



B. M. 158.58 N.W. cor. conc porch,
W. S. House 1502 MURRAY.

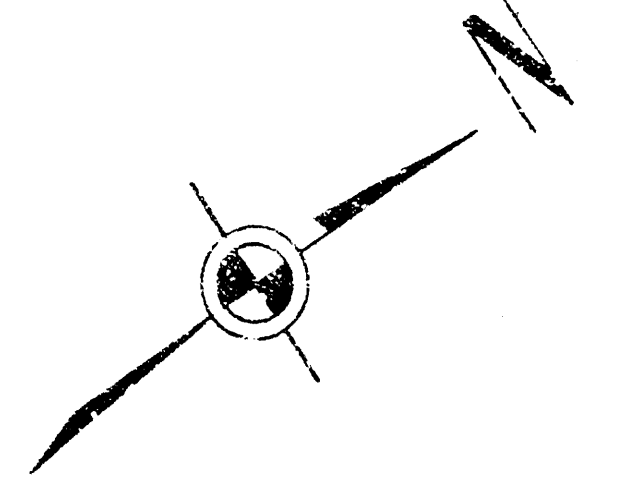


Plan Scale 1" = 40'
Profile Scale 1" = 5' Vert

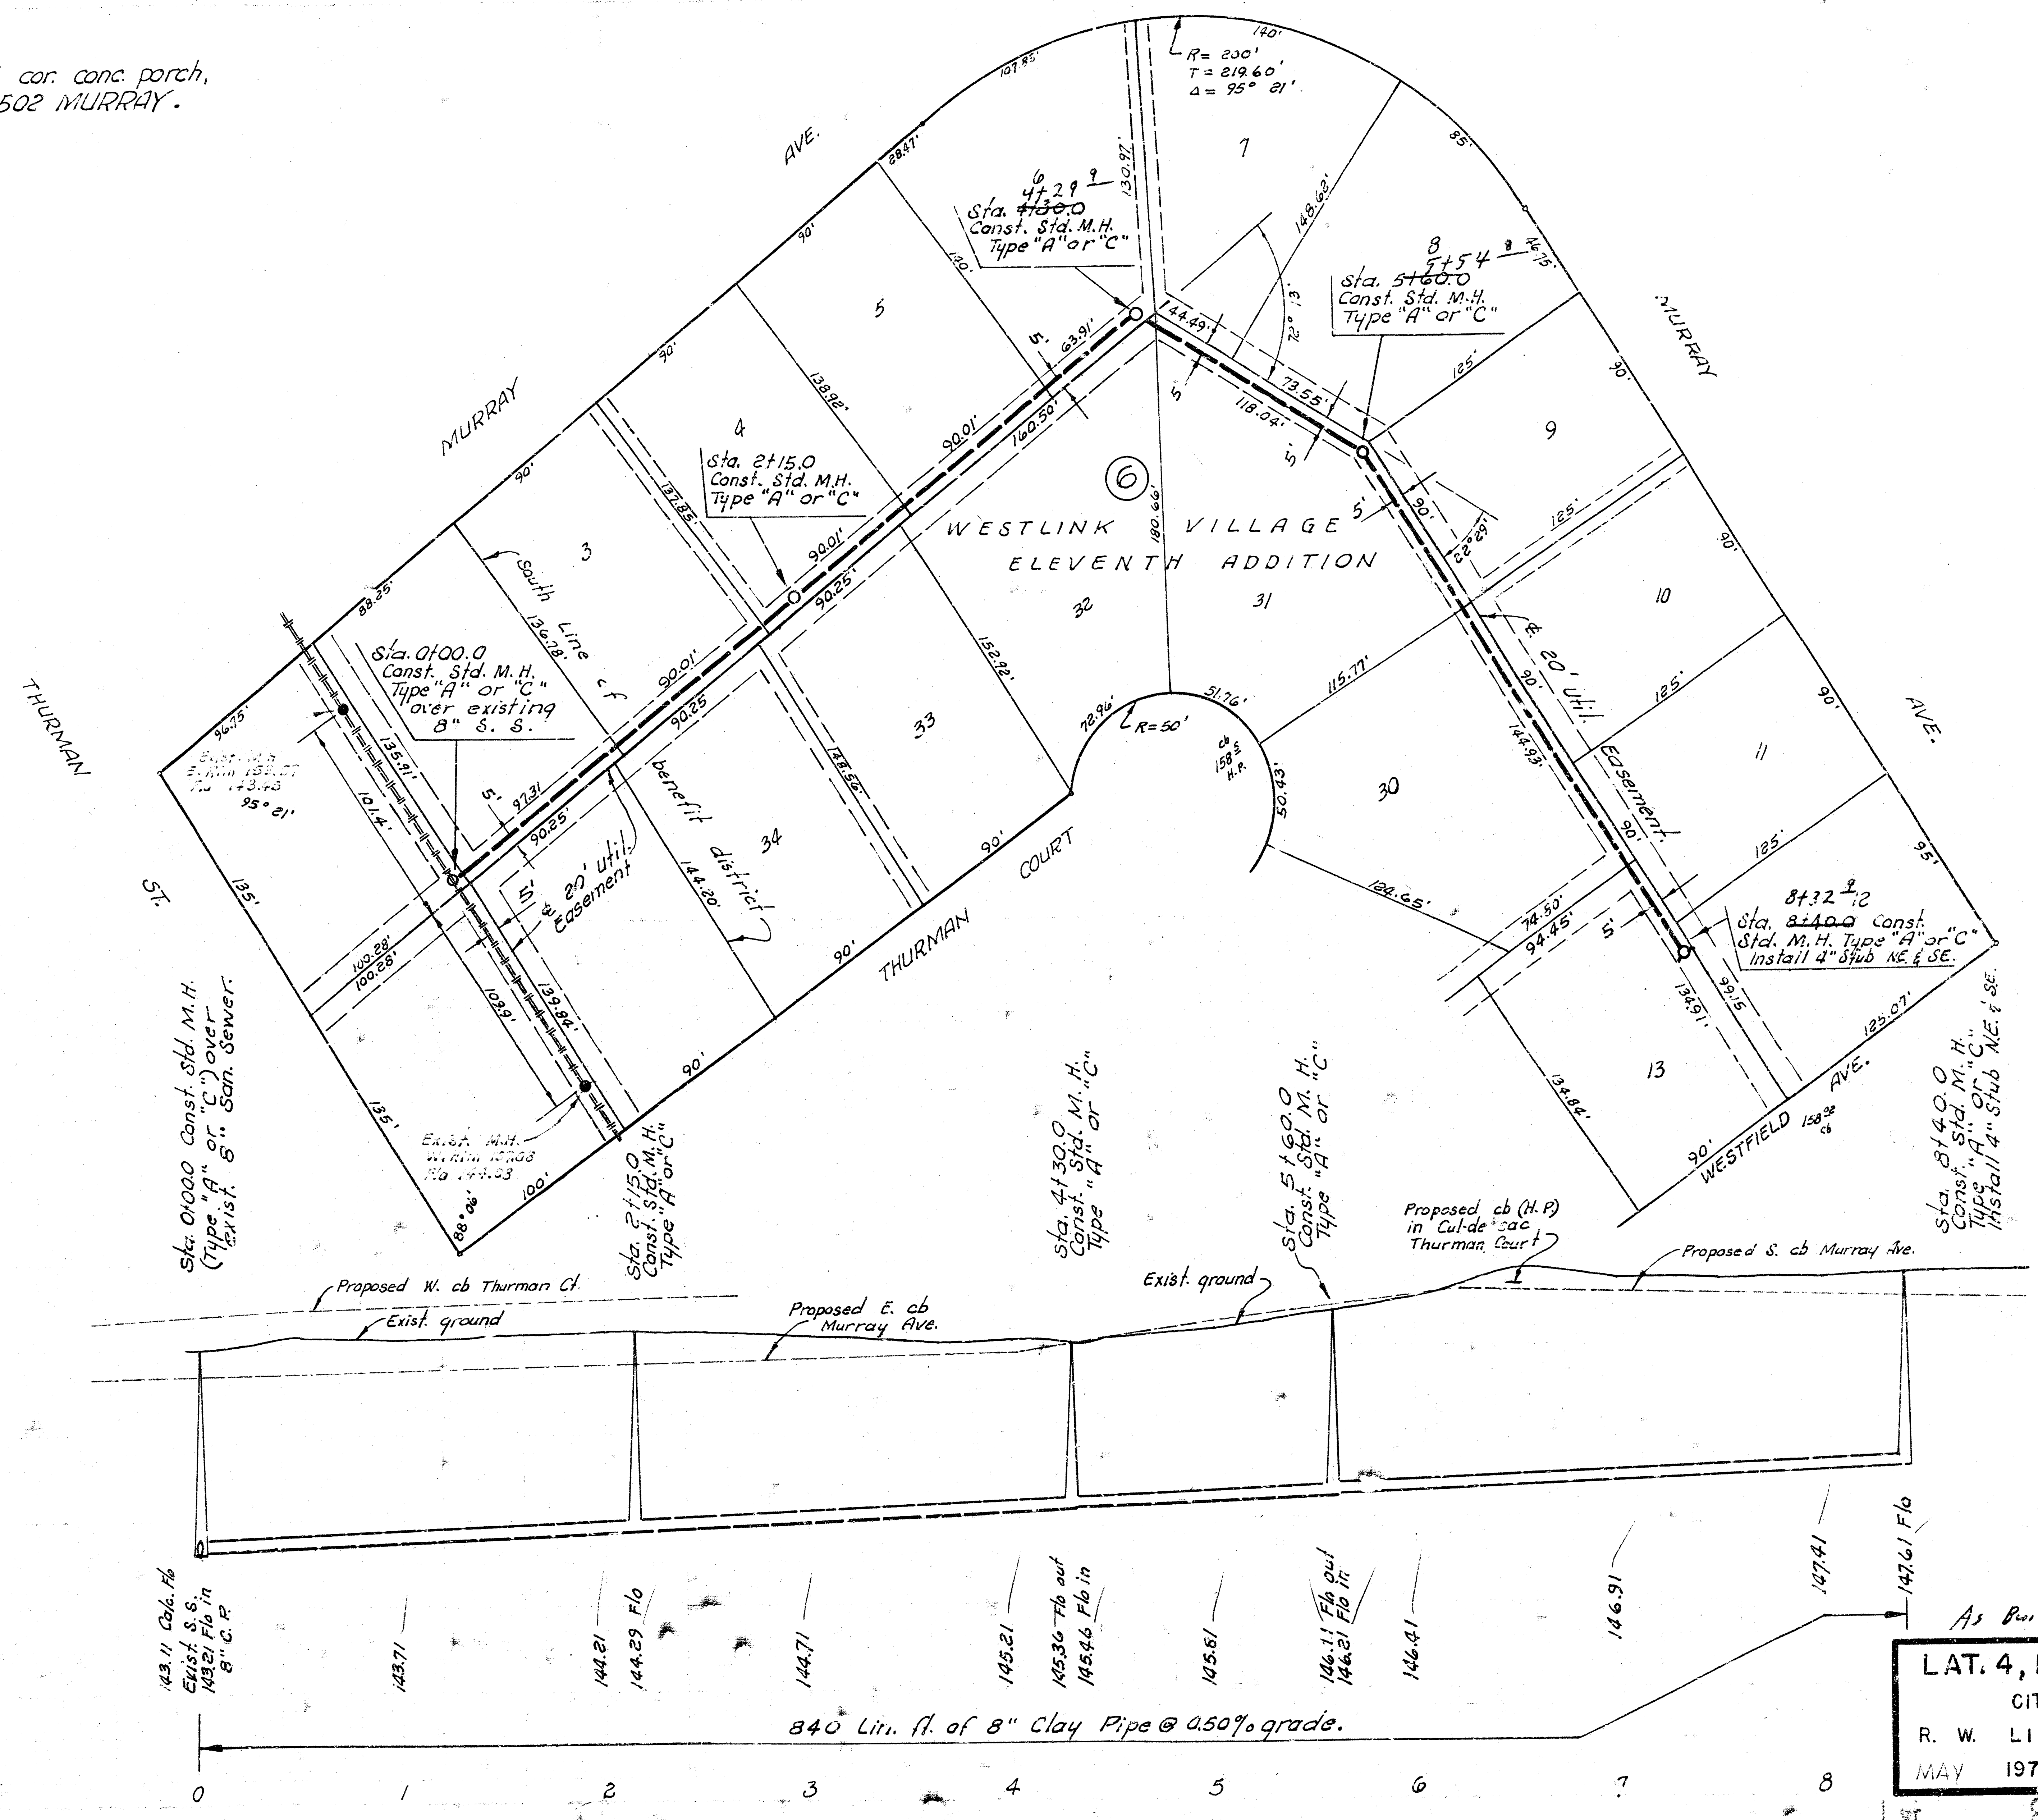

2-D. S. 94
 90

160
 155
 150
 145
 140

160
 155
 150
 145
 140

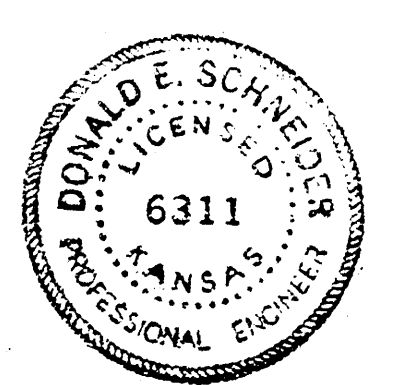

As Built 7-24-75

LAT. 4, MAIN 3, WESTLINK SEWER	
CITY OF WICHITA, KANSAS	
R. W. LINN	CITY ENGINEER
MAY 1975	PROJECT NO. DBKL574028