

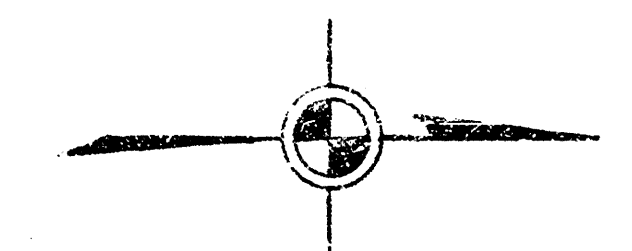


D. C. D. W.
U. R.

060

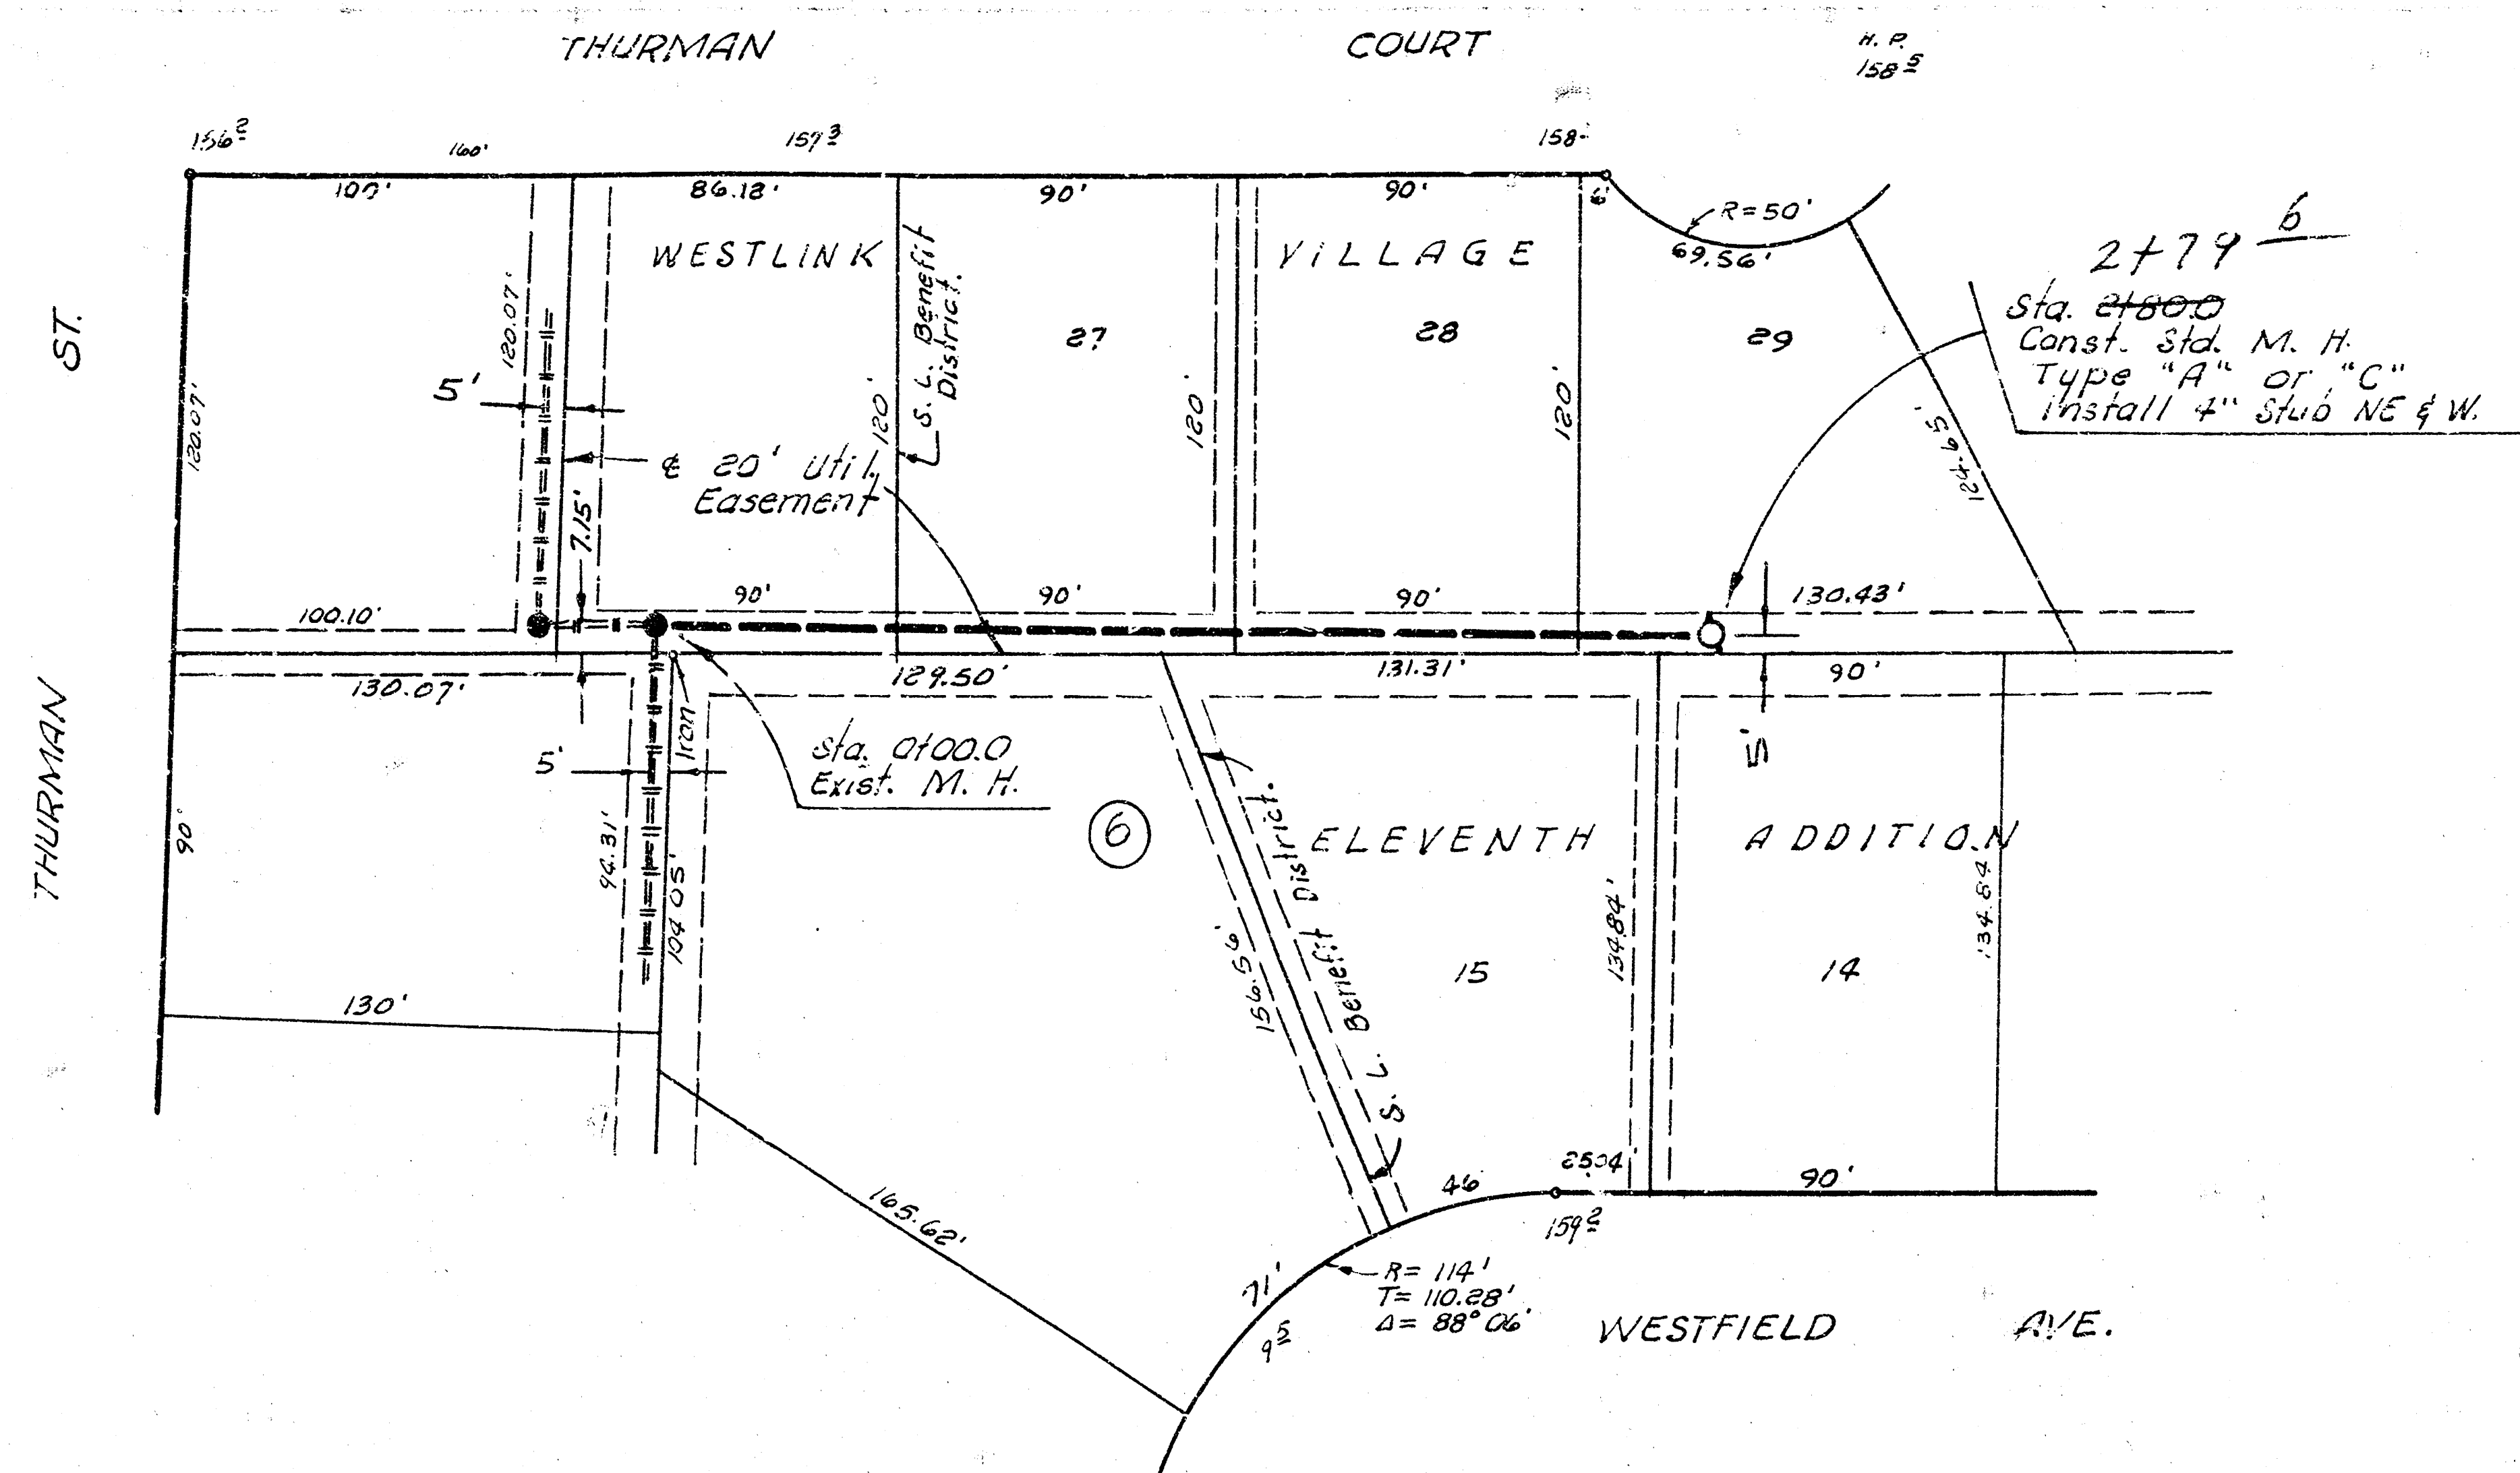

Plan Scale 1" = 40'
Profile Scale 1" = 40' Horiz.
1" = 5' Vert.

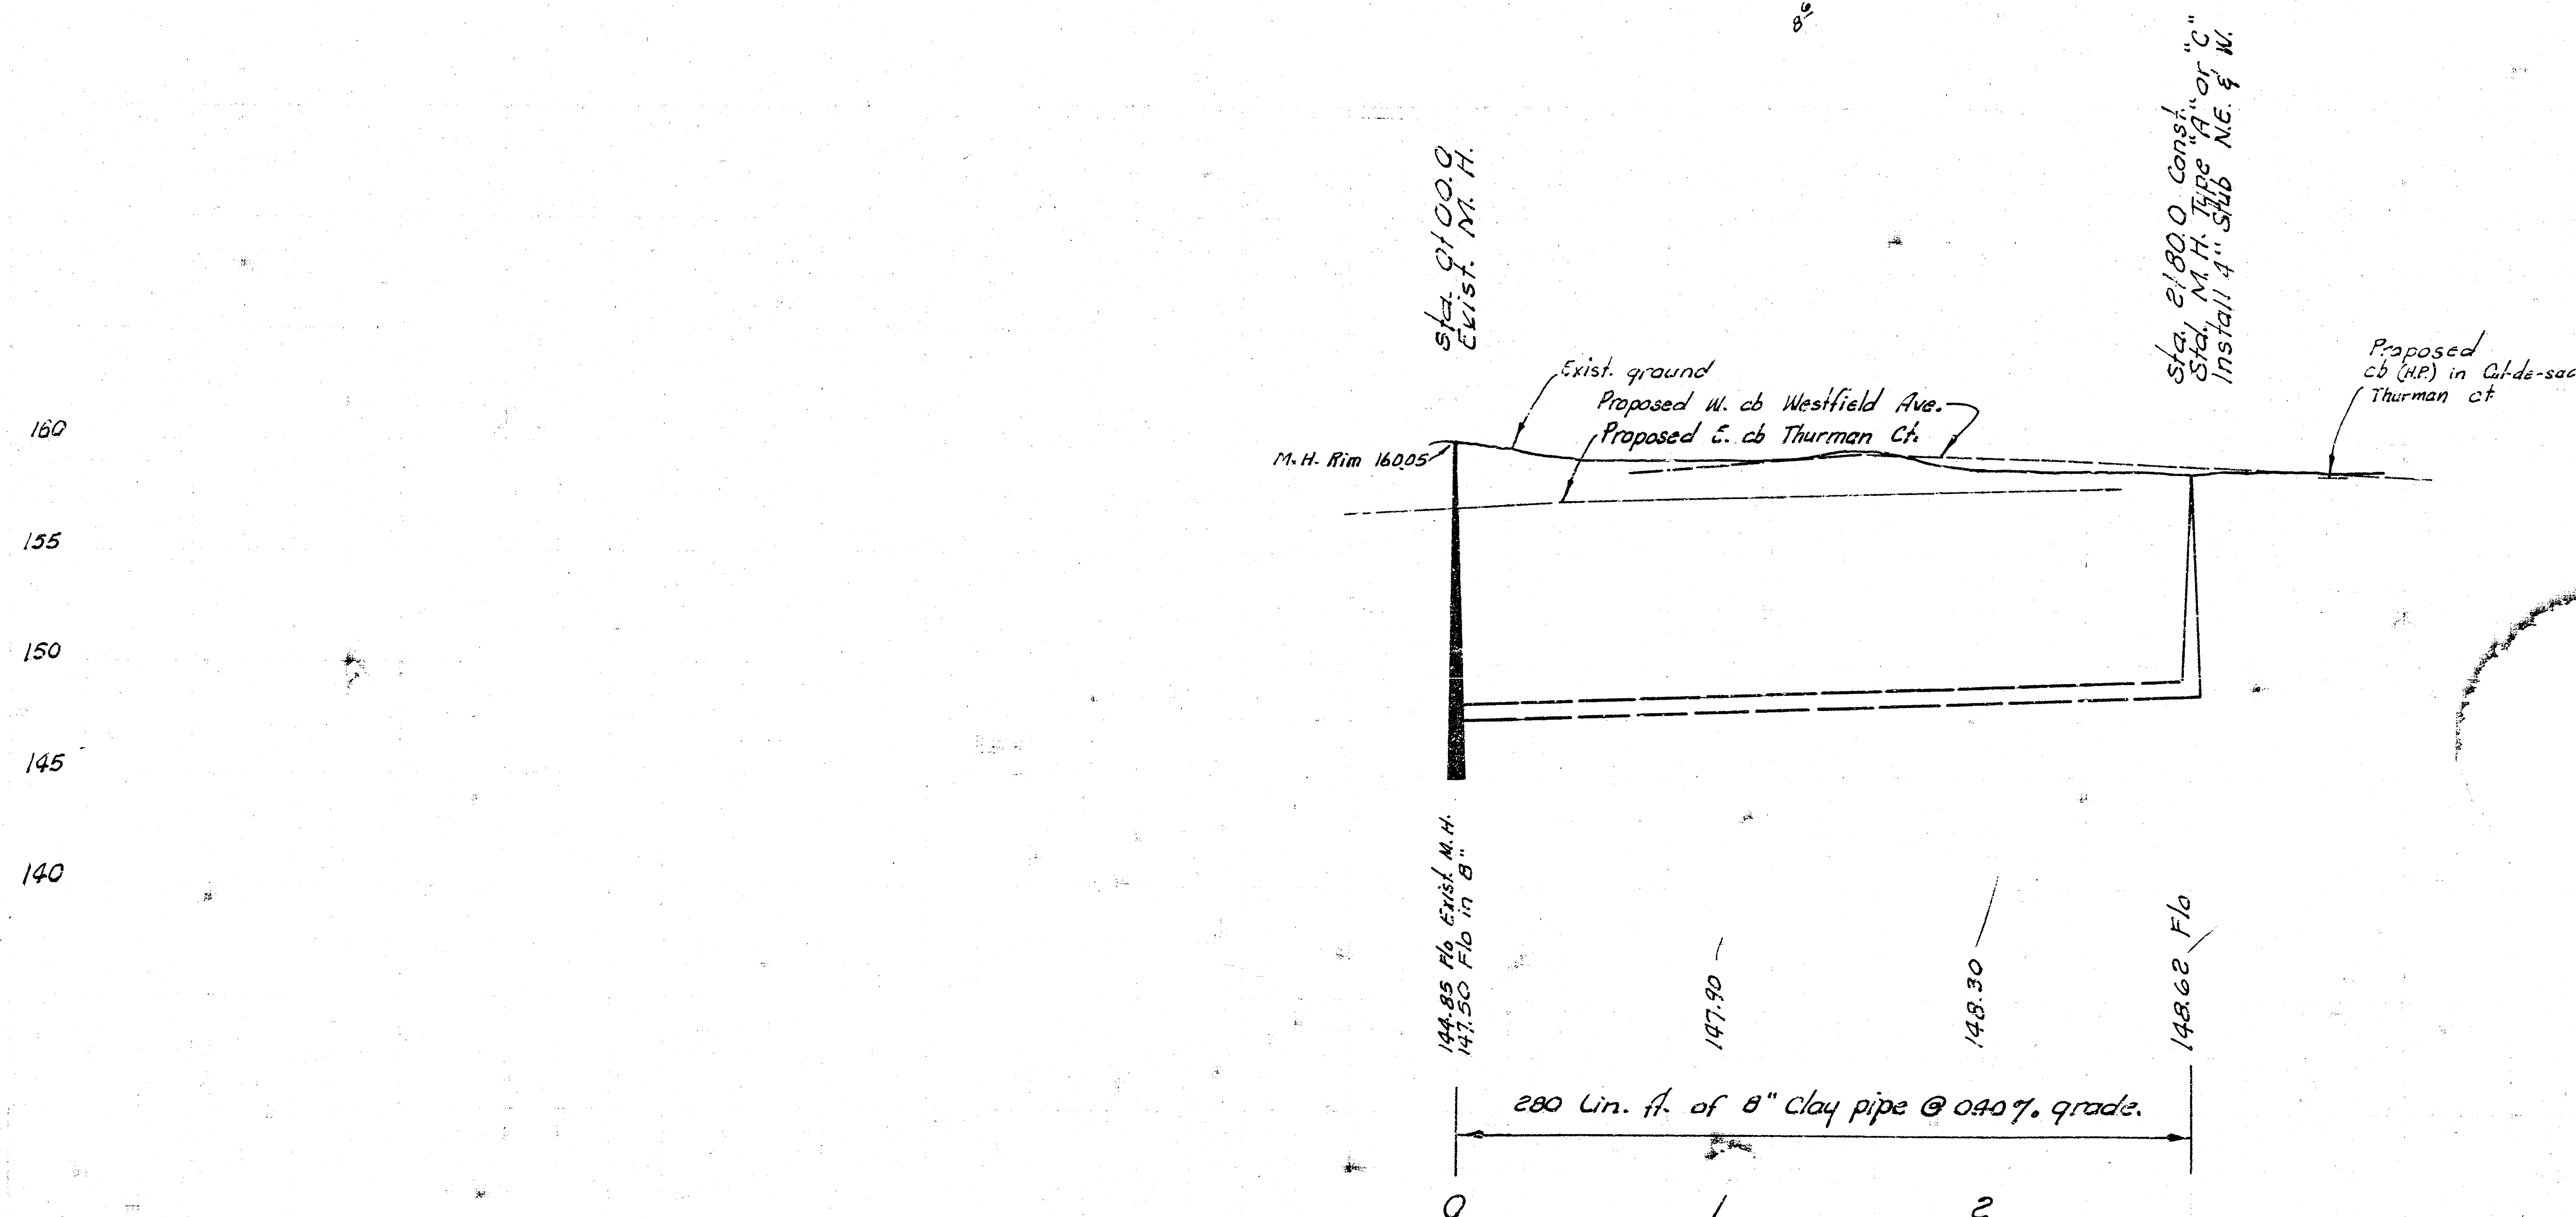

As Built 7-24-75

LAT. 5, MAIN 3, WESTLINK SEWER
CITY OF WICHITA, KANSAS

R. W. LINN — CITY ENGINEER
1-14-75 1975 PROJECT NO. DBKL574029