

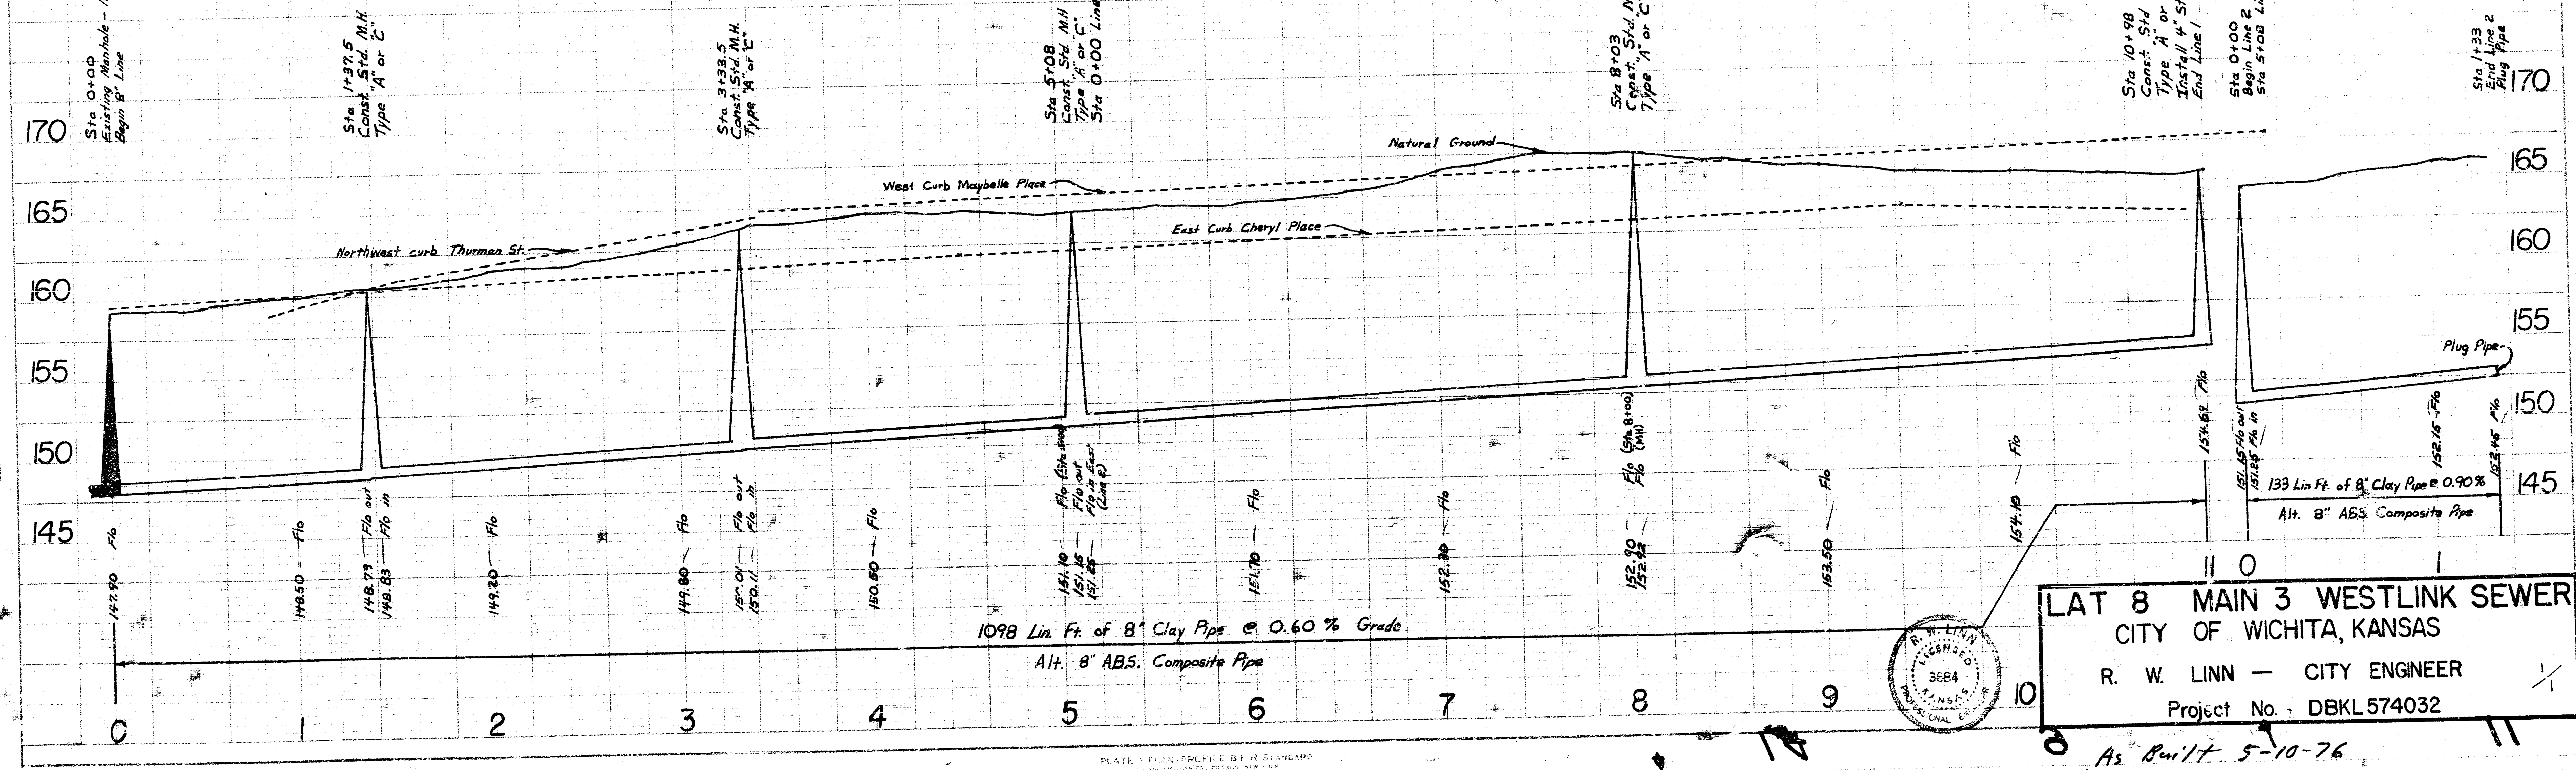



BM. 172.48 City Std. SE corner of 17th St. North and Tyler Road
 BM. 158.75 SE. corner concrete porch 9116 Nantucket

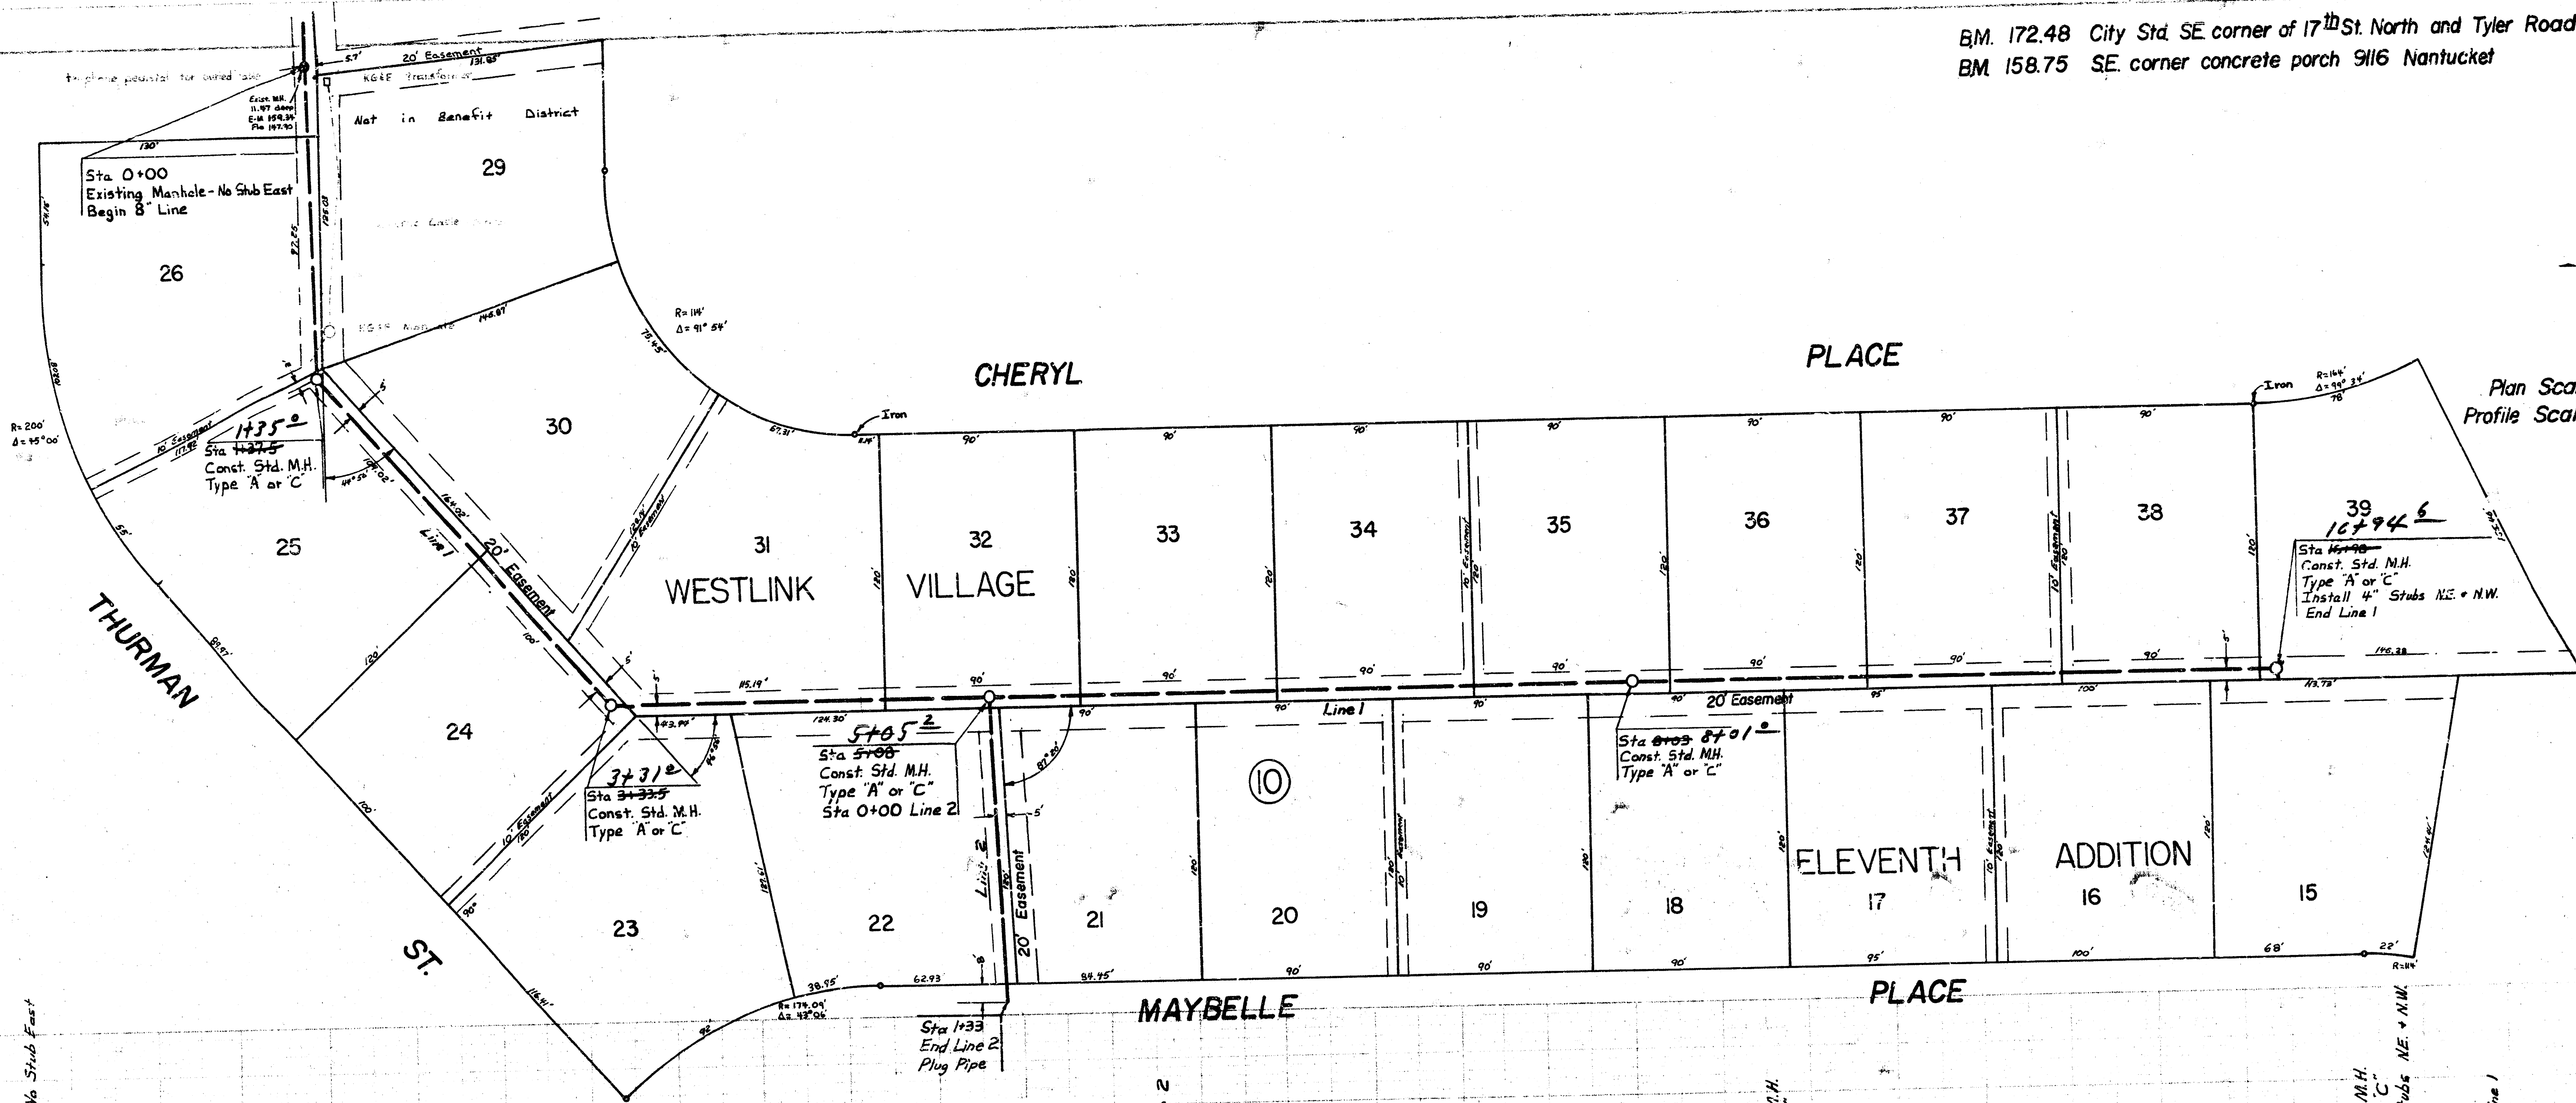

Plan Scale 1" = 40'
 Profile Scale 1" = 40' Horiz.
 1" = 5' Vert.

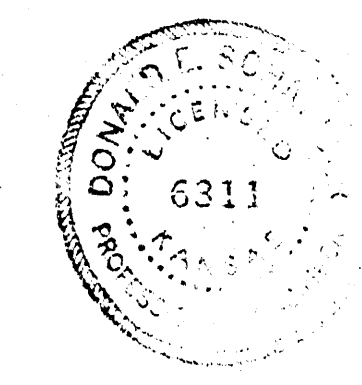

LAT 8 MAIN 3 WESTLINK SEWER
 CITY OF WICHITA, KANSAS
 R. W. LINN — CITY ENGINEER
 Project No. DBKL 574032

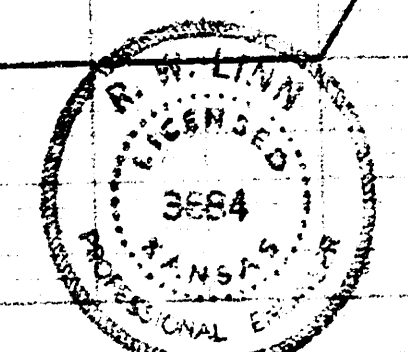

As Built 5-10-76