

Plan Scale $1" = 40'$
Profile Scale $1" = 40'$ Horiz.
 $1" = 5'$ Vert.

EXIST. M.H.
Flo 142.31
S. Rim 154.81

sta. 0+00.0 Const.

EXIST. M.H.
FLO 142.06
S. RIM 155.0

EXCEPTION
Not in benefit district

Sta. 5+60.0
Const Std. M. H.
Type "A" or "C"

sta. 8 + ~~43.62~~
CONST Std M. H
T "A" "C"

Sta. 8 + 92.00
Const. Std. M. H.
Type "A" or "C"



Sta. 10 + ~~15.00~~
const std. M. H.
Type "A" or "C"
Sta. 0 + 00.00 Line No. 2

10 735 Bu:11 0 23 12
LAT. 12, MAIN 3, WESTLINK SEWER
CITY OF WICHITA, KANSAS
R. W. LINN — CITY ENGINEER
Feb. 1975 PROJECT NO. DBKL574036


M-267
Book out front

1 of 3

FILMED FROM THE BEST

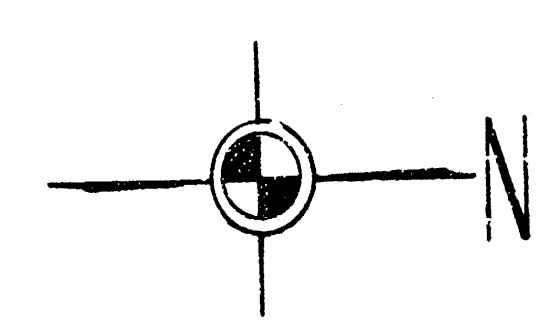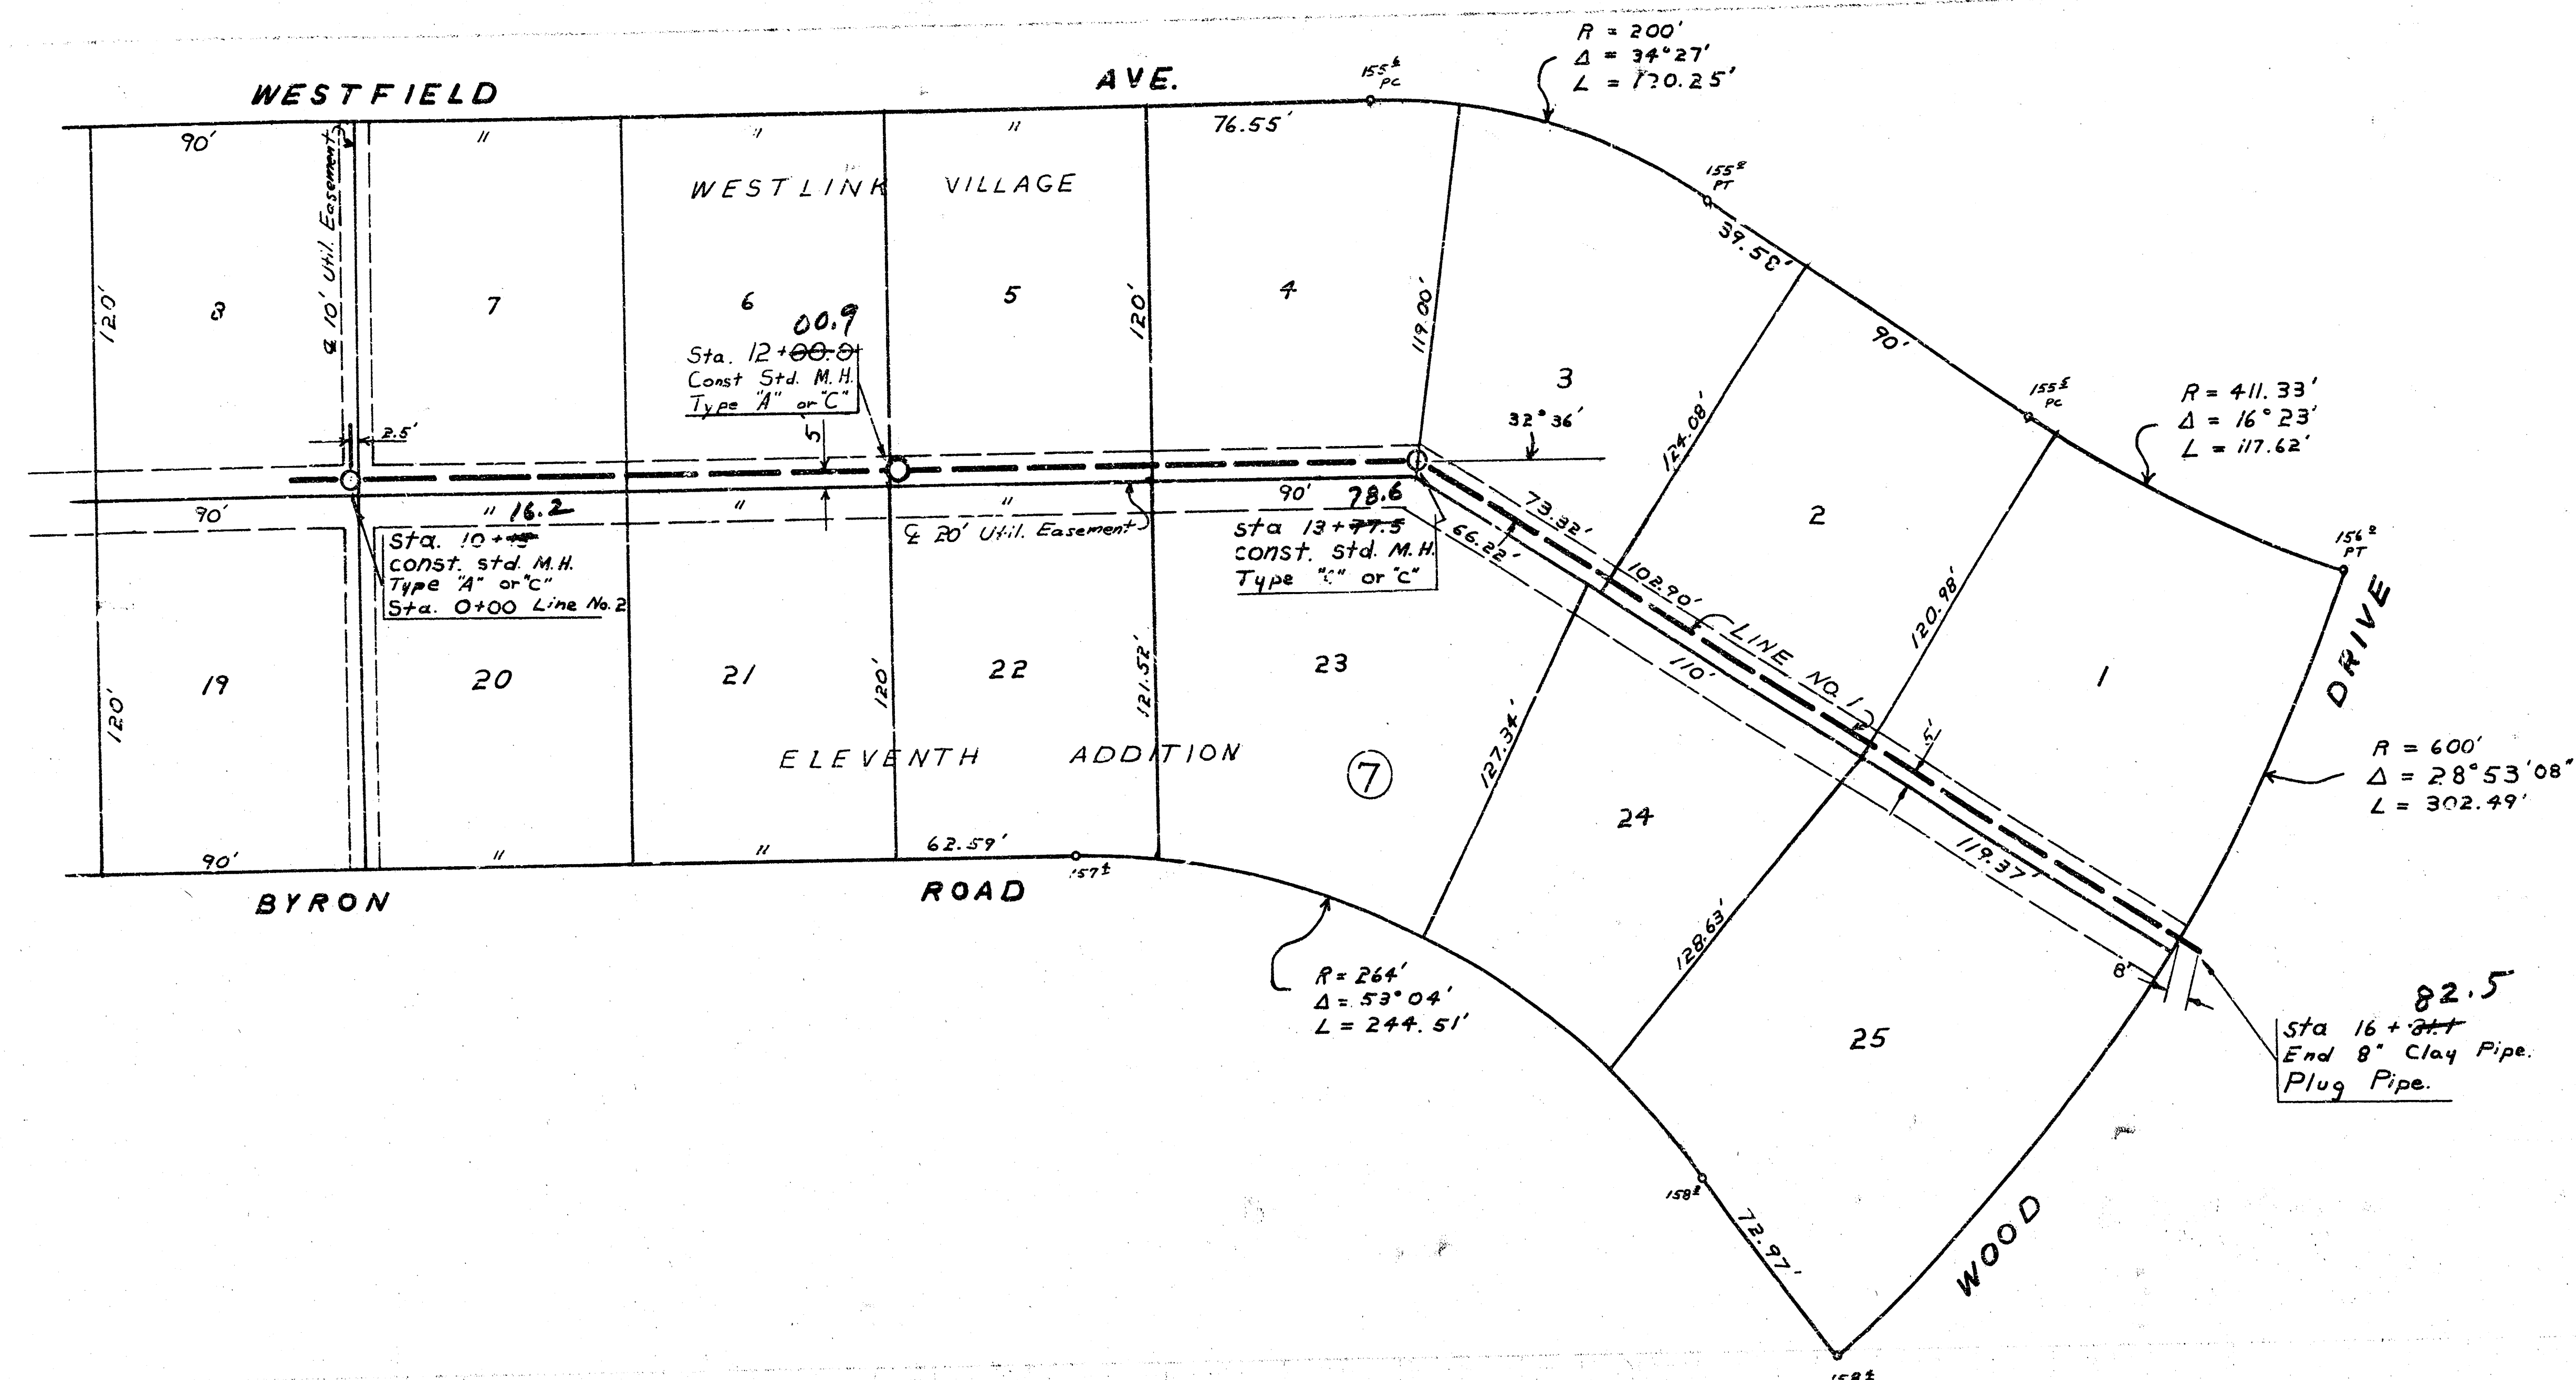

Plan Scale 1" = 40'
 Profile Scale 1" = 5' Vert


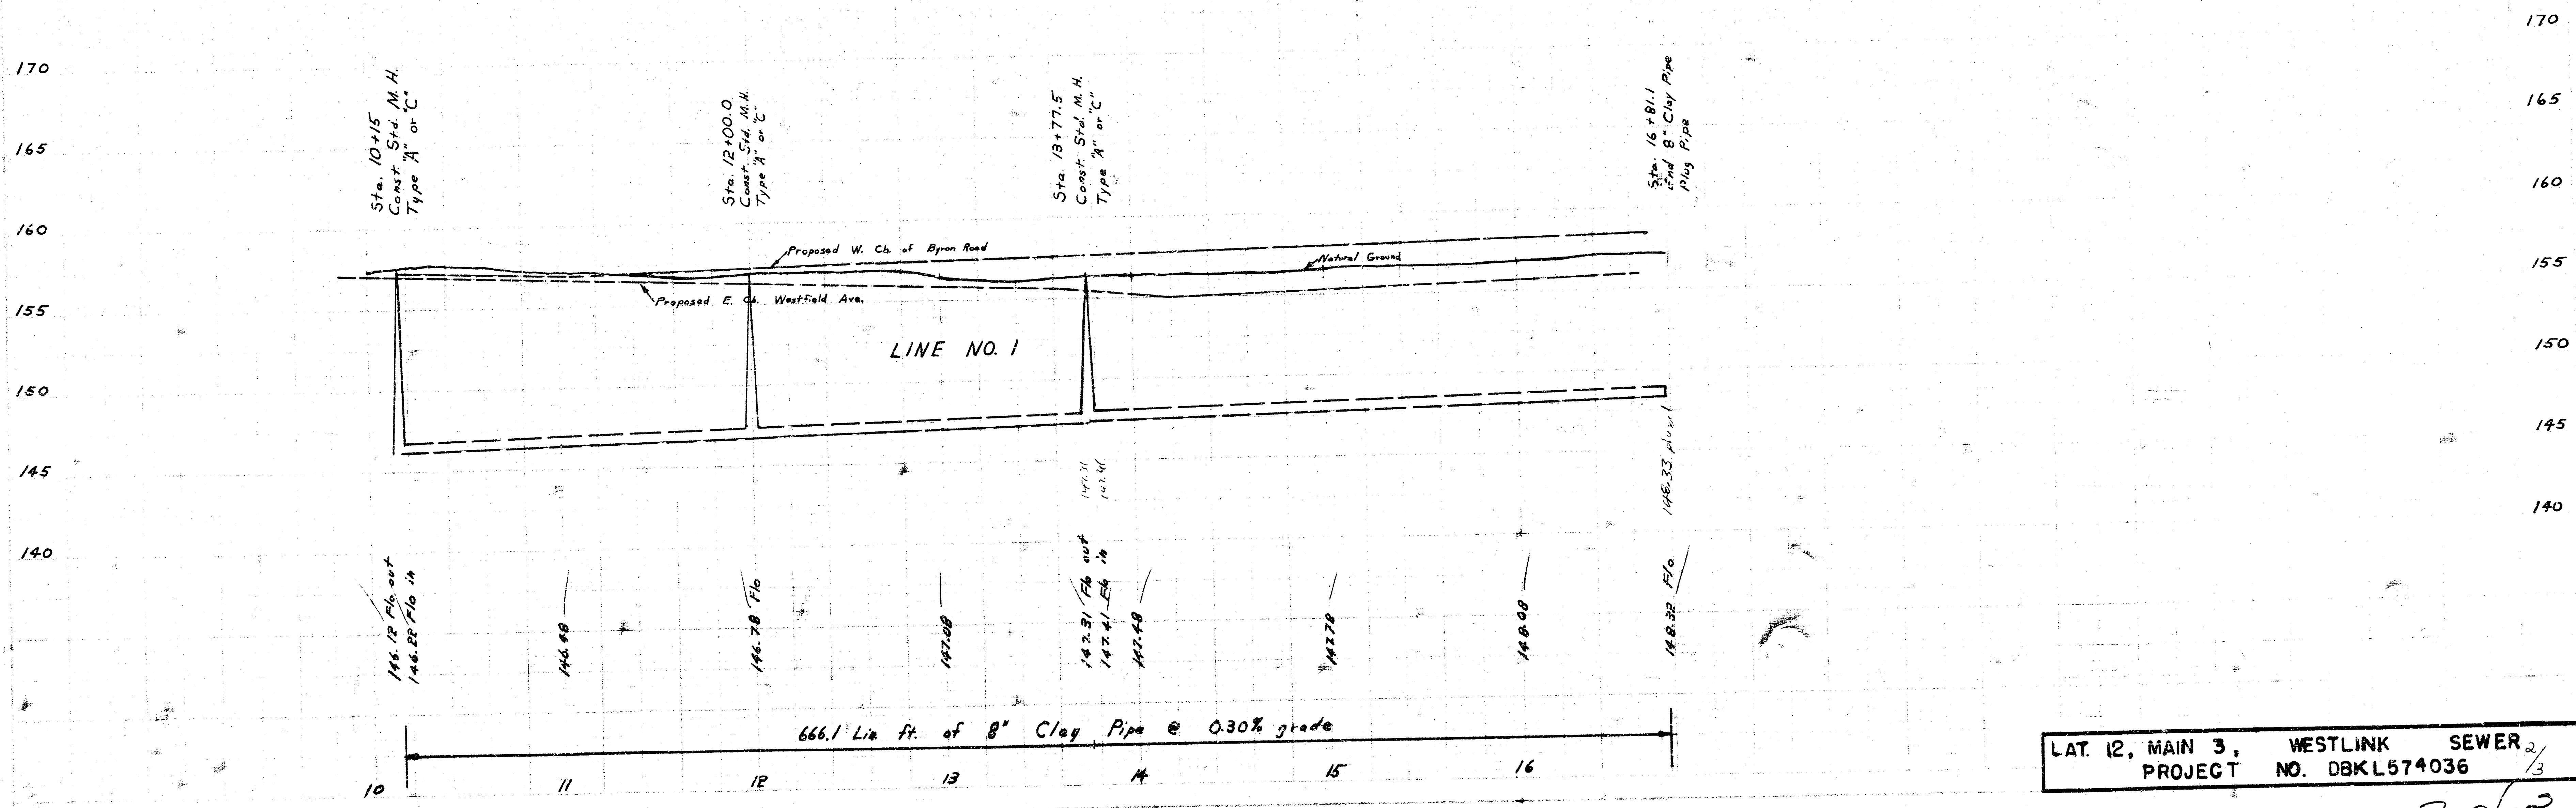


LAT. 12, MAIN 3, WESTLINK SEWER
 PROJECT NO. DBKL574036

2 of 3

WESTLINK


VILLAGE

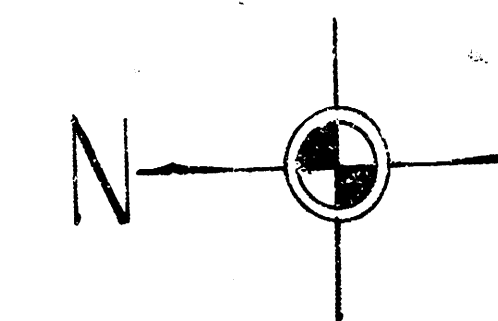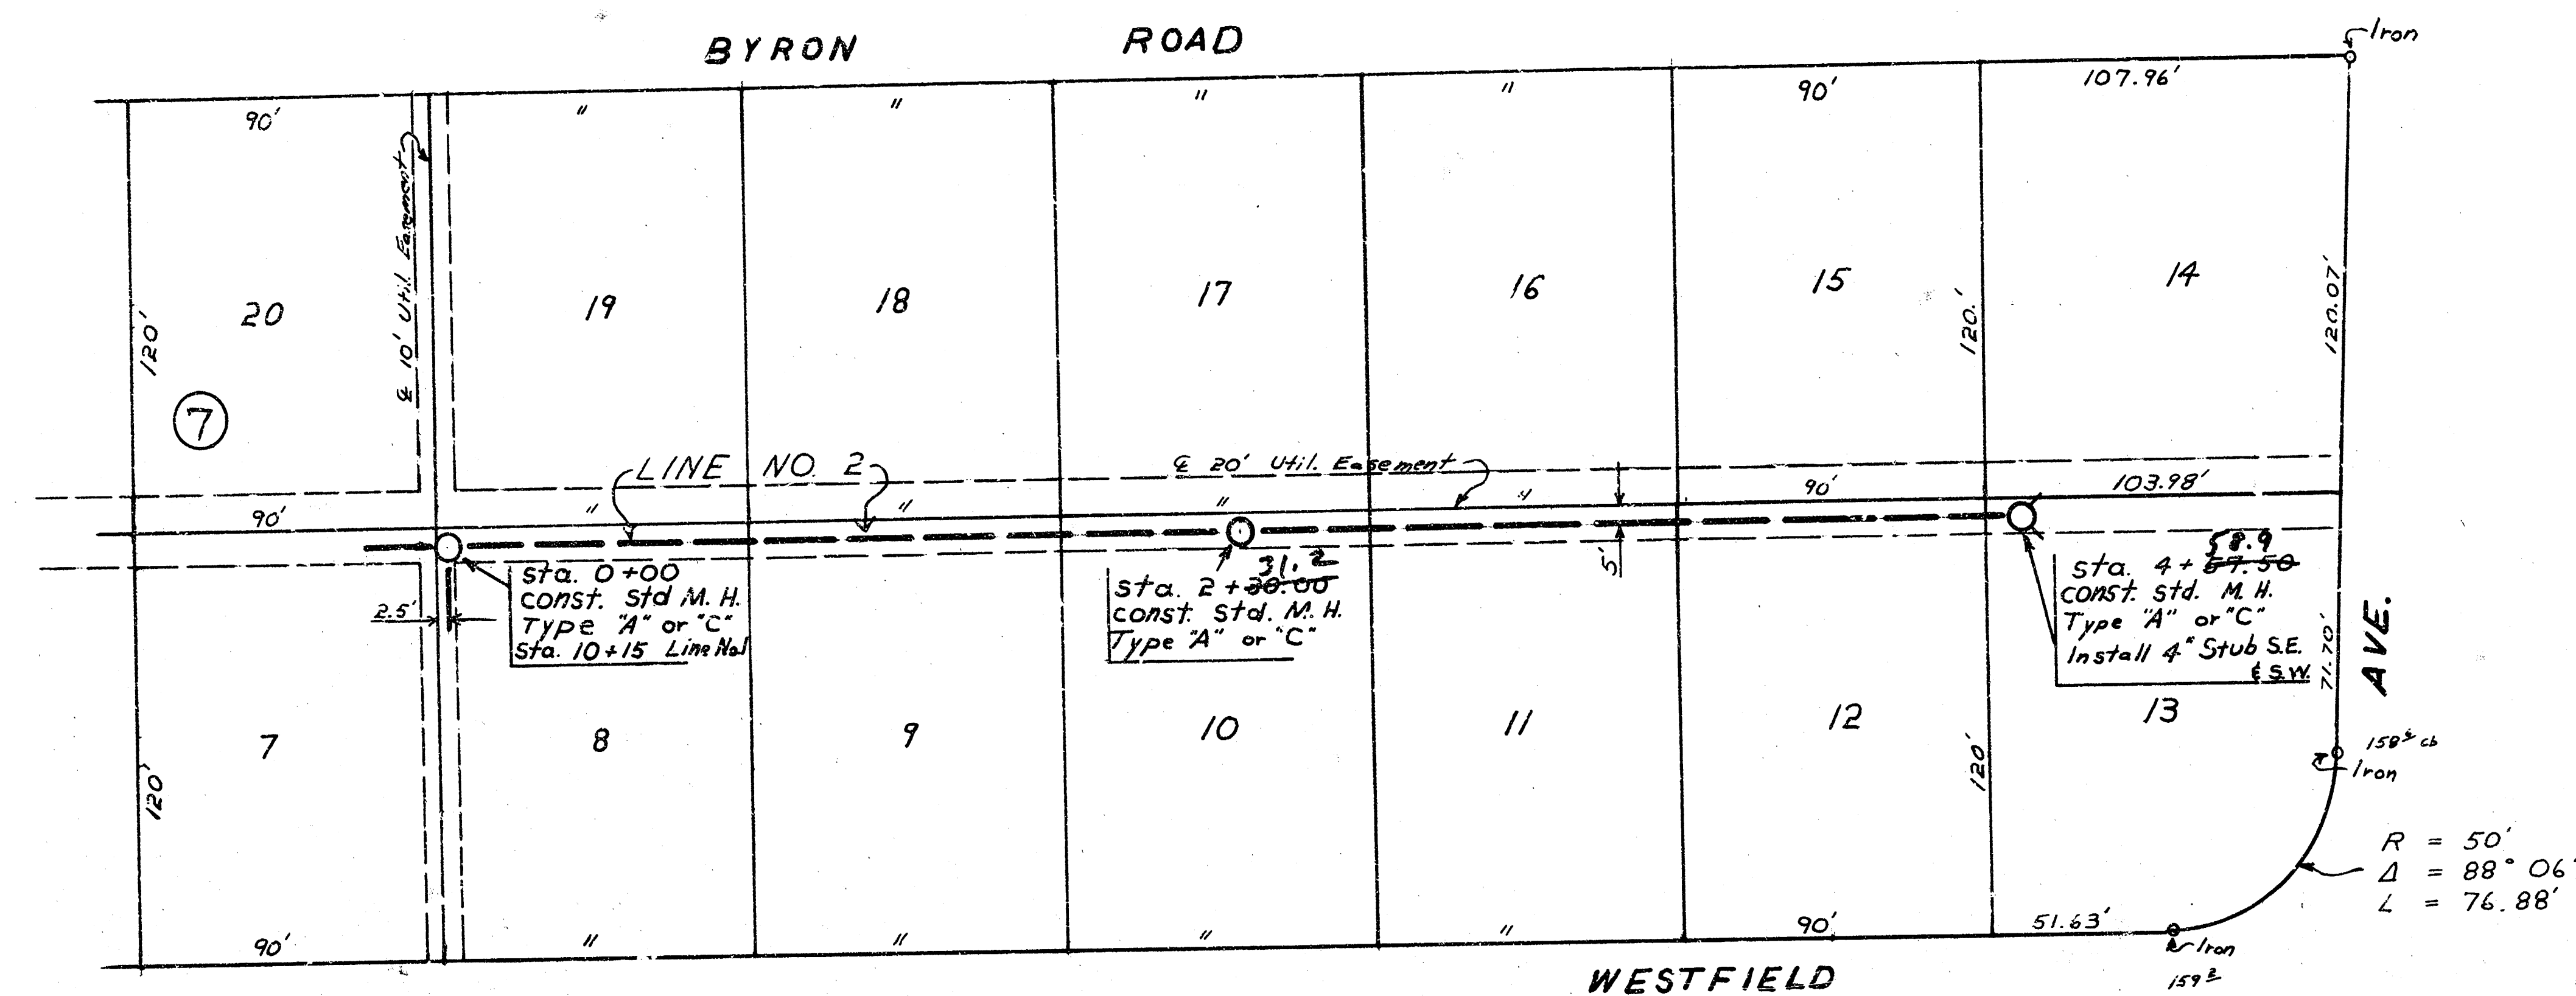

Plan Scale 1" = 40'
Profile Scale 1" = 40' Horiz.
1" = 5' Vert.

ELEVENTH

ADDITION

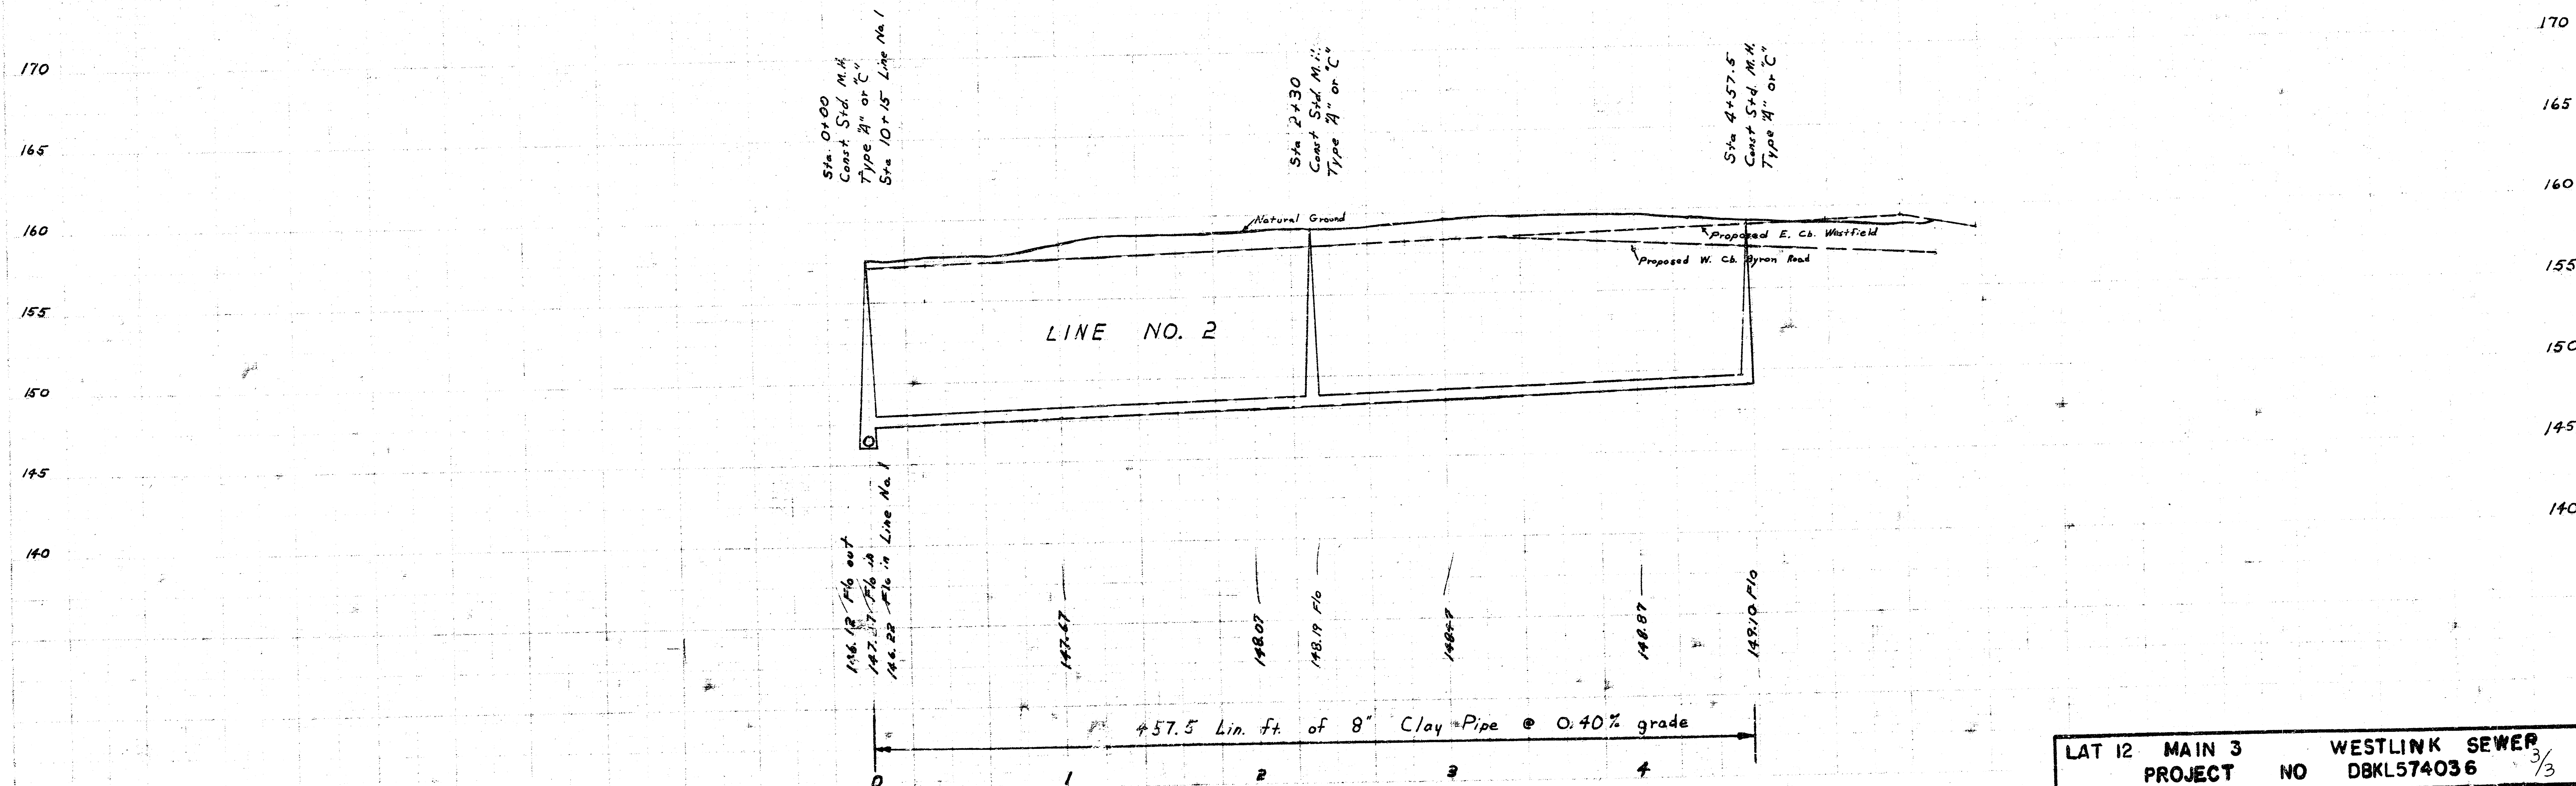

LAT 12 MAIN 3 WESTLINK SEWER
PROJECT NO DBKL574036 3/3

14 1 2 3 0789