

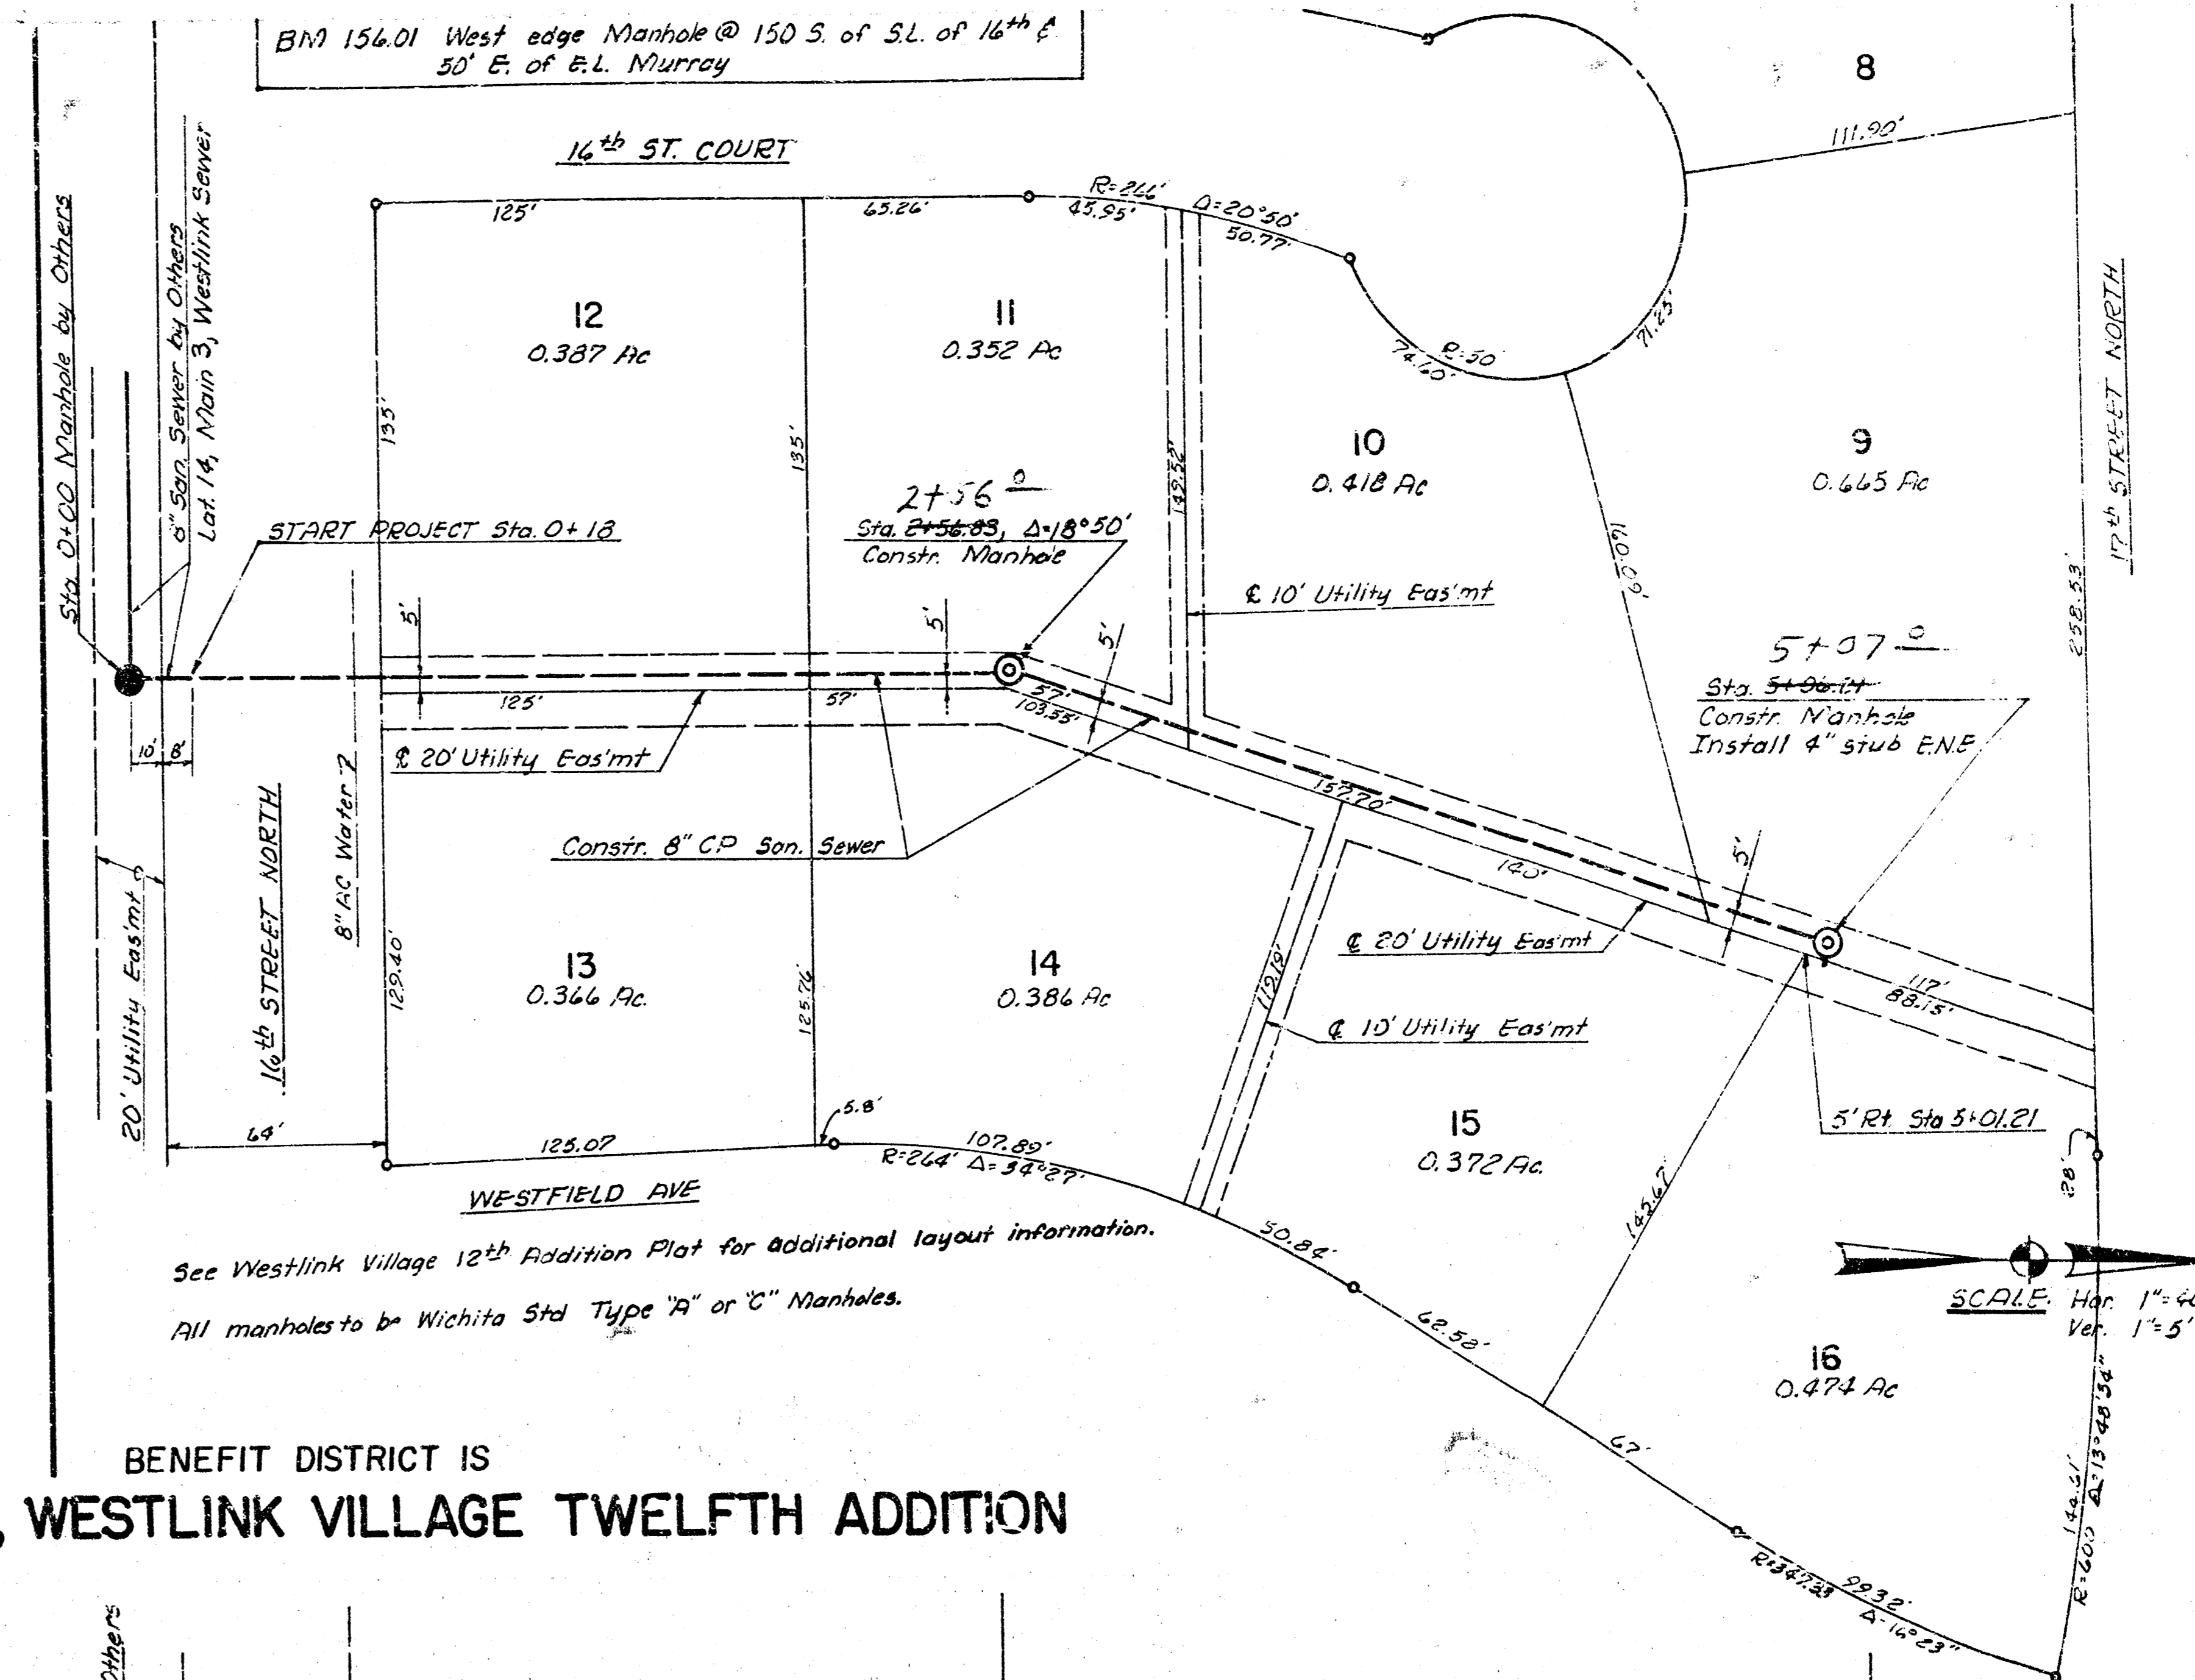
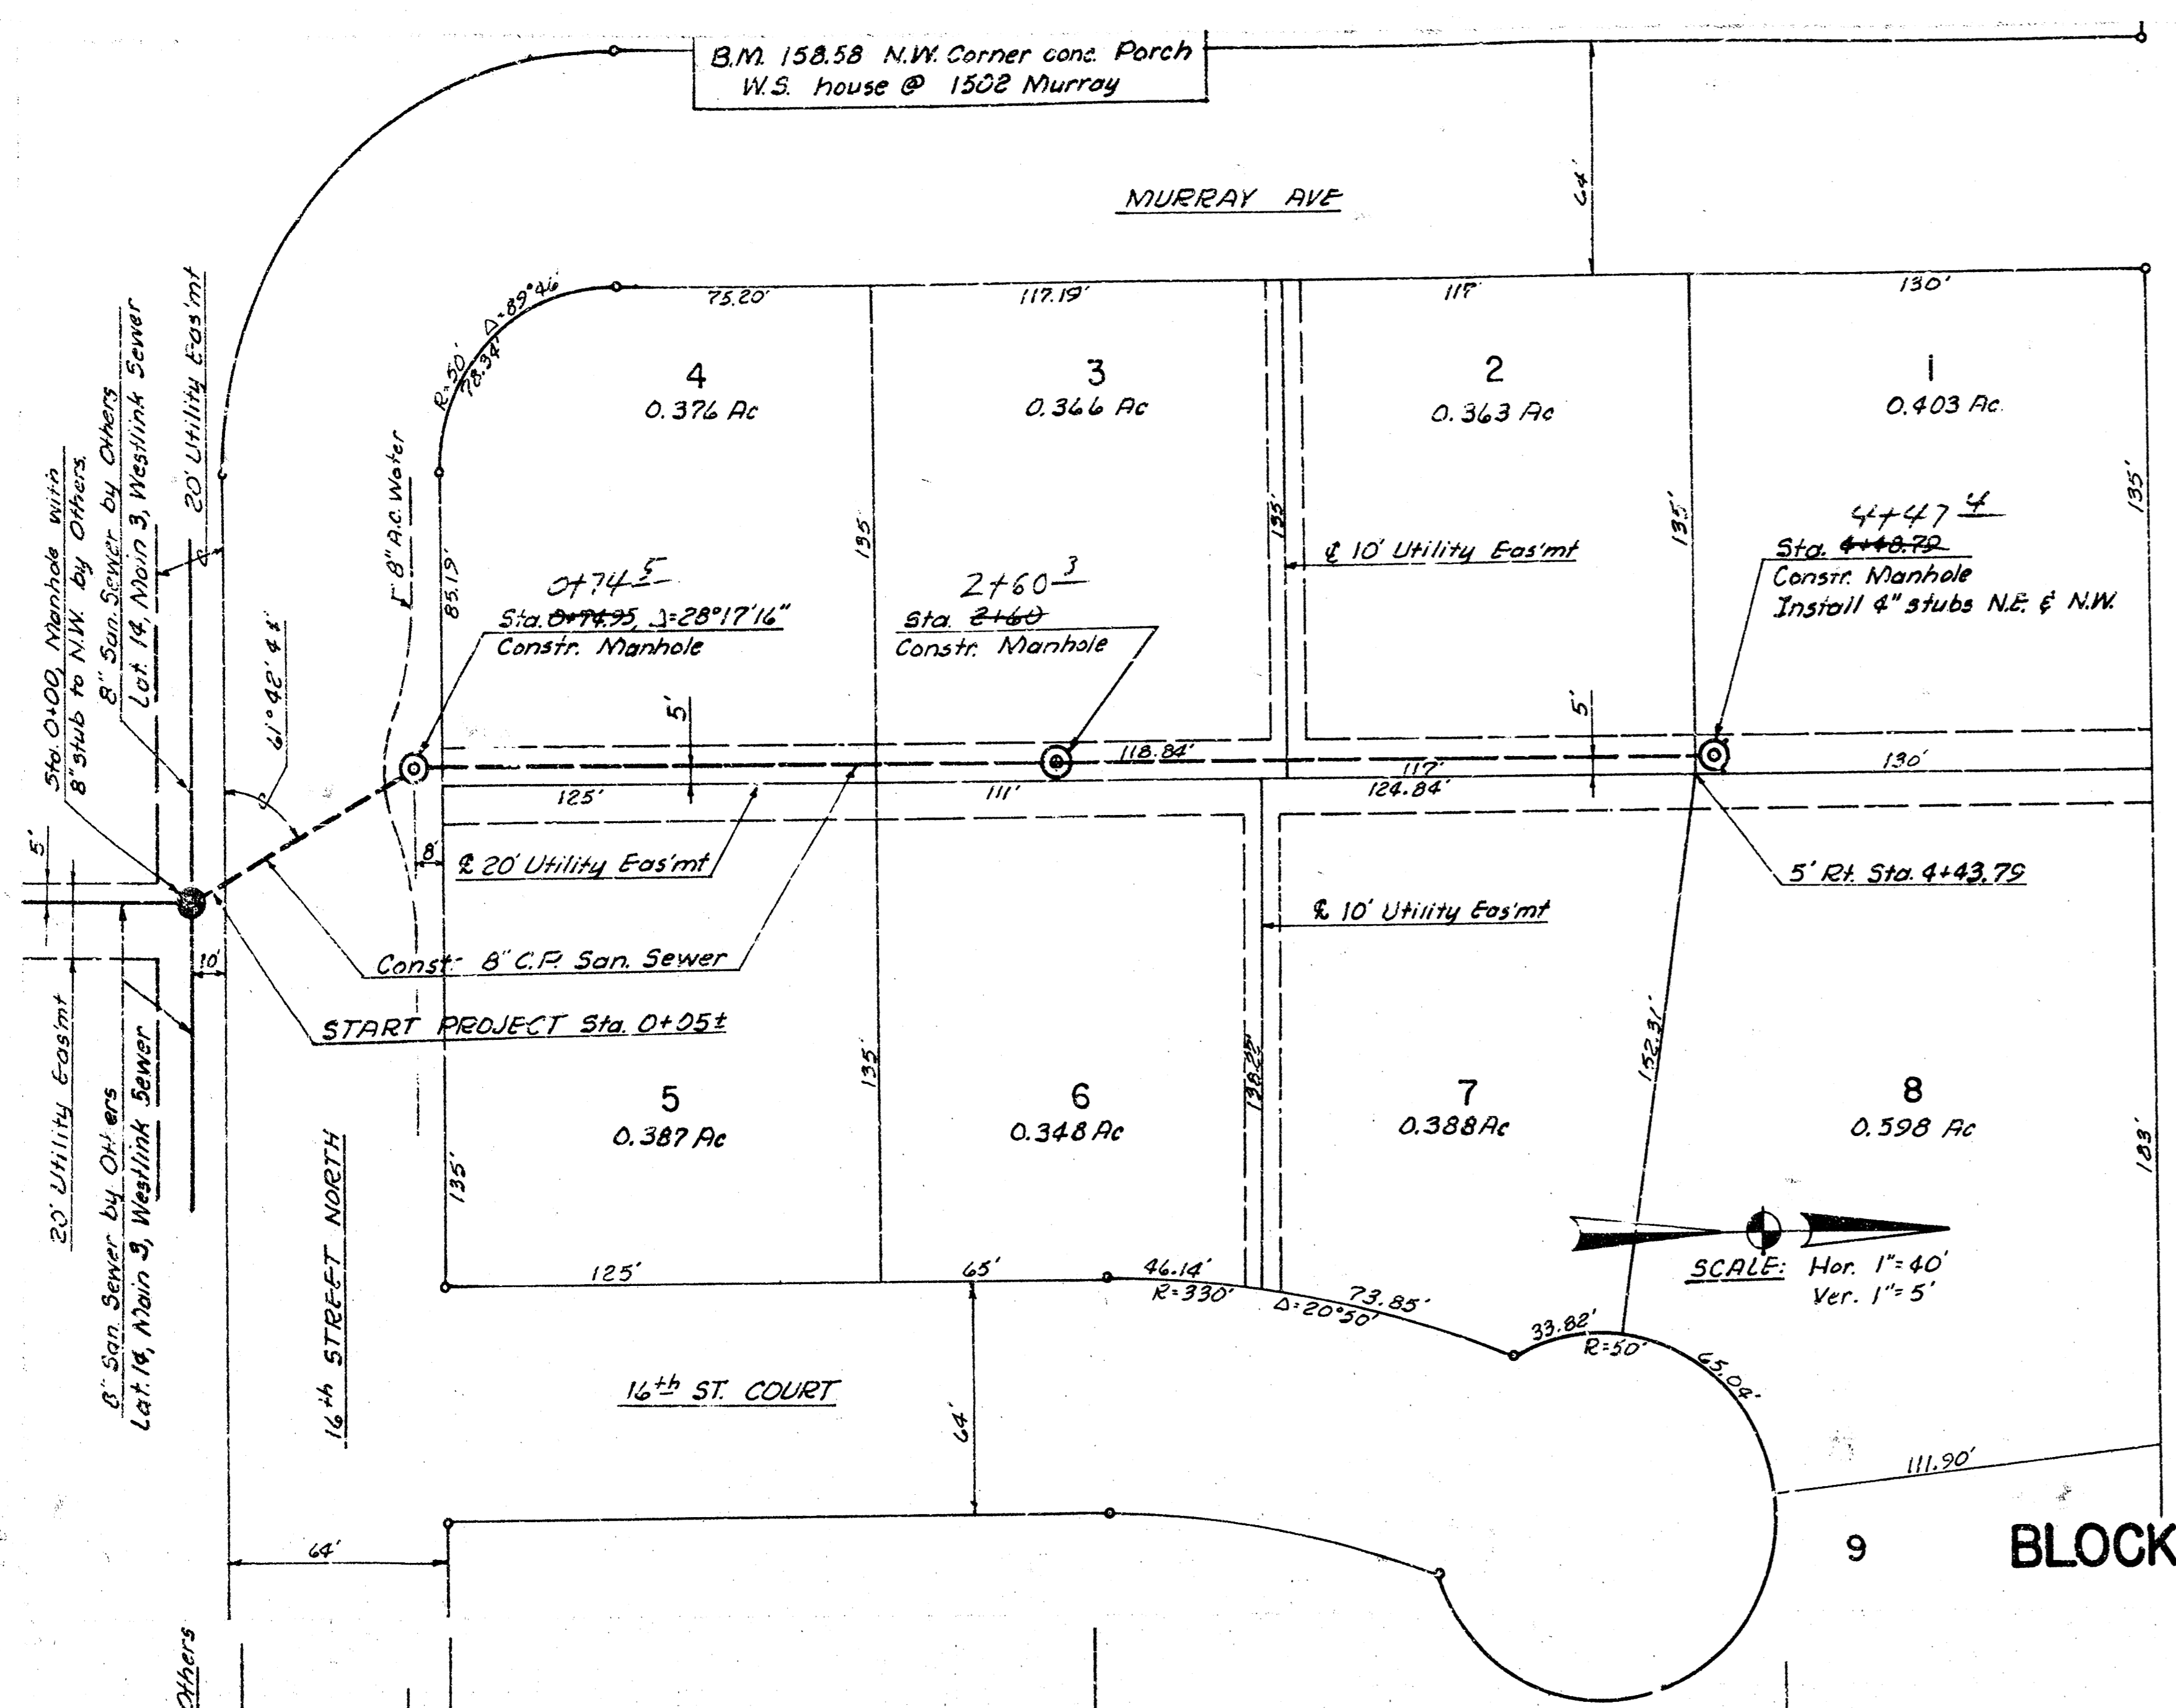
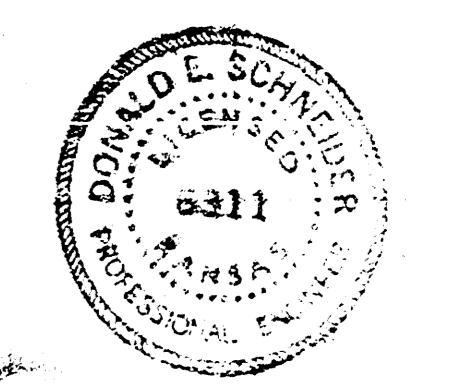


JFG, MSR (LES 2)

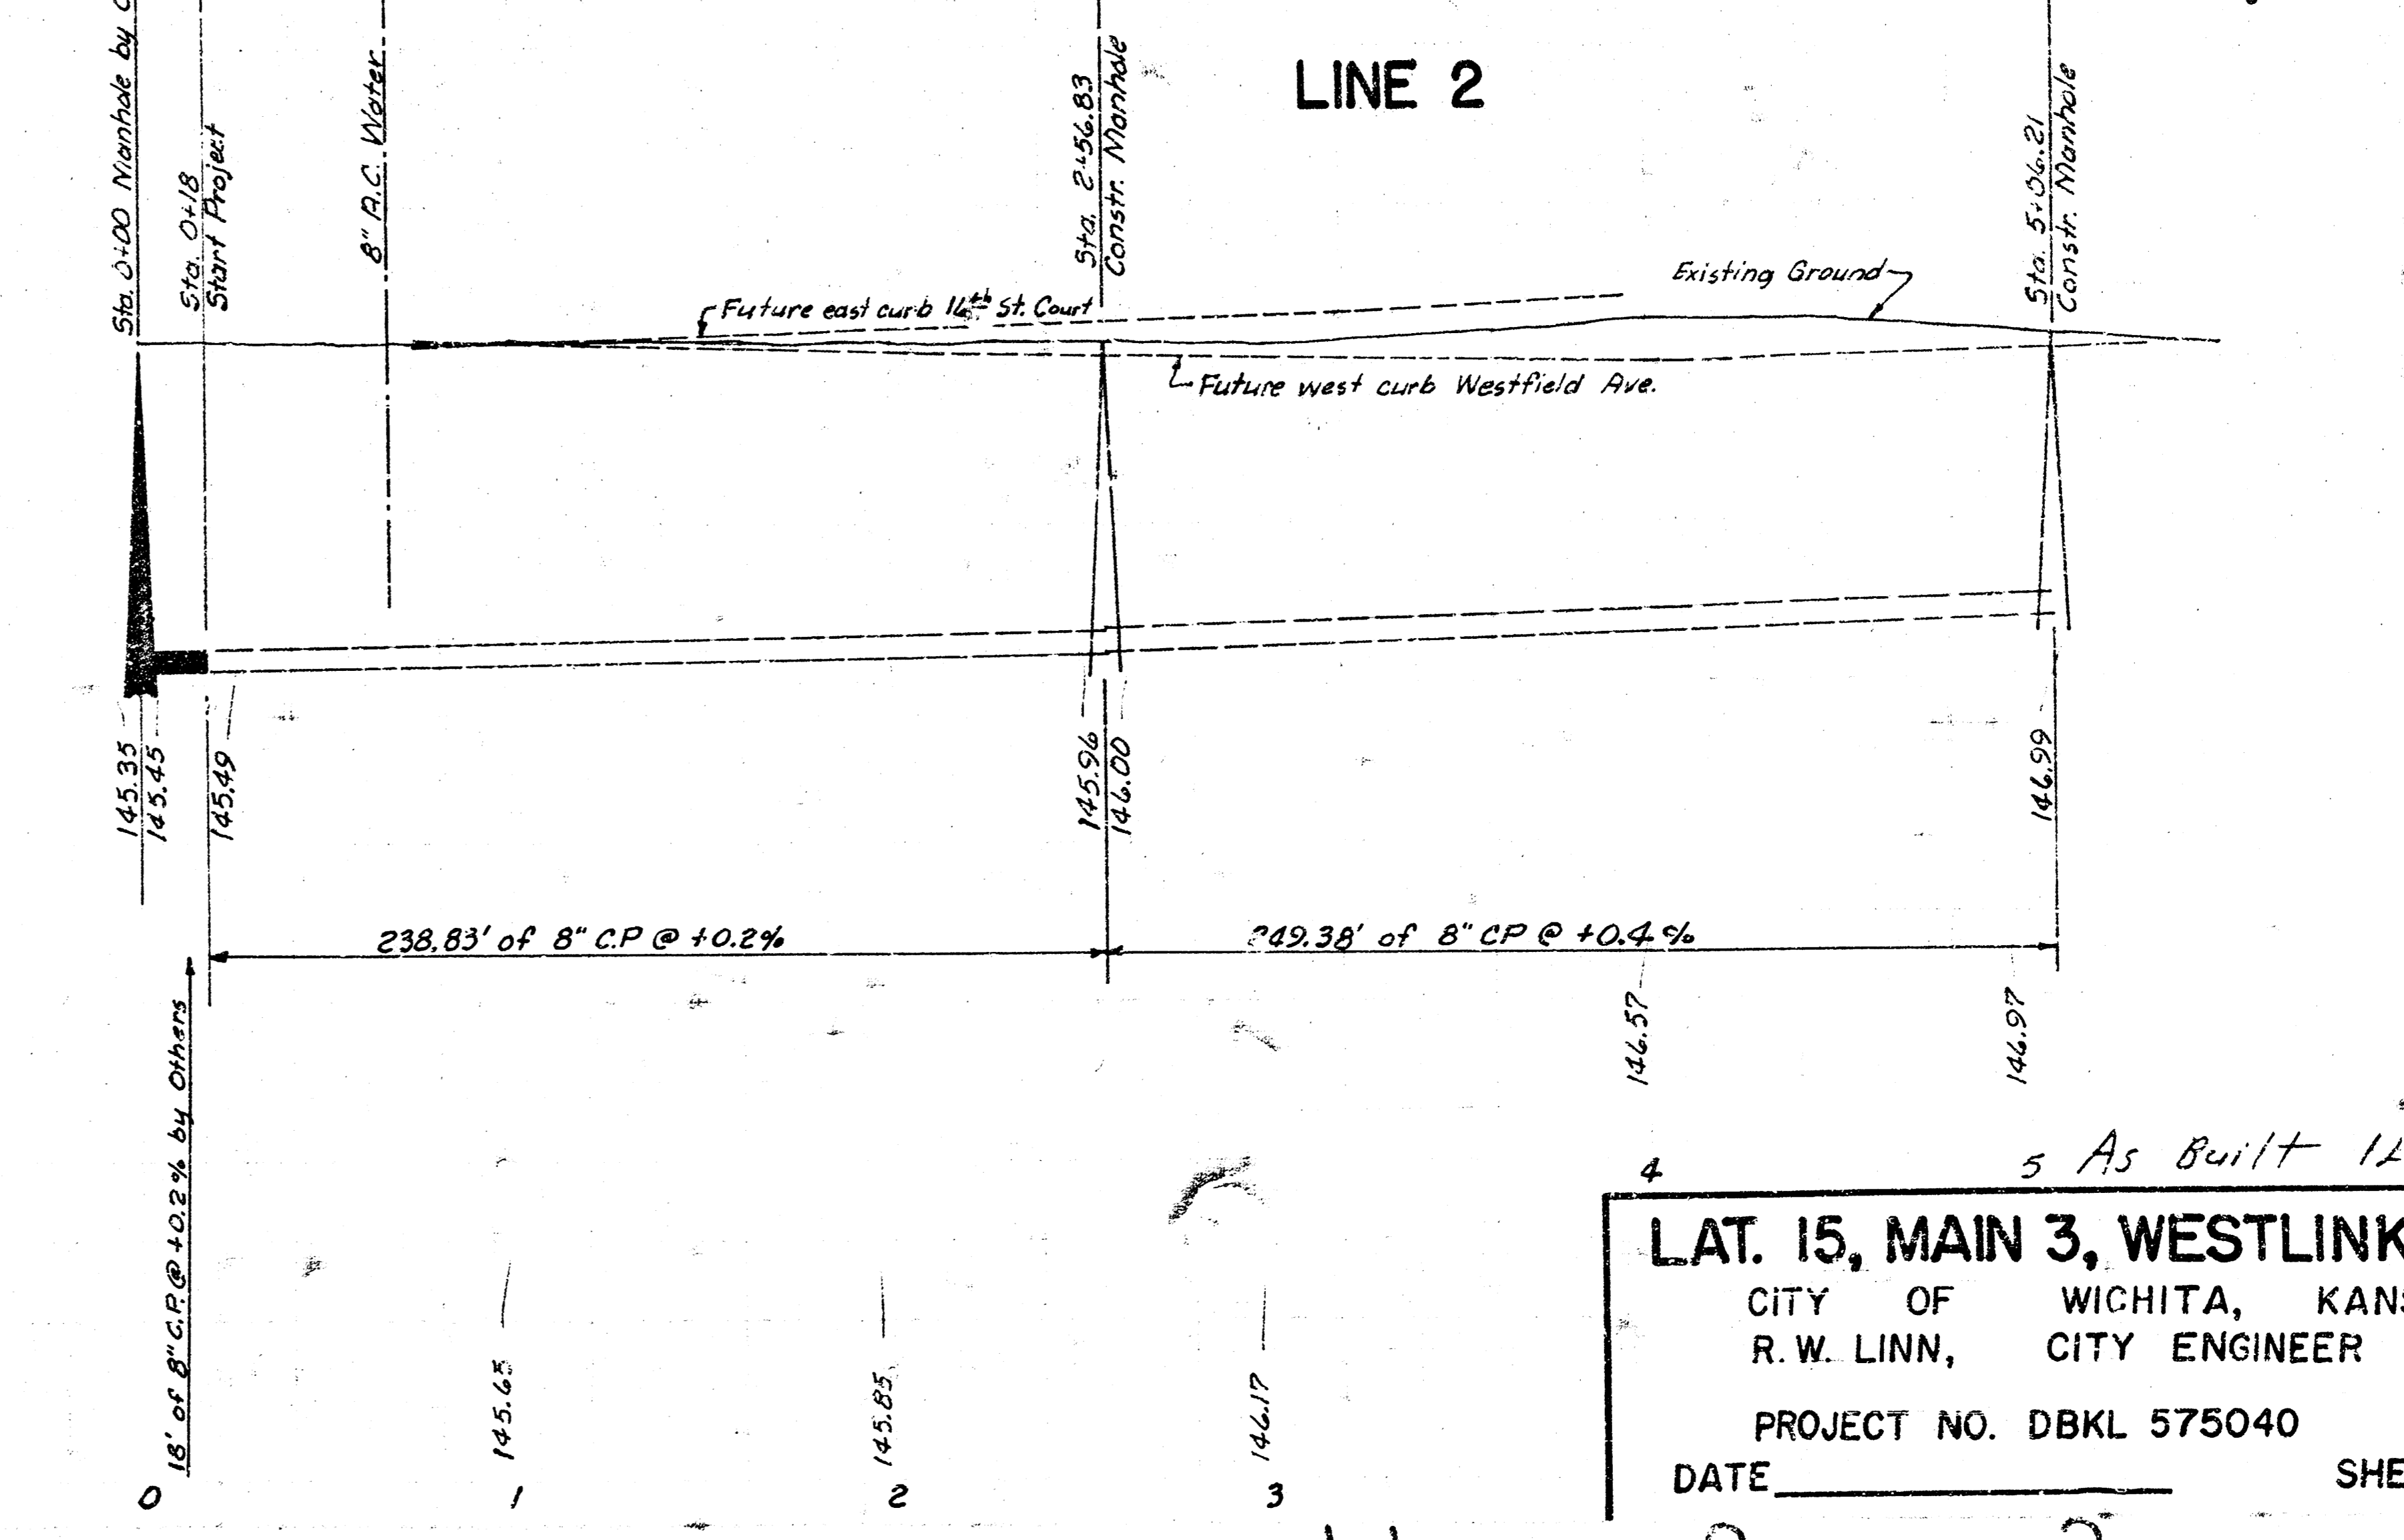

BENEFIT DISTRICT IS  
**BLOCK 2, WESTLINK VILLAGE TWELFTH ADDITION**

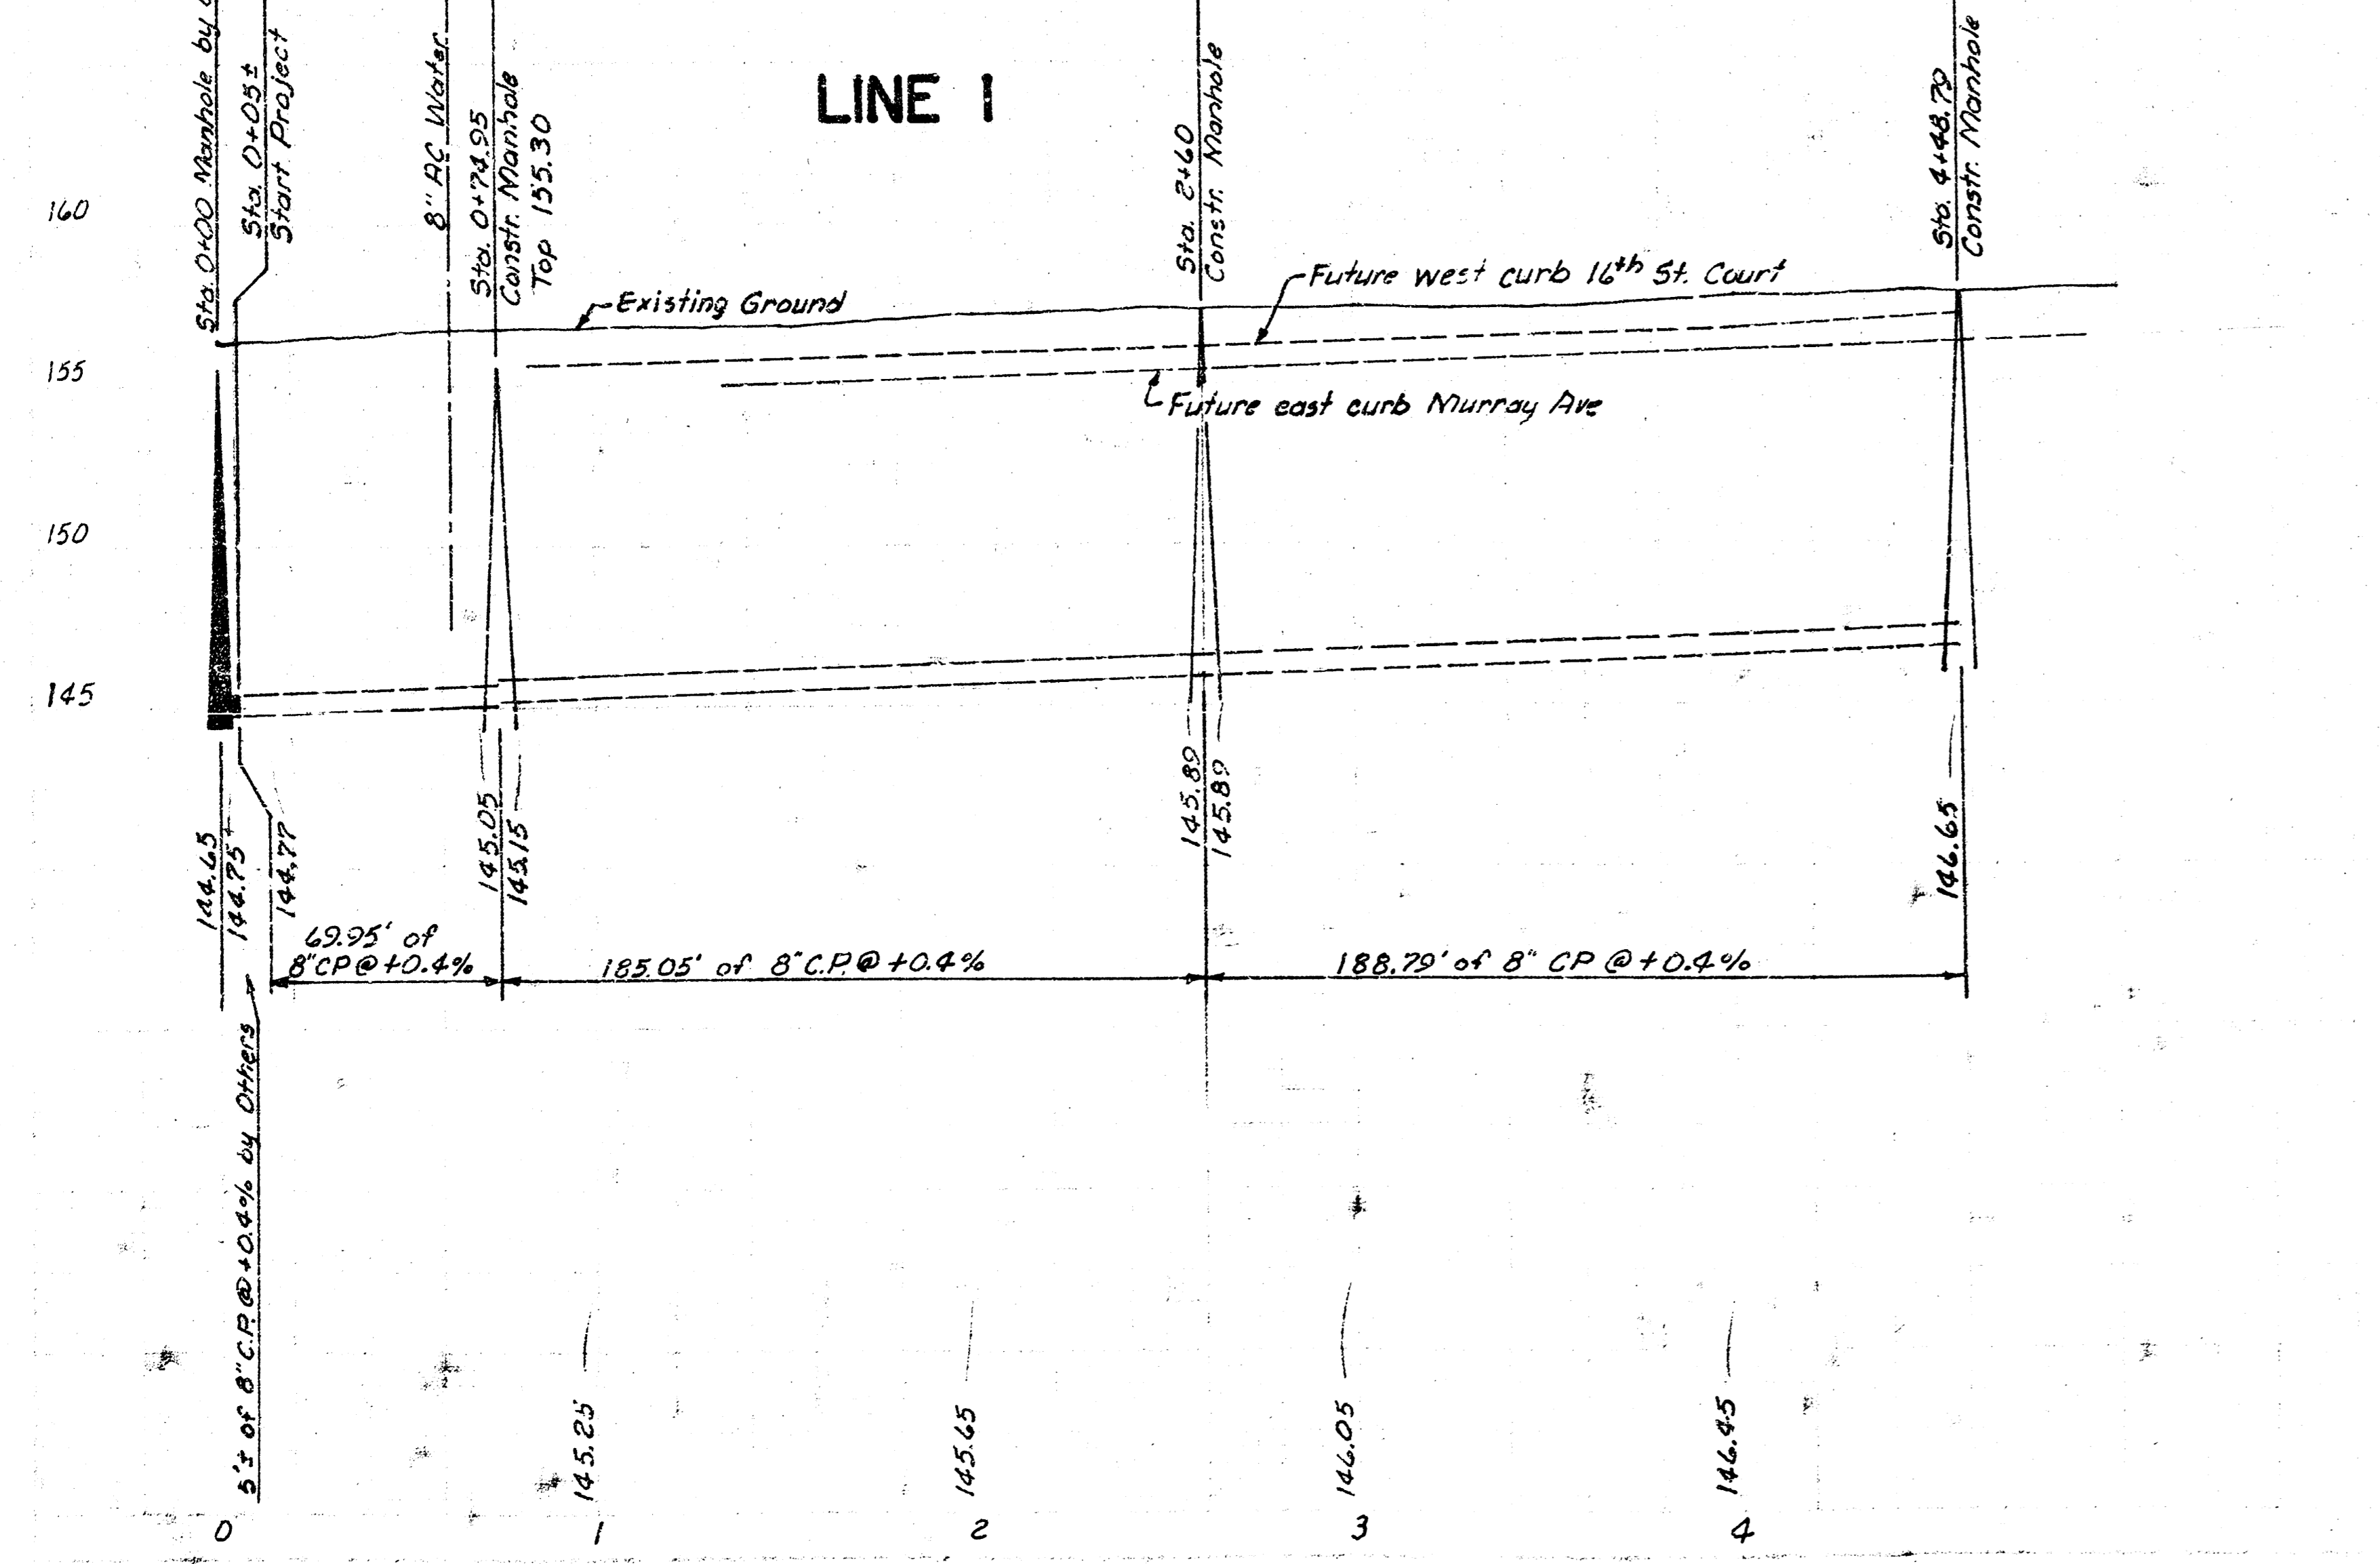

As Built 12-16-75  
**LAT. 15, MAIN 3, WESTLINK SEWER**  
CITY OF WICHITA, KANSAS  
R.W. LINN, CITY ENGINEER  
PROJECT NO. DBKL 575040  
DATE \_\_\_\_\_ SHEET 1 OF 1