


LAT 1, MAIN 4, WESTLINK SEWER
(PHASE I)
CITY OF WICHITA

R.W. BRUGGEMAN - DIRECTOR OF ENGINEERING /

CITY ENGINEER

JAMESBURG PARK ADDITION

PROJECT NO. 468-76-245-80981-000-000-001

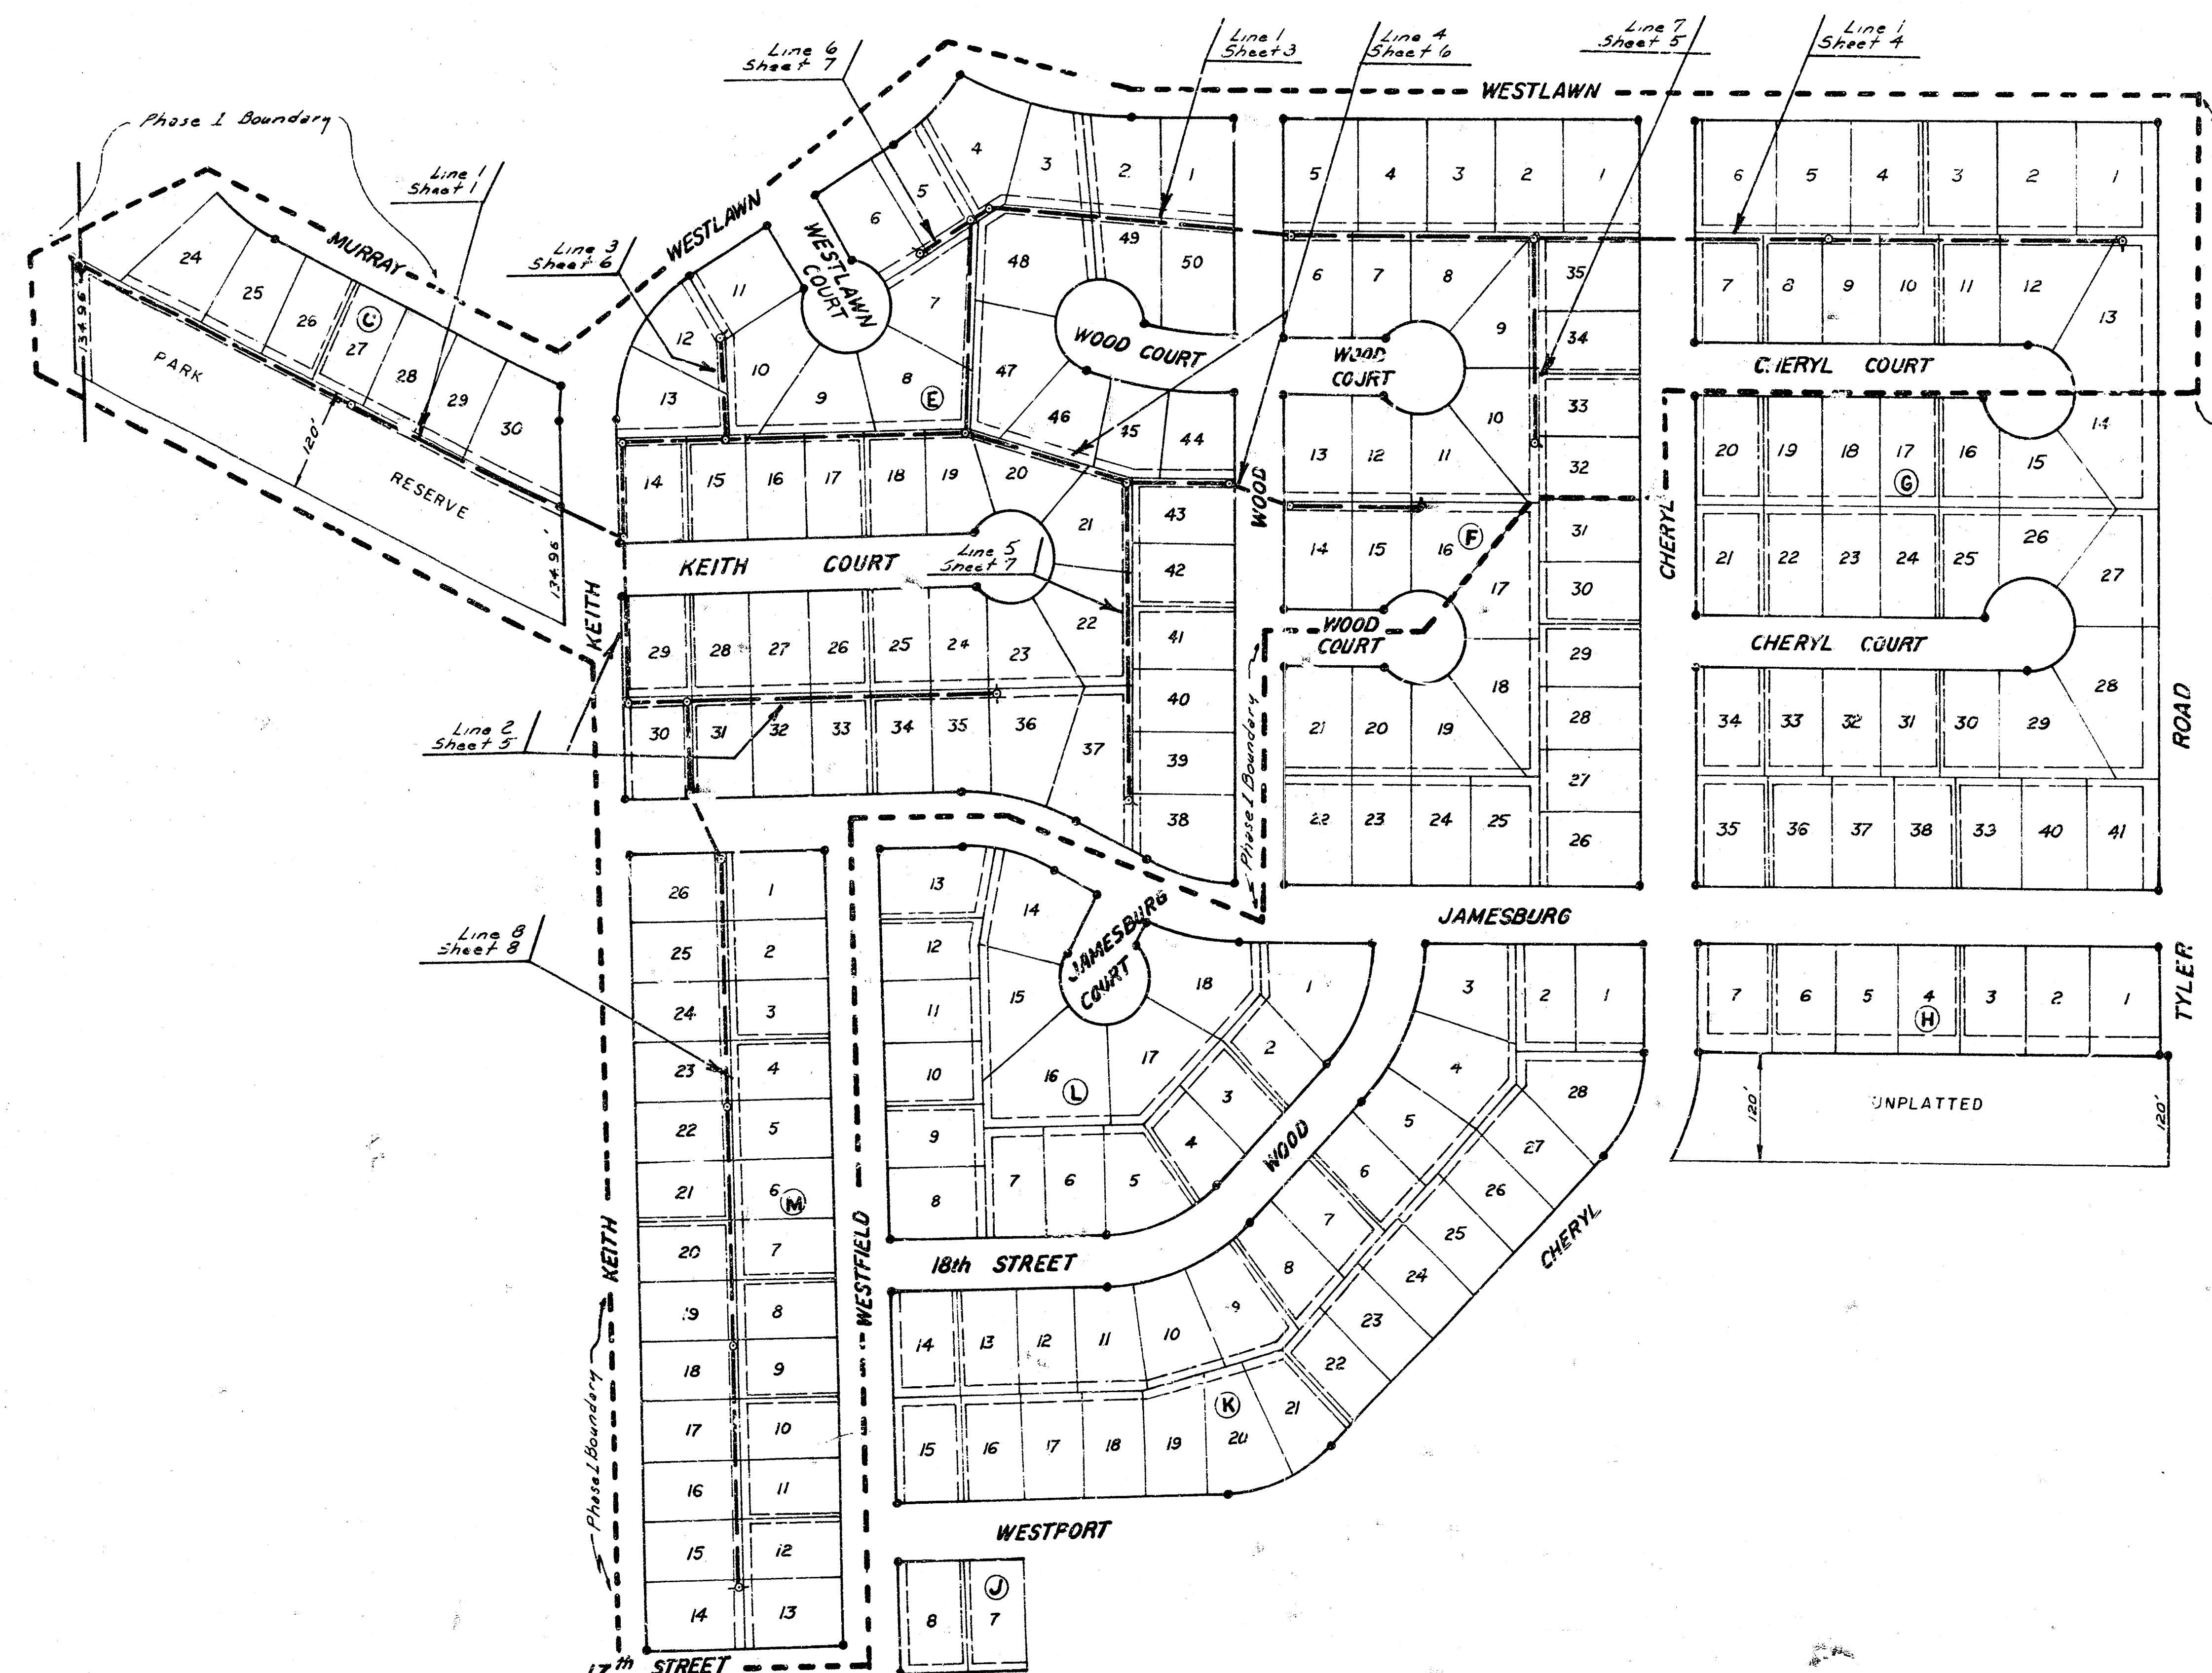


NOTE: TOPS OF MANHOLES SHALL BE SET 0.4' ABOVE EXISTING GROUND EXCEPT WHERE A SPECIFIC ELEVATION IS SHOWN ON PLANS.


NOTE: All 8" & 4" Pipe on this Pipe, or V.C.P. (for grades


Composite


As Built
8/81

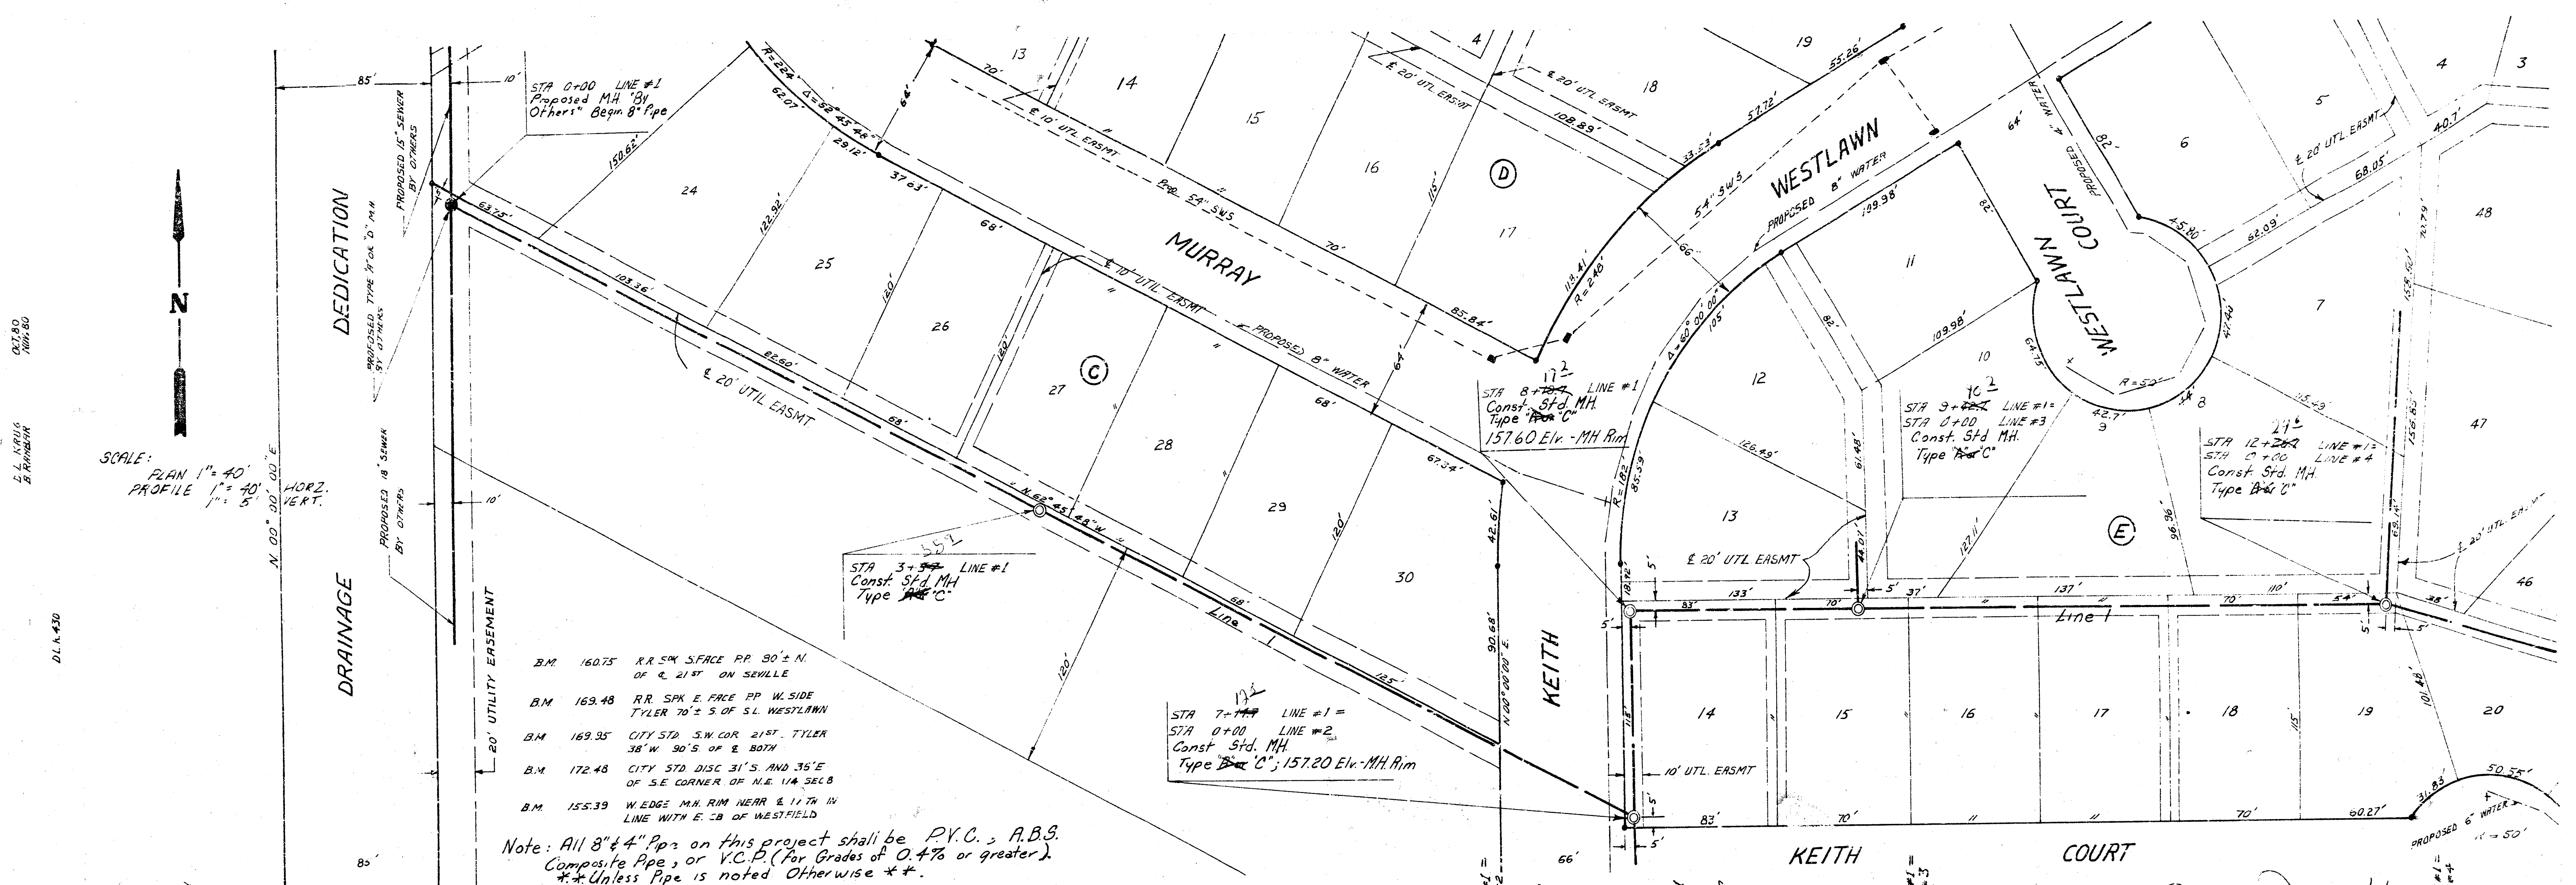

As Built
8/81
JL




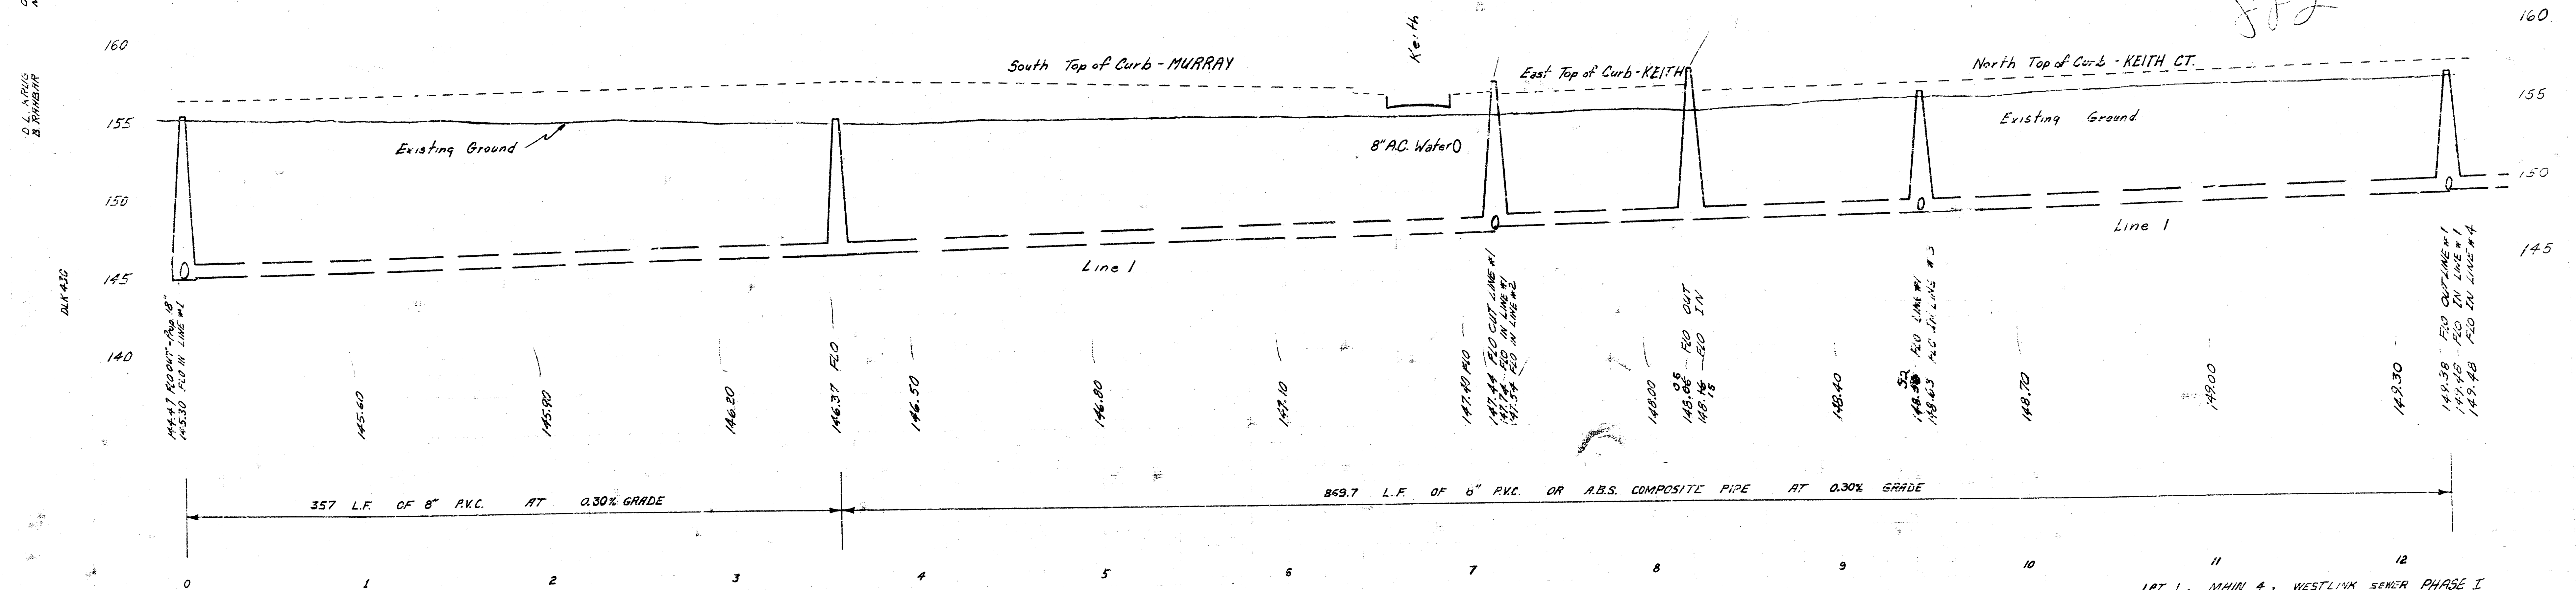


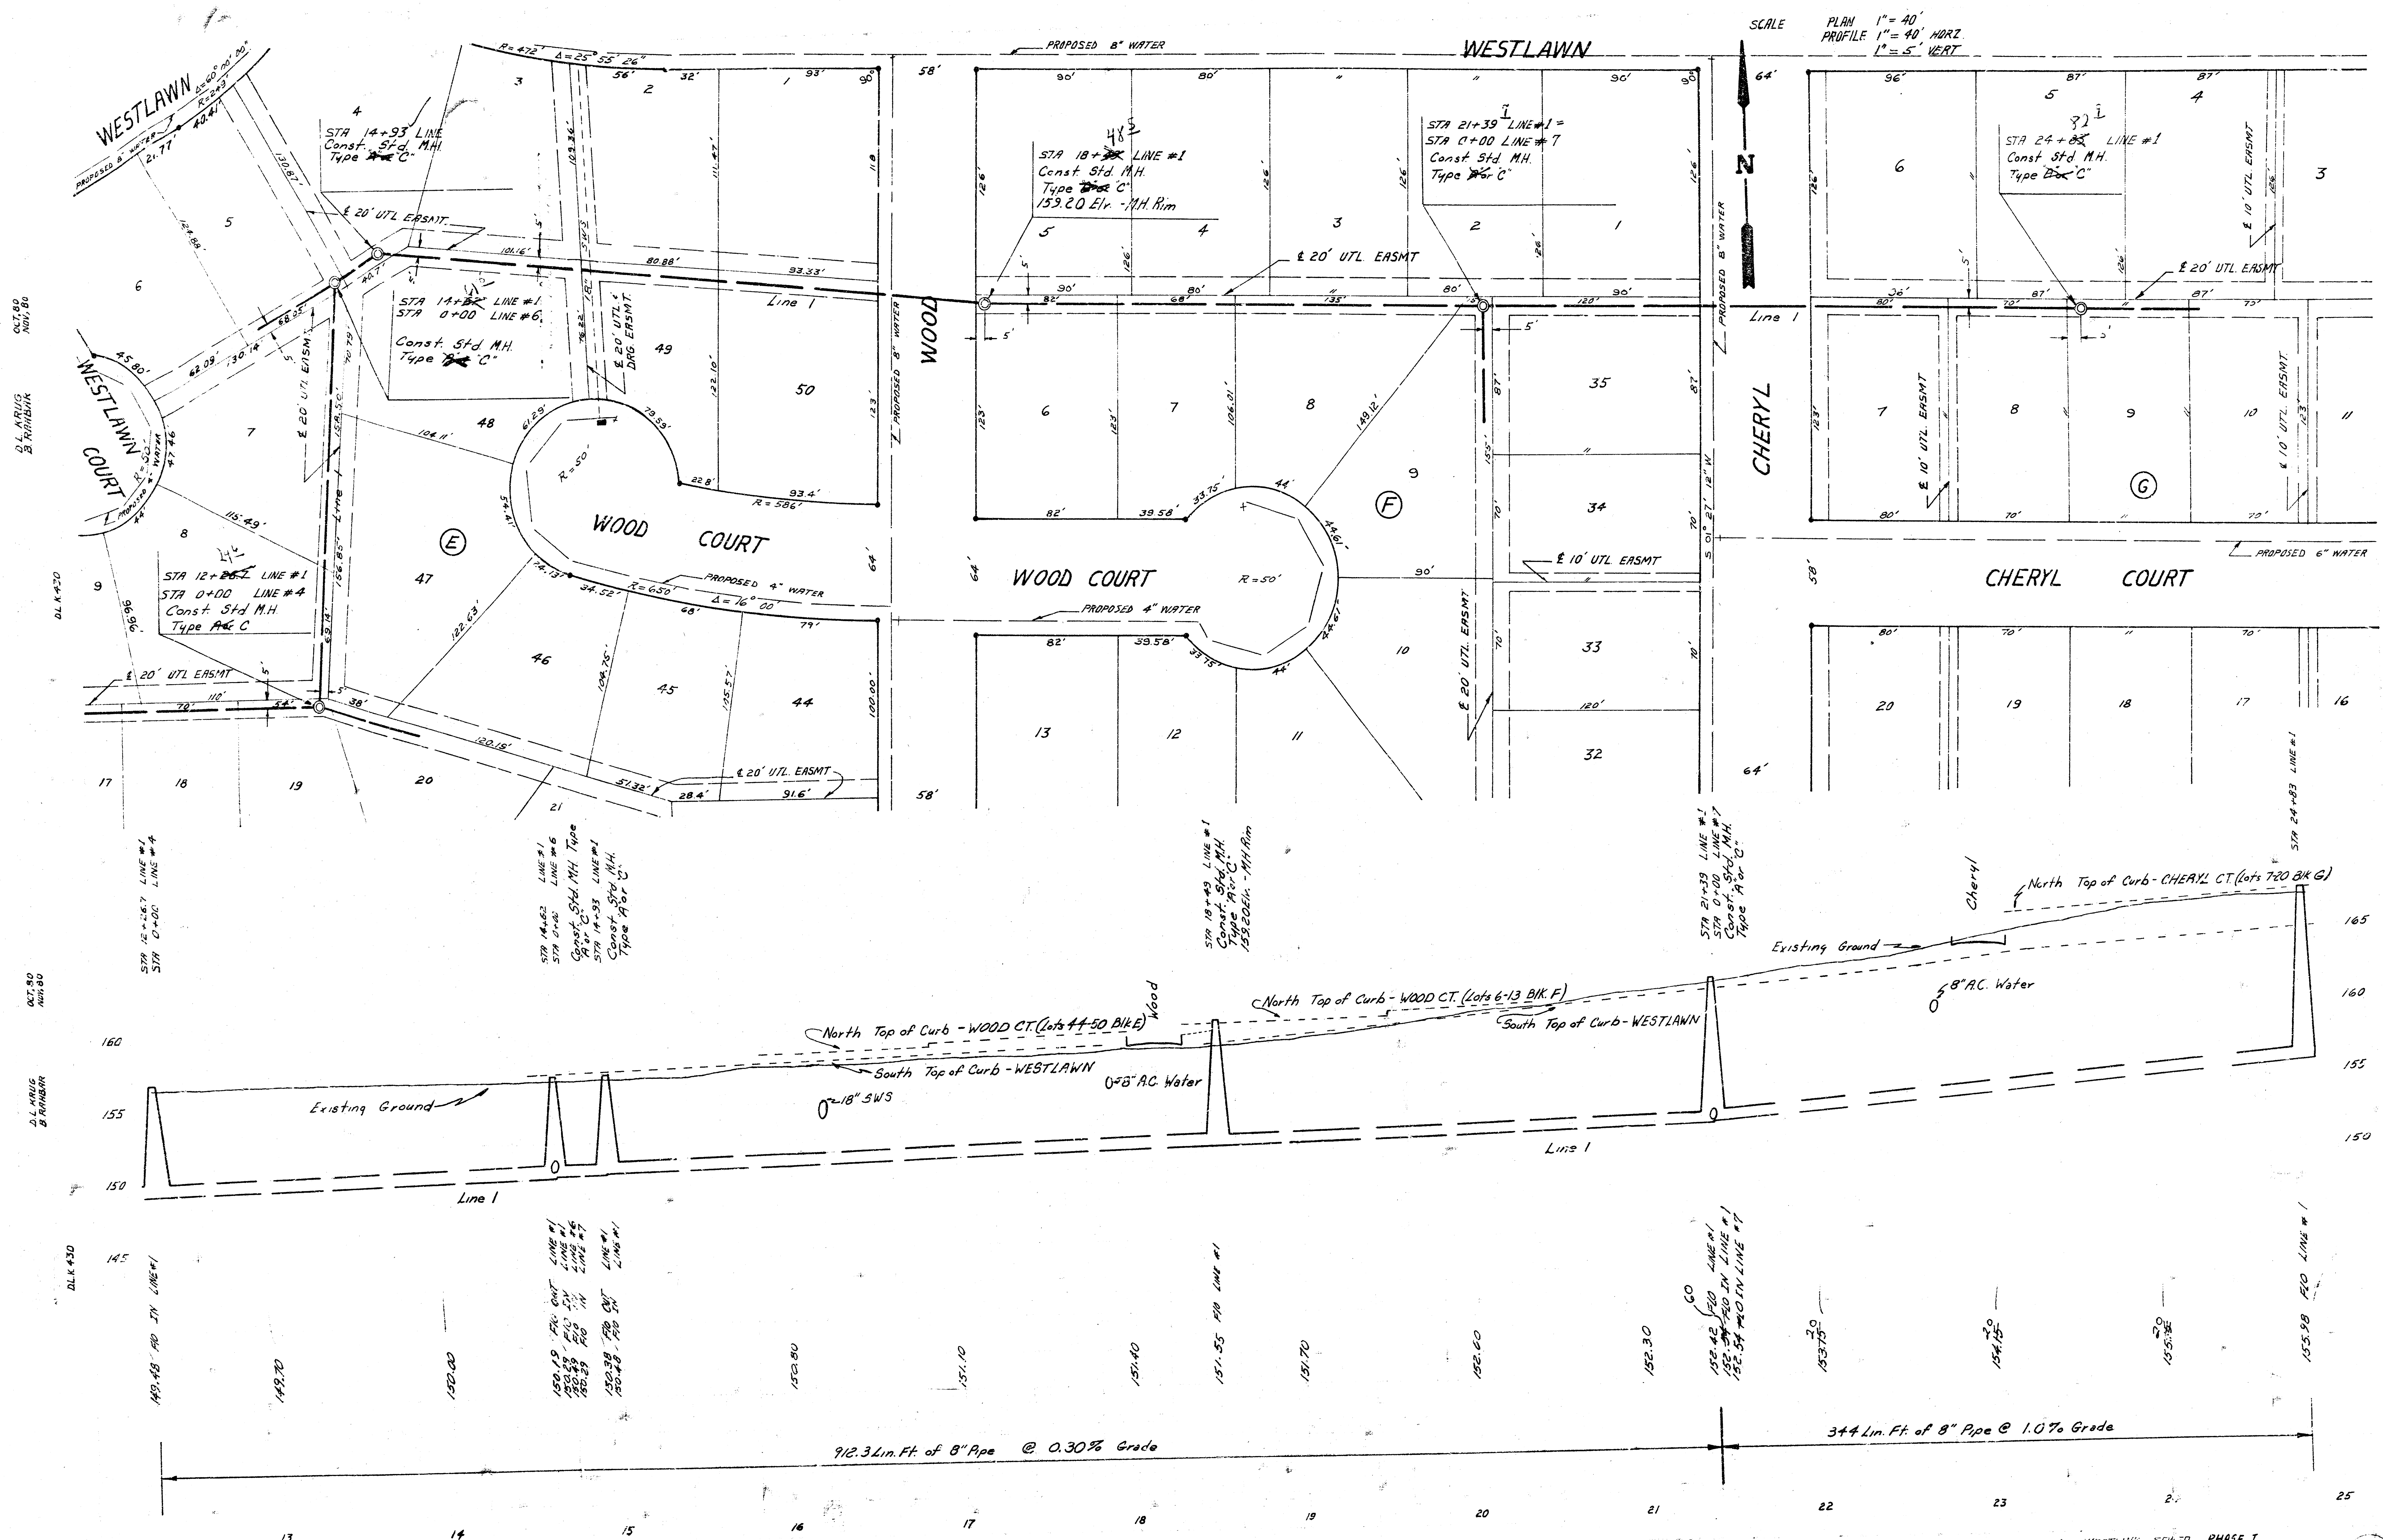

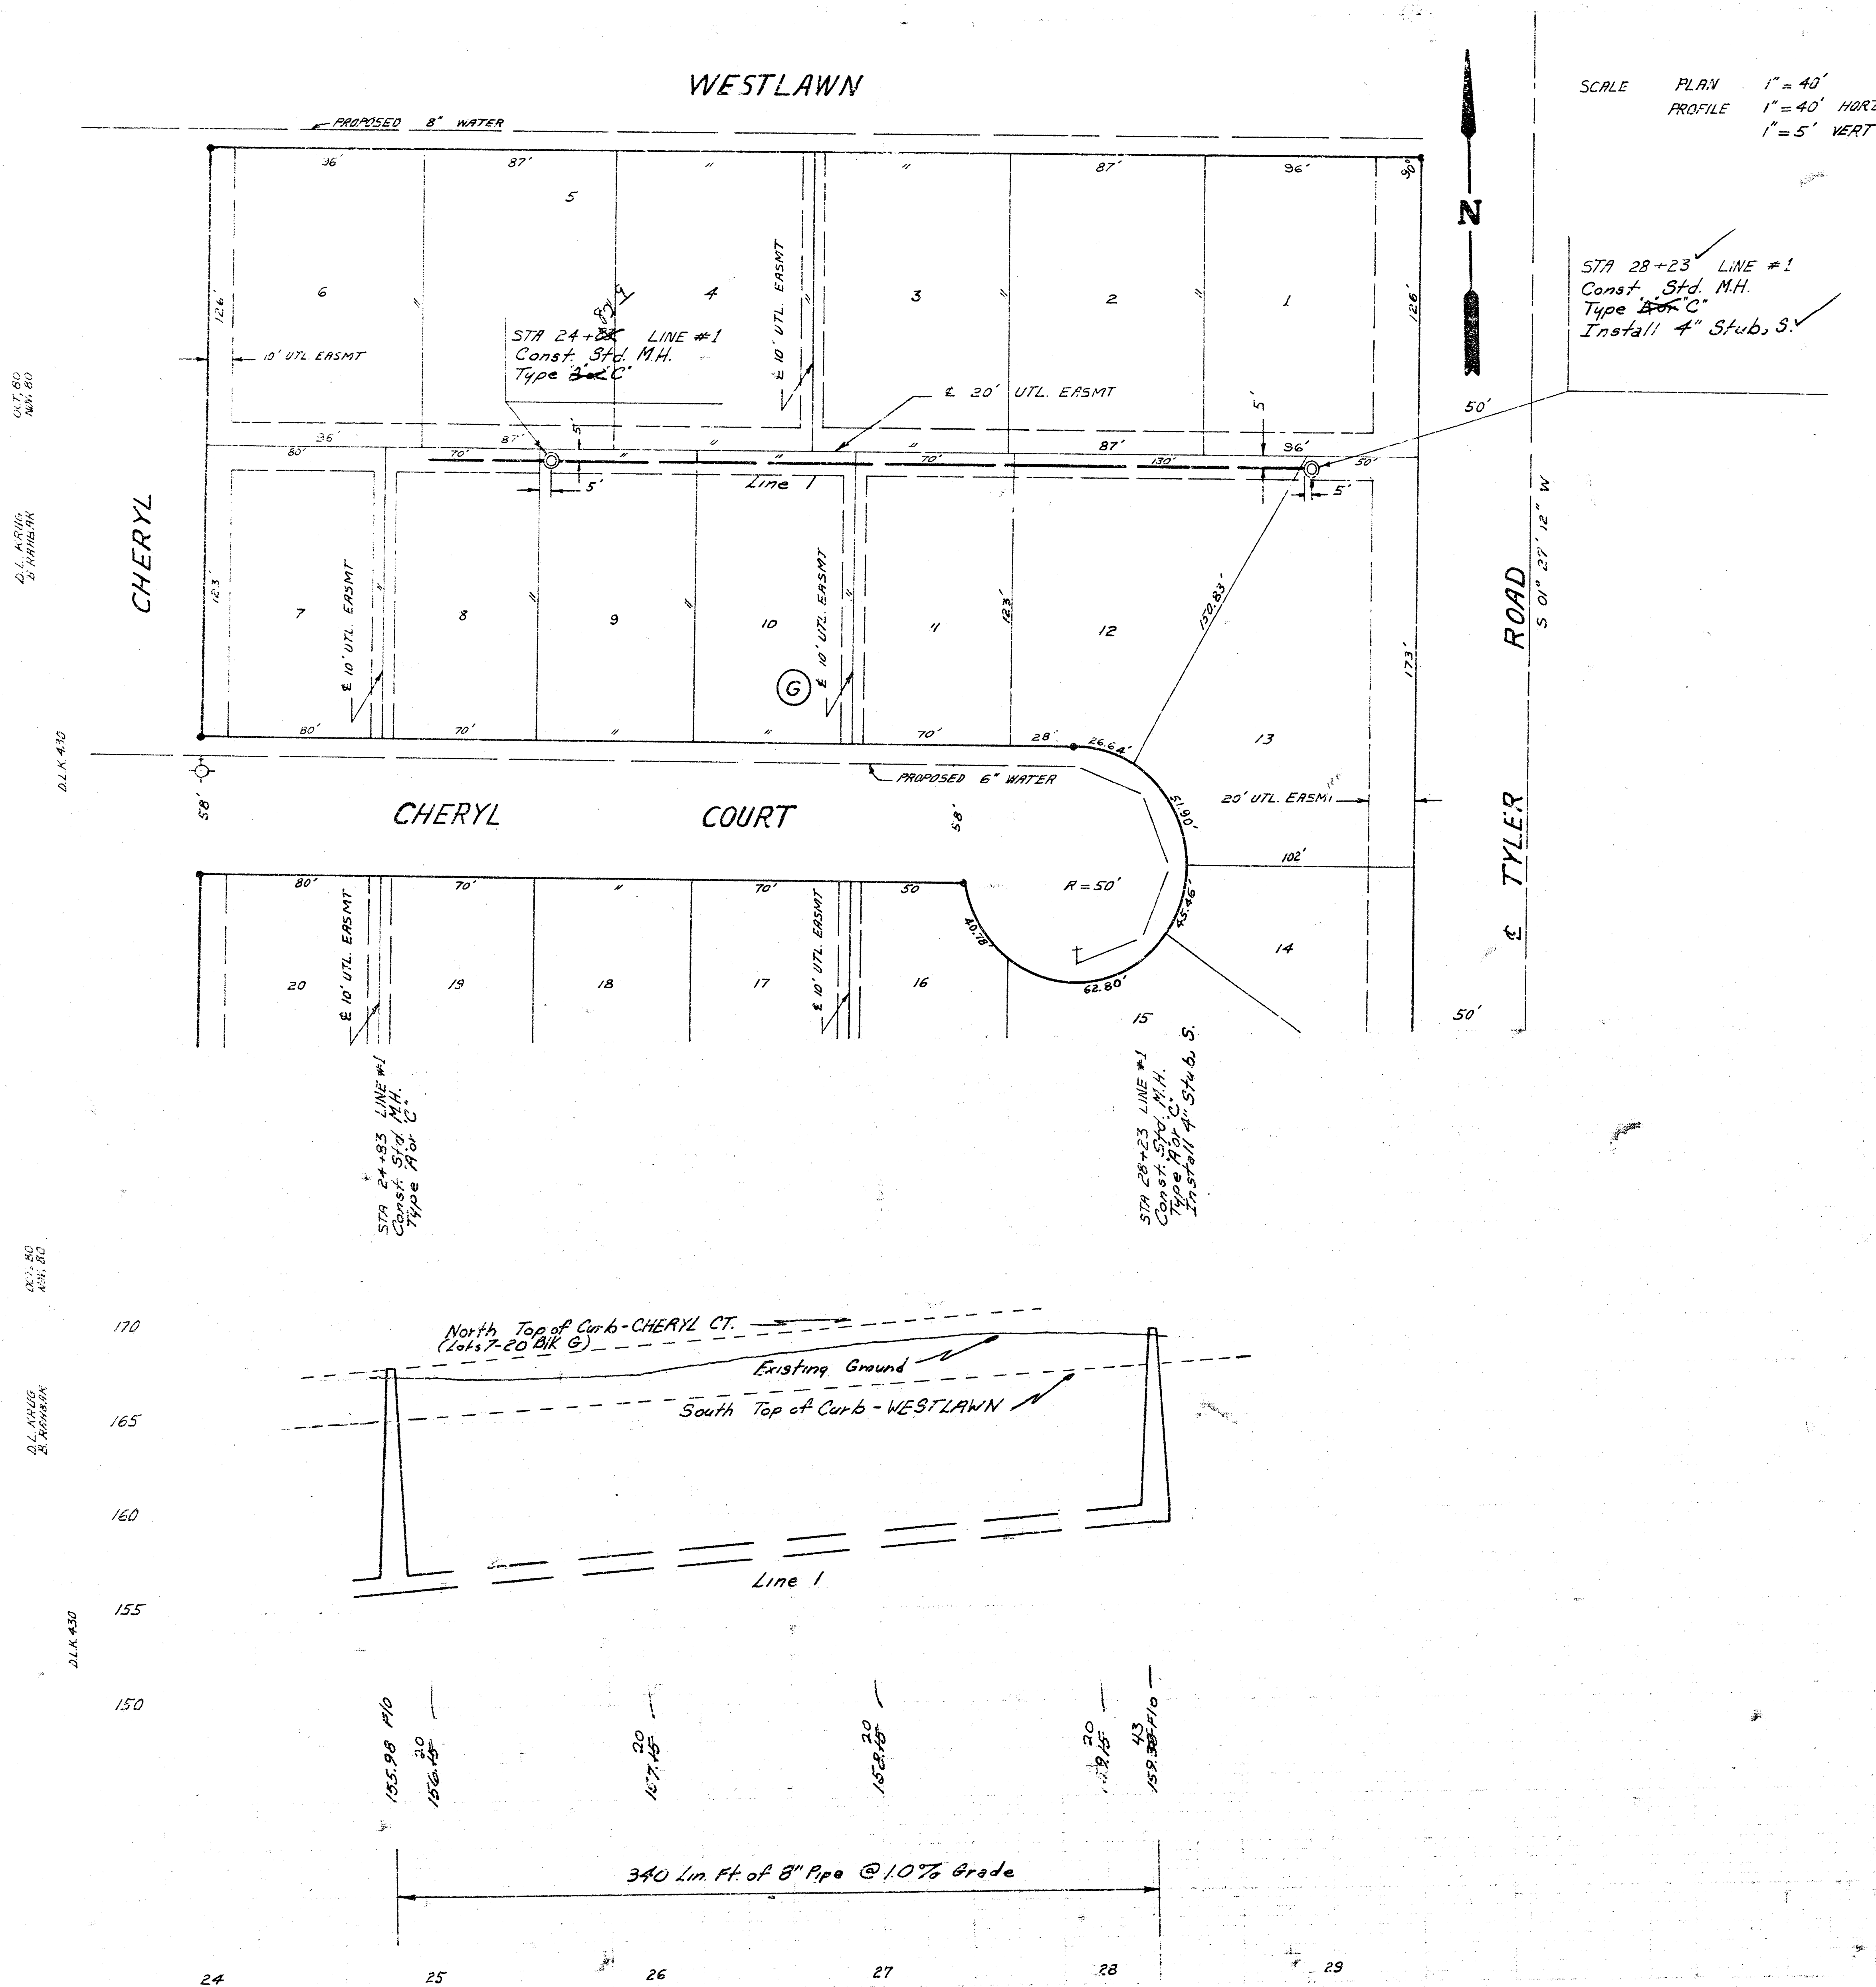



As BUILT
 JLL
 8/8/

SCAL: Plan 1"=40'
 Profile 1"=40' Horiz.
 Profile 1"=5' Vert.

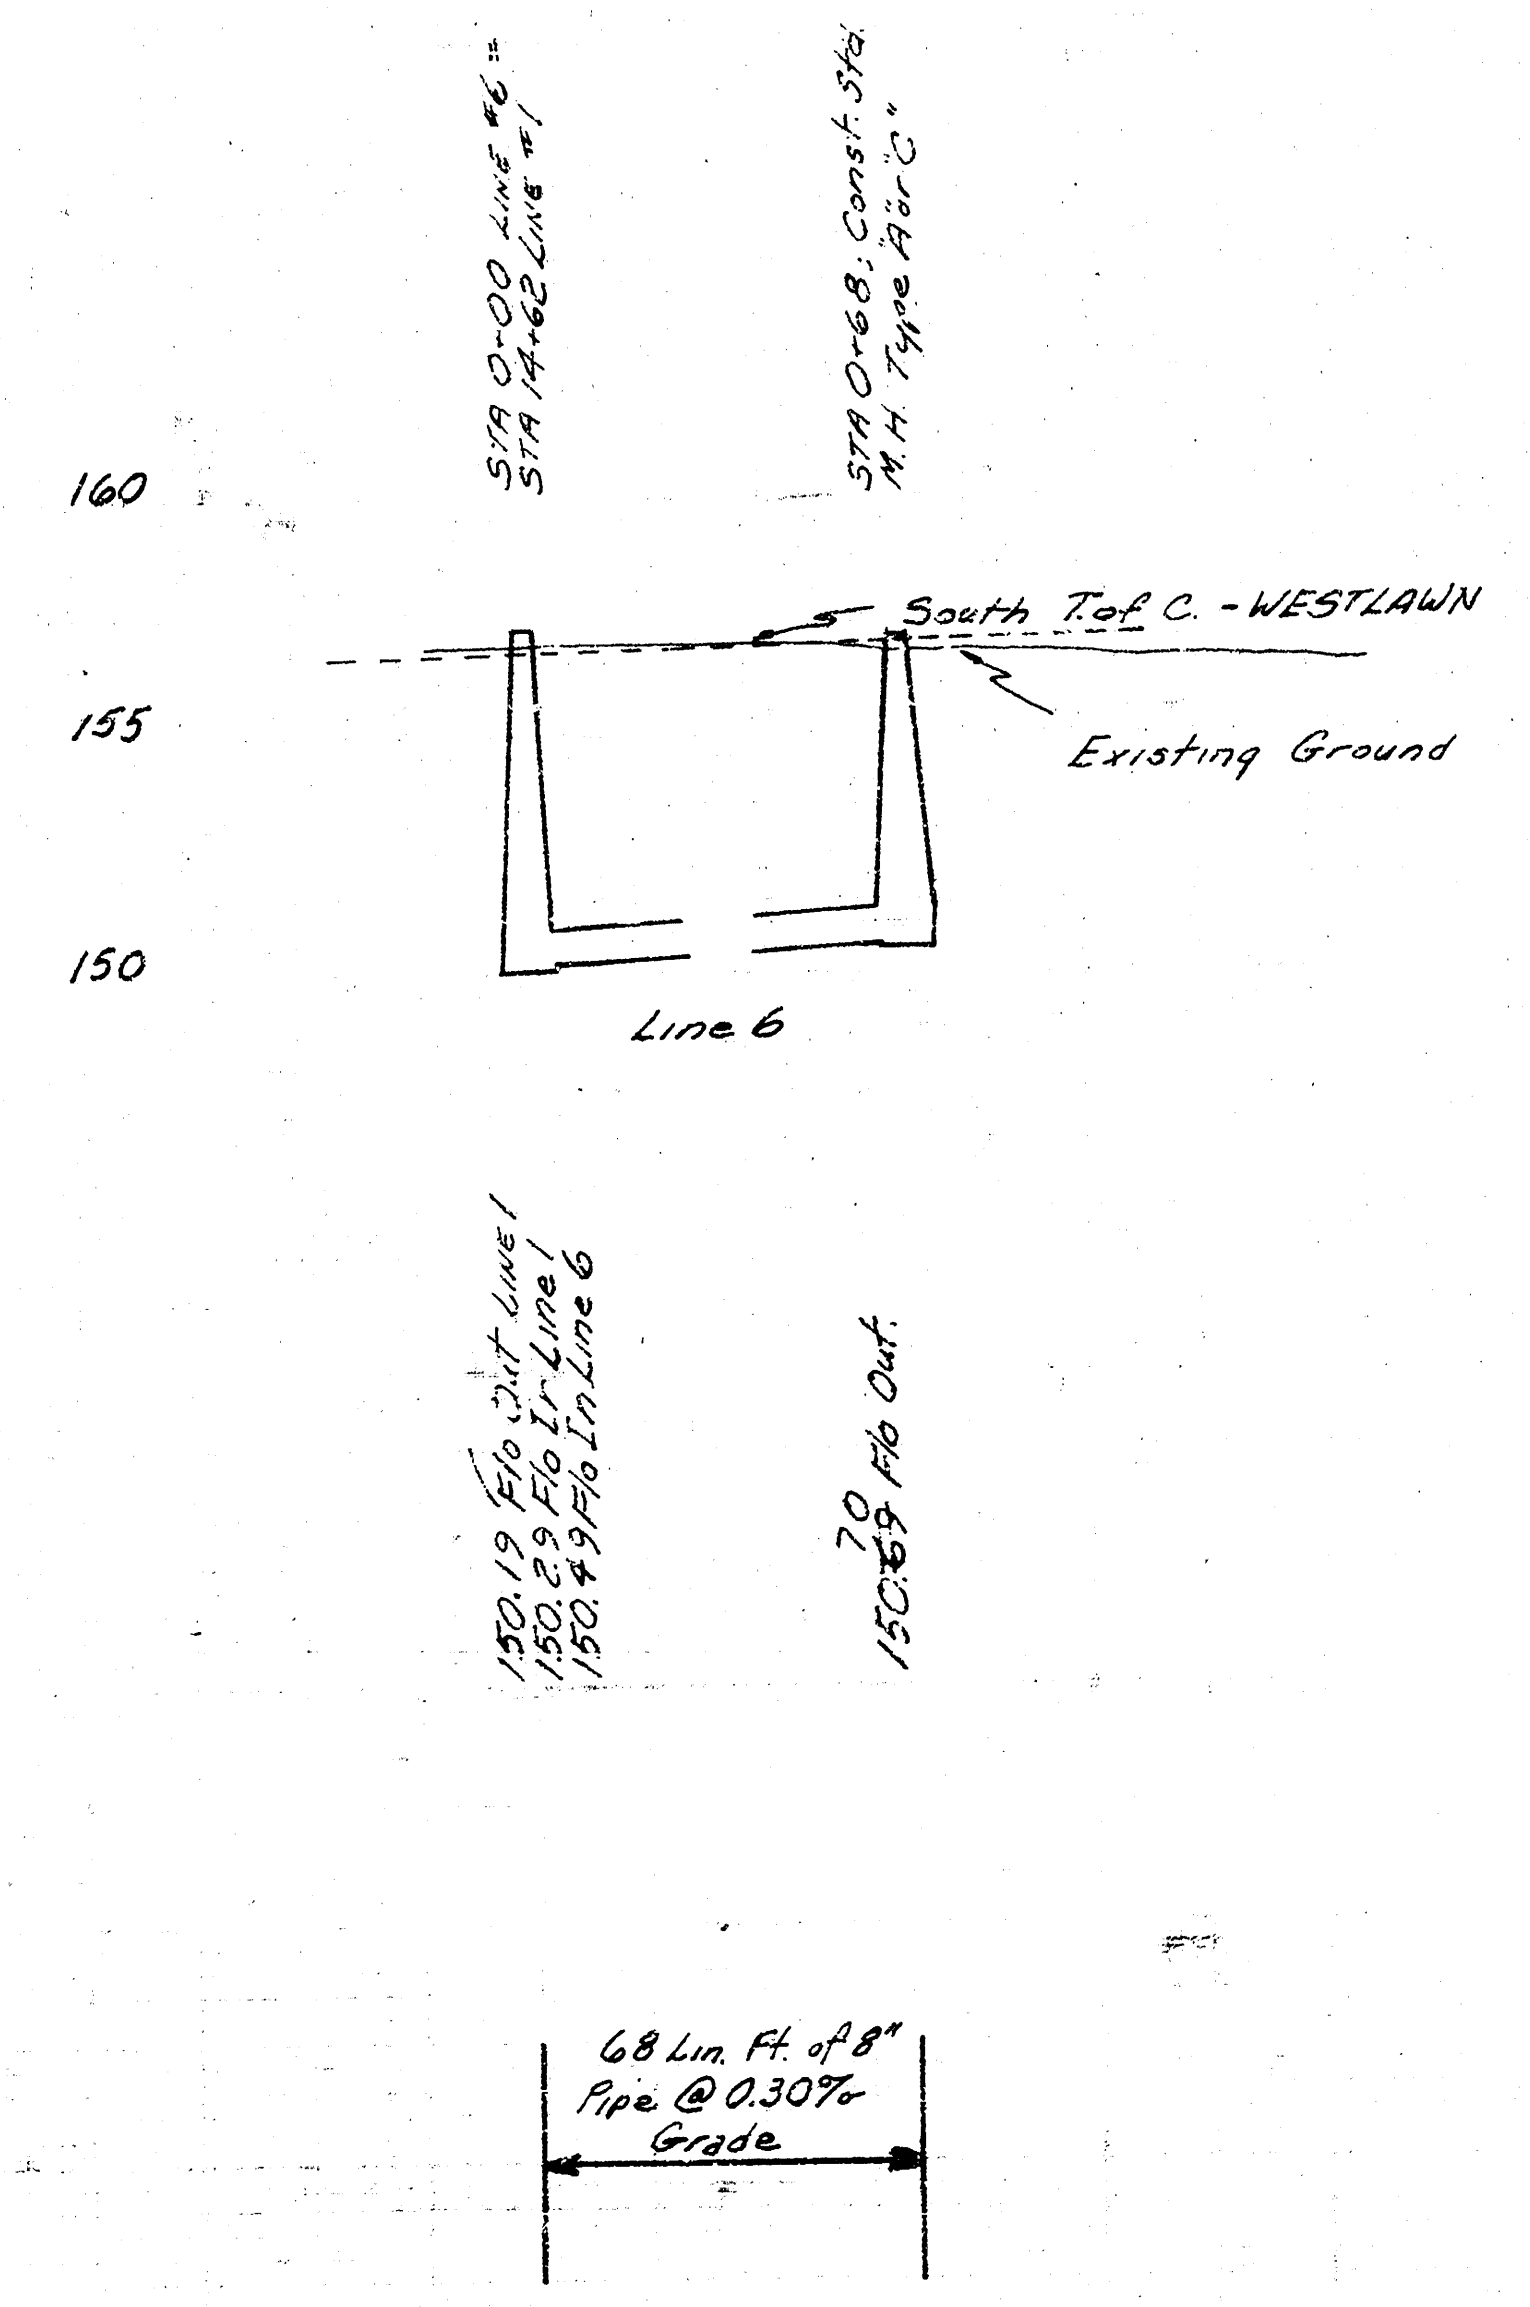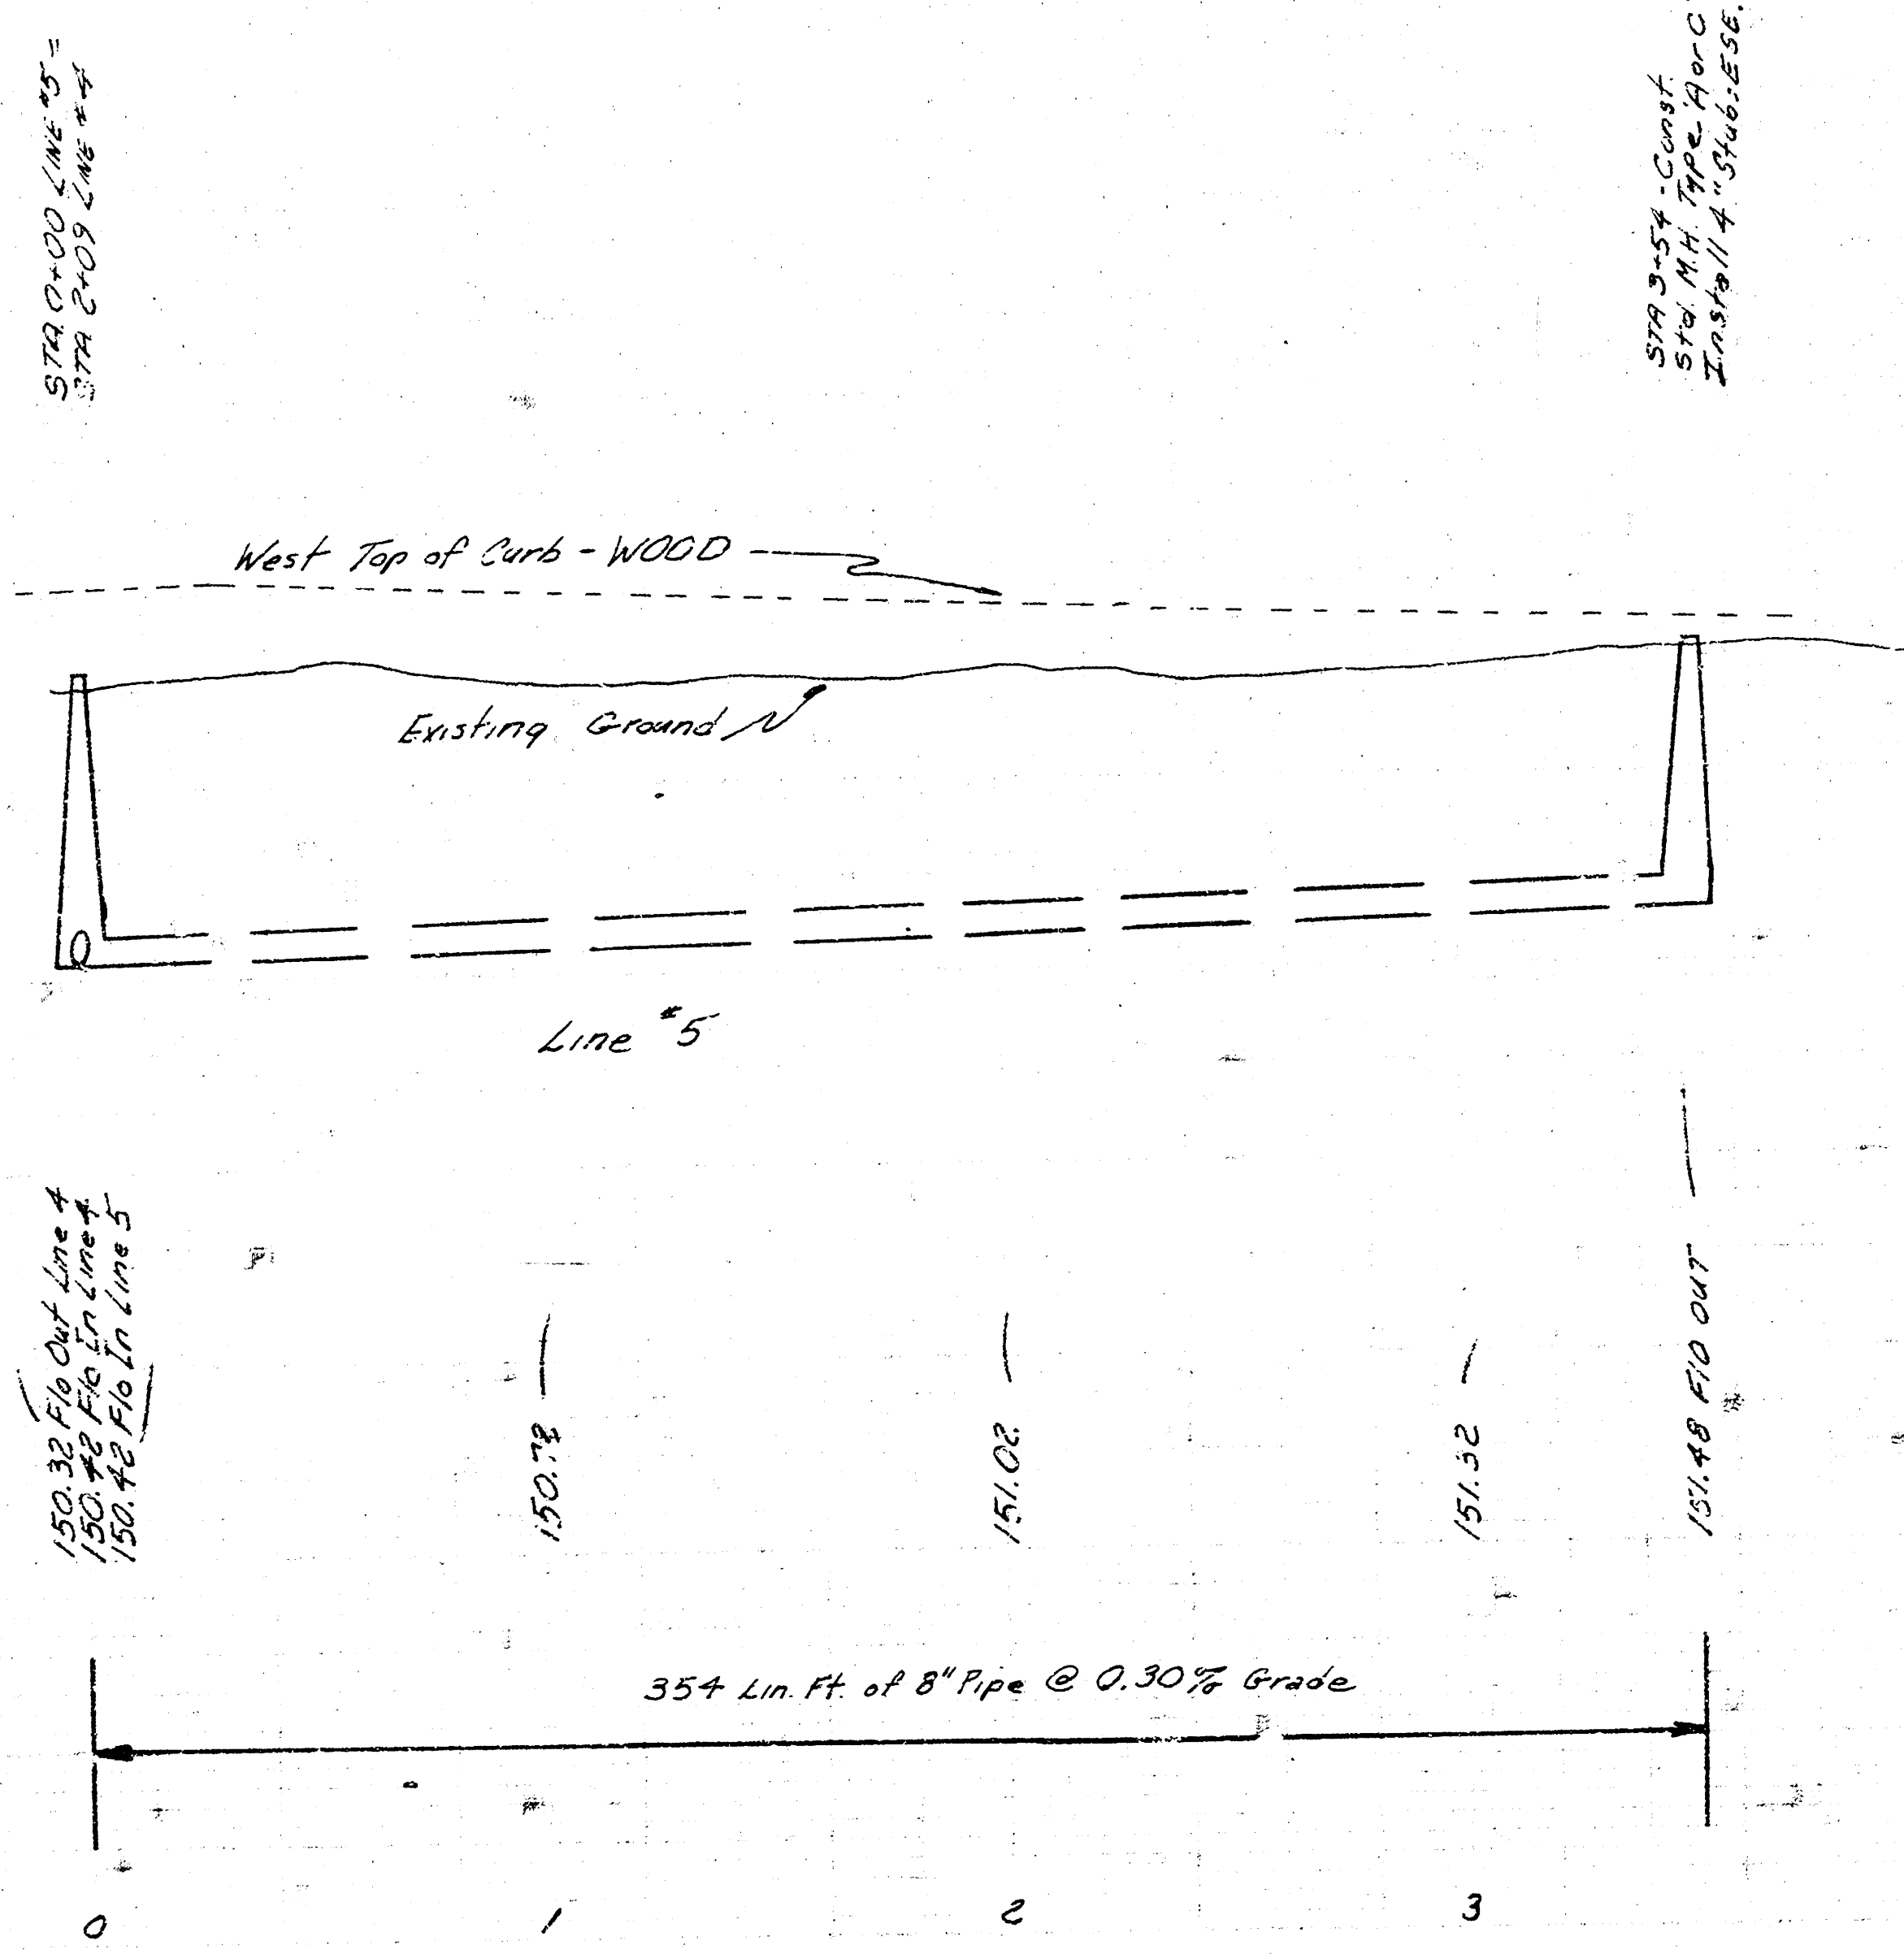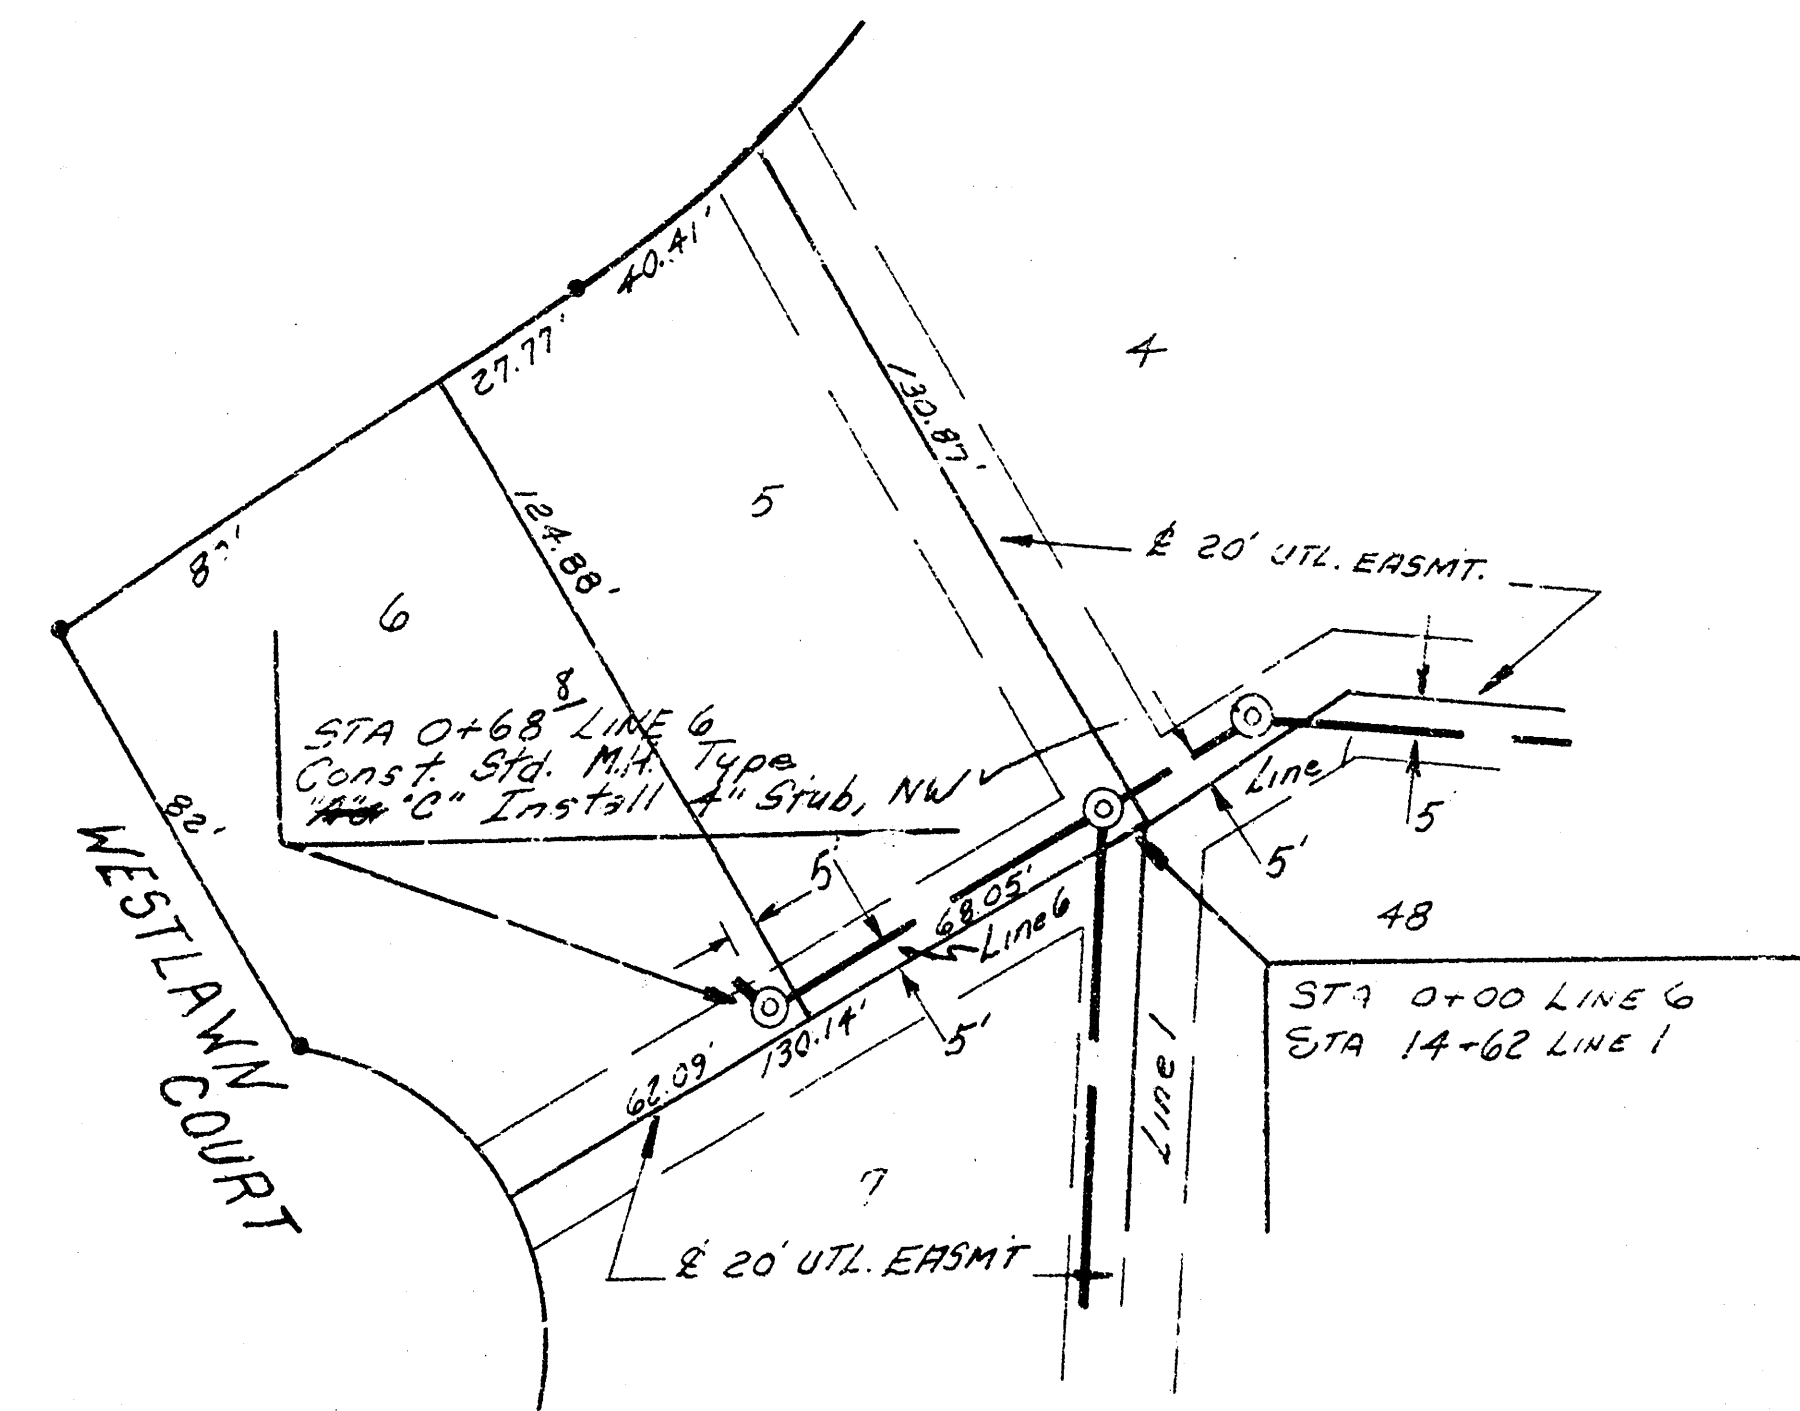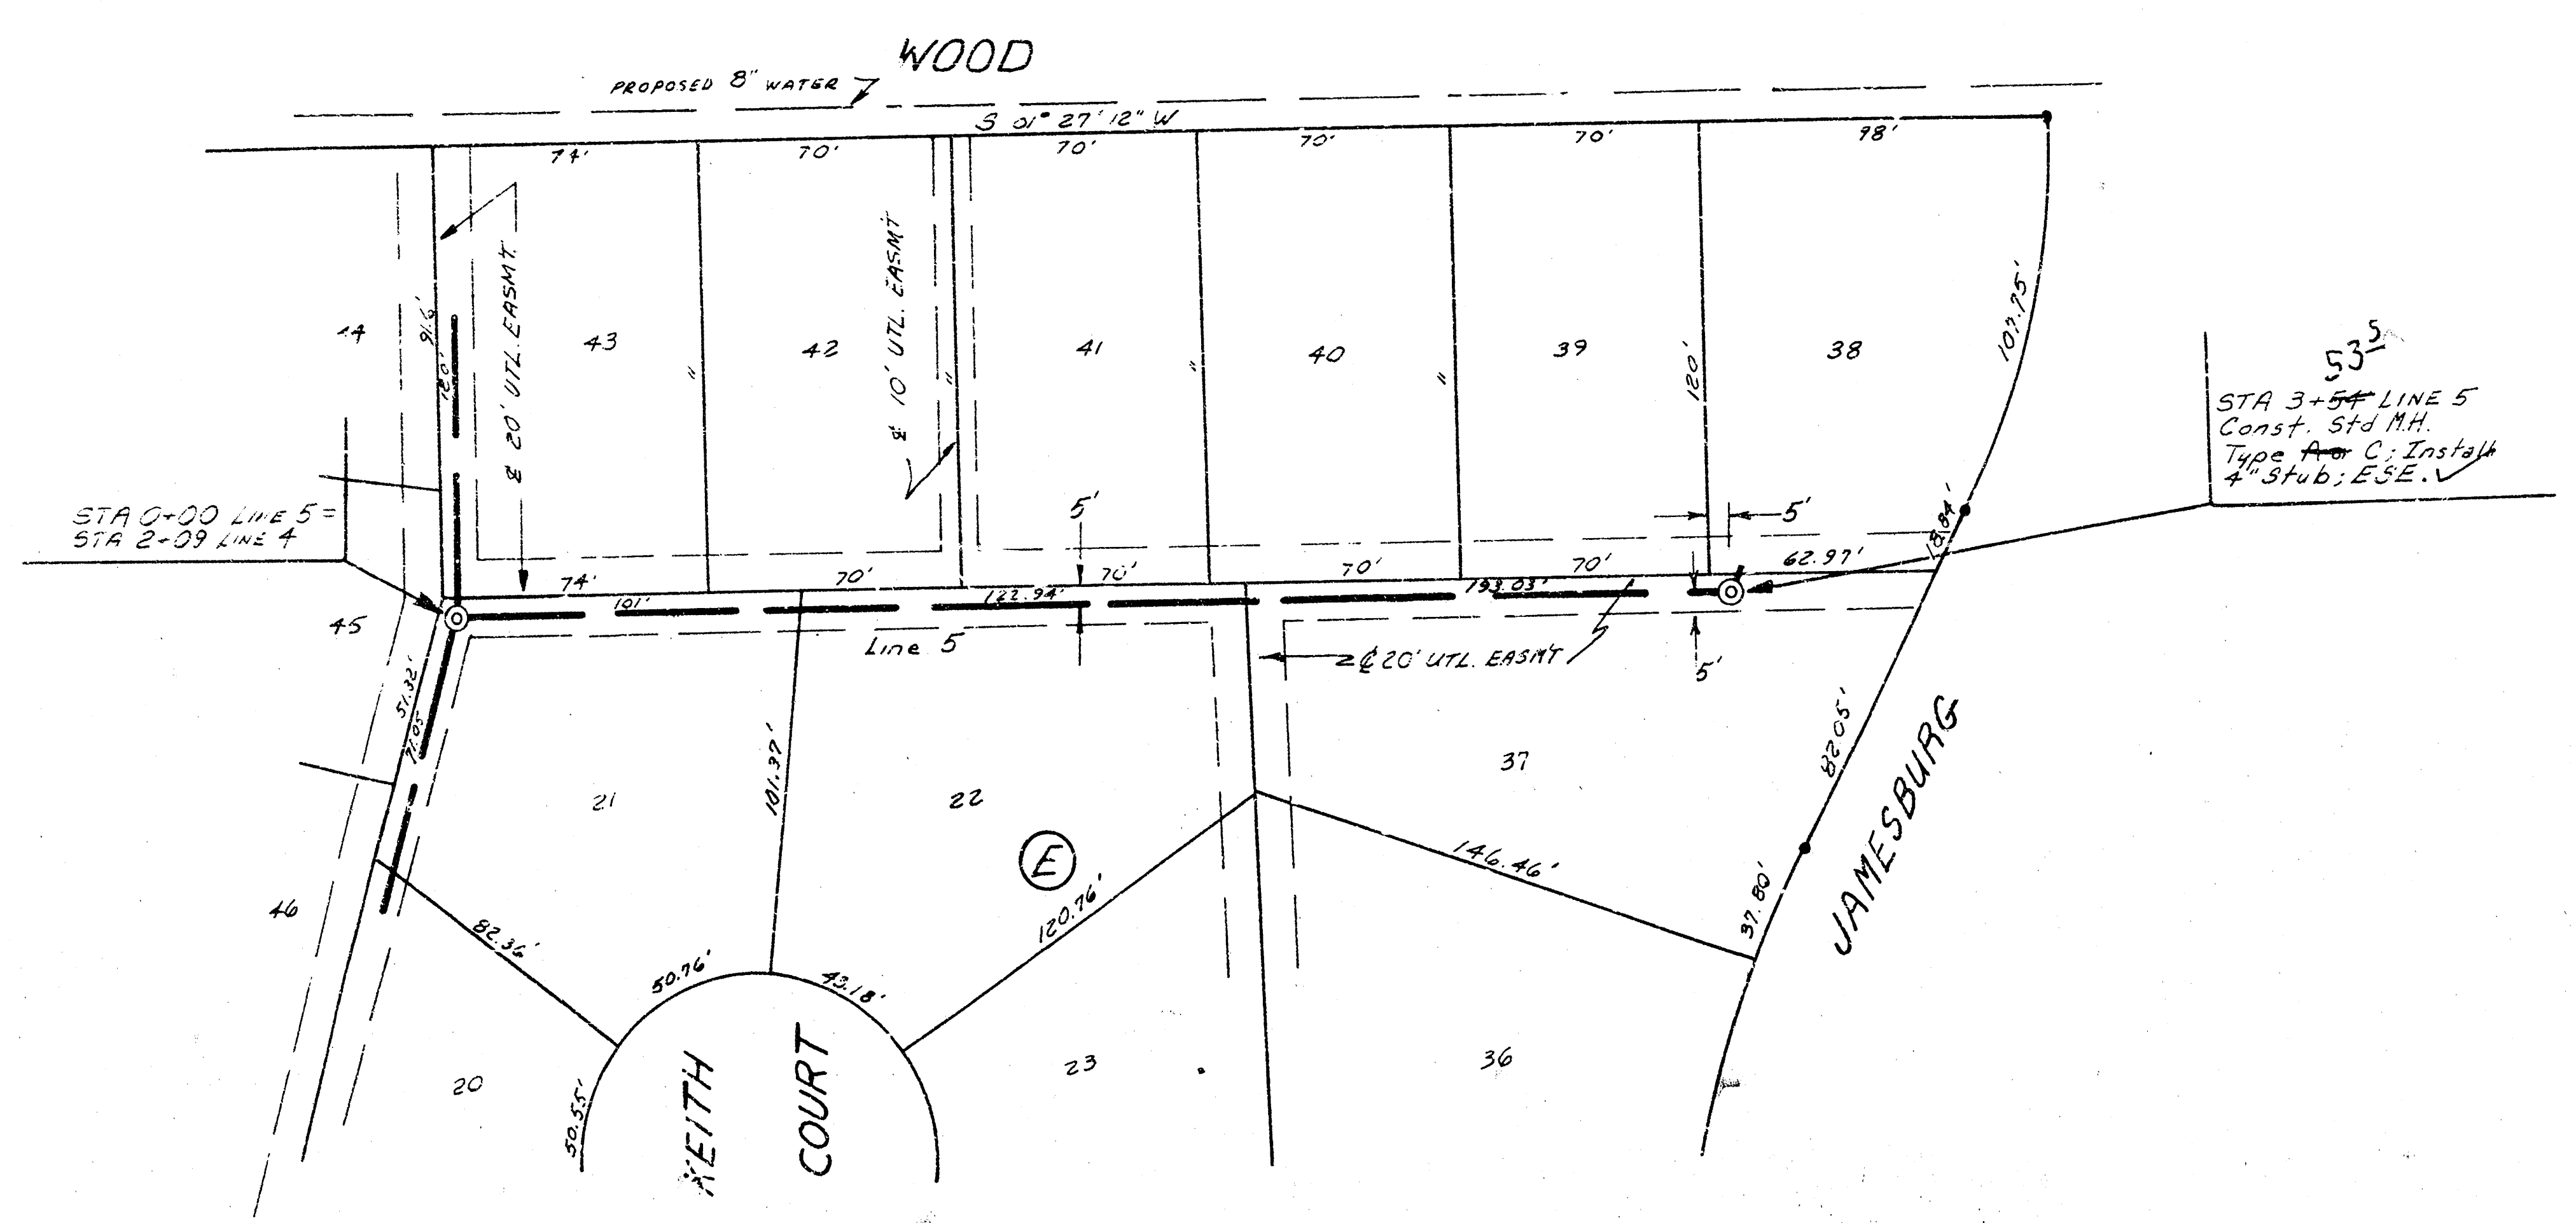

LAT 1, MAIN 4, WESTLINK SEWER PHASE I
 PROJECT NO. 468.76.245.80981.000.000.001
 LINES 5 and 6

SCALE: 1"=40' PLAN
1"=40' HORIZ. 1"=5' VERT. PROFILE

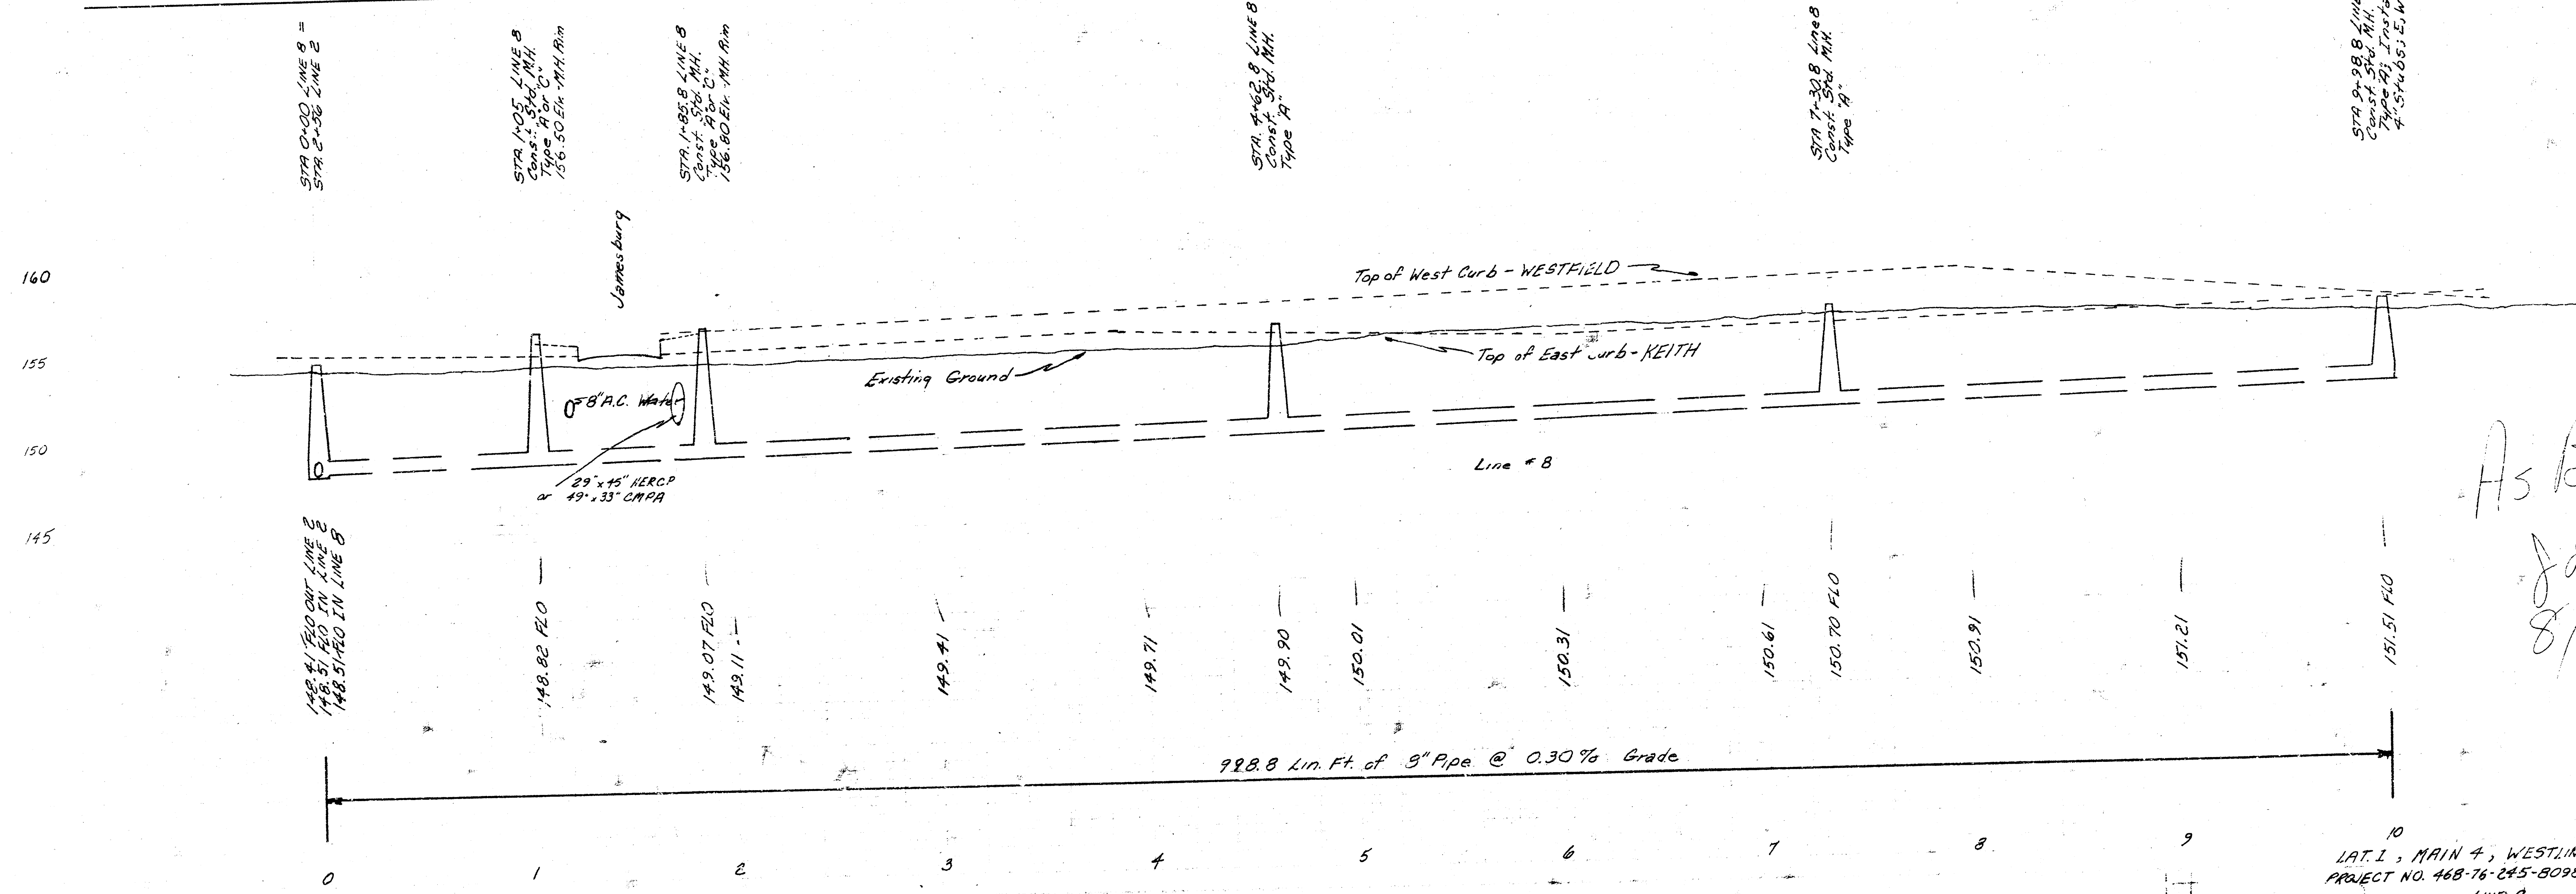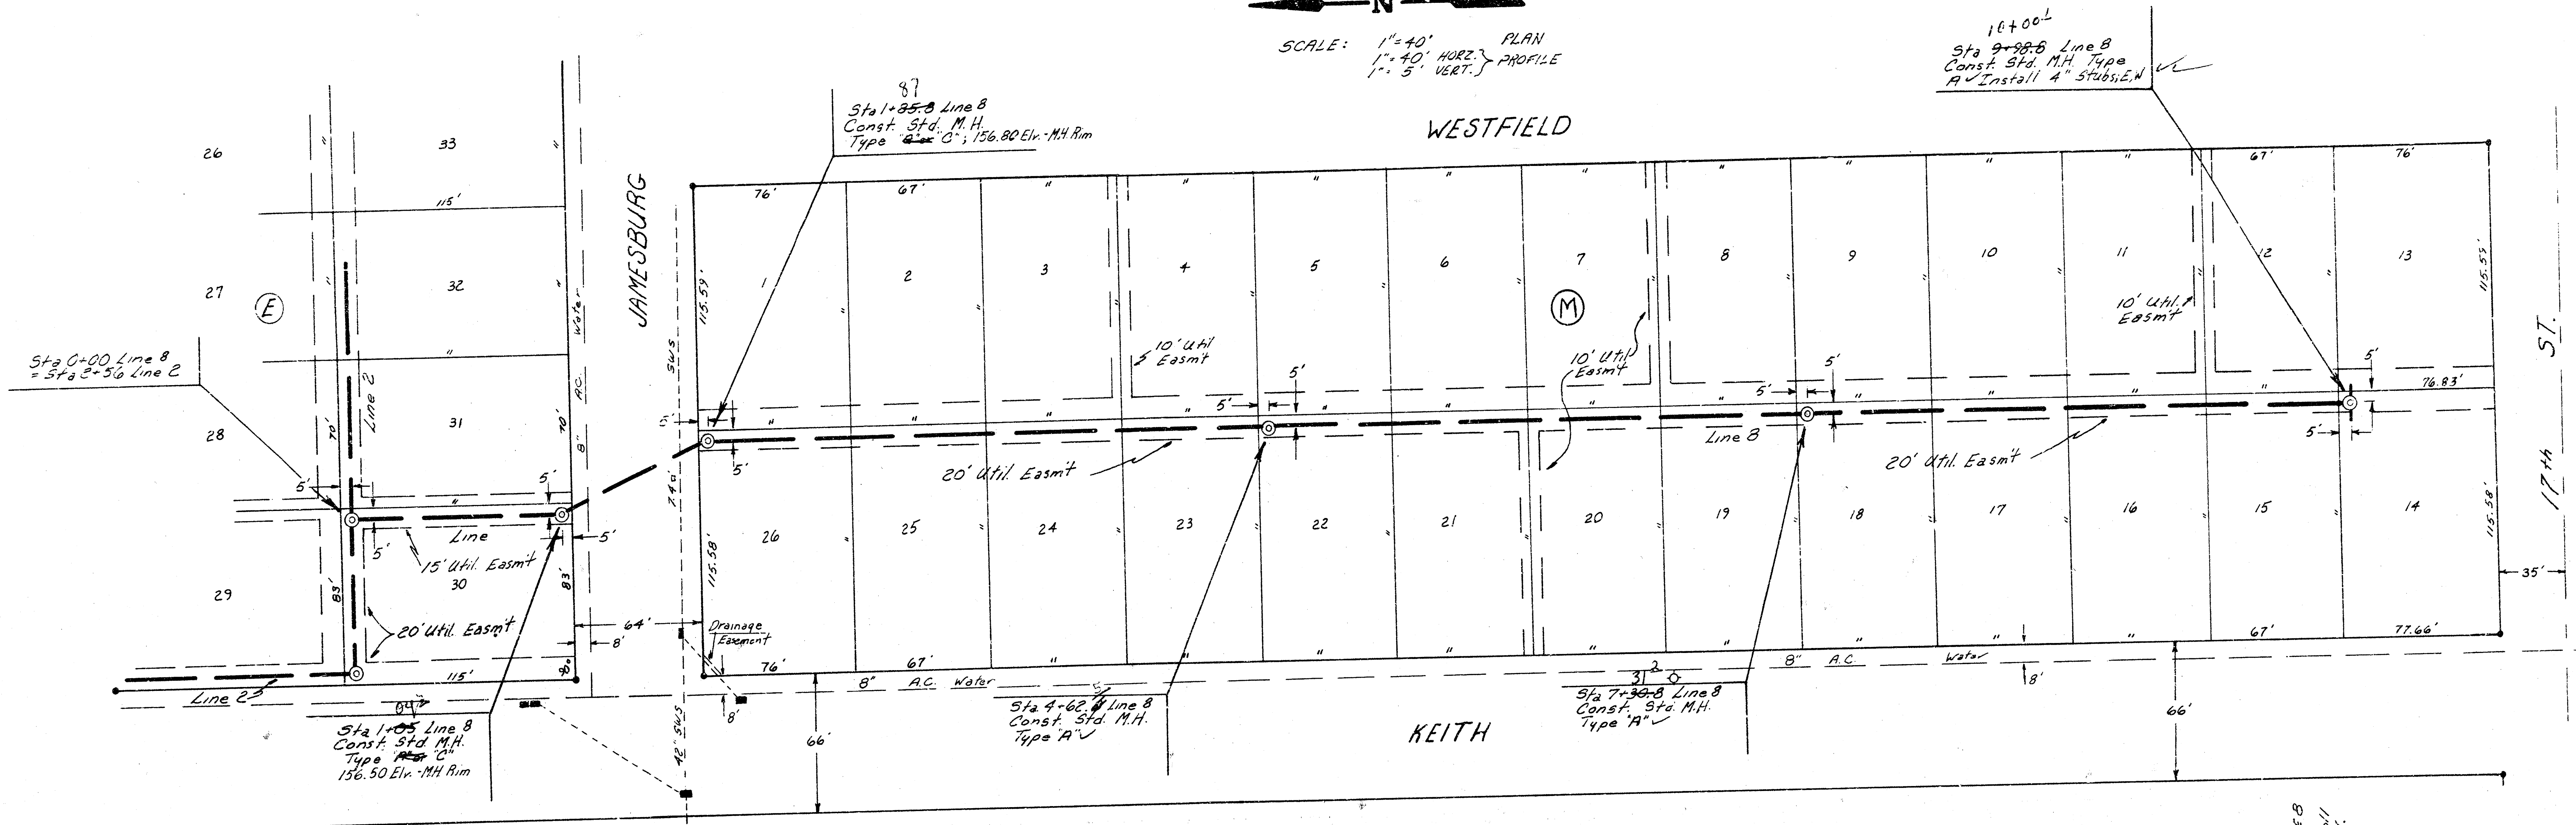

LAT. I, MAIN 4, WESTLINK SEWER PHASE I
PROJECT NO. 468-76-245-80981-000-C22-001
LINE 8

As Built
JLL
8/8/01


LAT 1, MAIN 4, WESTLINK SEWER
(PHASE II)
CITY OF WICHITA

R.W. BRUGGEMAN - DIRECTOR OF ENGINEERING /


CITY ENGINEER

PROJECT NO. 468-76-245-80981-000-000-001

JAMESBURG PARK ADDITION

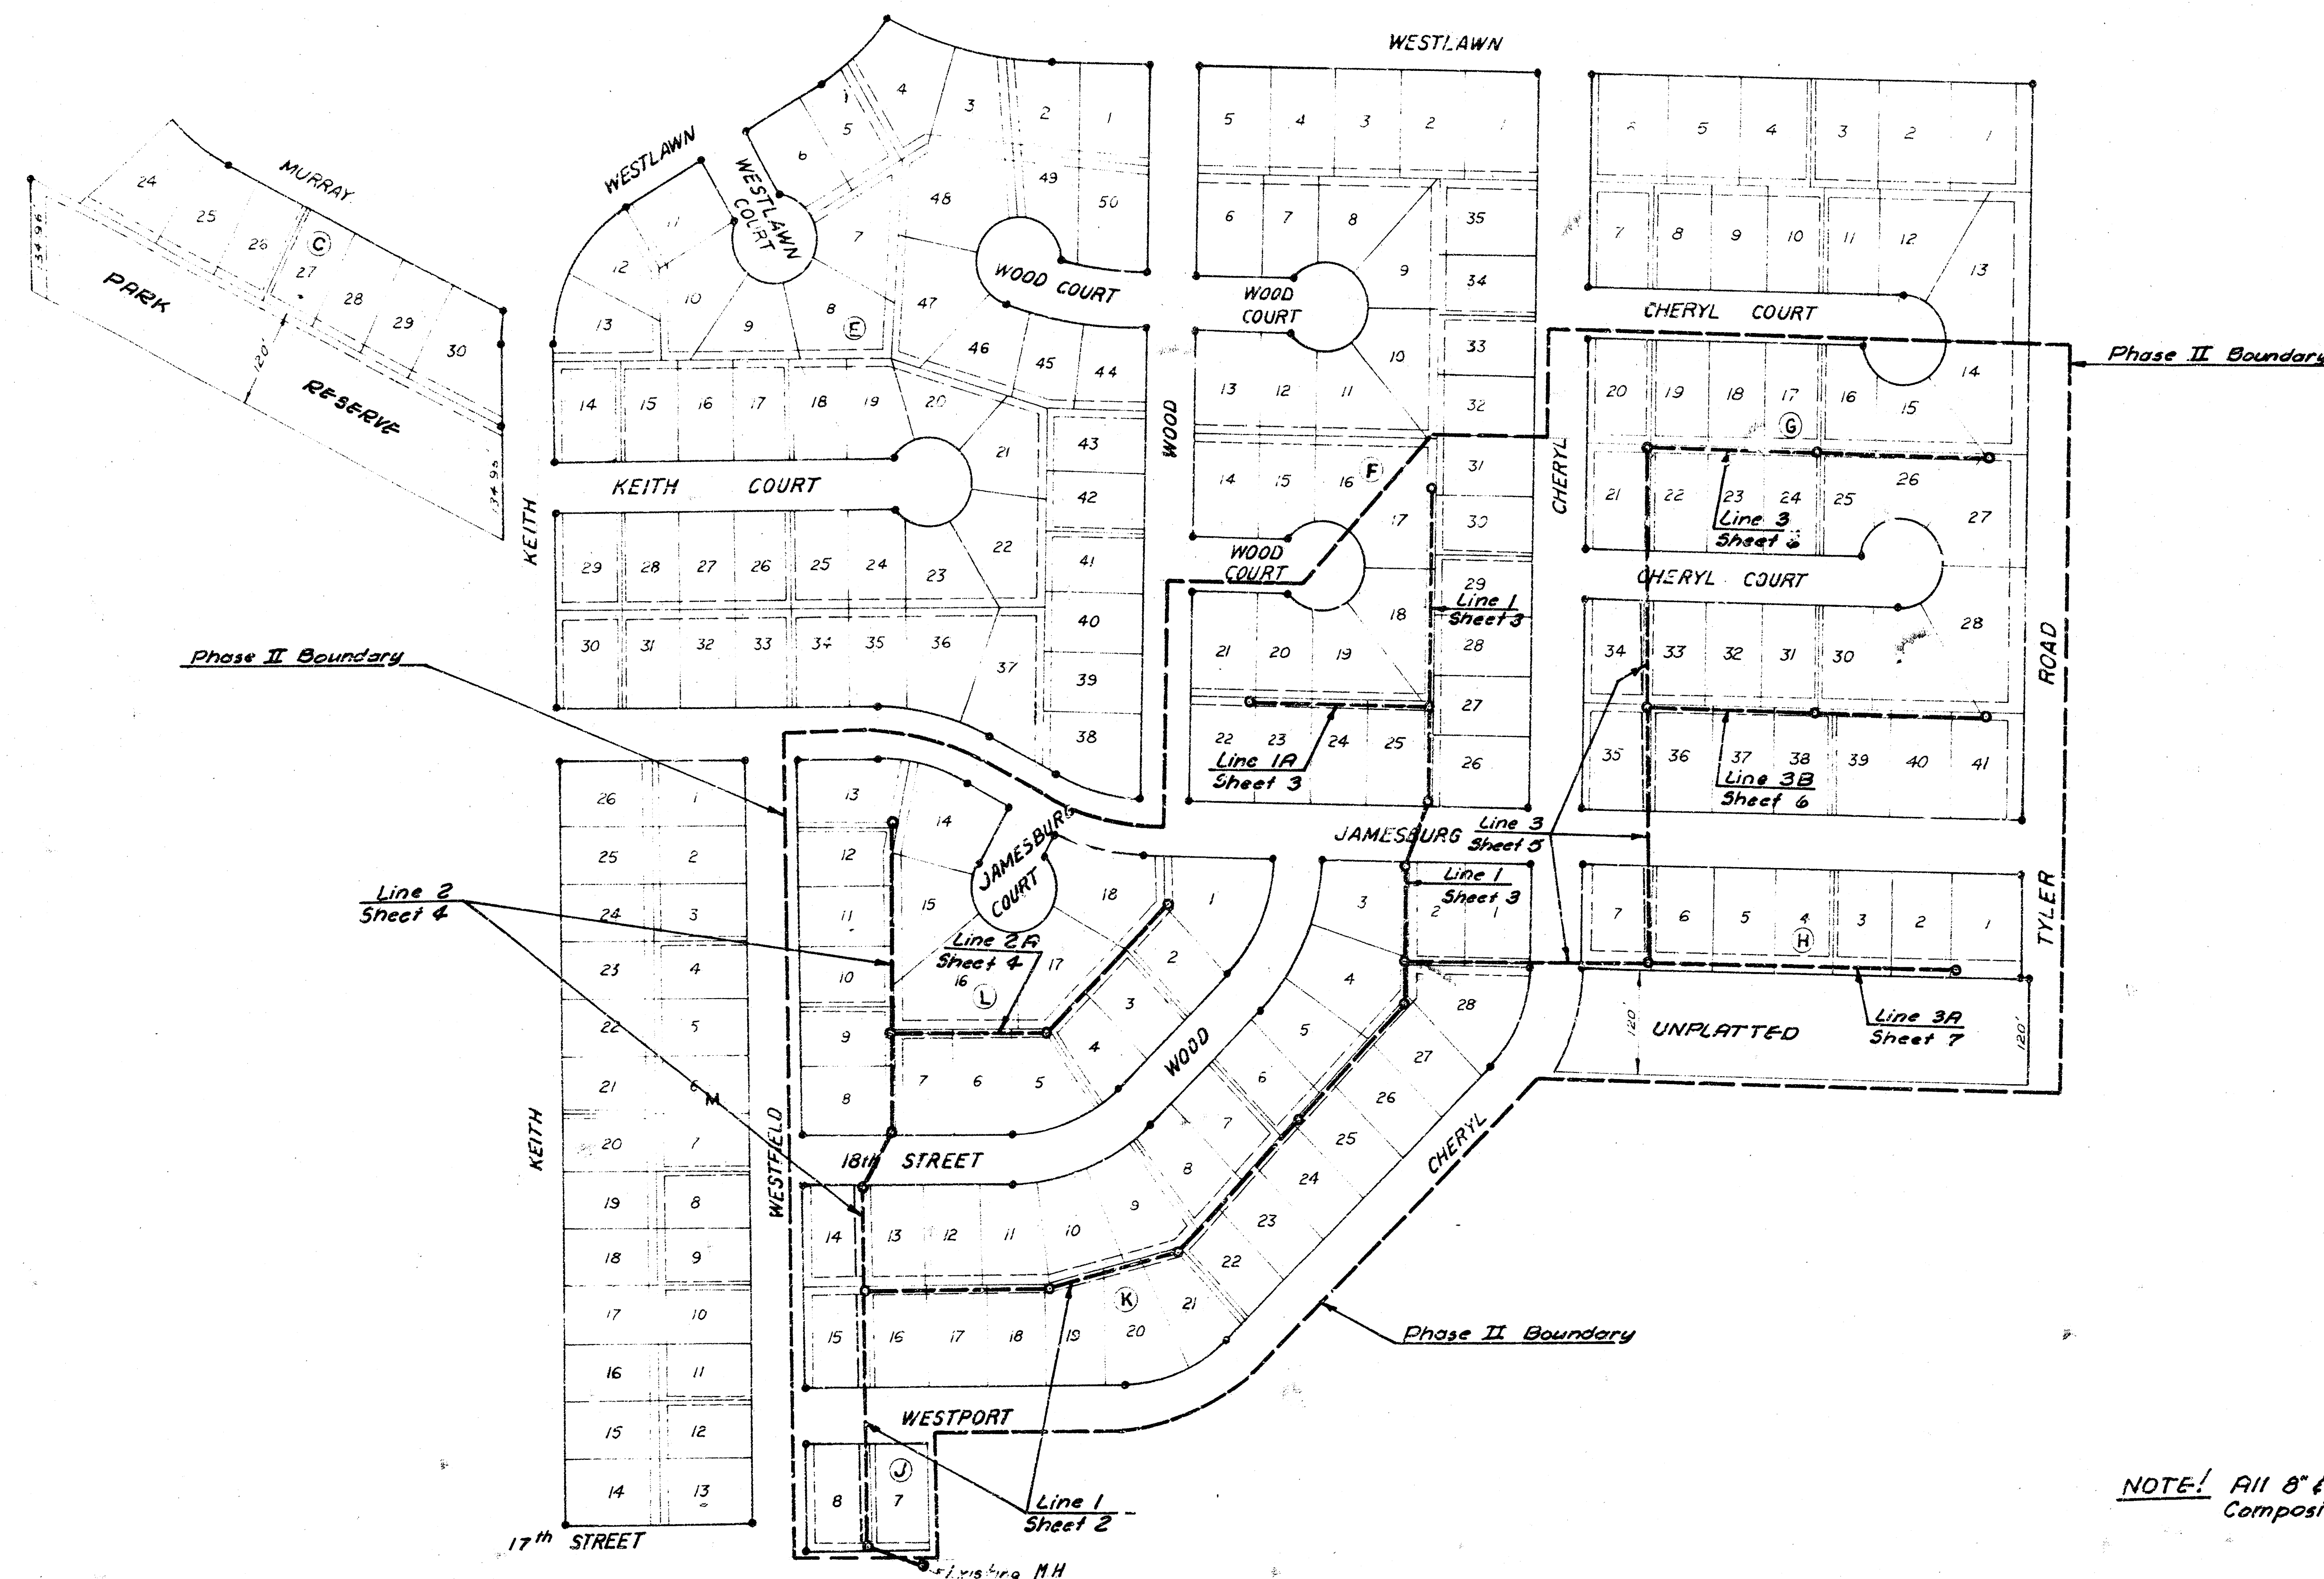



NOTE: All 8" & 4" Pipe on this Project shall be P.V.C., A.B.S. Composite Pipe, or V.C.P. (for grades of 0.4% or greater).

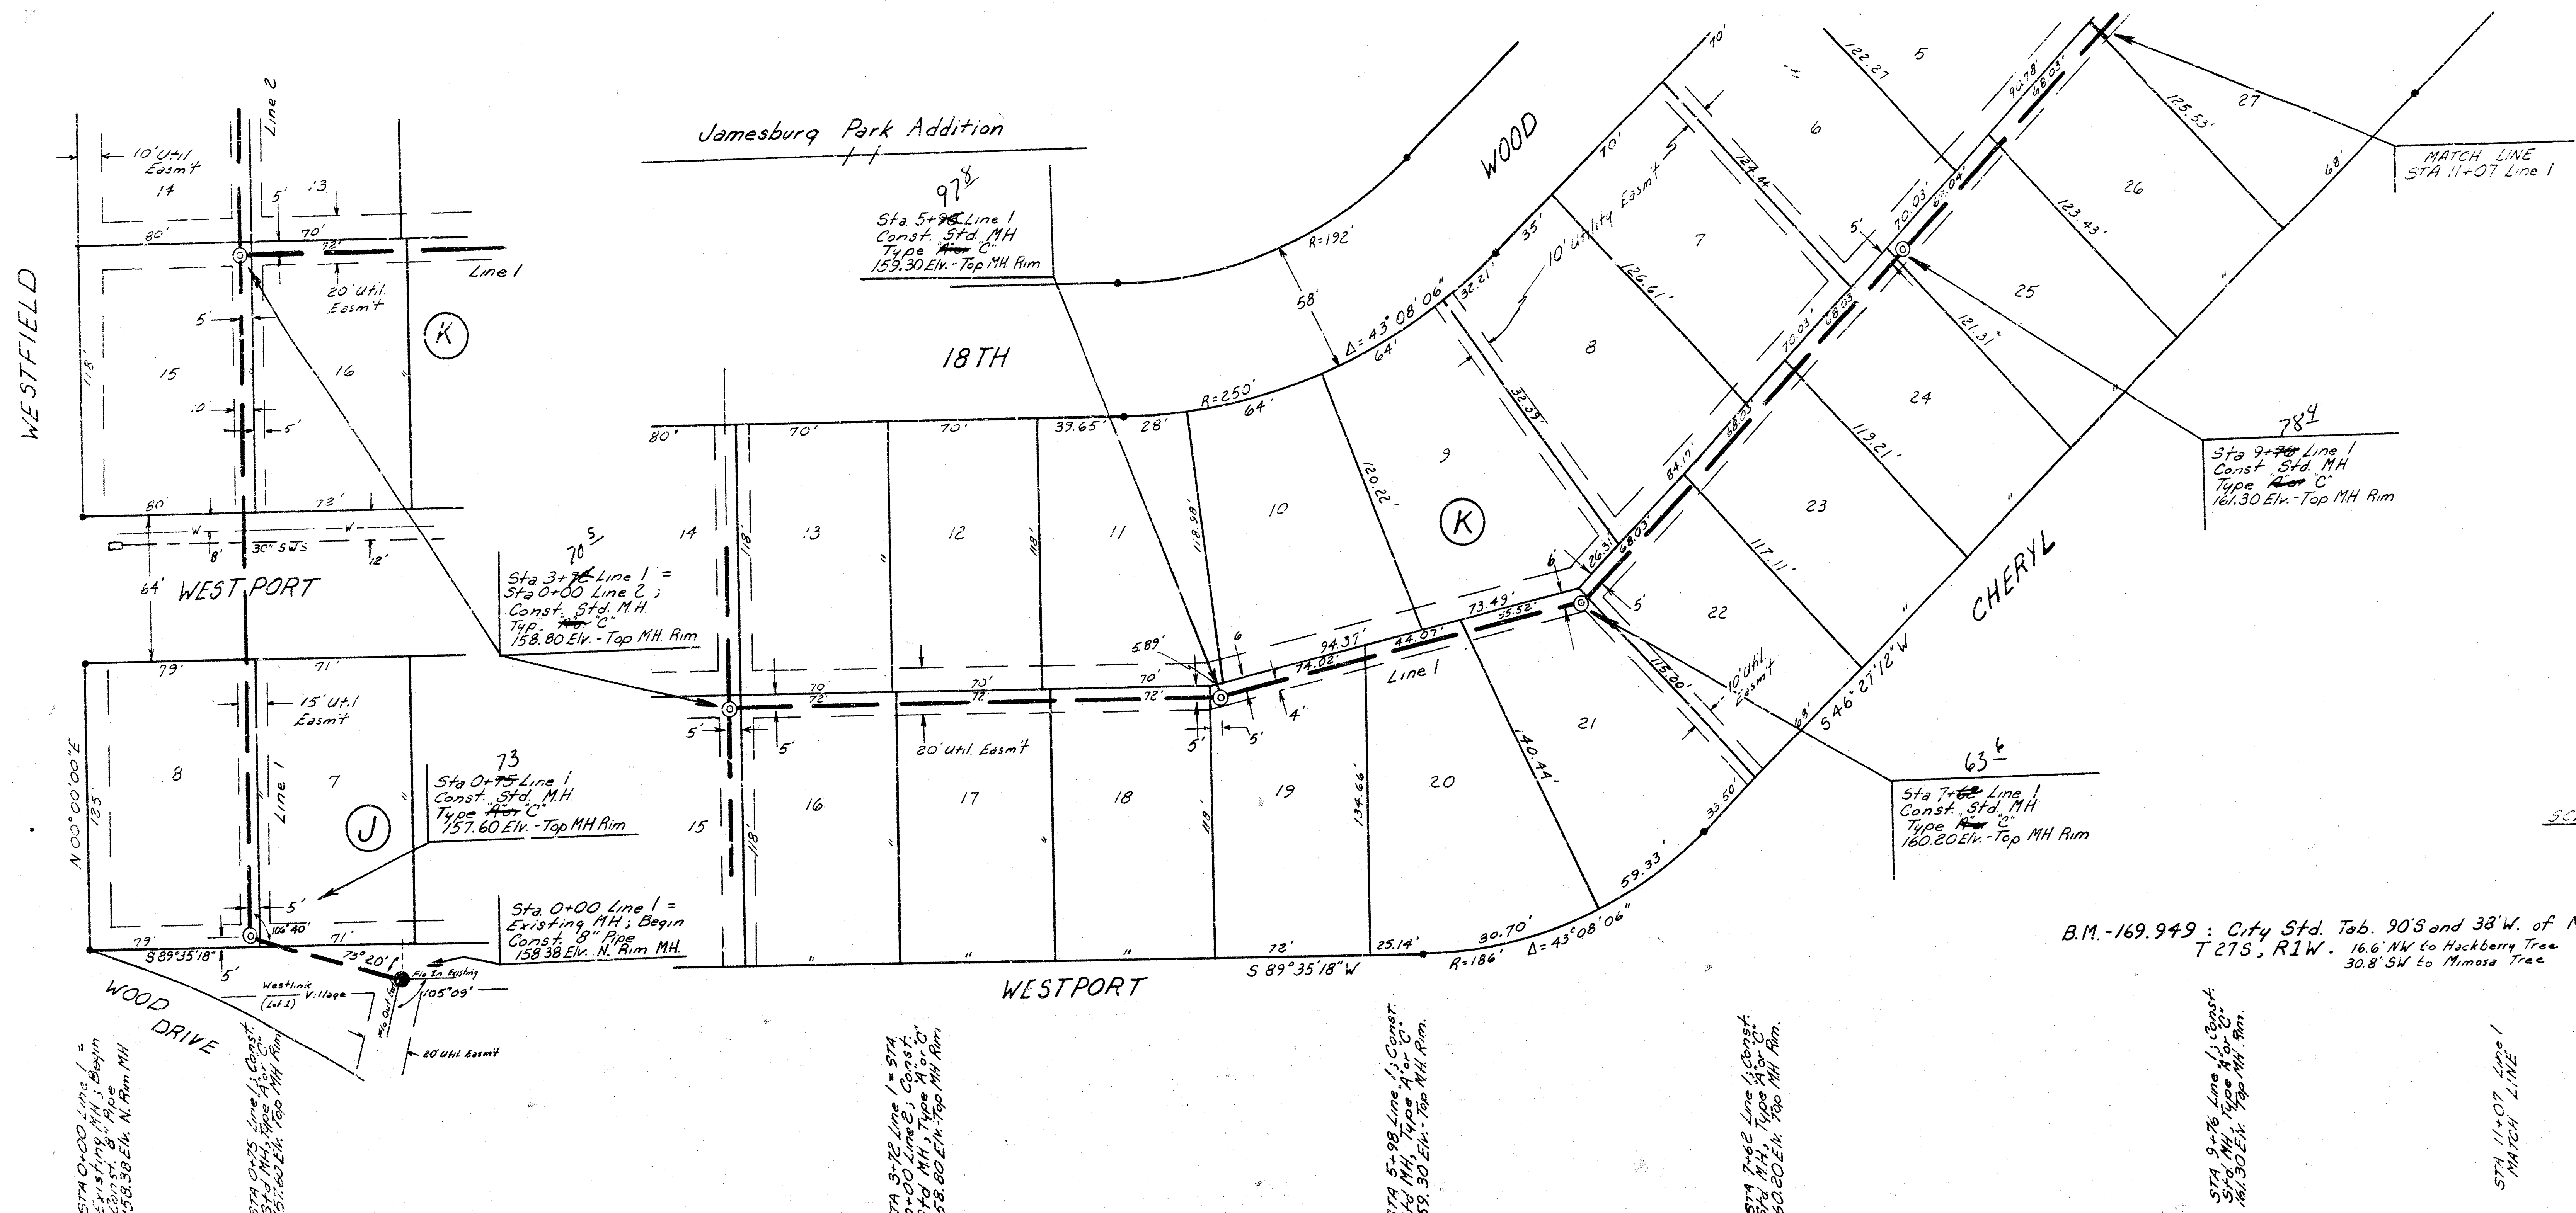

SCALE: 1" = 40' Plan
1" = 4' Horiz. & Profile
1" = 5' Vert. (Elev.)
• - Irons


B.M. - 169.949 : City Std. Tab. 90'S and 38'W. of NE Cor. Sec. 8,
T27S, R1W. 16.6' NW to Hackberry Tree
30.8' SW to Mmose Tree

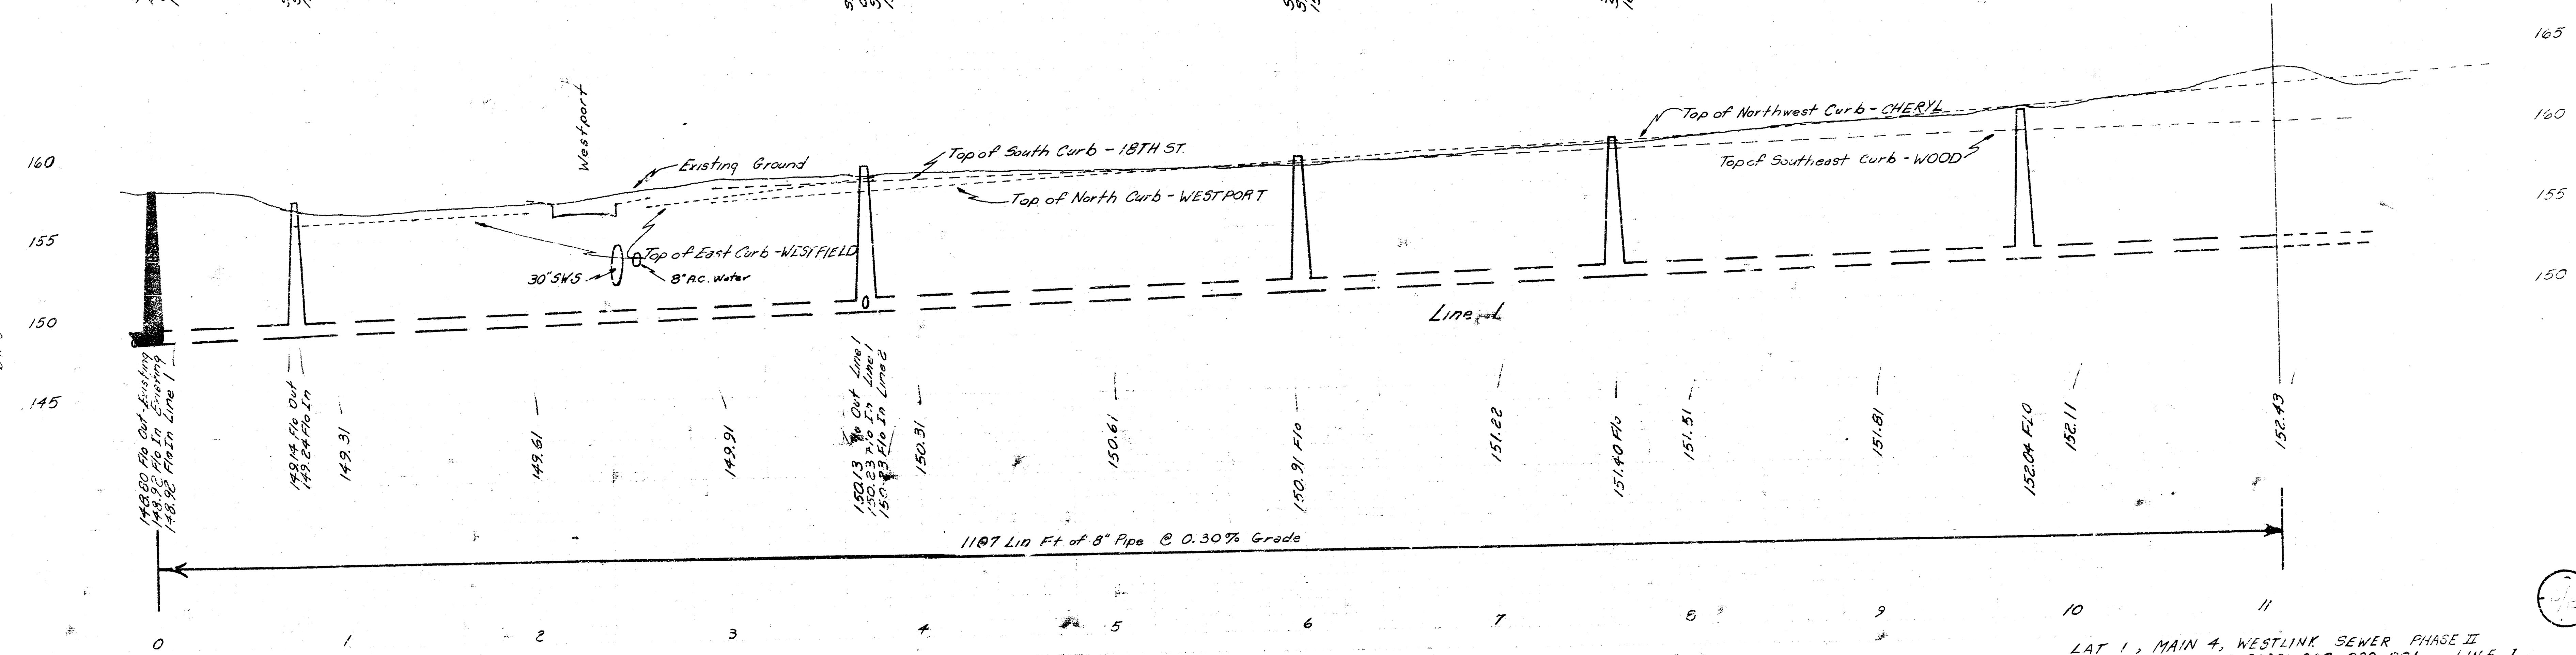

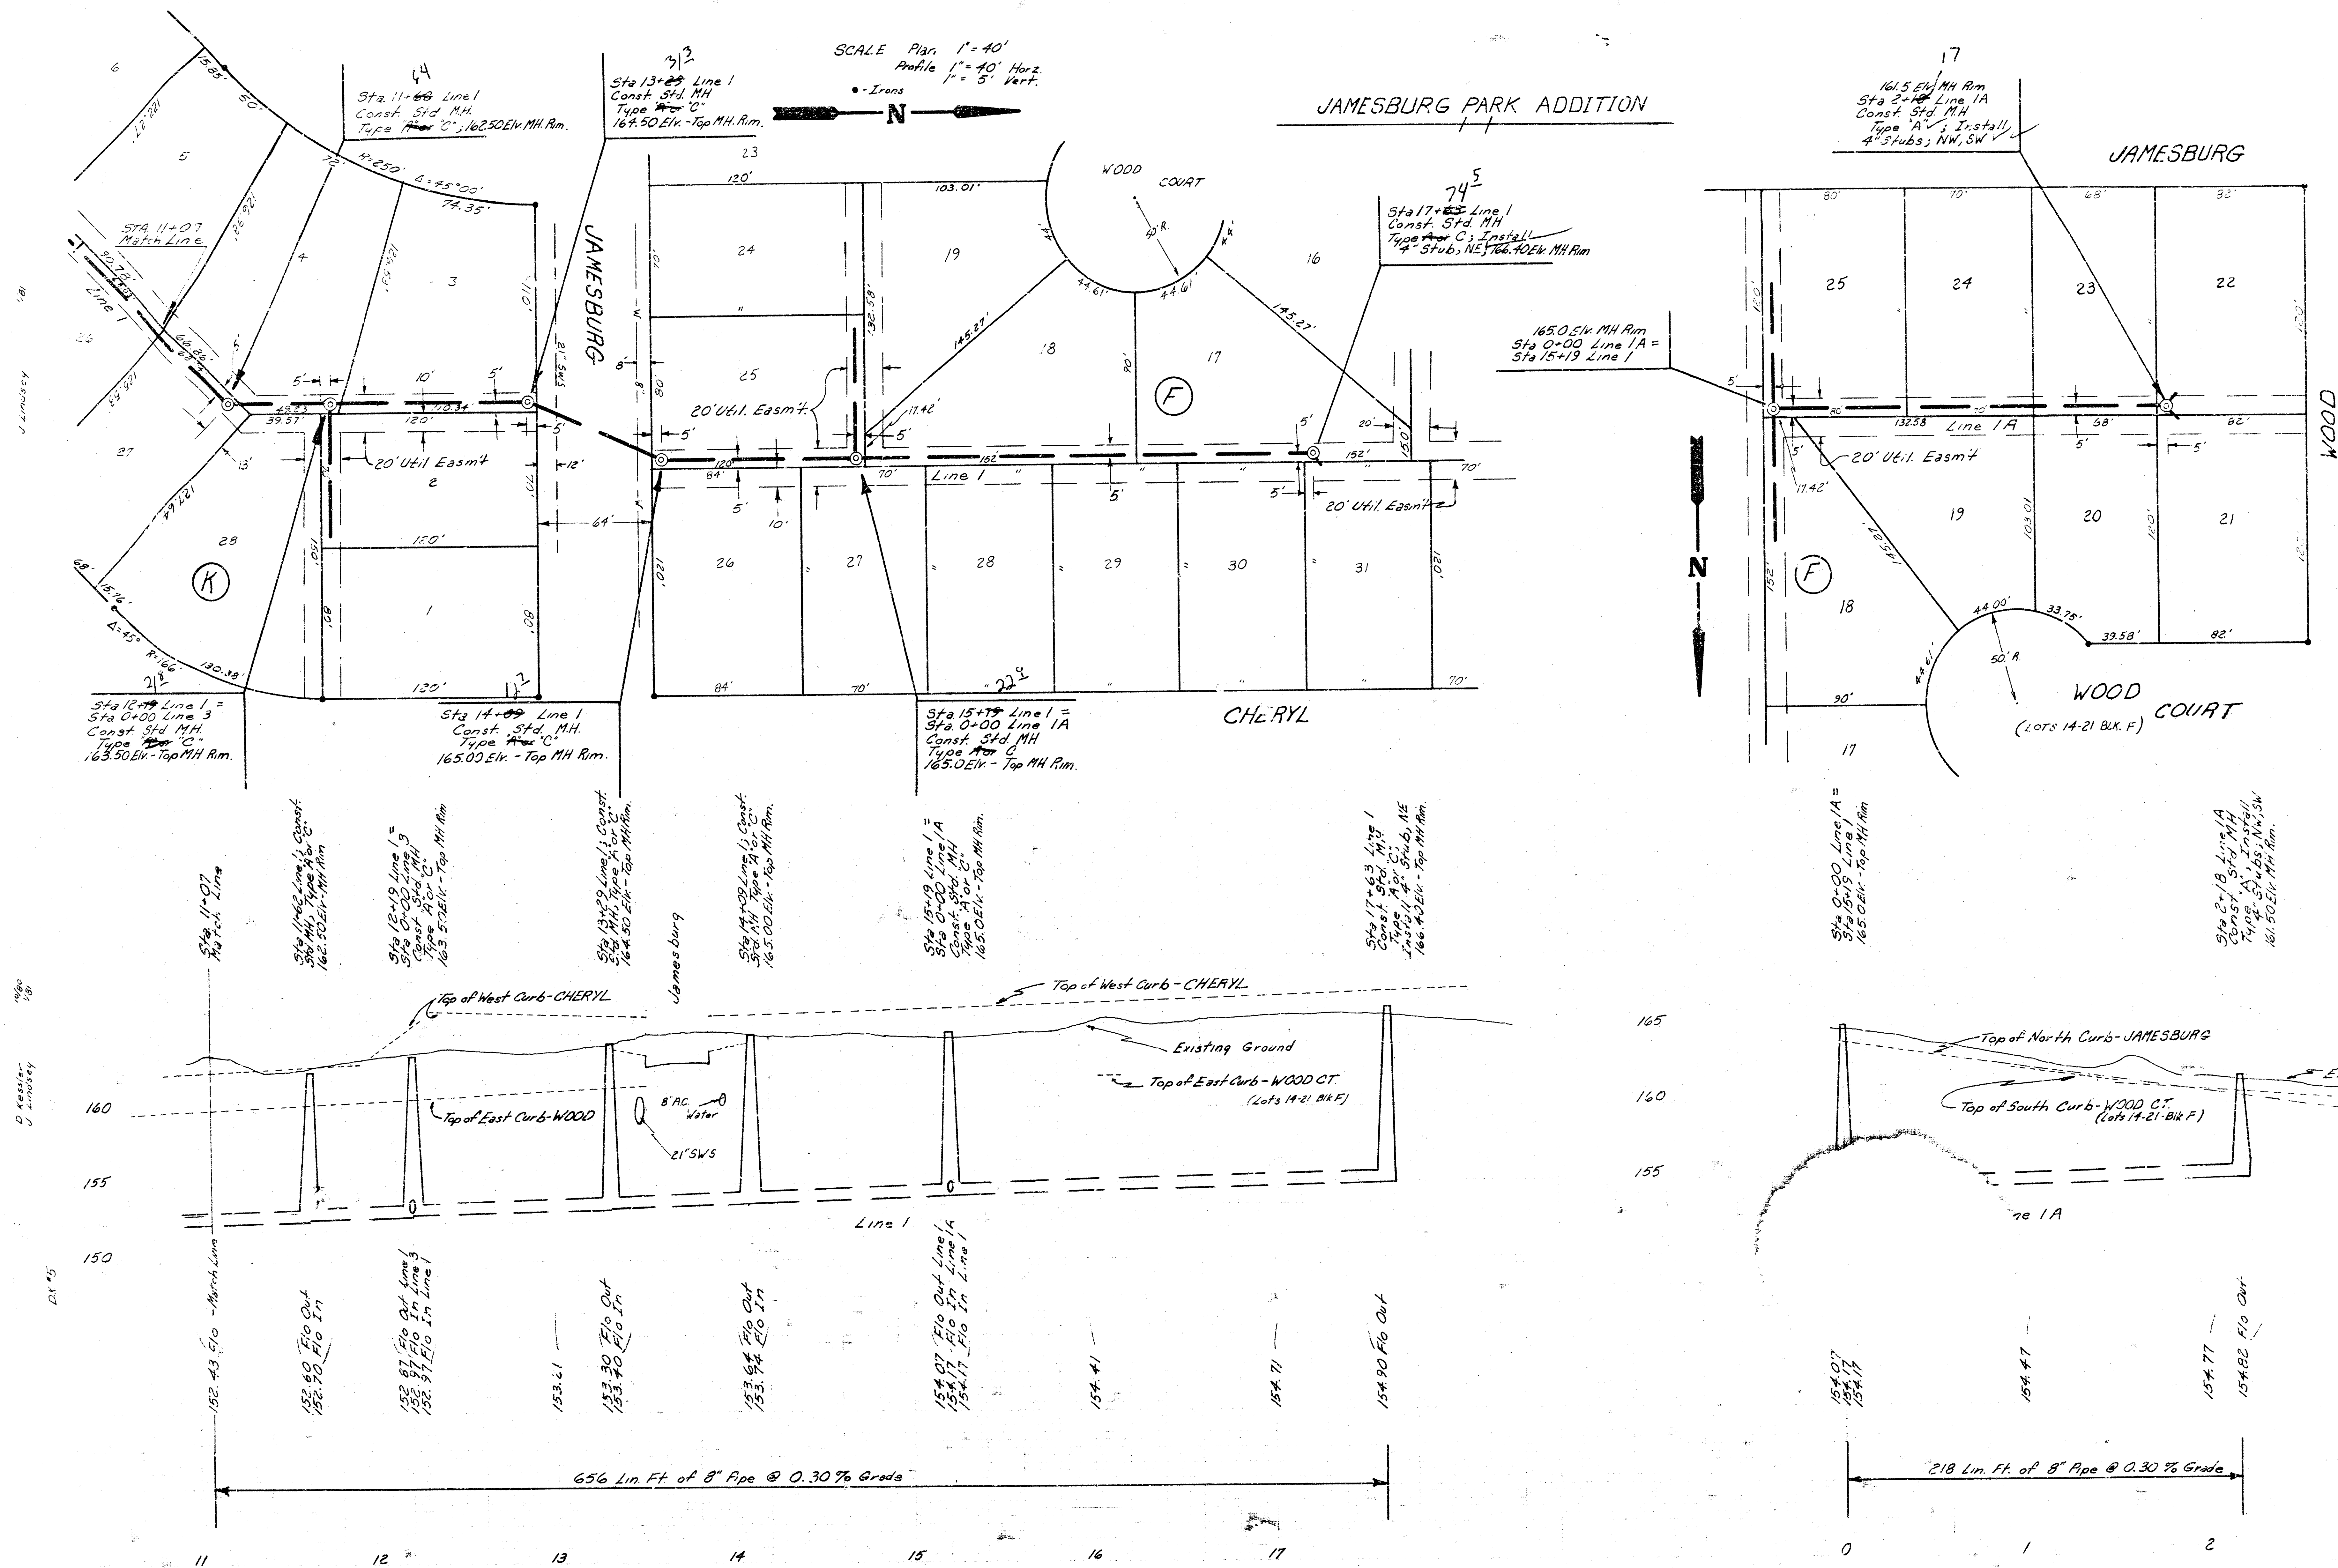

LAT 1, MAIN 4, WESTLINK SEWER PHASE II
 PROJ. # 468-76-245-80381-000-000-001 LINE 1 and 1A



FILMED FROM THE BEST
 AVAILABLE COPY

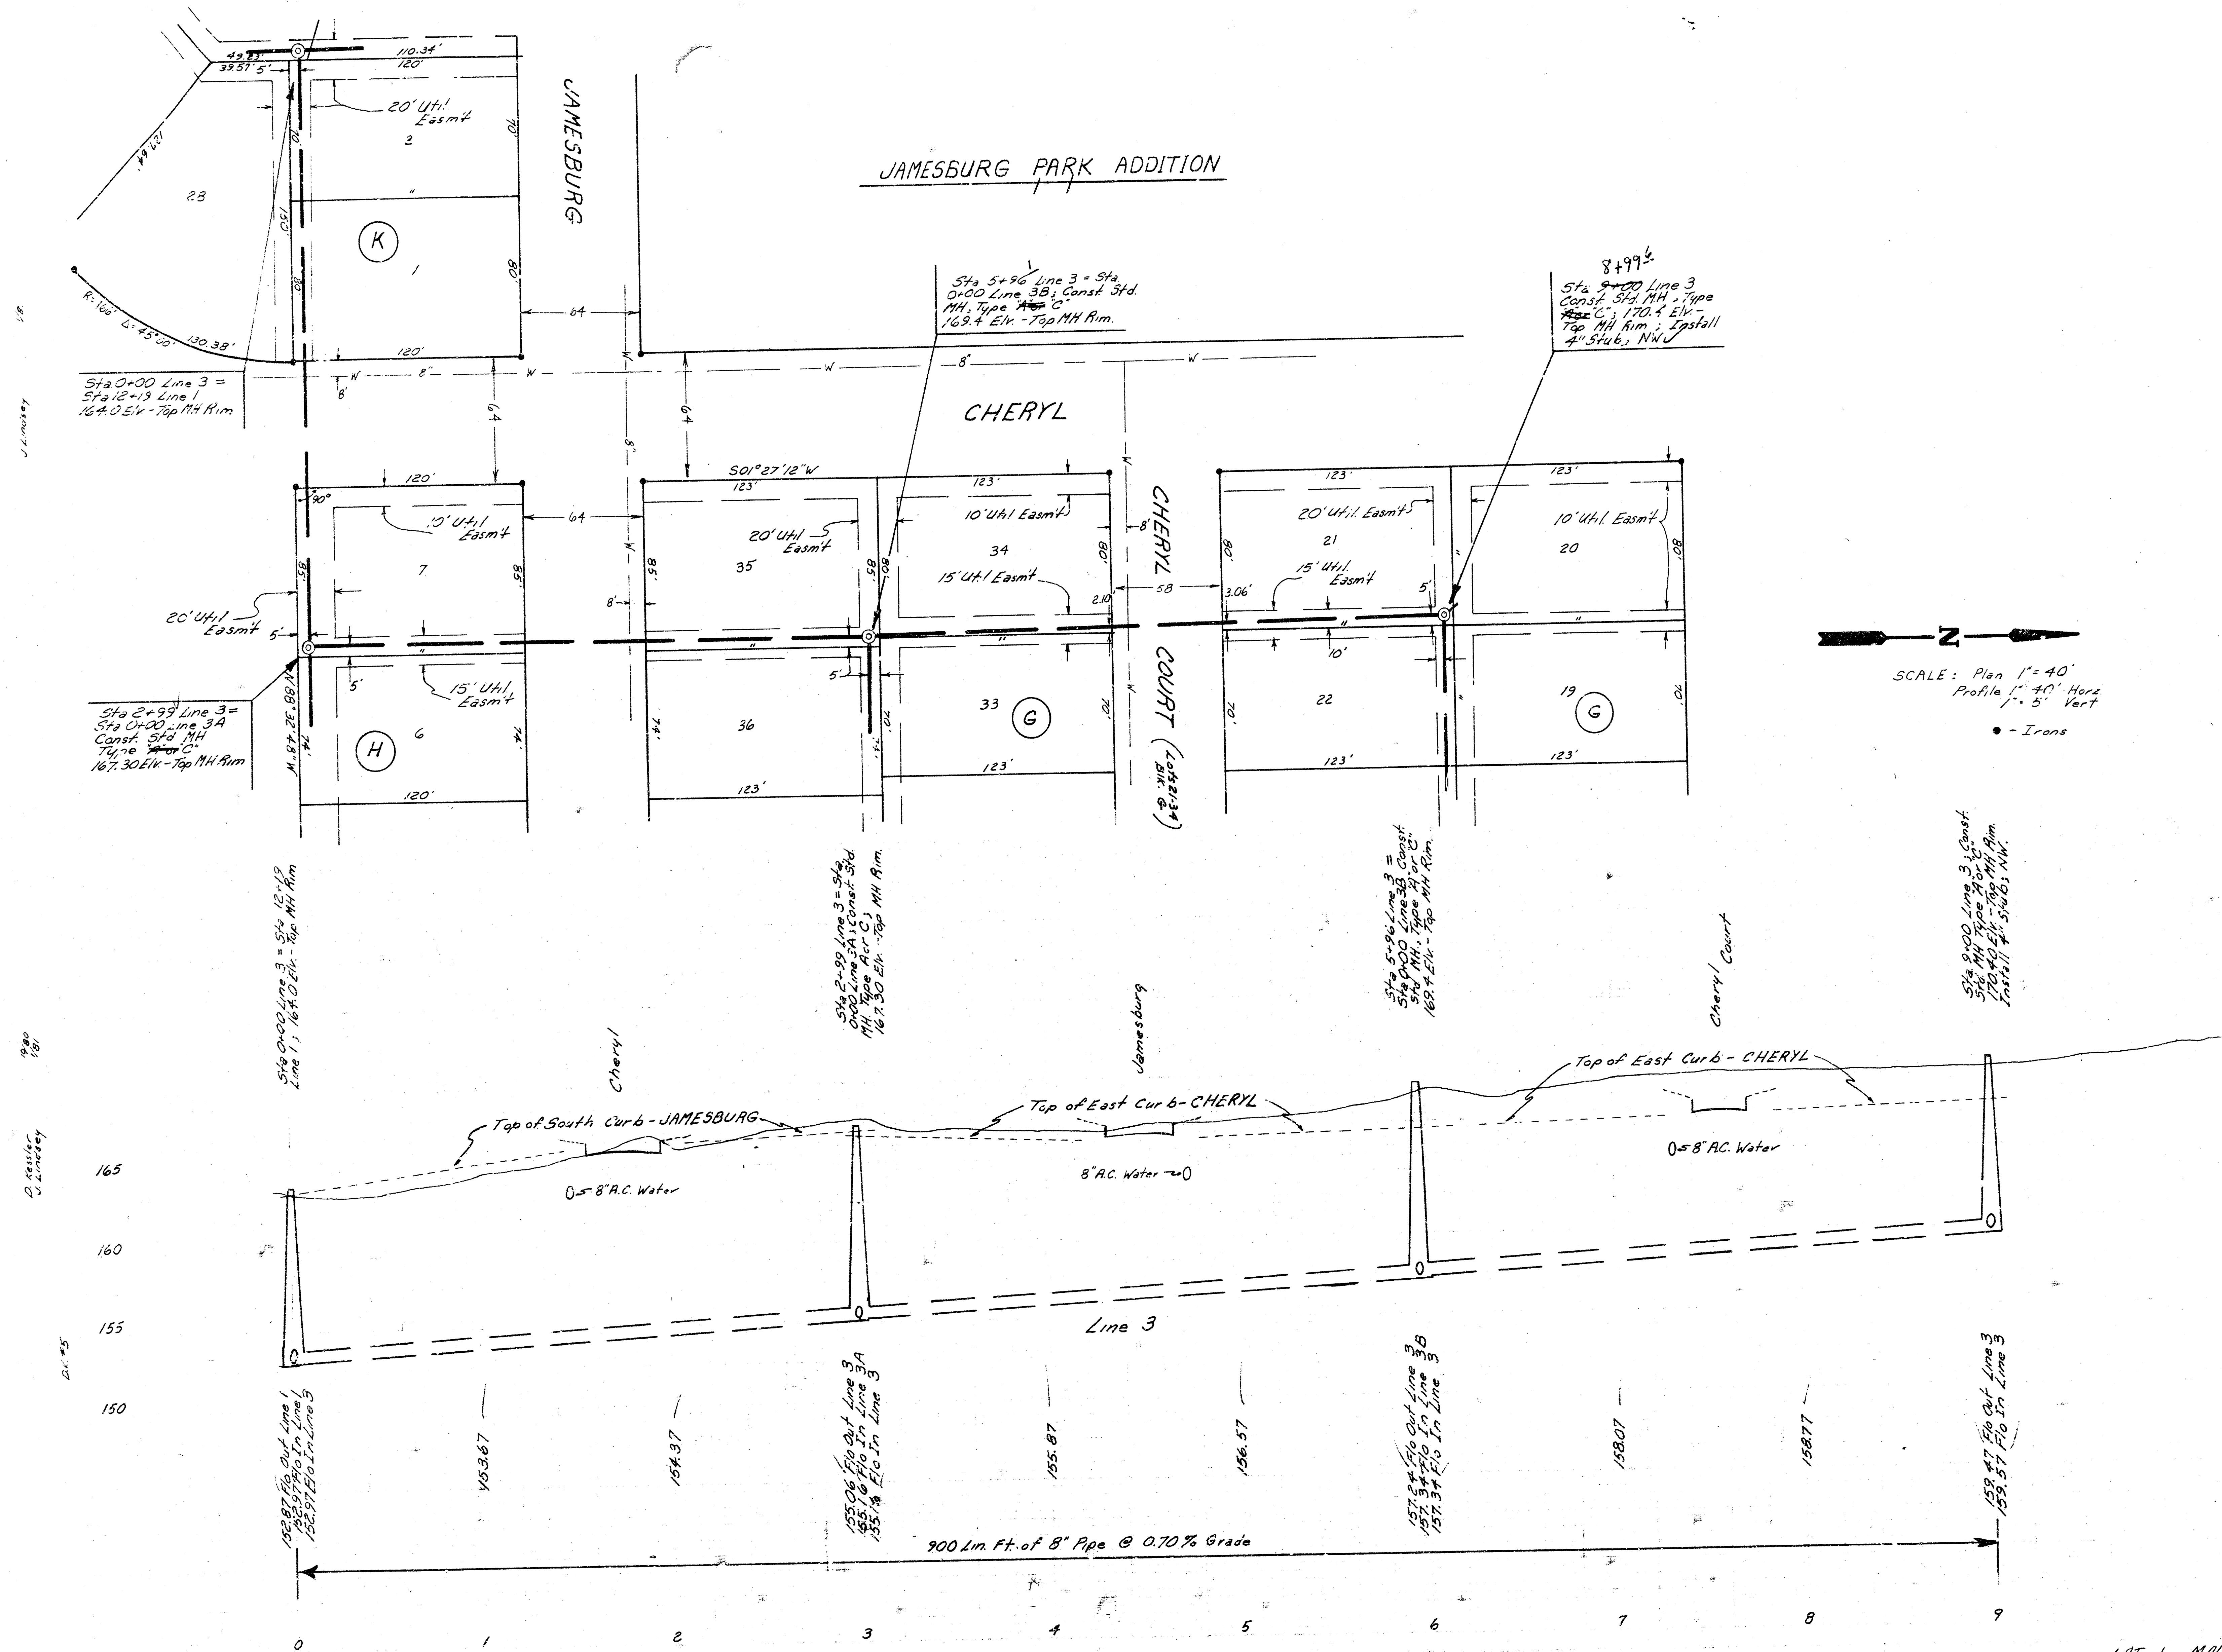

LAT 1, MAIN 4, WESTLINK SEWER PHASE II
 PROJ. # 468-76-2+5-80981-000-000-001 LINE 3

FILMED FROM THE BEST
 AVAILABLE COPY.....

JAMESBURG PARK ADDITION

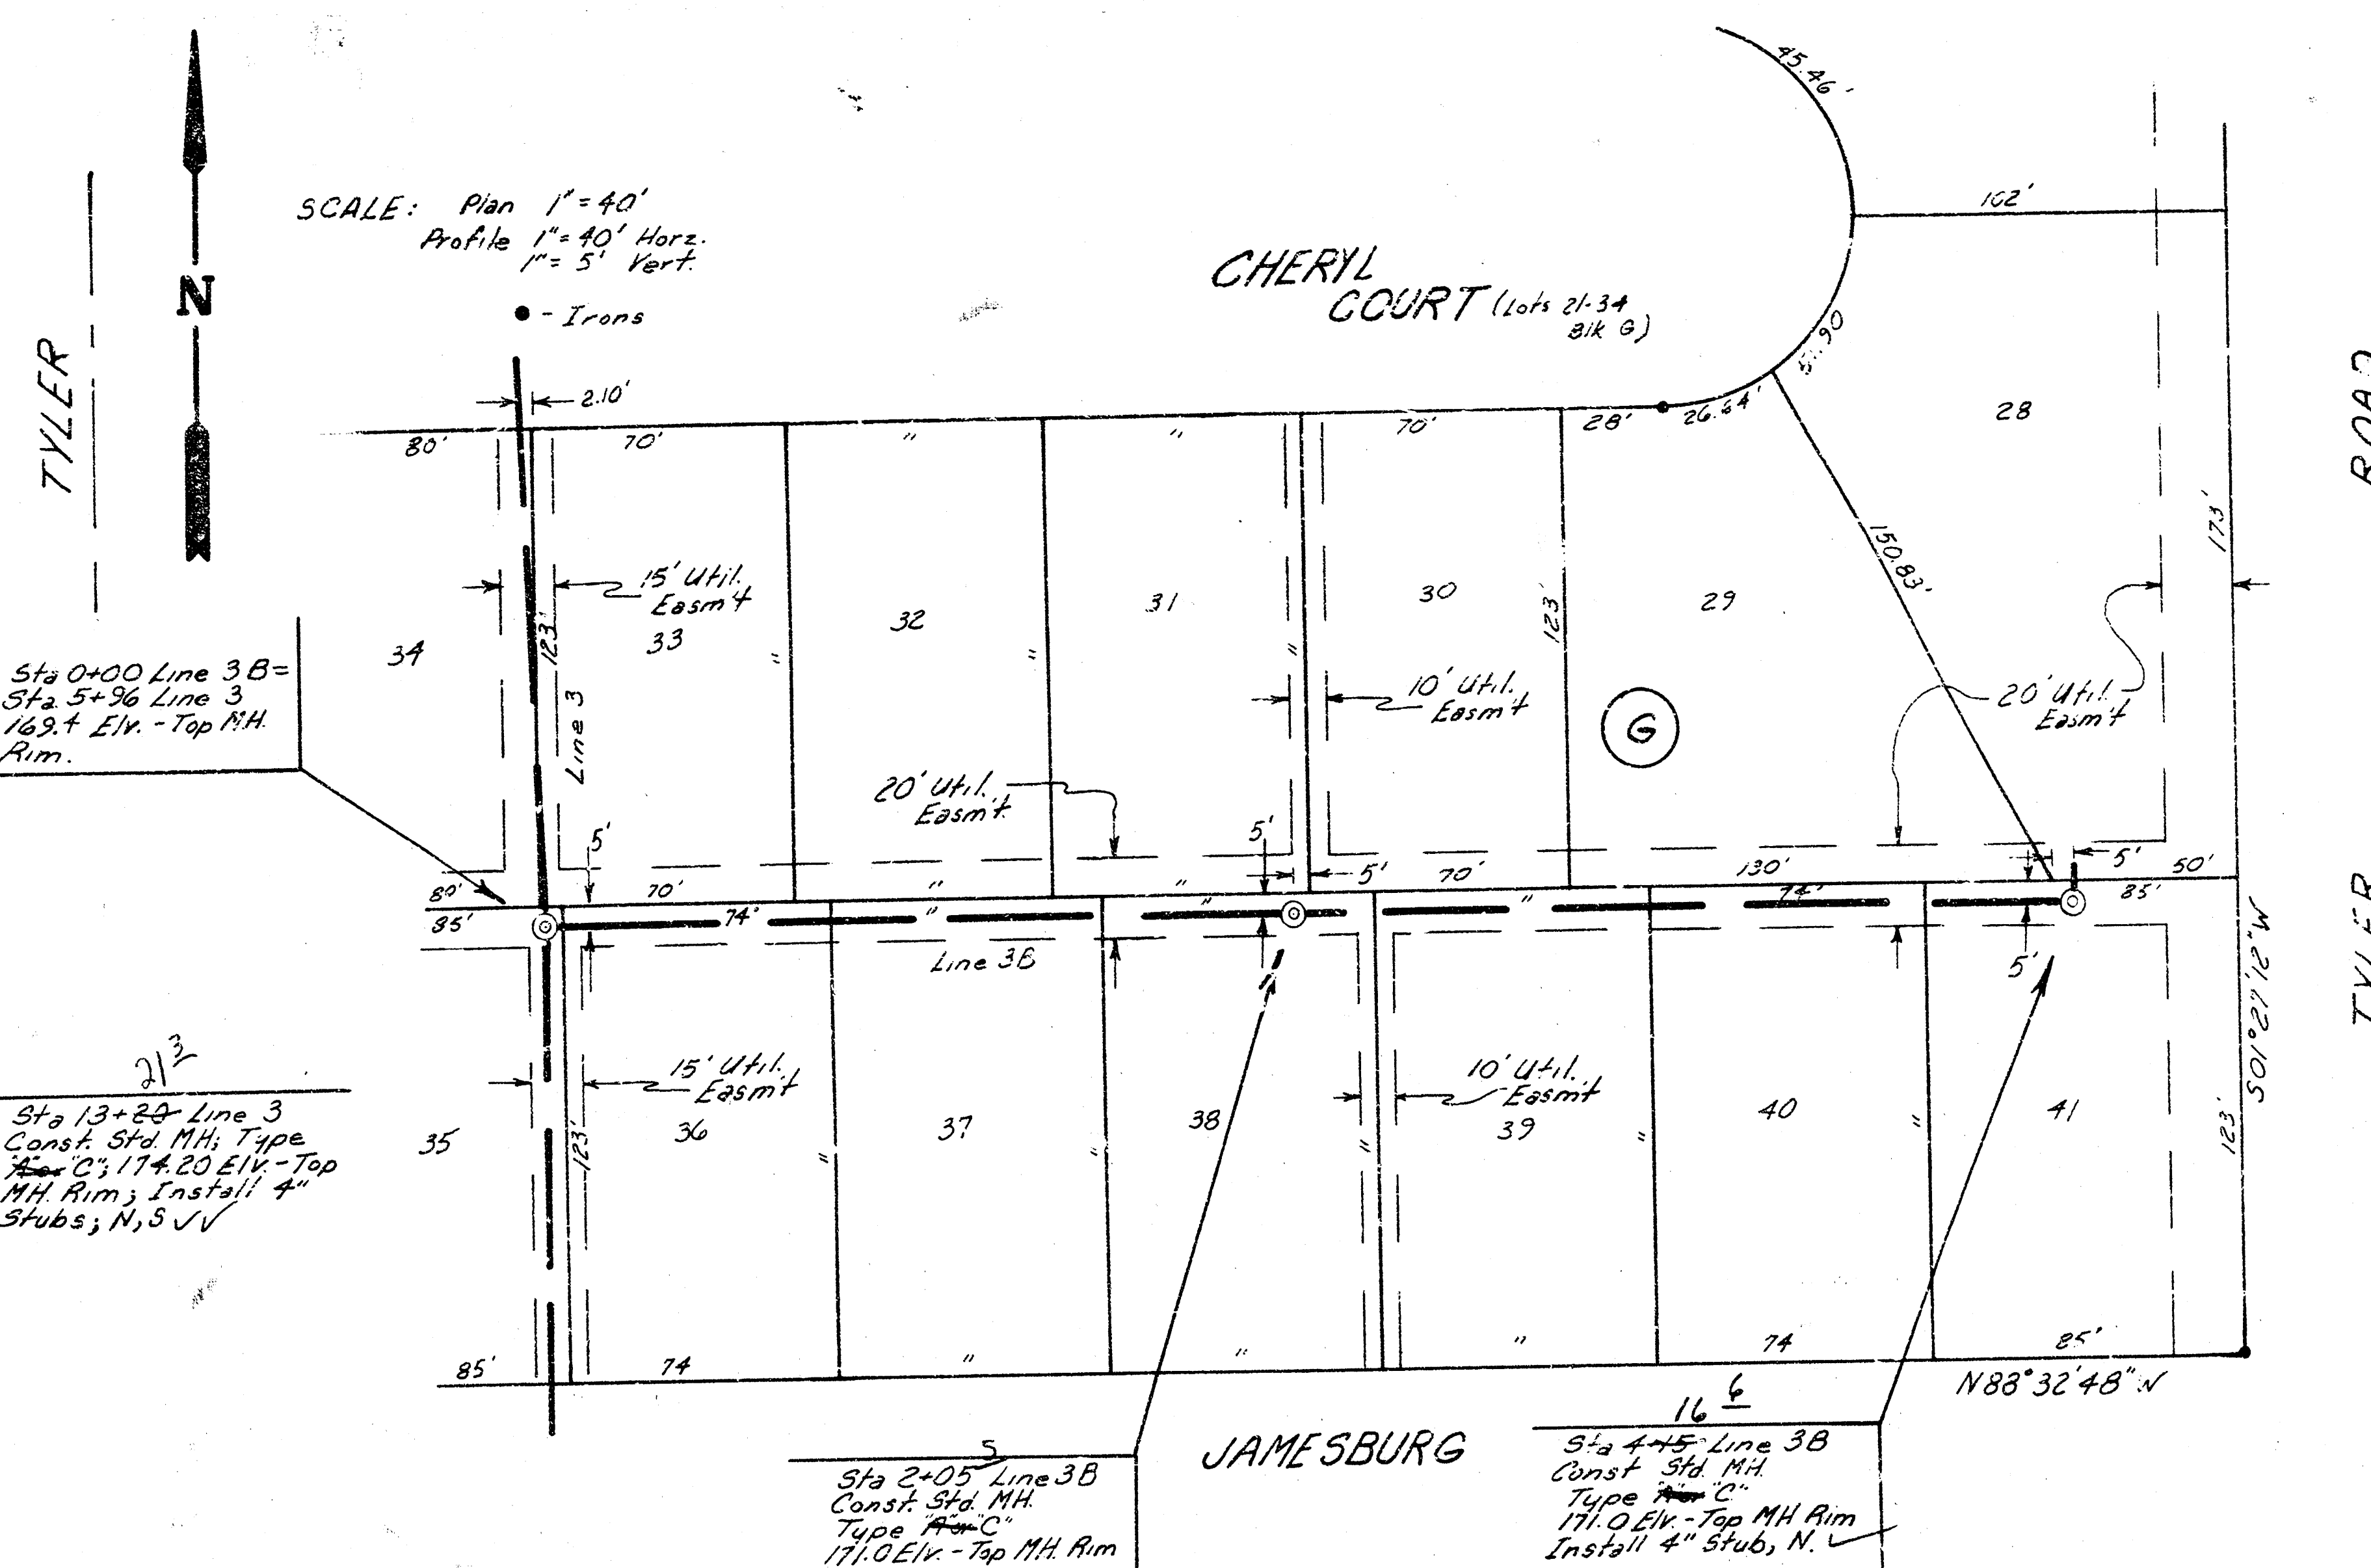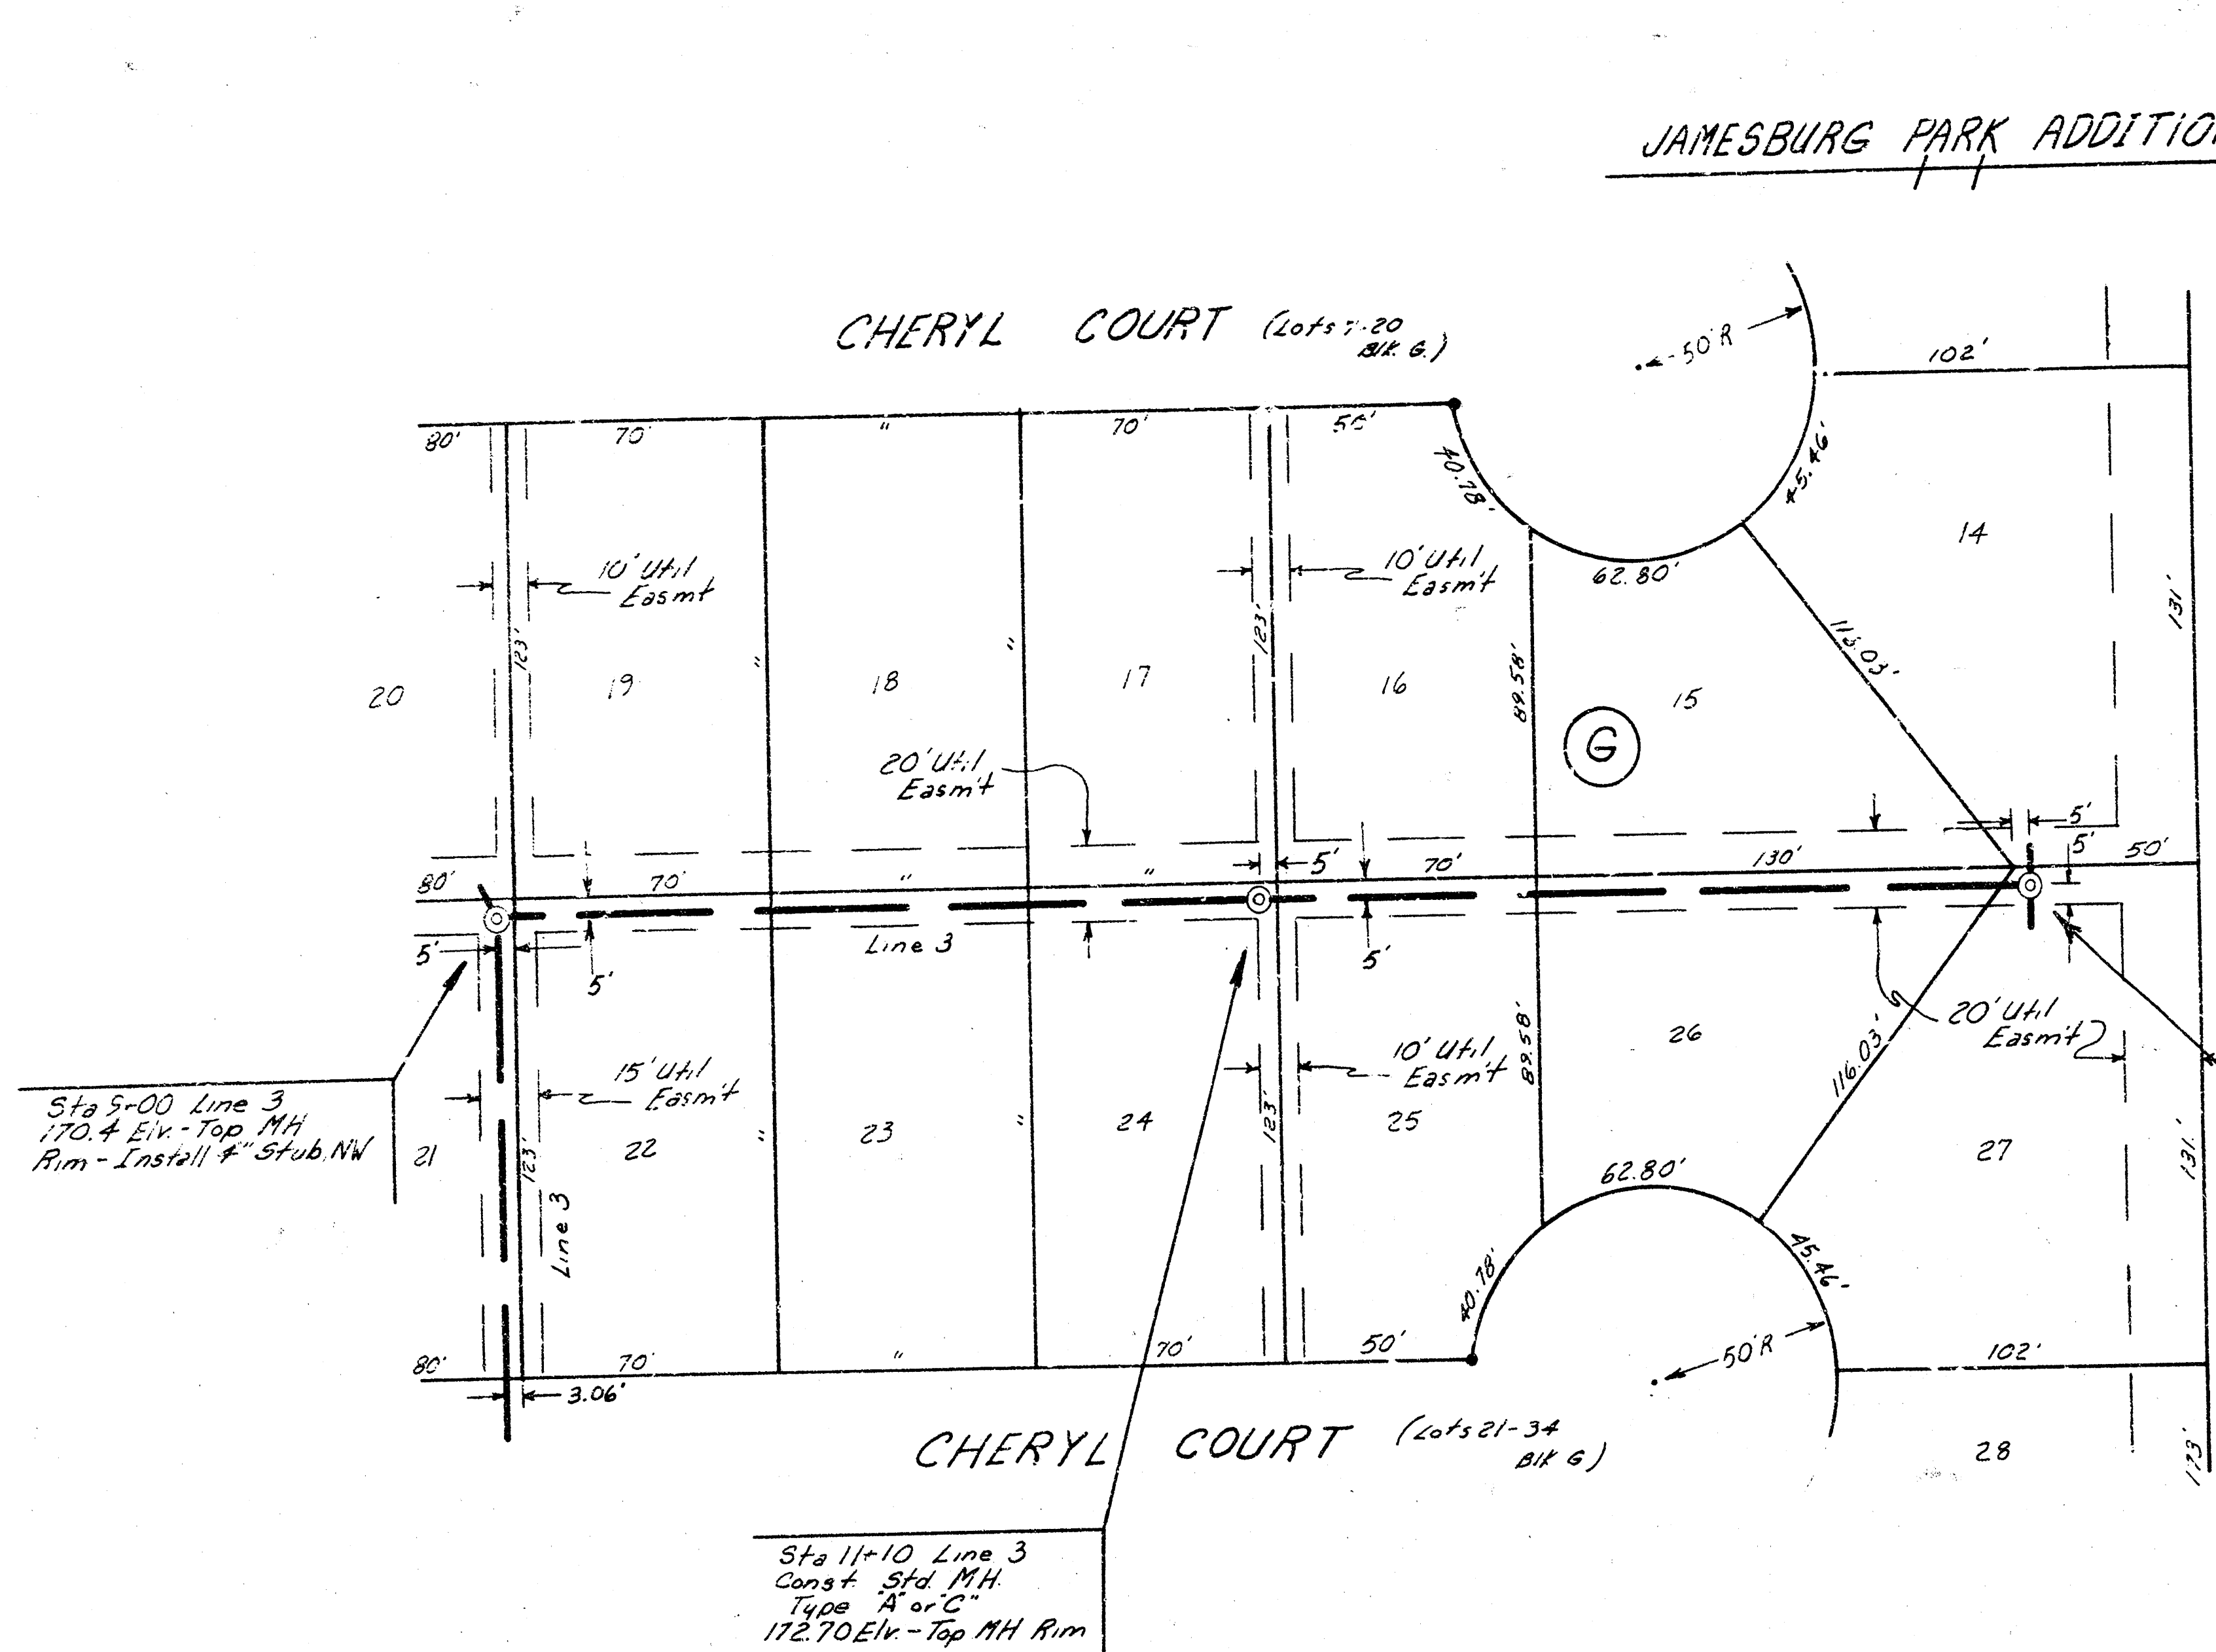



SCALE: Plan 1"=40'
Profile 1"=10' Horiz.
1"=5' Vert.

Sta 0+00 Line 3B =
Sta 5+36 Line 3
169.4 Elev. - Top MH
Rim.

Sta 13+20 Line 3
Const. Std. MH, Type
"C", 174.20 Elev. - Top
MH Rim, Install 4"
Stubs, N, S, V

Sta 2+05 Line 3B
Const. Std. MH,
Type "C",
171.0 Elev. - Top MH Rim
Install 4" Stub, N, S, V

Sta 4+45 Line 3B
Const. Std. MH,
Type "C",
171.0 Elev. - Top MH Rim
Install 4" Stub, N, S, V

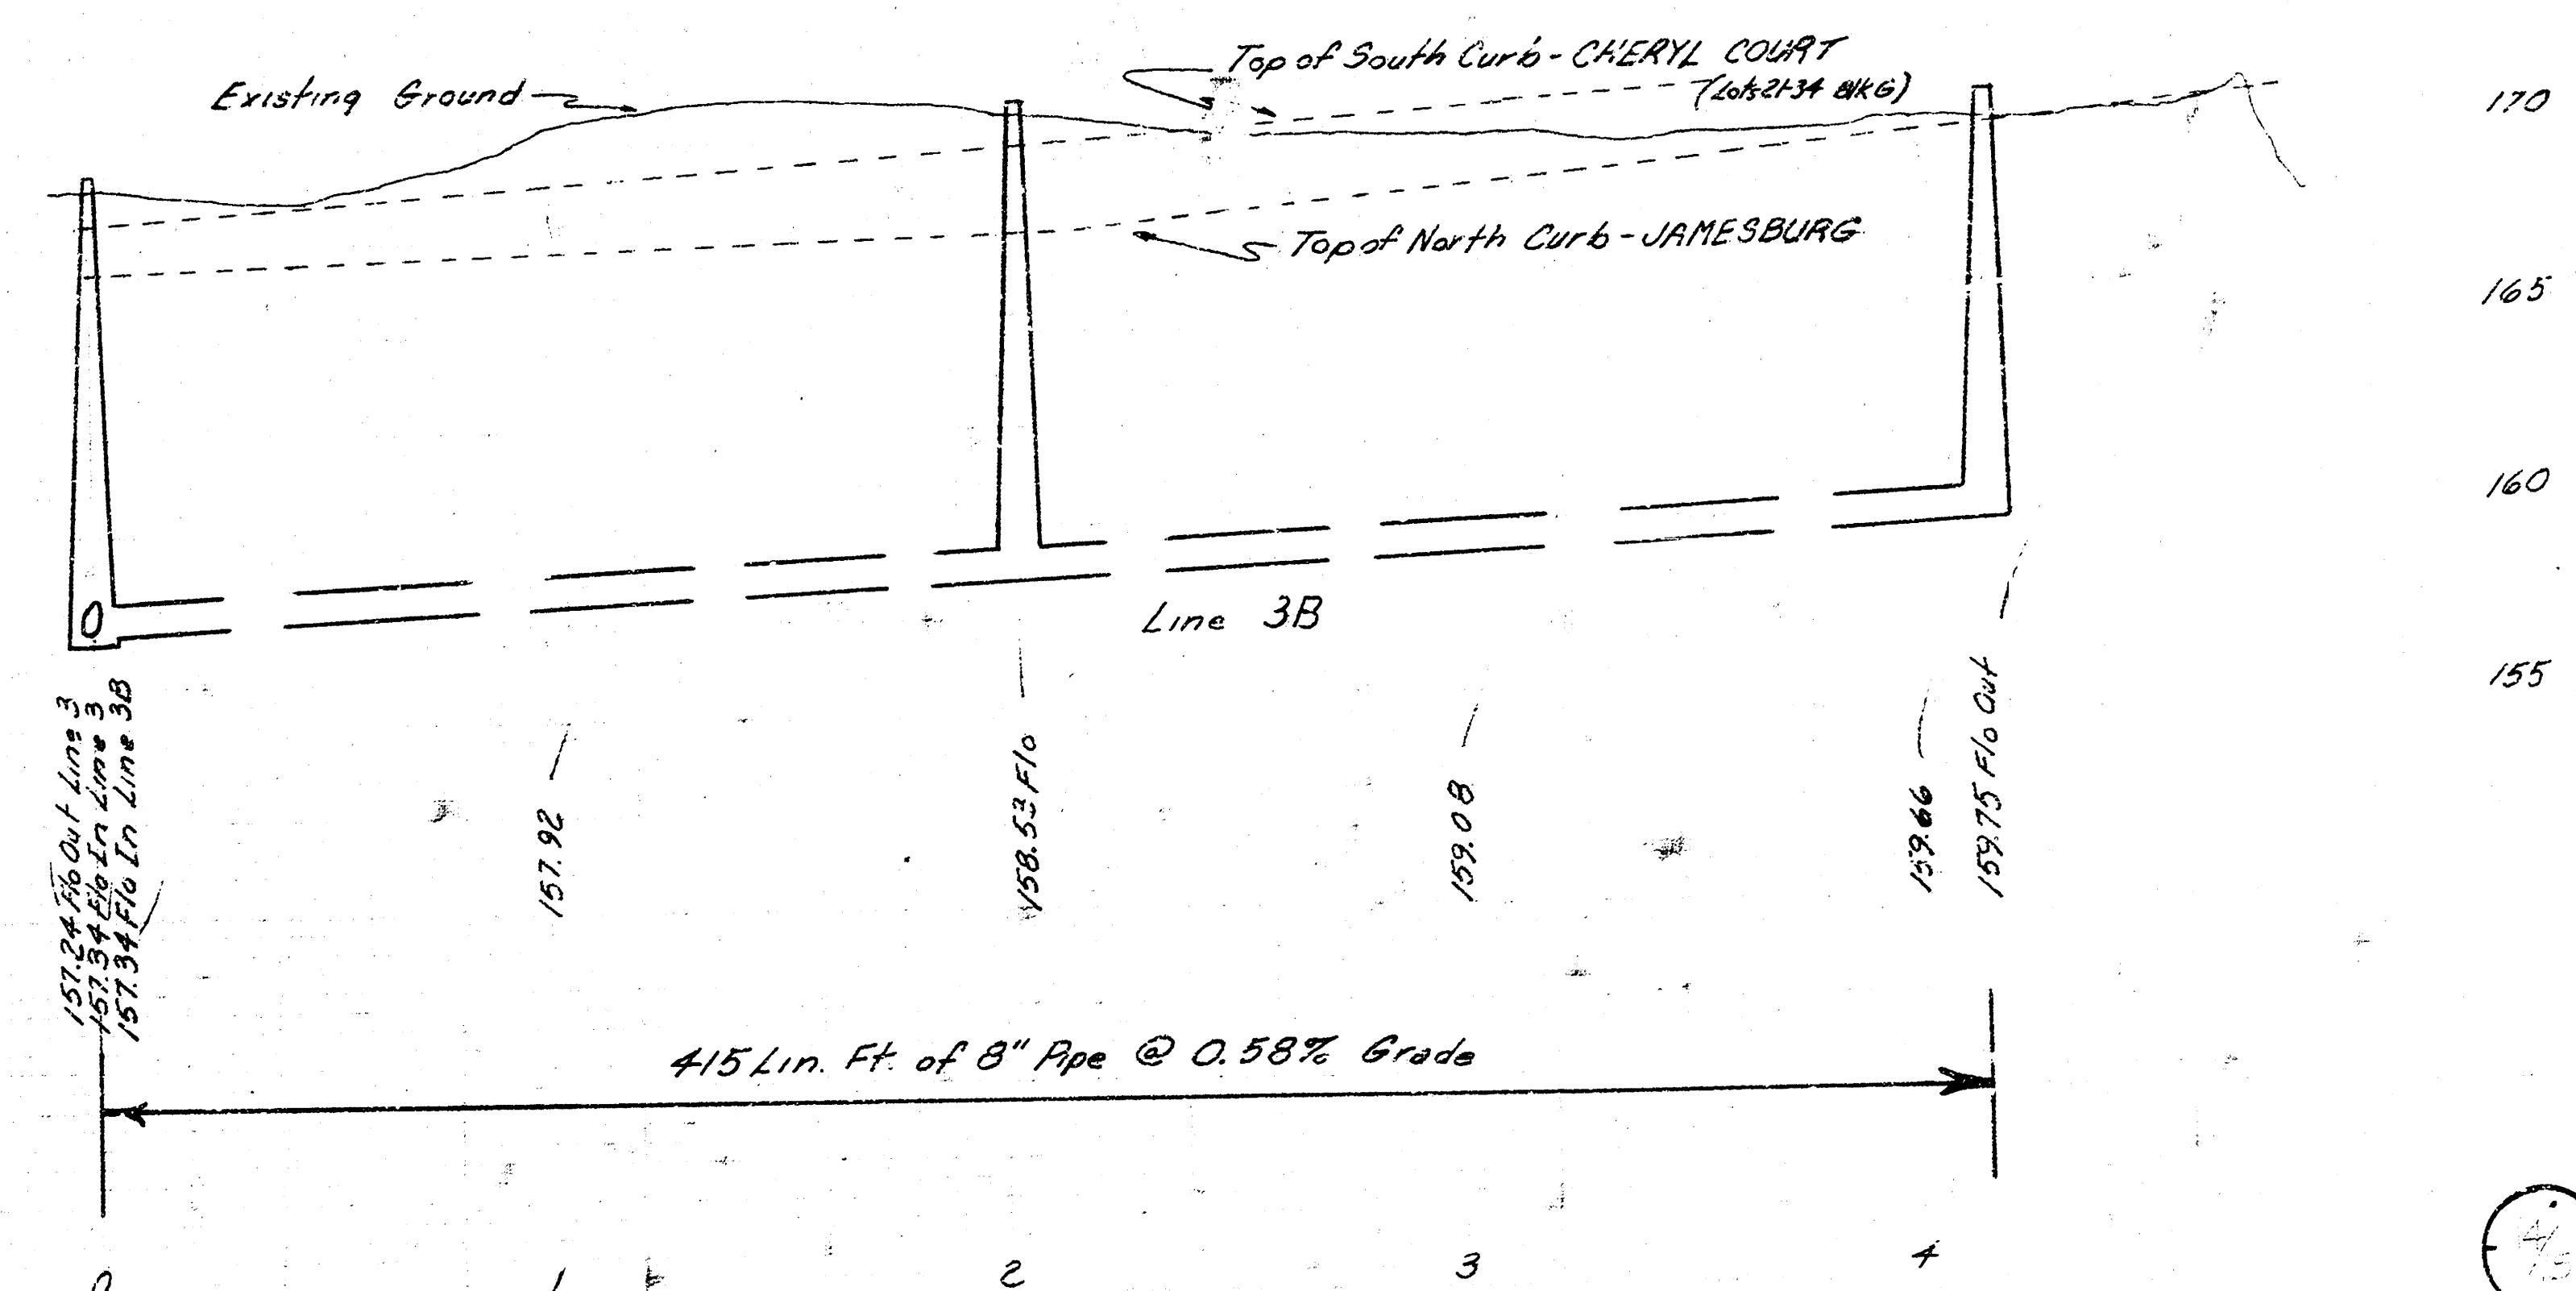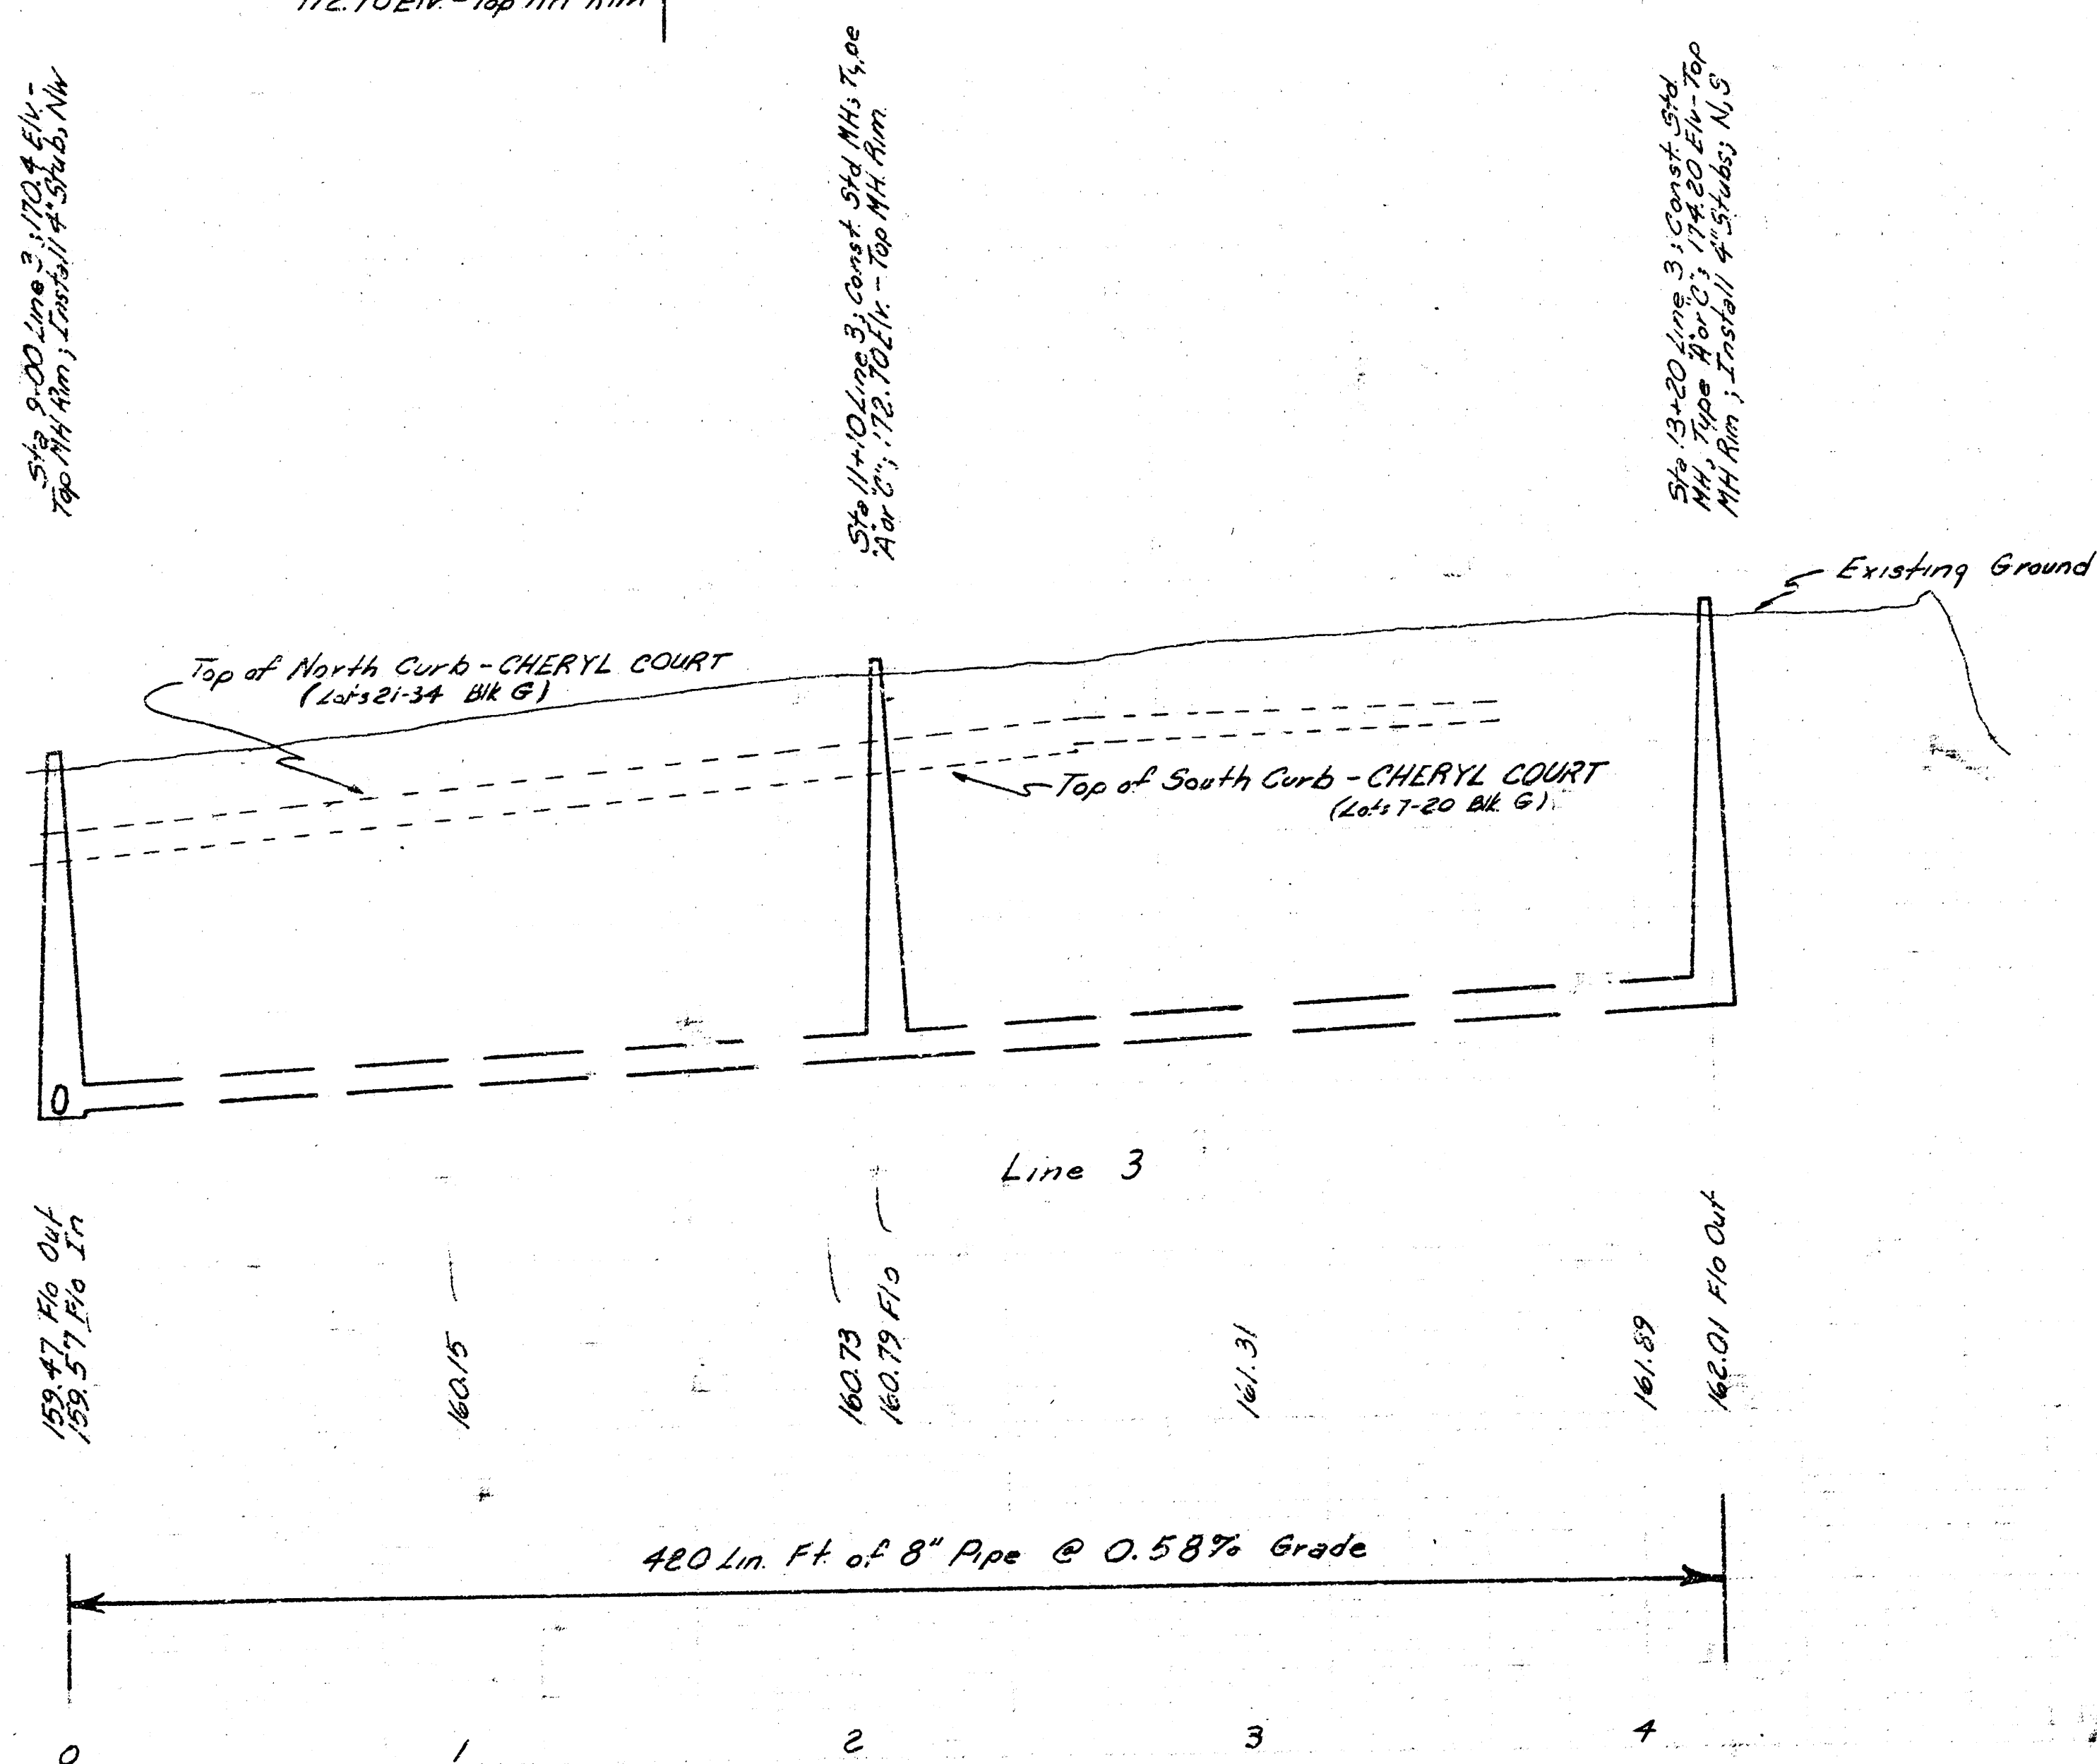


LAT 1, MAIN 4, WESTLINK SEWER PHASE II
PROJ. # 448-76-245-80981-000-000-001 LINES 3 and 3B

FILMED FROM THE BEST
AVAILABLE COPY

— JAMESBURG PARK
ADDITION —

JAMESBURG

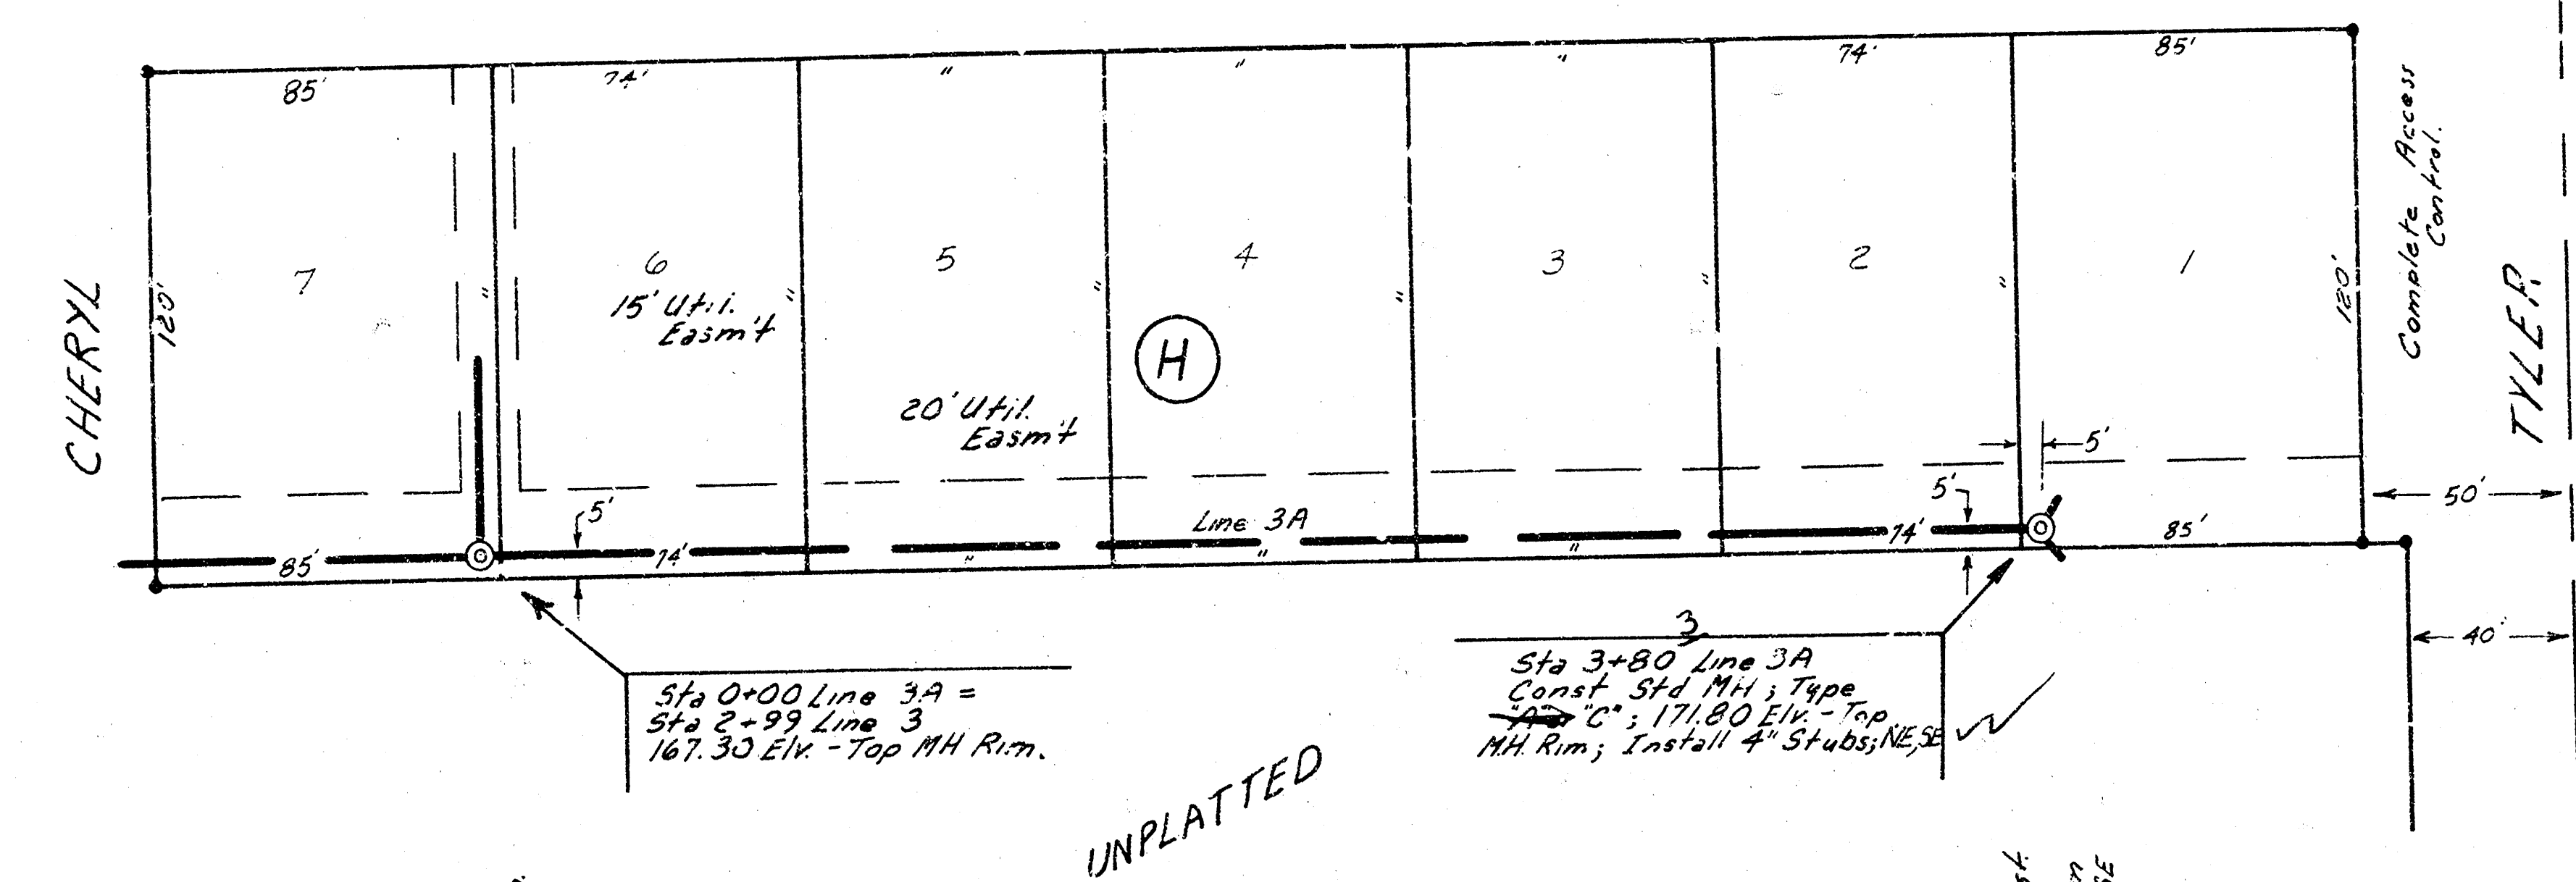

Sta 0+00 Line 3A =
Sta 2+99 Line 3
167.30 Elev - Top MH Rim.

Sta 3+80 Line 3A
Const. Sta. MH; Type
171.80 Elev - Top
MH Rim; Install 4" Stub; NESE


UNPLATTED

Sta 0+00 Line 3A = Sta 2+99
Line 3; 167.30 Elev - Top MH Rim.

Sta 3+80 Line 3A; Const.
Sta. MH; Type A w/ C
171.80 Elev - Top MH Rim
Install 4" Stub; NESE

SCALE: Plan 1" = 40'
Profile 1" = 40' Horiz.
1" = 5' Vert.
• Irons

170
165
160
155

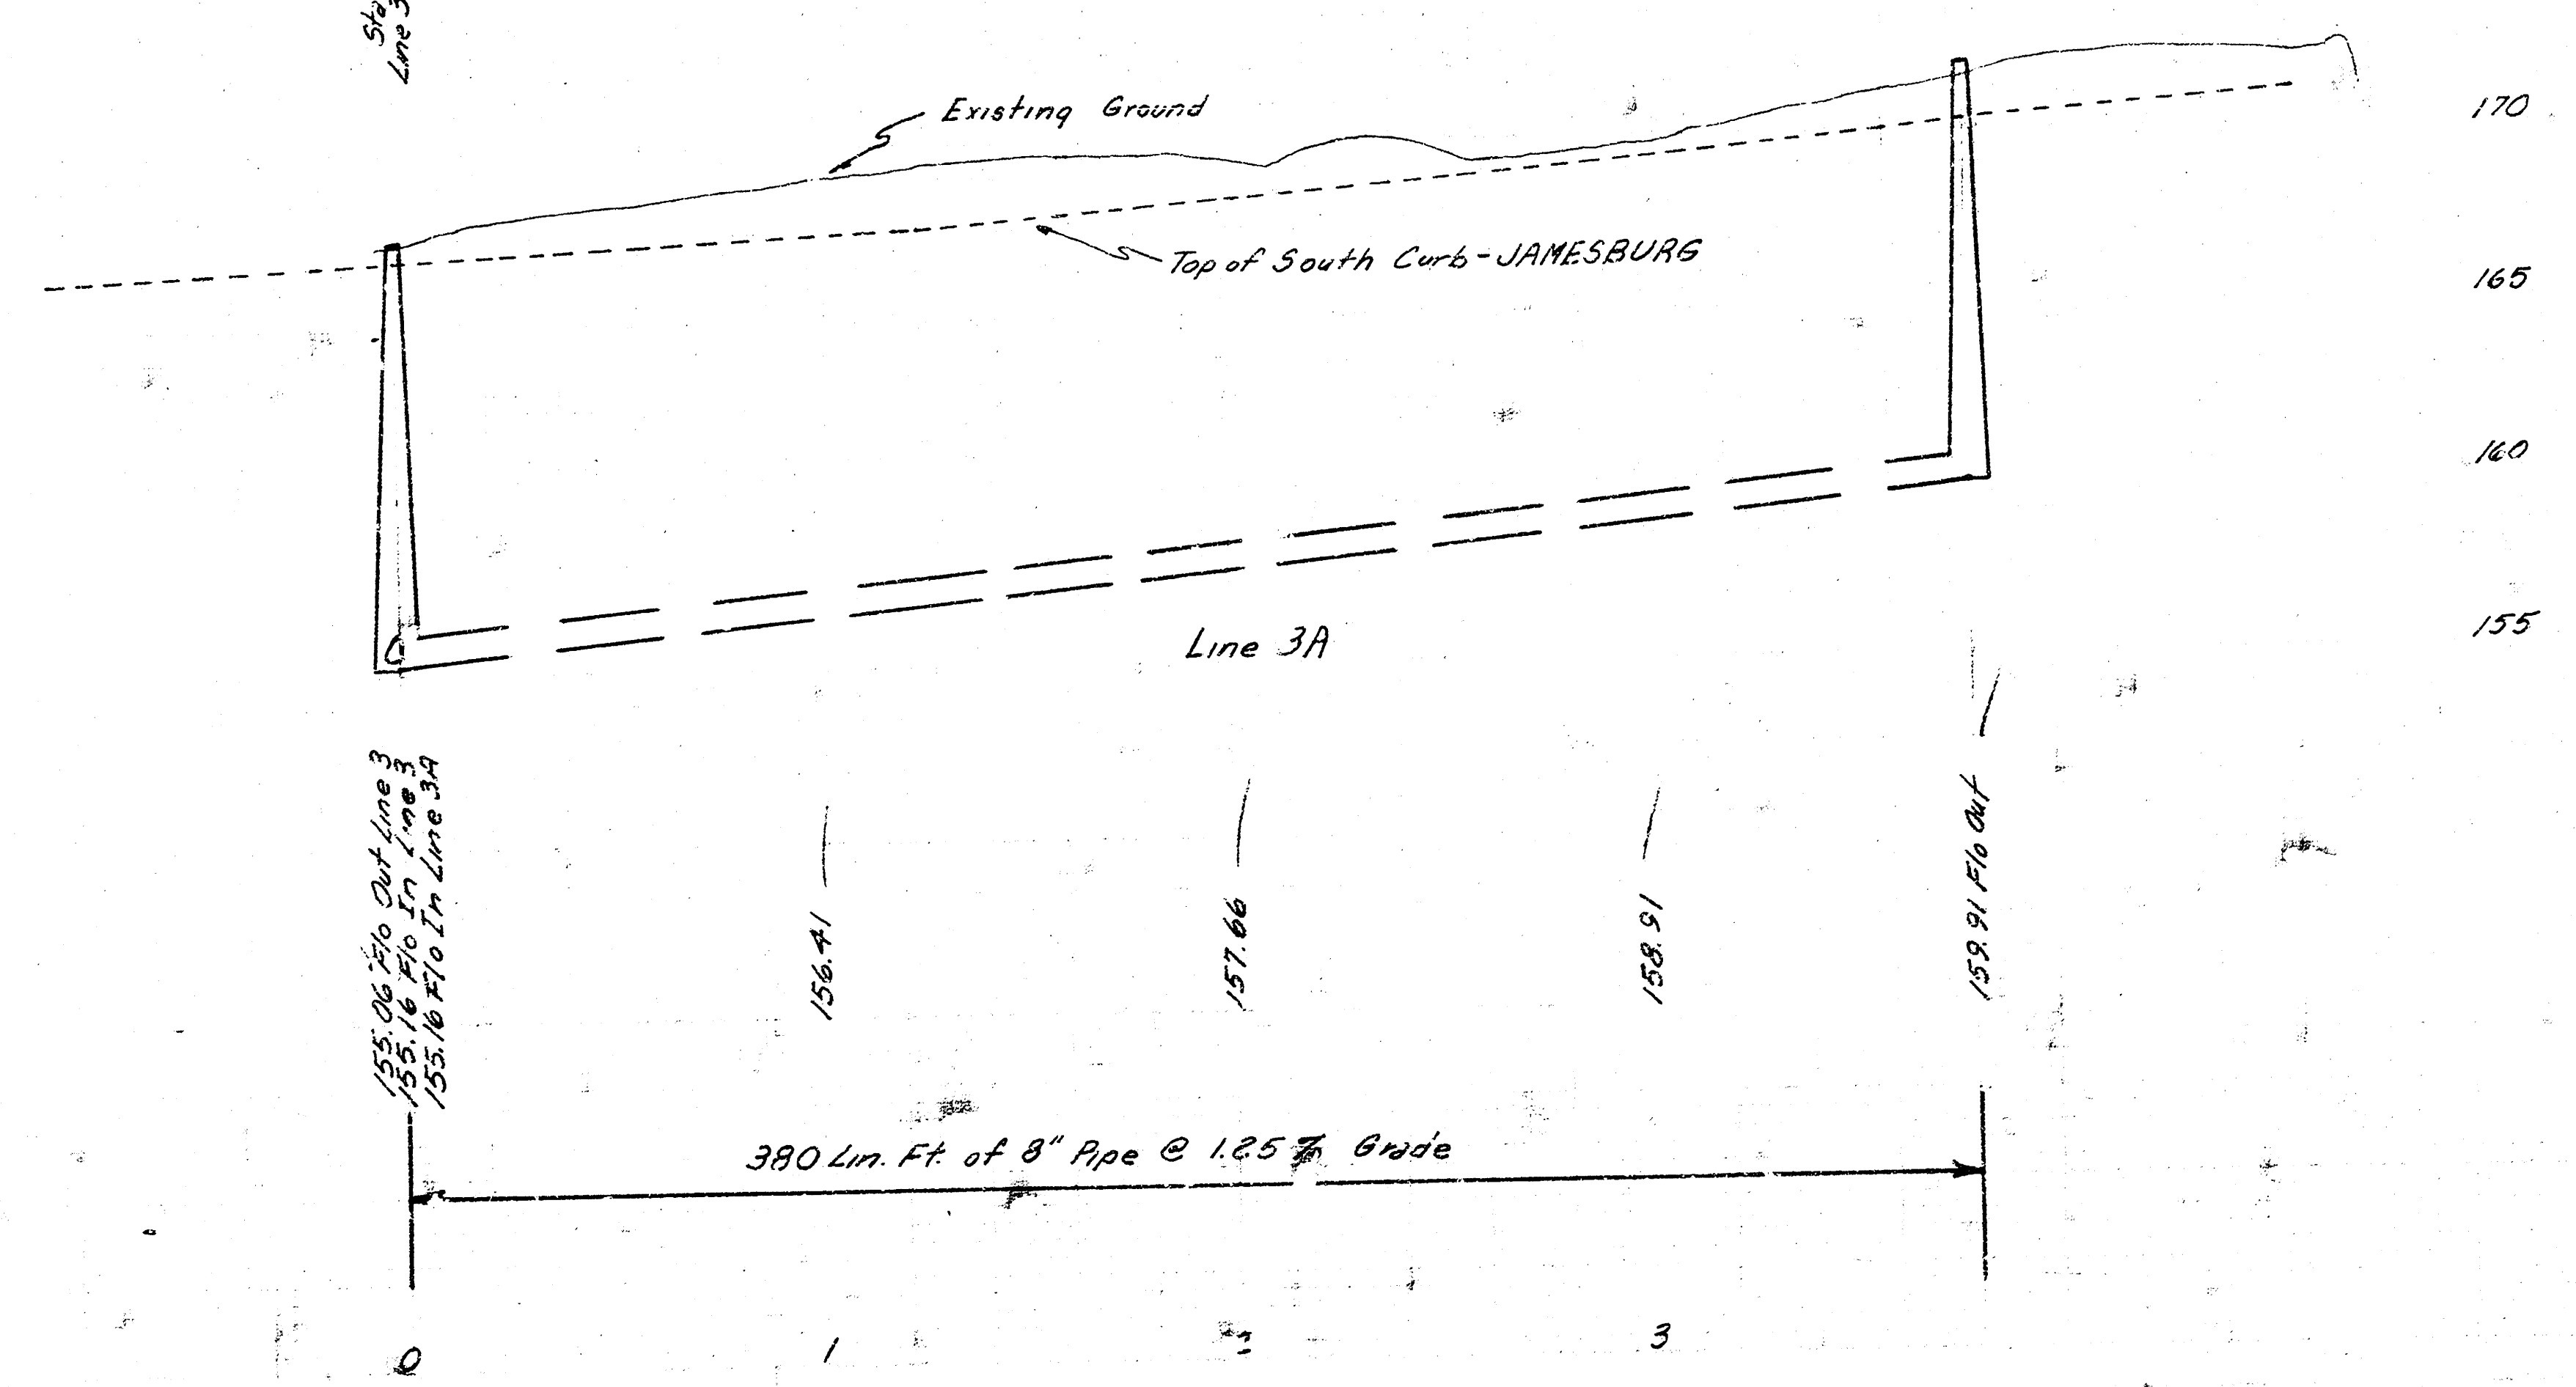

380 Lin. Ft. of 8" Pipe @ 1.25% Grade

2 AT 1: MAIN 4" WESTLINK SEWER PHASE II
PROJ. # 468-76-245-80981-000-000-001 LINE 3A

FILMED FROM THE BEST
AVAILABLE COPY