

L 8-20A

L 8-20A

On 1/4 Section 5-37

SHEET
2 OF 8



JAMESBURG PARK

AN ADDITION TO WICHITA, SEDGWICK COUNTY, KANSAS

N.W. Cor. NE. 1/4, Sec. 8

2628.59' N 89°36'36"E

N.E. Cor. Sec. 8, 27, 1W

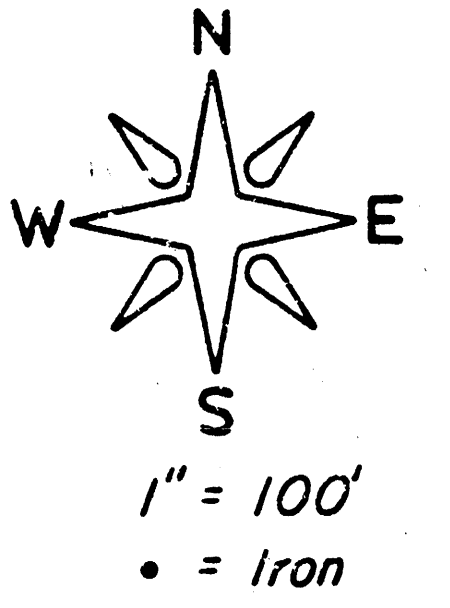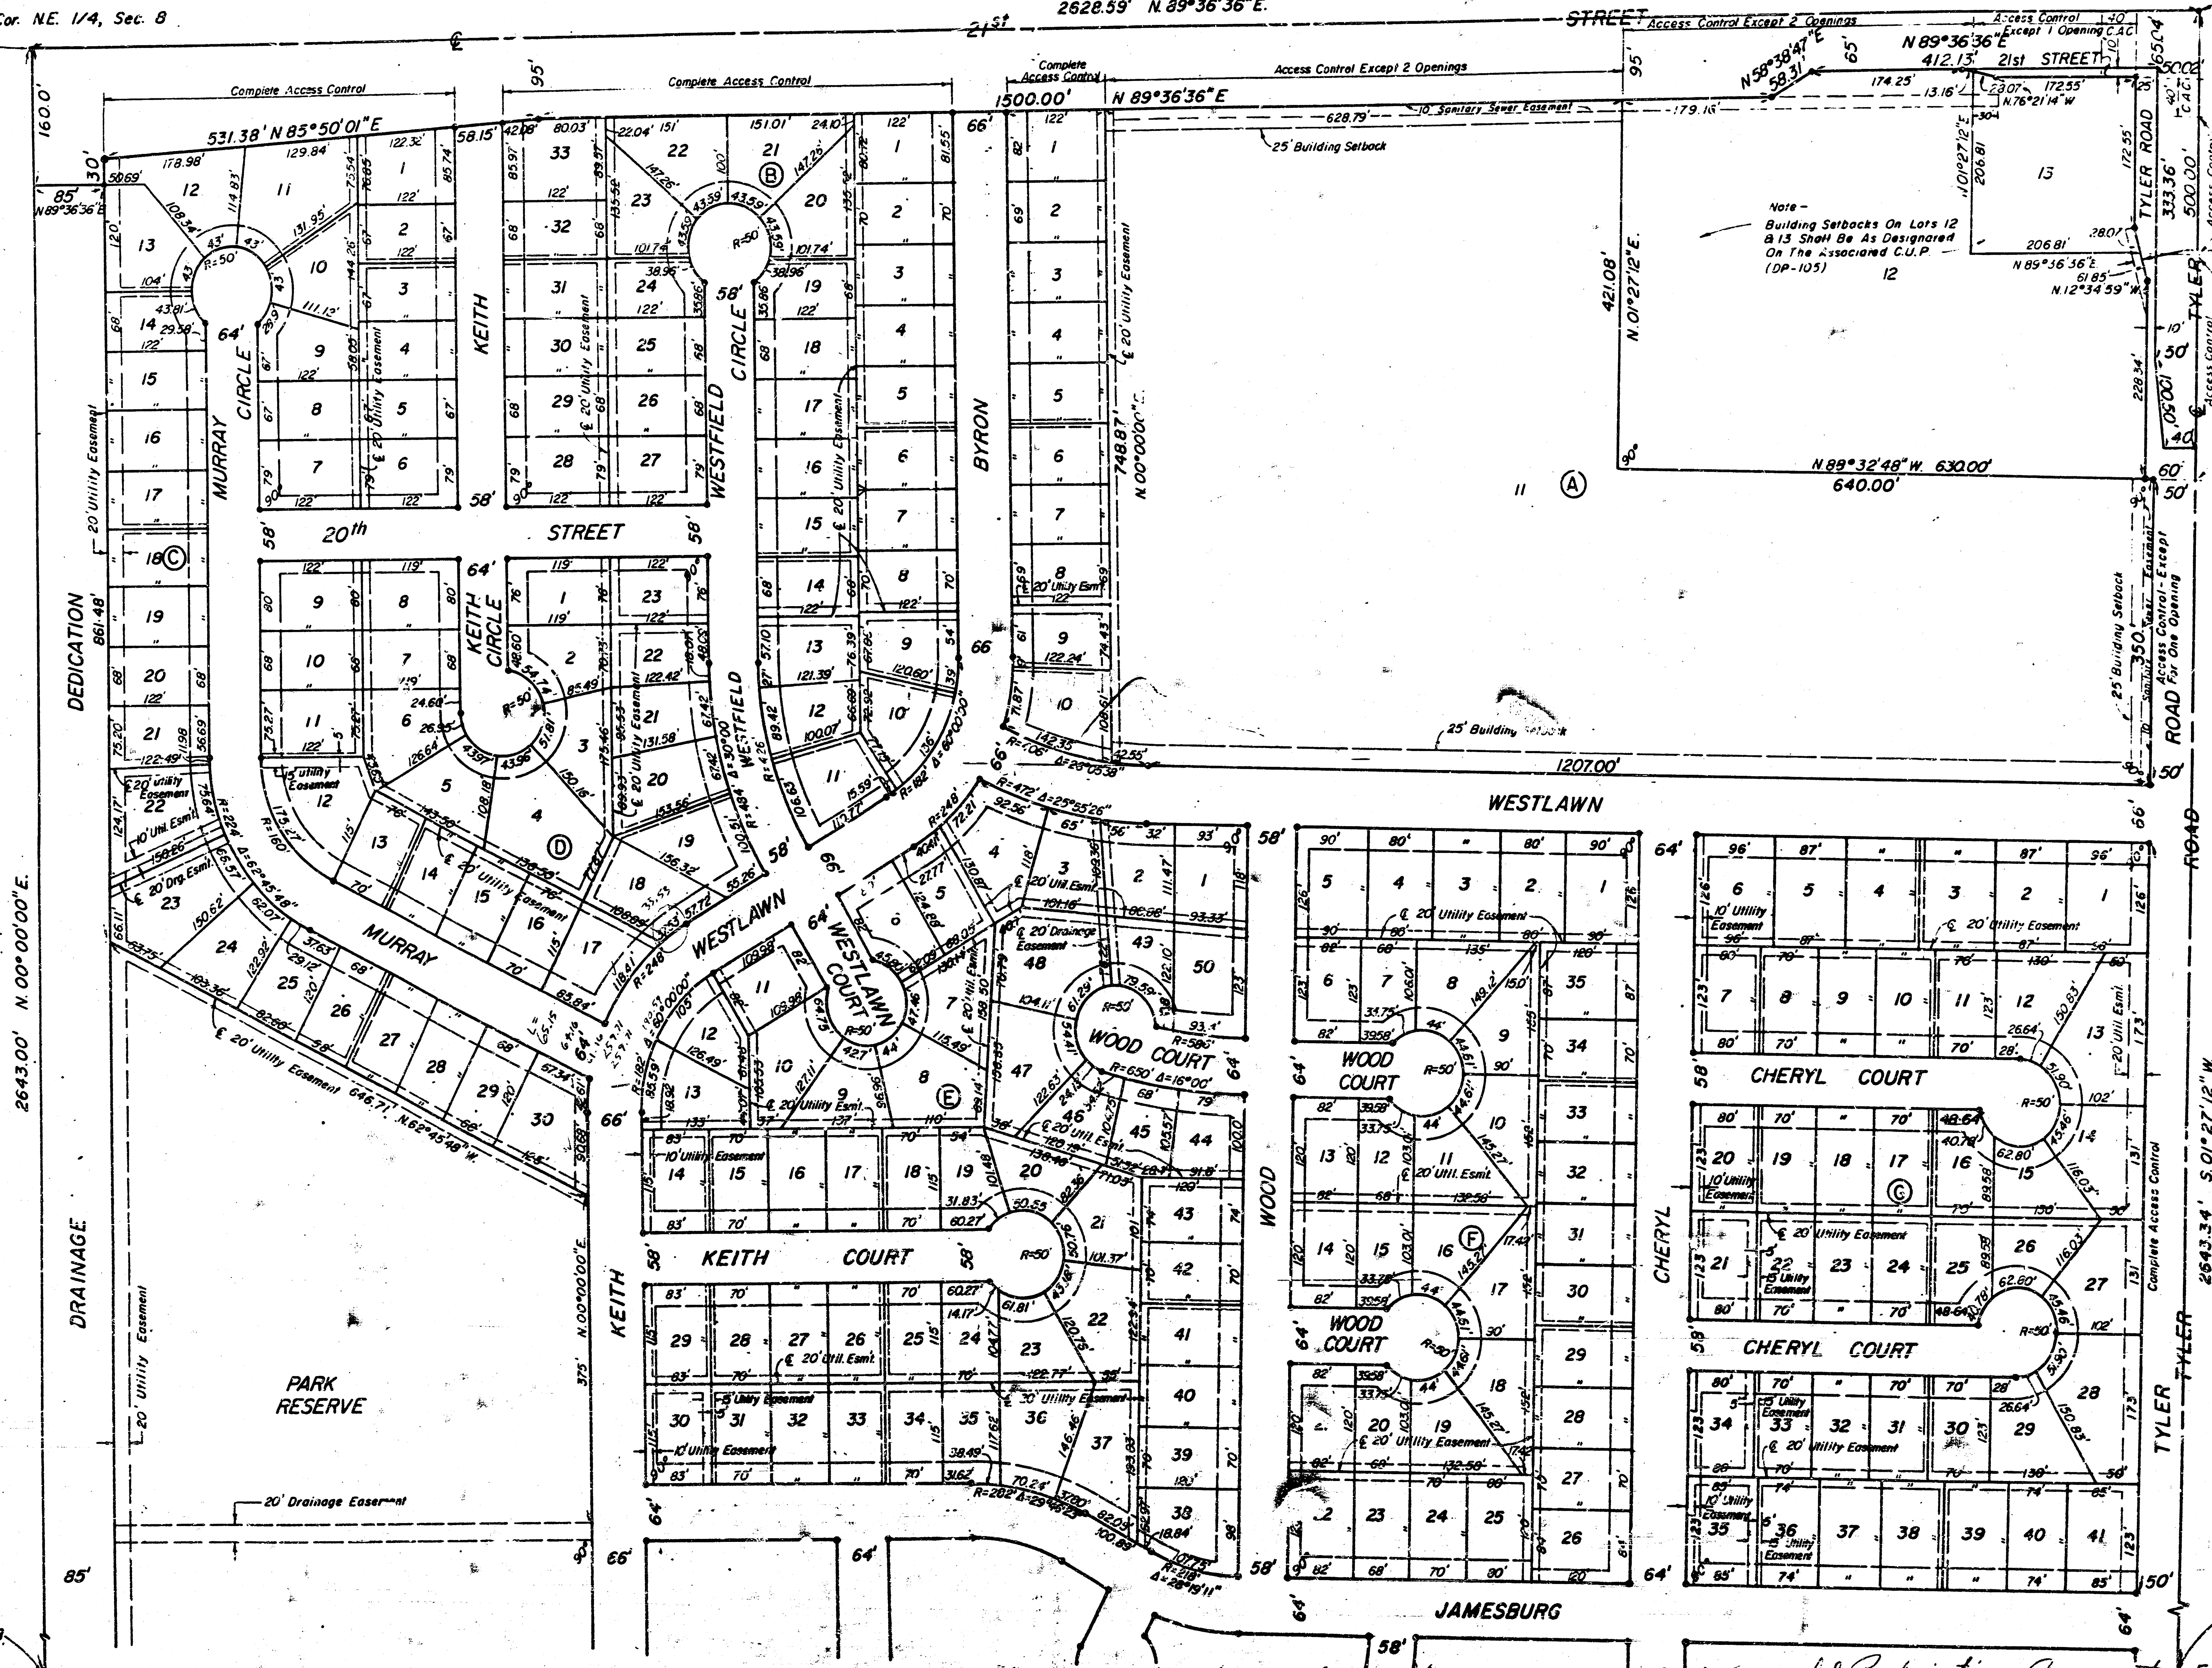

REFILE
#531184

SHEET 1 OF 2 SHEETS

NOTE
All utility easements are 10' wide except where noted otherwise.
Front building setbacks are 25'. Street side building setbacks on corner lots are 15'.
(Except for Lots 11, 12 and 13 in Block A).

STATE OF KANSAS, COUNTY OF SEDGWICK, SS:
This is to certify that this Plat was refilled this 25th day of MARCH, 1981, at 9:00 A.M. by Don C. Moehring II, for the purpose of correcting front lot dimension in Lots 16 and 25, Block G, and rear lot dimension in Lot 13, Block C; together with revised Utility Easements in Lots 8 and 9, Block A; Lots 8, 9, 13 and 14, Block B; Lots 21 and 22, Block C; Lots 12, 23 and 24, Block D; Lot 30, Block E; Lots 21, 34 and 35, Block G; Lot 7 Block H; Lot 8 Block J; Lots 14 and 15, Block K.

Bette F. McCurt Register of Deeds

Pat Keiler Deputy
Pat Keiler

LAT 2, MAIN 4, WESTLINK SEWER
468-76-245-80980-898-000-001


S.E. Cor. NE. 1/4, Sec. 8

35.00 REFILE 35.00




Restrictive Covenants F 470 pg 1514
Restrictive Covenants F 473 pg 1536
Restrictive Covenants F 455 pg 1423

2nd Amended Restrictive Covenants F 475 pg 1547


8 10 3 SE L 8-20A

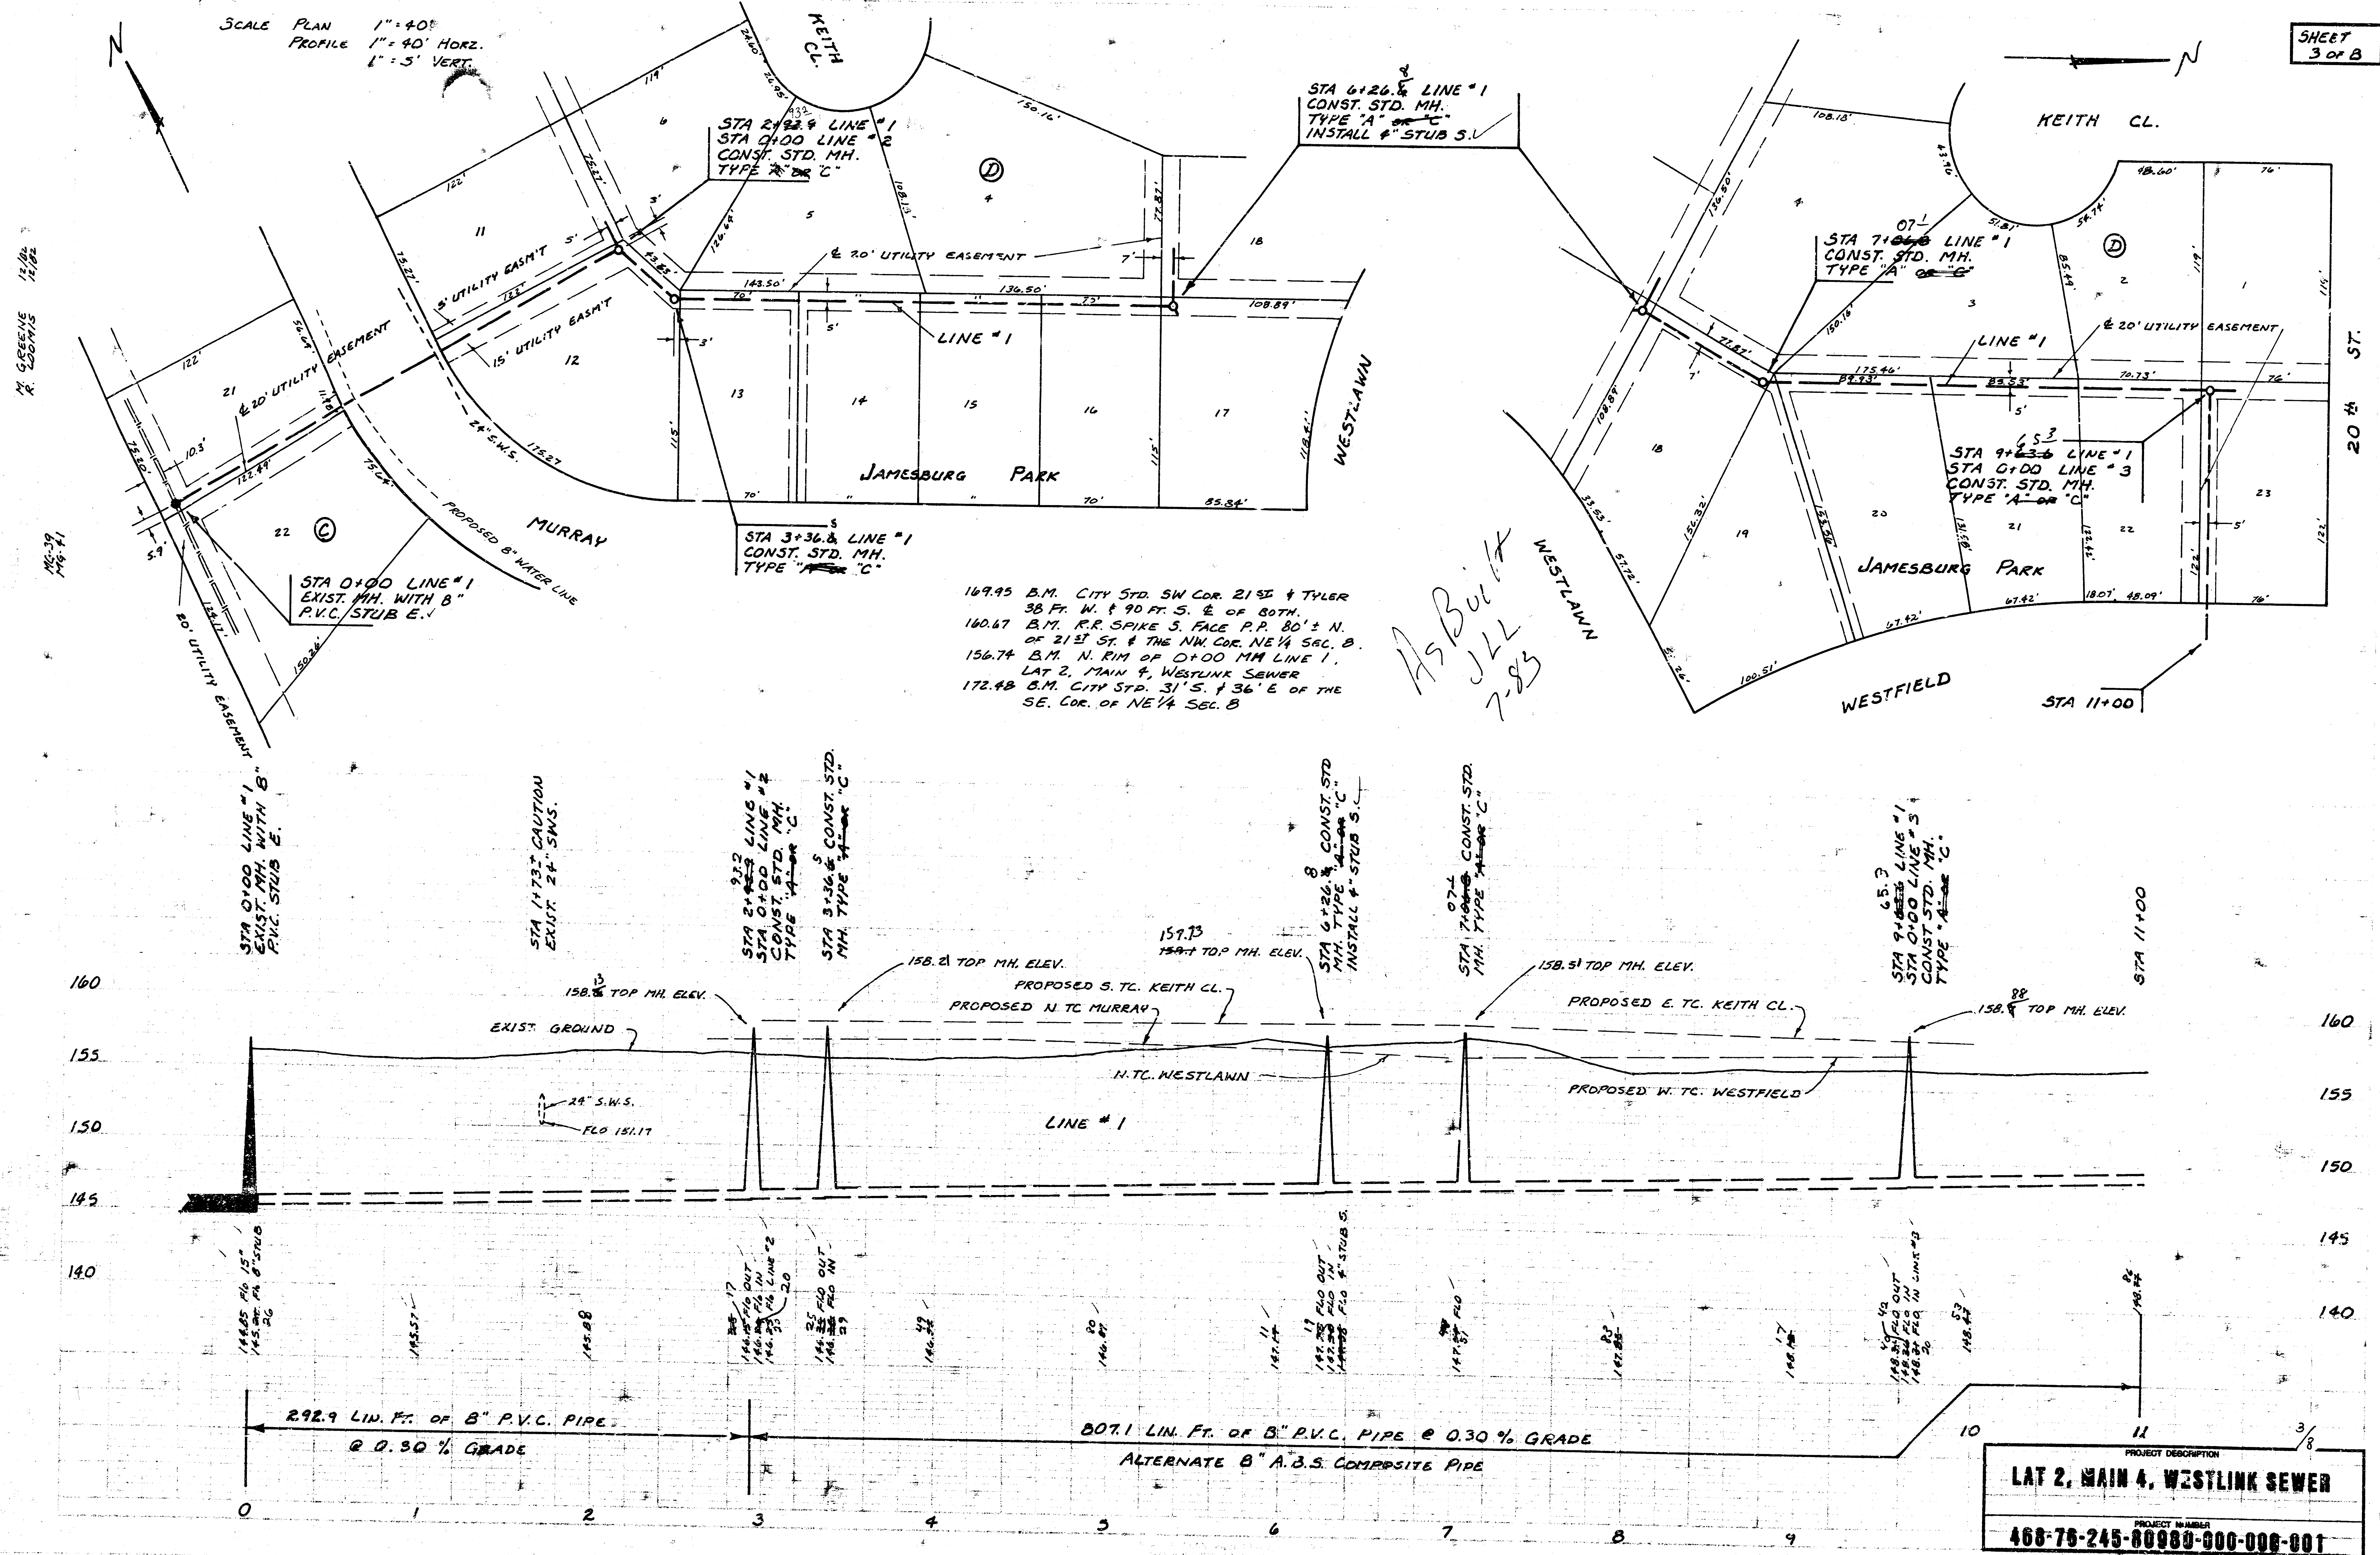


SCALE PLAN 1"=40'
PROFILE 1"=40' HORIZ.
1"=5' VERT.

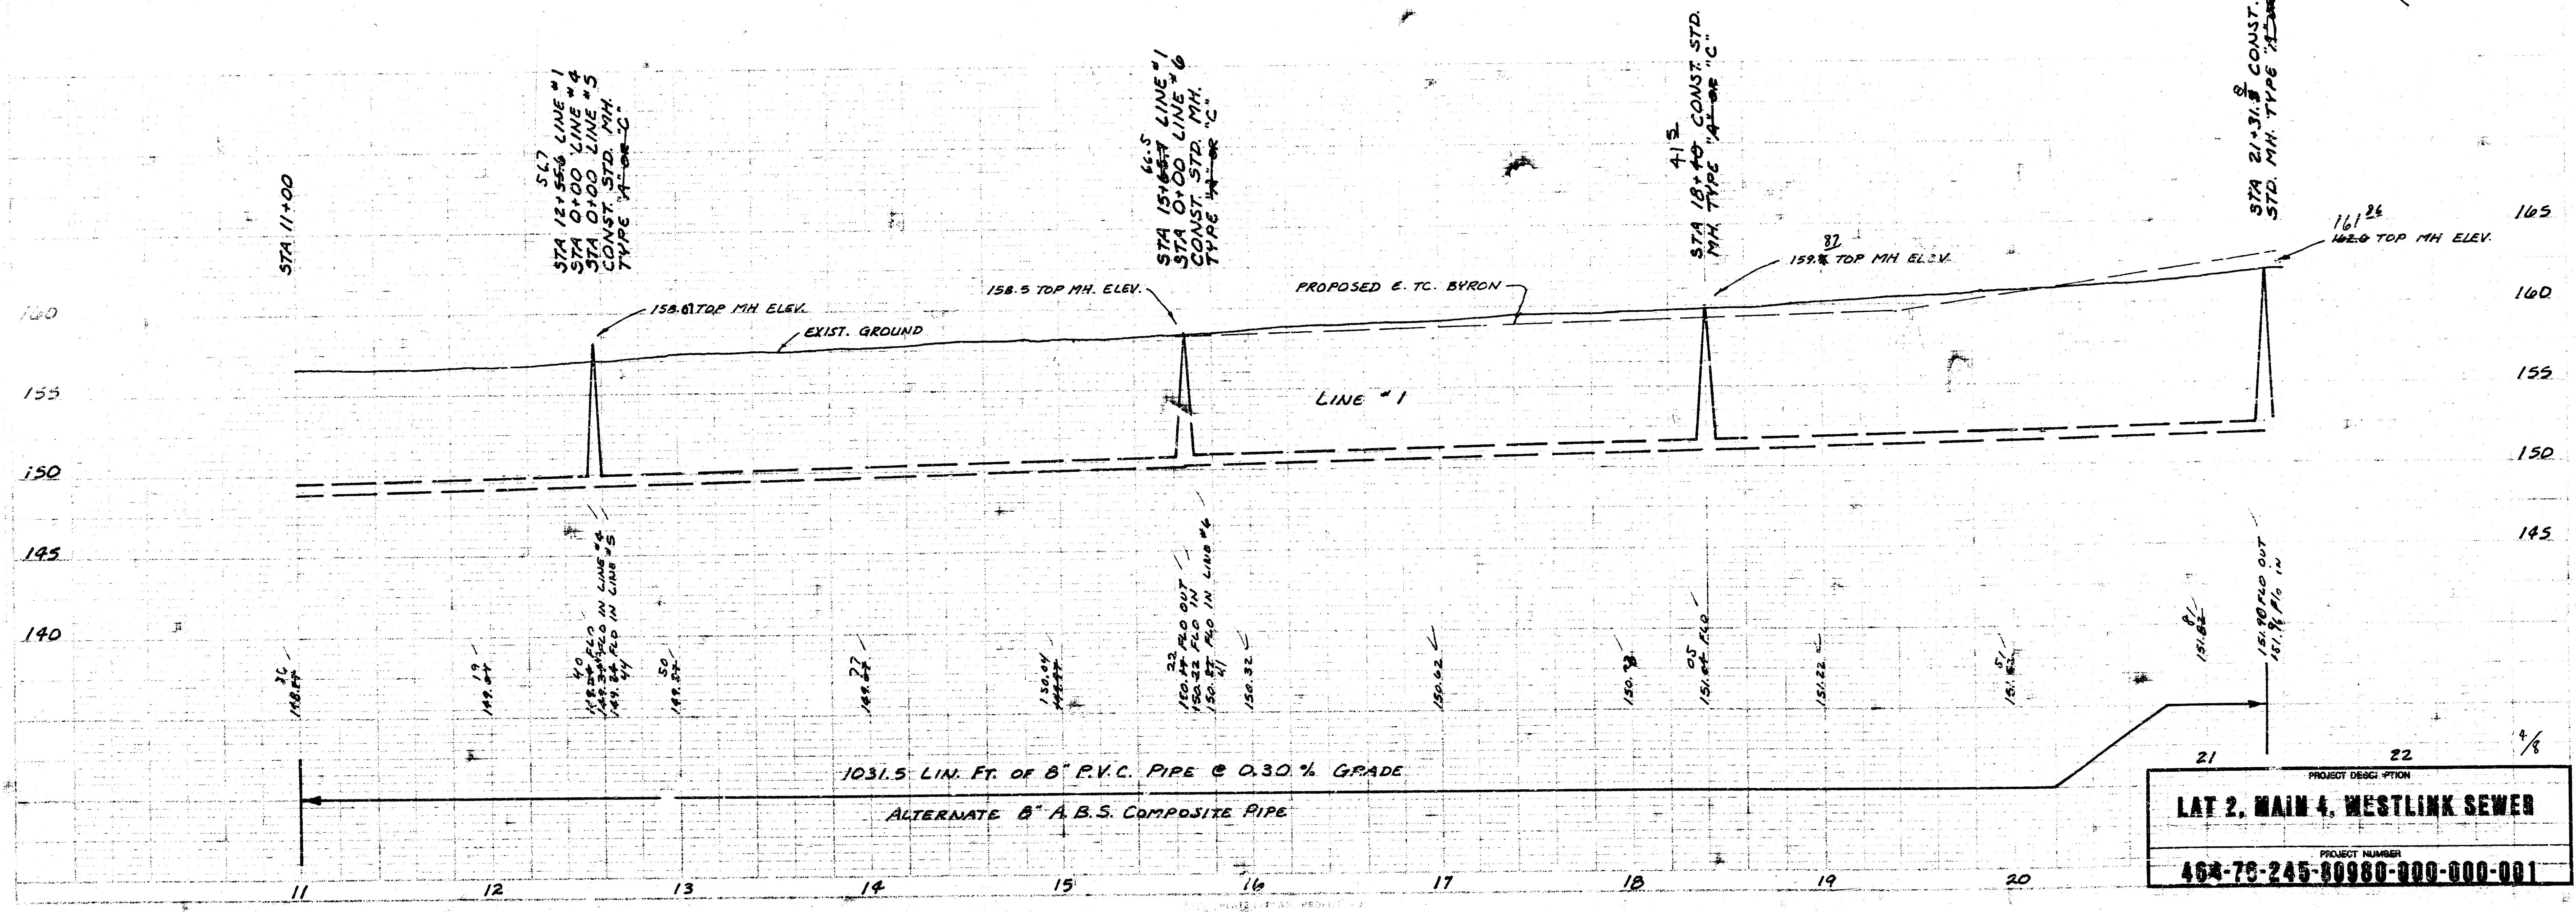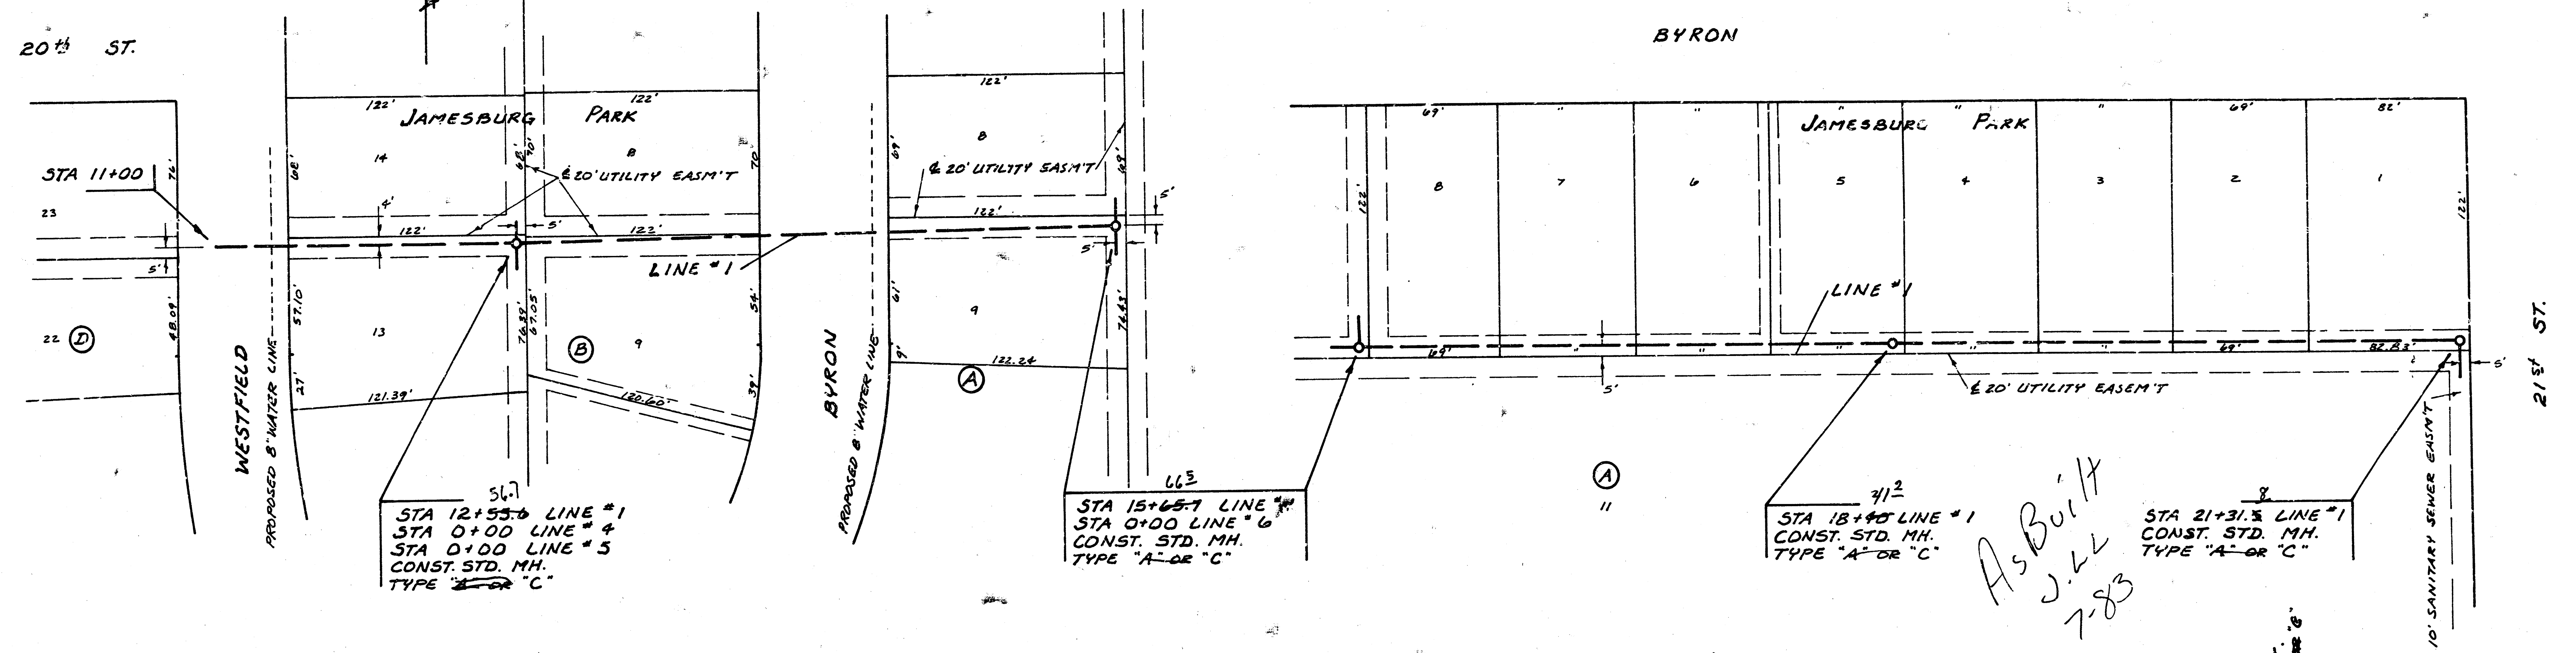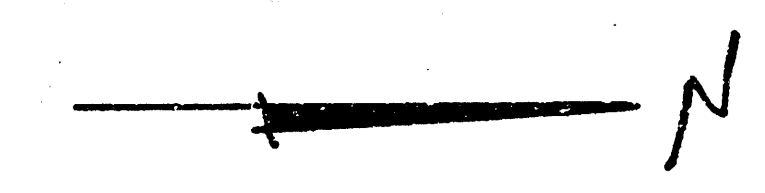


PROJECT DESCRIPTION	
LAT 2. MAIN 4. WESTLINK SEWER	
PROJECT NUMBER	
454-78-245-80980-000-001	

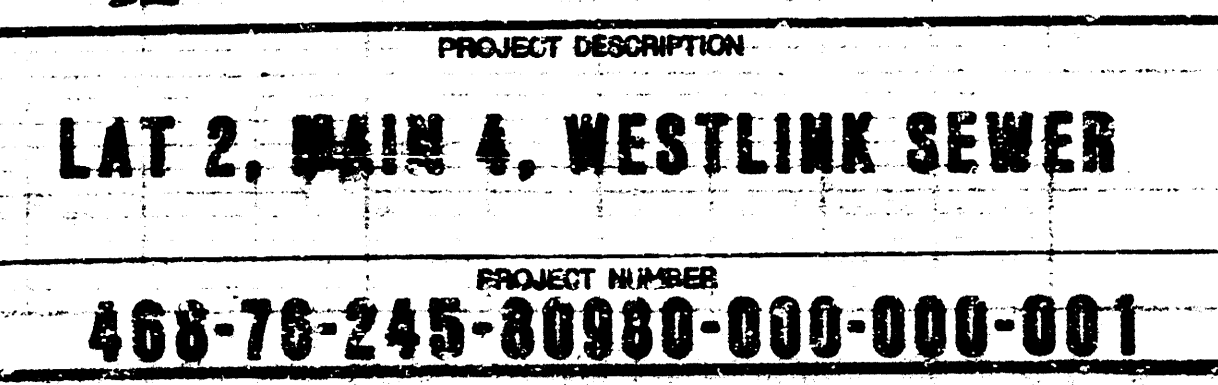


SCALE PLAN 1" = 40'
PROFILE 1" = 40' HORIZ.
1" = 5' VERT.

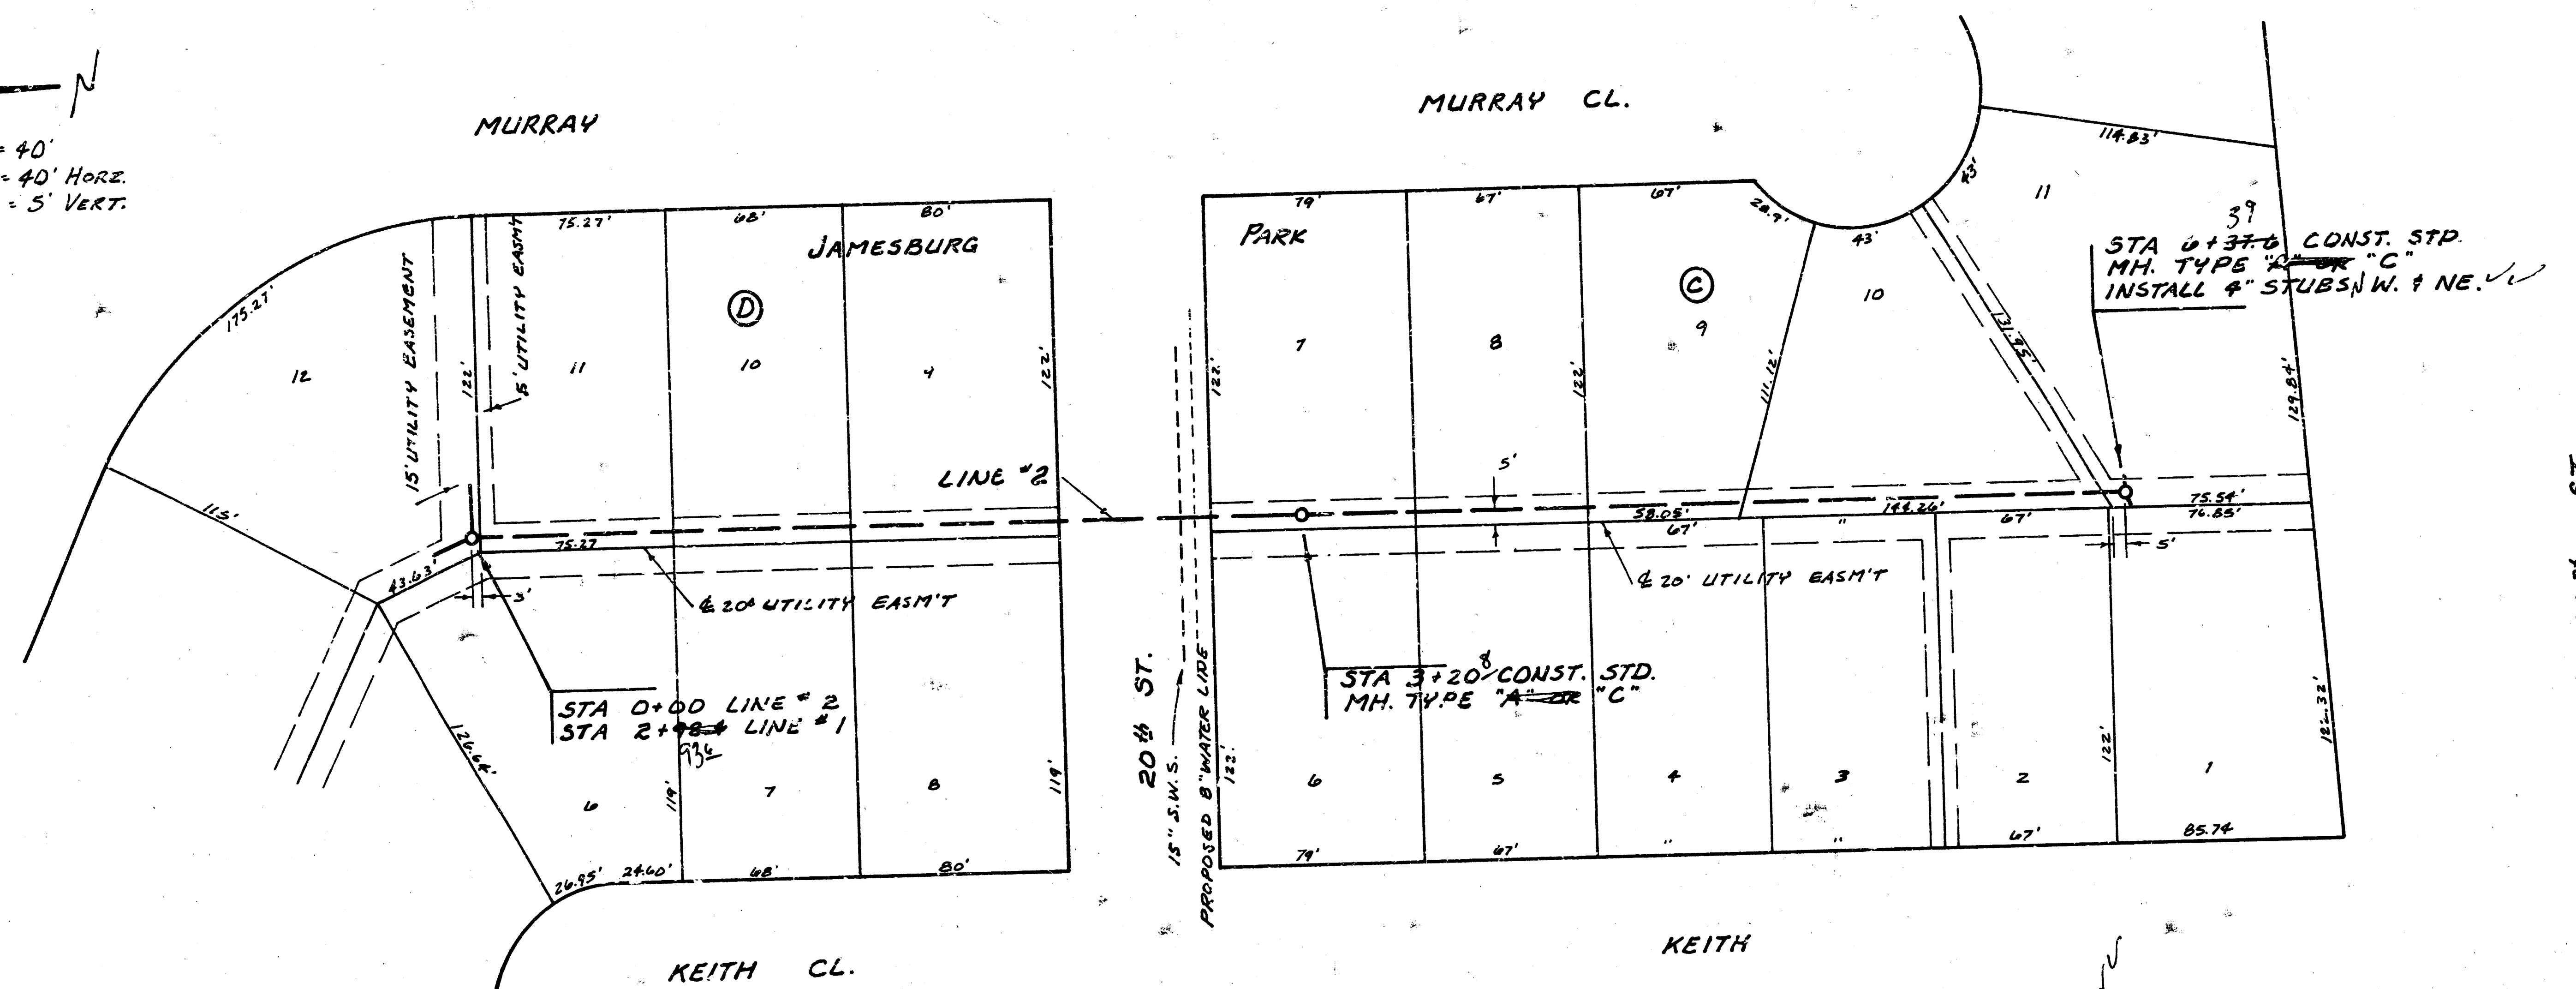


As Built
7-83
J.L.L.

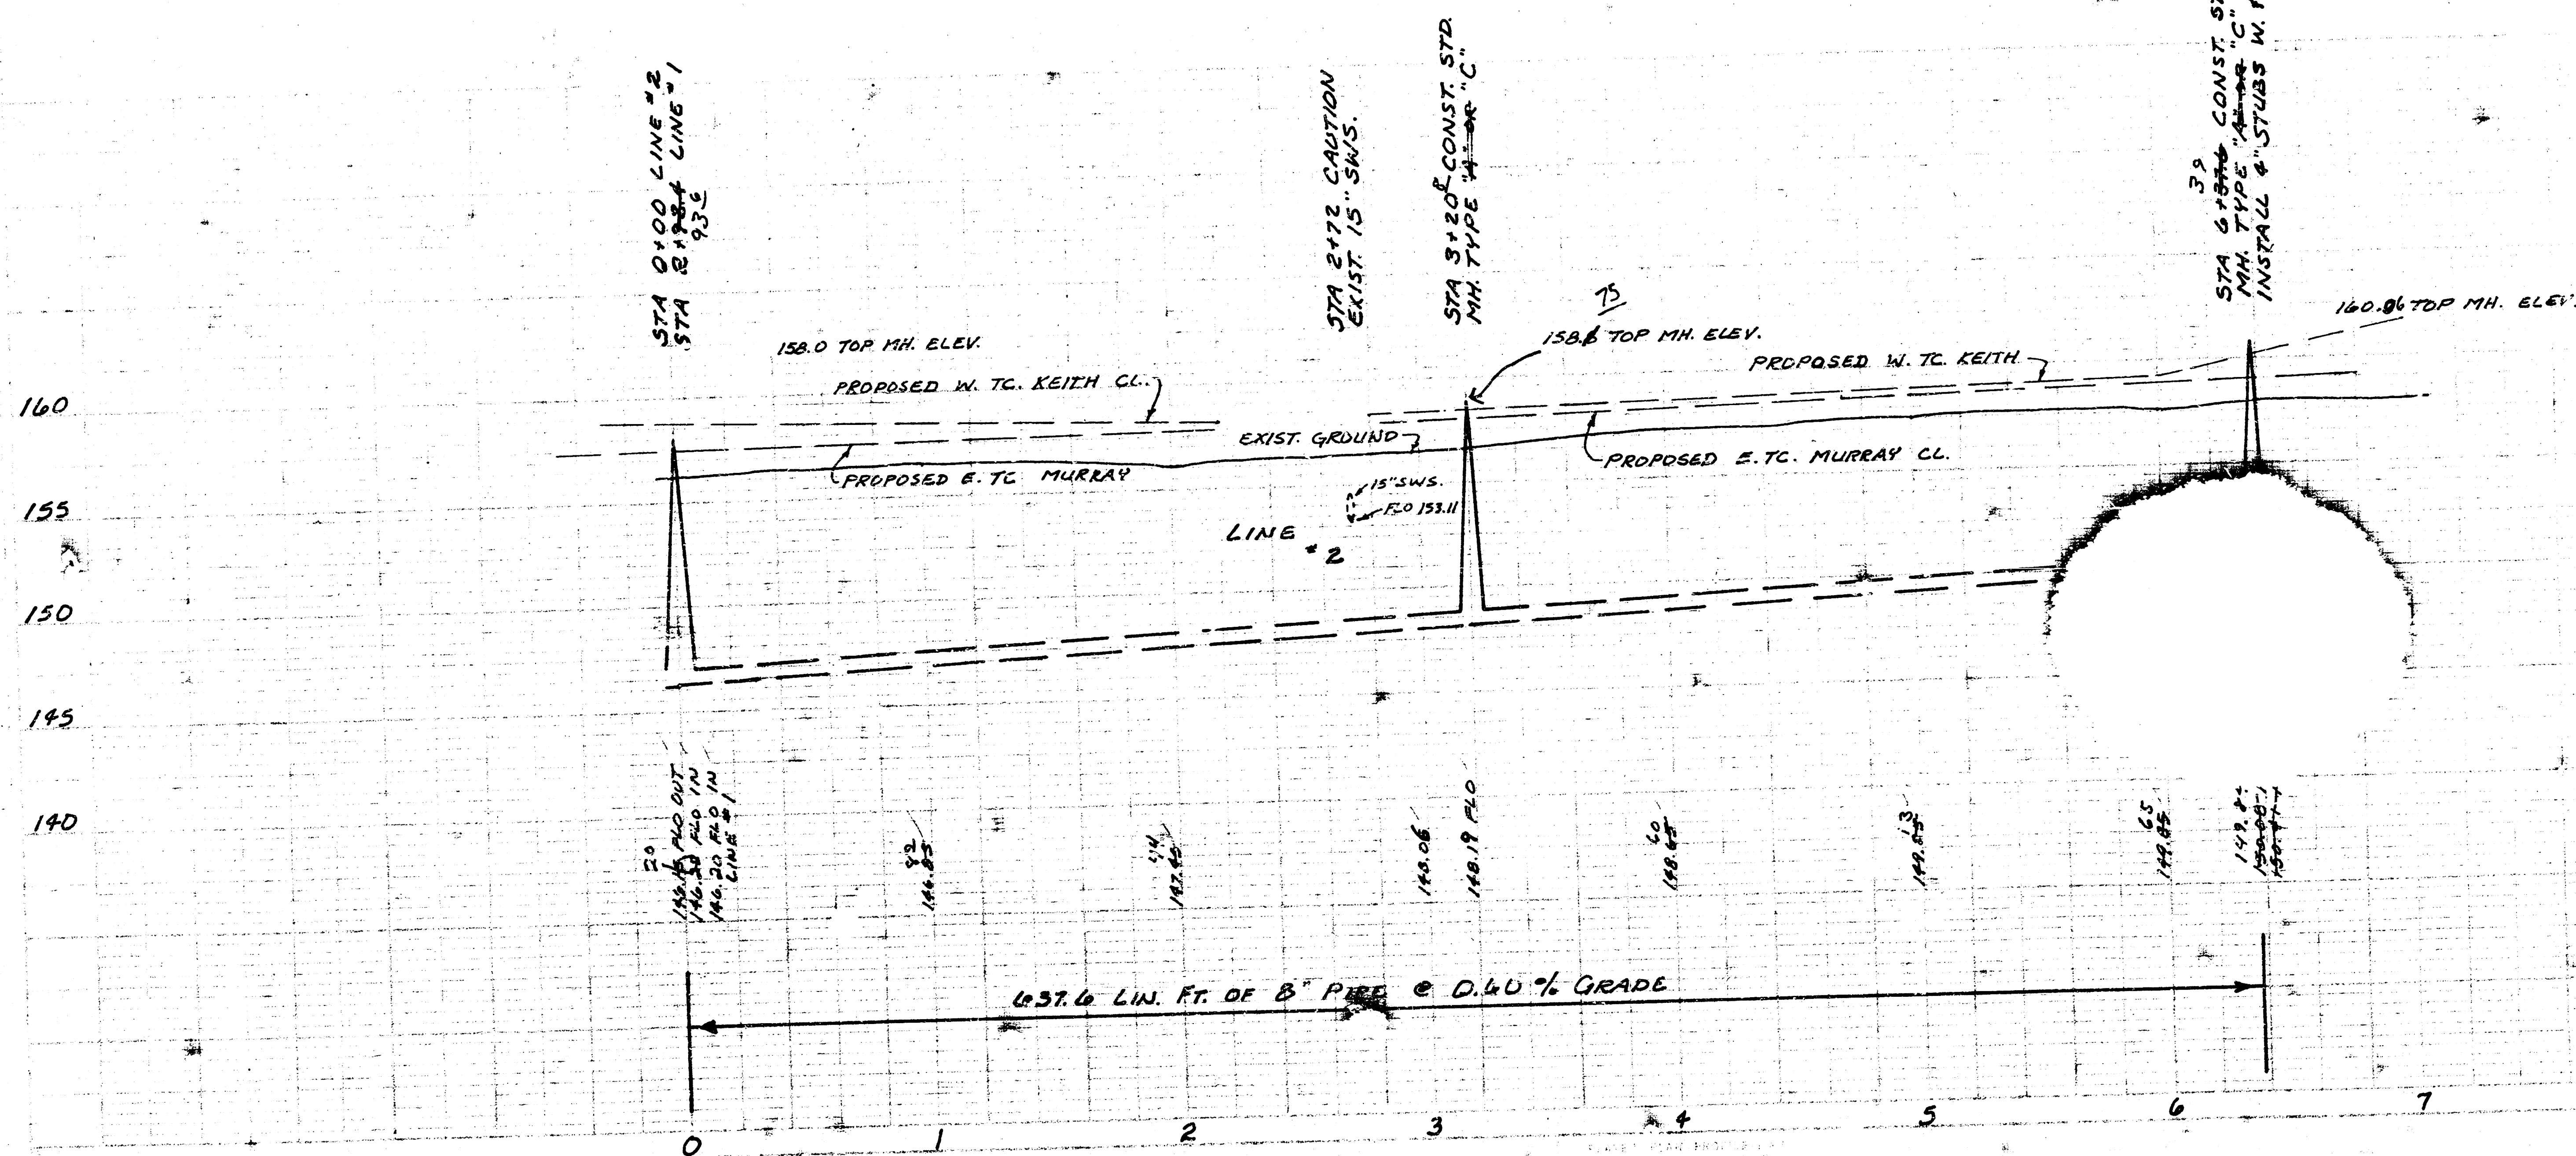



SCALE PLAN 1" = 40'
PROFILE 1" = 40' HORIZ.
1" = 5' VERT.

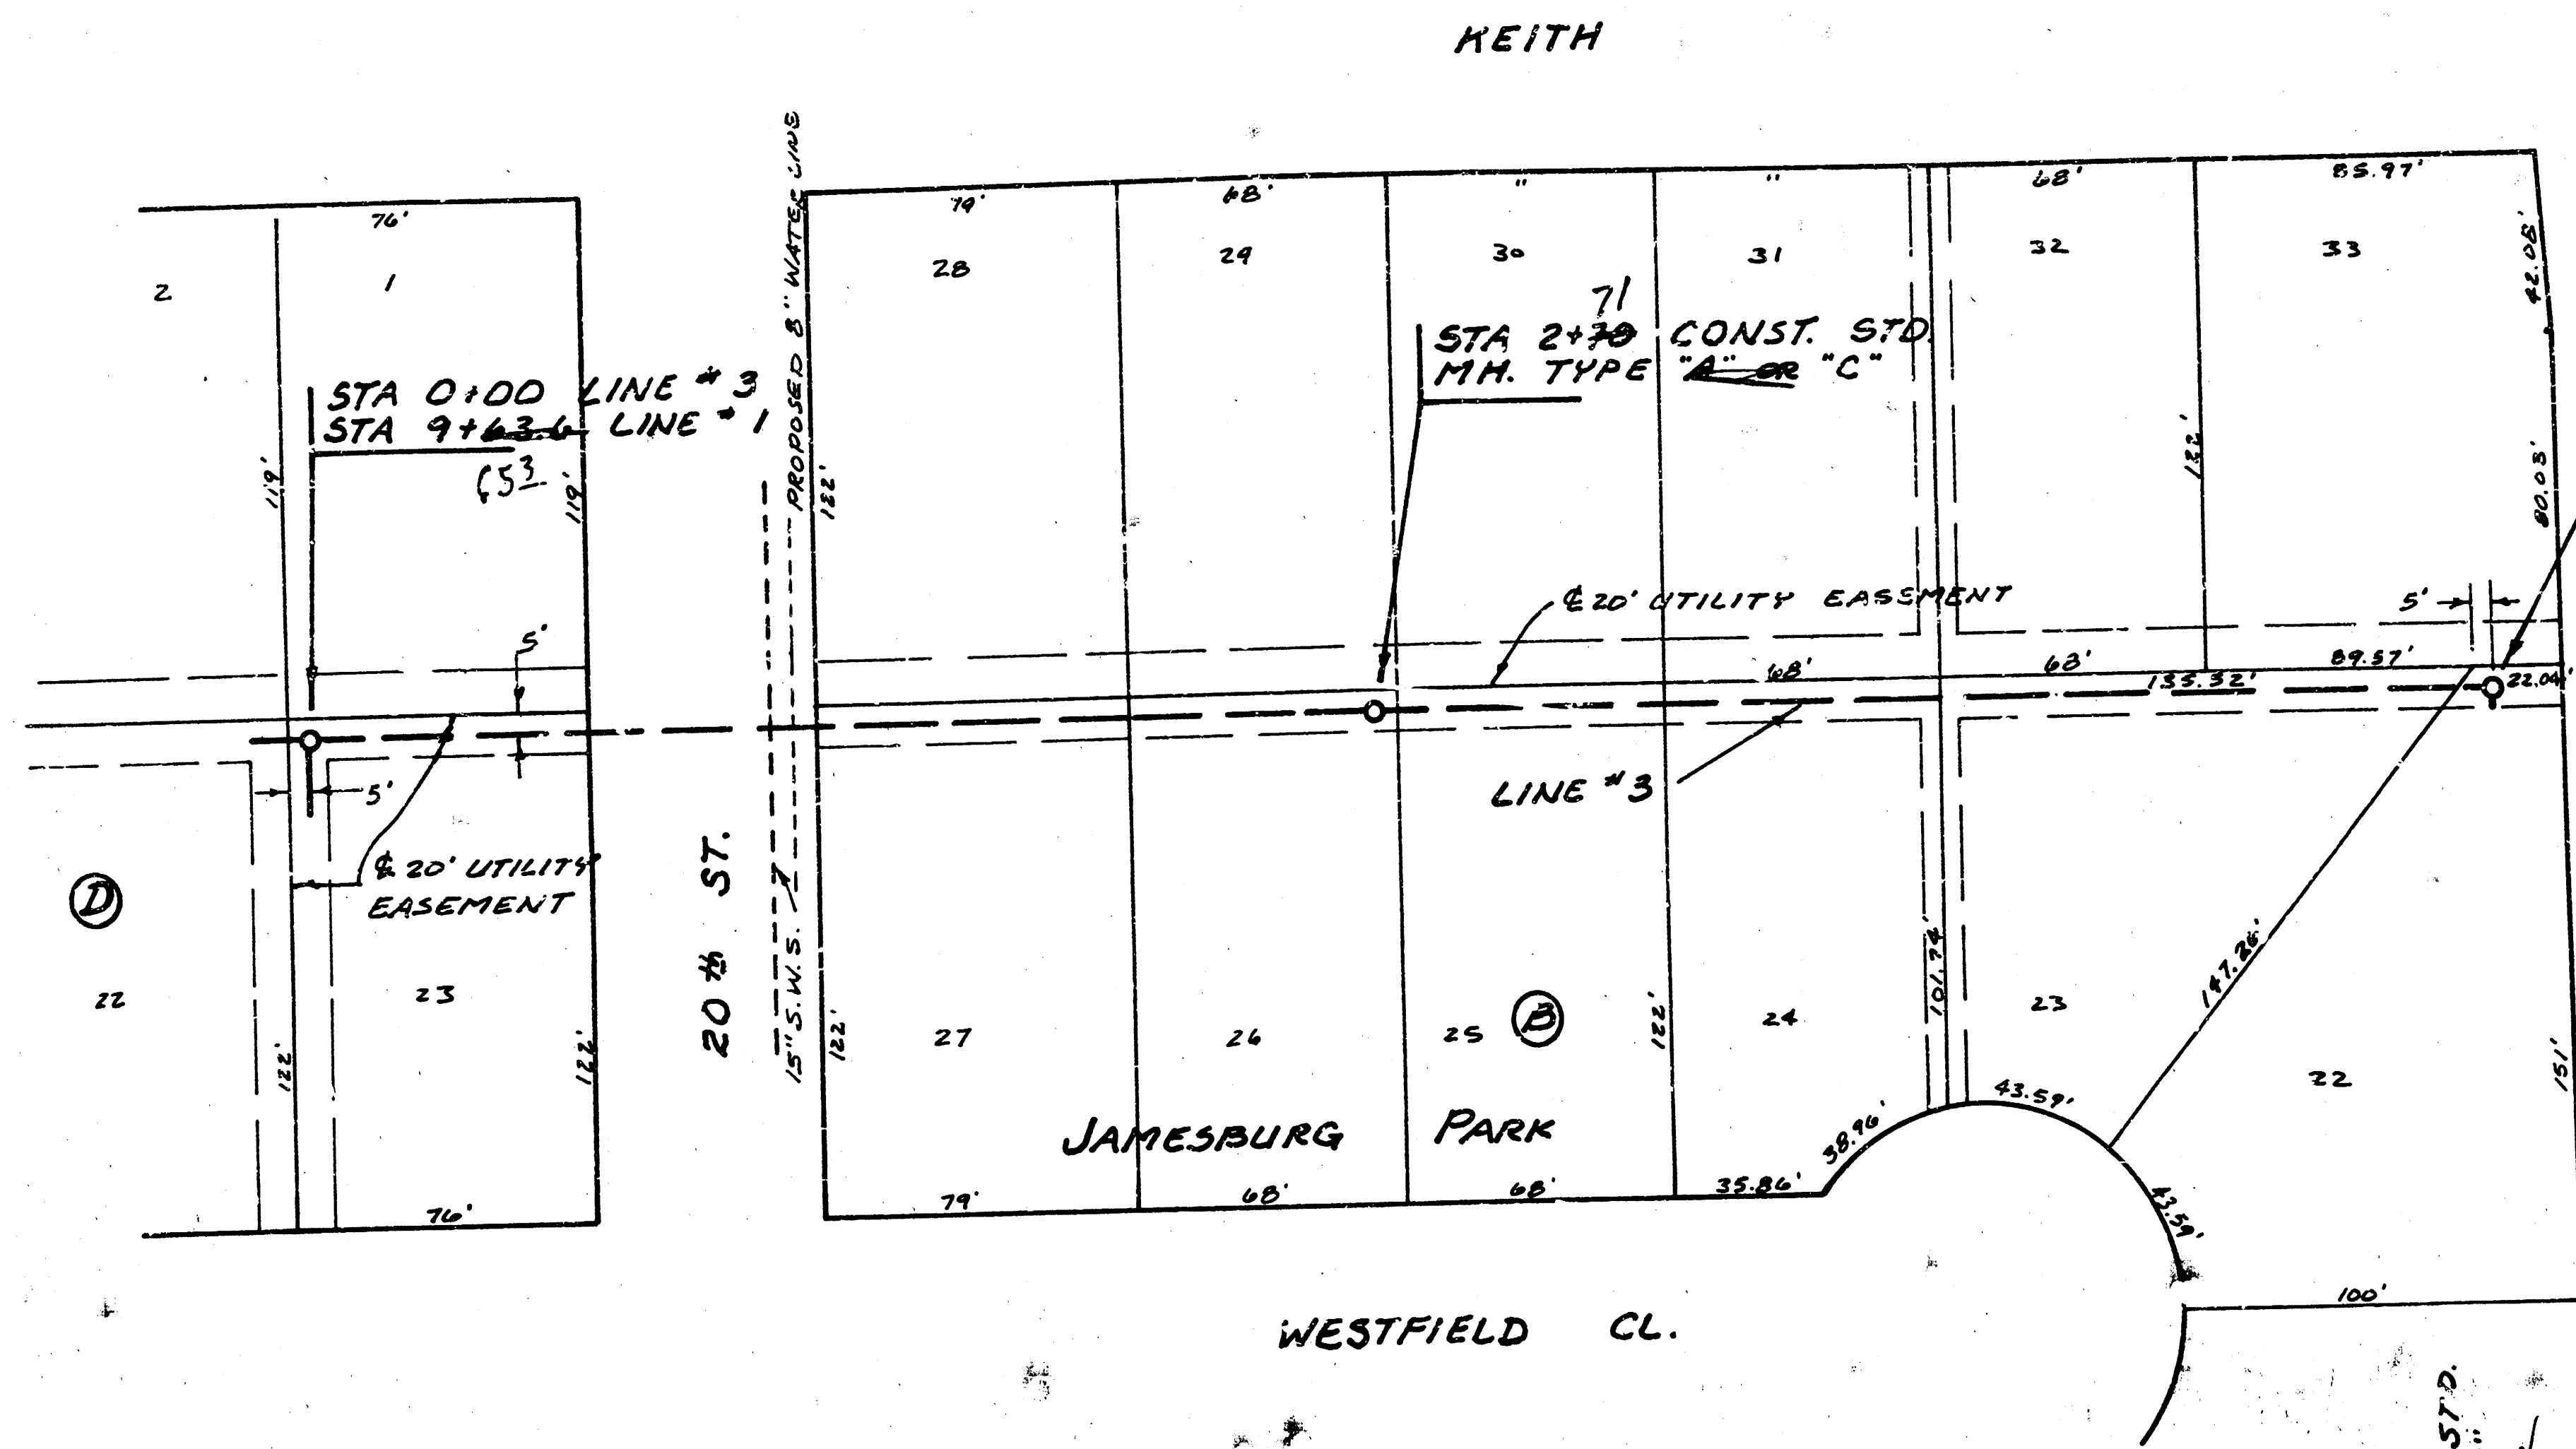


BYRON

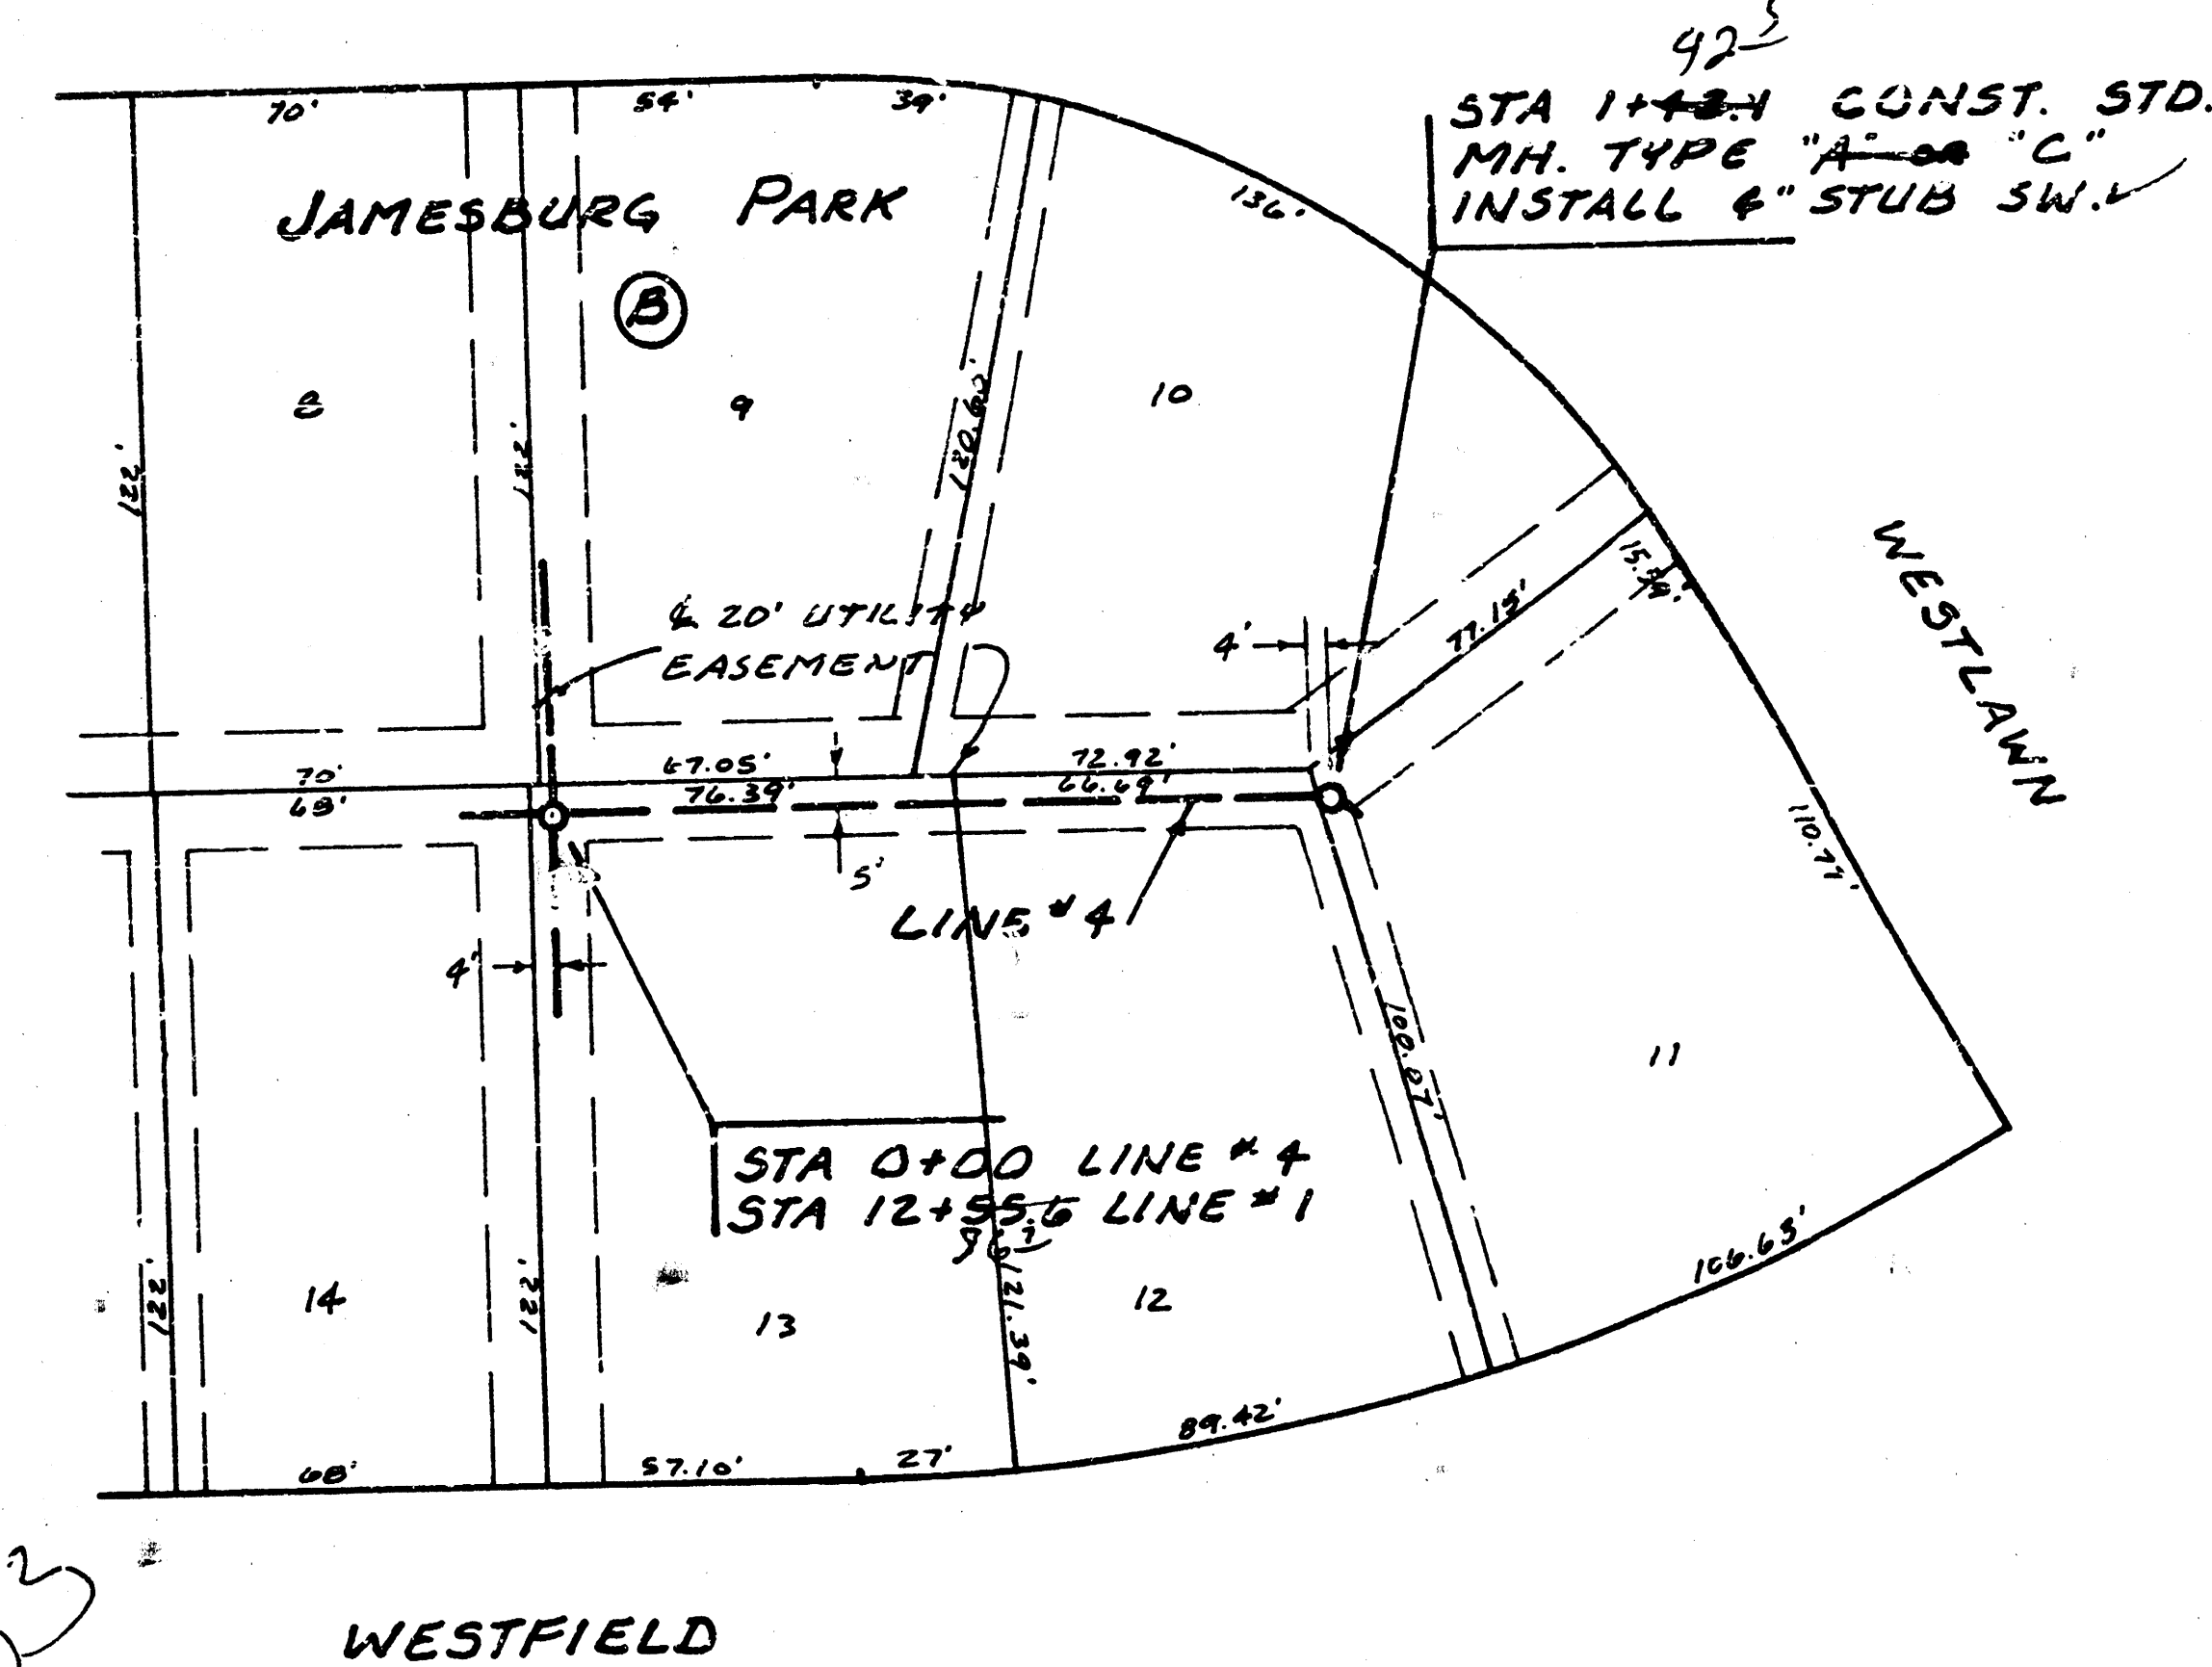

As Built
S.L.L.
7-83

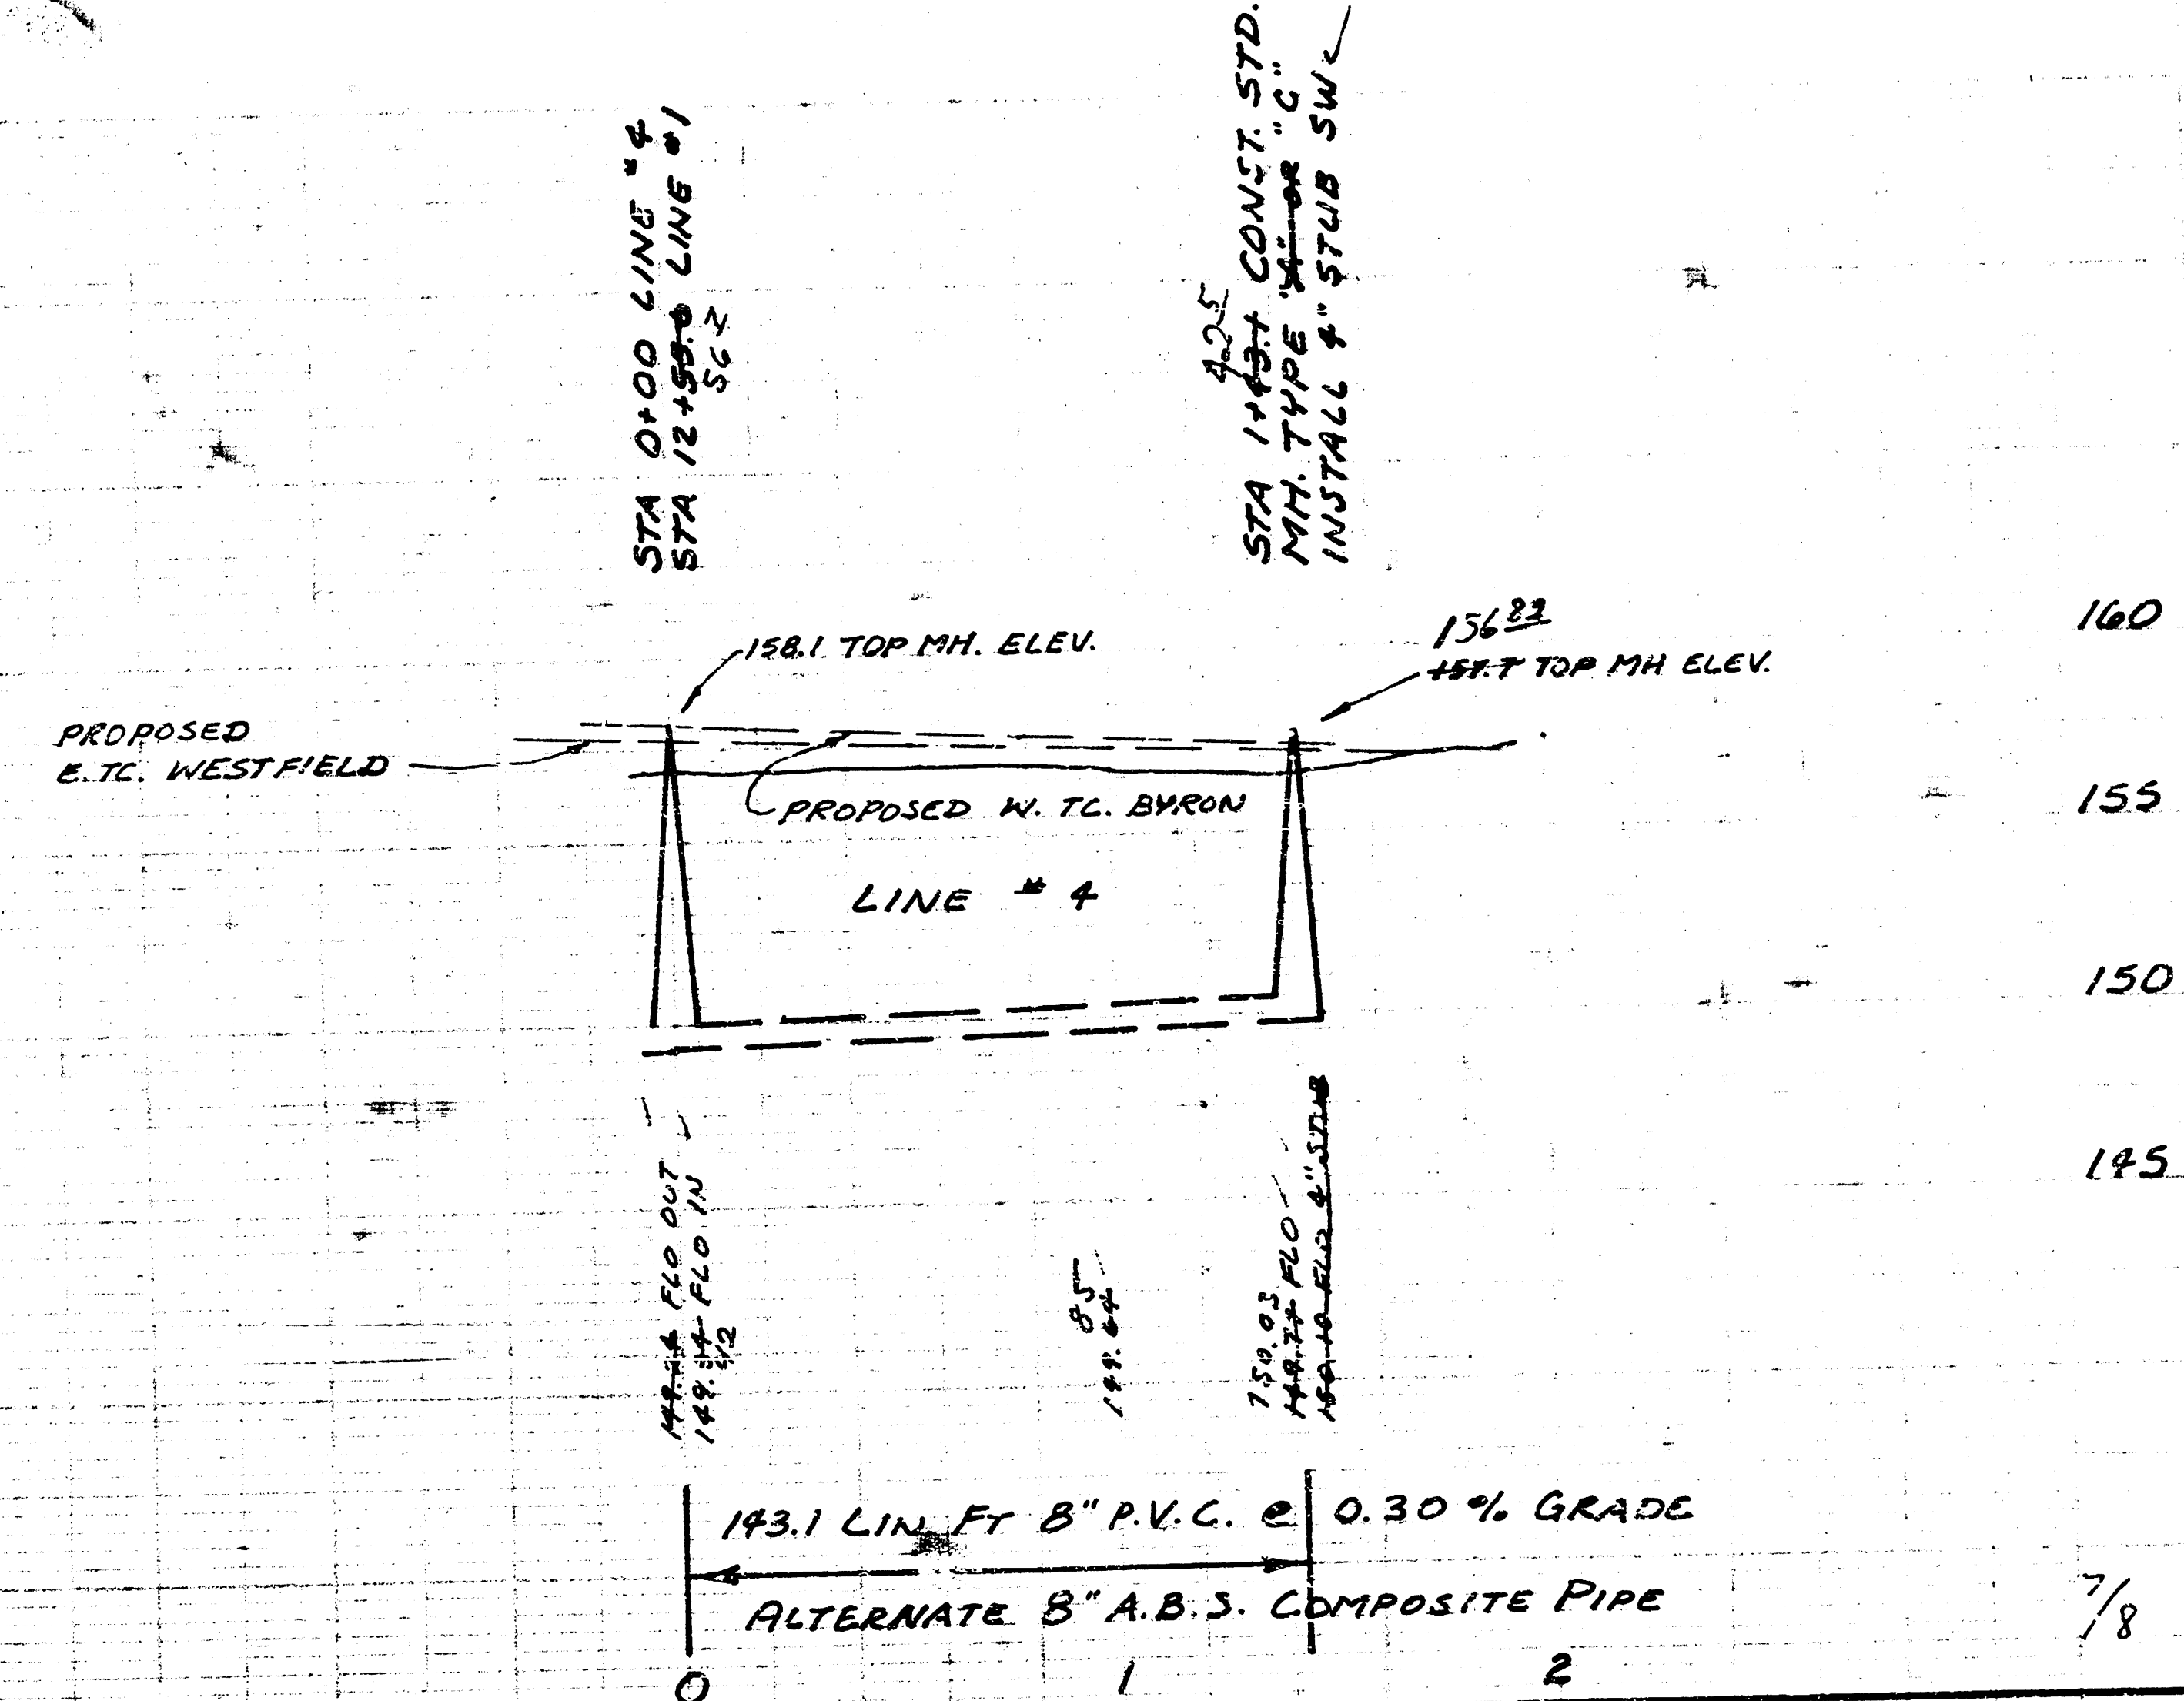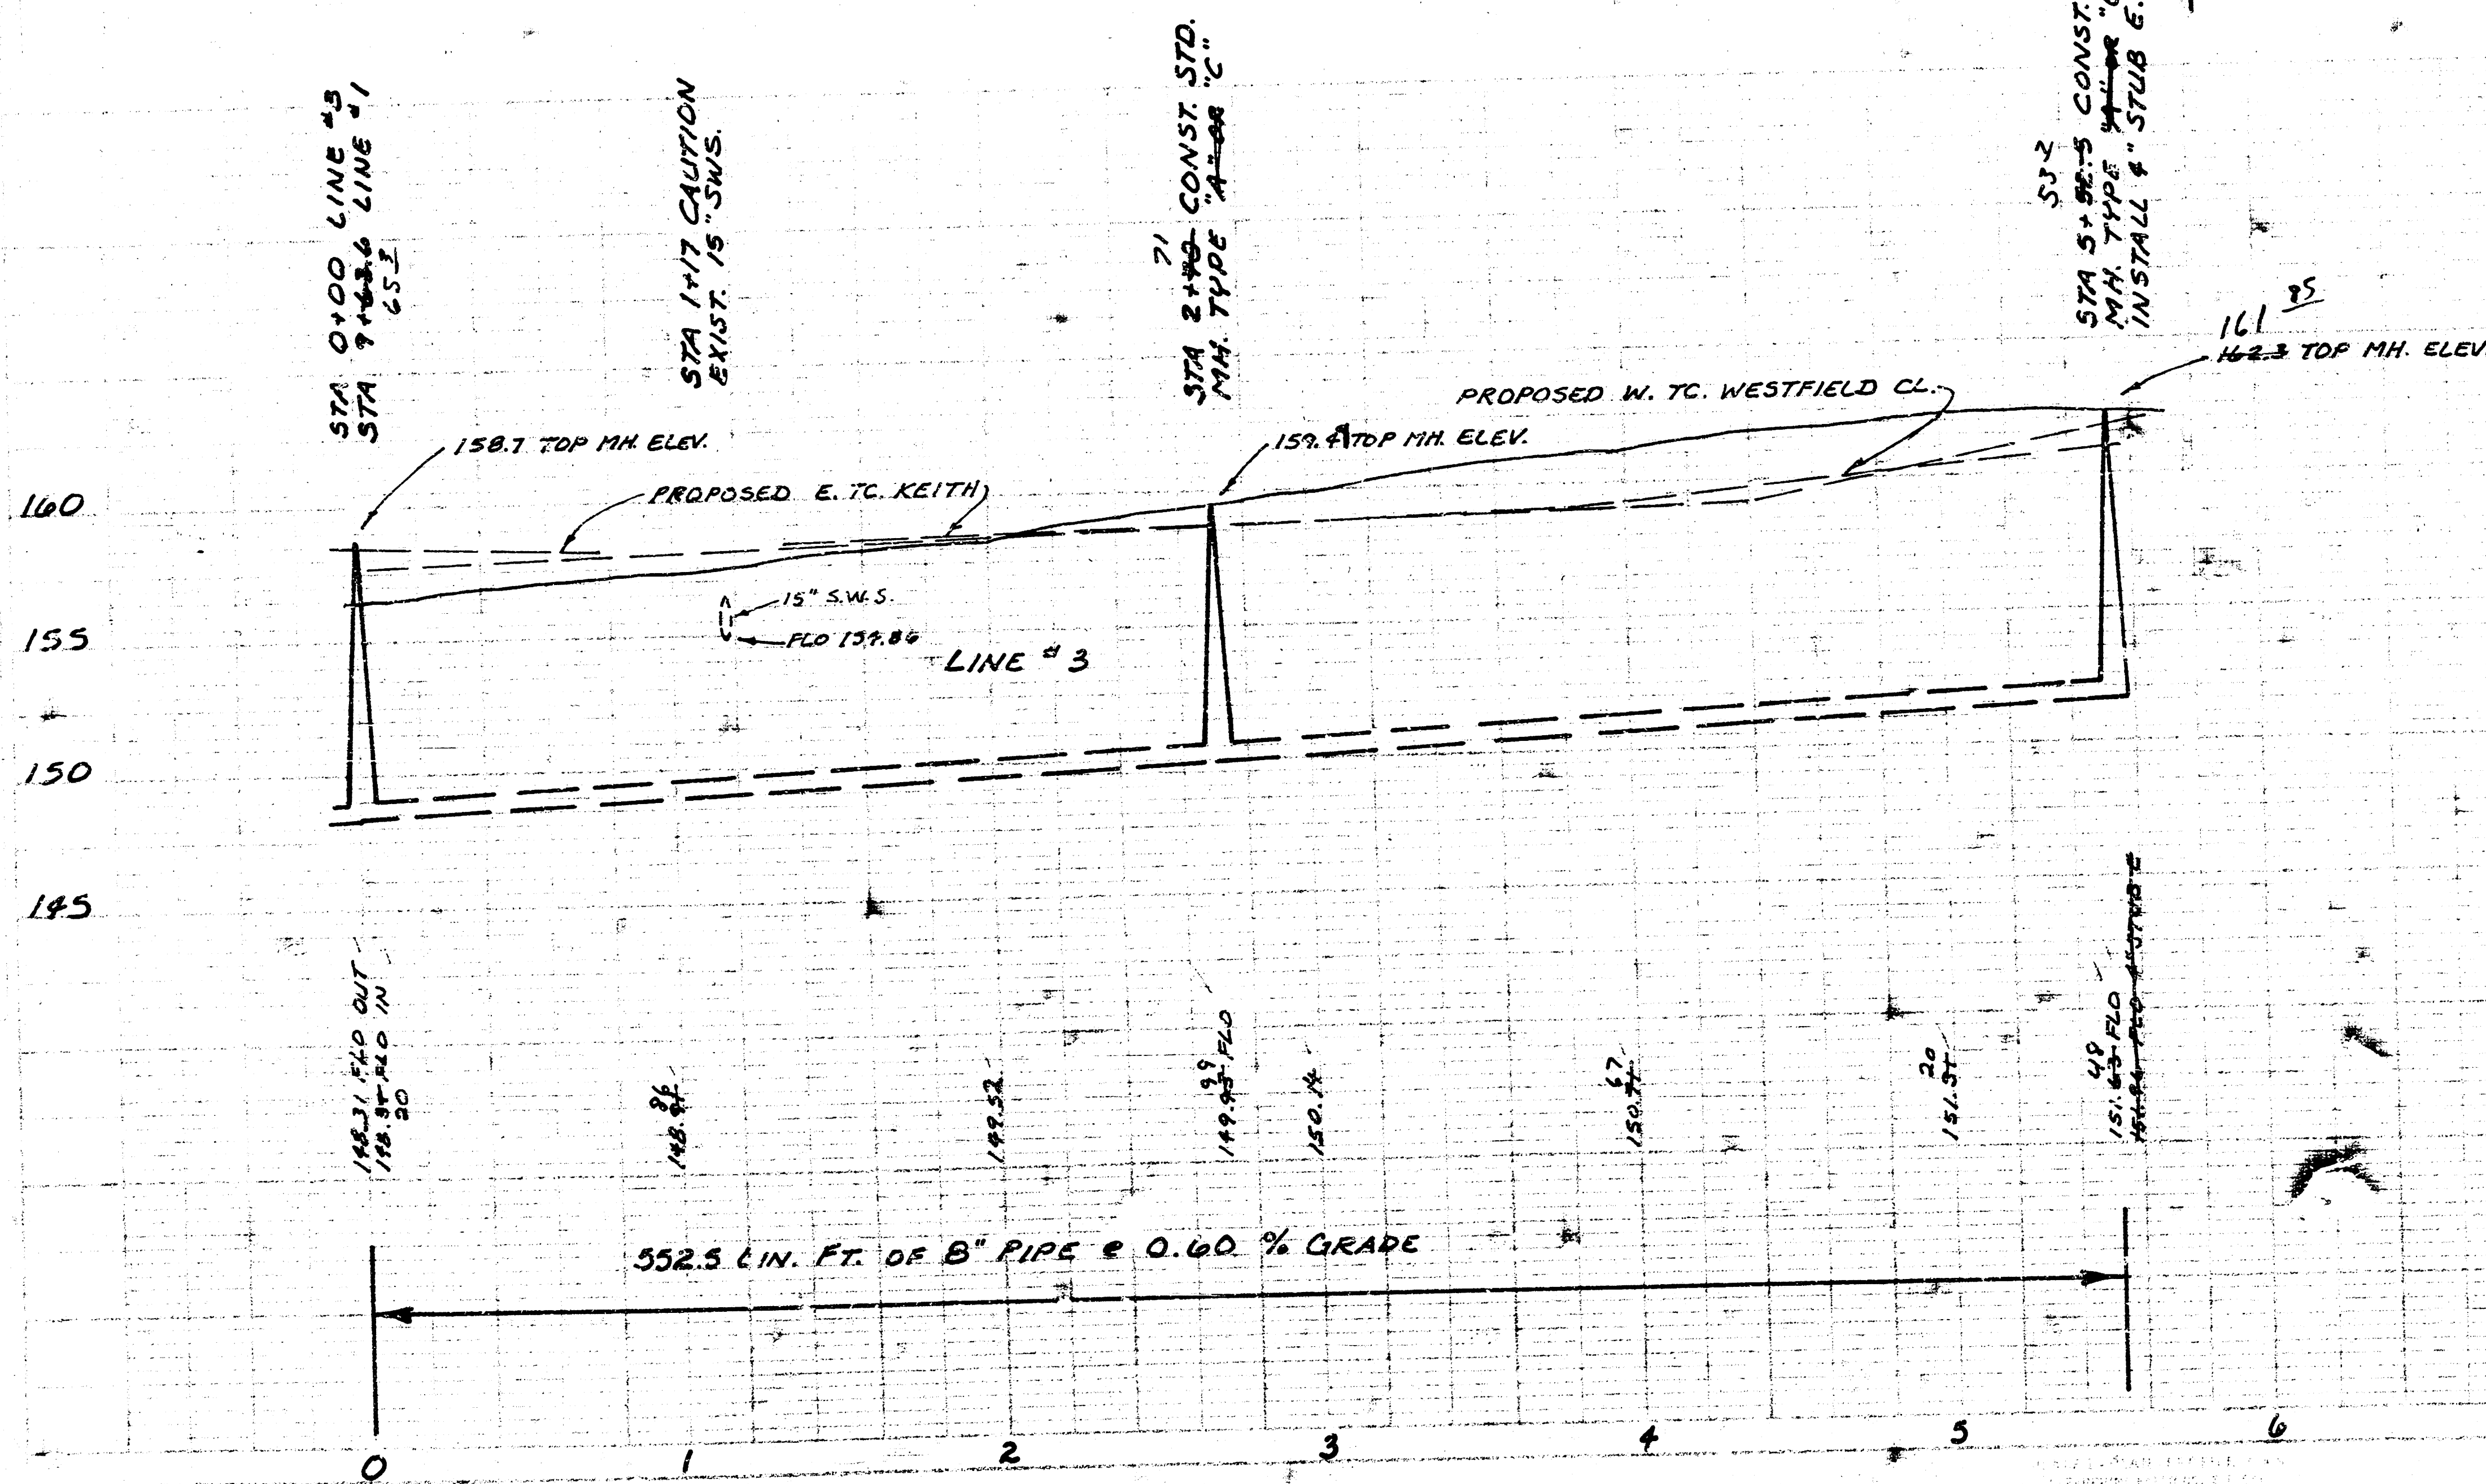


PROJECT DESCRIPTION
LAT 2, MAIN 4, WESTLINK SEWER
PROJECT NUMBER
468-76-245-83960-000-000-001

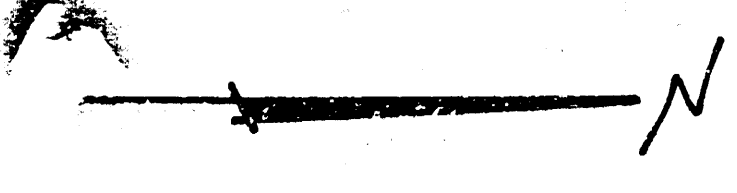




SCALE PLAN 1"=40'
PROFILE 1"=40' HORIZ.
1"=5' VERT.

SHEET
8 OF 8

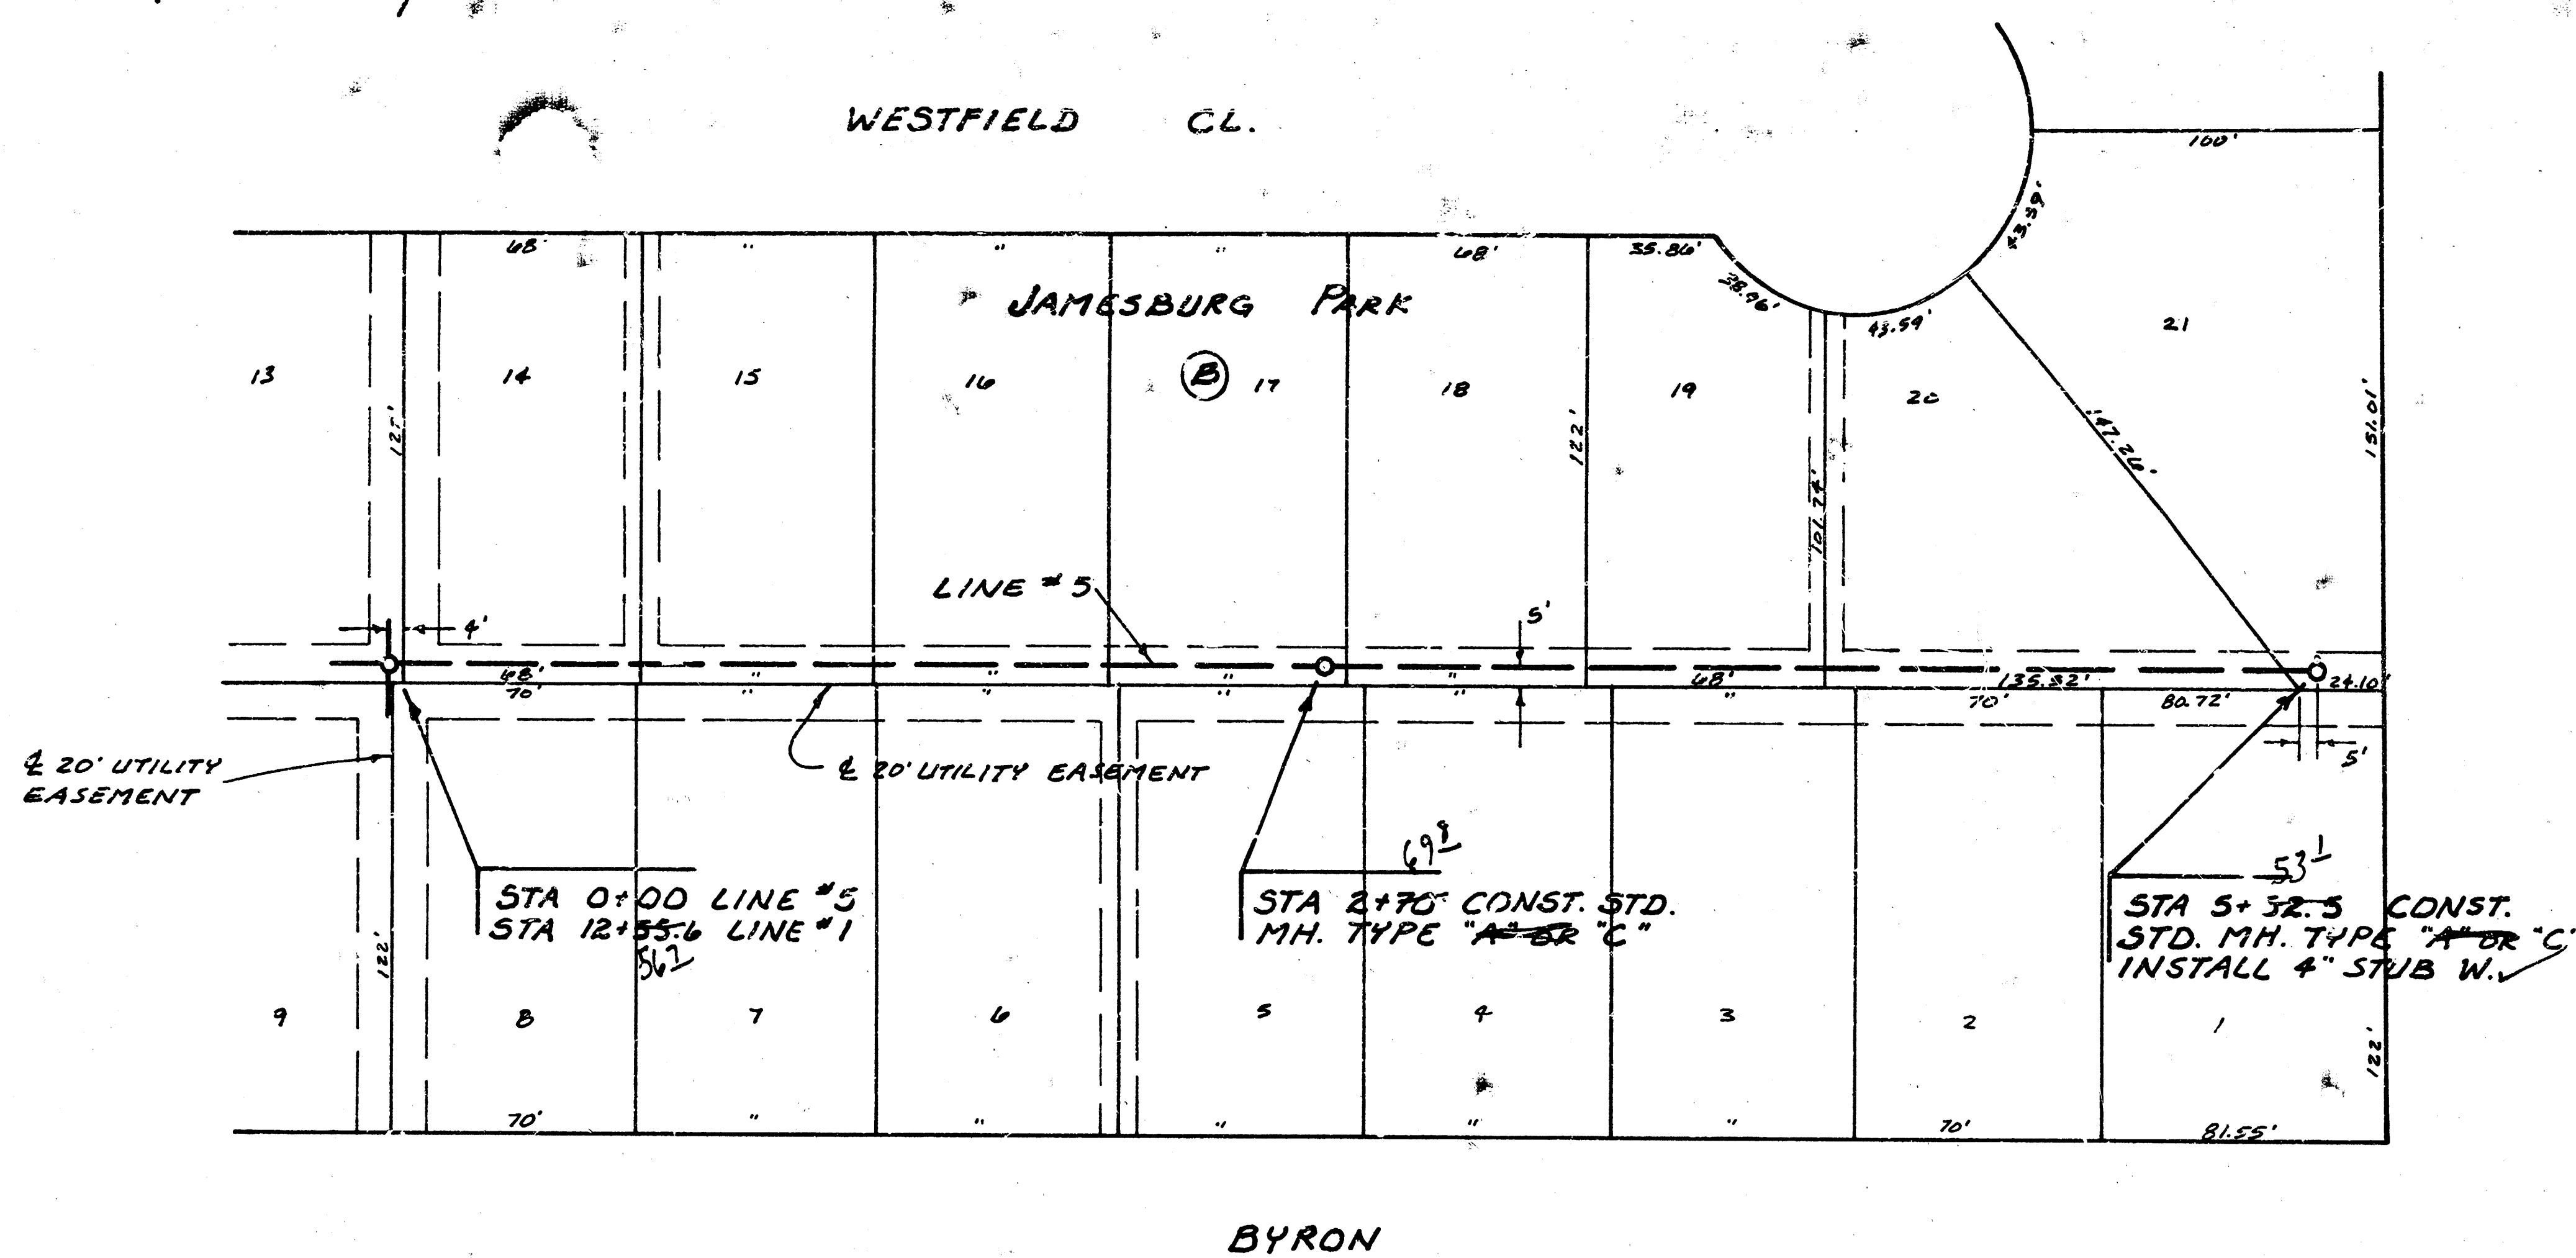

21st ST.

As Built
JUL
7-83

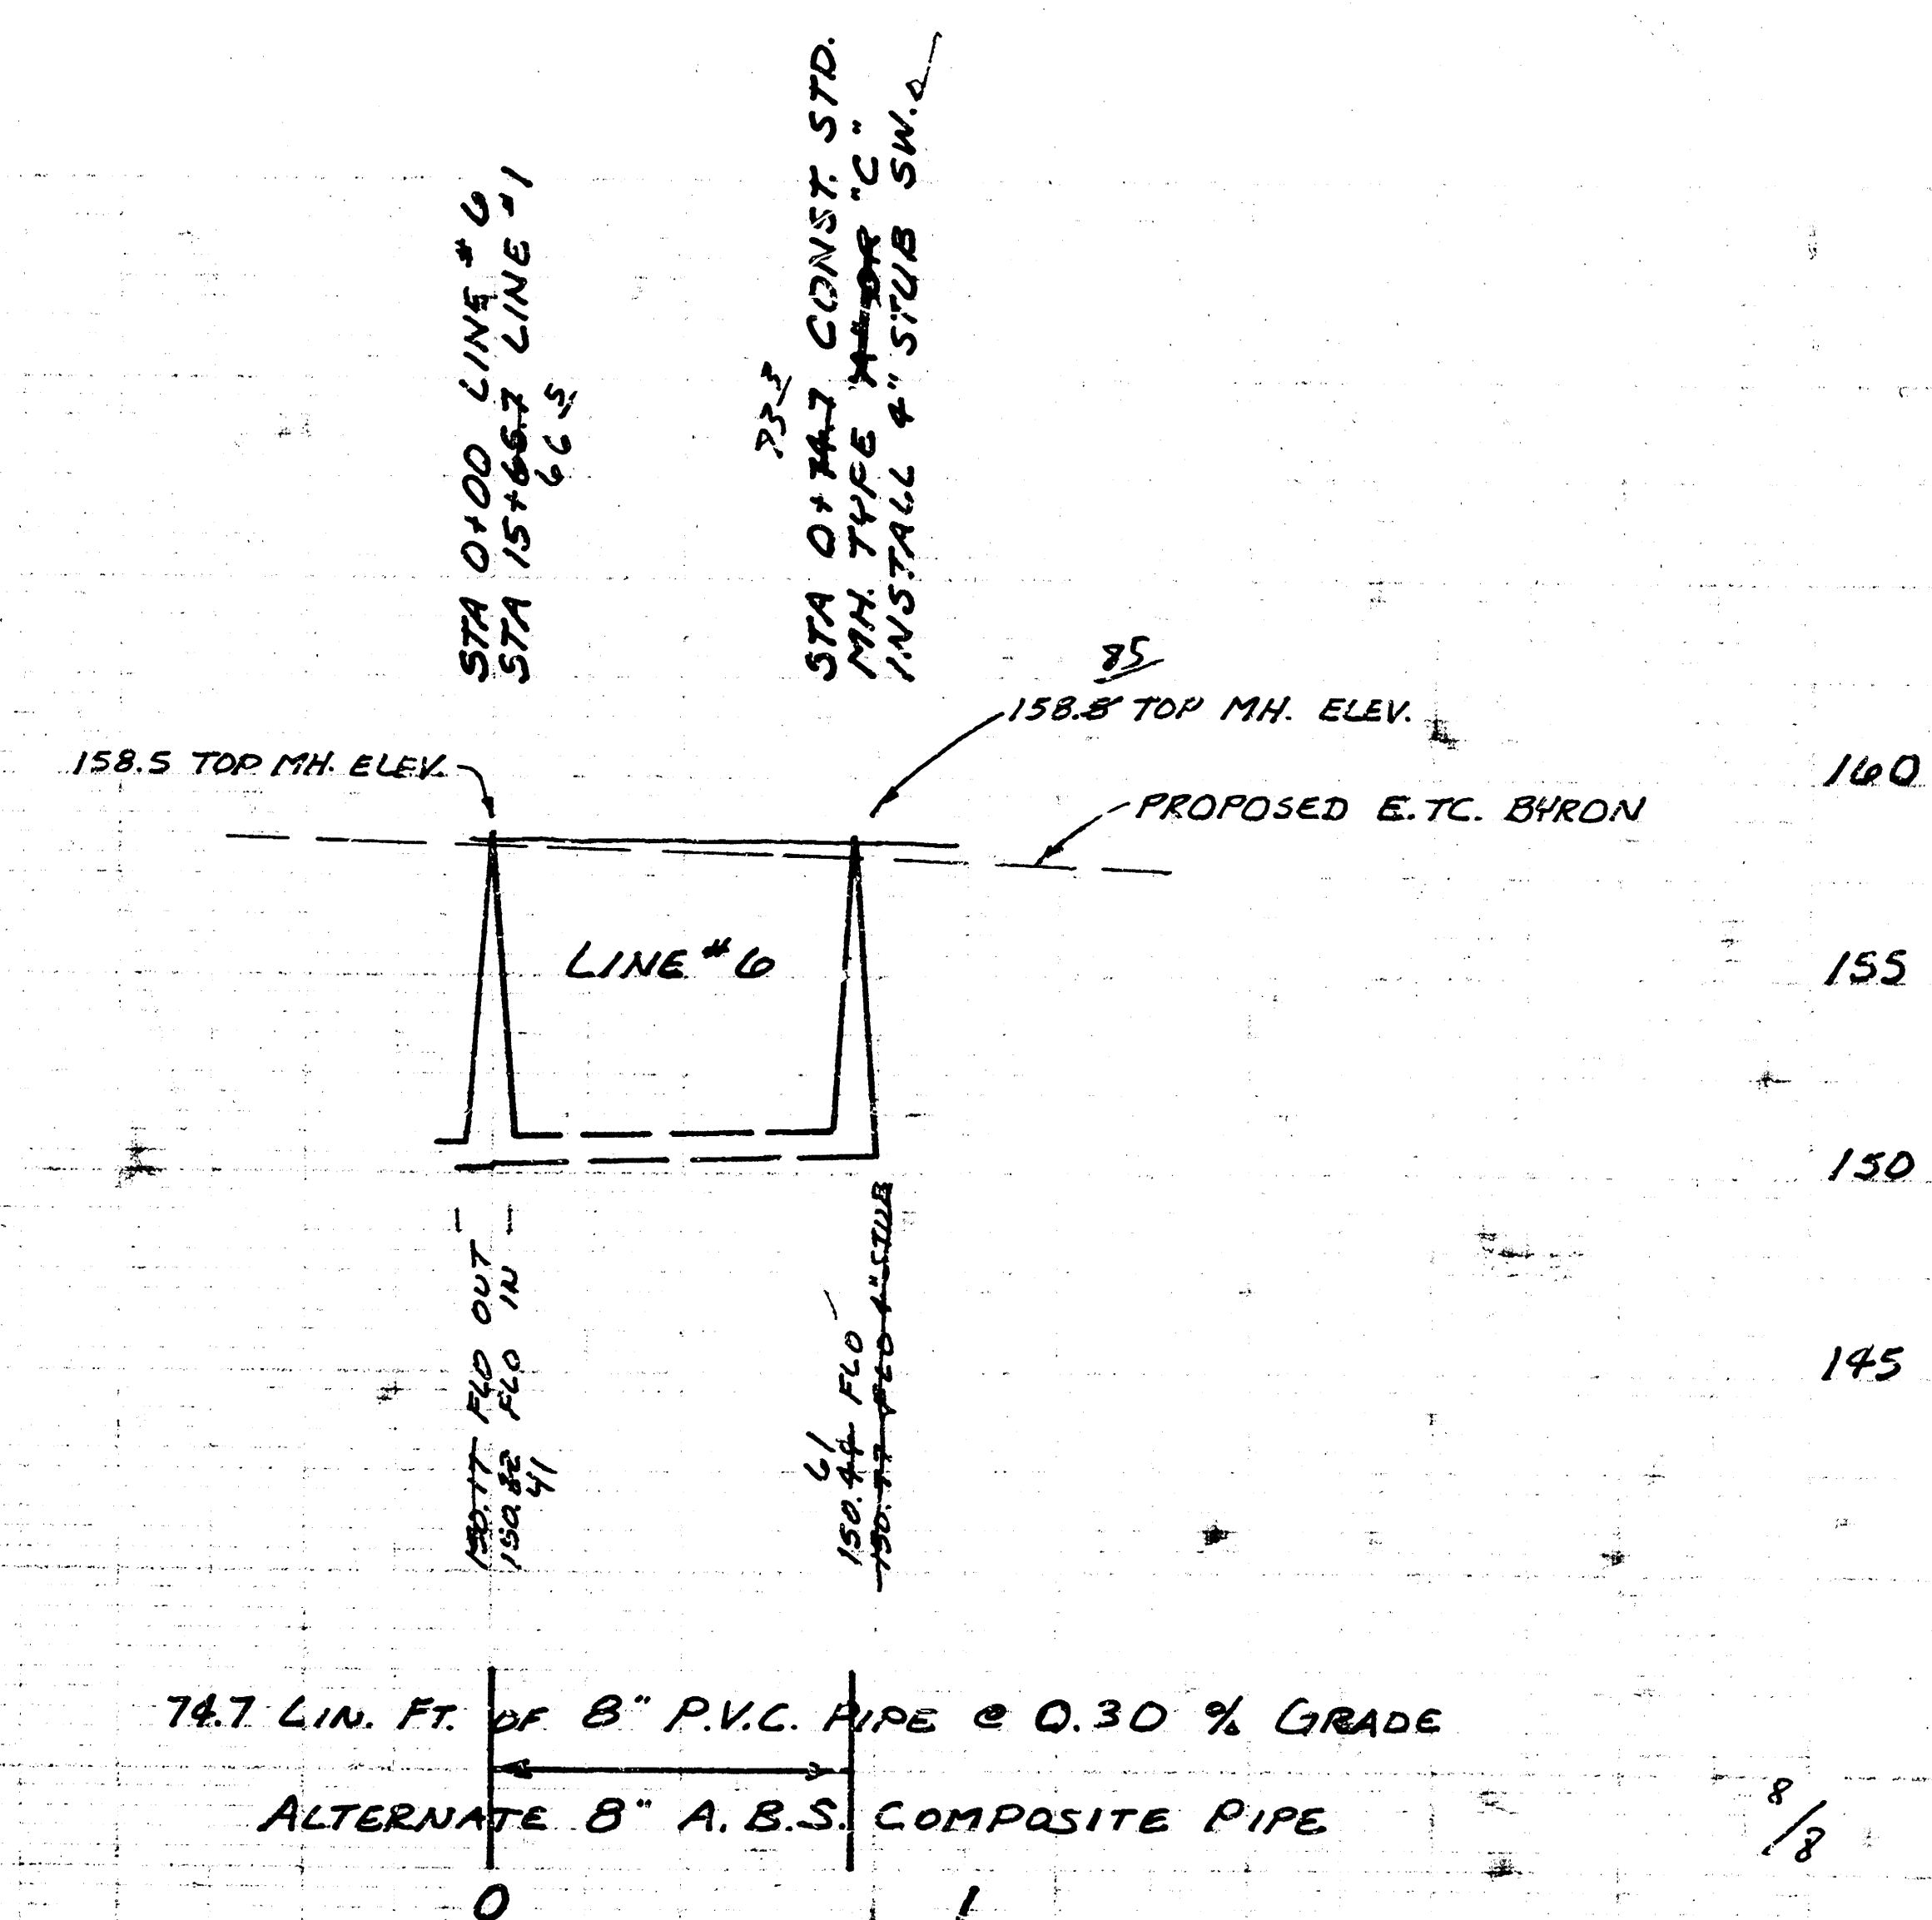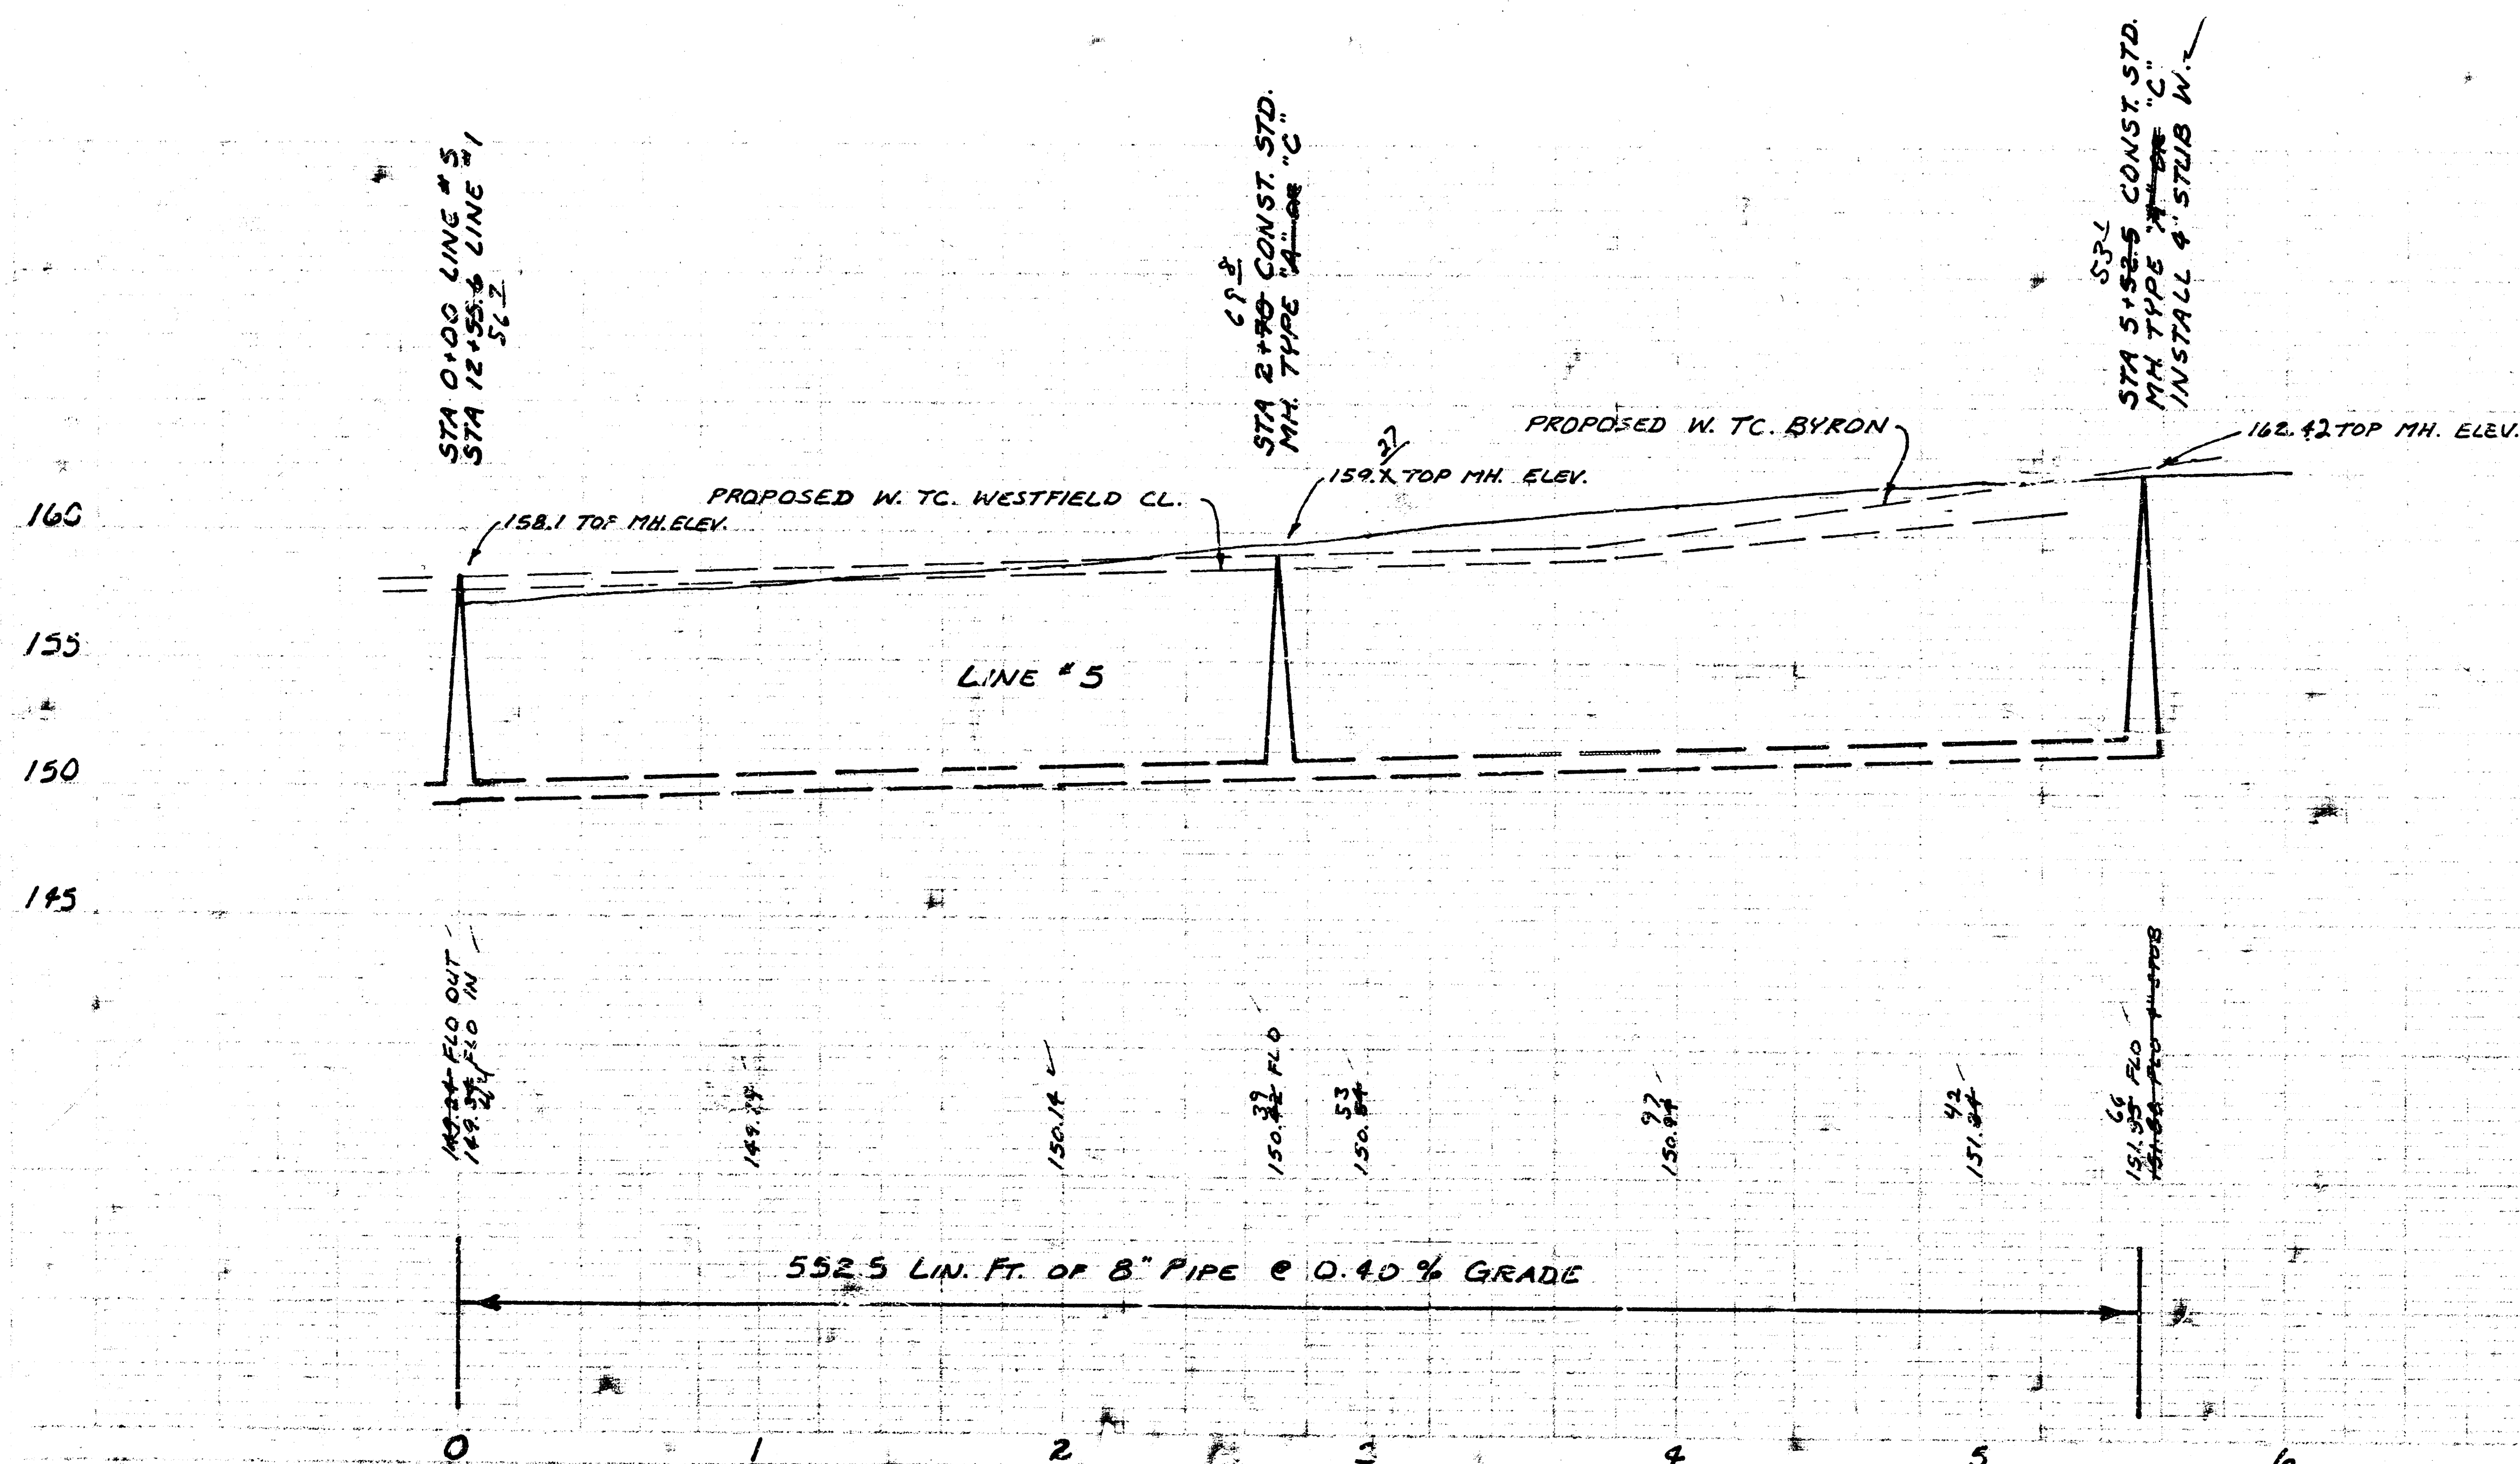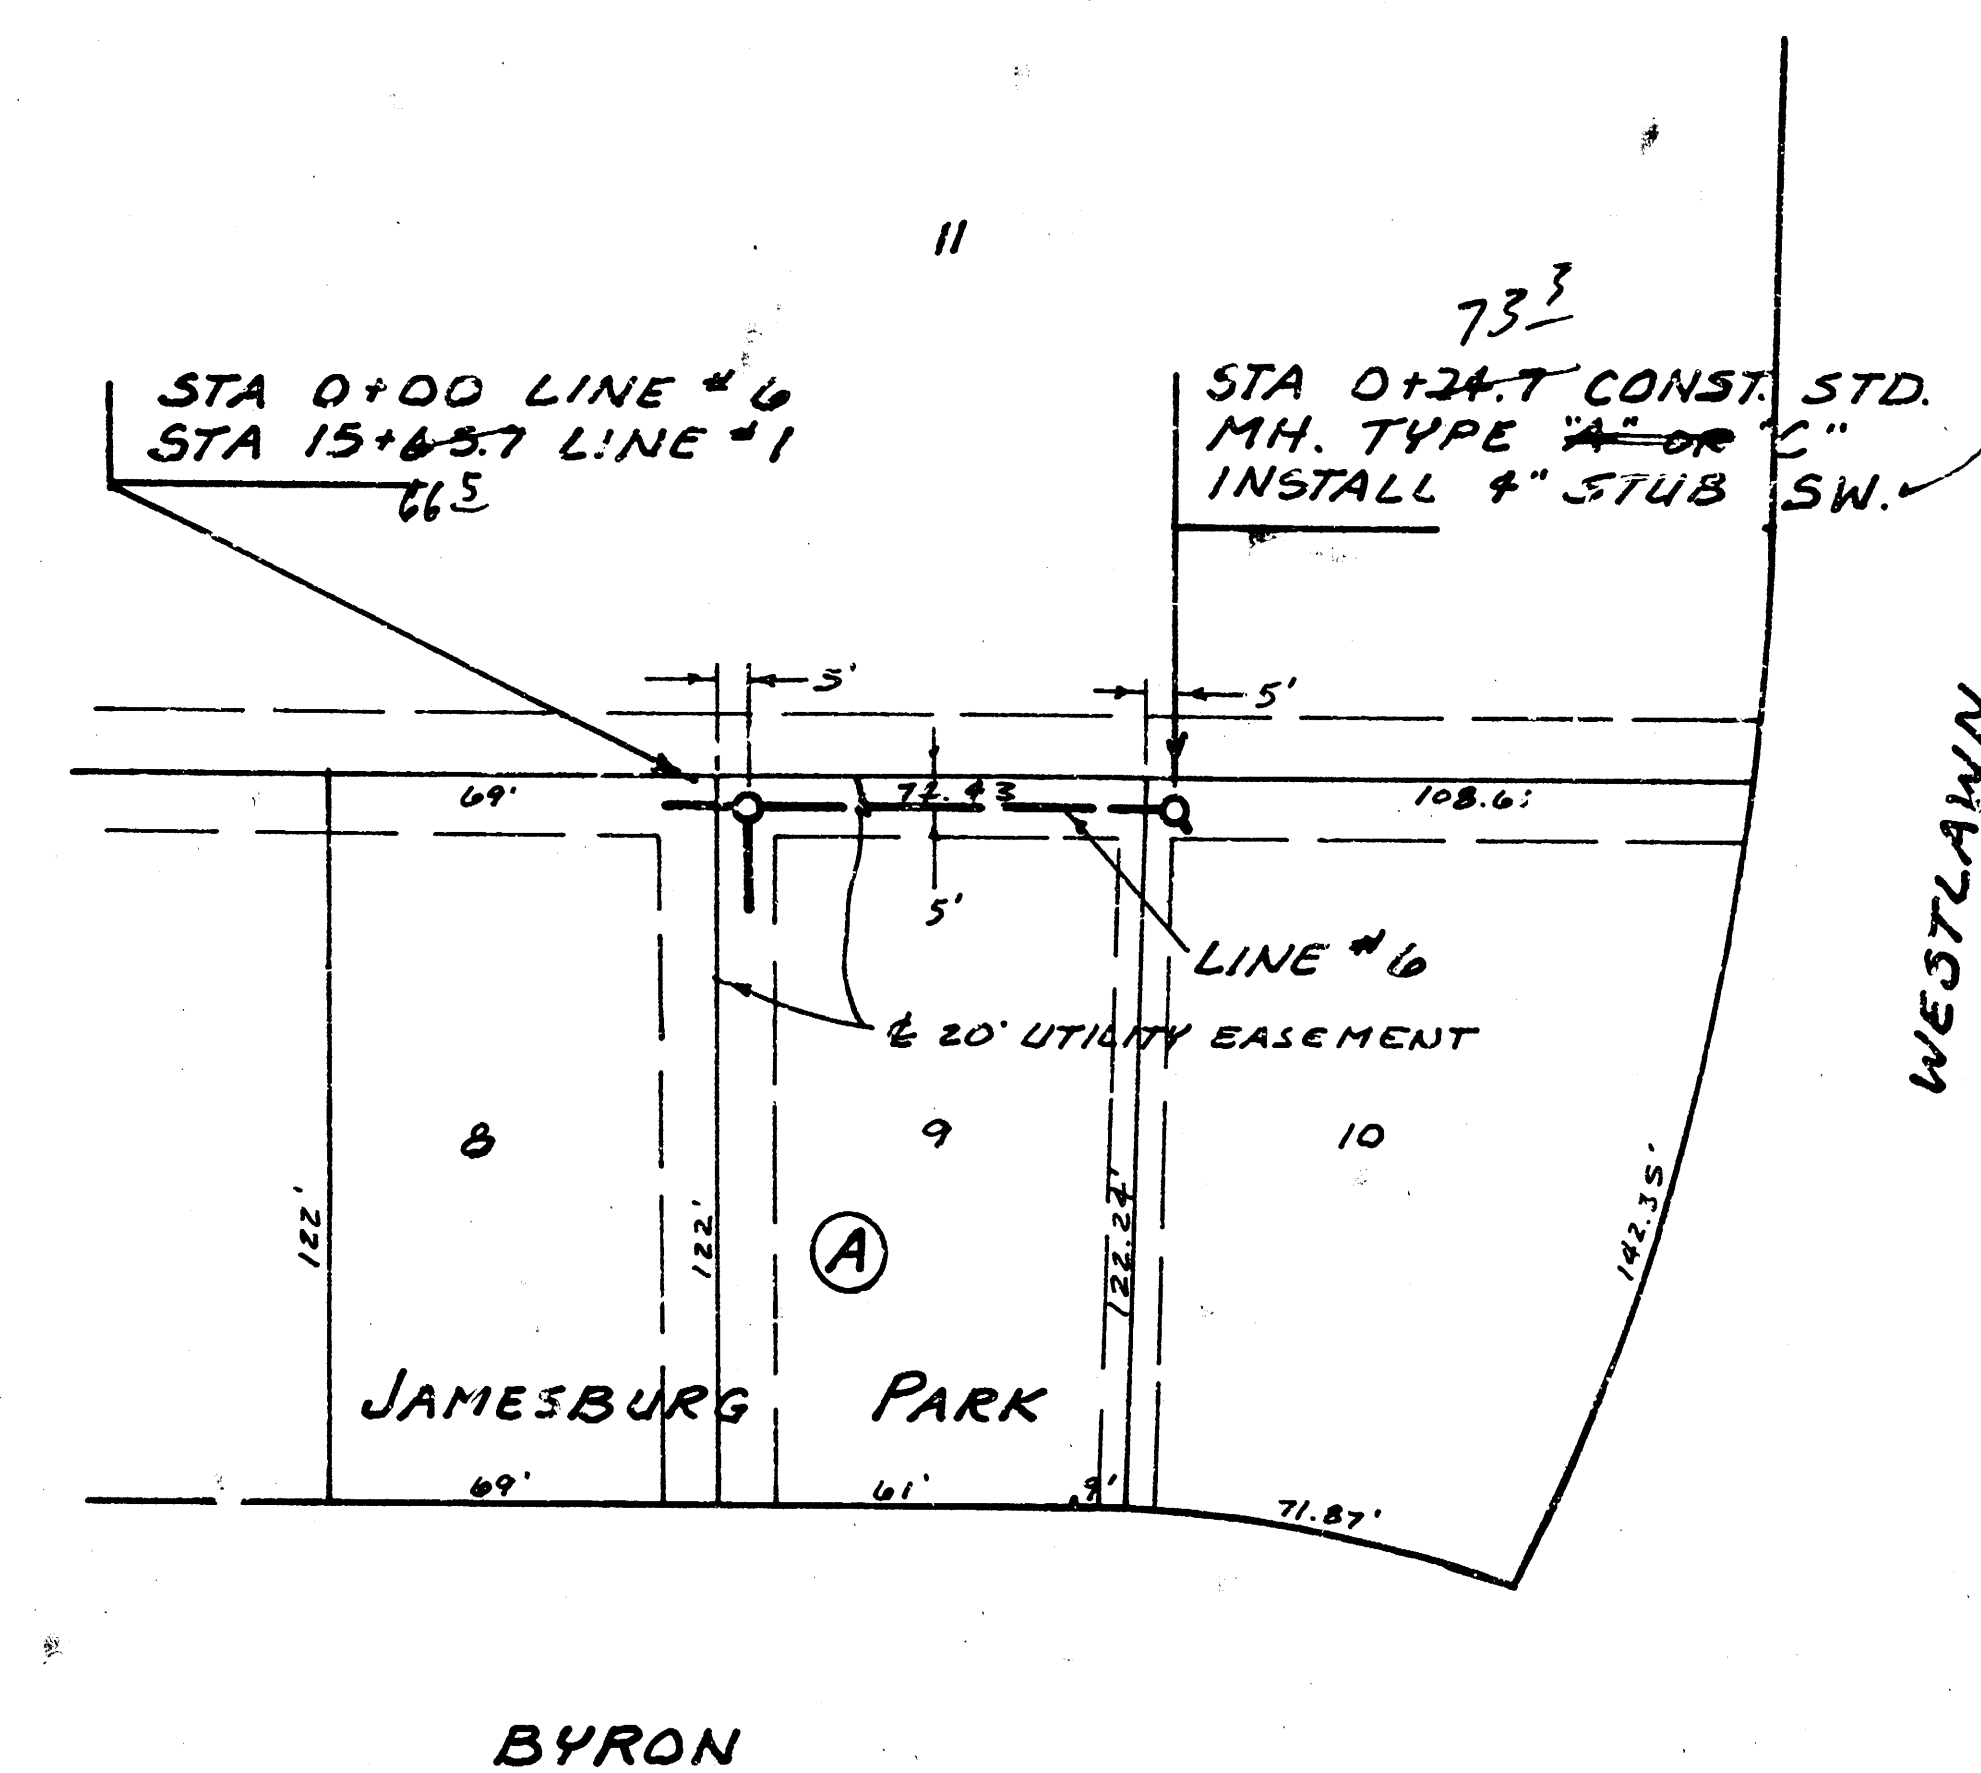

PROJECT DESCRIPTION	
LAT 2, MAIN 4, WESTLINK SEWER	
PROJECT NUMBER	
468-78-245-80980-000-000-001	

10 5 4 12