
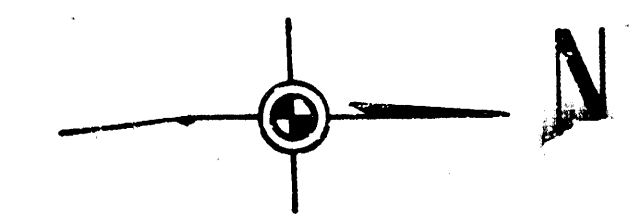




B. M. 143.11 "G" in Globe W. L. Eastern Ave.
N-26 Rose Lane. 1955

Sta. 0100.0
Const. Std. M.H. Type "A"
over exist. 6" S. S.

KANSAS TURNPIKE

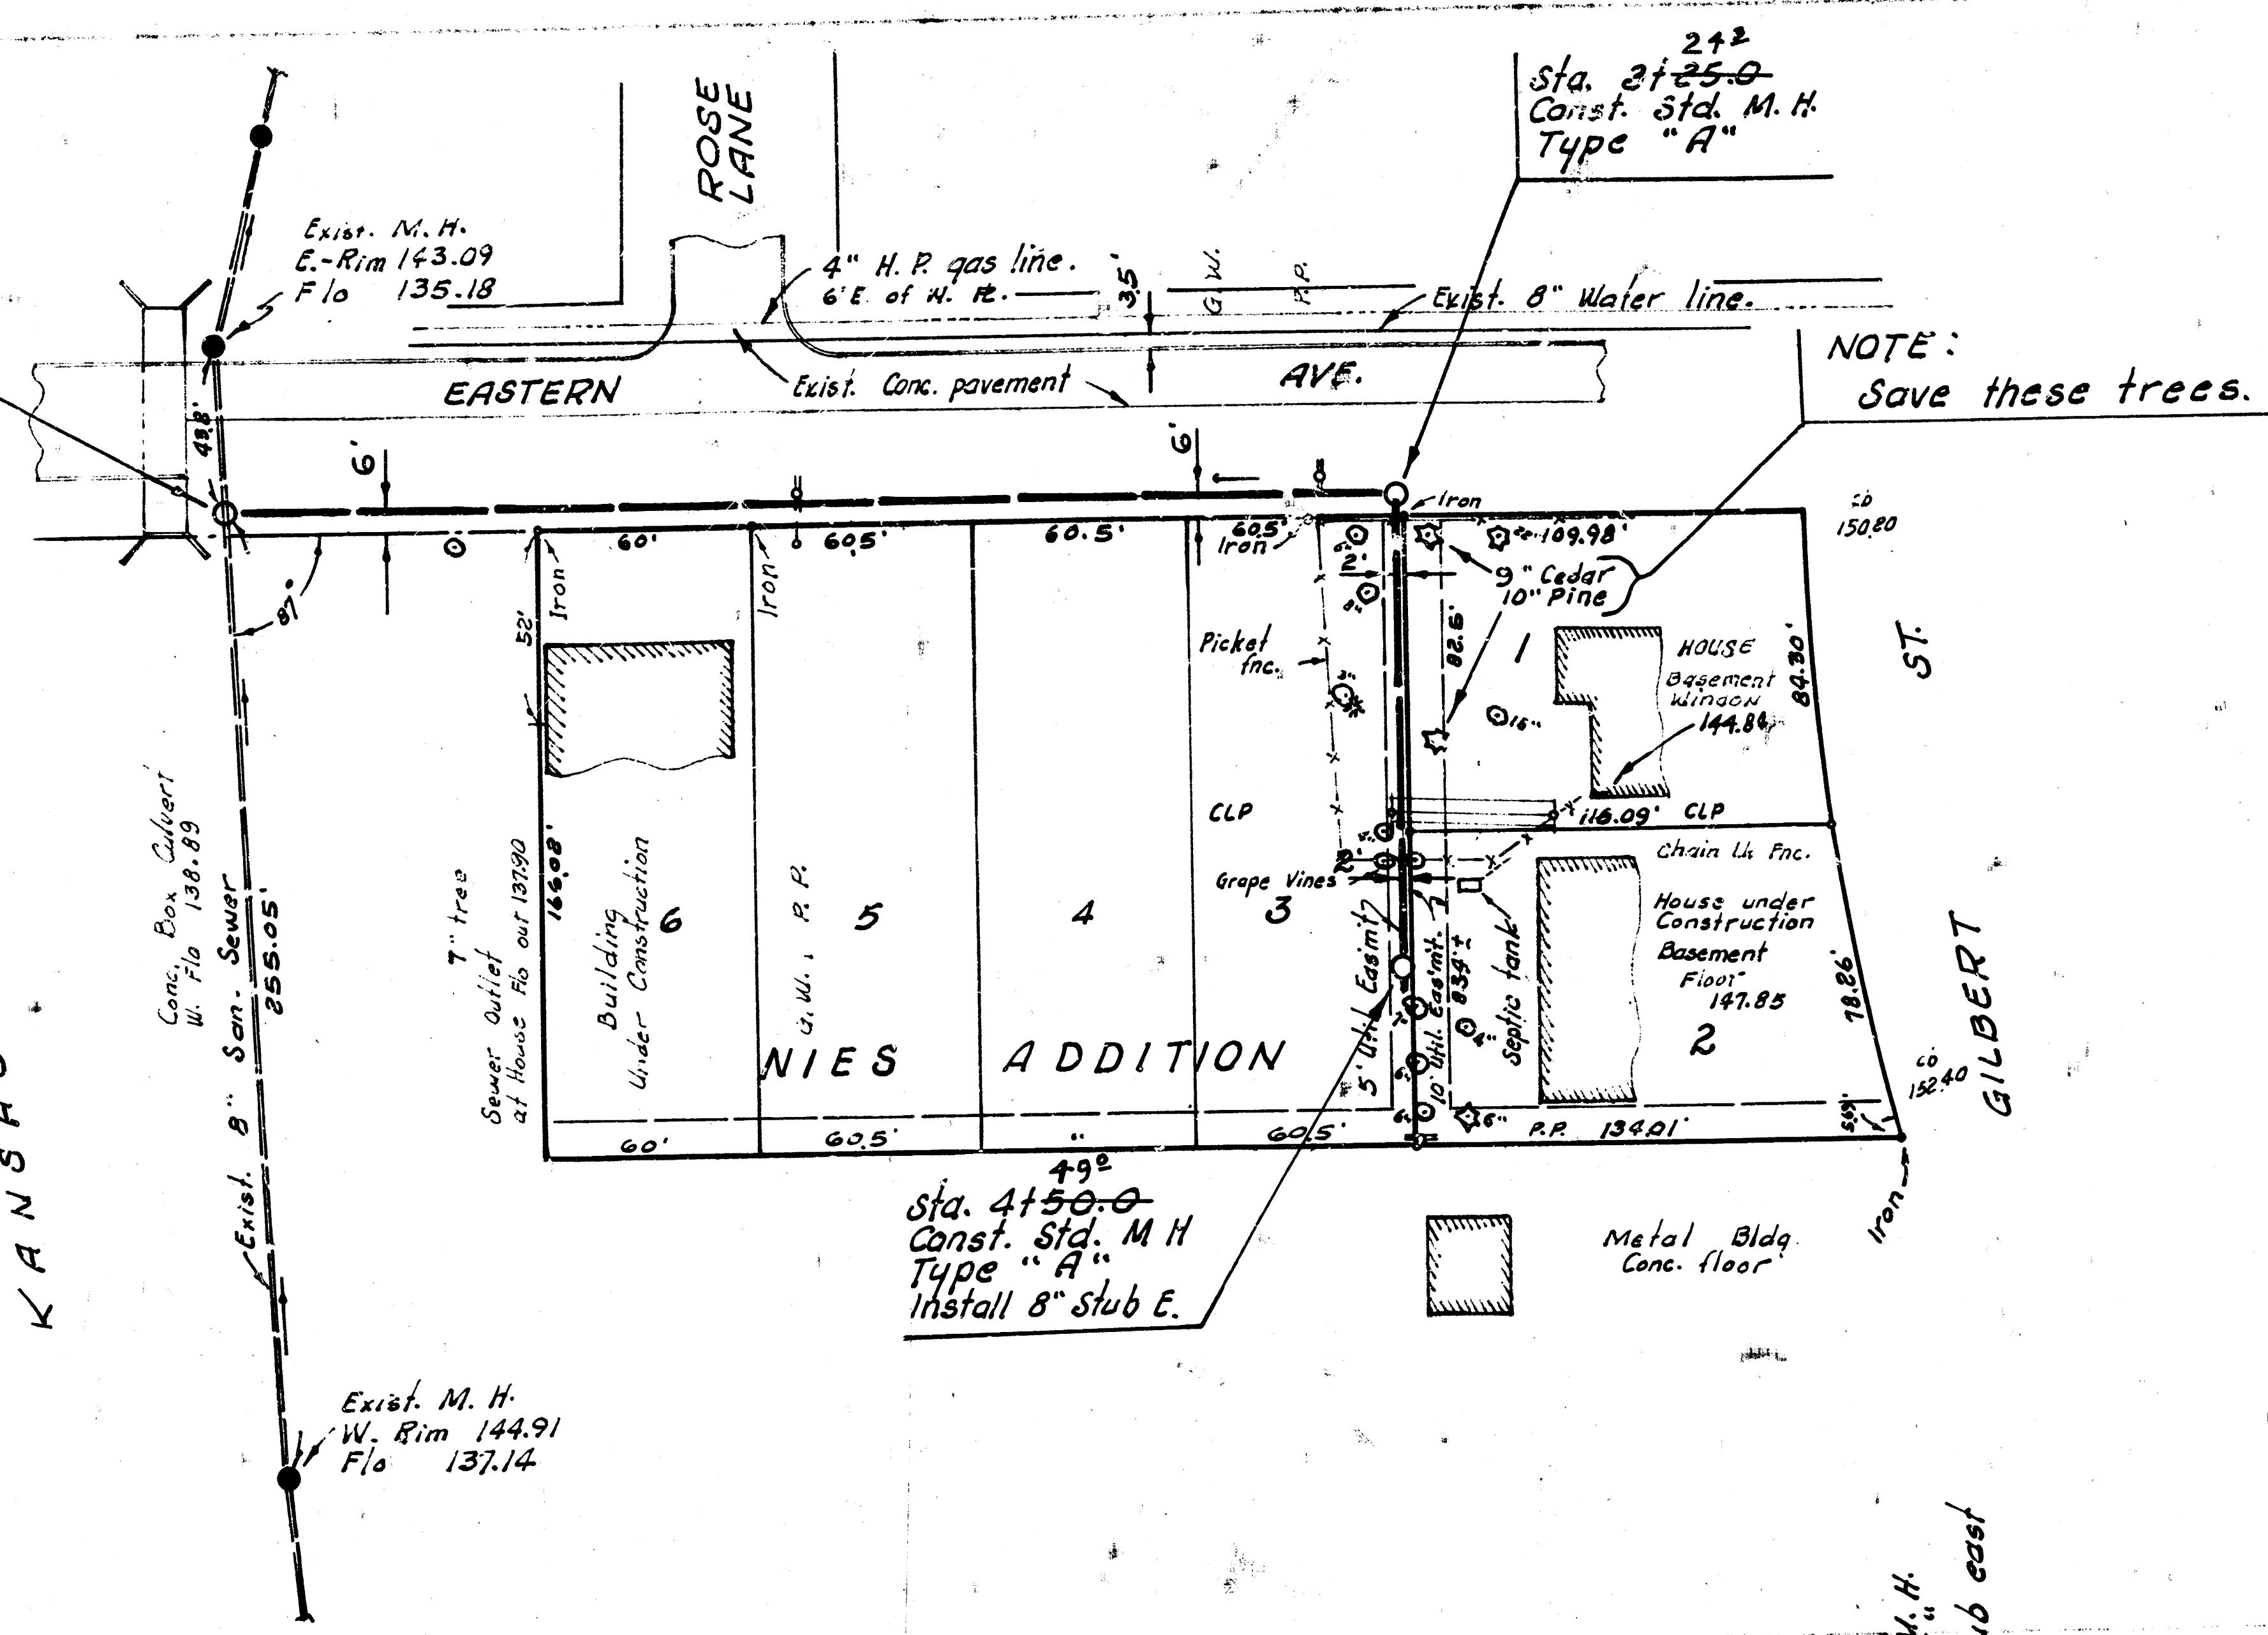


Plan Scale 1" = 40'
Profile Scale 1" = 5' Vert.

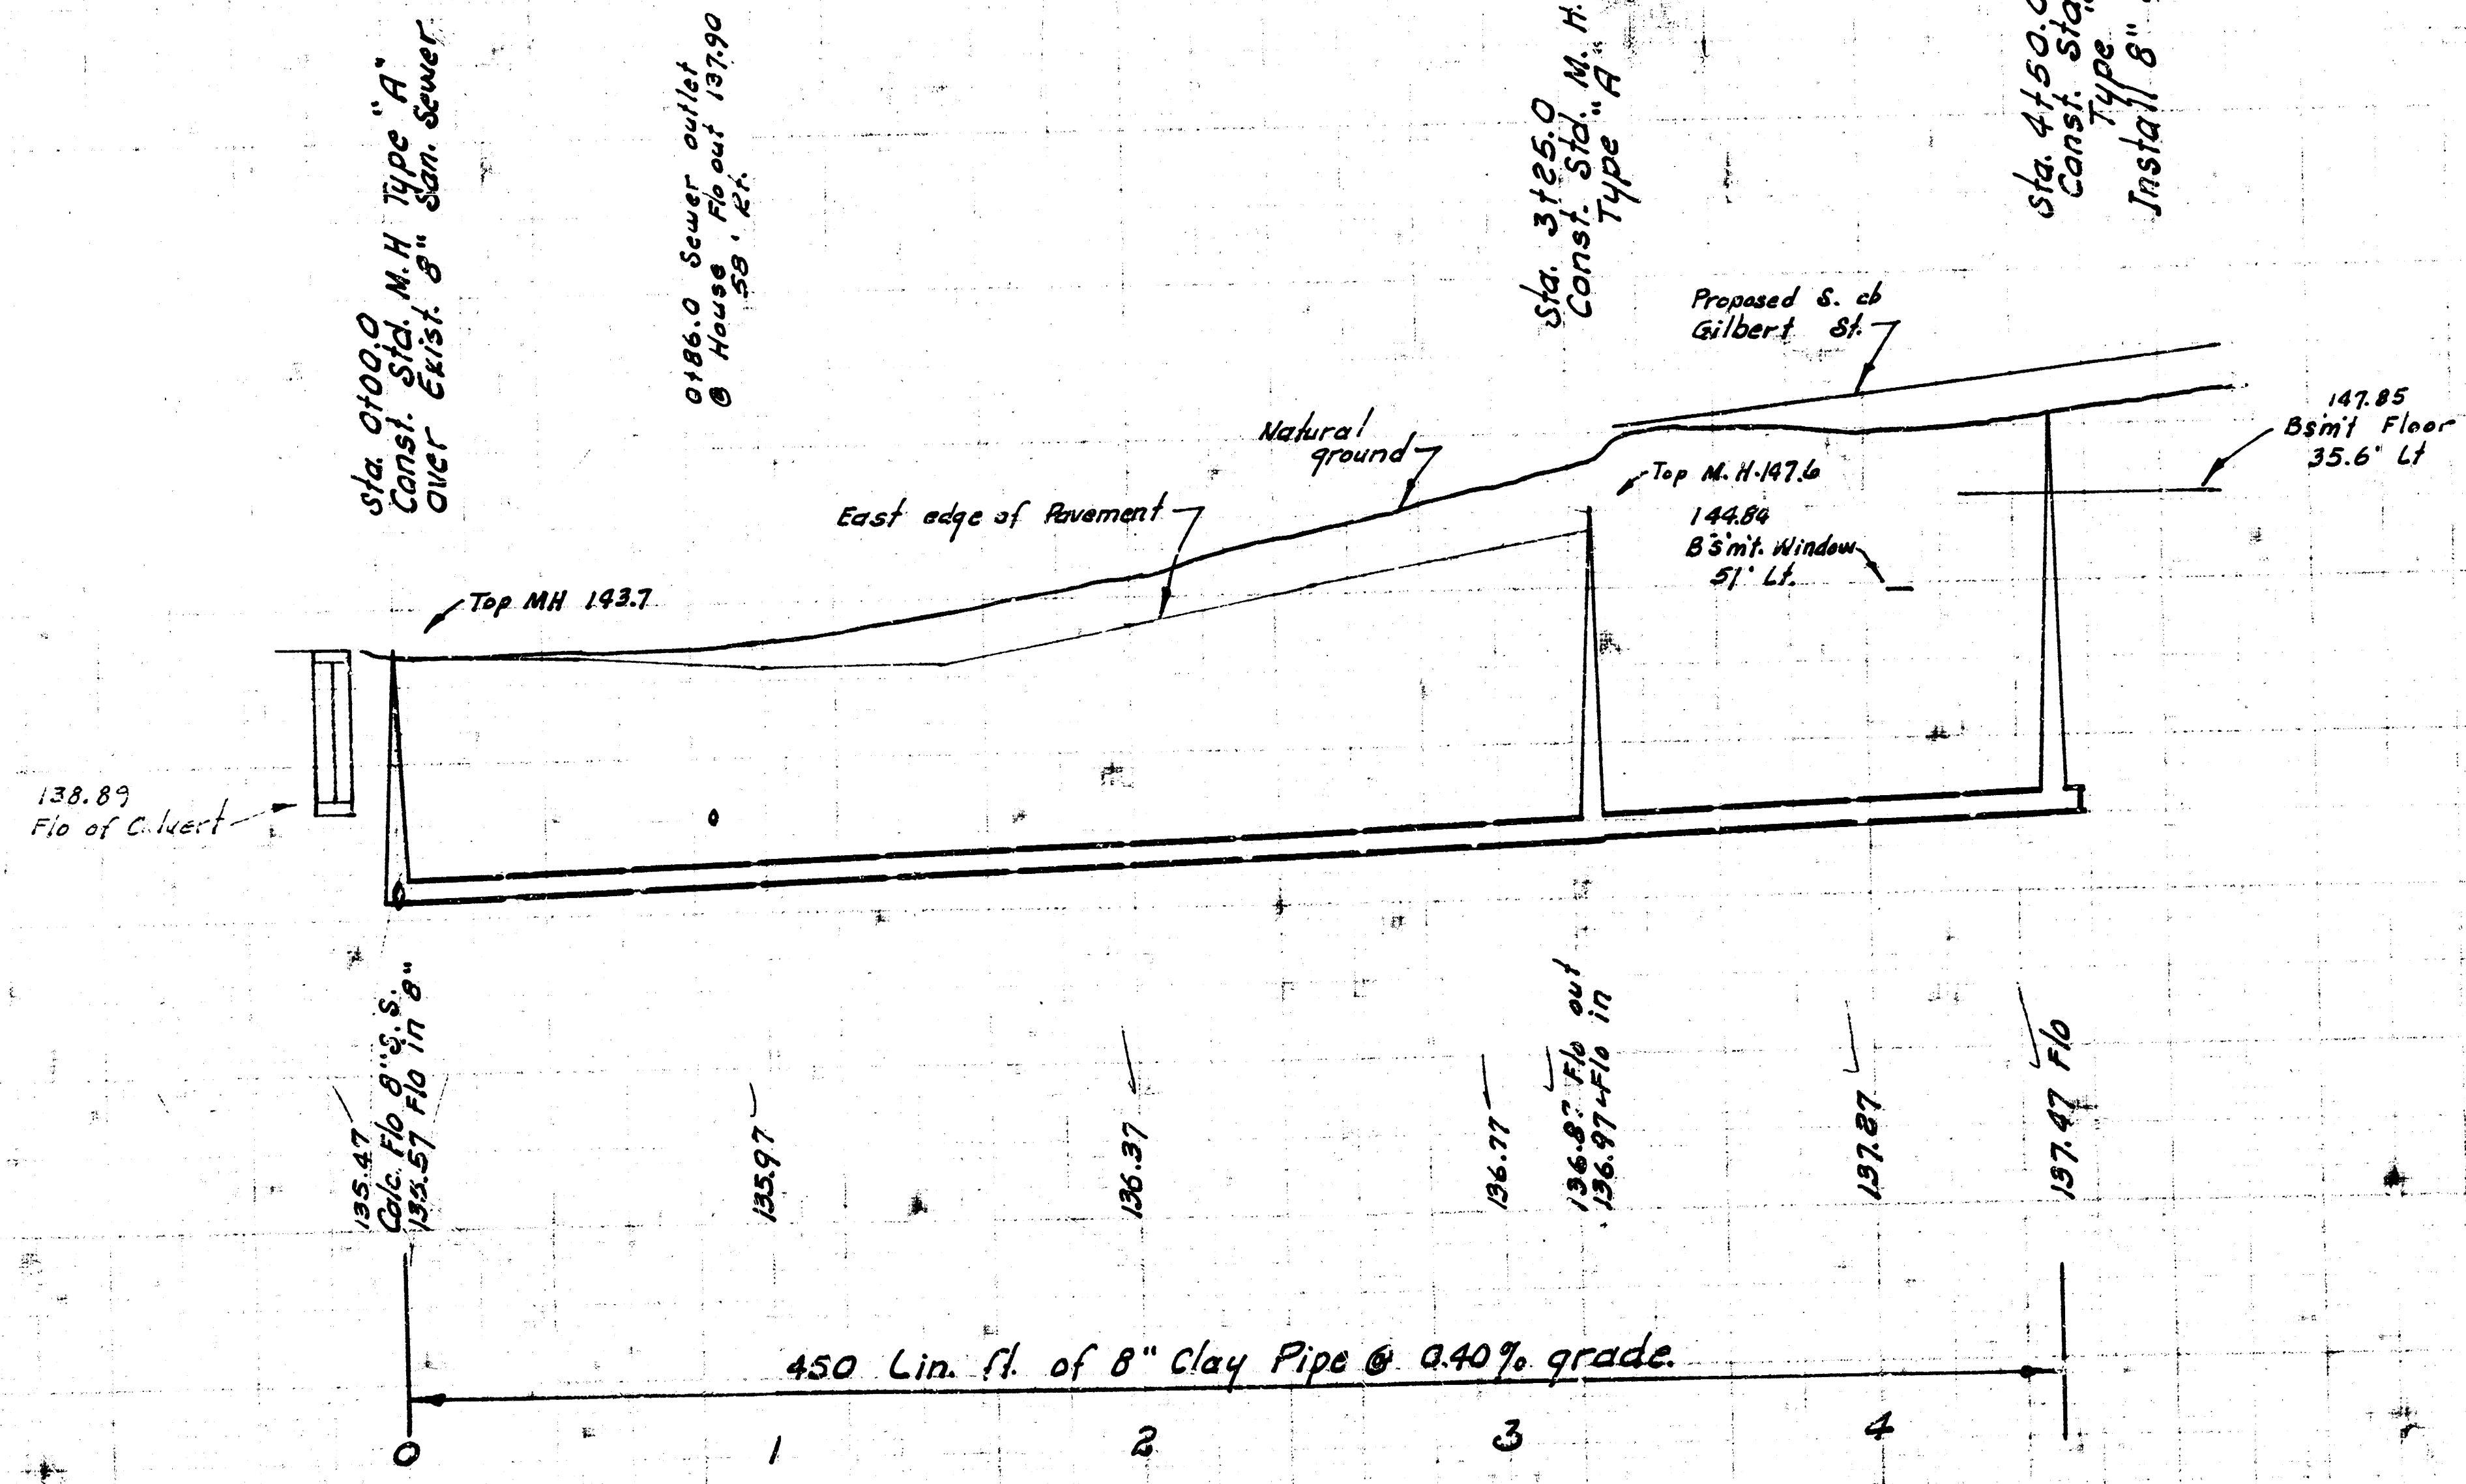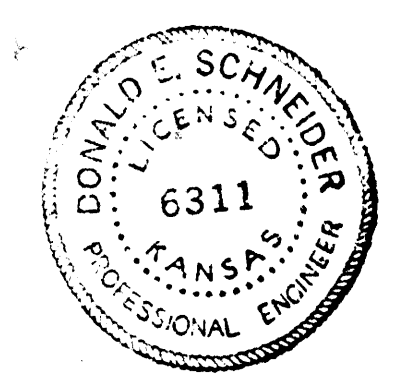

"As Built" FINAL MEASUREMENTS J-H-79

LAT. 52, WAR INDUSTRIES SEWER
CITY OF WICHITA, KANSAS
R. W. LINN — CITY ENGINEER
FEB. 1973 PROJECT NO. DBKL 572042

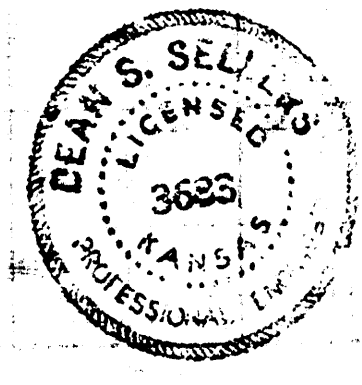

FILMED FROM THE BEST AVAILABLE COPY....