



1. A. R. W.

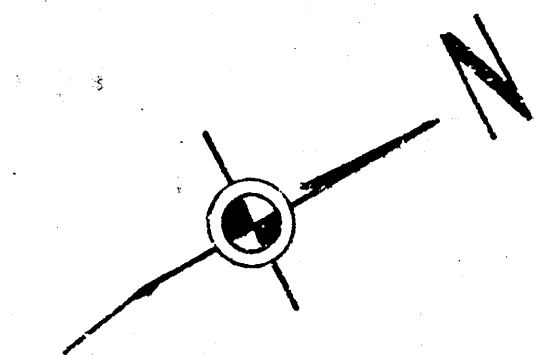

NOTE:
San. Sewer pipe must
have a minimum of
30" cover."

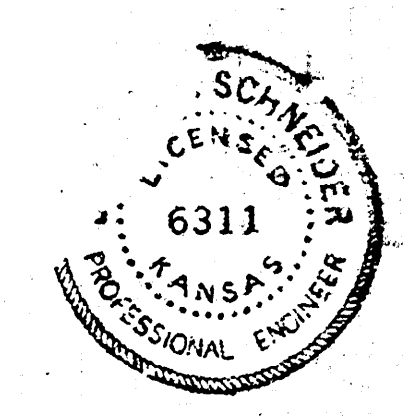

As Built Final Meas. 8-2

LAT. 53, W. I. S.

CITY OF WICHITA, KANSAS

R. W. LINN — CITY ENGINEER

MAY 1974 PROJECT NO. DBKL572061

FILMED FROM THE BEST