

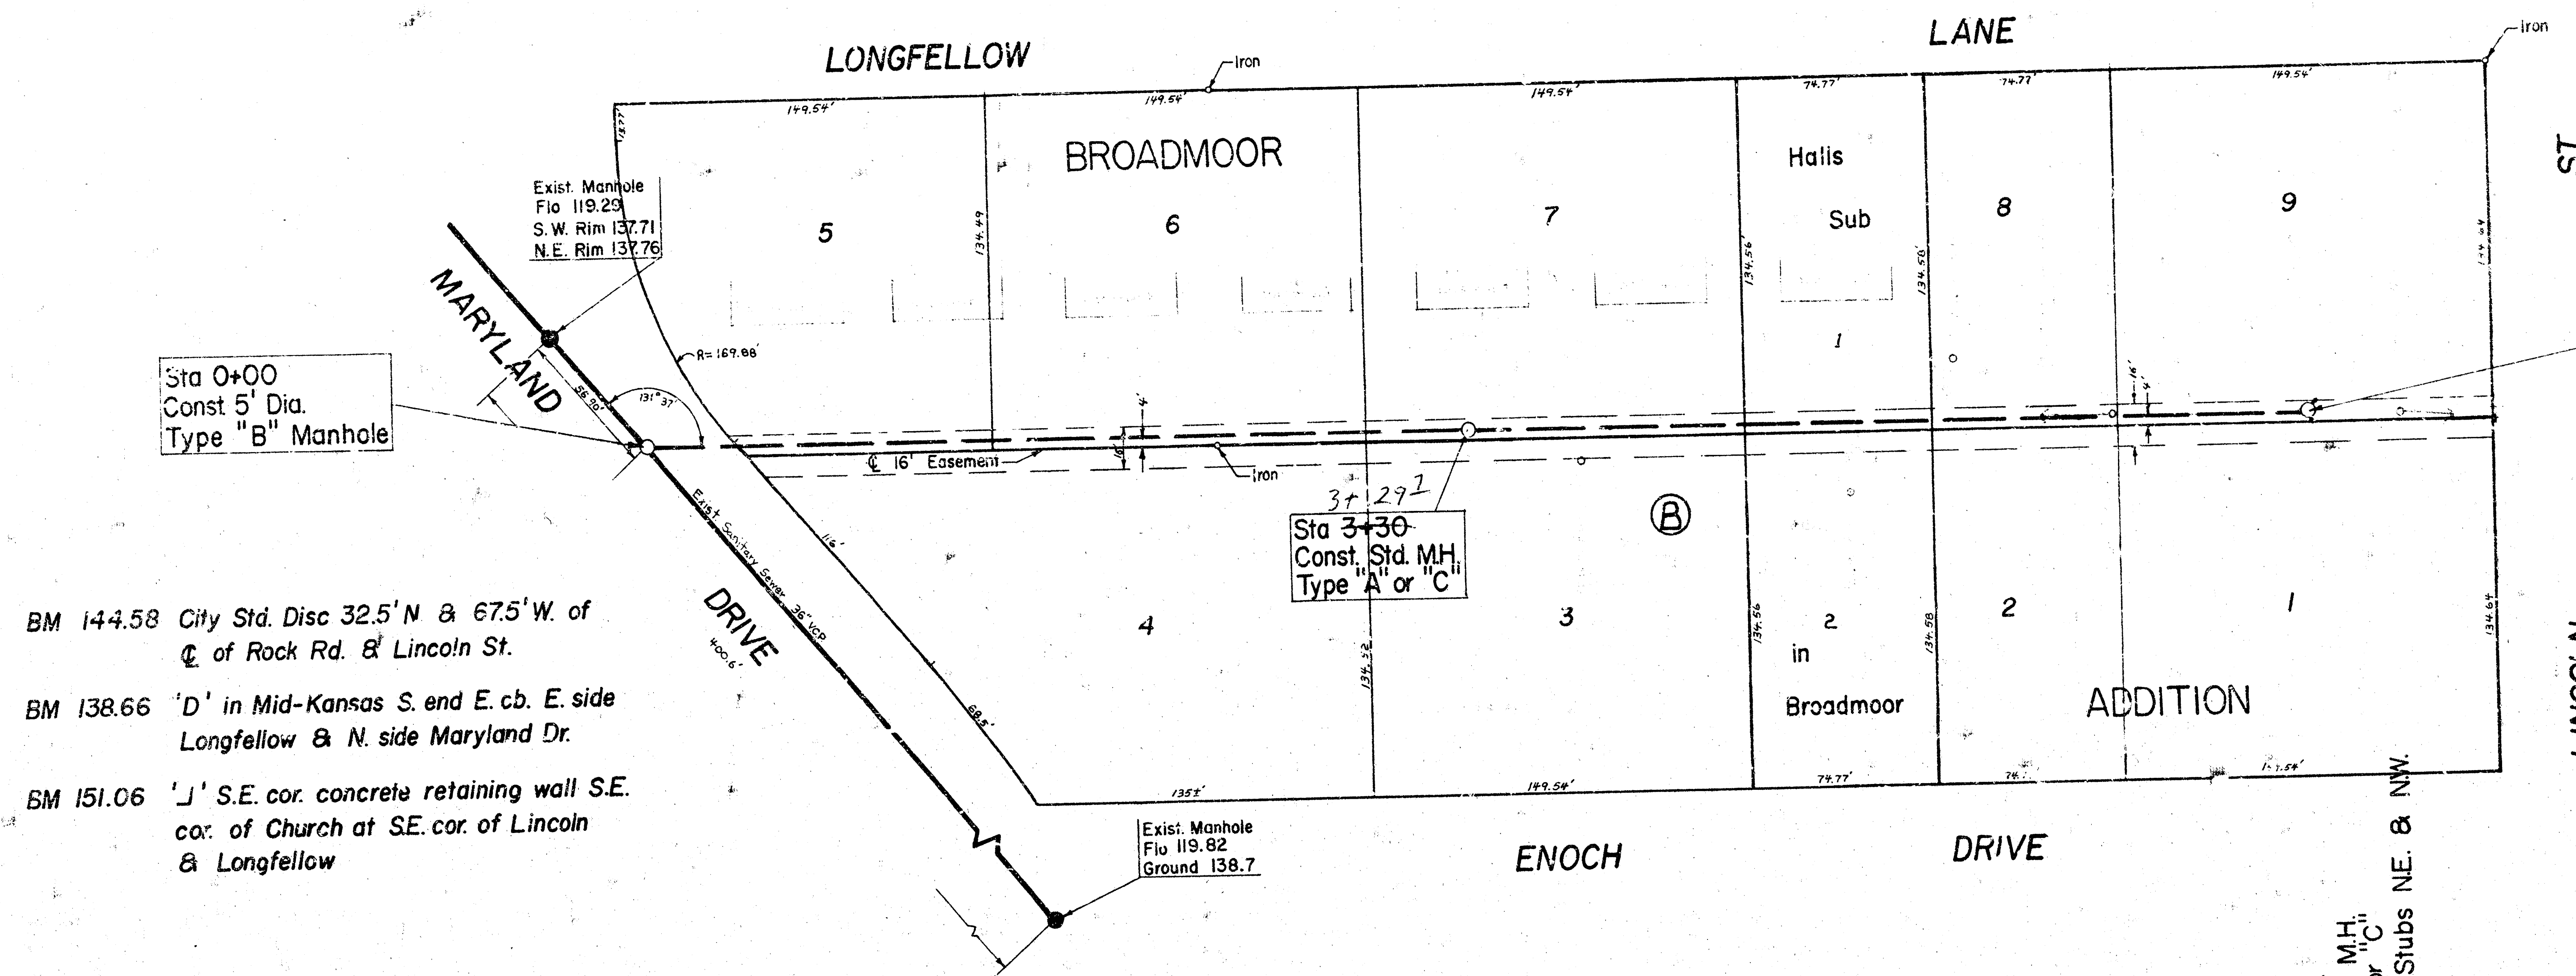


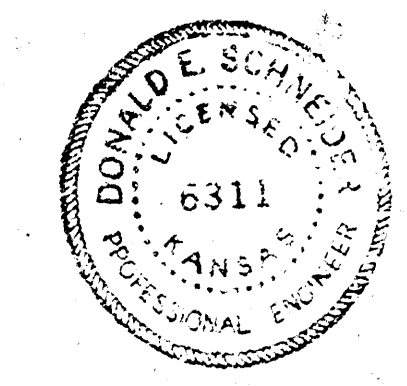

Plan Scale 1" = 40'
 Profile Scale 1" = 40' Horiz. -
 1" = 5' Vert.

BM 144.58 City Std. Disc 32.5' N & 67.5' W. of
 C. of Rock Rd. & Lincoln St.
 BM 138.66 'D' in Mid-Kansas S. end E. cb. E. side
 Longfellow & N. side Maryland Dr.
 BM 151.06 'J' S.E. cor. concrete retaining wall S.E.
 cor. of Church at S.E. cor. of Lincoln
 & Longfellow

NOTE: FIELD ENGINEER TO DETERMINE EXACT
 LOCATION OF MANHOLE ON THE END OF THE LINE
 SUCH AS TO FACILITATE CONNECTION OF EXISTING
 BUILDING ON THE SOUTHEAST CORNER OF LINCOLN
 AND LONGFELLOW.

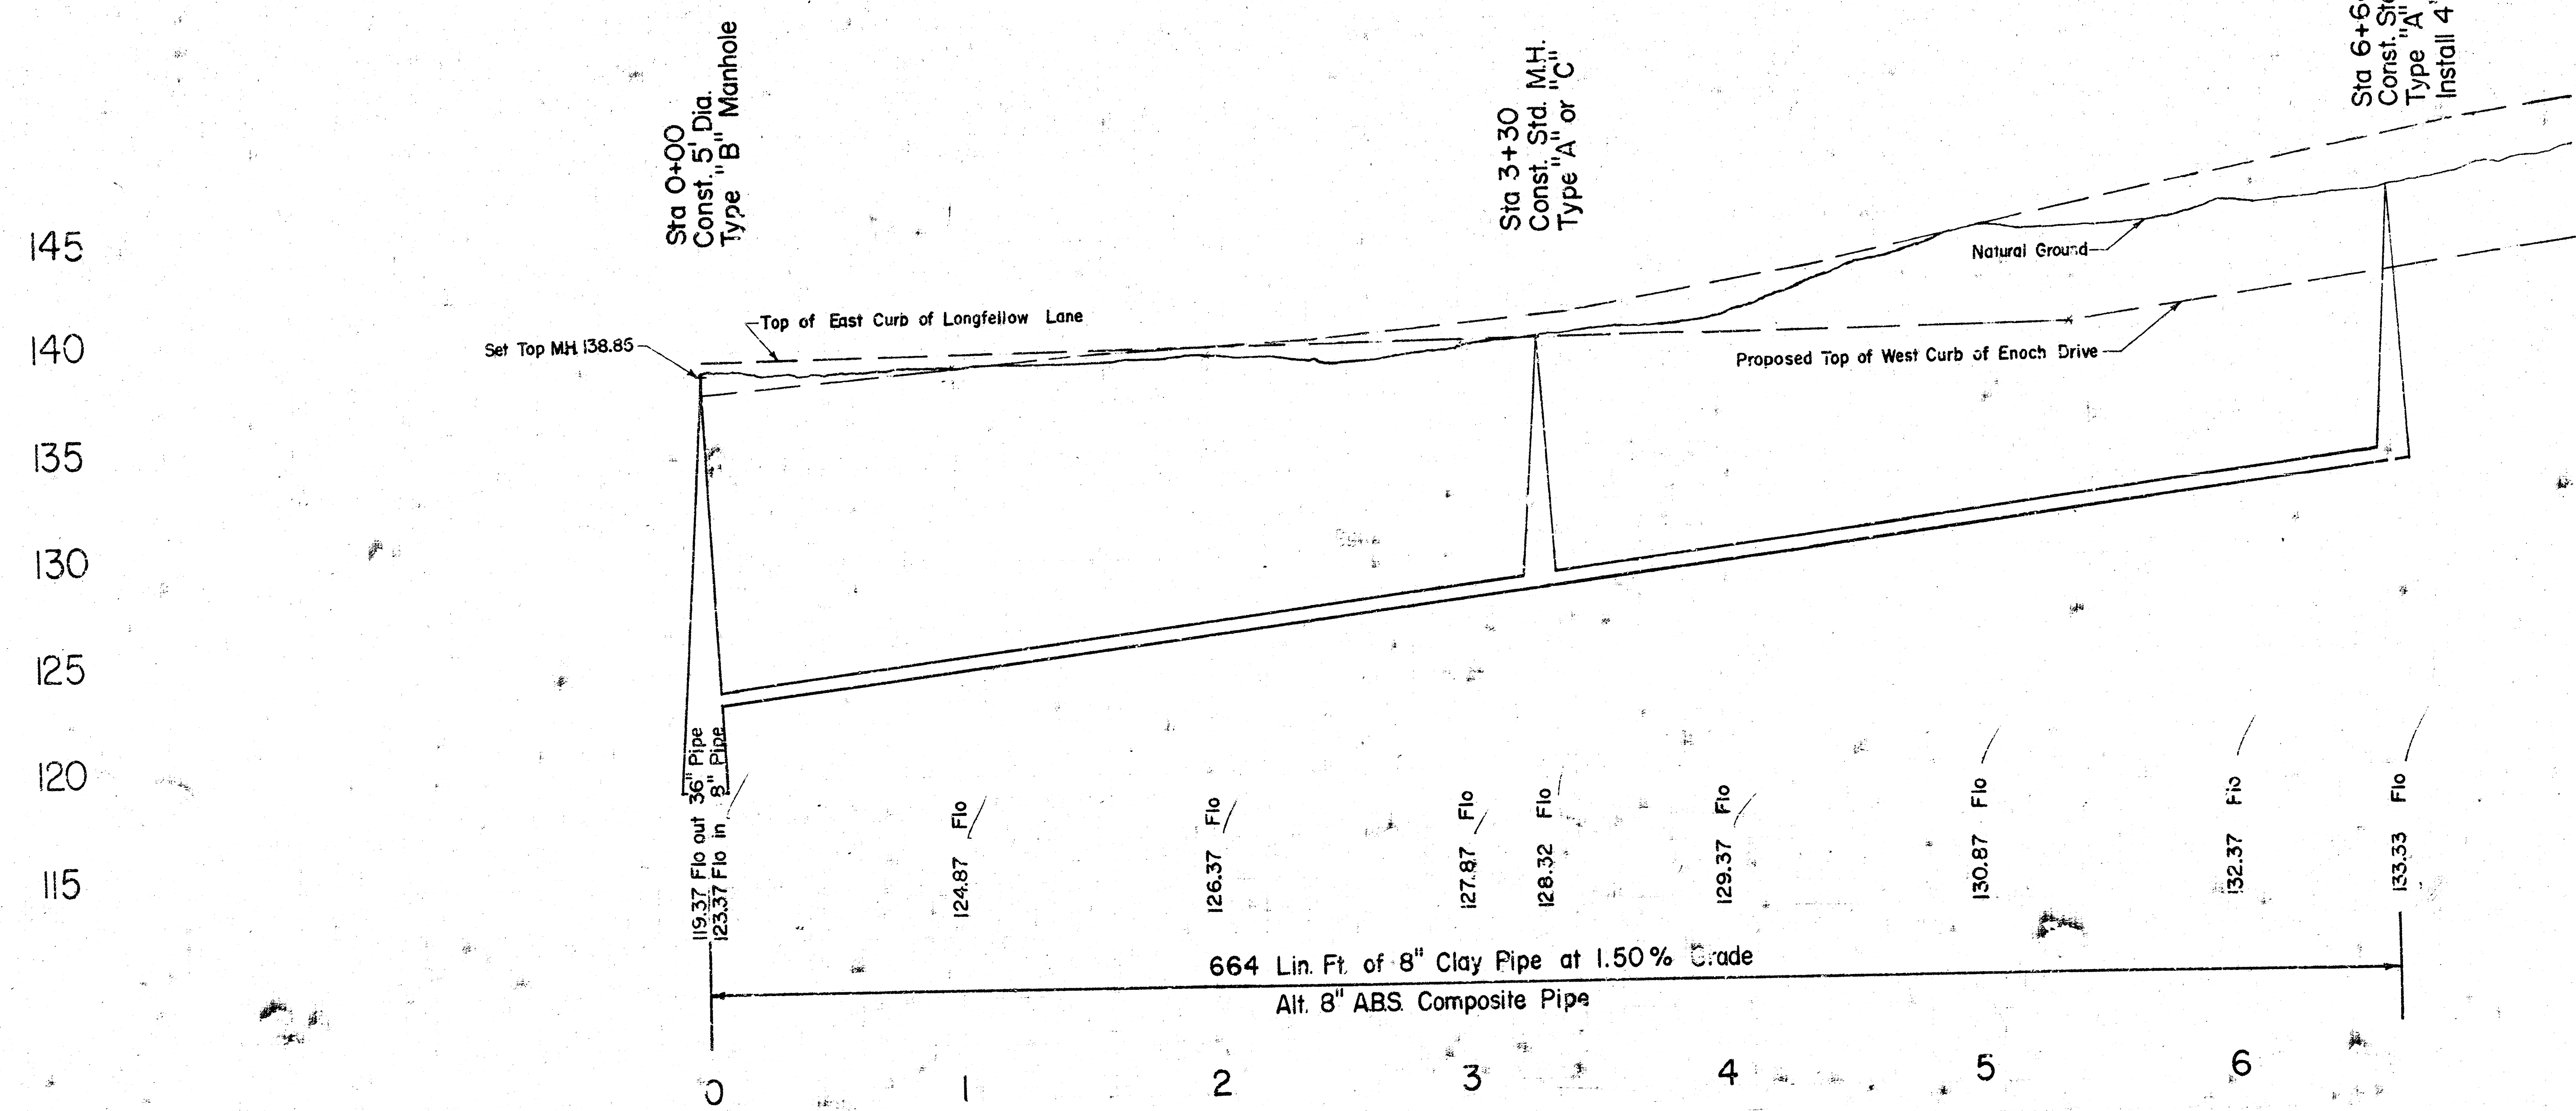

As built - 12-29-76
 LAT. 57 WAR INDUSTRIES SEWER
 CITY OF WICHITA, KANSAS
 R. W. LINN - CITY ENGINEER
 Project No. DBKL576019