


SCALE 1" = 100'

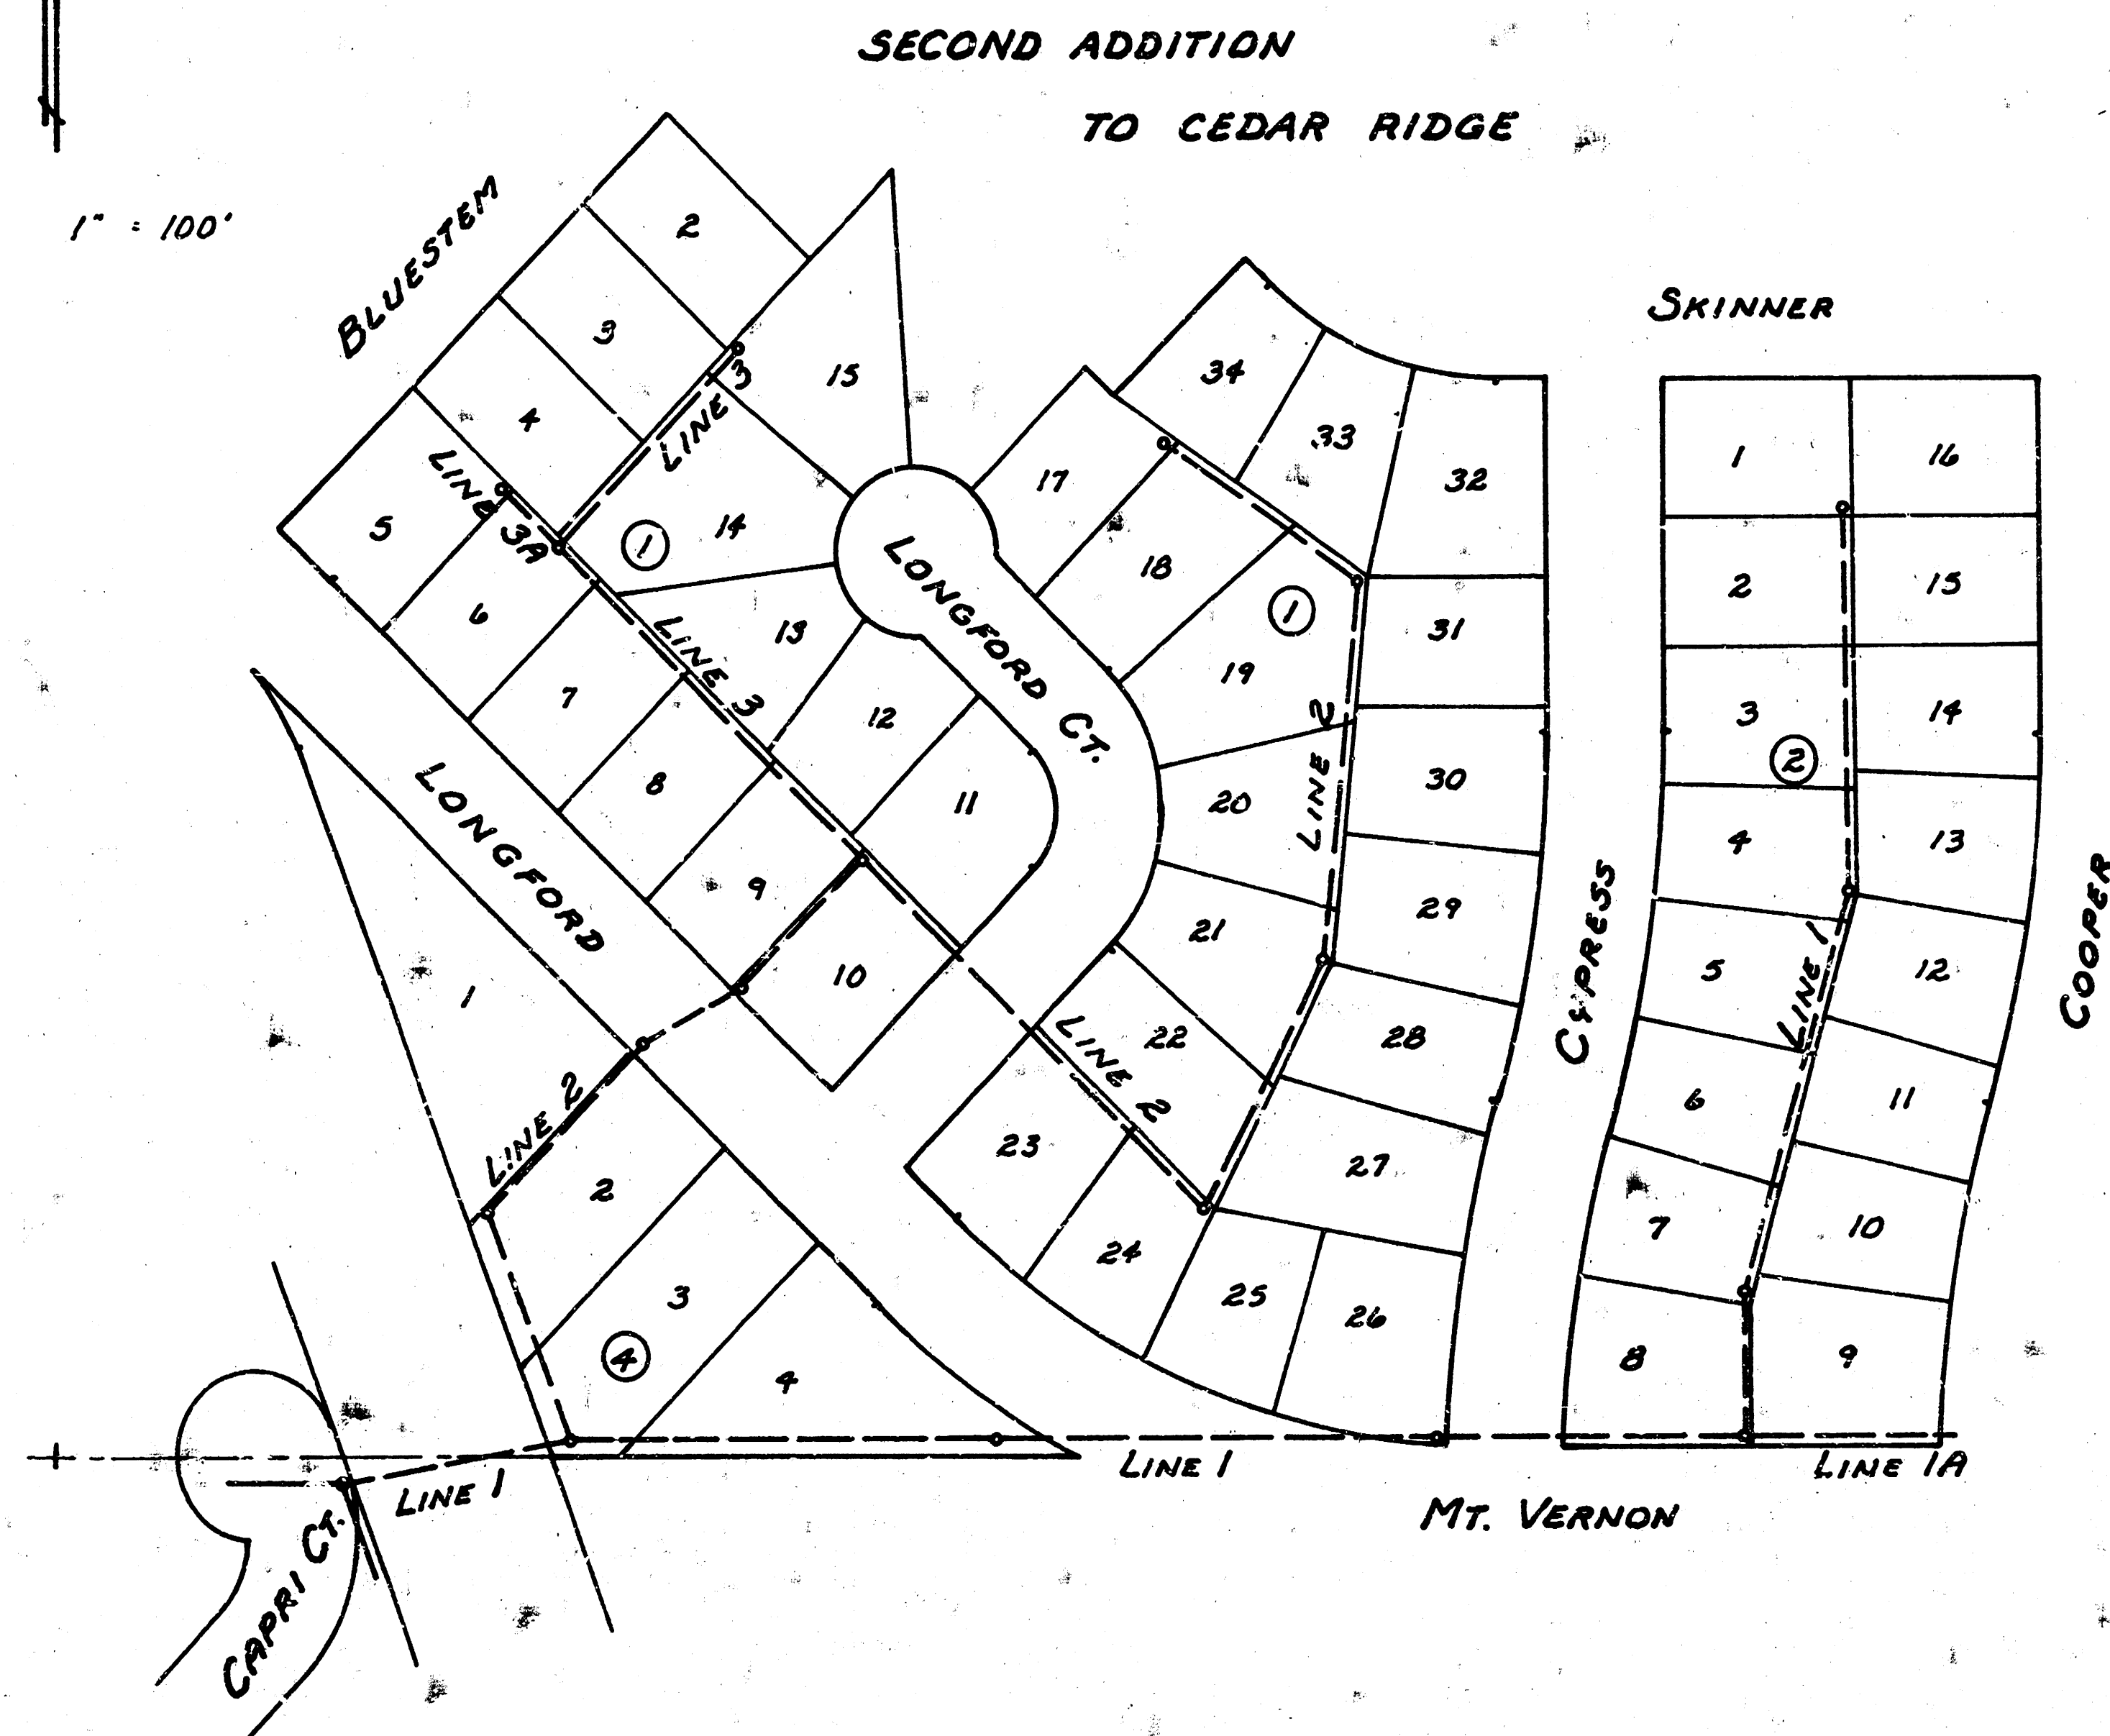

LAT 70, WAR INDUSTRIES SEWER

CITY OF WICHITA, KANSAS

R. W. BRUGGEMAN

DIRECTOR OF ENGINEERING - CITY ENGINEER

PROJ. NO. 468-76-245-81137-000-000-001

As Built
J.L.L.
8/82

INDEX


2nd Addn. to Cedar
Ridge Plot
Line 1
Line 1A
Line 2
Line 3
Line 3A

Sheet 2
Sheet 3-4
Sheet 3
Sheet 4-5
Sheet 6
Sheet 6

NOTE: RISER PIPE SHALL BE INSTALLED TO SERVE INDIVIDUAL LOTS OR TRACTS IN CONJUNCTION WITH NEW SANITARY SEWER CONSTRUCTION, UNLESS OTHERWISE ORDERED BY THE ENGINEER. BECAUSE OF GROUND WATER, UNSTABLE SOIL OR UNUSUALLY DEEP CONSTRUCTION, RISER LOCATIONS SHALL BE AS APPROVED BY THE PROPERTY OWNER WITH THE CONCURRENCE OF THE ENGINEER. INSTALLATION OF RISERS ON SEWERS BECAUSE OF UNUSUAL DEPTH WILL BE REQUIRED WHEN THE SEWER IS DEEPER THAN TWELVE FEET (12'). RISER PIPE CONSTRUCTION SHALL CONFORM TO THE REQUIREMENTS AS SHOWN ON THE STANDARD RISER FORM TO THE REQUIREMENTS AS SHOWN ON THE STANDARD RISER DETAIL SHEET. THE CONTRACTOR WILL BE REQUIRED TO FILE WRITTEN DOCUMENTATION WITH THE ENGINEER IN A FORM APPROVED BY THE ENGINEER INDICATING THE LOCATIONS WHERE RISERS ARE TO BE INSTALLED AS REQUESTED BY THE PROPERTY OWNER OR HIS AUTHORIZED REPRESENTATIVE.




60 2-28



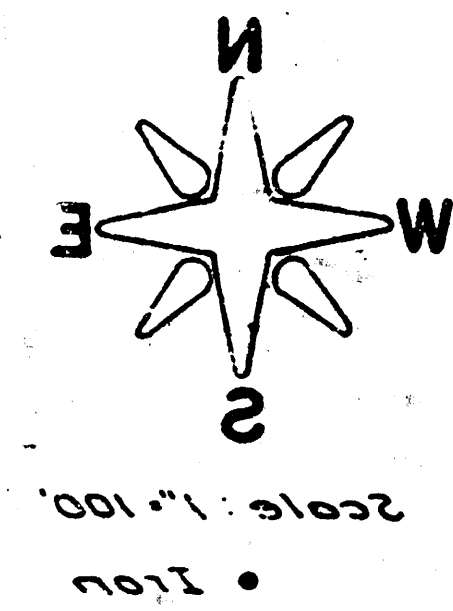



President

SCALE PLAN 1" = 40'
 PROFILE 1" = 40' HORIZ.
 1" = 5' VERT.

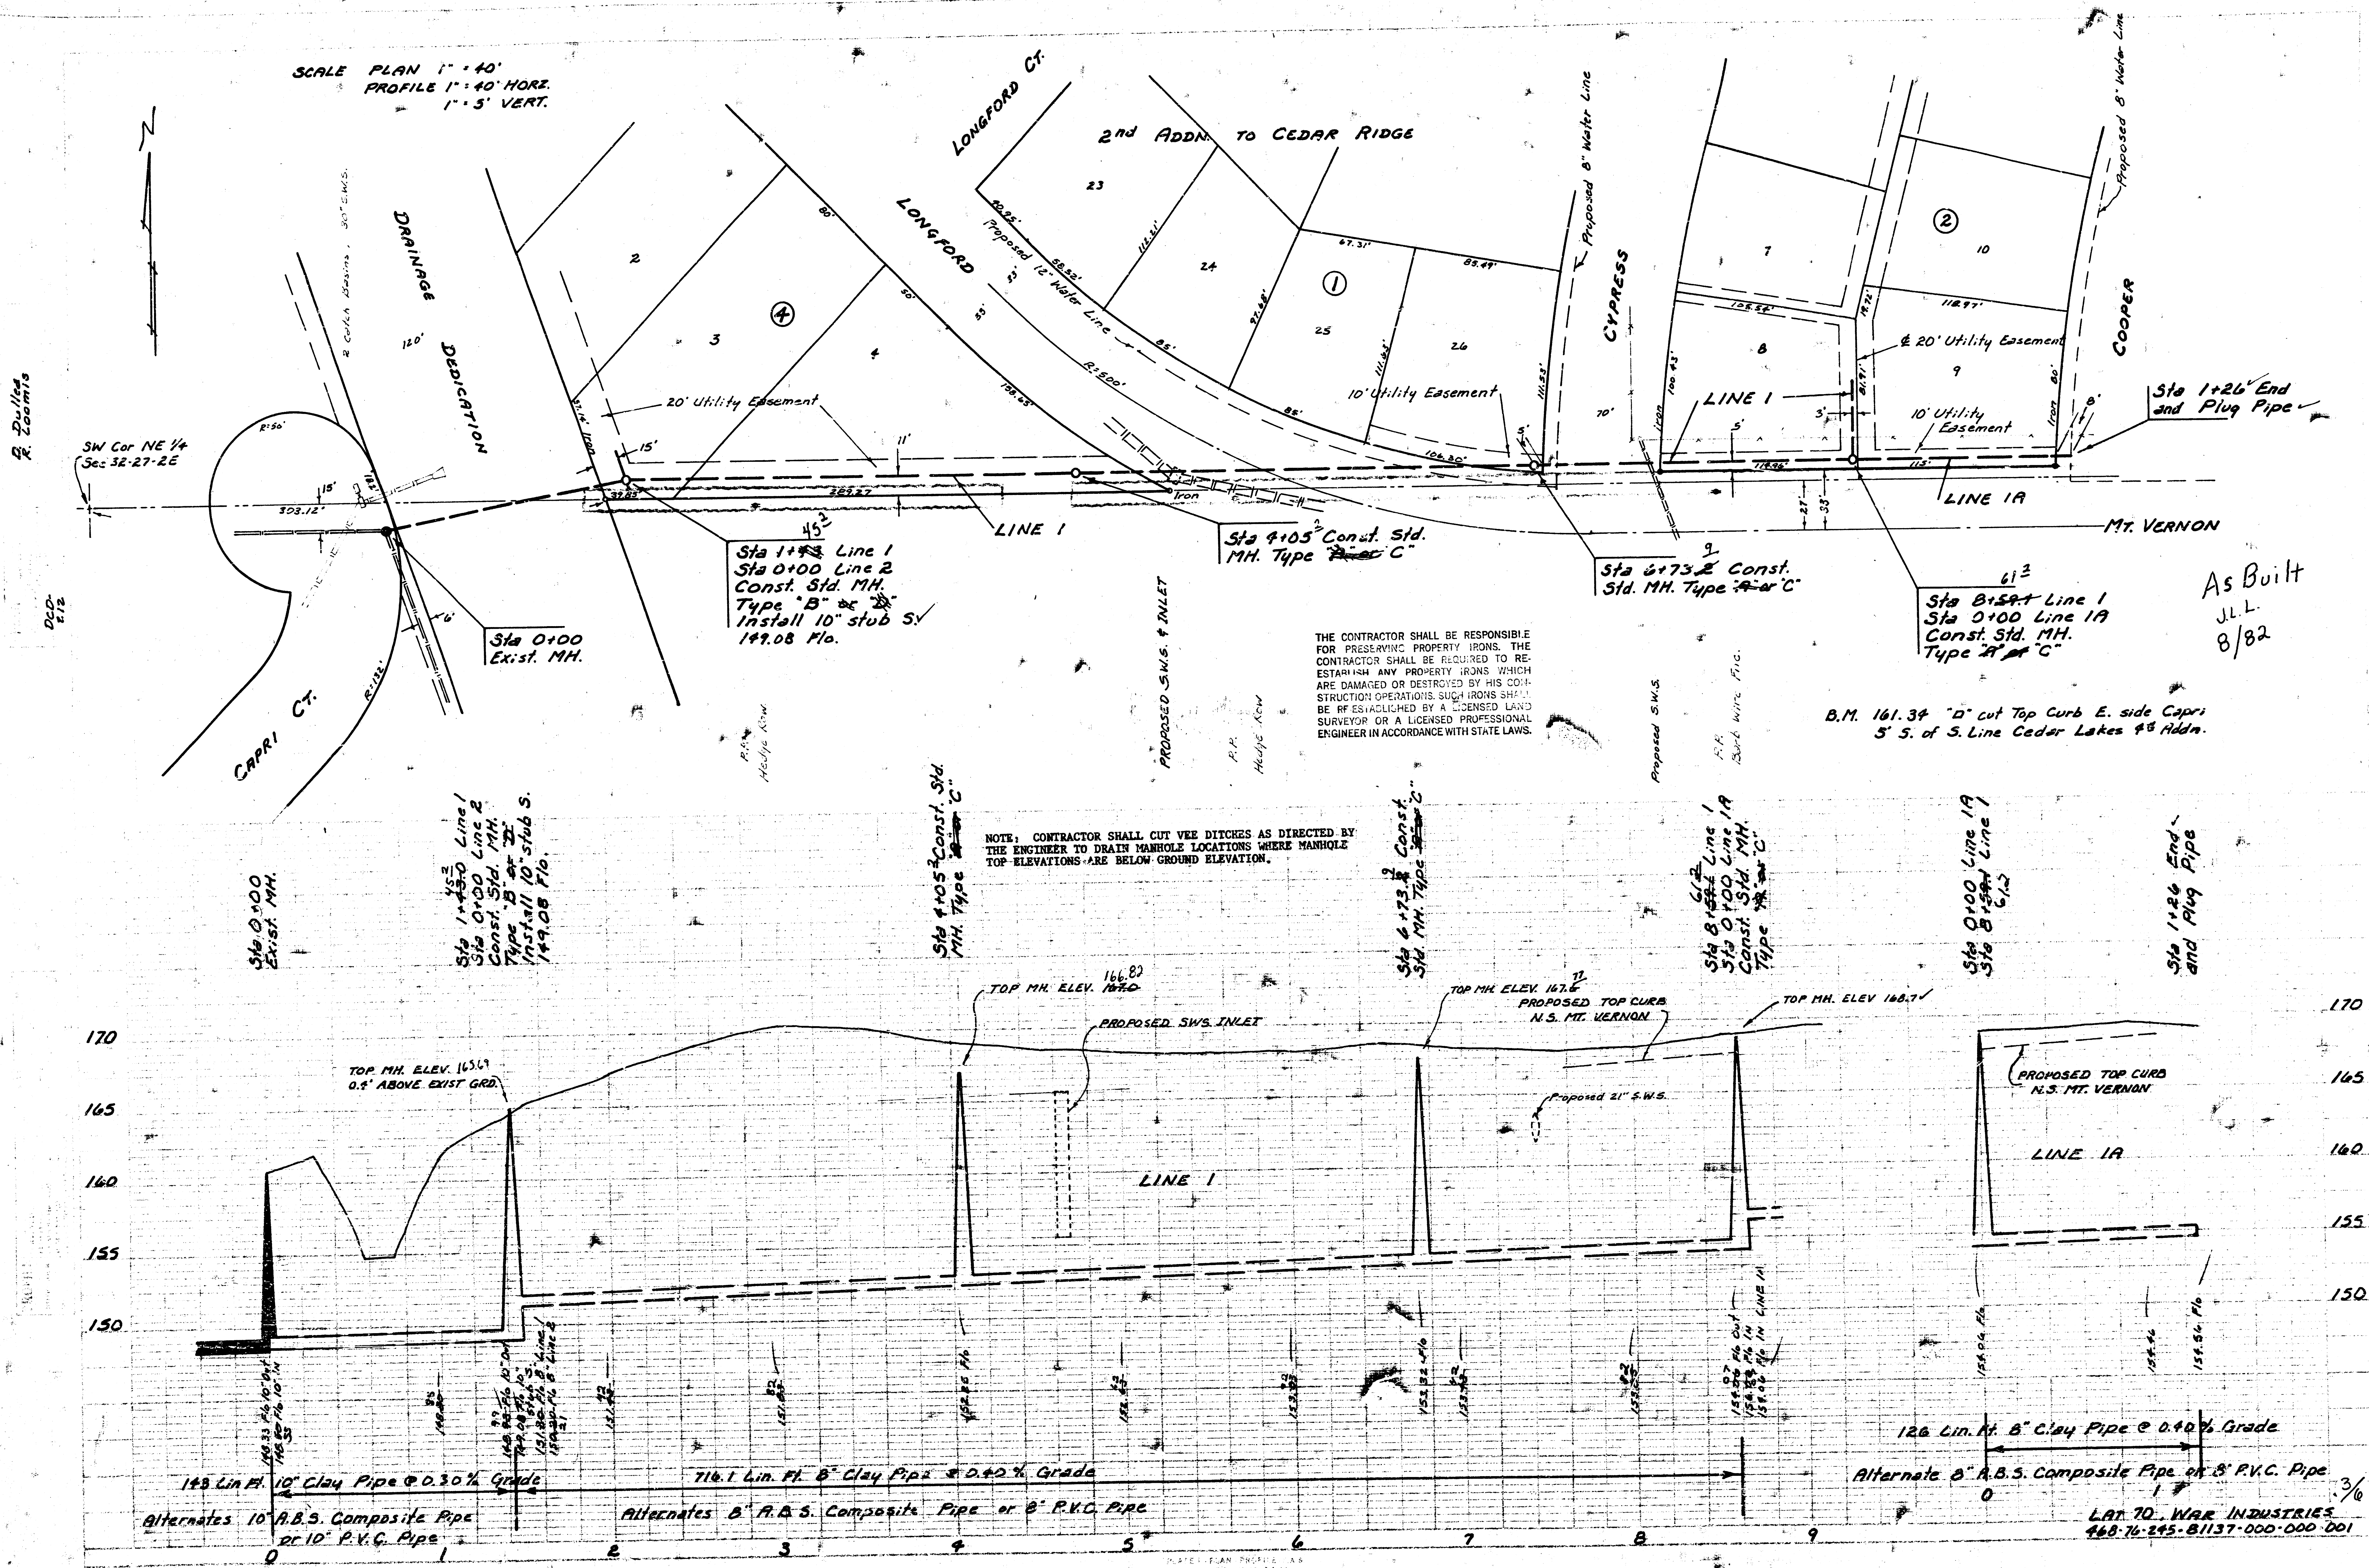

SCALE PLAN 1" = 40'
 PROFILE 1" = 40' HORIZ.
 1" = 5' VERT.

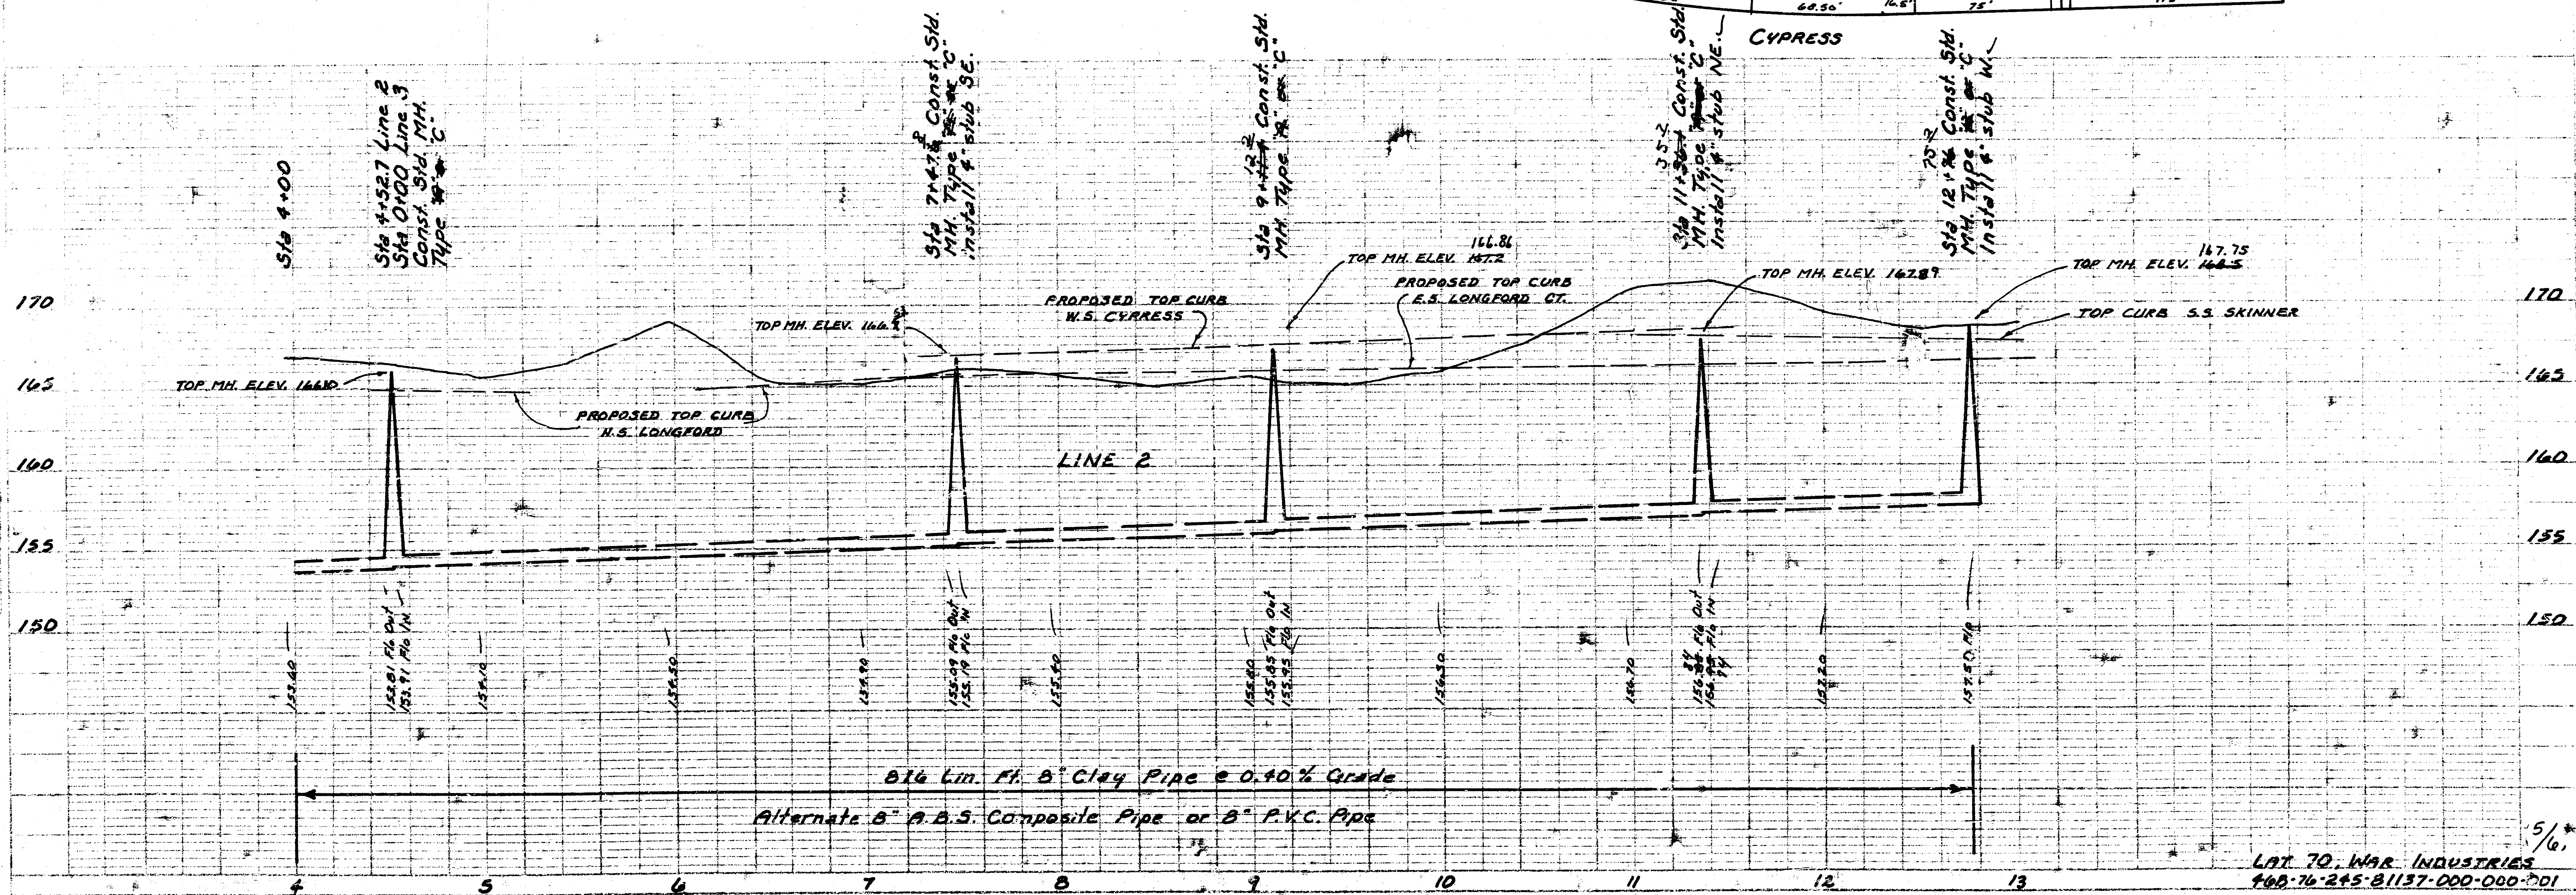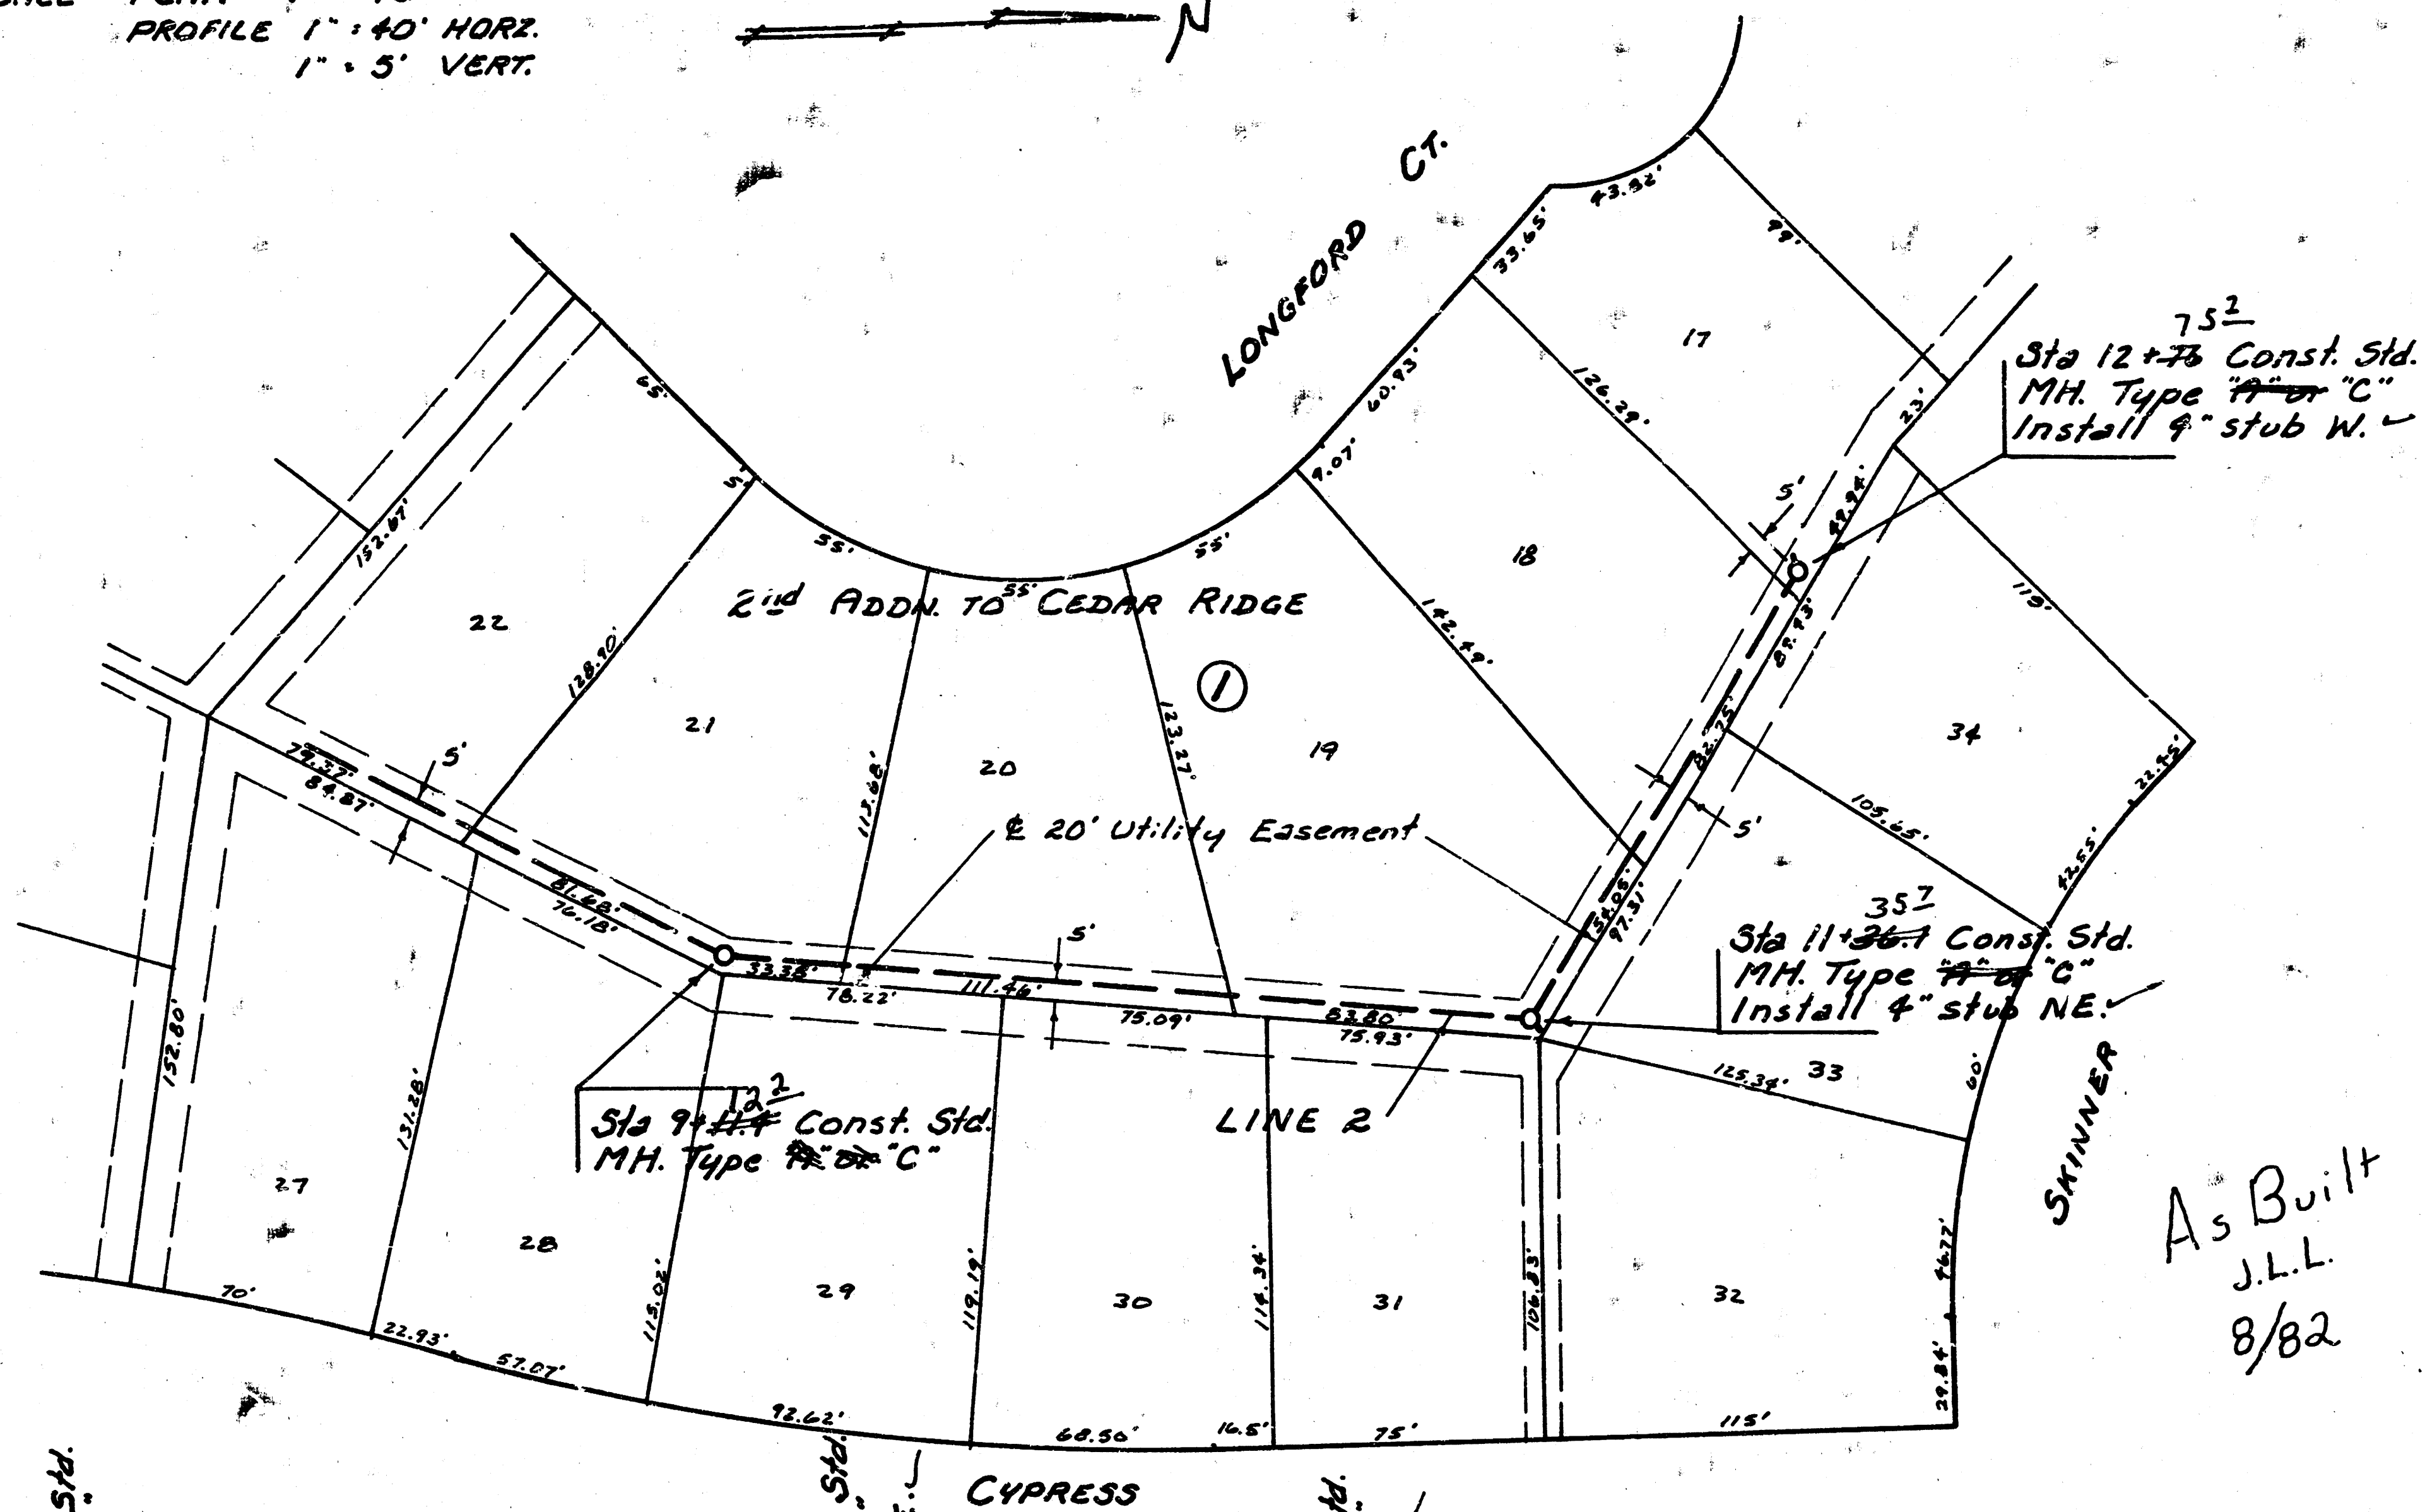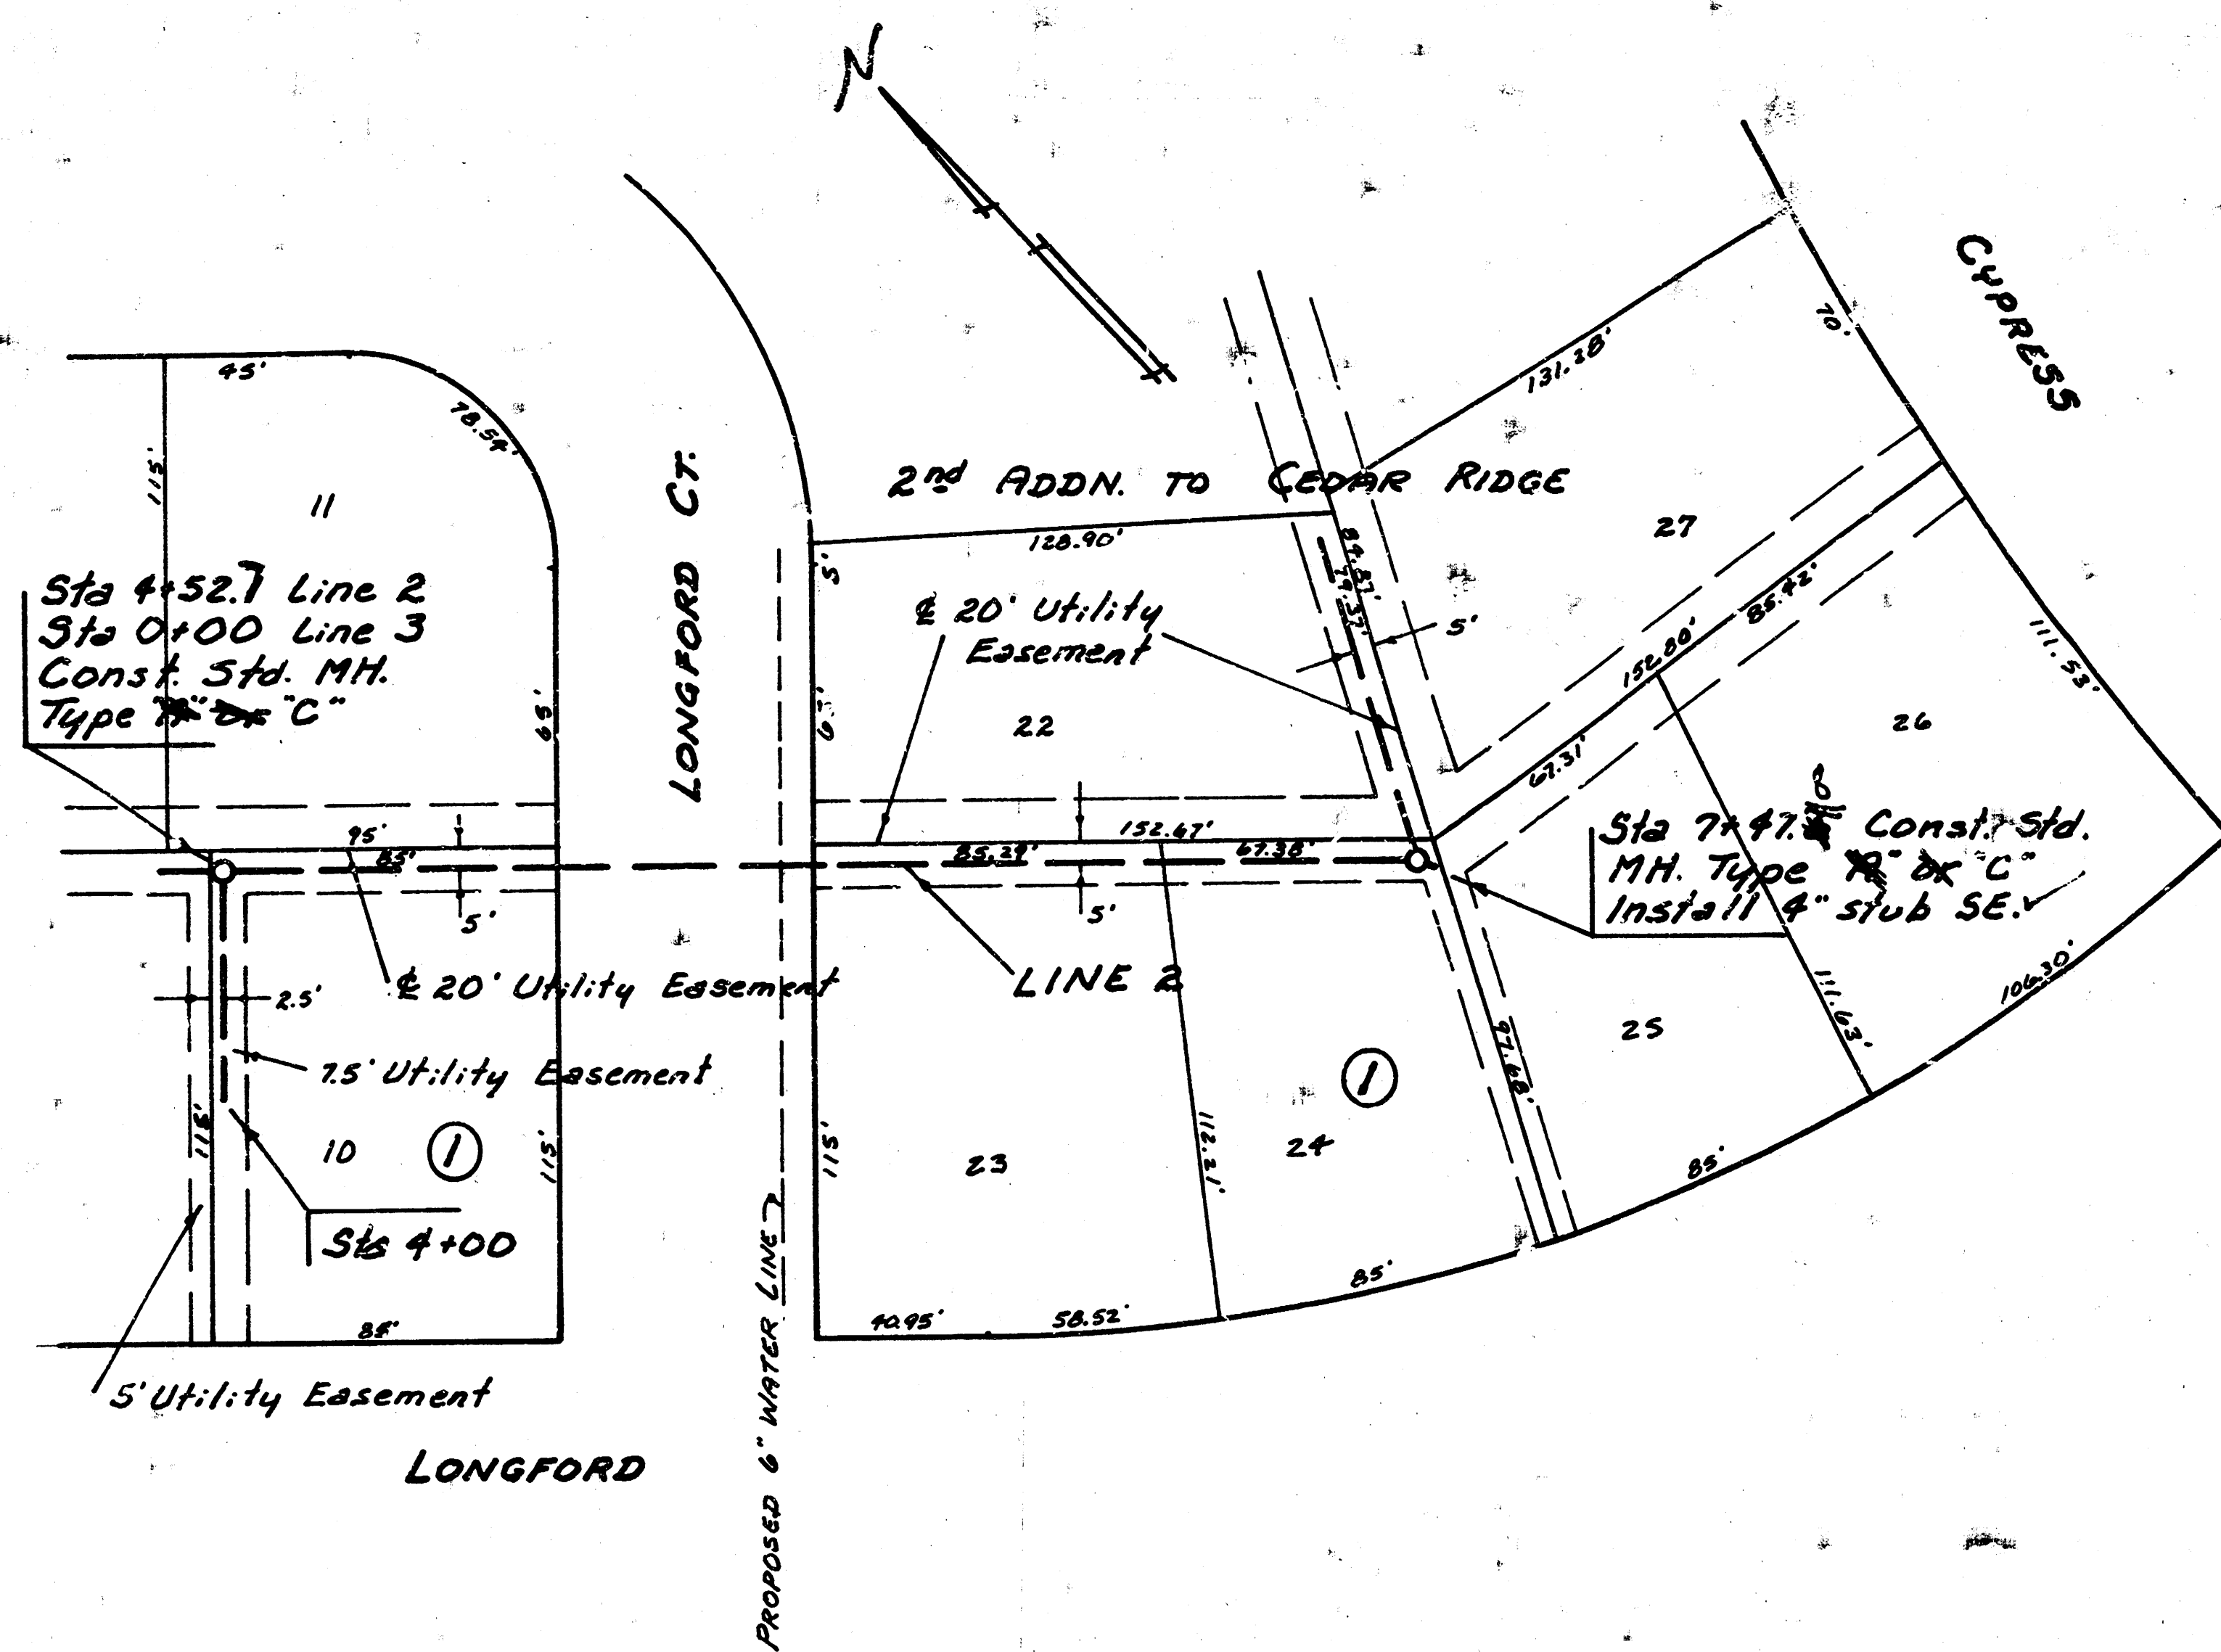

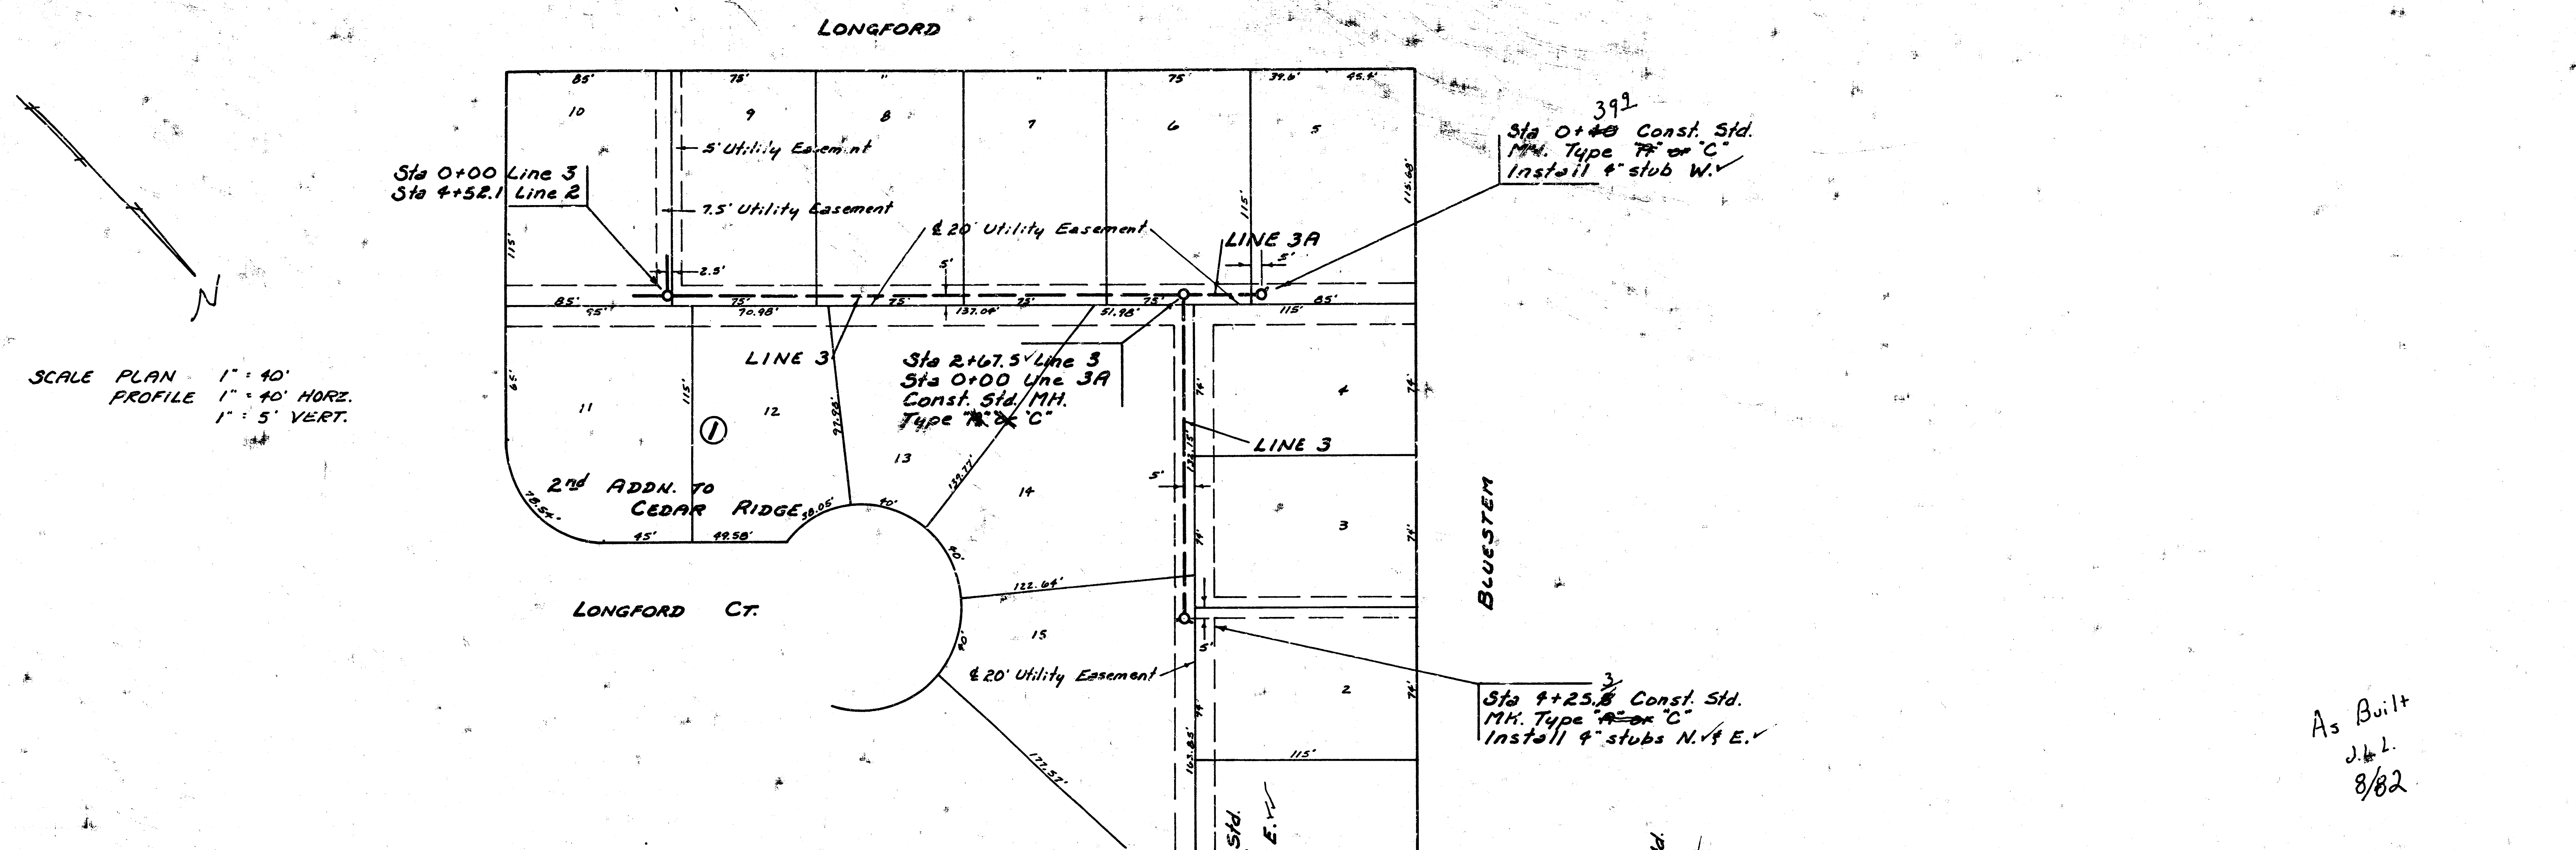

As Built
J. L.
8/82

