



Plan Scale: 1" = 40'
Profile Scale: 1" = 5'

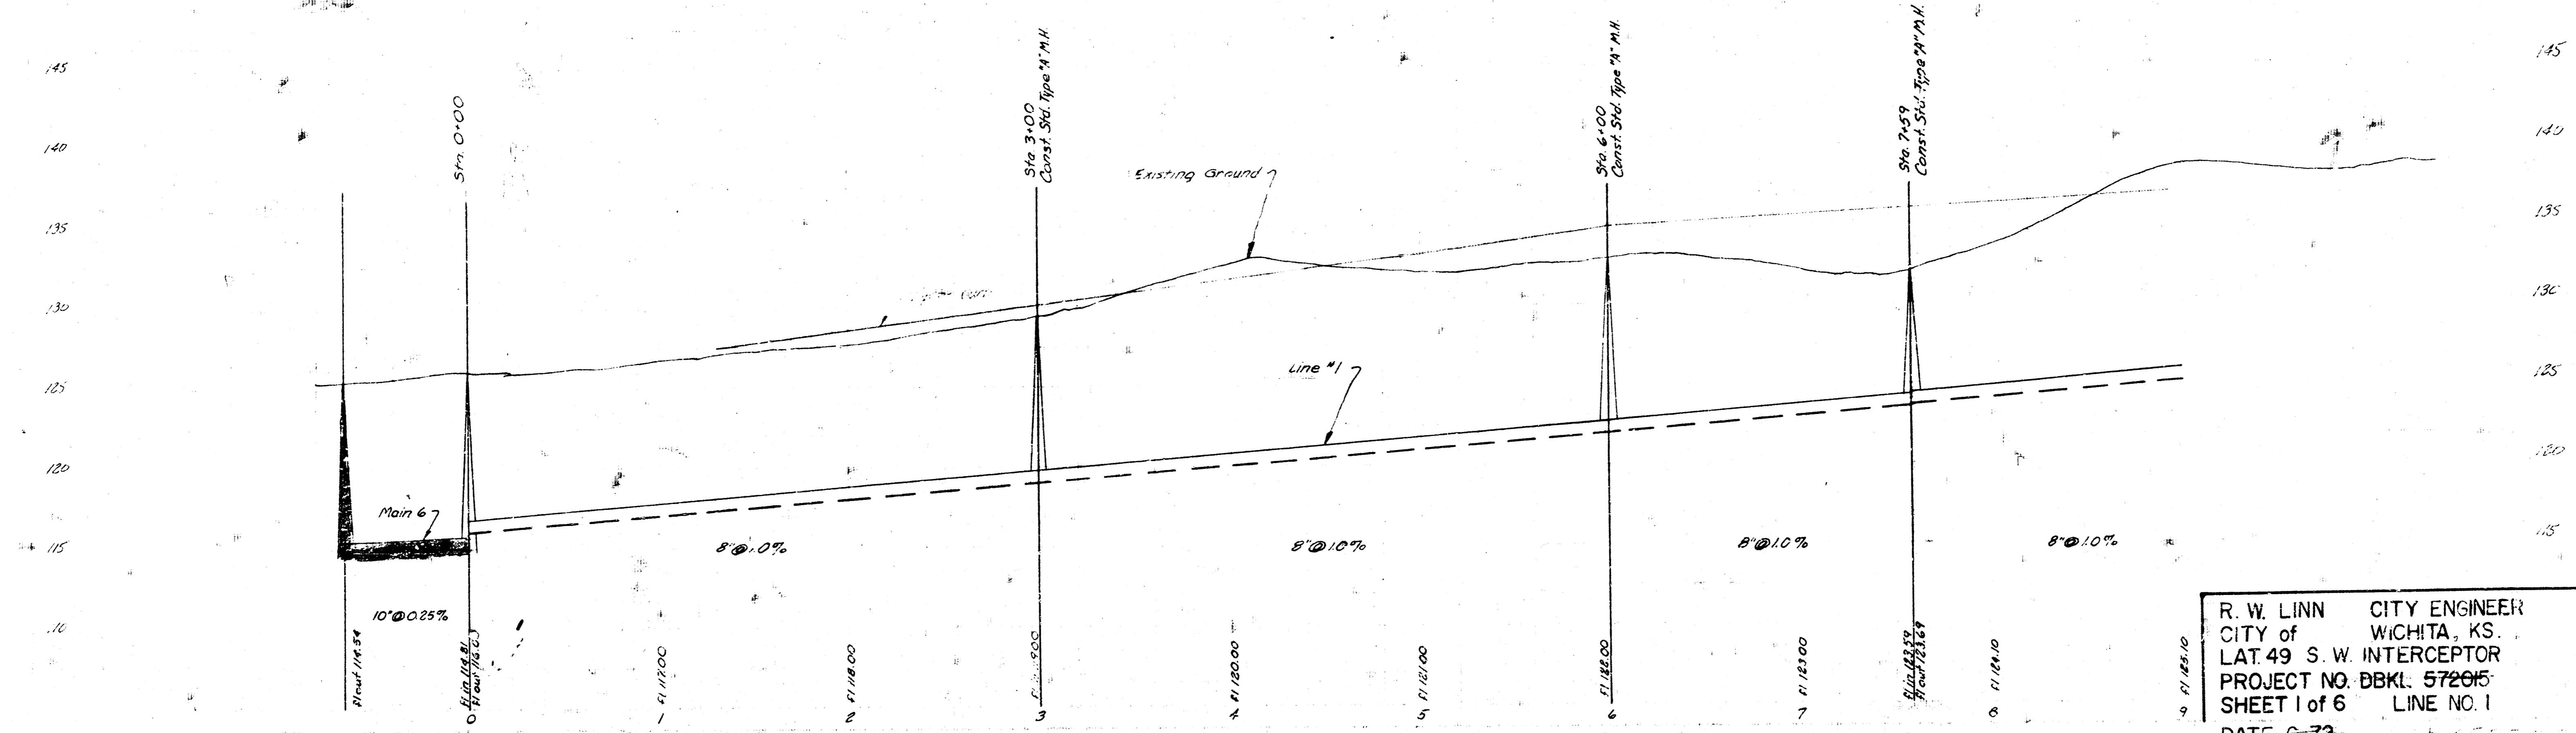


R. W. LINN CITY ENGINEER
CITY of WICHITA, KS.
LAT. 49 S. W. INTERCEPTOR
PROJECT NO. DBKL 57205
SHEET 1 of 6 LINE NO. 1
DATE 6-72



9-72

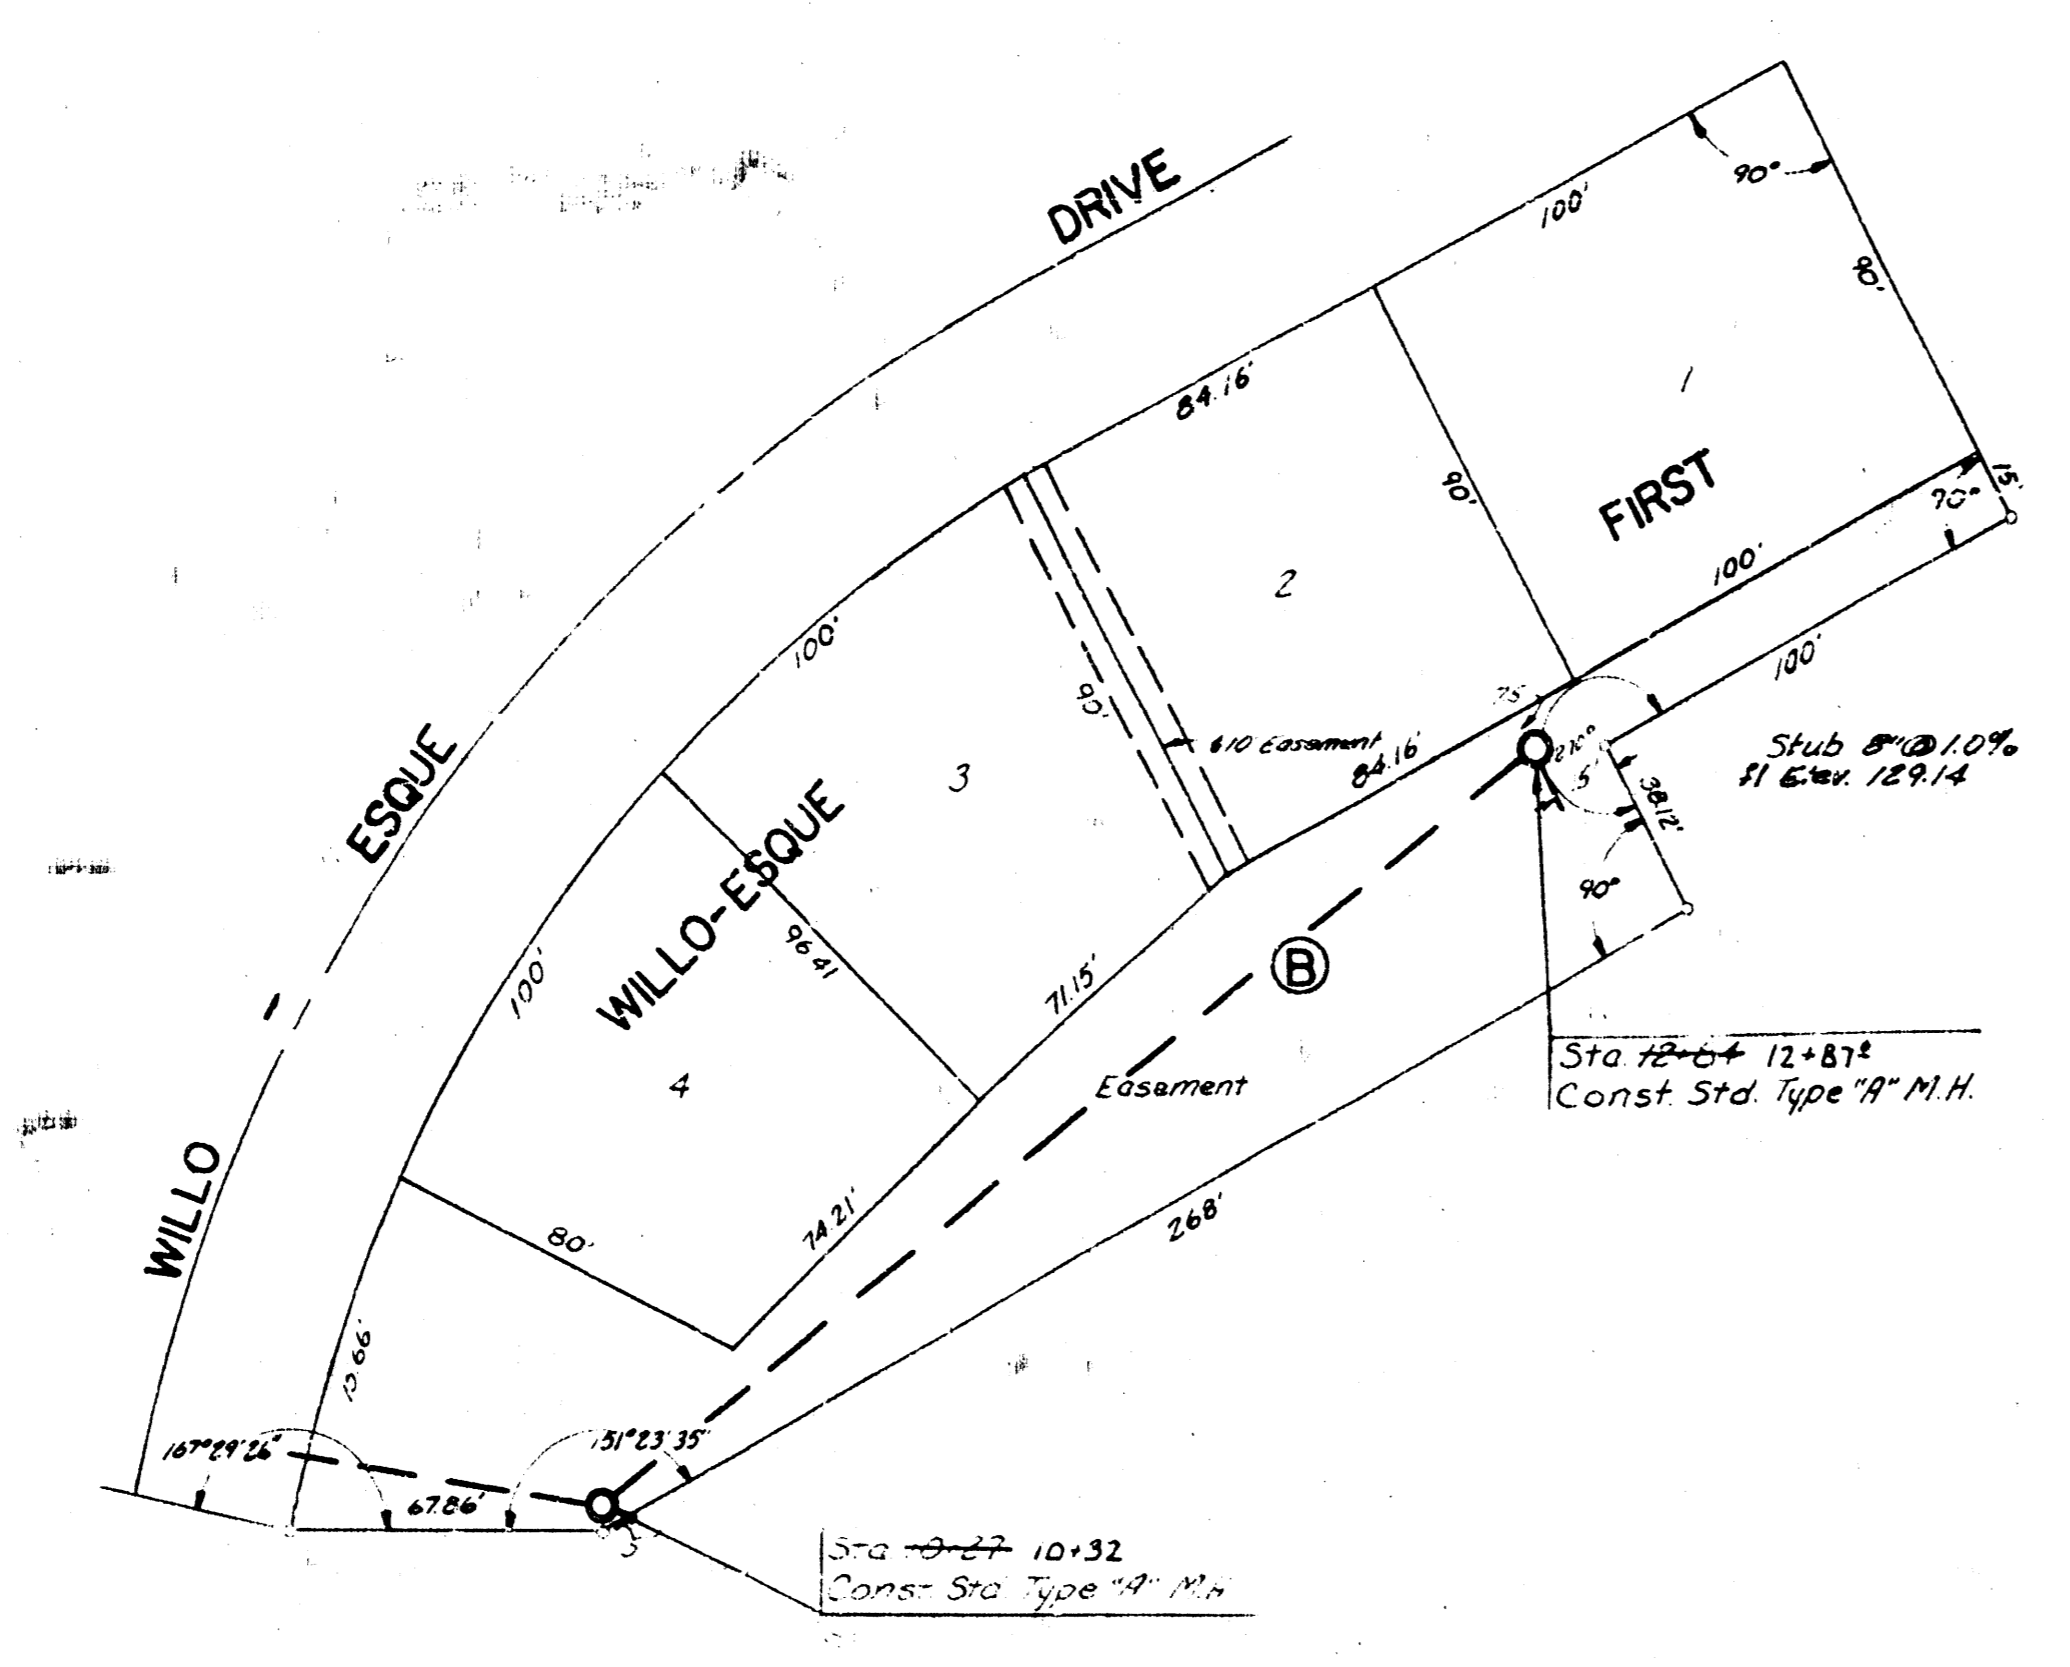


Plan Scale 1"=40'
Profile Scale 1"=4'
1/2"=1.5'

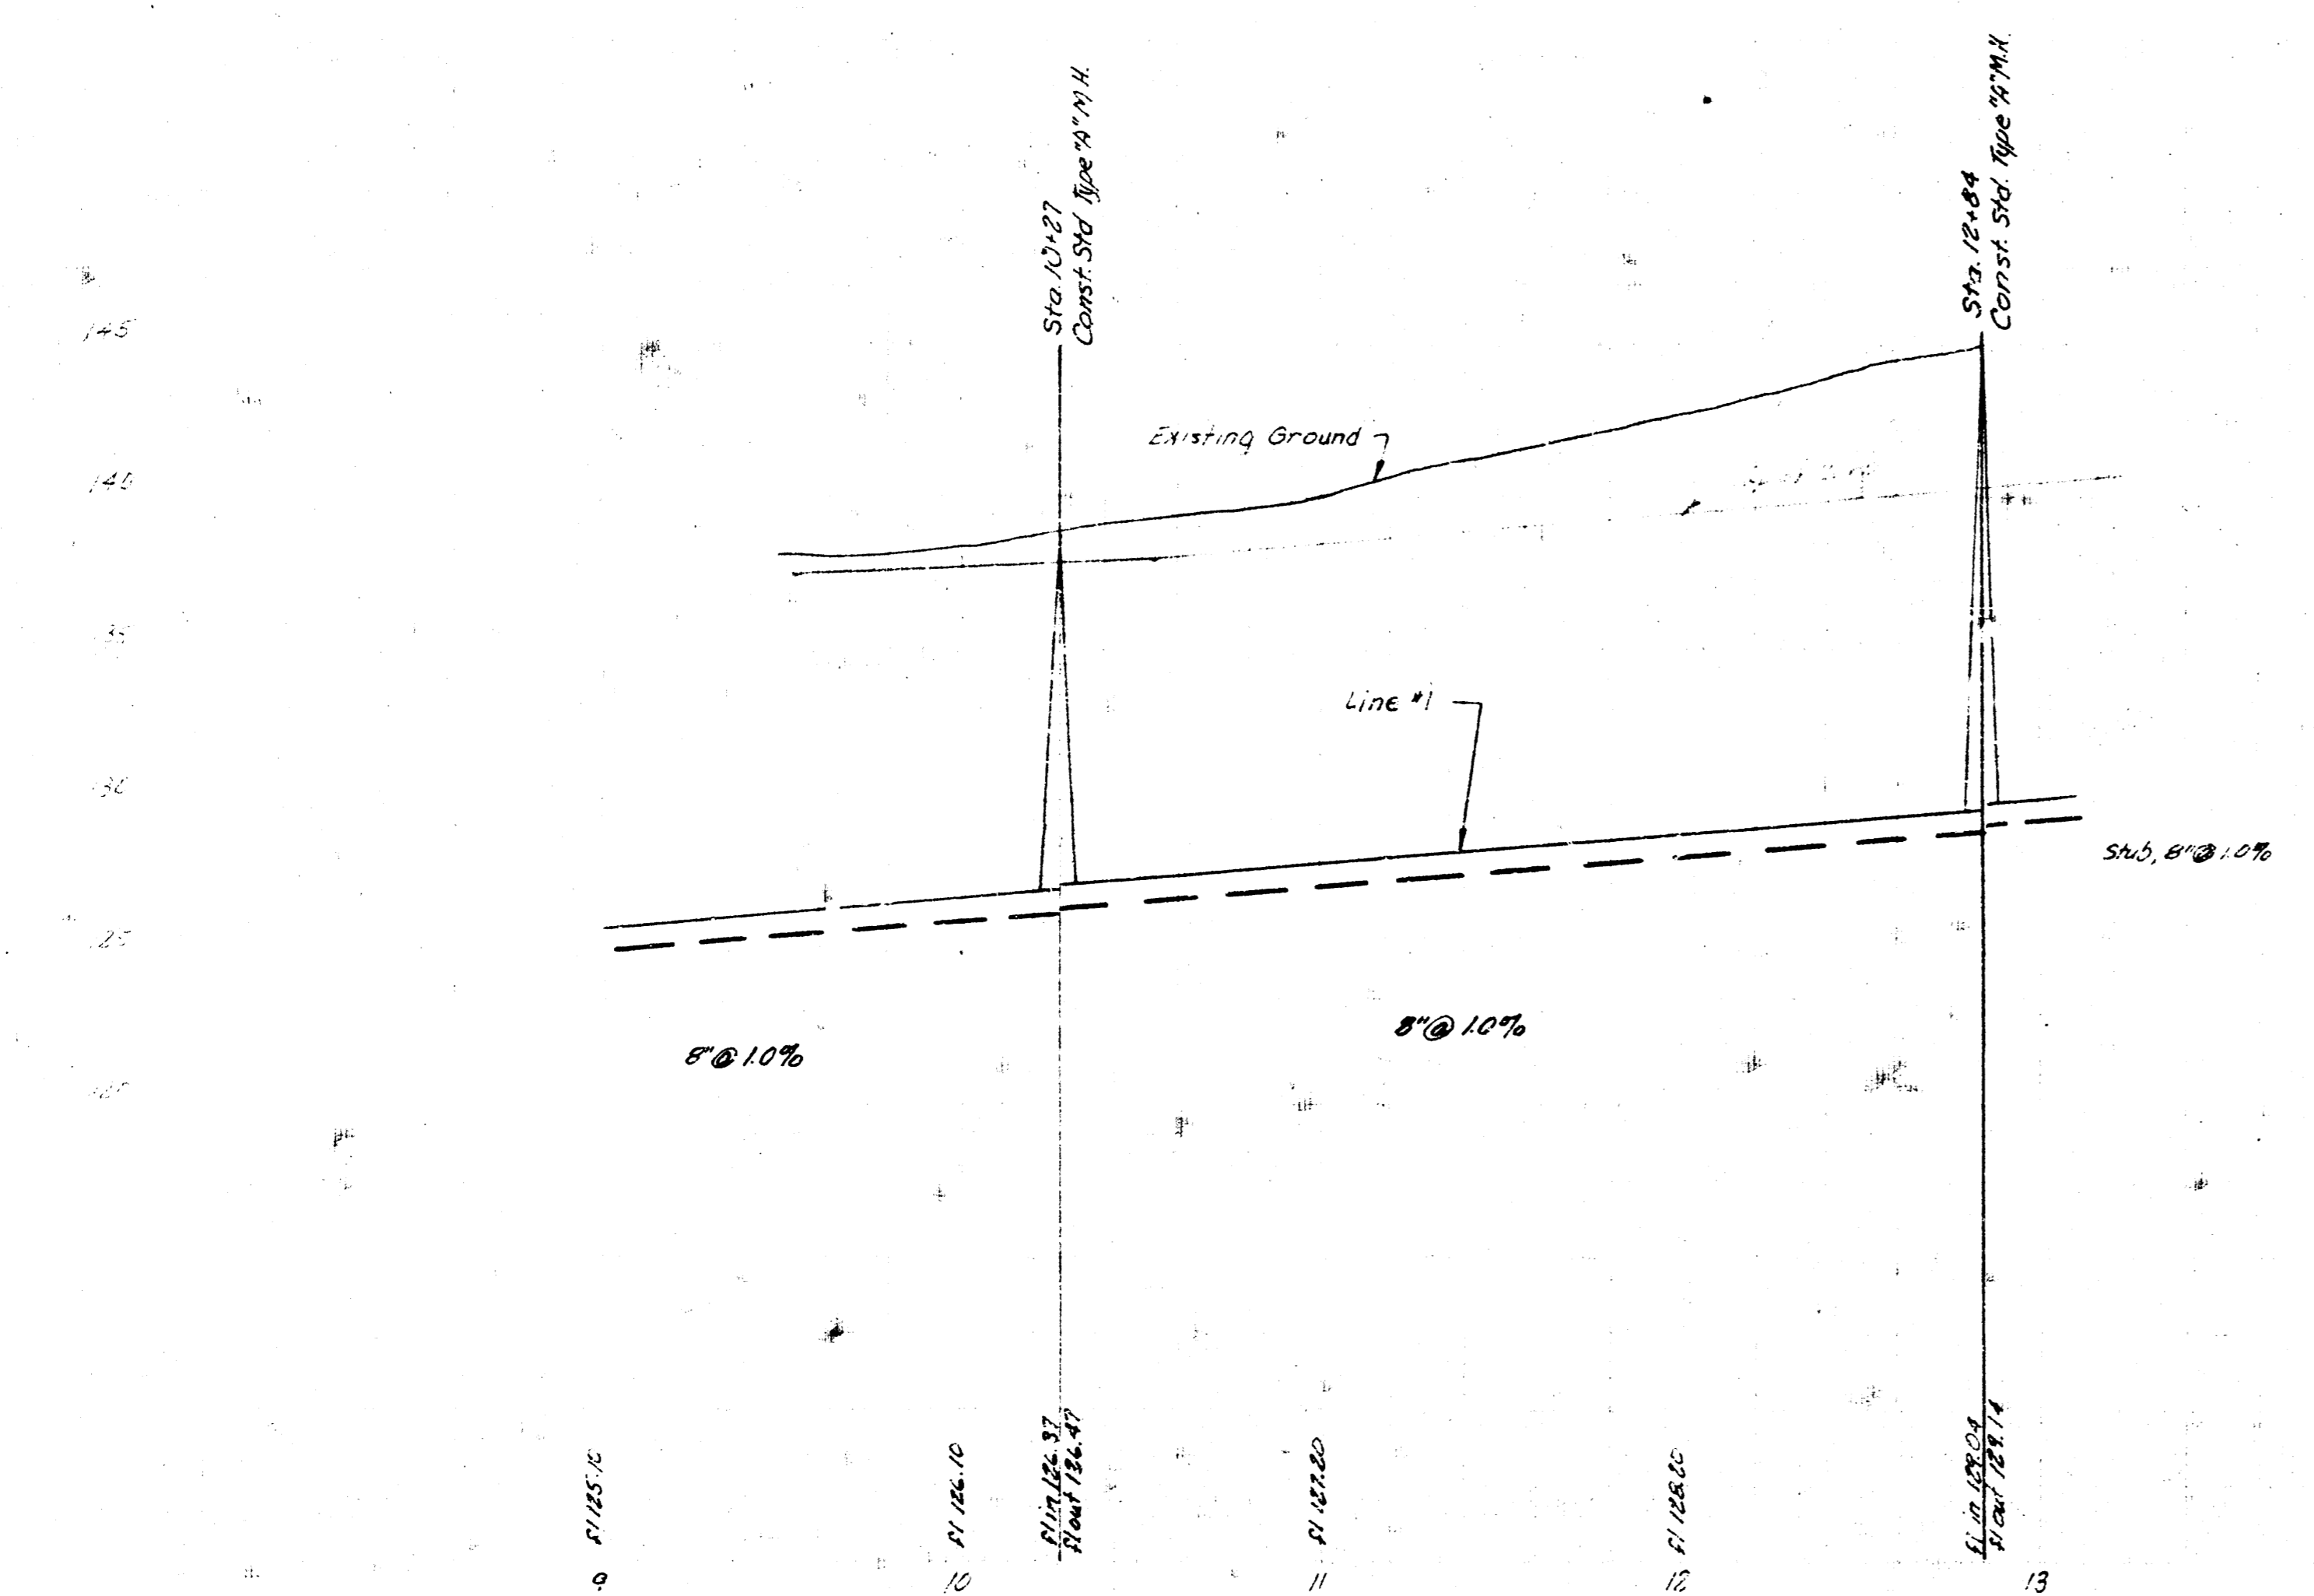

LAT. 49, S. W. INTERCEPTOR
 PROJ. NO. - BOKL572015
 SHEET 2 of 6 LINE NO. 1

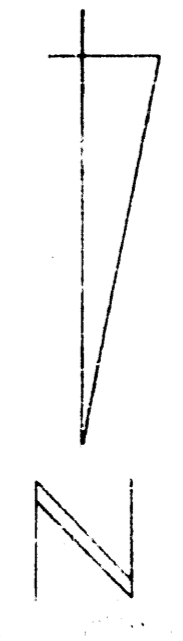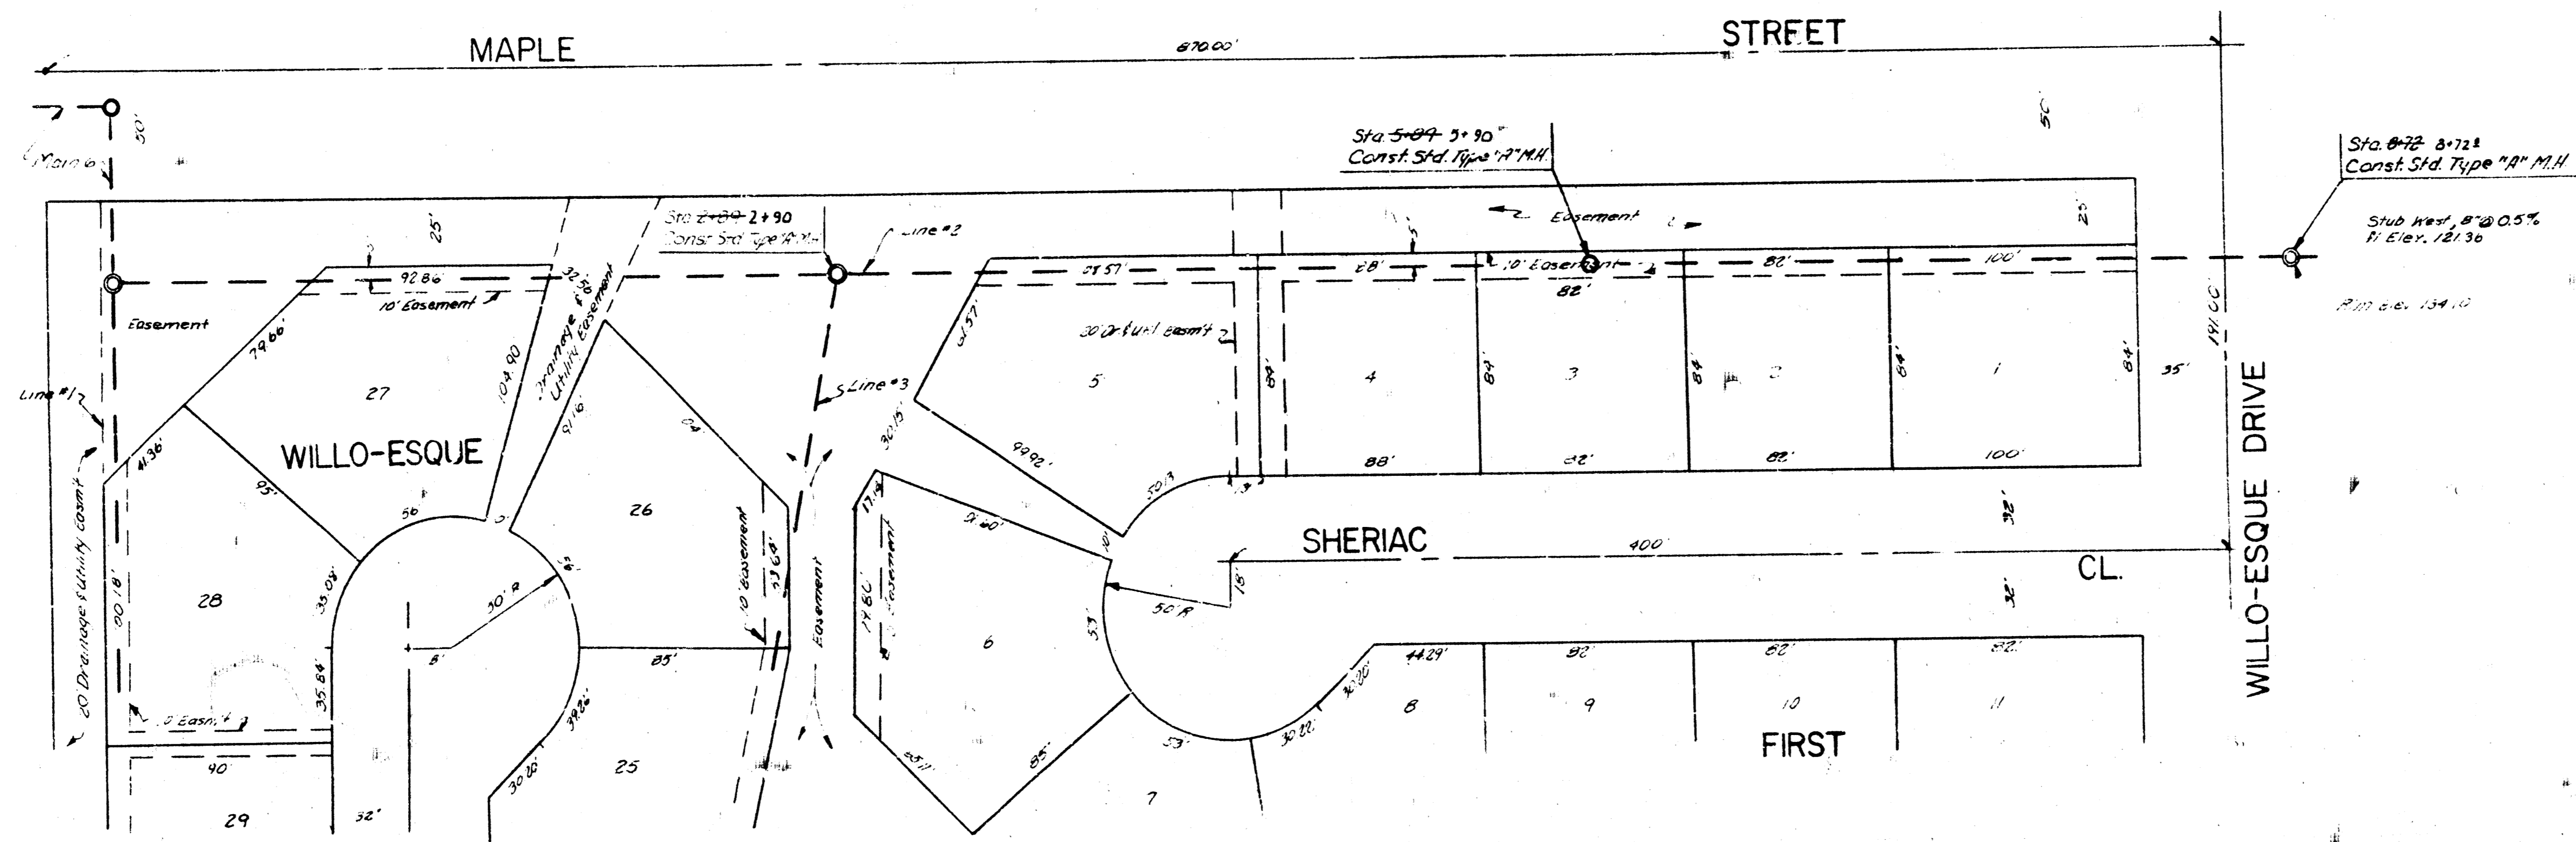


Plan Scale 1"=40'
 Prof. Scale 1"=5'

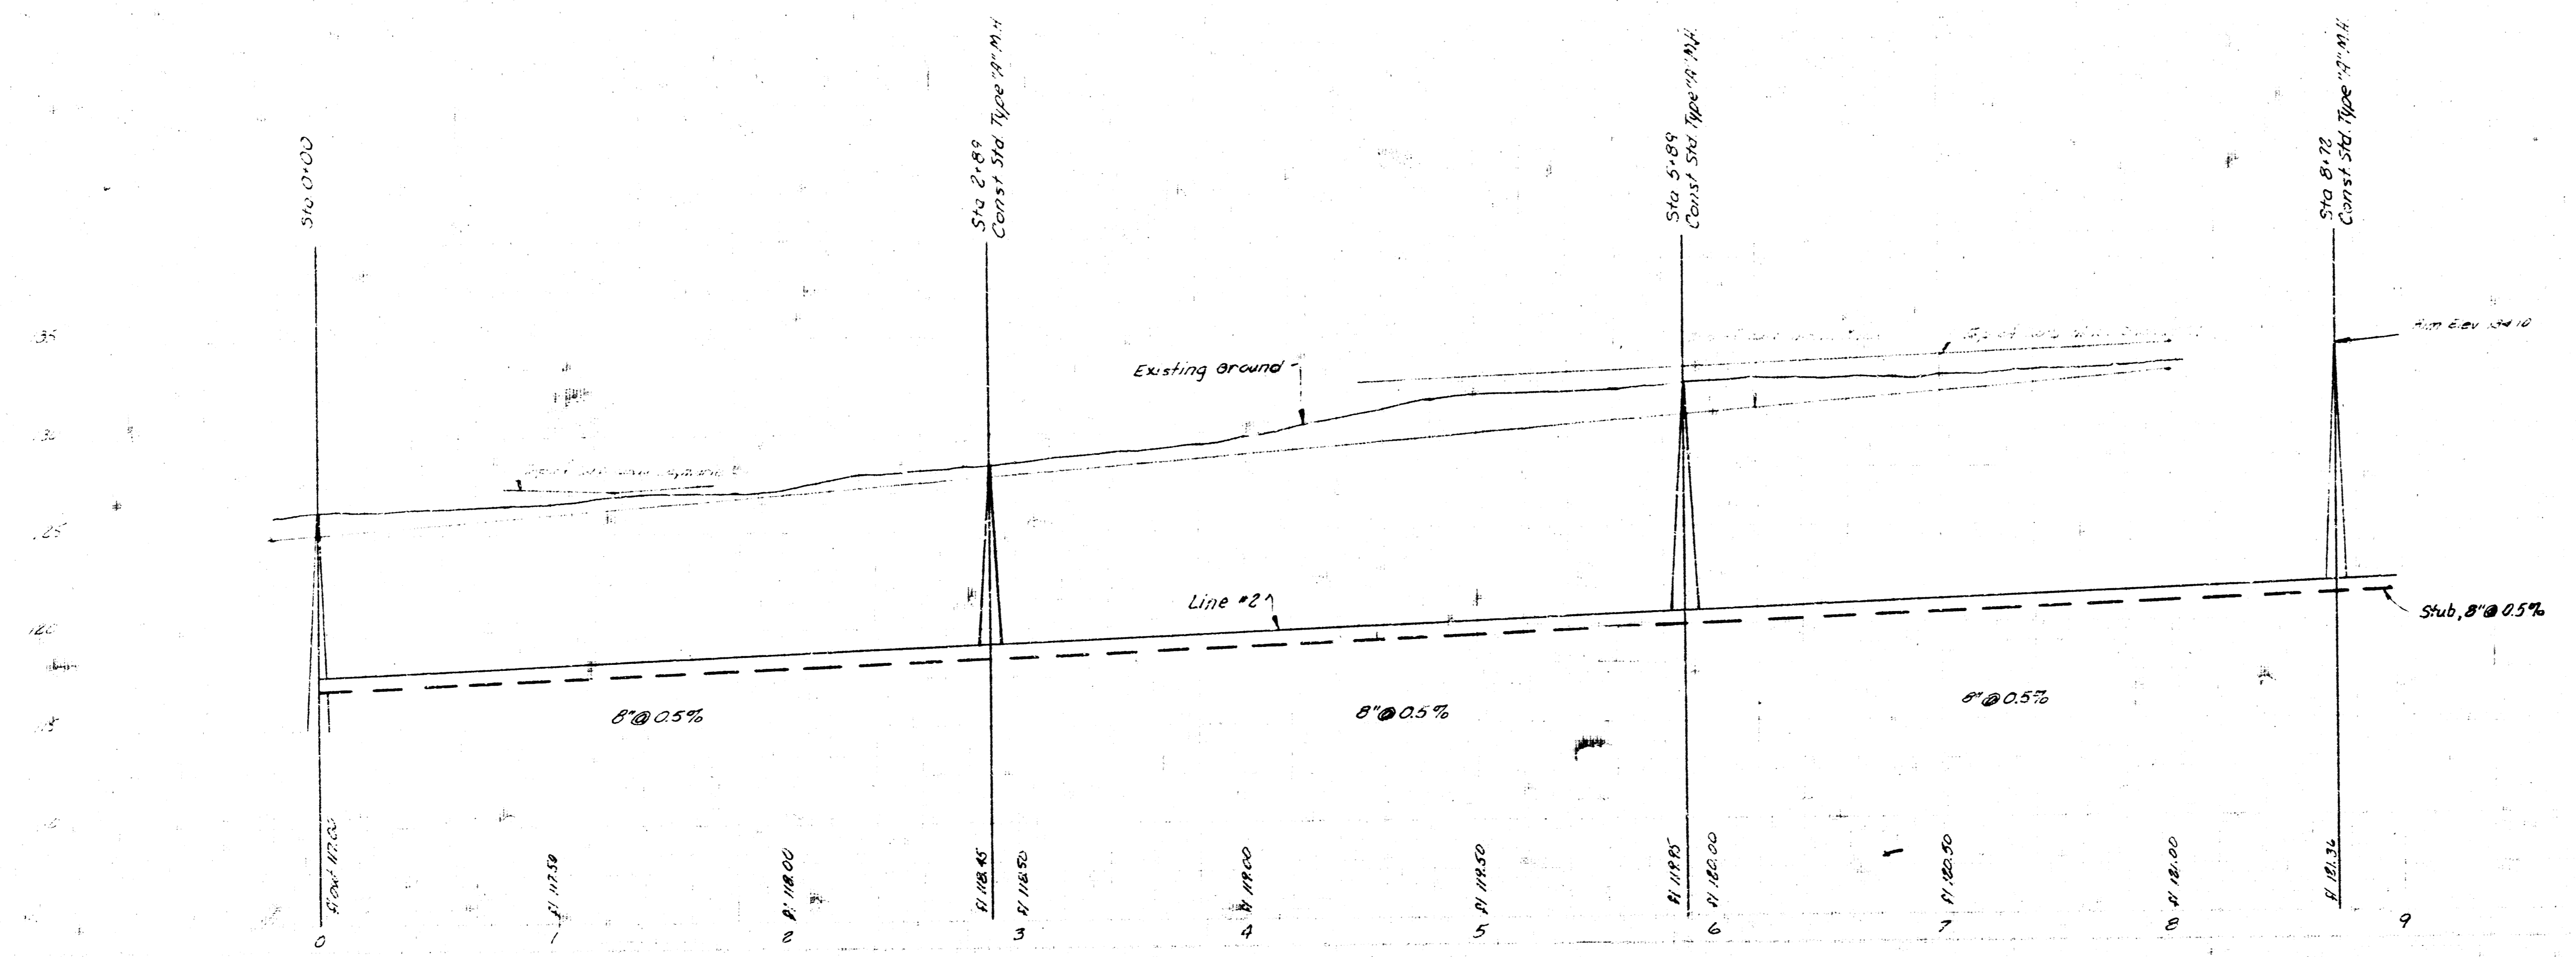


LAT. 49 S.W. INTERCEPTOR
 PROJ. NO. DBK 57205
 SHEET 3 of 6 LINE NO. 2

B.M. 12581 RR spike N side power pole S side Maple 100 E. of F.L. Ceymarie


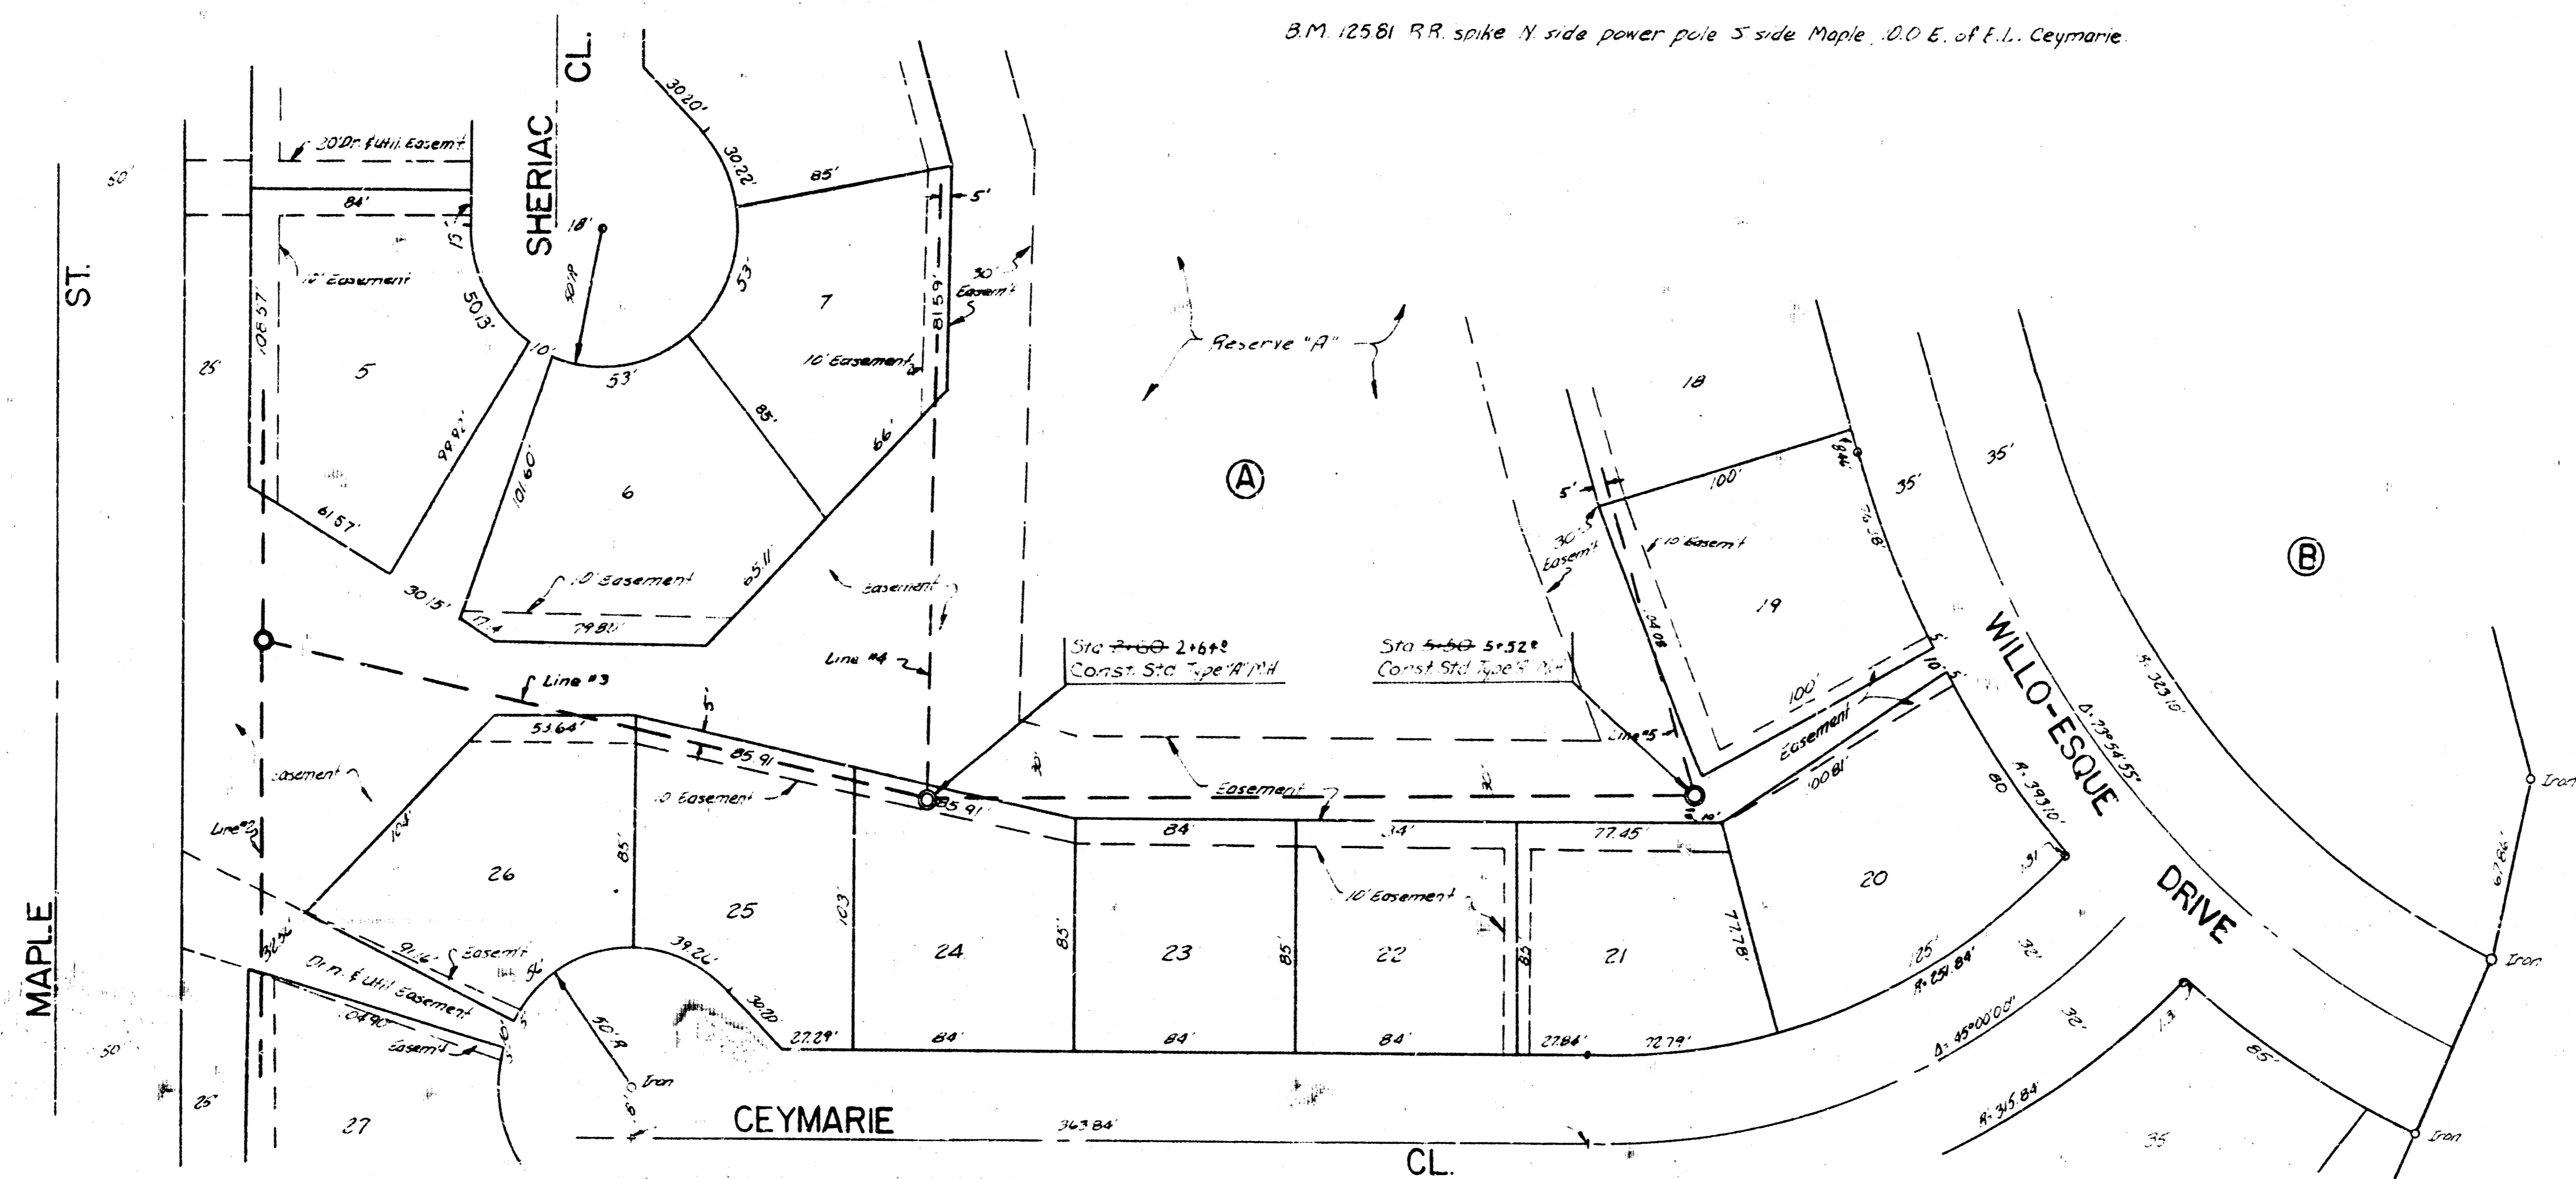


Plan Scale 1" = 40'
Profile Scale 1" = 10'

140
135
130
125
120
115

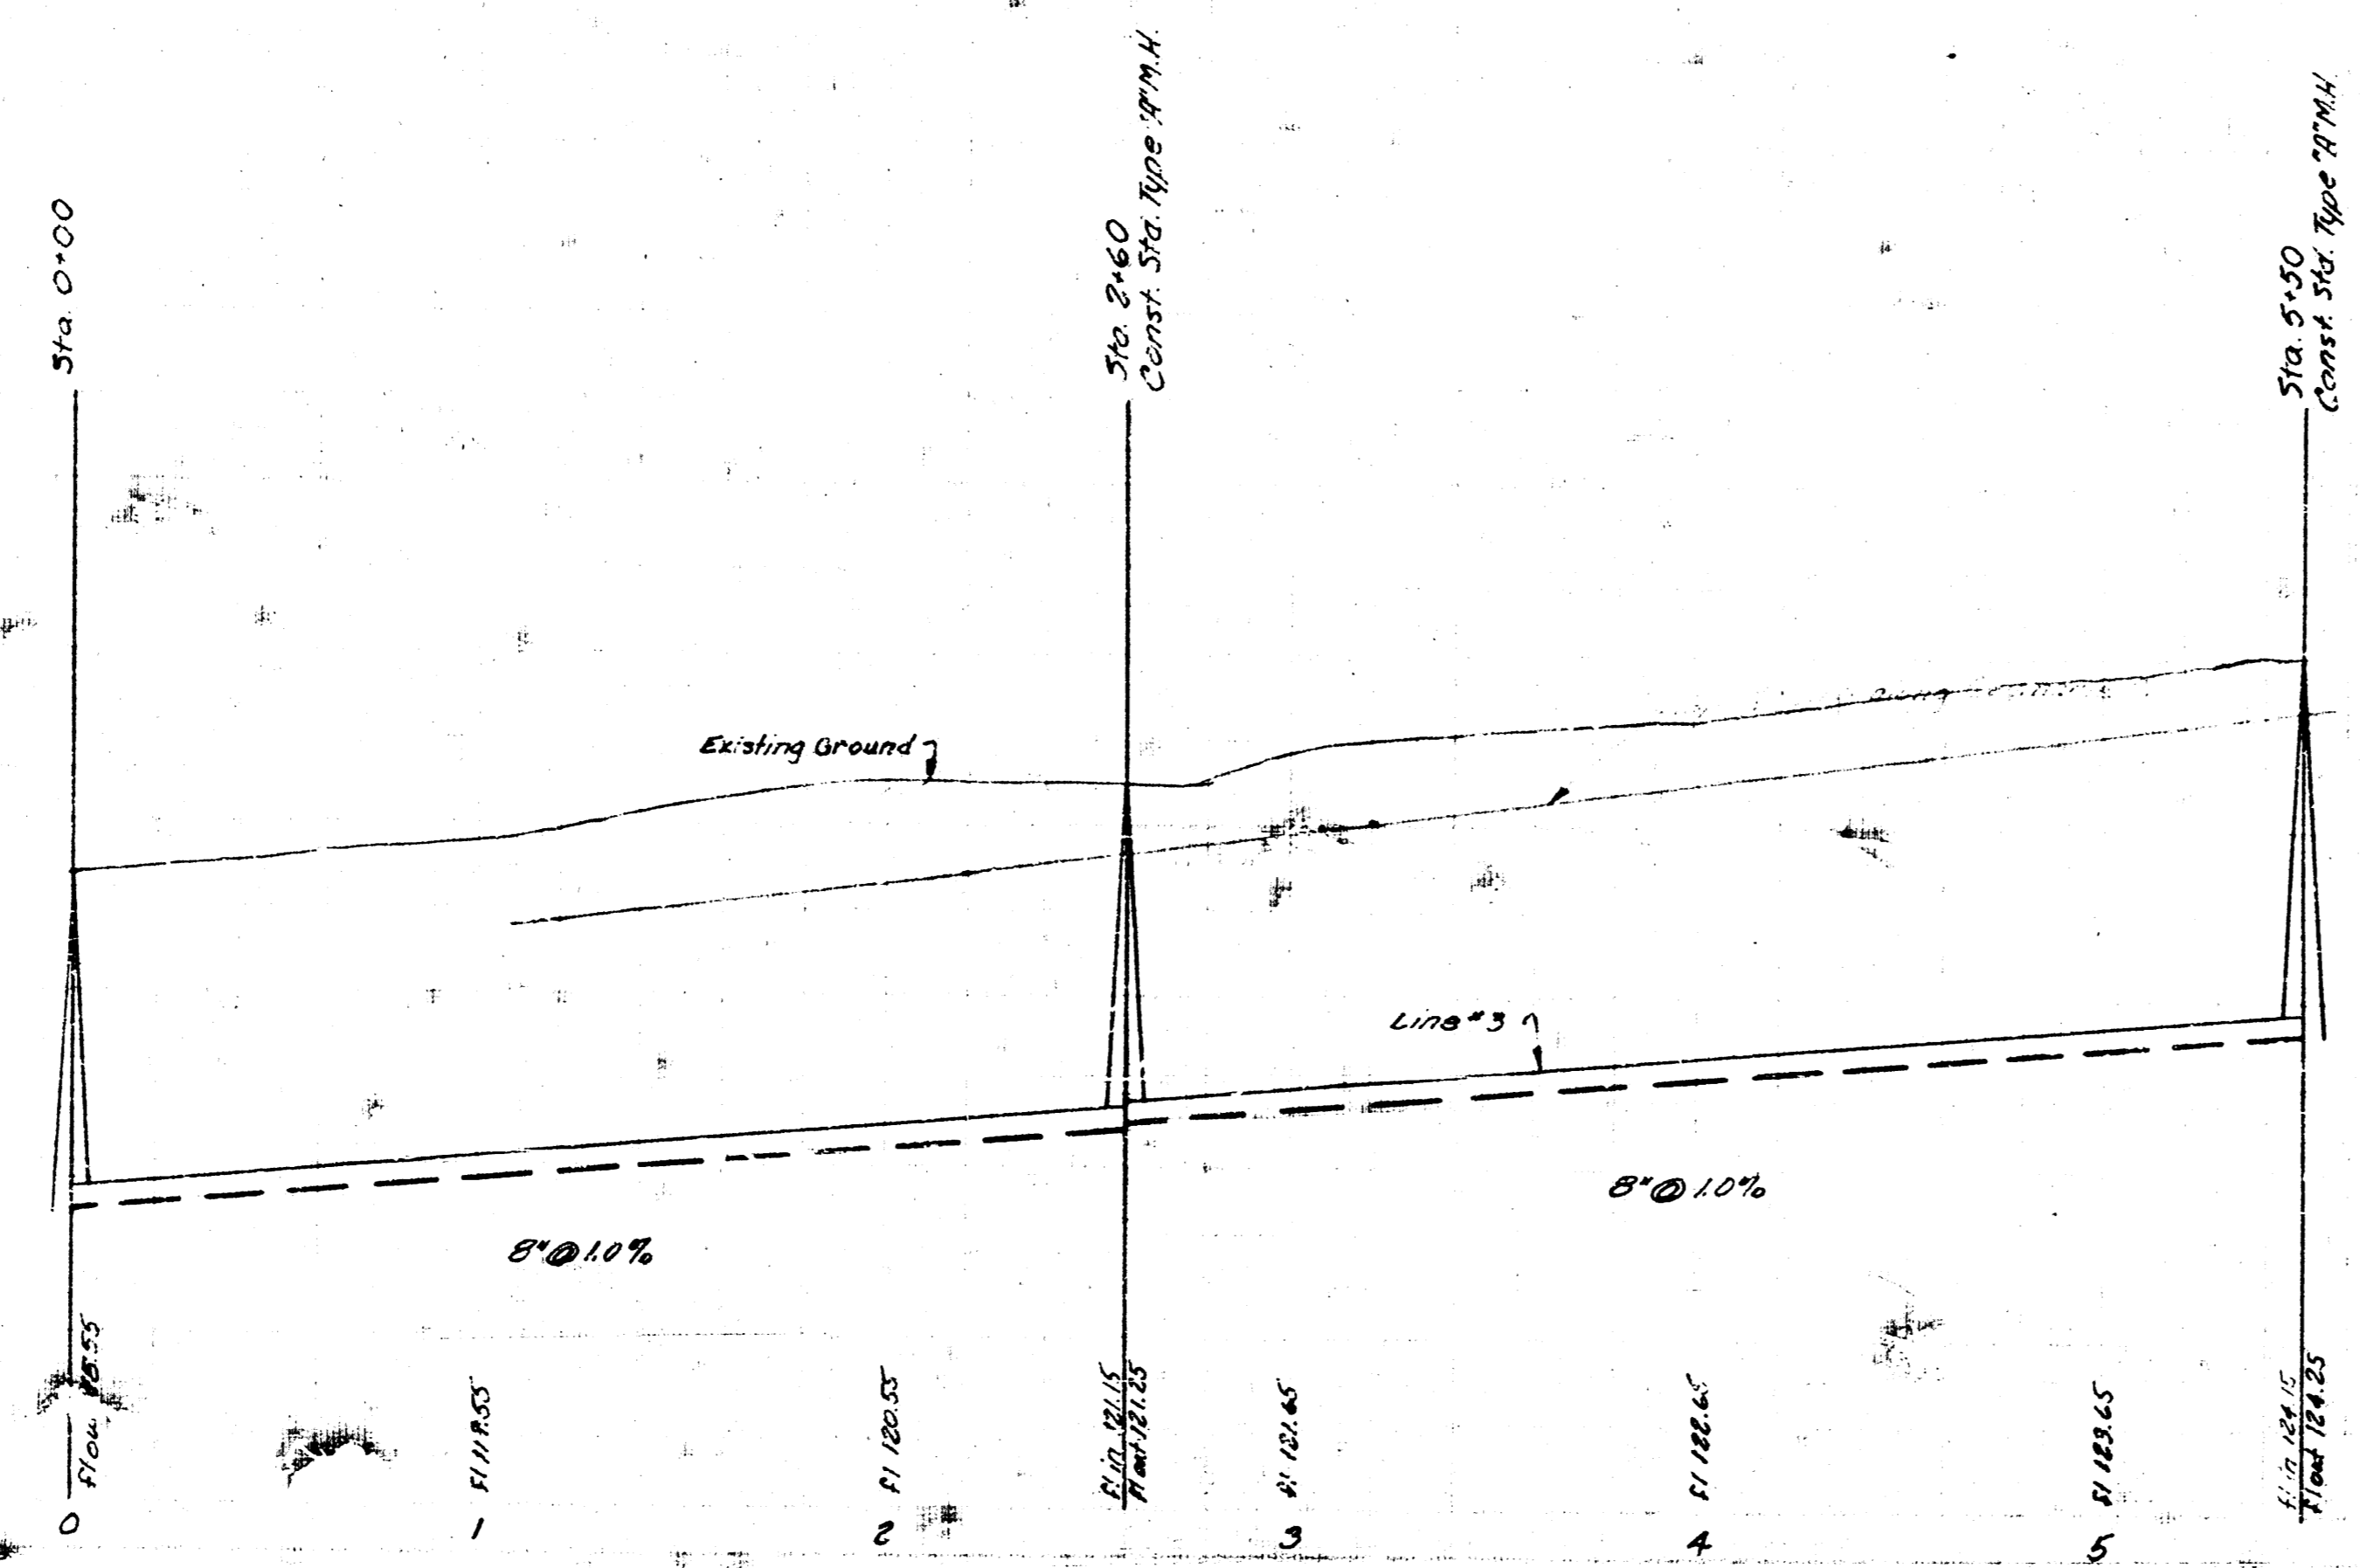


LAT 49 S.W. INTERCEPTOR
PROJ. NO. ~~DDK1572015~~
SHEET 4 of 6 LINE NO.3

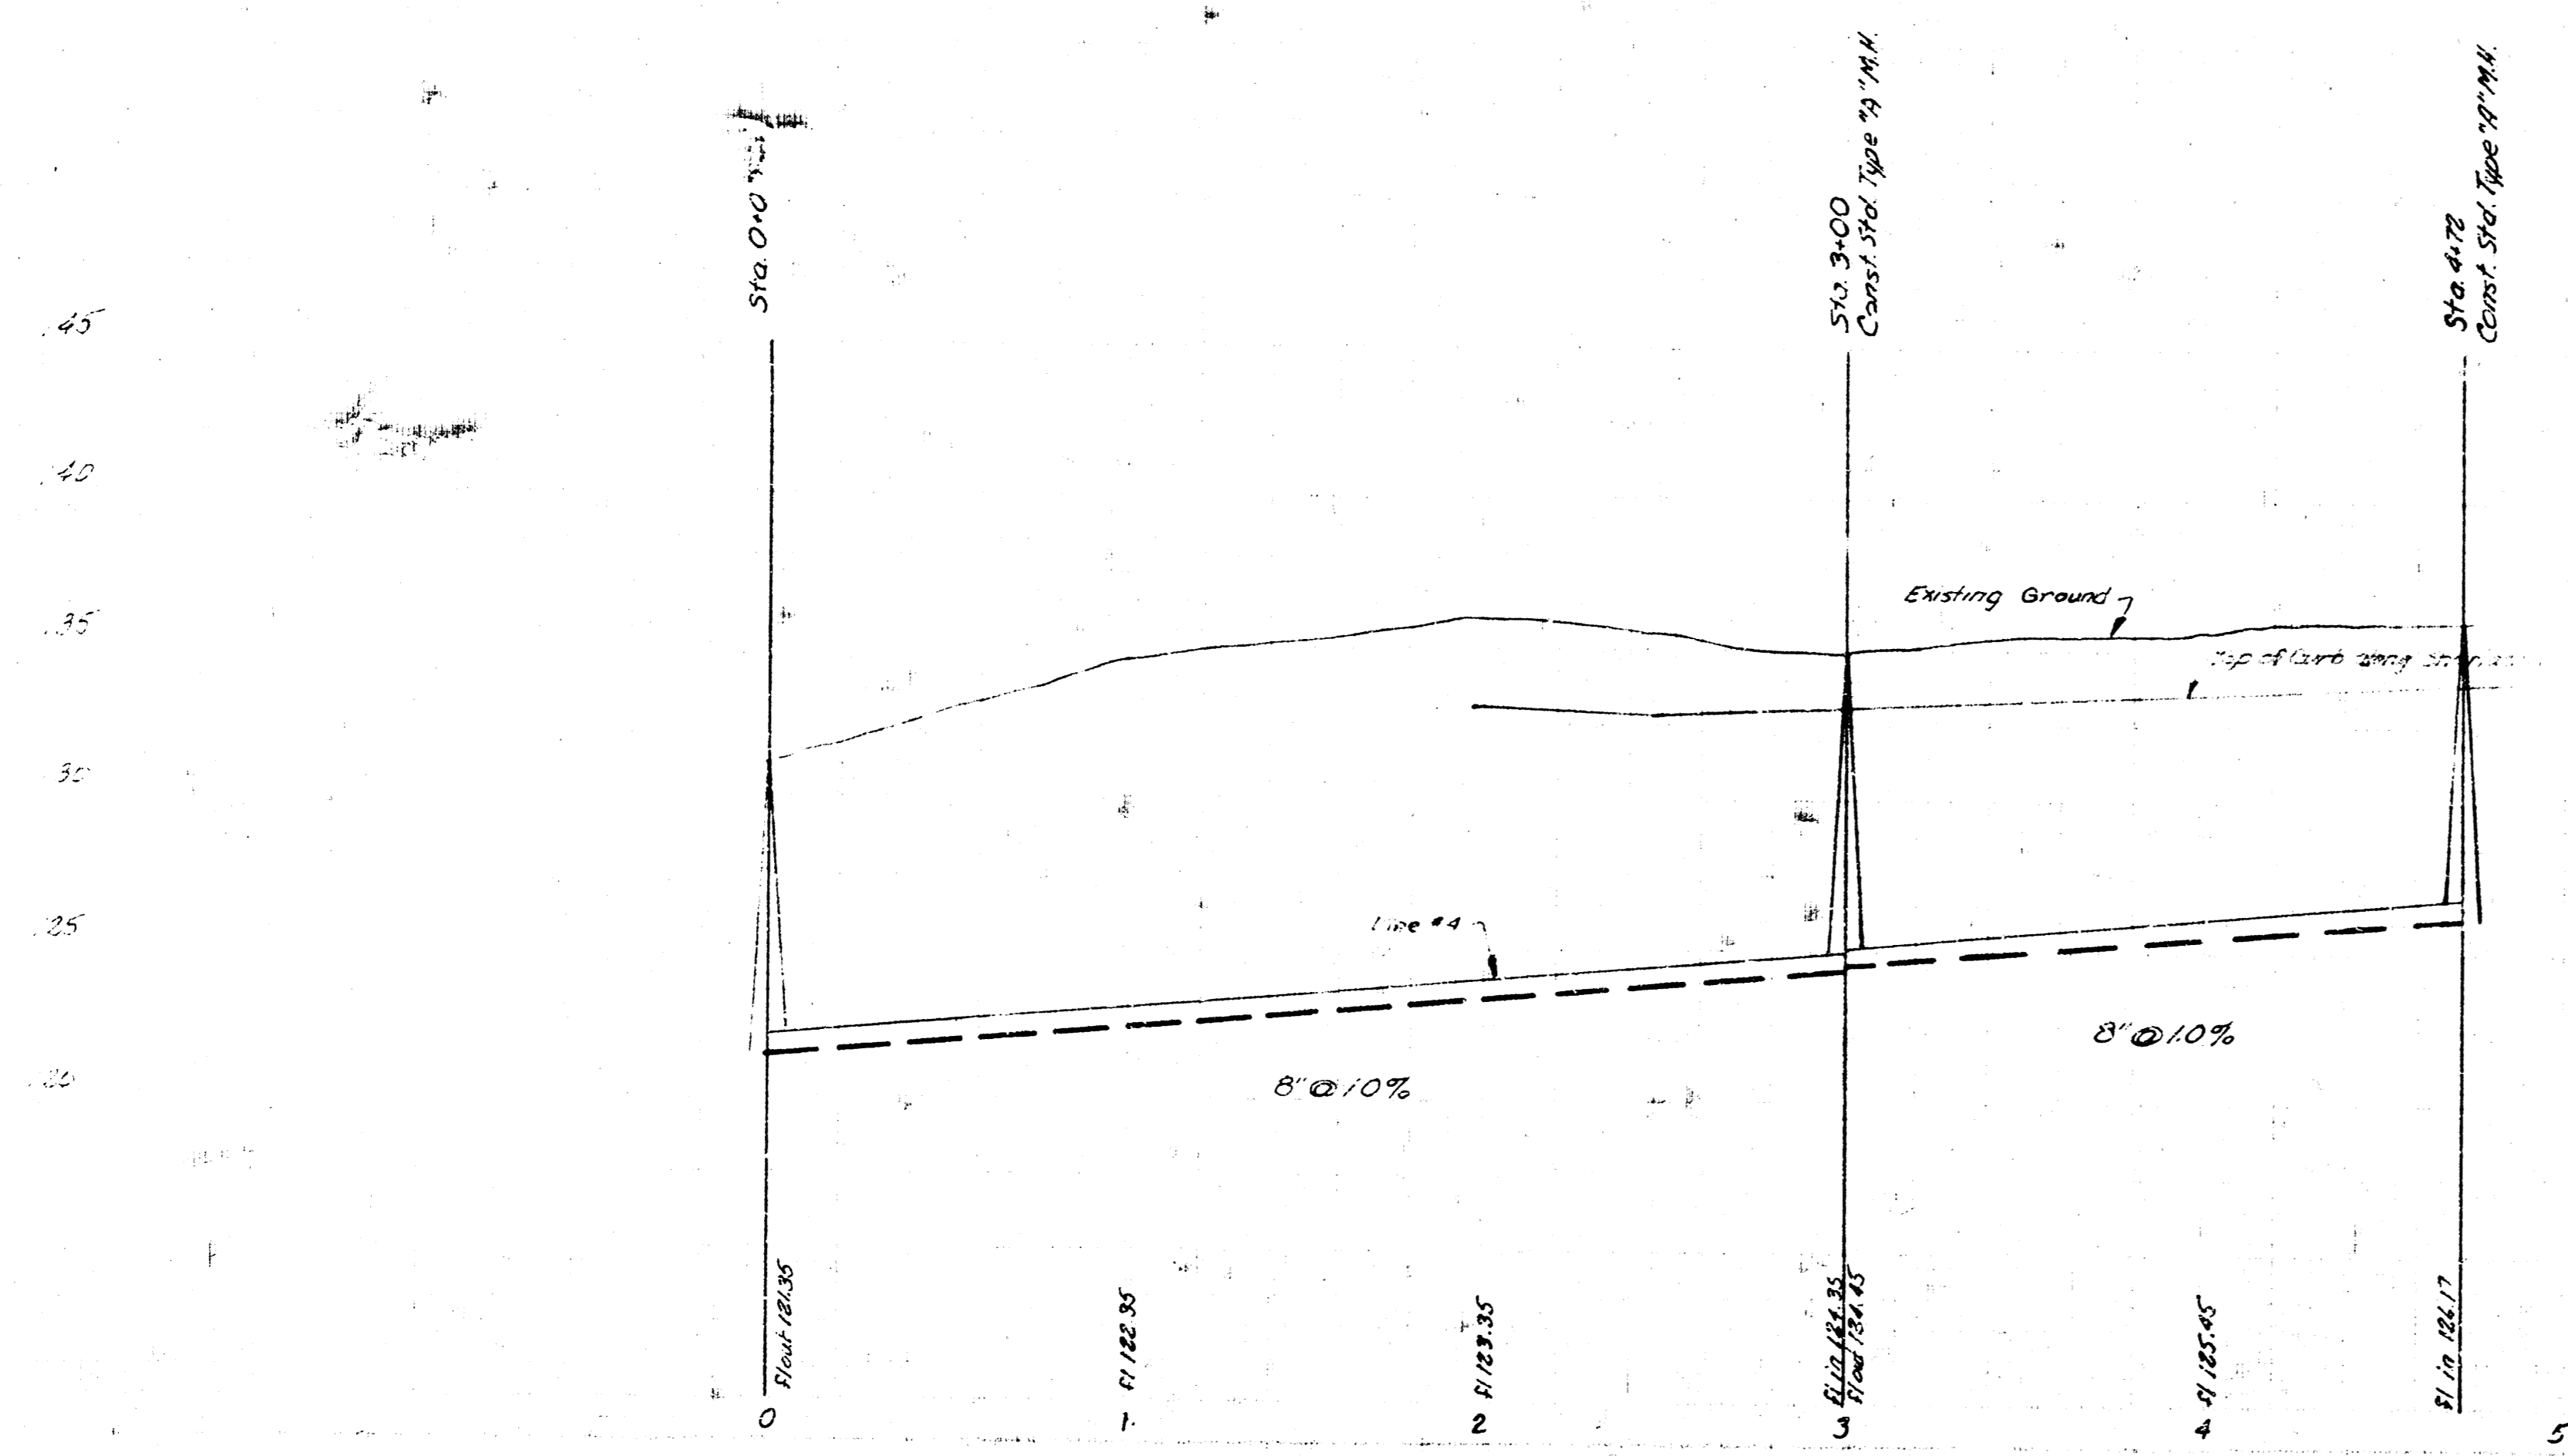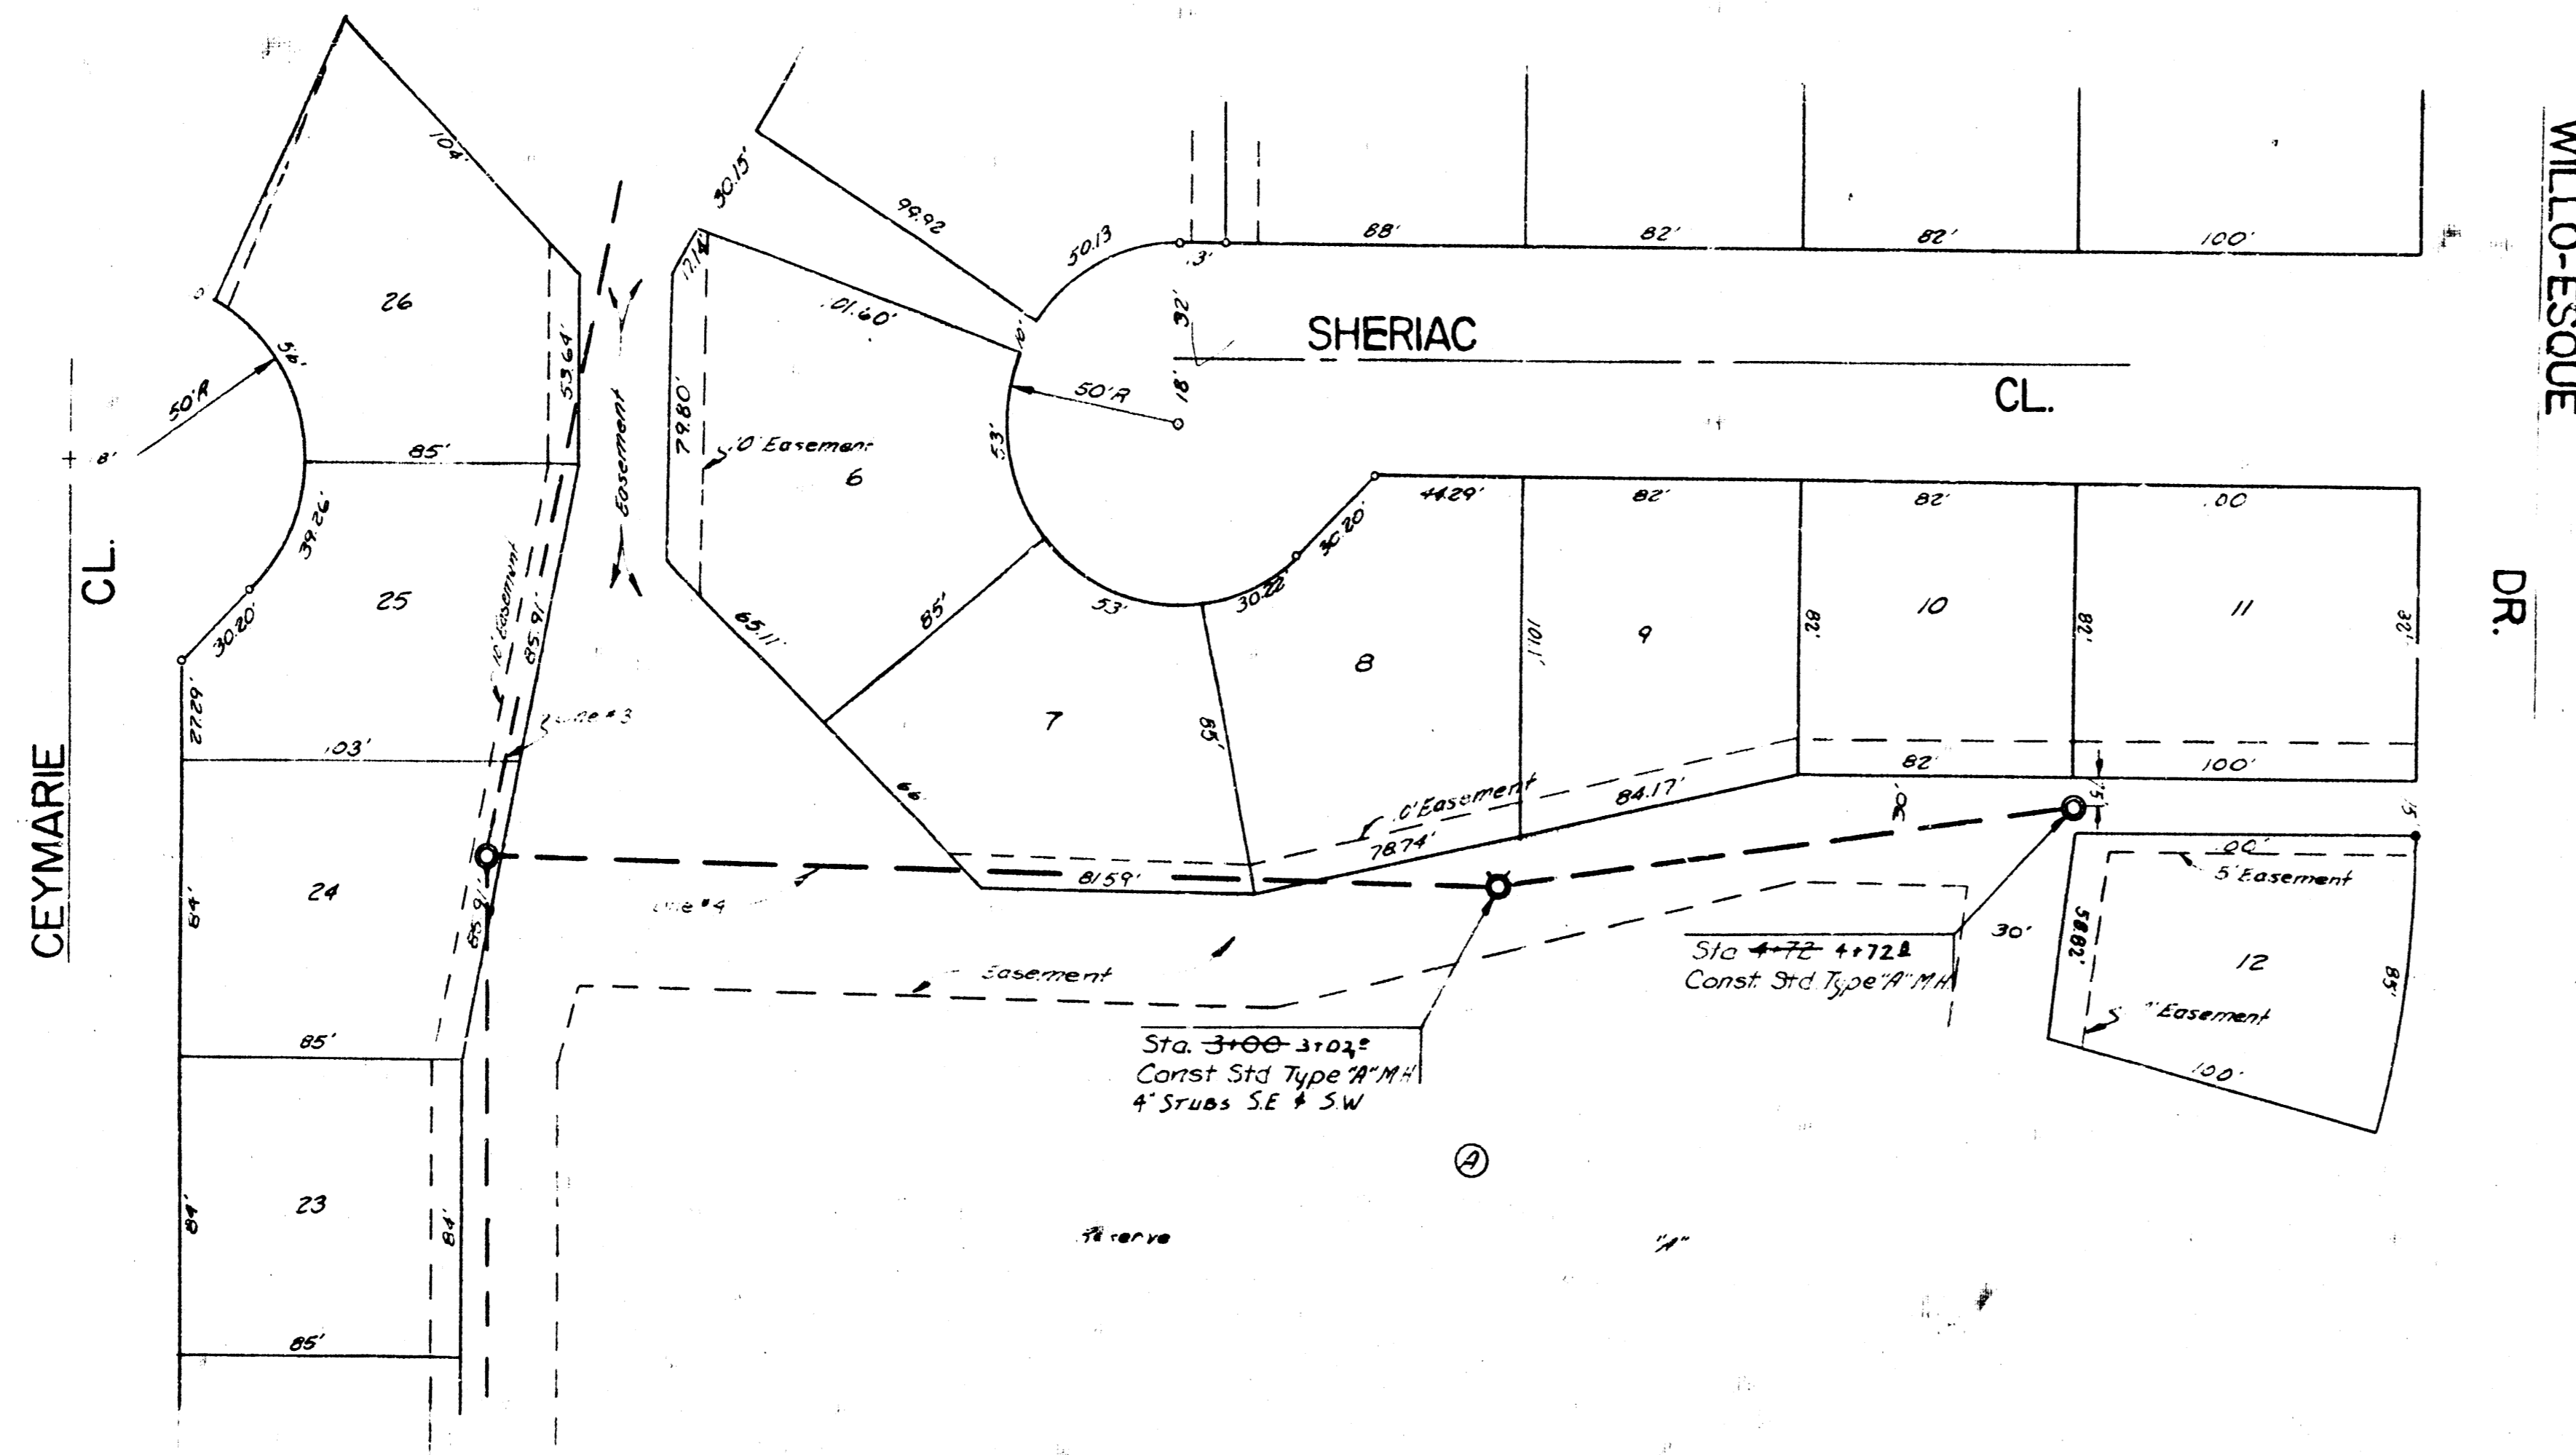


Plan Scale 1" = 40'
 Profile Scale Hor 1" = 40'
 Profile Scale Ver 1" = 5'

LAT. 49 S. W. INTERCEPTOR
 PROJECT NO. ~~00K1072013~~
 SHEET 5 of 6 LINE NO. 4

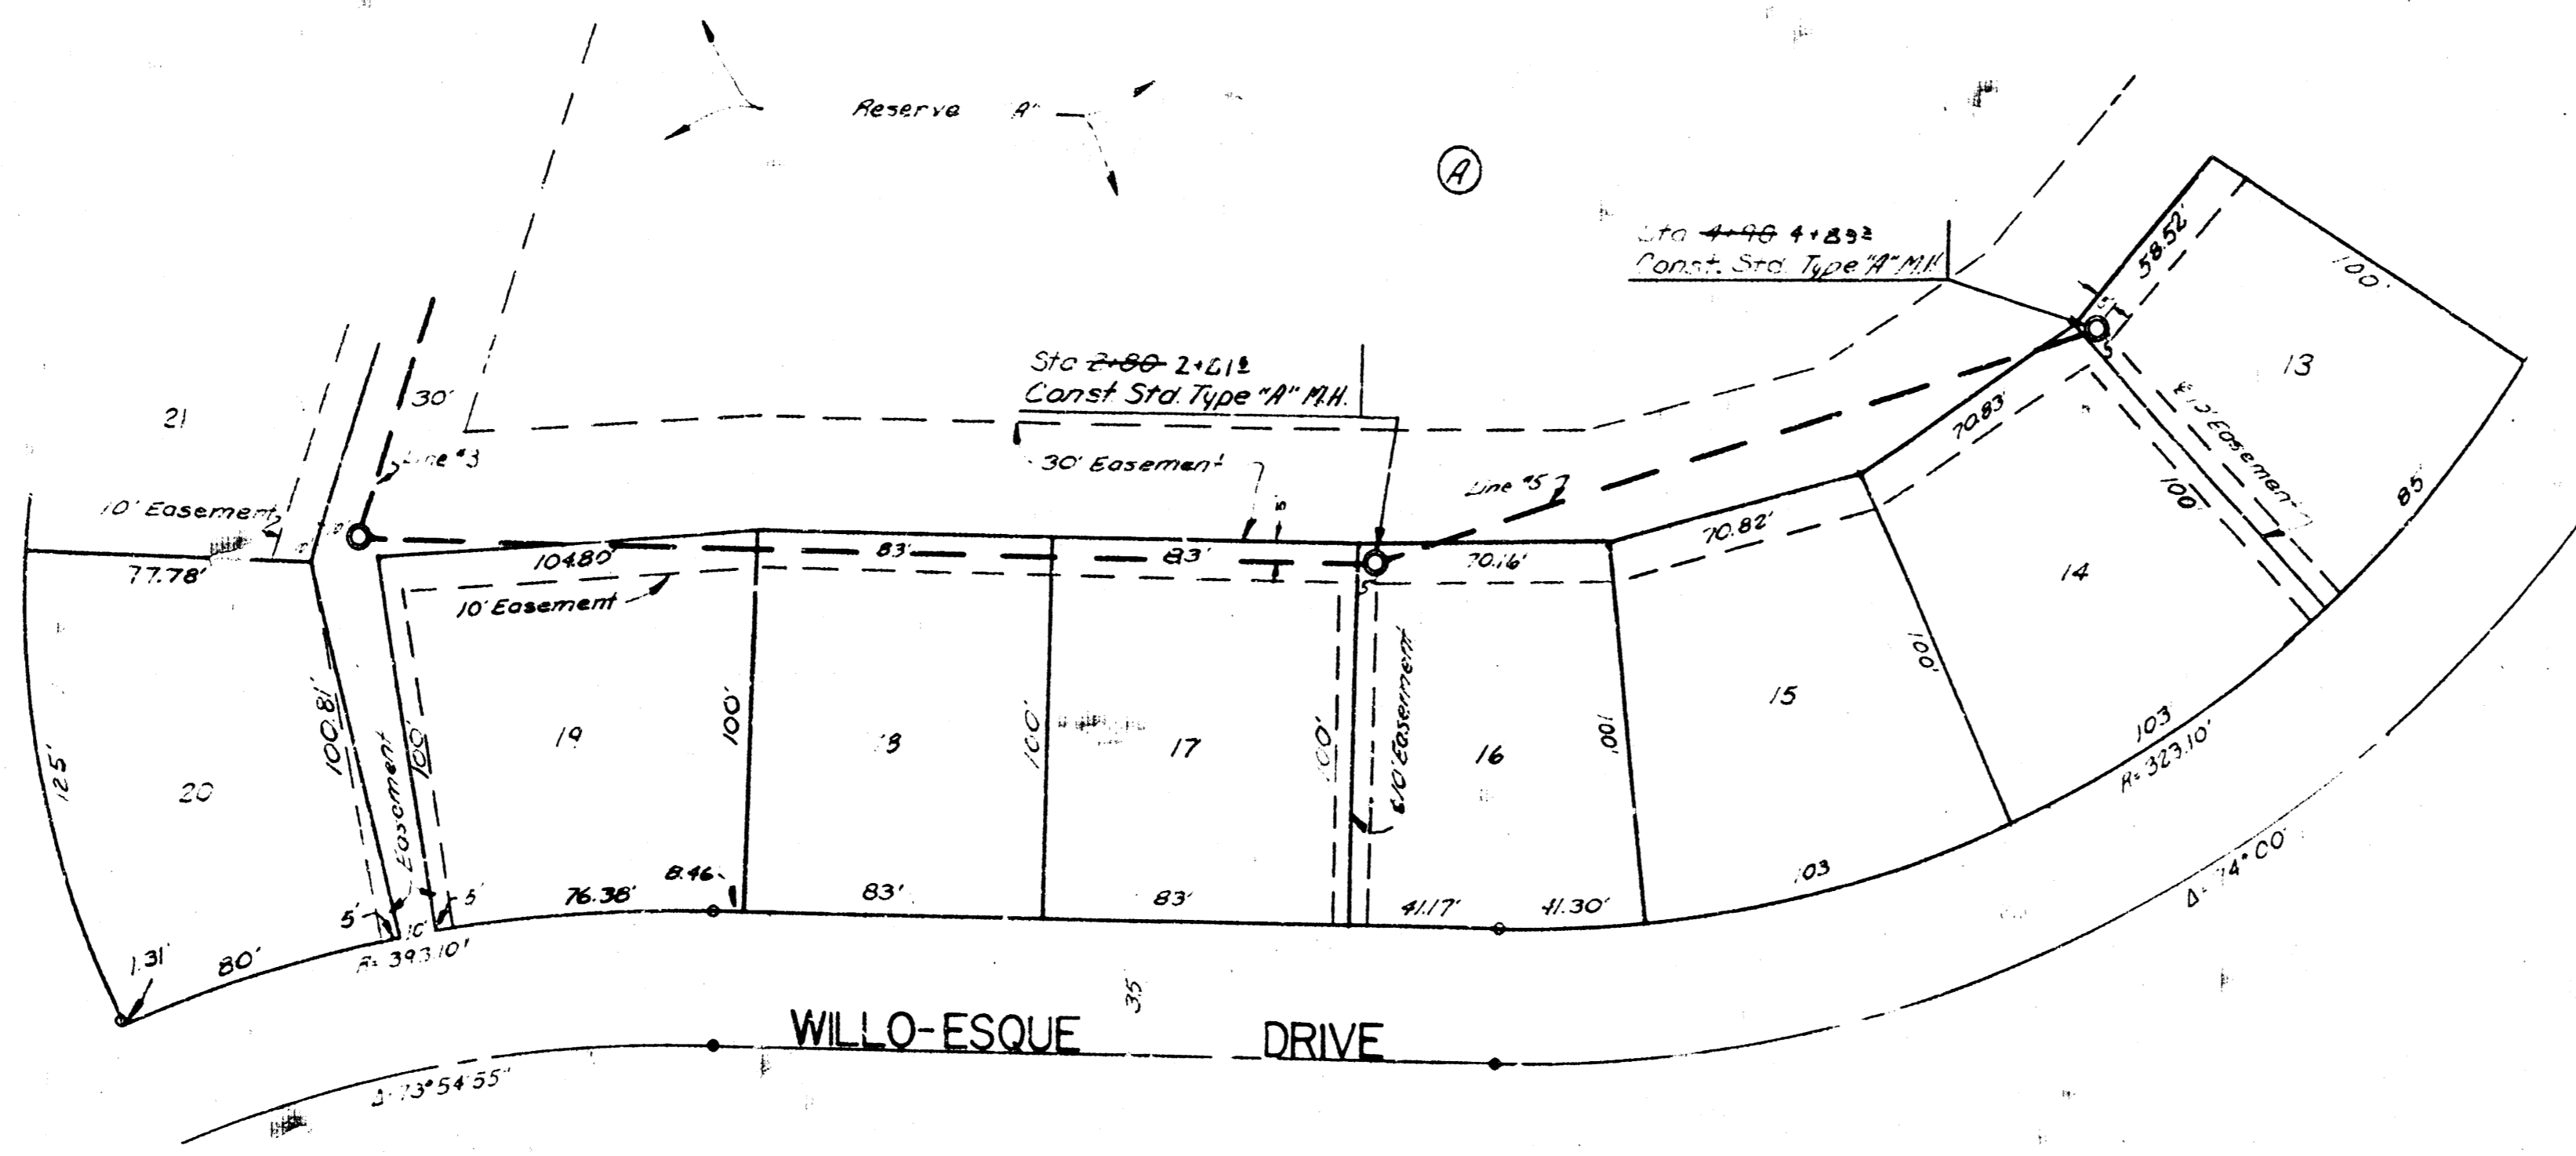

Plan Scale 1"=40'
 Profile Scale Hor. 1"=40'
 Profile Scale Ver. 1"=5'

120
125
130
135
140
145

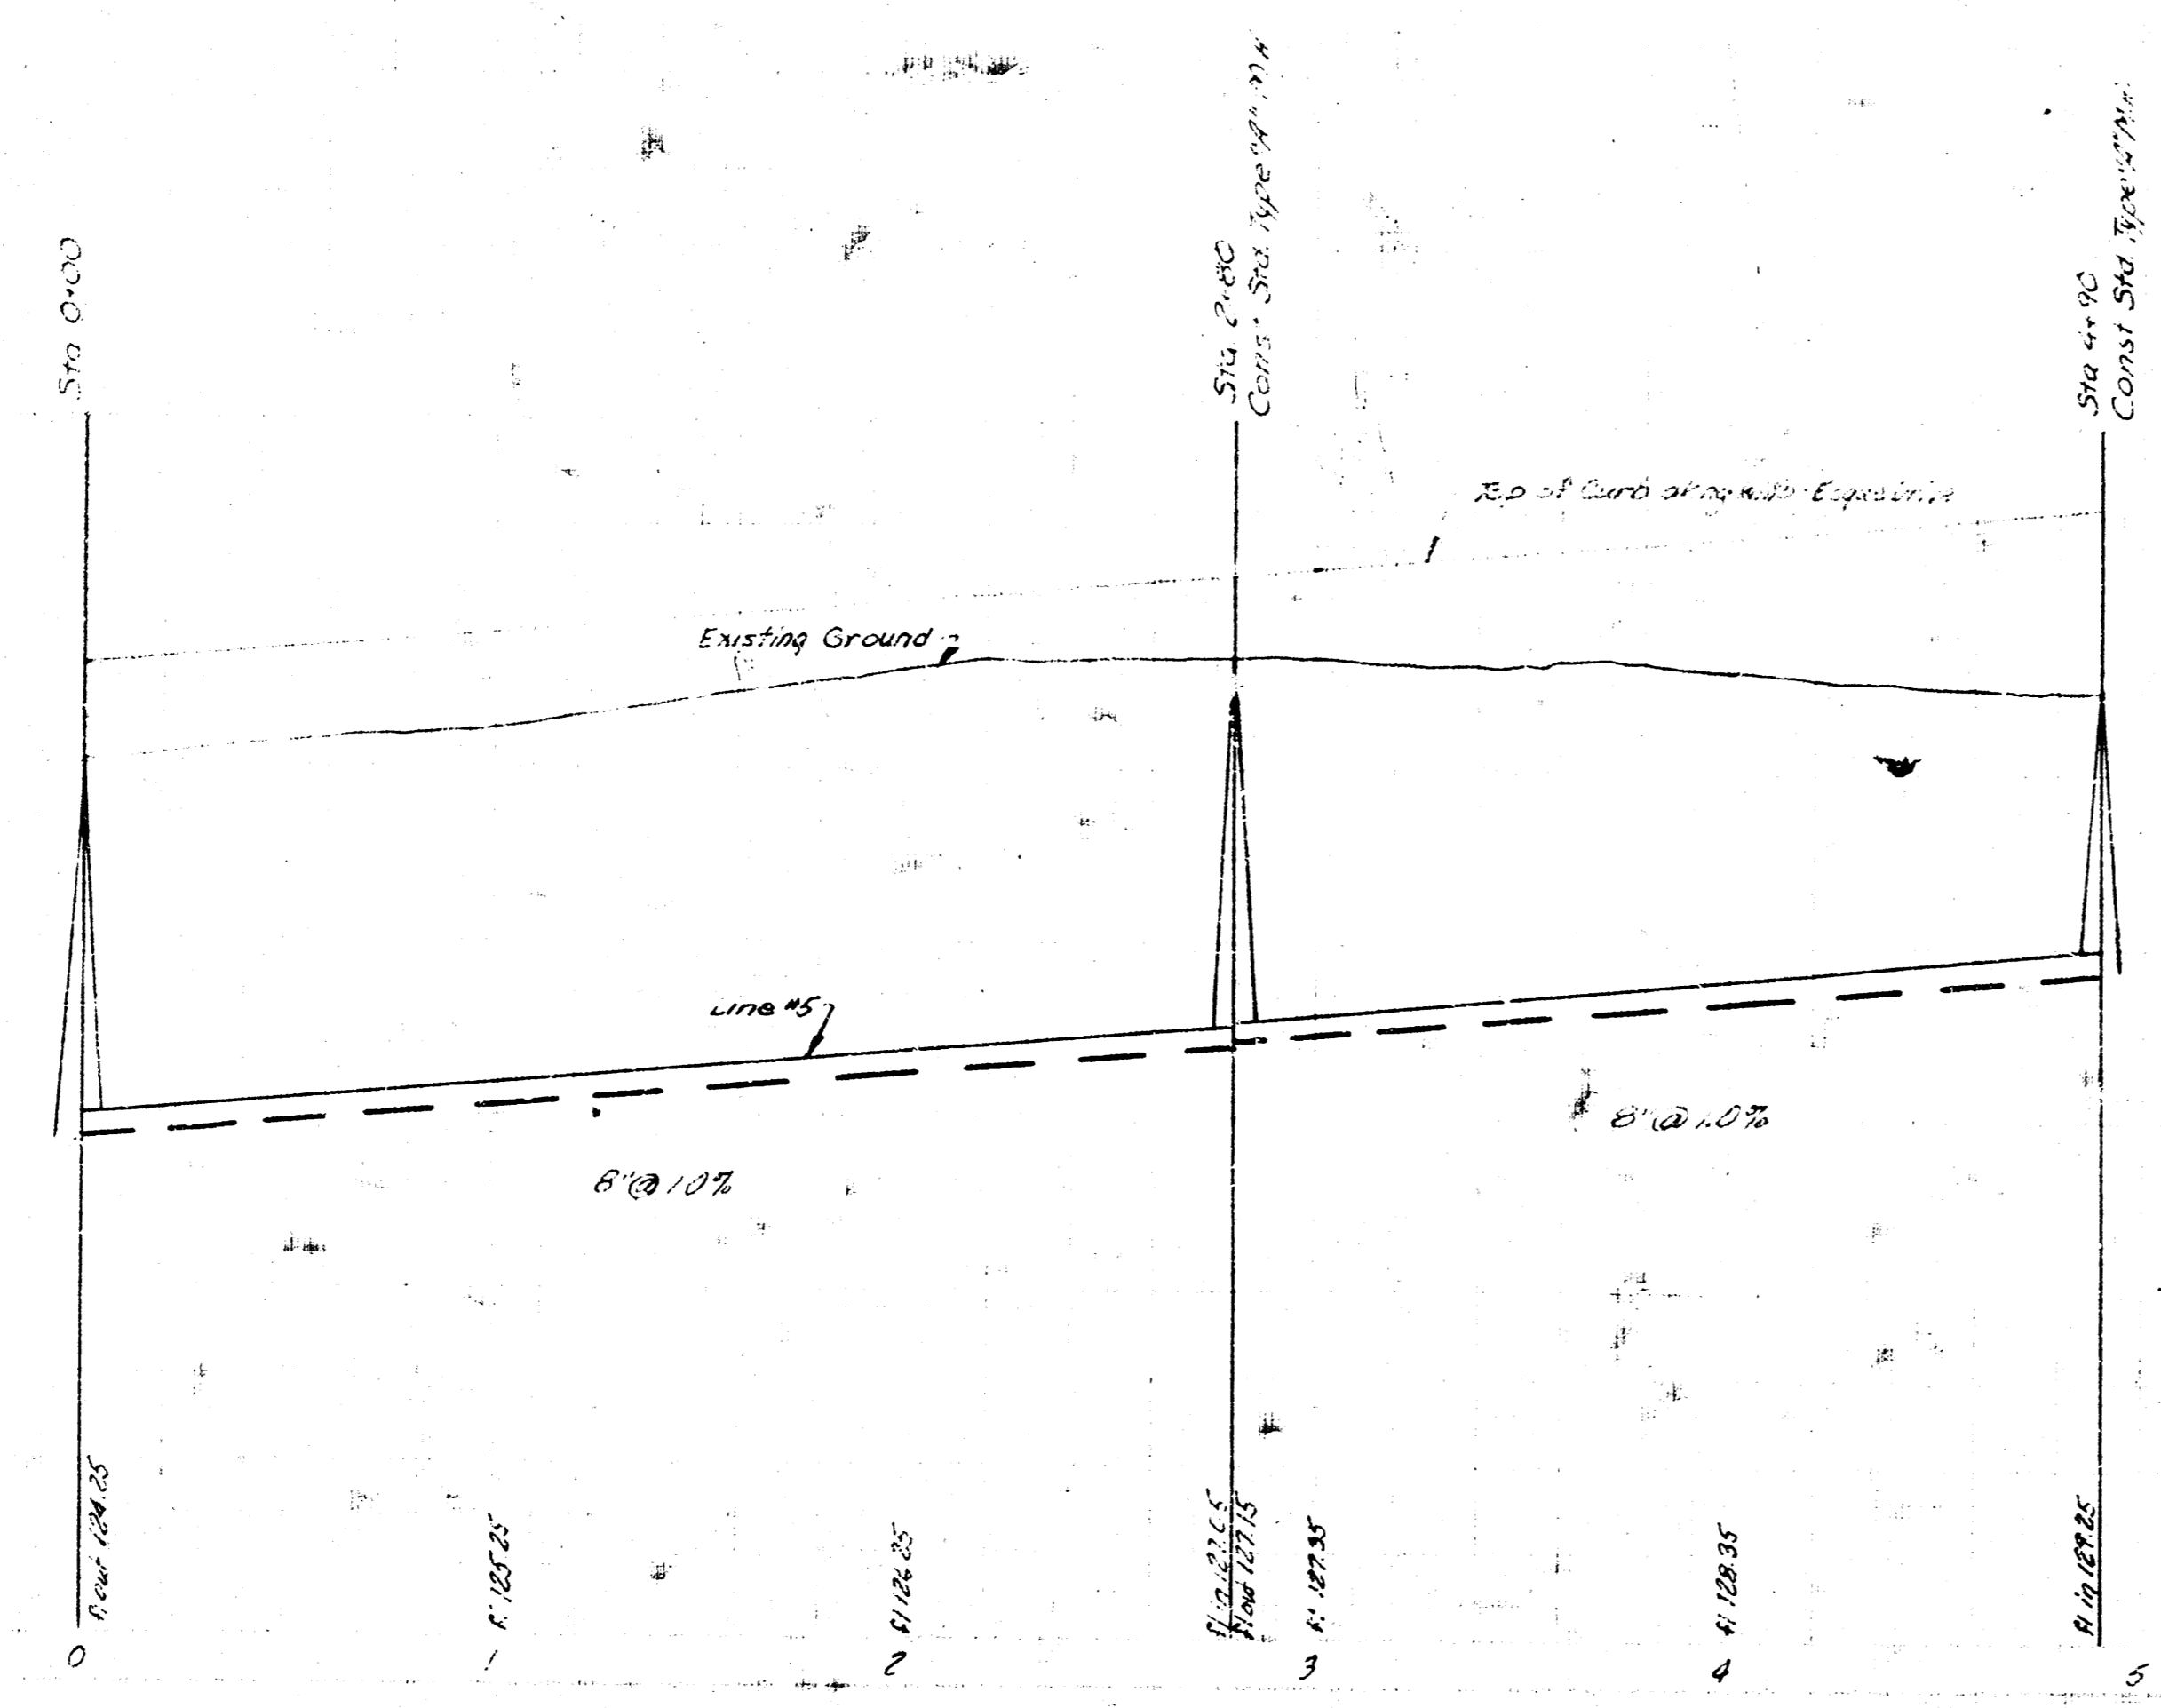

LAT. 49 S.W. INTERCEPTOR
 PROJECT NO. ~~DDK 67205~~
 SHEET 6 of 6 LINE NO. 5

1 4 3 4