

B. M. 109.85 R.R. Spk. in N.S.
P.P. N.W. cor. Hoover & 31st
St. So.

NOTE: CONTRACTOR TO SECURE HIS WORK ON THIS PROJECT
IN SUCH A MANNER THAT NO OTHER ST. WILL BE
CLOSED FOR A HIGHER LENGTH OF TIME.

Sta. 1125.4 Const.
Std. M. H. Type "B"
Install 6" x 15' Stub No.
at 0.4% grade.
Install 4" Stub N.E.

NOTE:
Replace 24" R.C.P.
Replace gravel drive.
Replace A.C. mat.

CAUTION:
S.W. Bell Tele.
underground cable
6" ± W. of E.P.
Call 268-1556
prior to construction.

Sta. 7140.0
Const. Std. M. H.
Type "A"
Install 6" Stub East

Sta. 0100.0
Exist. M. H.
8" opening is 3' south
of center of manhole.

NOTE: Replace fence.

NOTE:
Remove Stone coping.
Do not replace.

EXIST. M. H.
80 ± 40.1
Flo in 91.39
Flo out 91.09
10" stub W. 93.00
8" stub S. 93.00

Sta. 0100.0 Exist. M. H.
8" opening is 3' south of
center of manhole.
Exist. City Service & pipe line

Sta. 1125.4 Const.
Std. M. H. Type "B"
Install 6" x 15' Stub No.
at 0.4% grade.
Install 4" Stub N.E.

Sta. 4135.0 Const.
Std. M. H. Type "A"

Sta. 7140.0 Const.
Std. M. H. Type "A"
Install 6" Stub East

110
105
100
95
90

110
105
100
95
90

125.4 Lin. ft. of 8" Reinf.
Conc. encasement.
125.4 Lin. ft. of 8" clay pipe
@ 0.40% grade



614.6 Lin. ft. of 8" clay Pipe at 0.40% grade.

"As Built" Final Mean. K-106

LAT. 51, S. W. INTERCEPT SEWER
CITY OF WICHITA, KANSAS
R. W. LINN - CITY ENGINEER
JAN. 1973 PROJECT NO. DBKL572045

Plan Scale 1" = 40'
Profile Scale 1" = 40' Vert.

CAUTION
UNDERGROUND
UTILITIES
Please check with K & E or
Southwestern Bell
Telephone Co. for location.

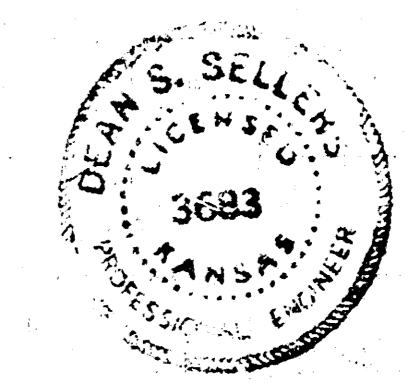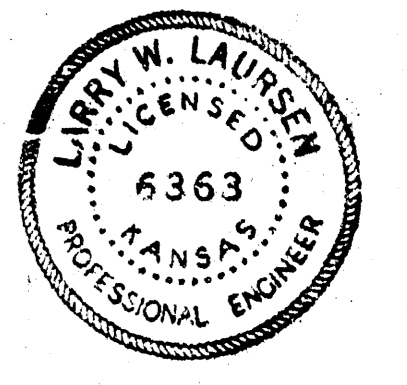

19 Eng
water