


B. M. 142.43 S.E. cor. conc. porch
513 Floyd St.
T. B. M. 140.89 NE. cor. conc. dr.
513 Floyd St.

Plan Scale 1" = 40'
Profile Scale 1" = 40' Horiz.
1" = 5' Vert.

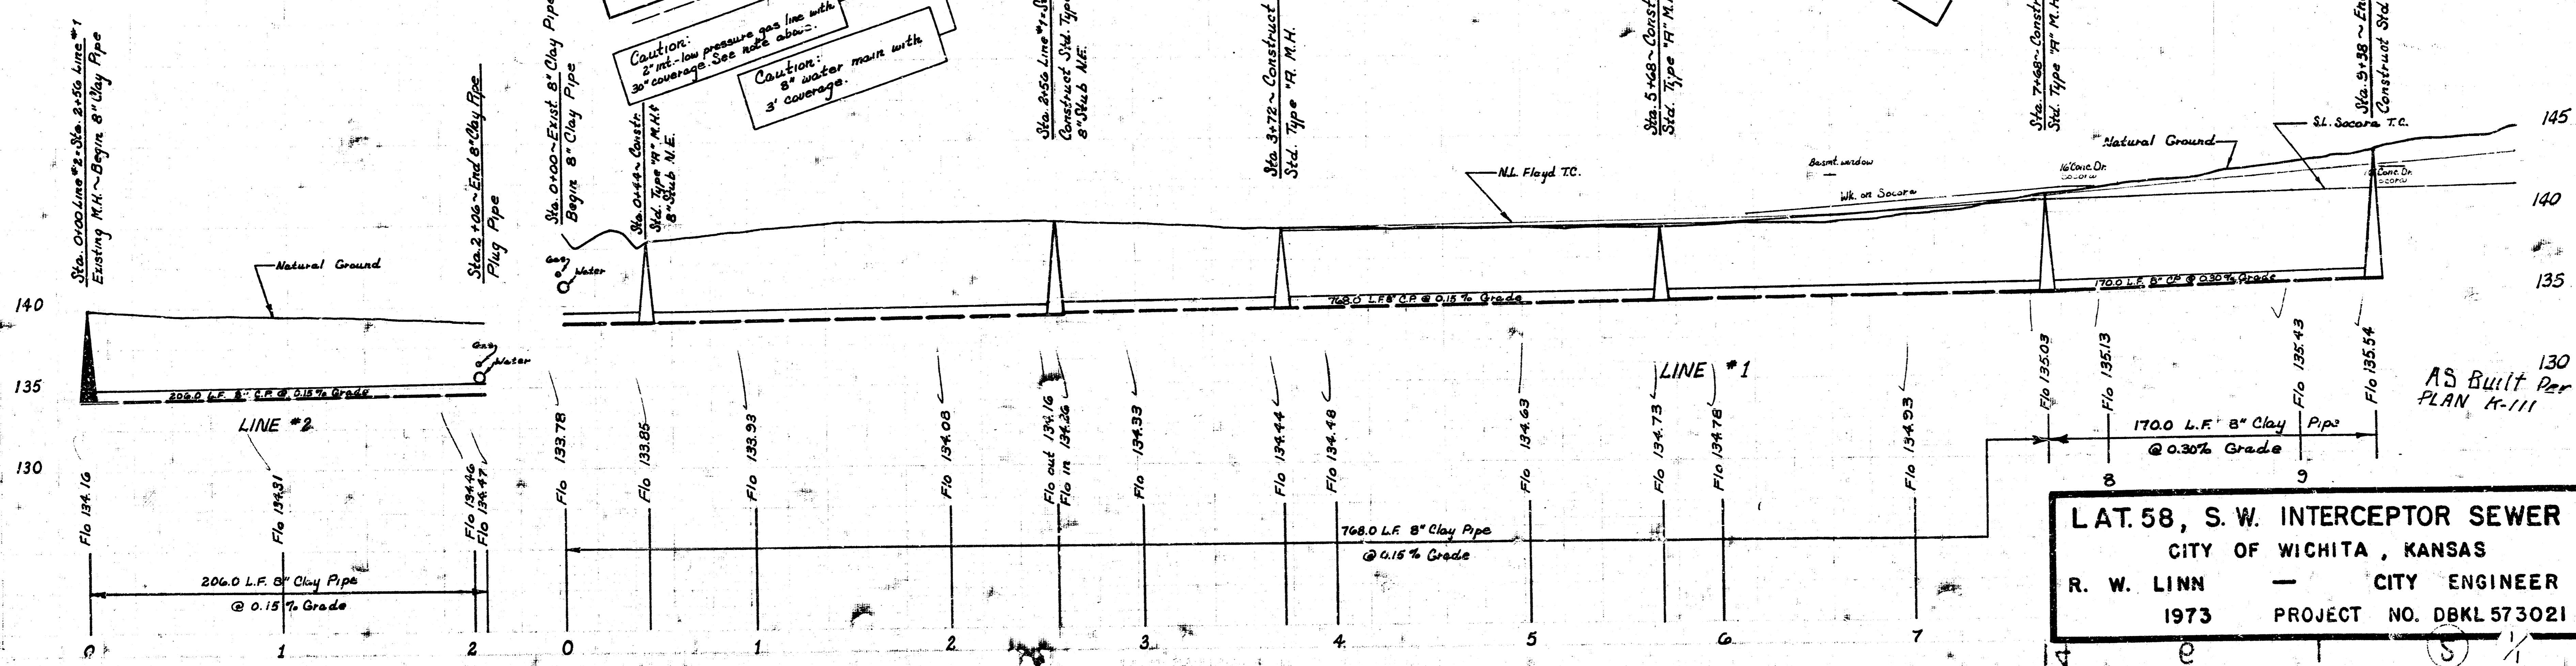

L AT. 58, S. W. INTERCEPTOR SEWER
CITY OF WICHITA, KANSAS
R. W. LINN — CITY ENGINEER
1973 PROJECT NO. DBKL 573021

AS Built Per
PLAN K-111