

T. B. M. 139.05 R. R. Spk. SW side R.R.  
NE cor. Floyd & Turquoise.

L.C.D. 10. 30  
Pg. 54 of 59

D.L.A.  
C.I.R.W.

D.L.K.  
# 160

Sta. 0100.0 Const. M.H.  
Exist. 8" Stud N.E.

Sta. 0100.0  
Exist. M.H.  
Exist. 8" Stud N.E.


Sta. 1174.1 Const.  
Std. M.H. Type "A"  
Sta. 0100.0 Line No. 3

Sta. 4105.0 Const.  
Std. M.H. Type "A"


Sta. 6125.5 Const.  
Std. M.H. Type "A"  
Sta. 0100.0 Line No. 2 SE

Sta. 6125.5 Const.  
Std. M.H. Type "A"  
Sta. 0100.0 Line No. 2 SE

Sta. 1200 Const.  
Std. M.H. Type "A"

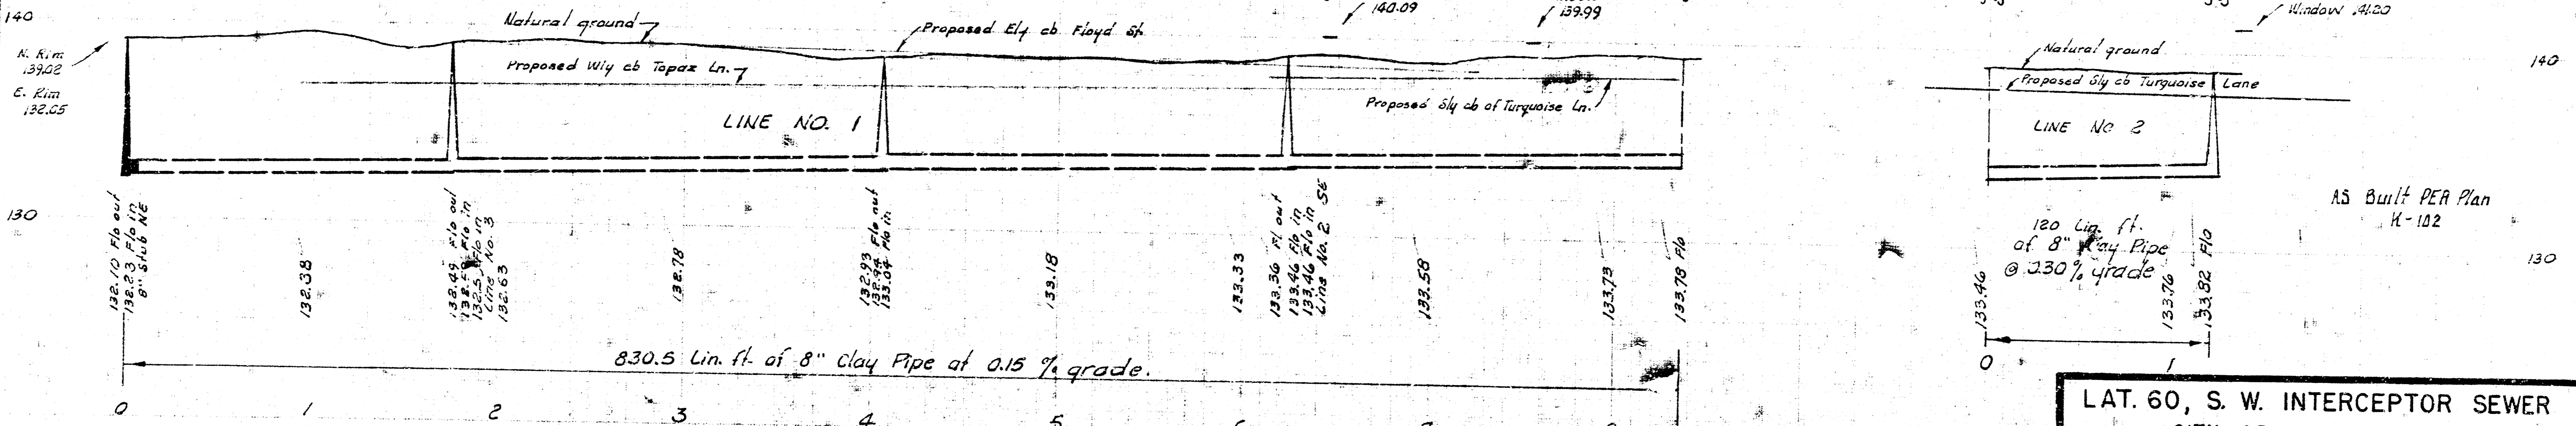

B. M. 145.50 SW cor. conc. curb 520 So. Evergreen Lane.


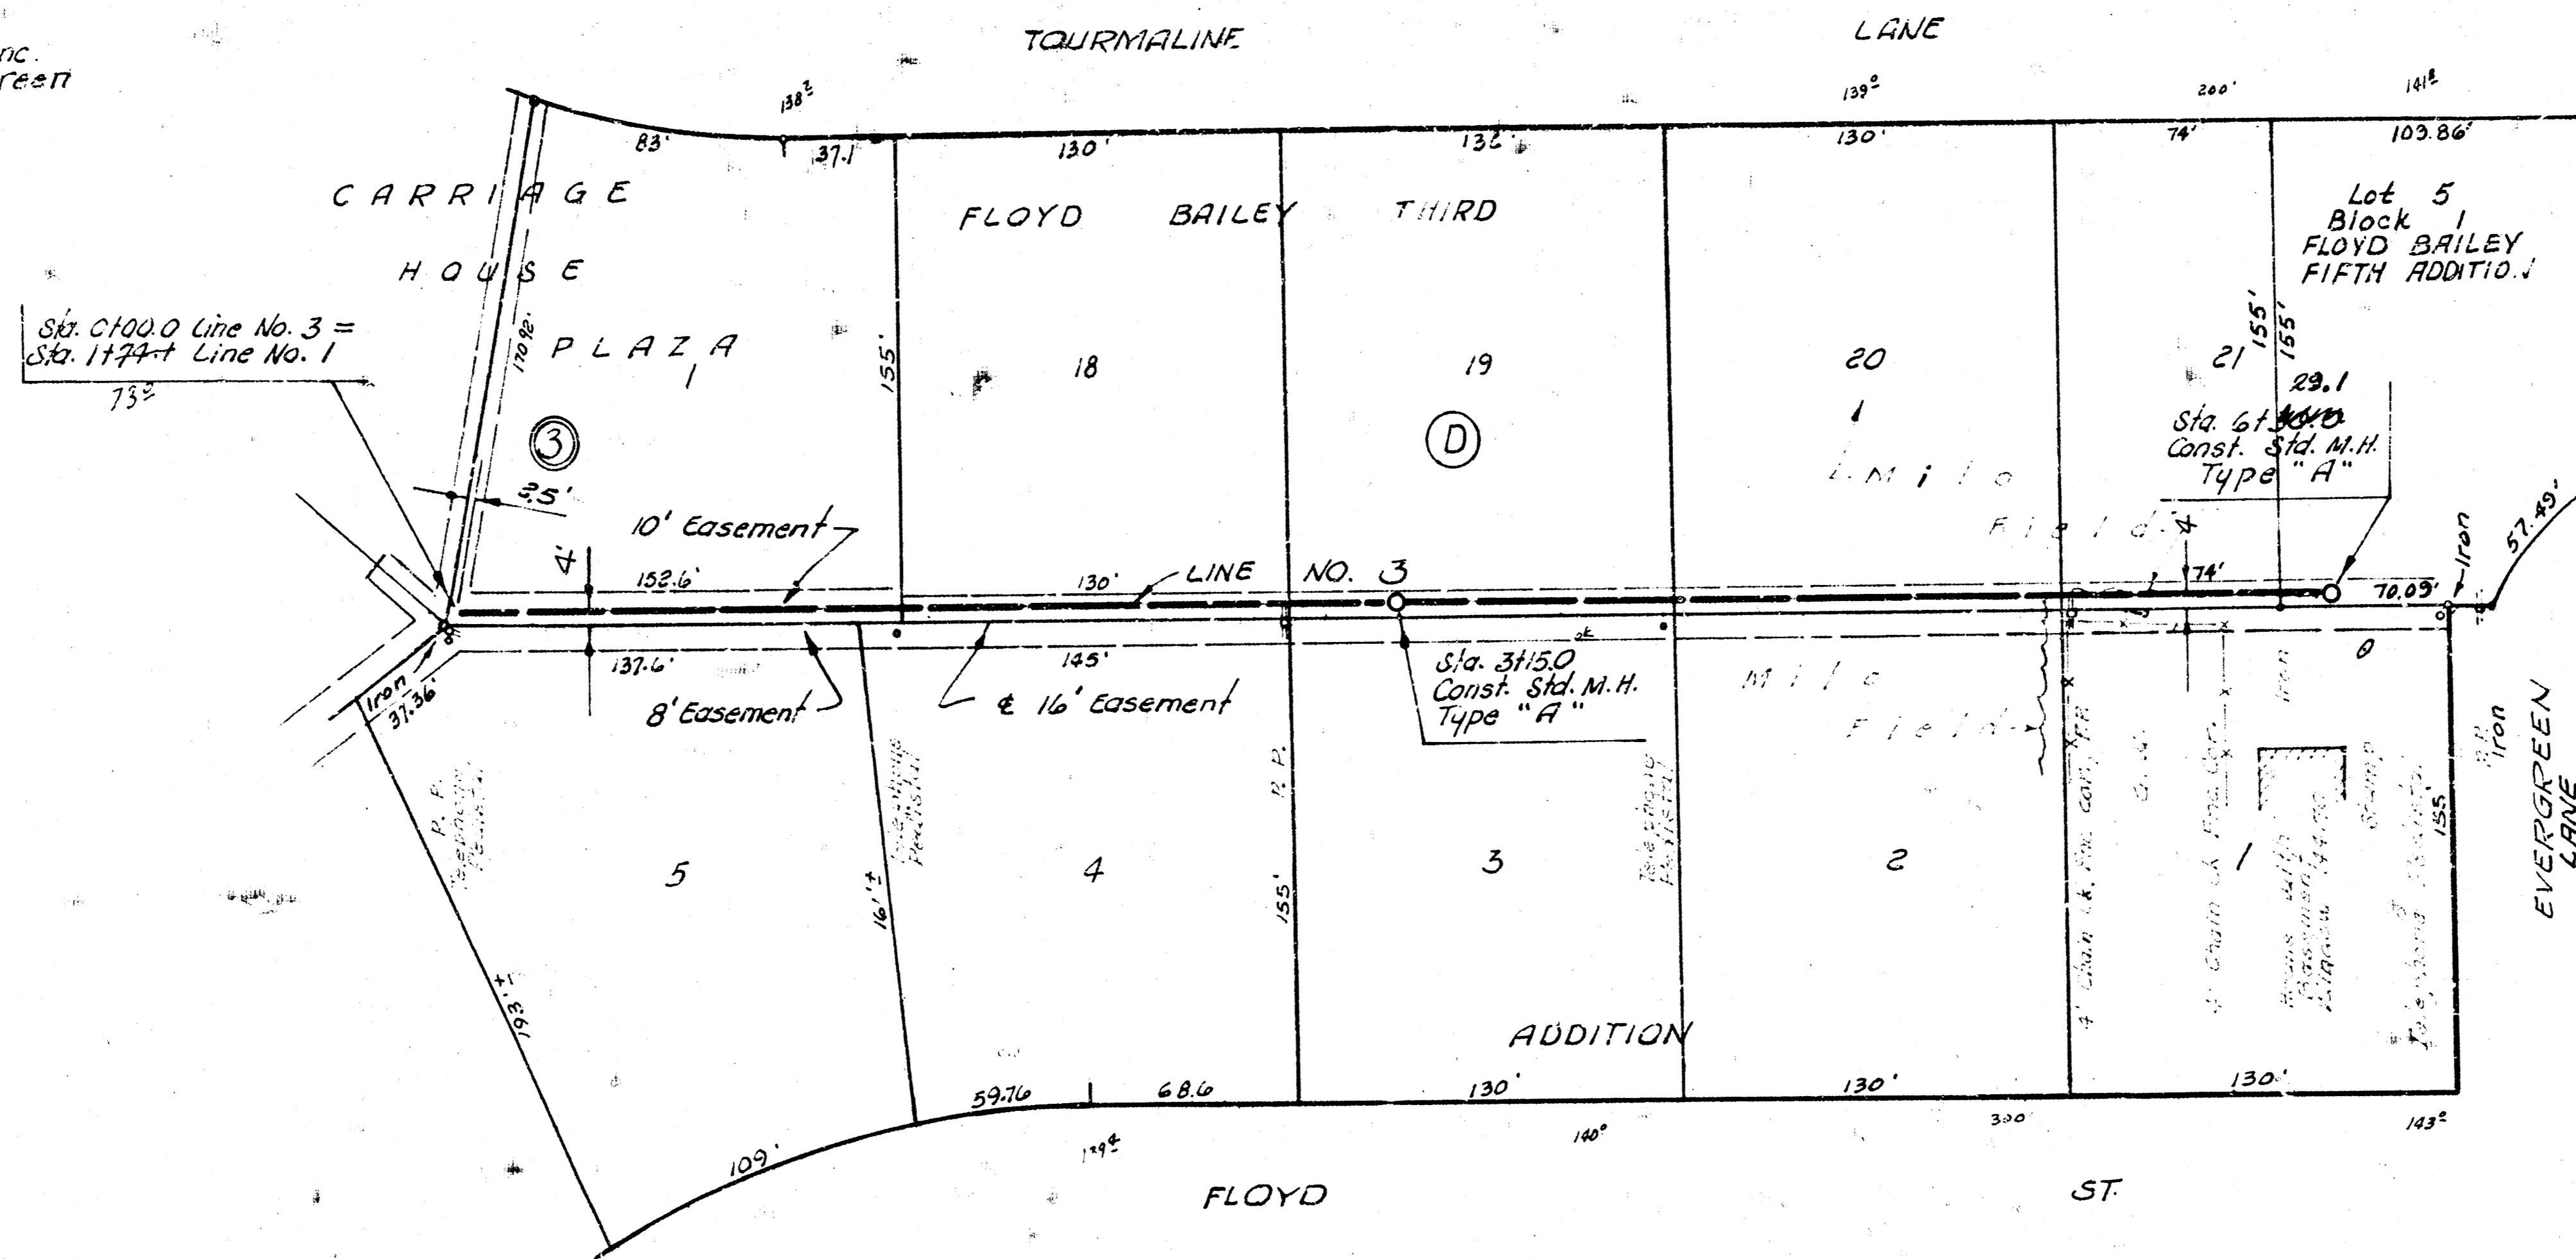


Plan Scale 1" = 40'  
Profile Scale 1" = 5' Vert.

160

145  
140  
135  
130

145  
140  
135  
130

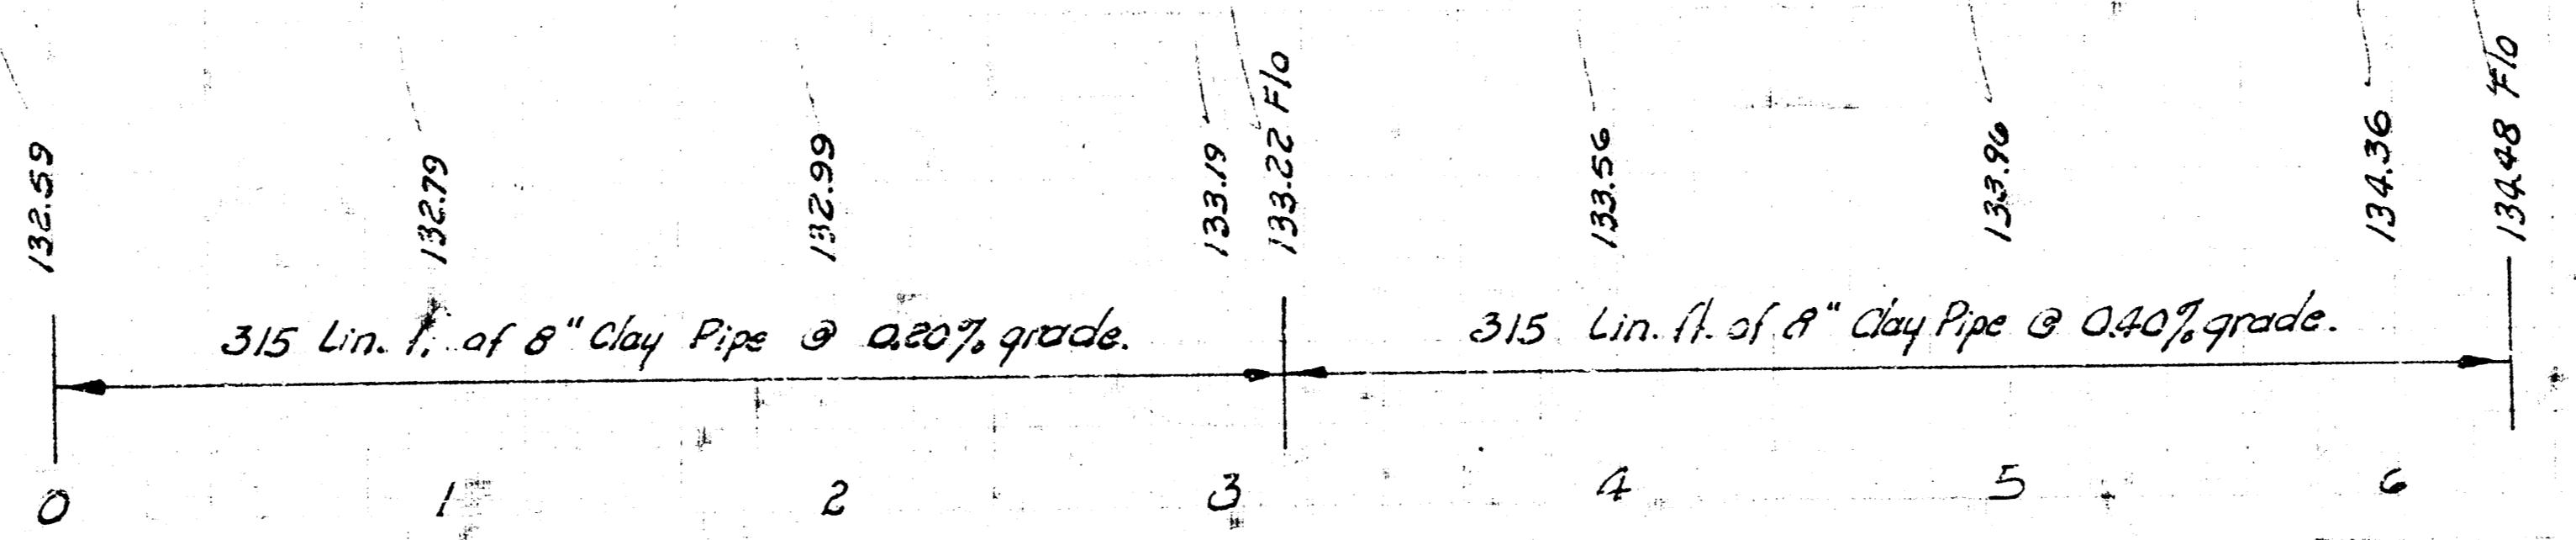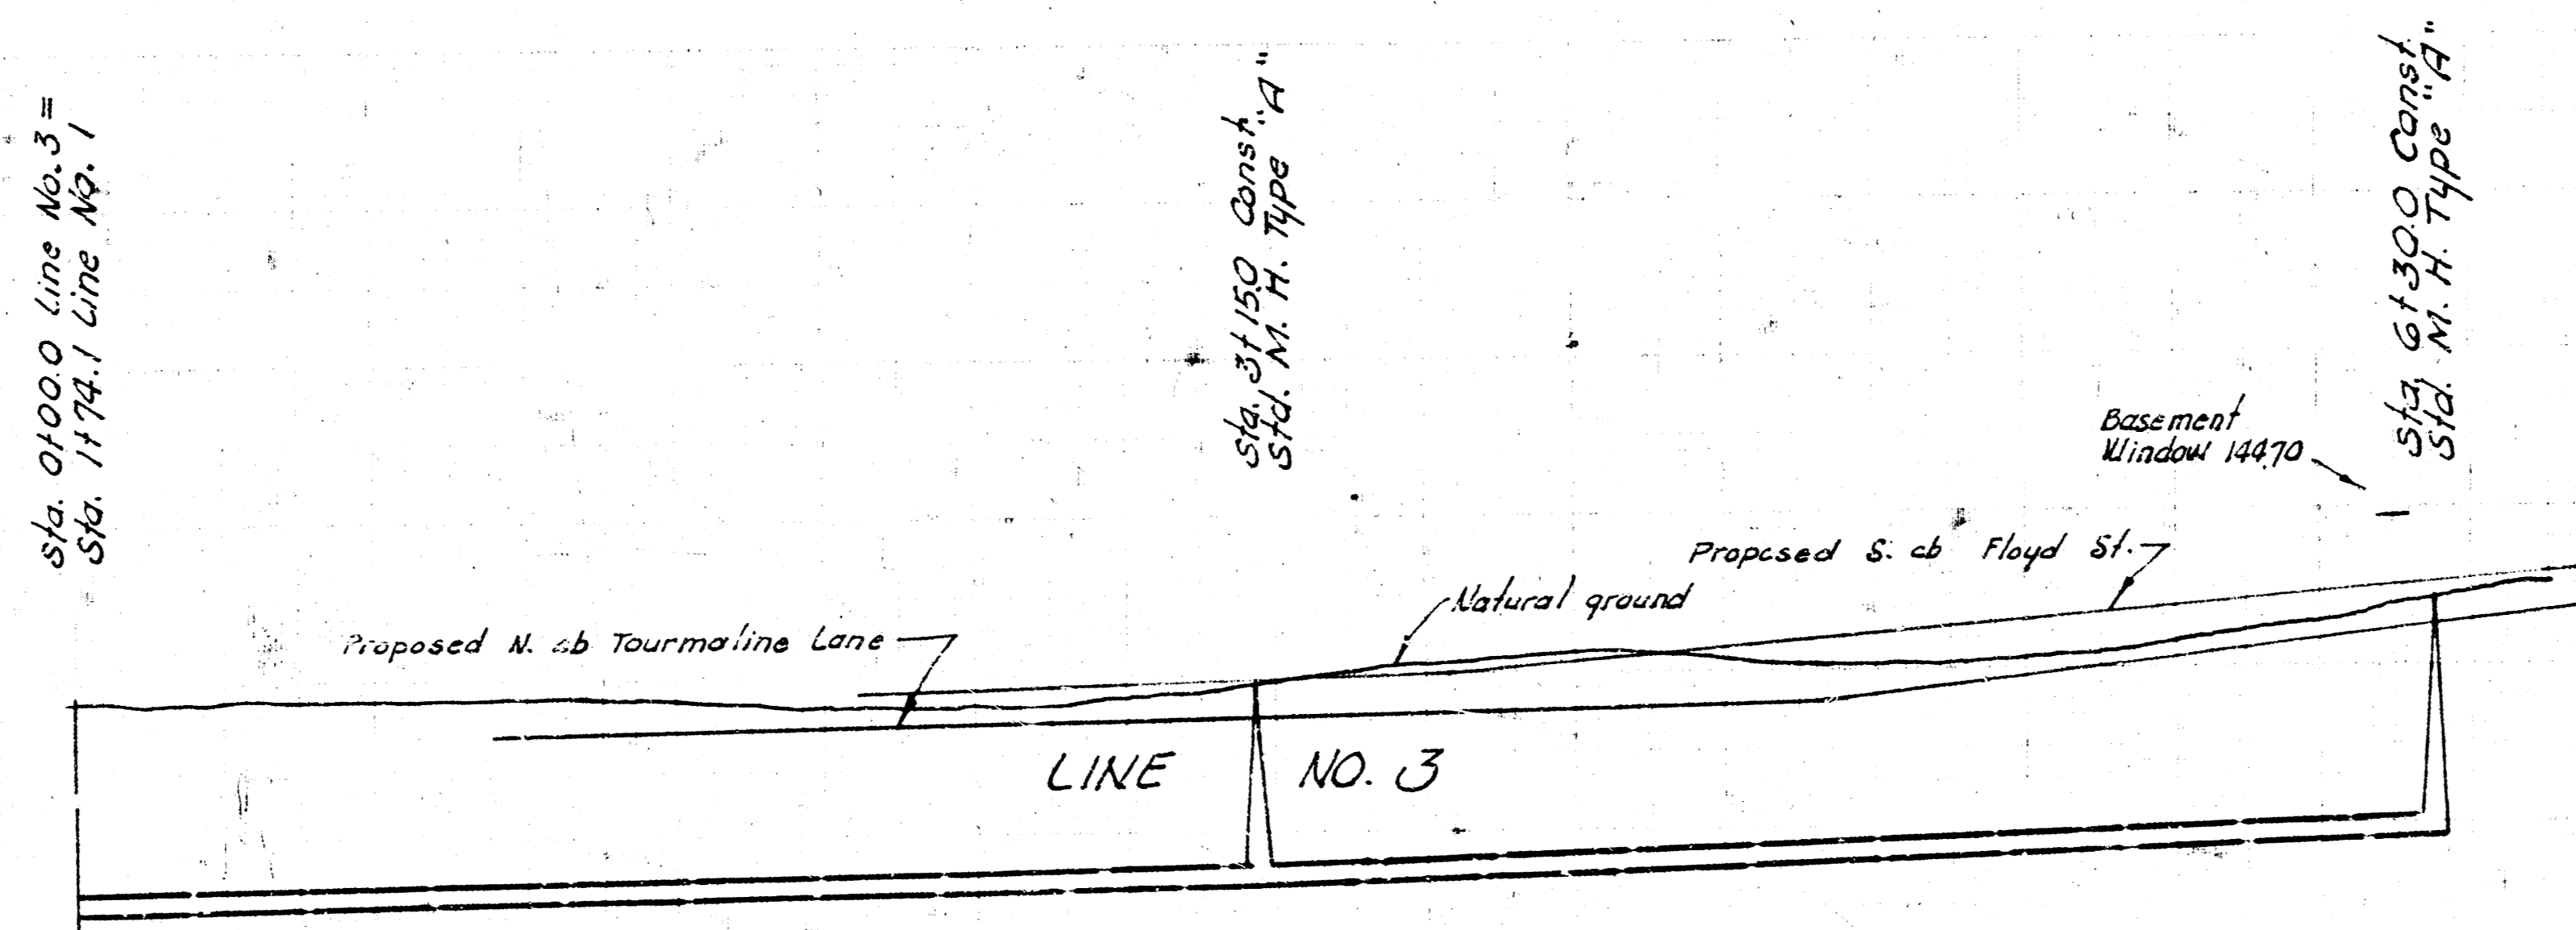

L.A.T. 50, S. W. INTERCEPTOR-SEWER  
PROJECT NO. DBK1573038