


Plan Scale 1" = 40'  
 Profile Scale 1" = 40' Horz.  
 1" = 5' Vert.

BM = 148.10 Wichita City Std. at 13th St. and Ridge Road  
 BM = 150.27 "+ at West end return at NW corner Margantown and Nantucket

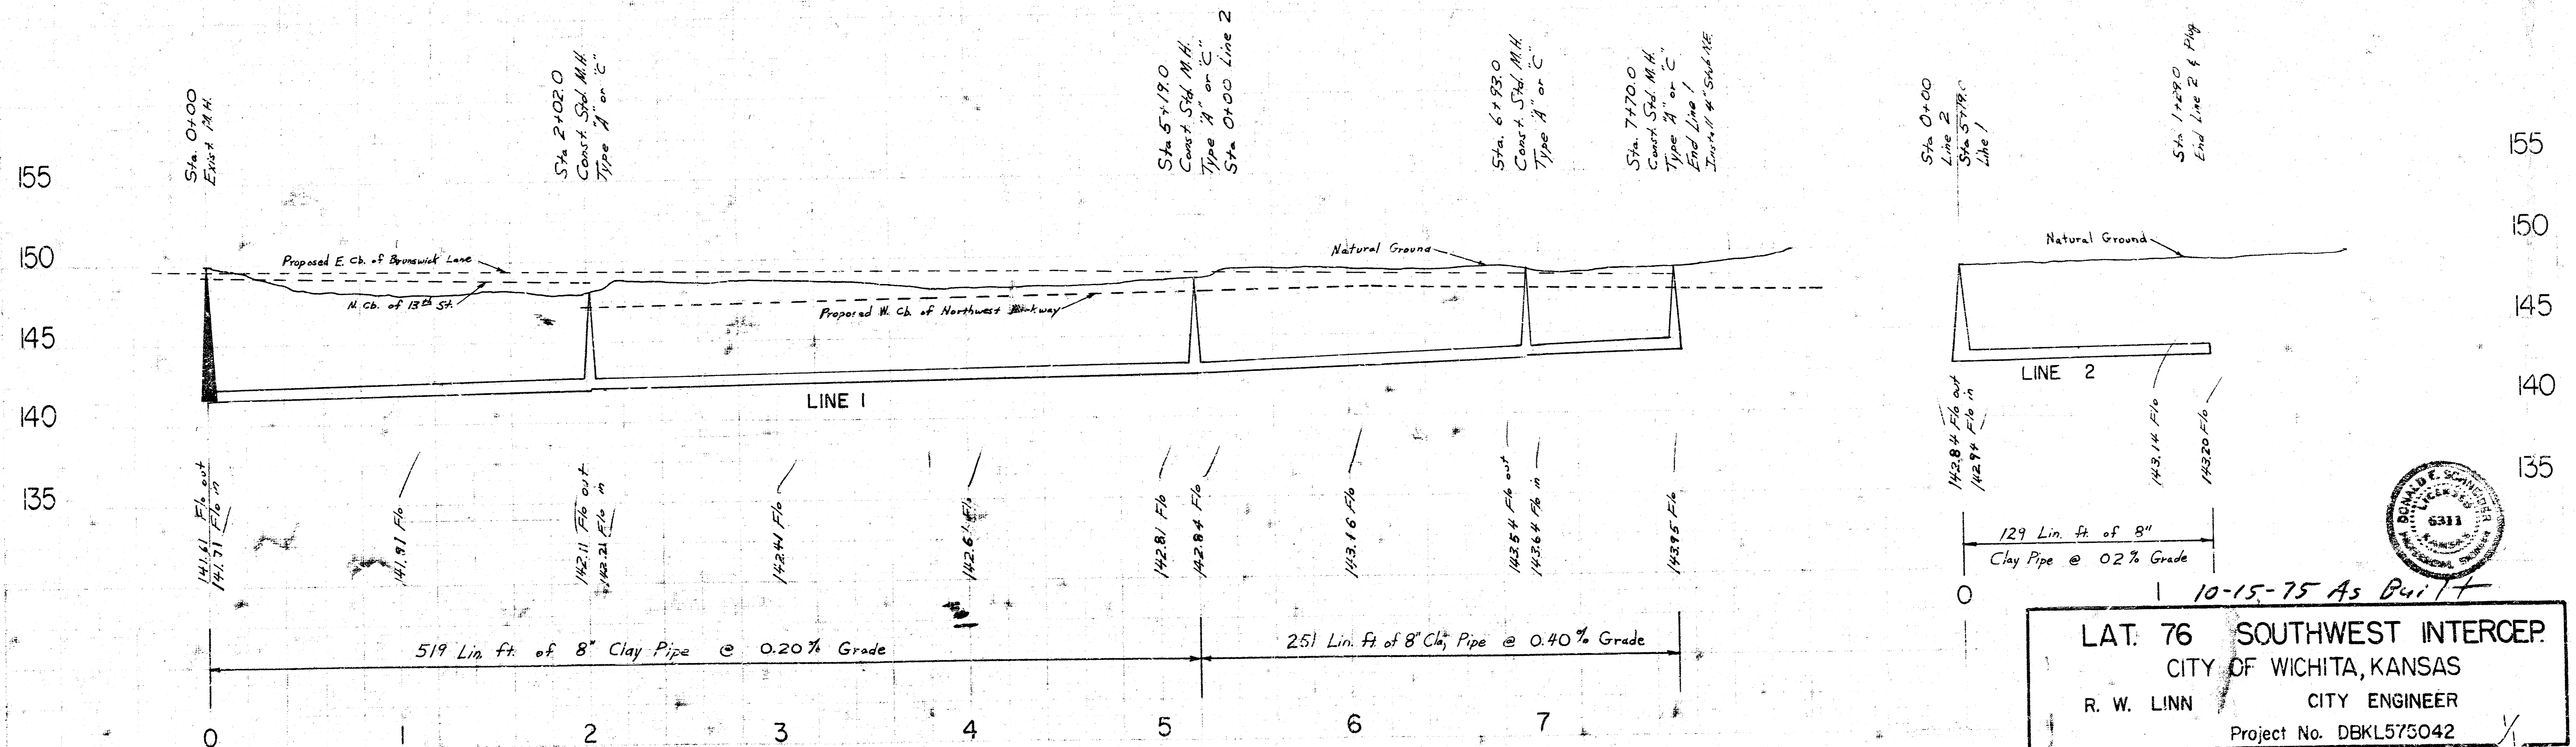

10-15-75 As Built  
 LAT. 76 SOUTHWEST INTERCEP.  
 CITY OF WICHITA, KANSAS  
 R. W. LINN CITY ENGINEER  
 Project No. DBKL575042