

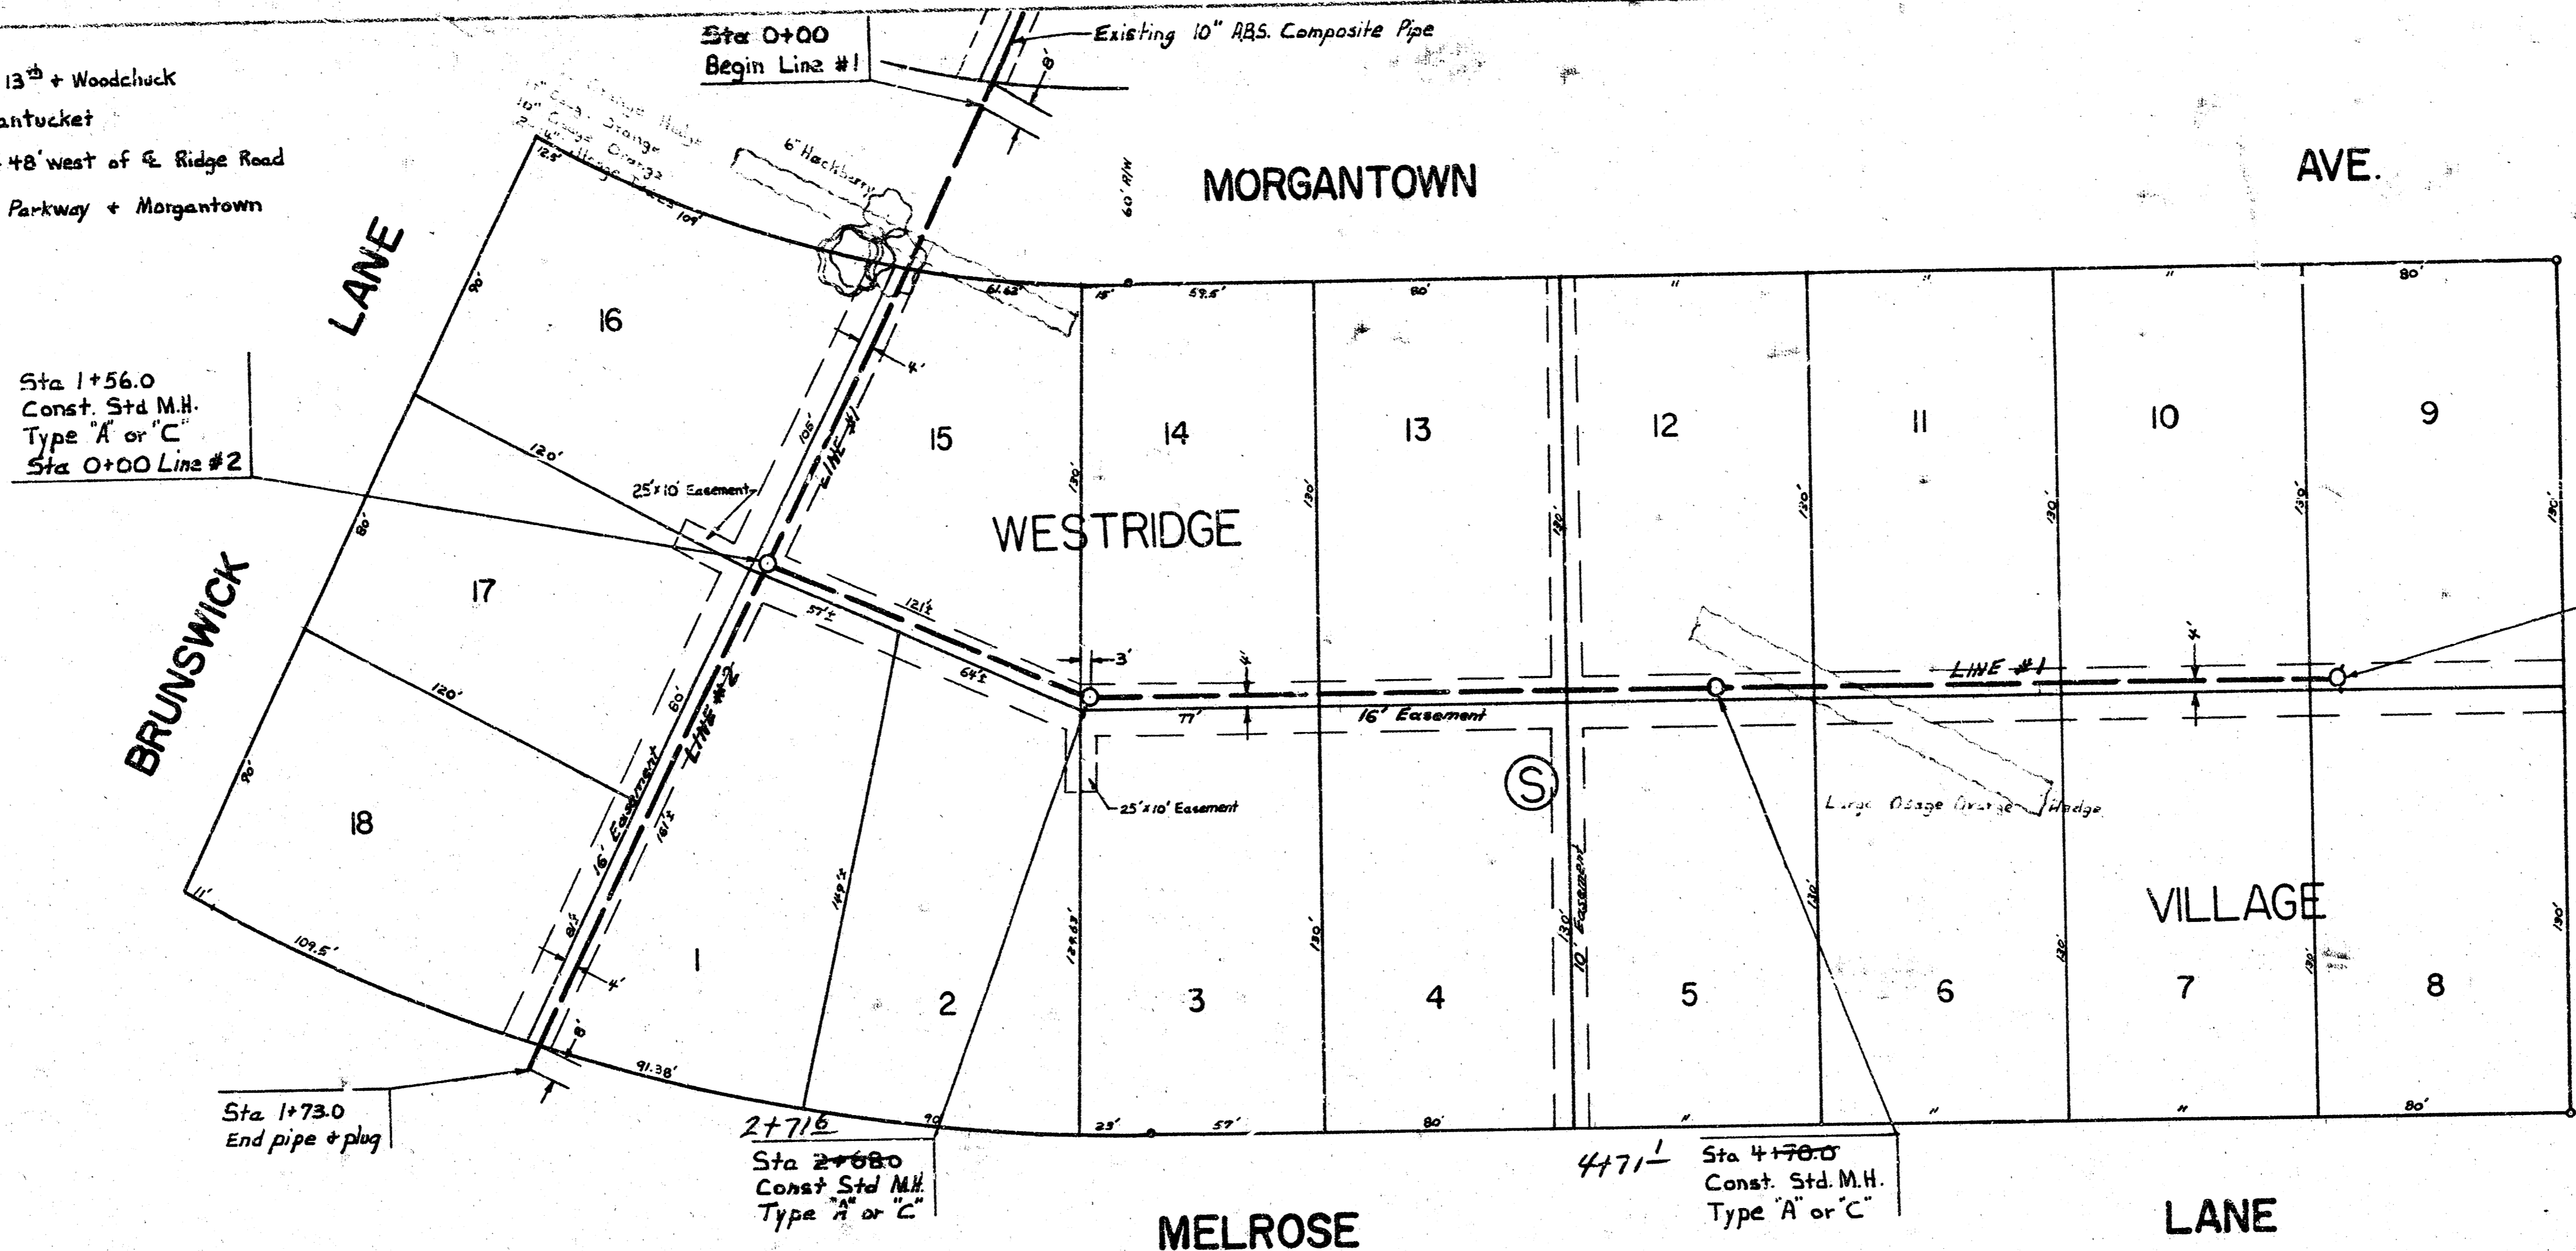


B.M. 156.187 City BM Disc +2.3' E. + 4.0' N. of 1/4 Sec. Co. @ 13th + Woodchuck
 B.M. 150.27 ' + @ W. end return @ N.W. corner Morgantown + Nantucket
 B.M. 137.95 RR. spike east side Power Pole 1010' N. of & 13th + 48' west of & Ridge Road
 B.M. 149.83 ' + on top curb west end Road N.W. corner Northwest Parkway + Morgantown

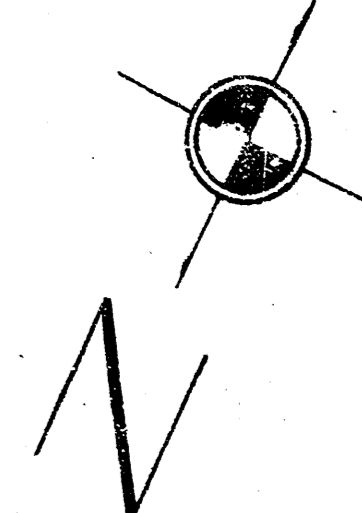



 Plan Scale 1" = 40'
 Profile Scale 1" = 40' Horiz.
 1" = 5' Vert.

Sta 6+70.0
 Const. Std. M.H.
 Type 'A' or 'C'
 Install 4" Stubs S+W.

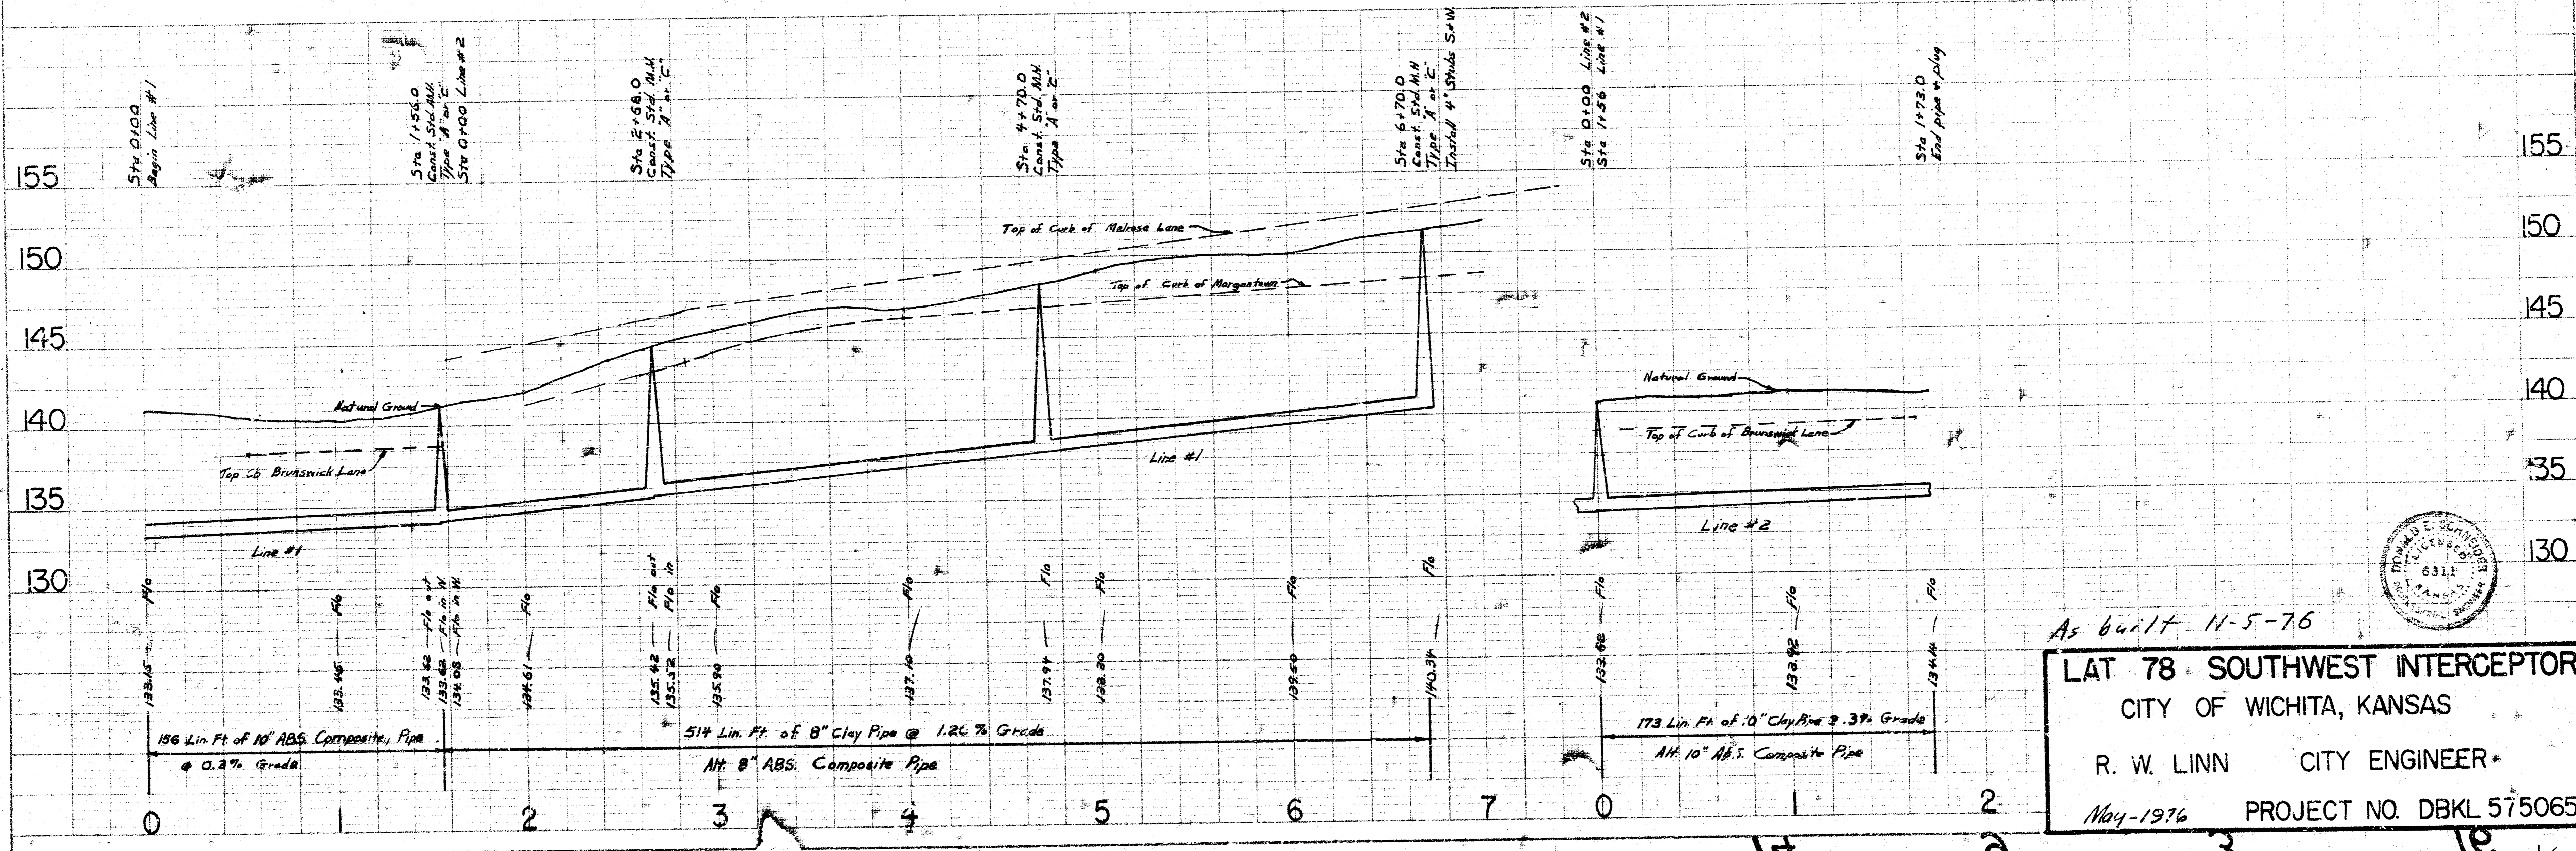

As built 11-5-76
LAT 78 SOUTHWEST INTERCEPTOR
 CITY OF WICHITA, KANSAS
 R. W. LINN CITY ENGINEER
 May-1976 PROJECT NO. DBKL 575065

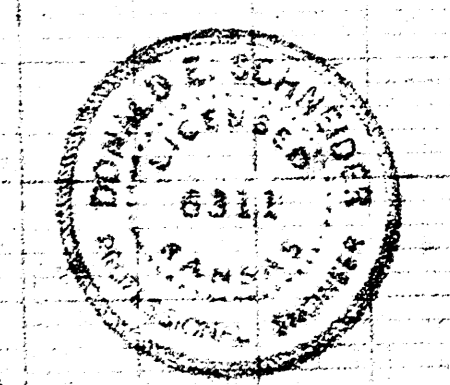

PLAN
 INTERCEPTOR
 11-5-76

PROFILE
 INTERCEPTOR
 11-5-76