


LAT 108 SOUTHWEST INTERCEPTOR

CITY OF WICHITA, KANSAS


R. W. LINN CITY ENGINEER

Project Number DBKL577045

WESTLINK VILLAGE 14TH ADDITION

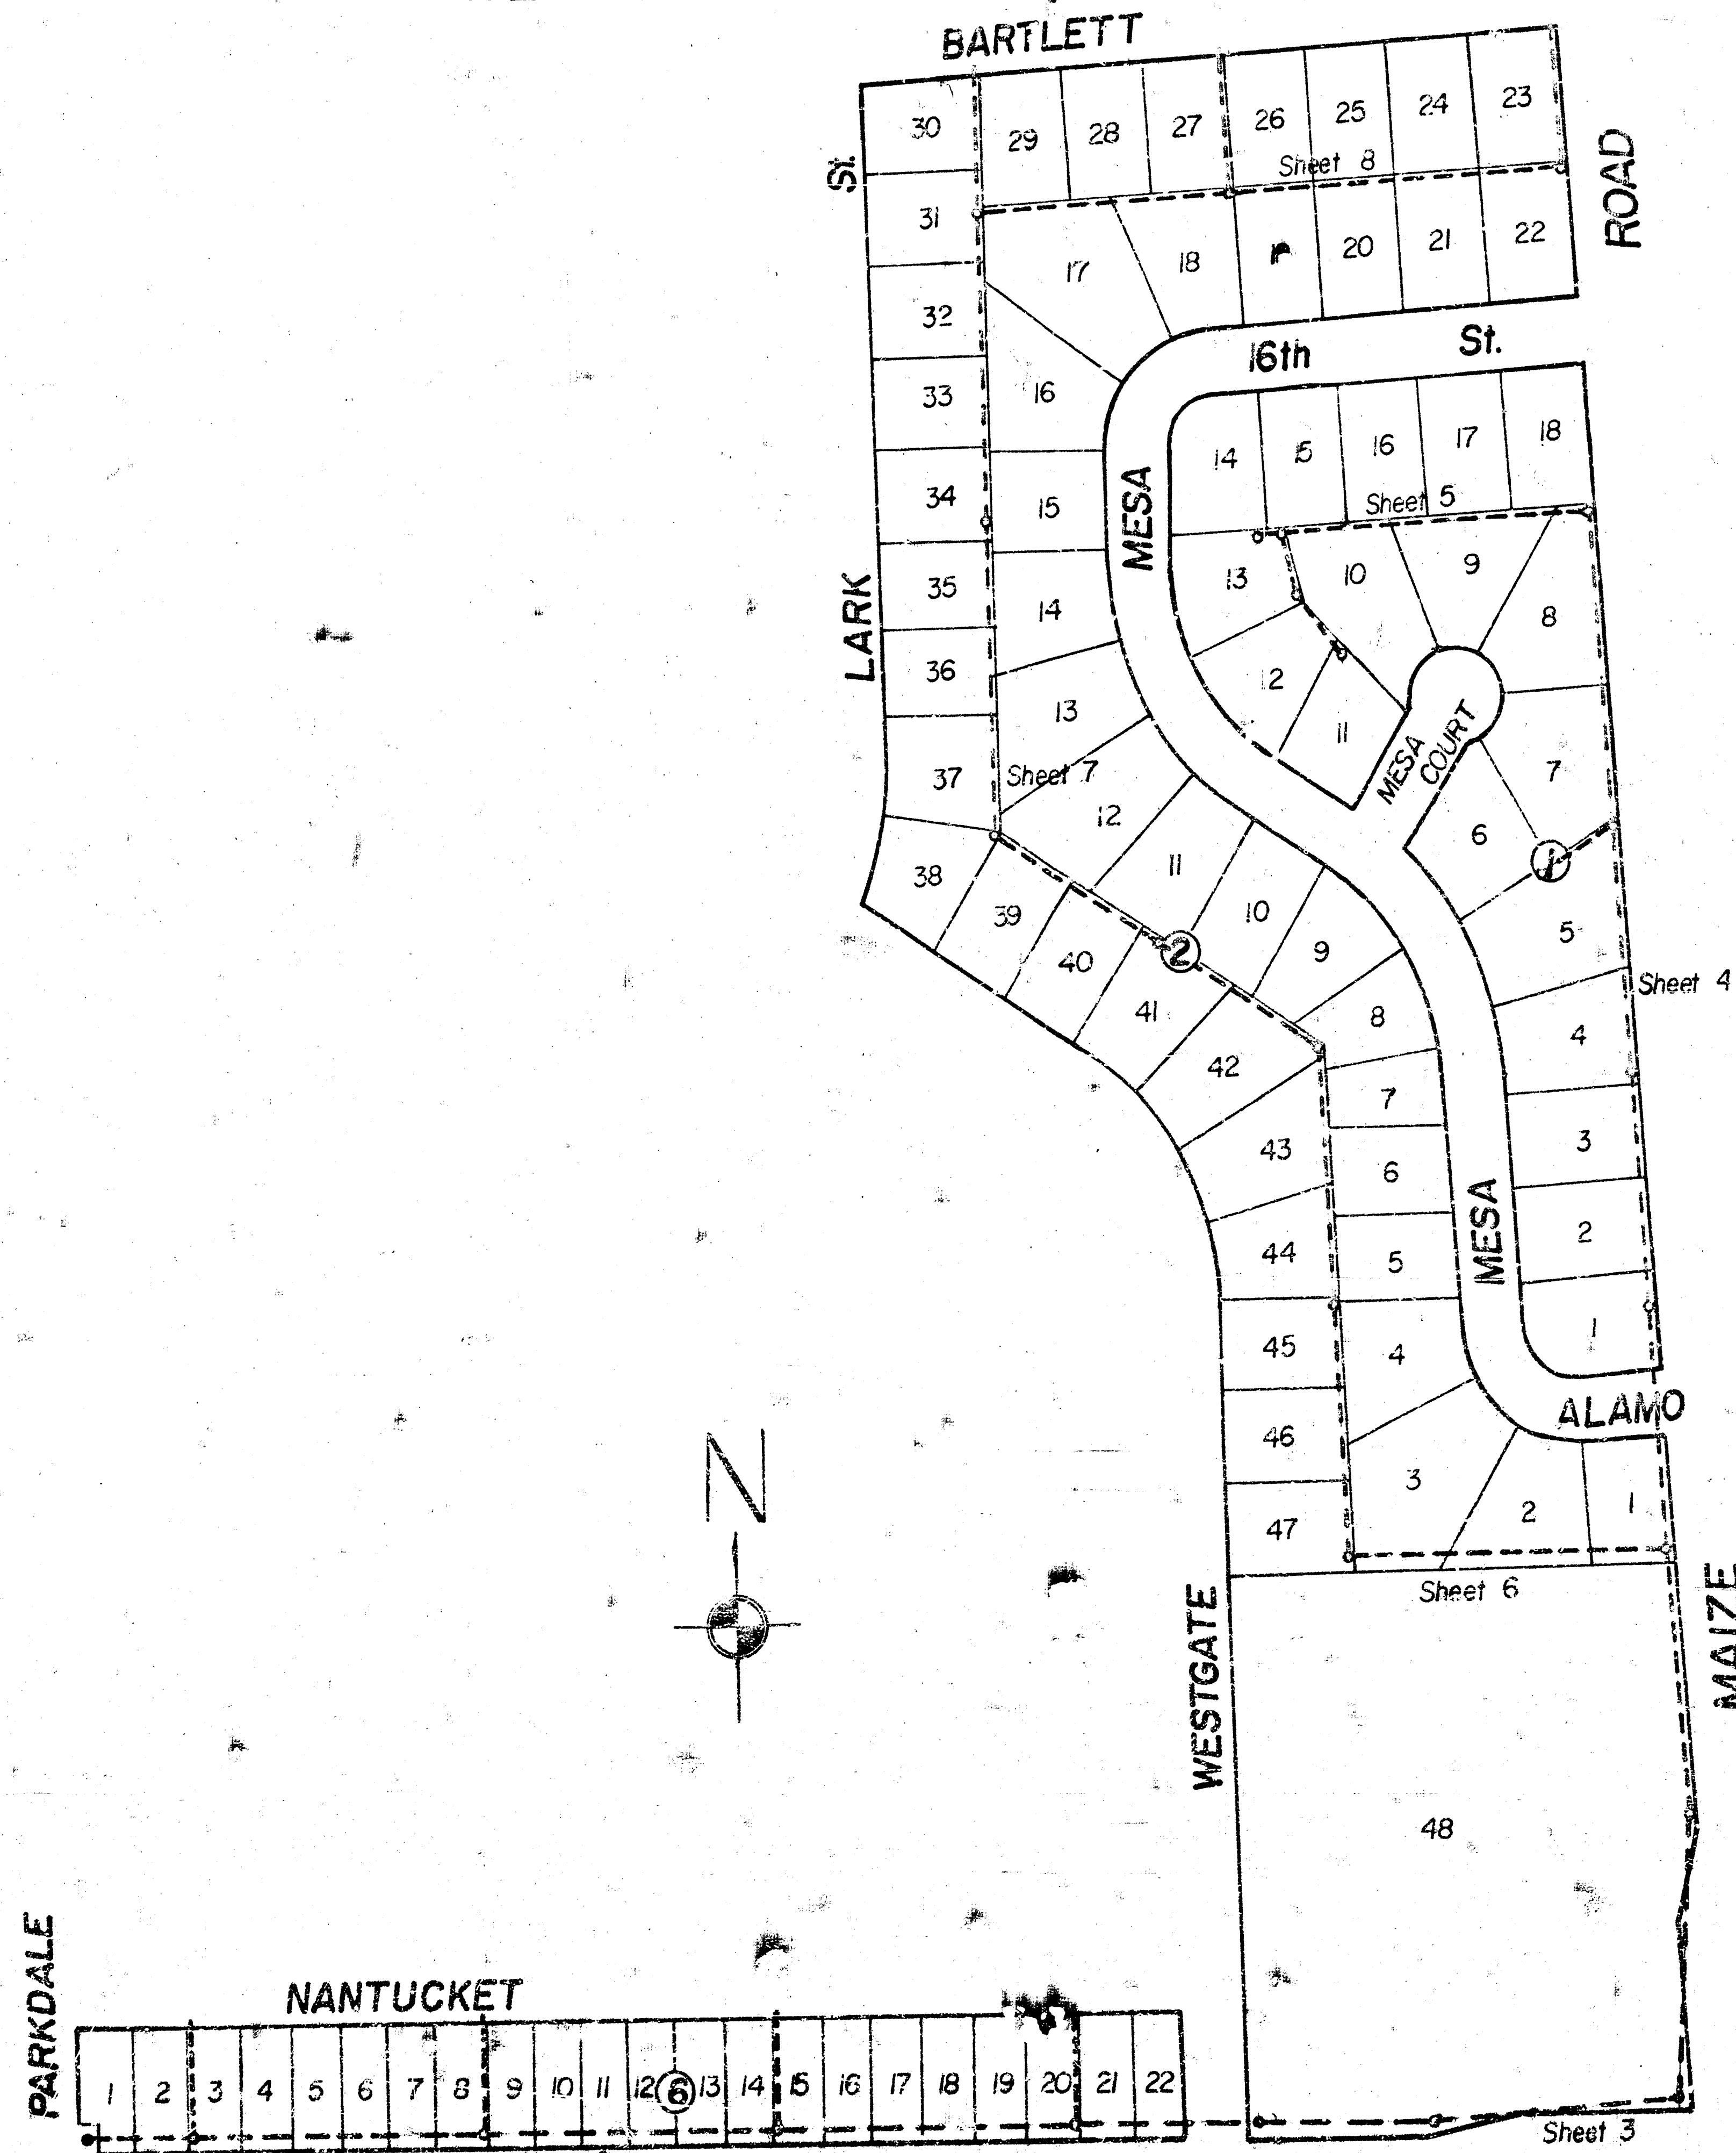

As built 3-15-78

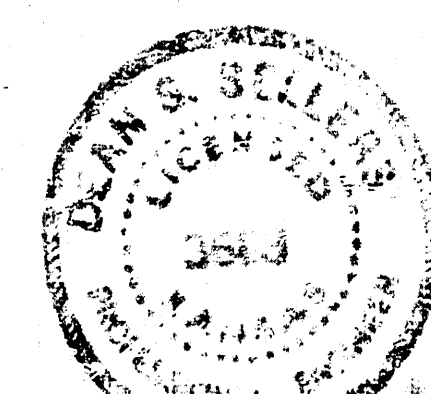


BM 155.686 Westlink & 13th St. N. City of Wichita BM disc Top W. end N. handrail to R.C.B. at Westlink
 BM 157.08 Top bolt S.W. corner High-Line Pole Base, South side KG & E Westlink Substation.
 BM 158.10 RR. spike N. fc. P.P. NE. cor. 13th & Maize Rd.

PARKDALE


NANTUCKET

WESTGATE

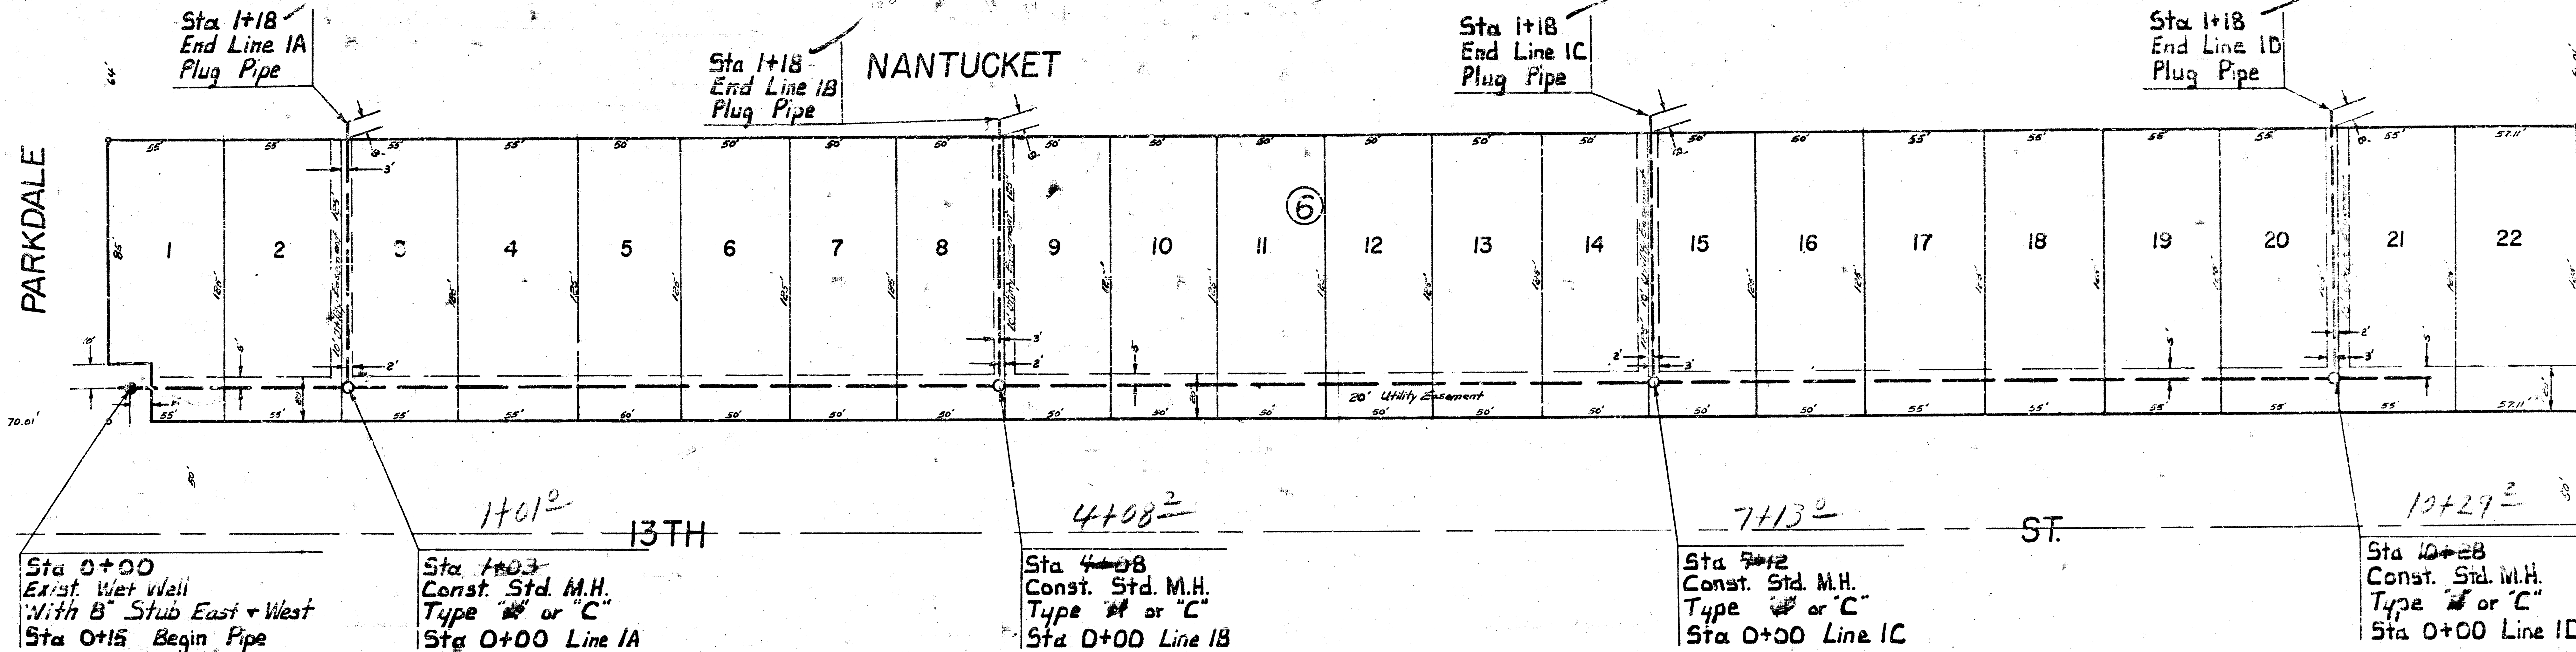


Note: For Profile on Lines IA, IB, IC, and ID See Sheet 9


Plan Scale 1" = 40'
 Profile Scale 1" = 40' vertical
 1" = 5' horizontal

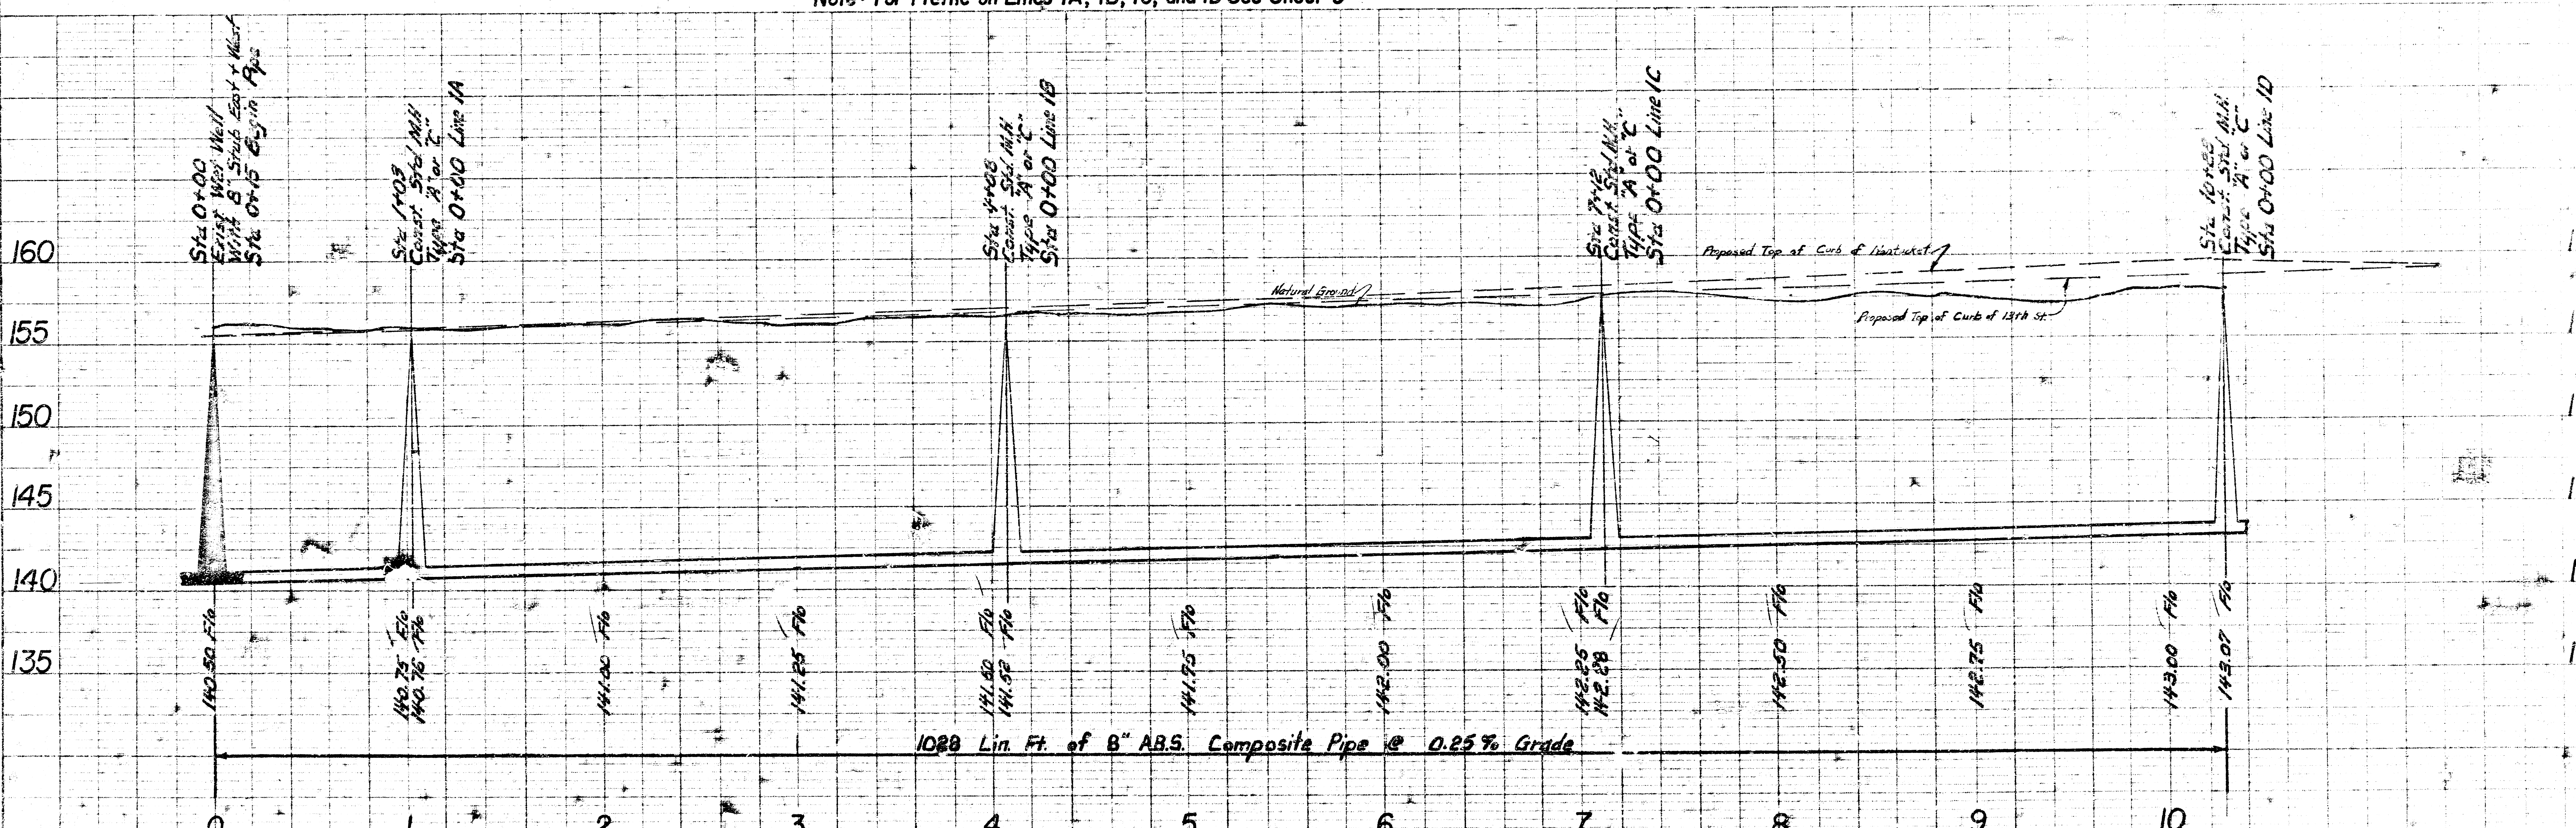

157.04 R.R. spike N. fc. PP approx. 200' S. & 100' W. of NW cor. Nantucket & Lark (4th PP W. Maize Rd.)

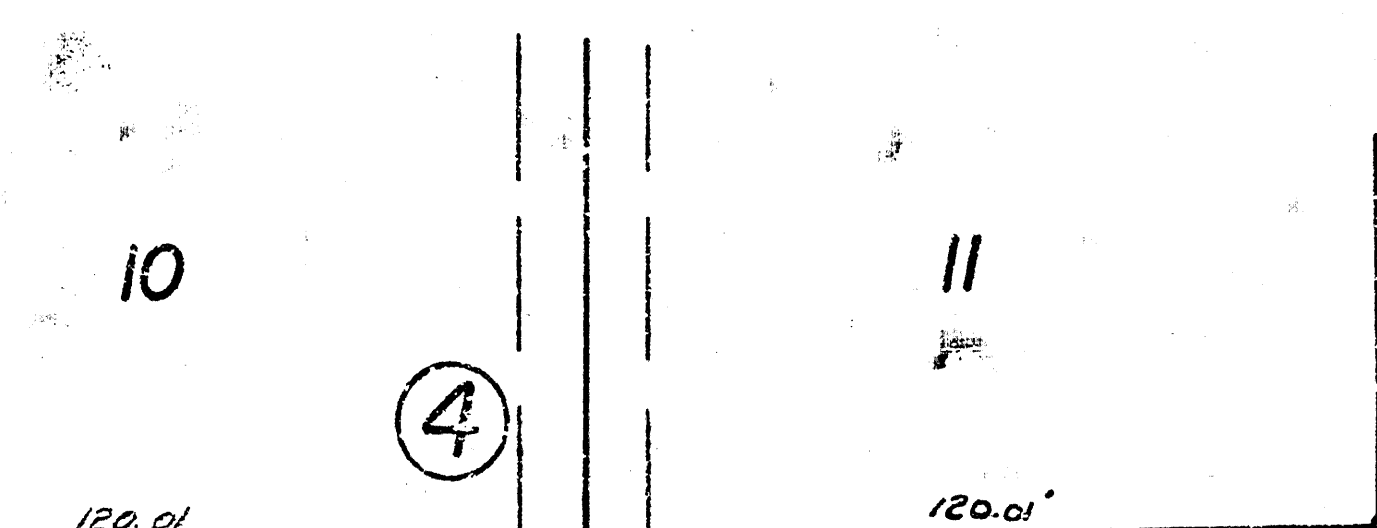

NANTUCKET

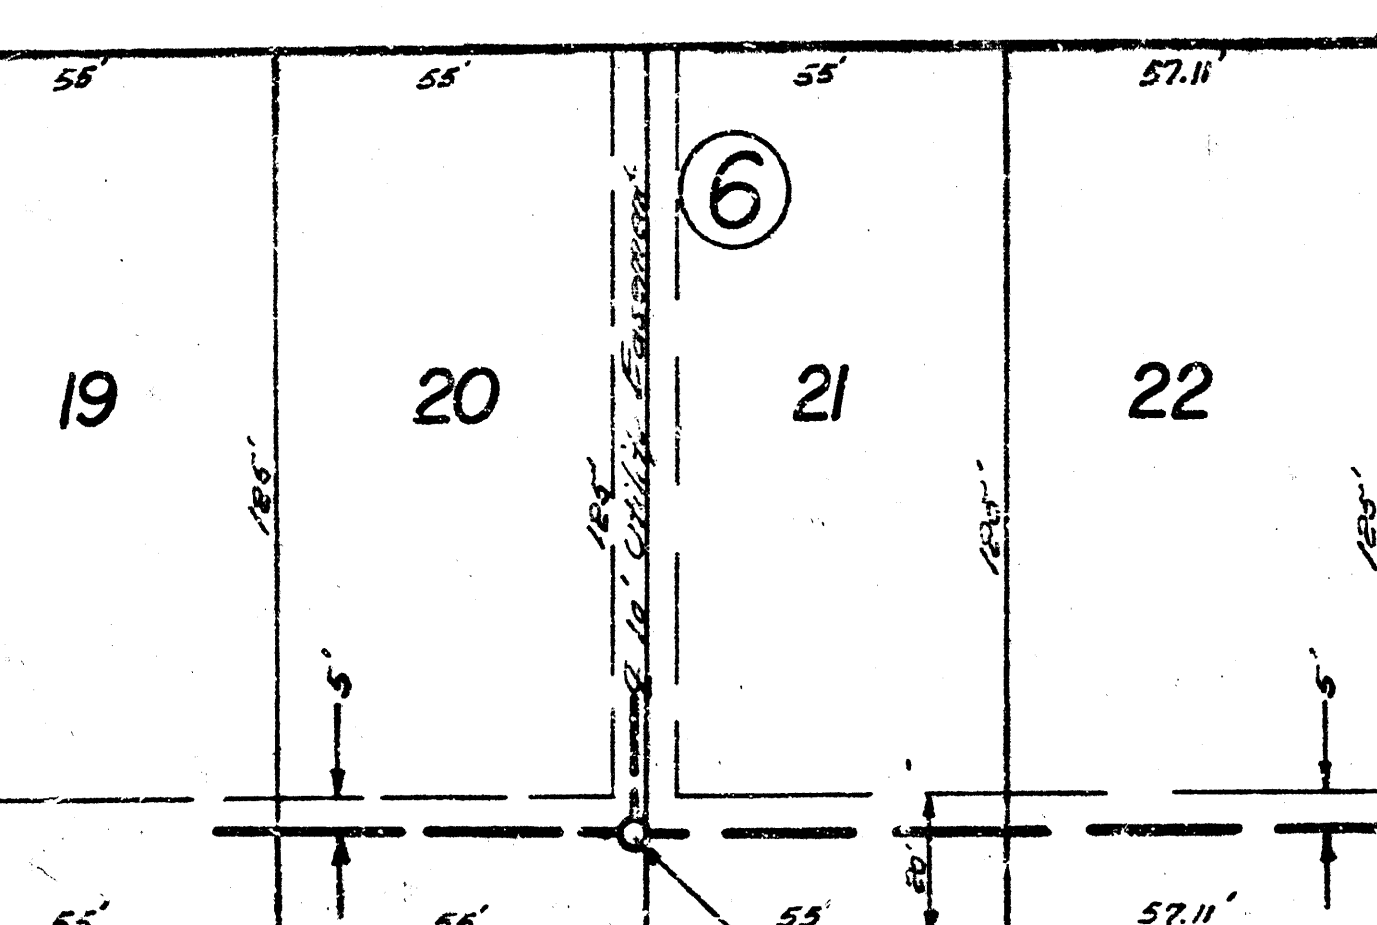


WESTGATE

Lot 48

②

19+32.0
Sta 19+32
Const. Std. M.H.
Type A or C

ROAD

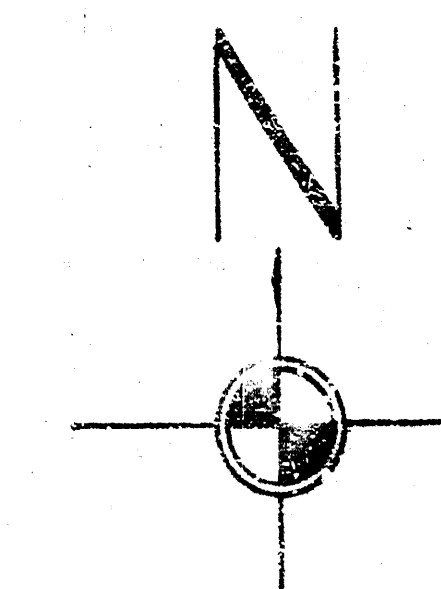

Plan Scale 1" = 40'
Profile Scale 1" = 40' Horiz.
1" = 5' Vert.

Sta 10+28
10+29.2
13TH

Sta 12+18
Const. Std. M.H.
Type A or C
12+18.2


Sta 14+08
Const. Std. M.H.
Type A or C
14+09.5

ST.

Sta 16+60
Const. Std. M.H.
Type A or C

S.E. Corner 50' Sec 7-27-1W



MAIZE

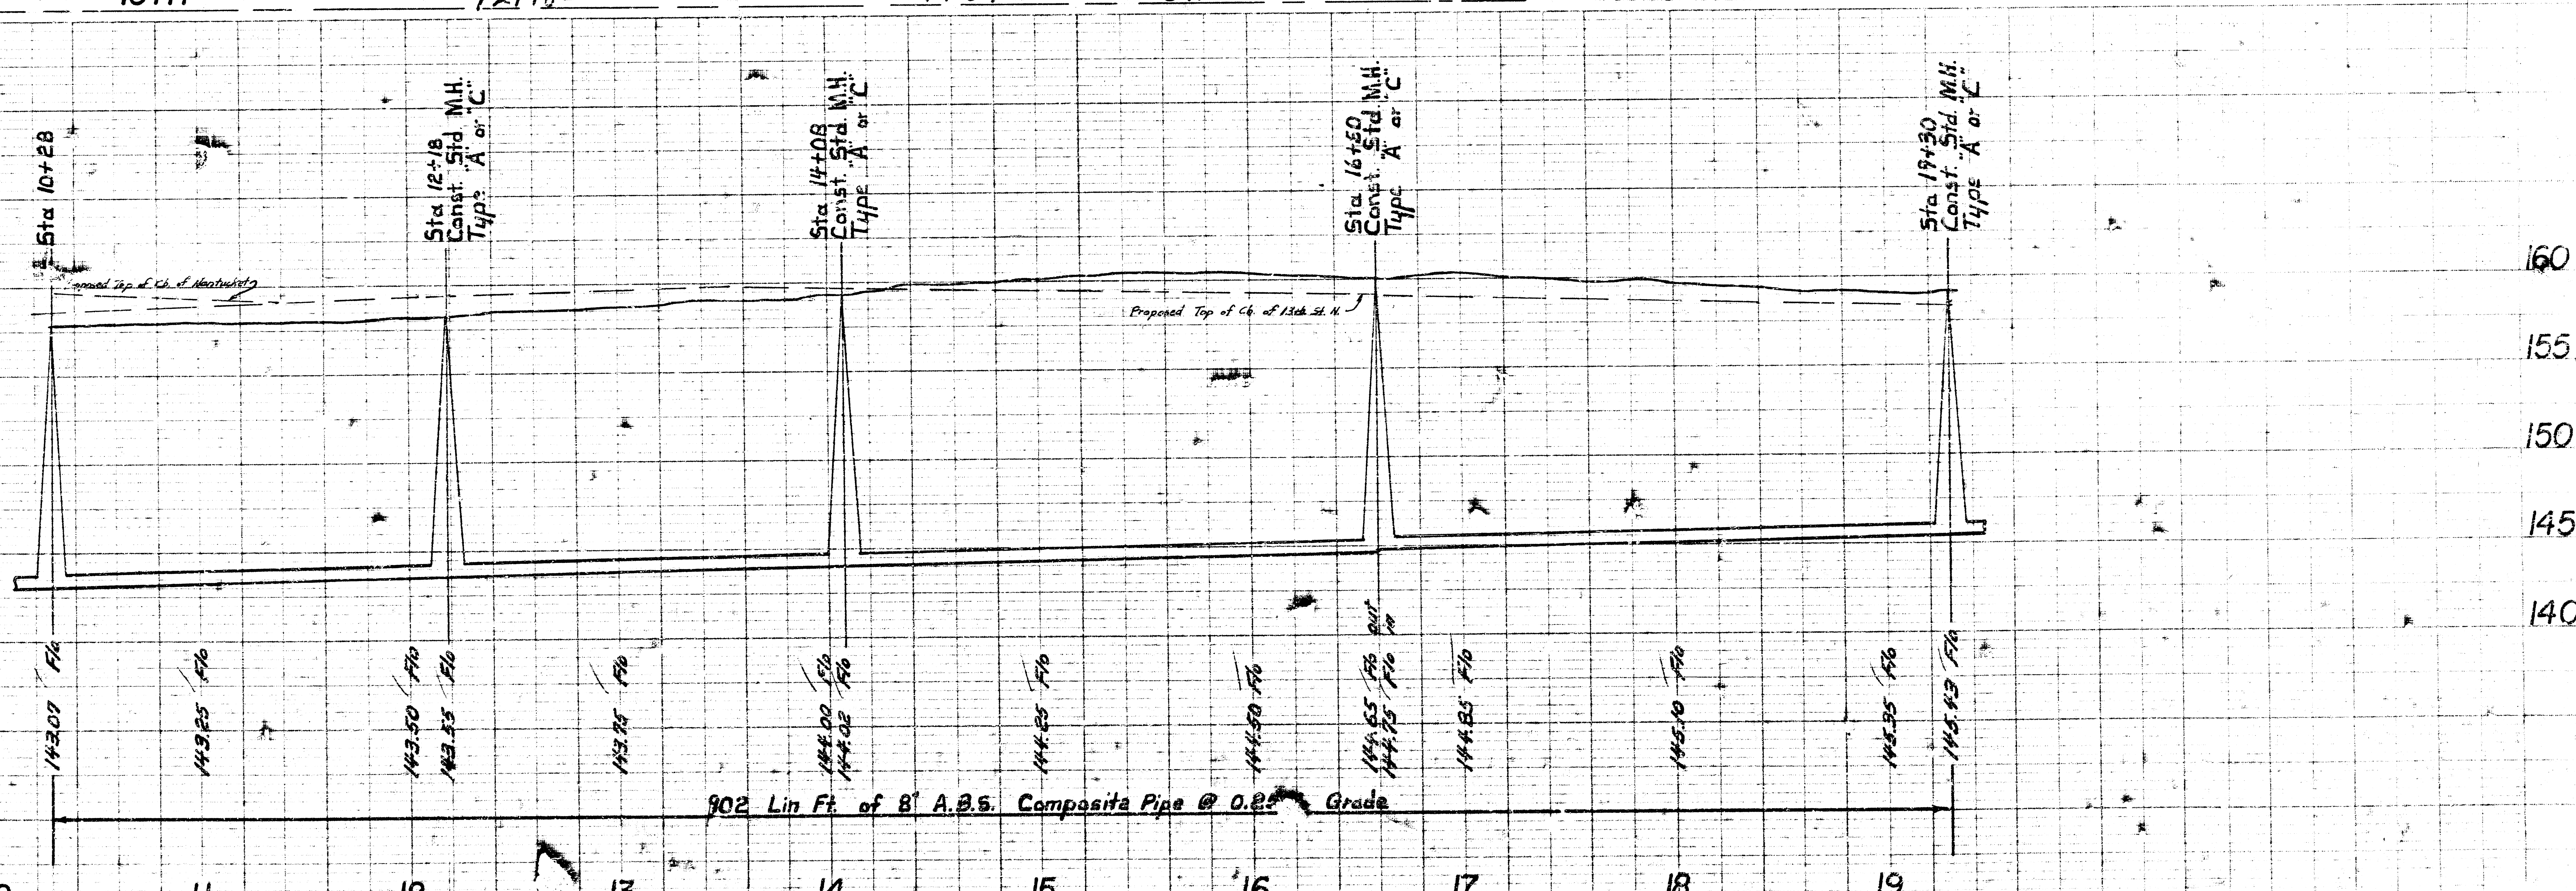


BM 158.84 R.R. Spike W. fc. PP E.S. Maize Rd. 8 Alamo

Plan Scale 1" = 40'
Profile Scale 1" = 40' Horiz.
1" = 5' Vert.


Note: For Profile on Line IE See Sheet 9

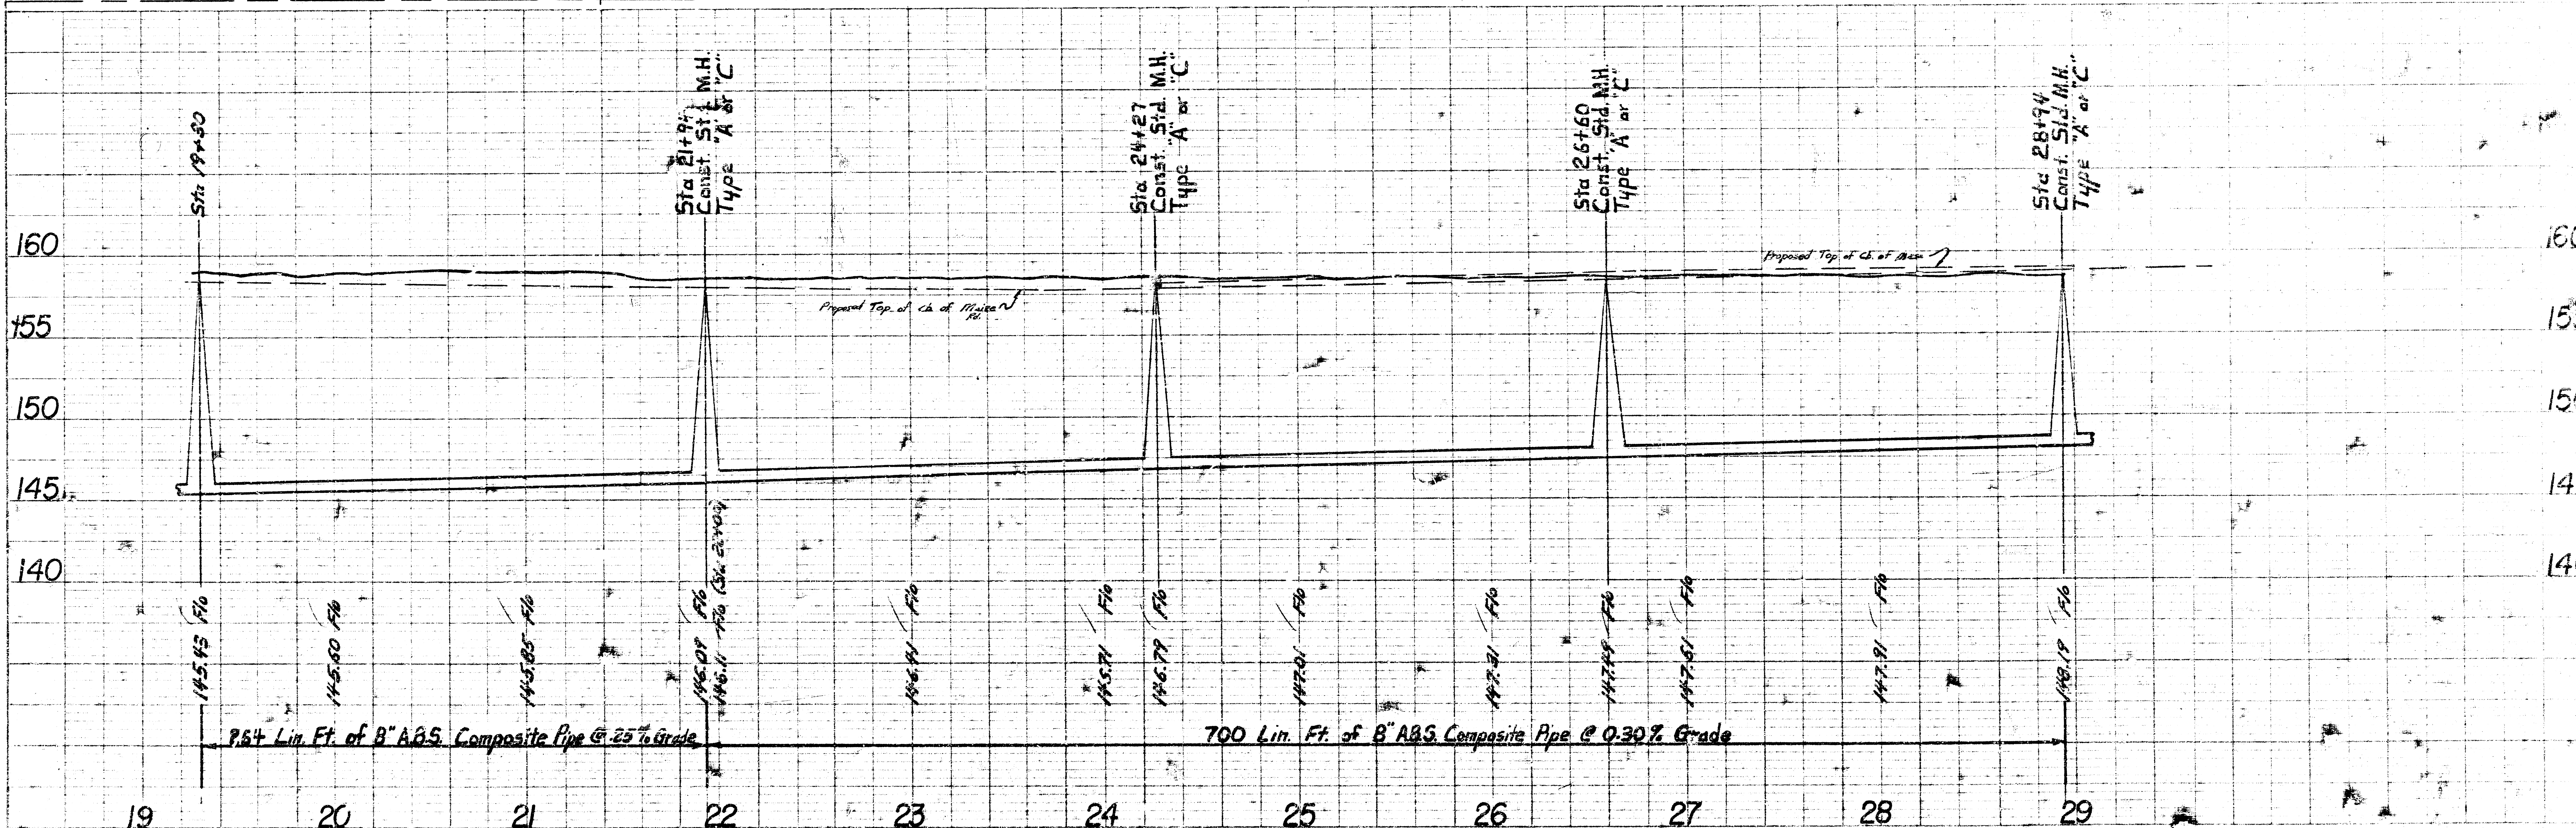
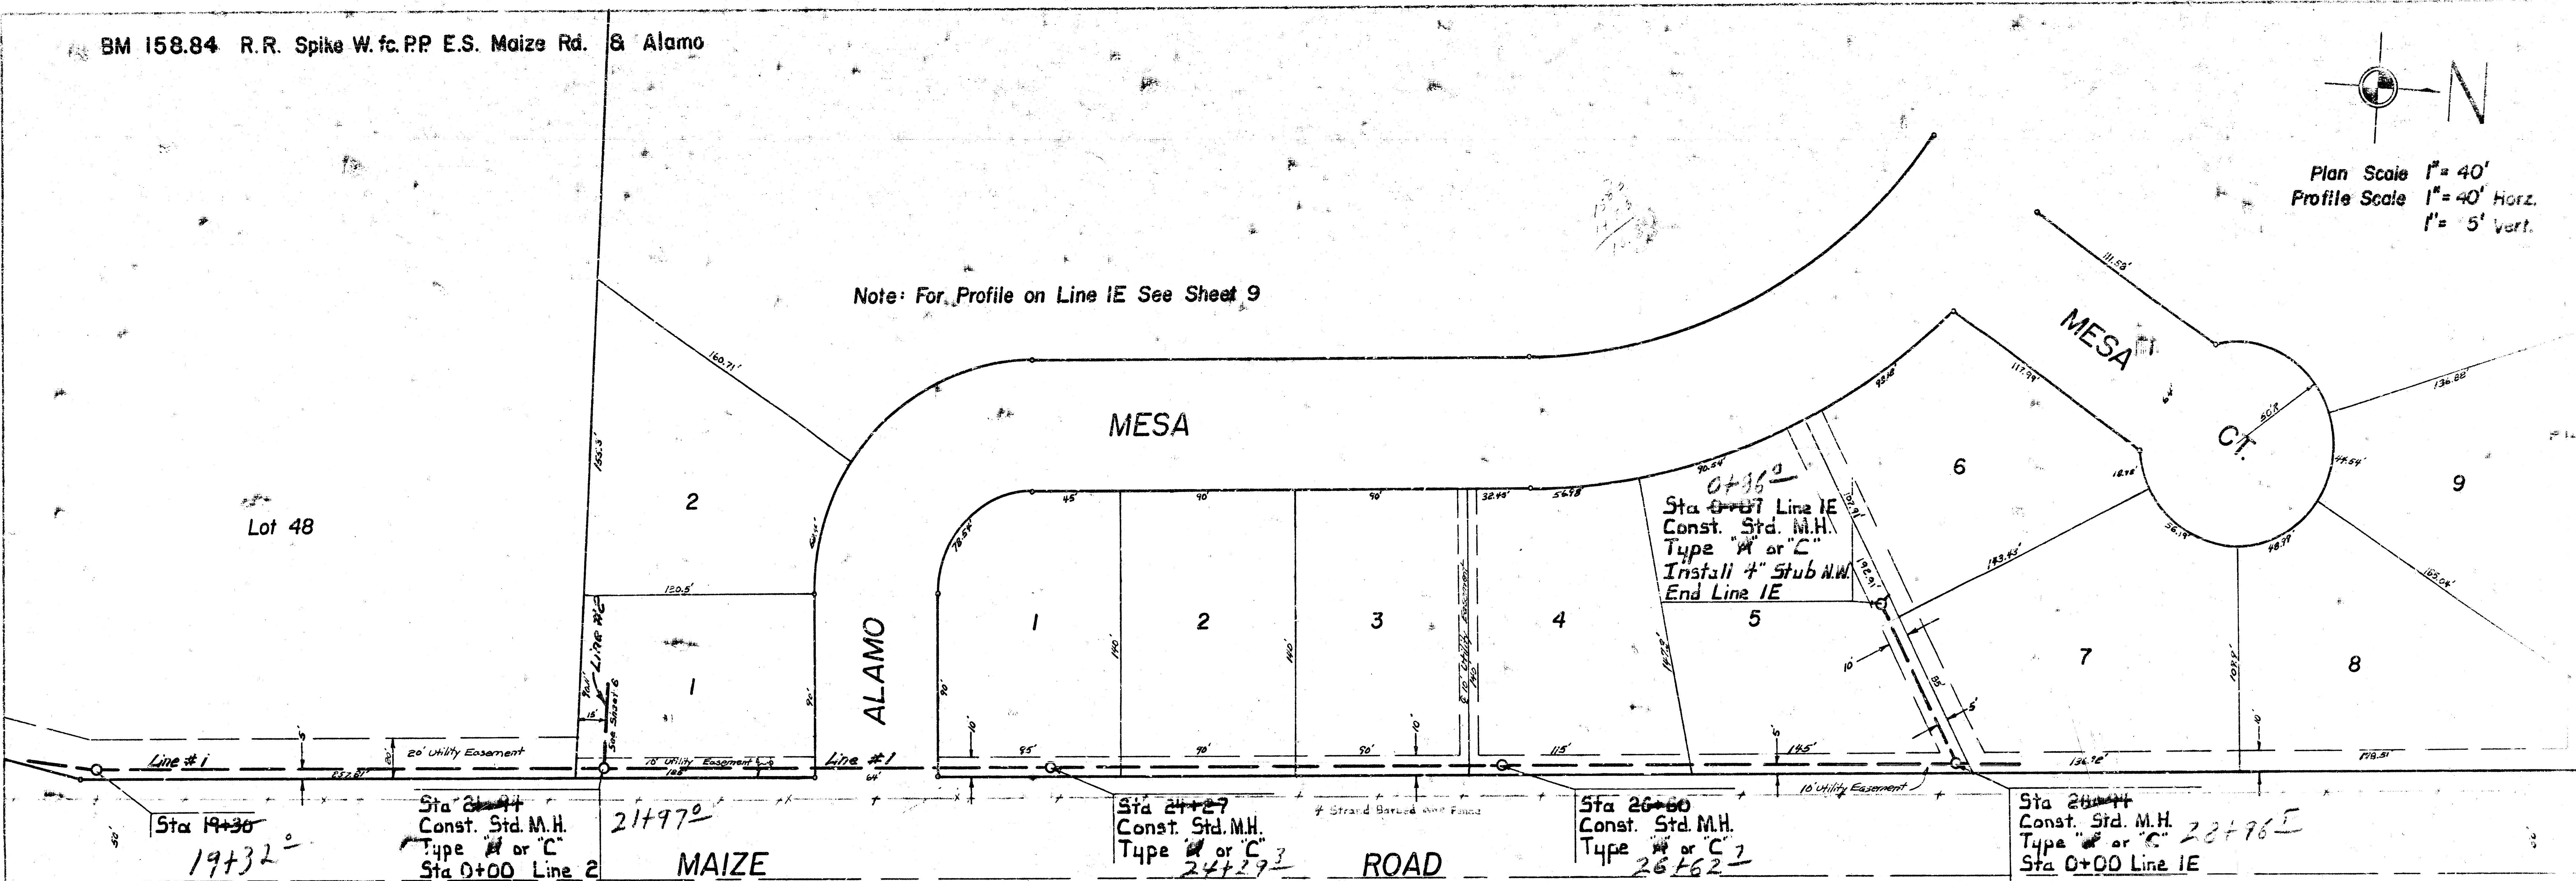


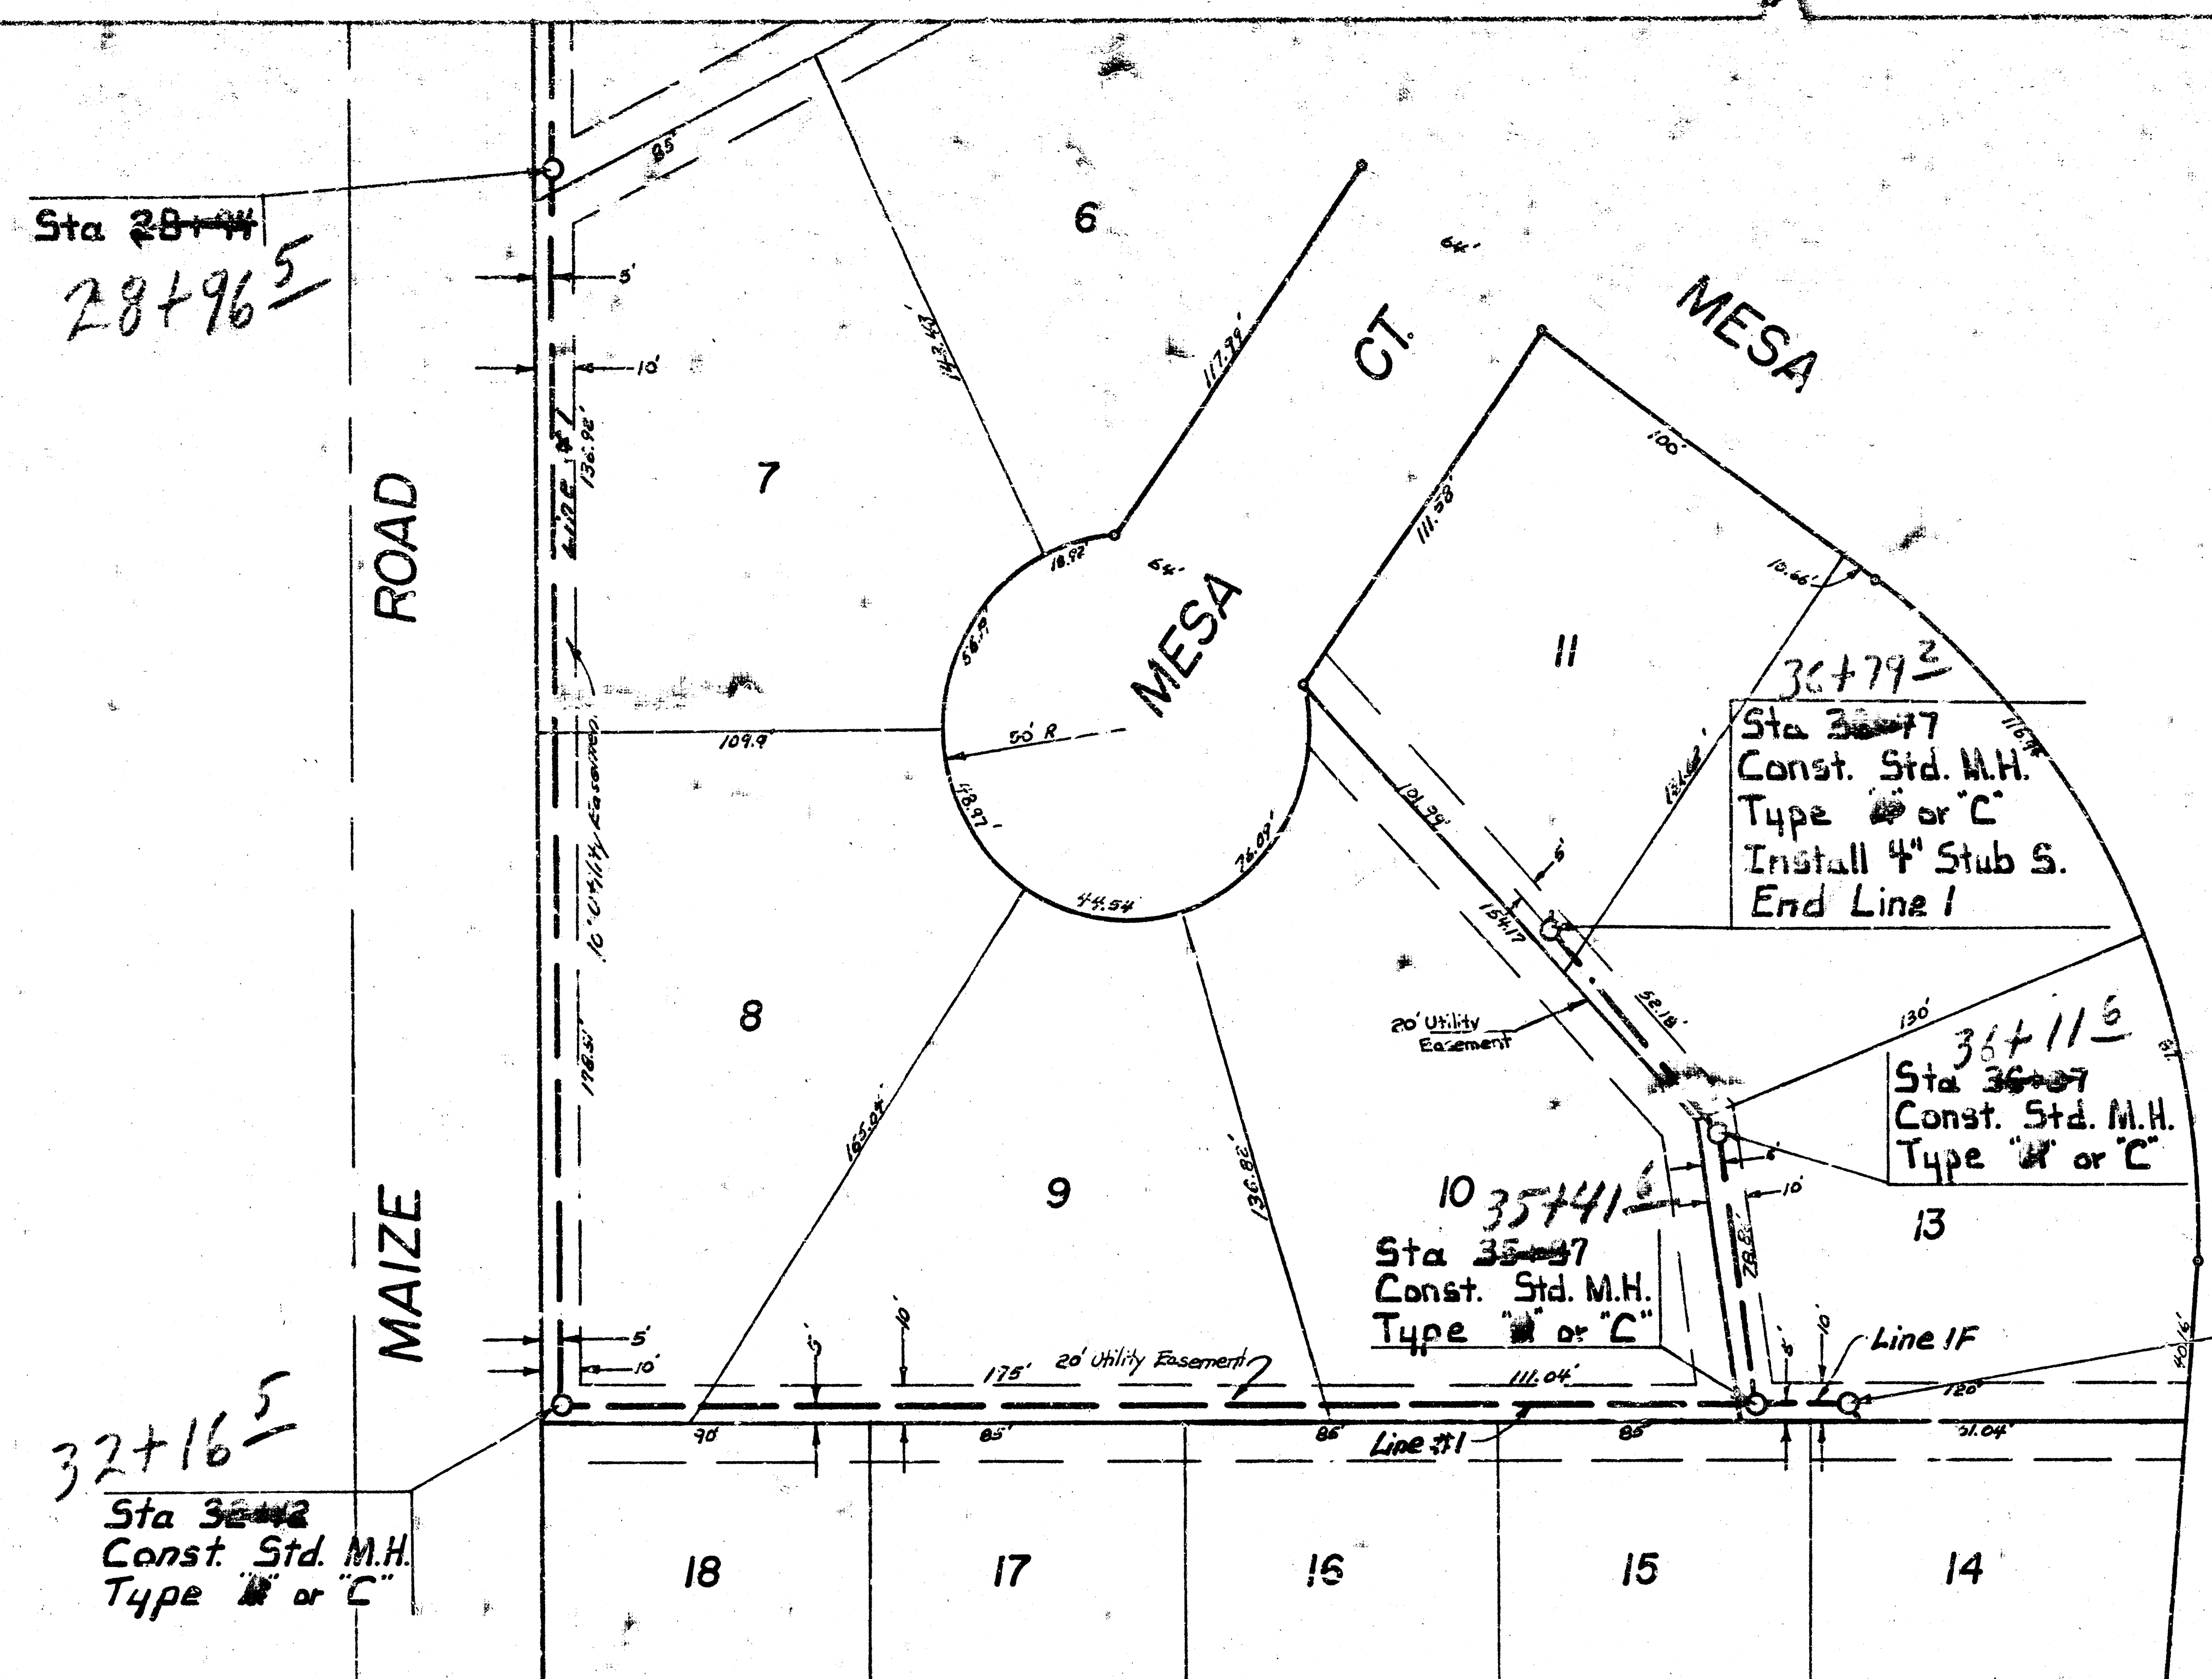



Plan Scale 1" = 40'
 Profile Scale 1" = 40' Horz.
 1" = 5' Vert.

Note: For Profile on Line IF See Sheet 9

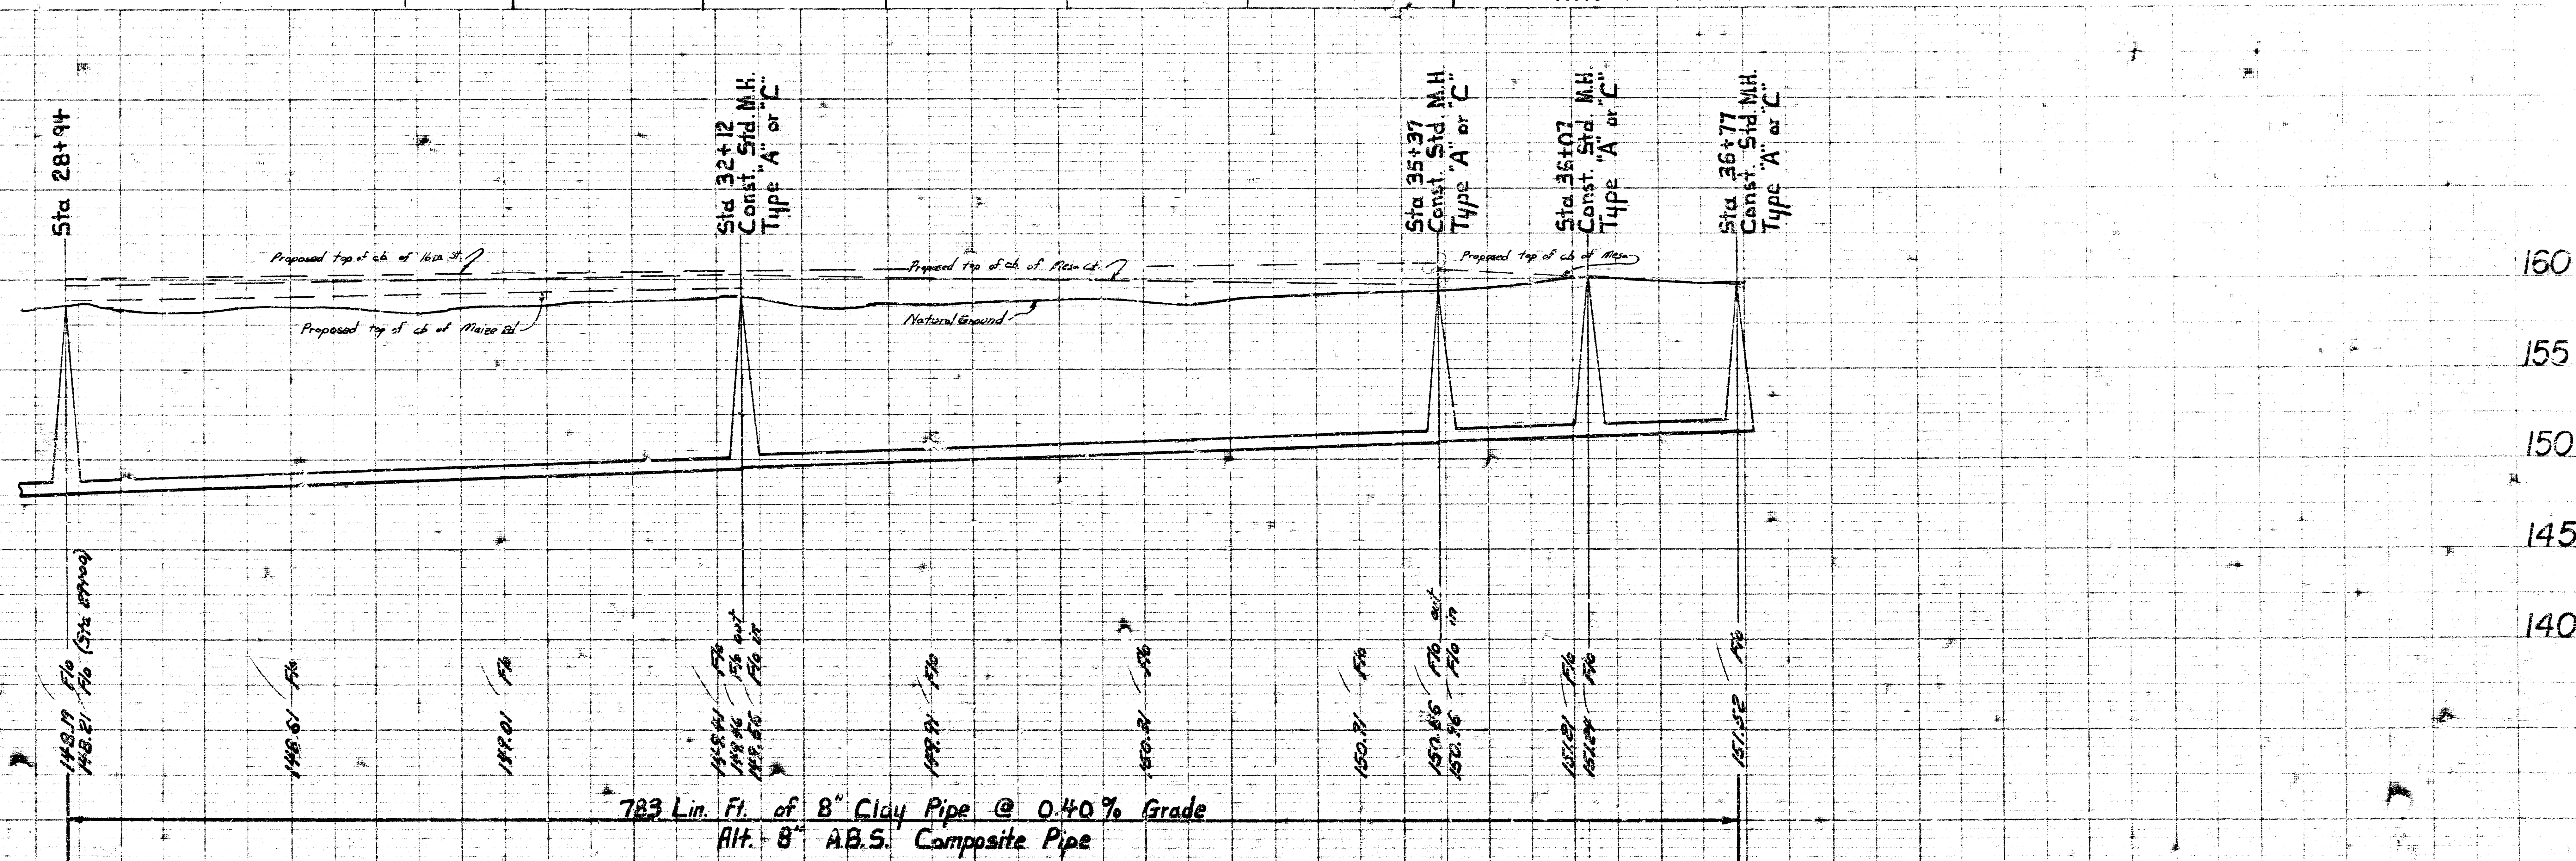


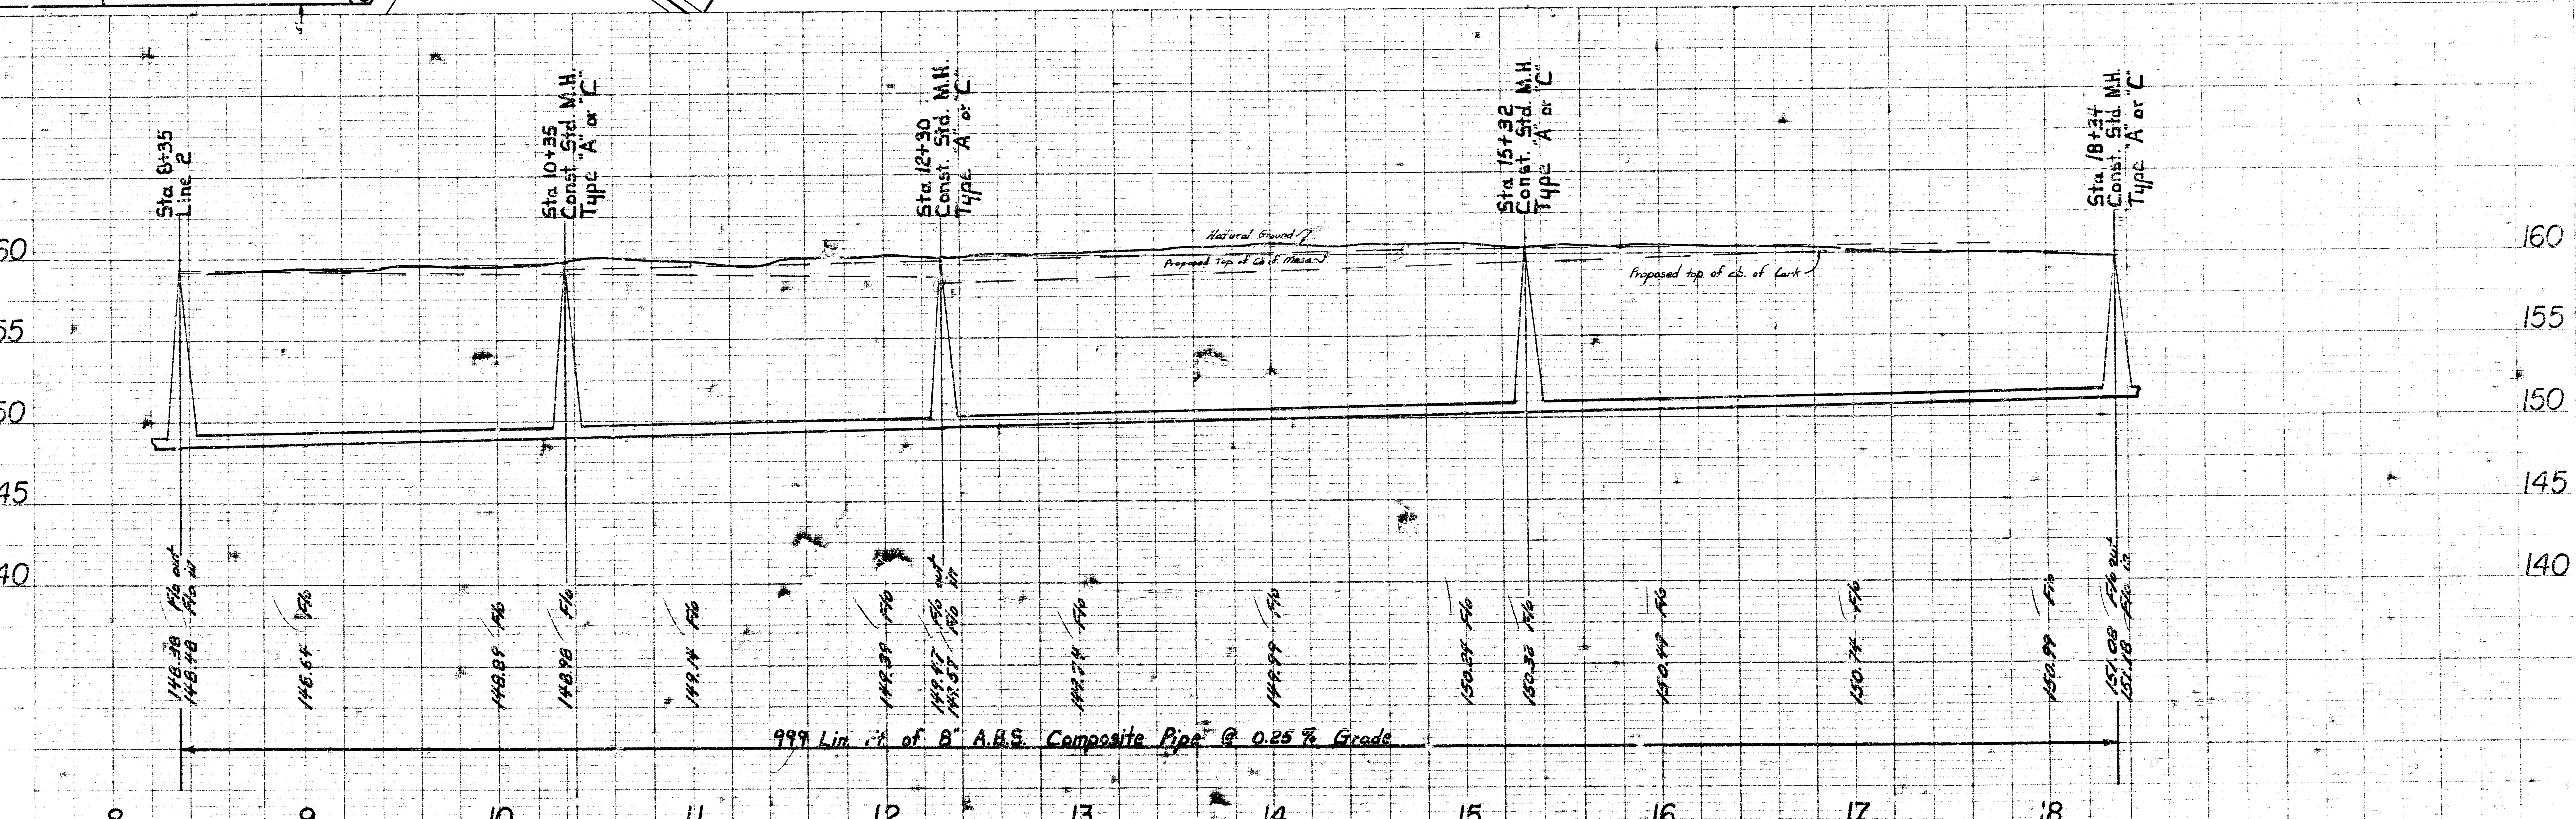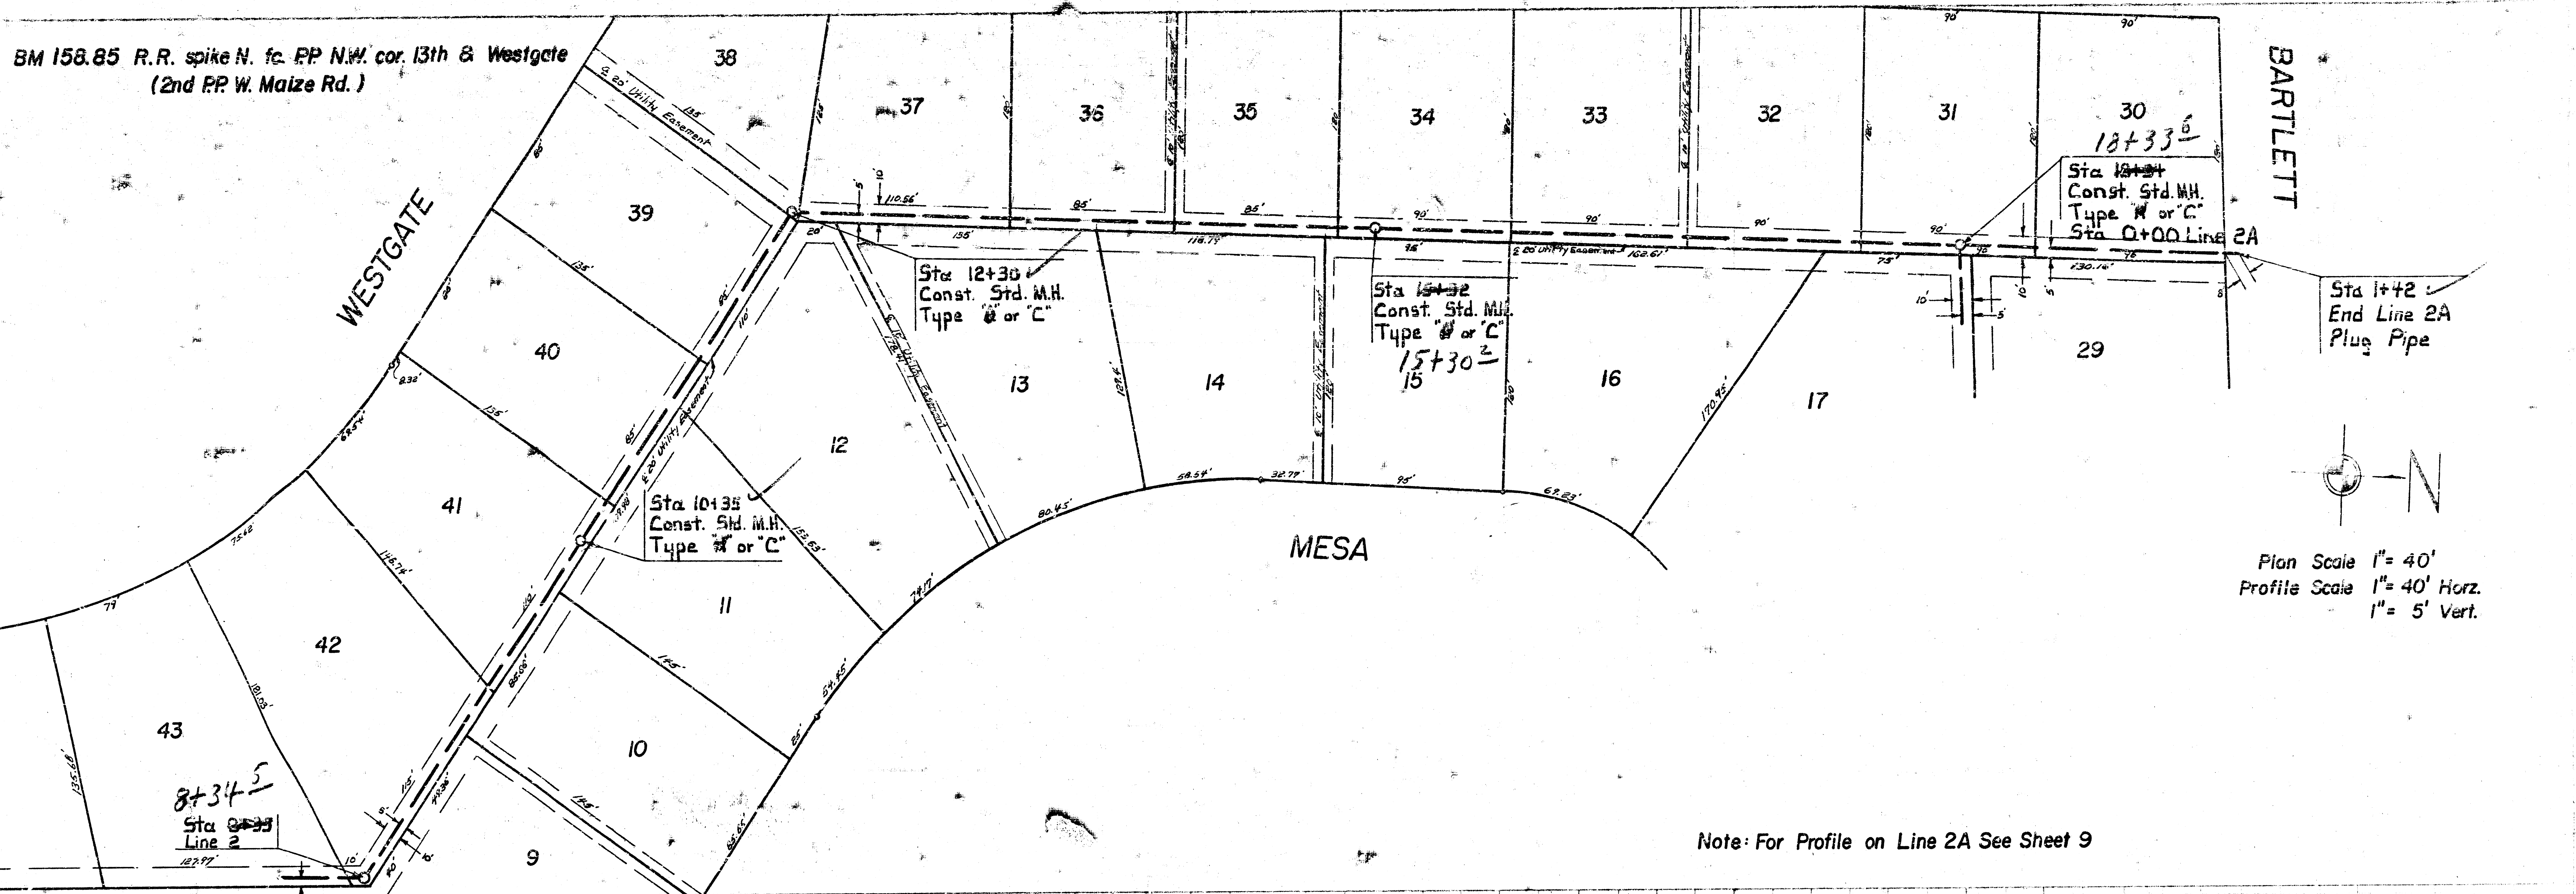

Note: For Profile on Lines 2B and 2C See Sheet 9

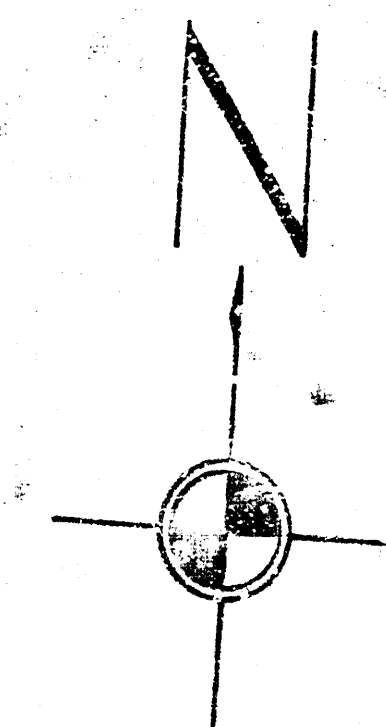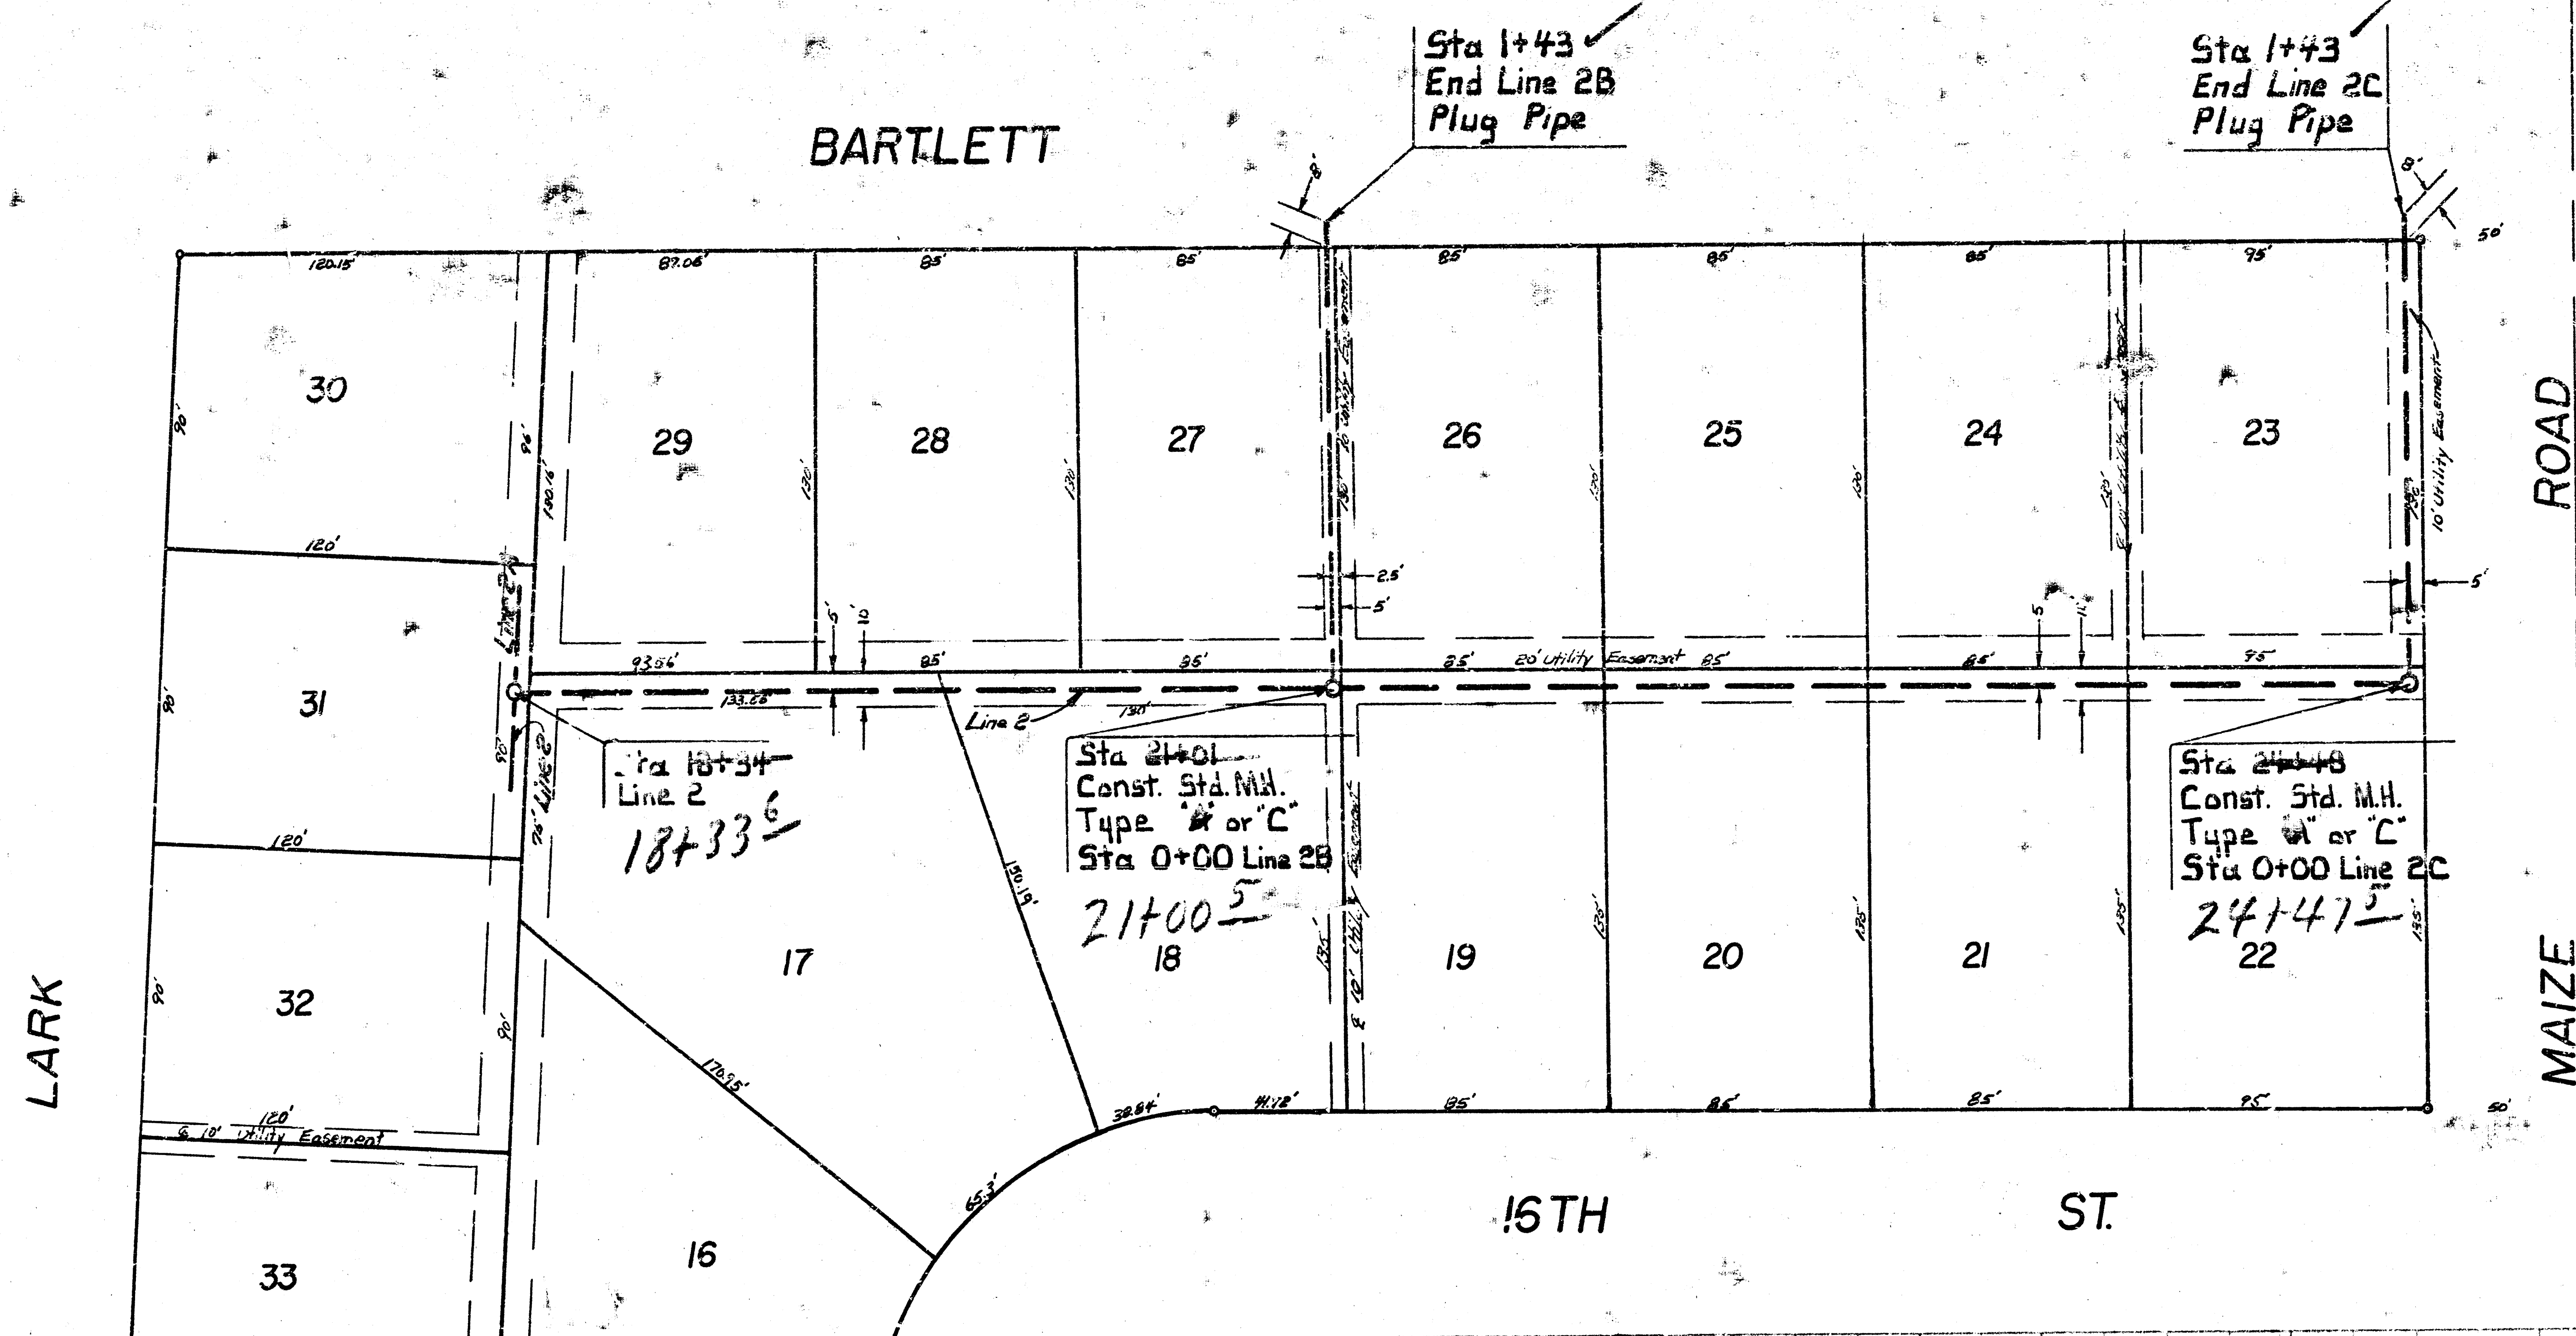

Plan Scale 1" = 40'
 Profile Scale 1" = 40' Horz.
 1" = 5' Vert.

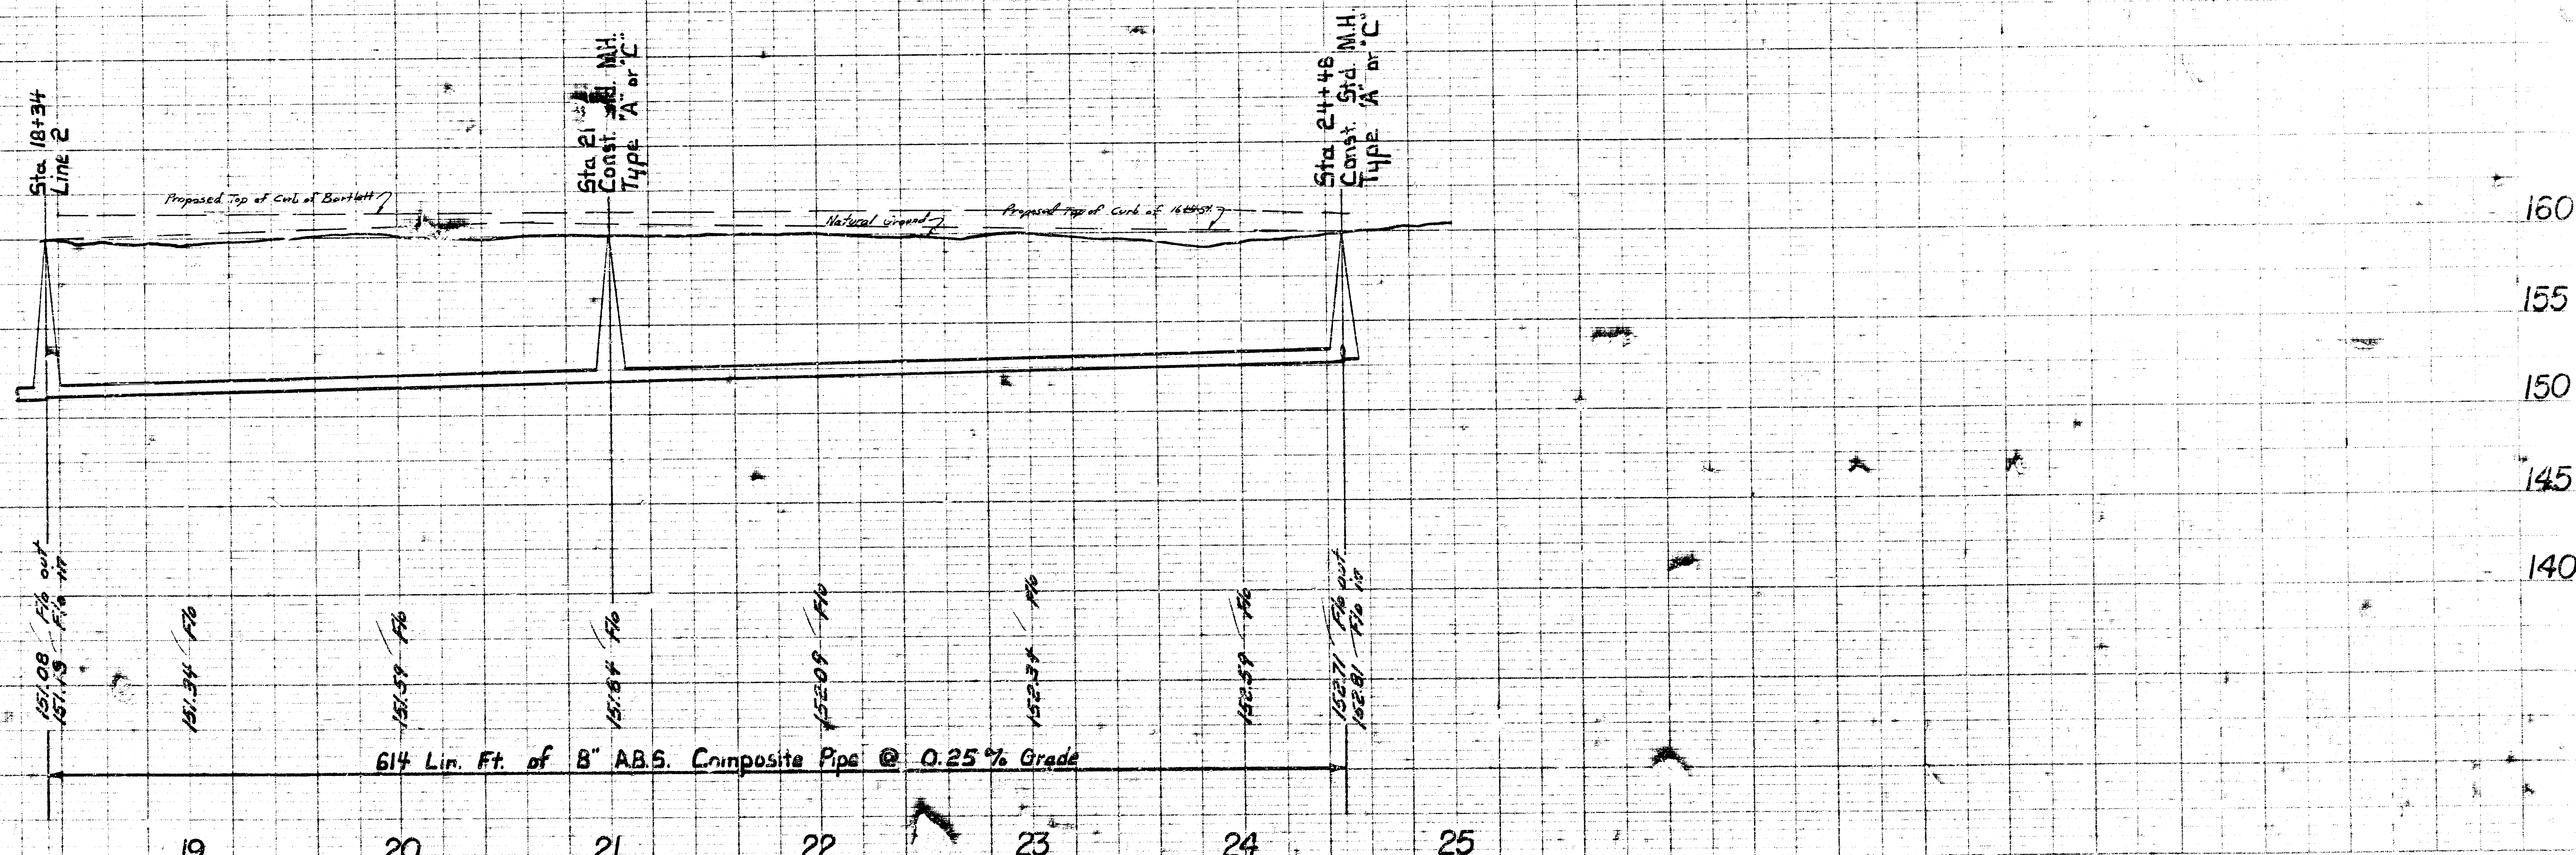

BM 158.26 R.R. spike W. fc. PP S.S. arrive to Resurrection Cemetery & E.S. Maize Rd.
 BM 157.04 R.R. spike N. fc. PP approx 200' S & 100' W of NW cor Nantucket & Lark
 (4th PP W. Maize Rd.)

