

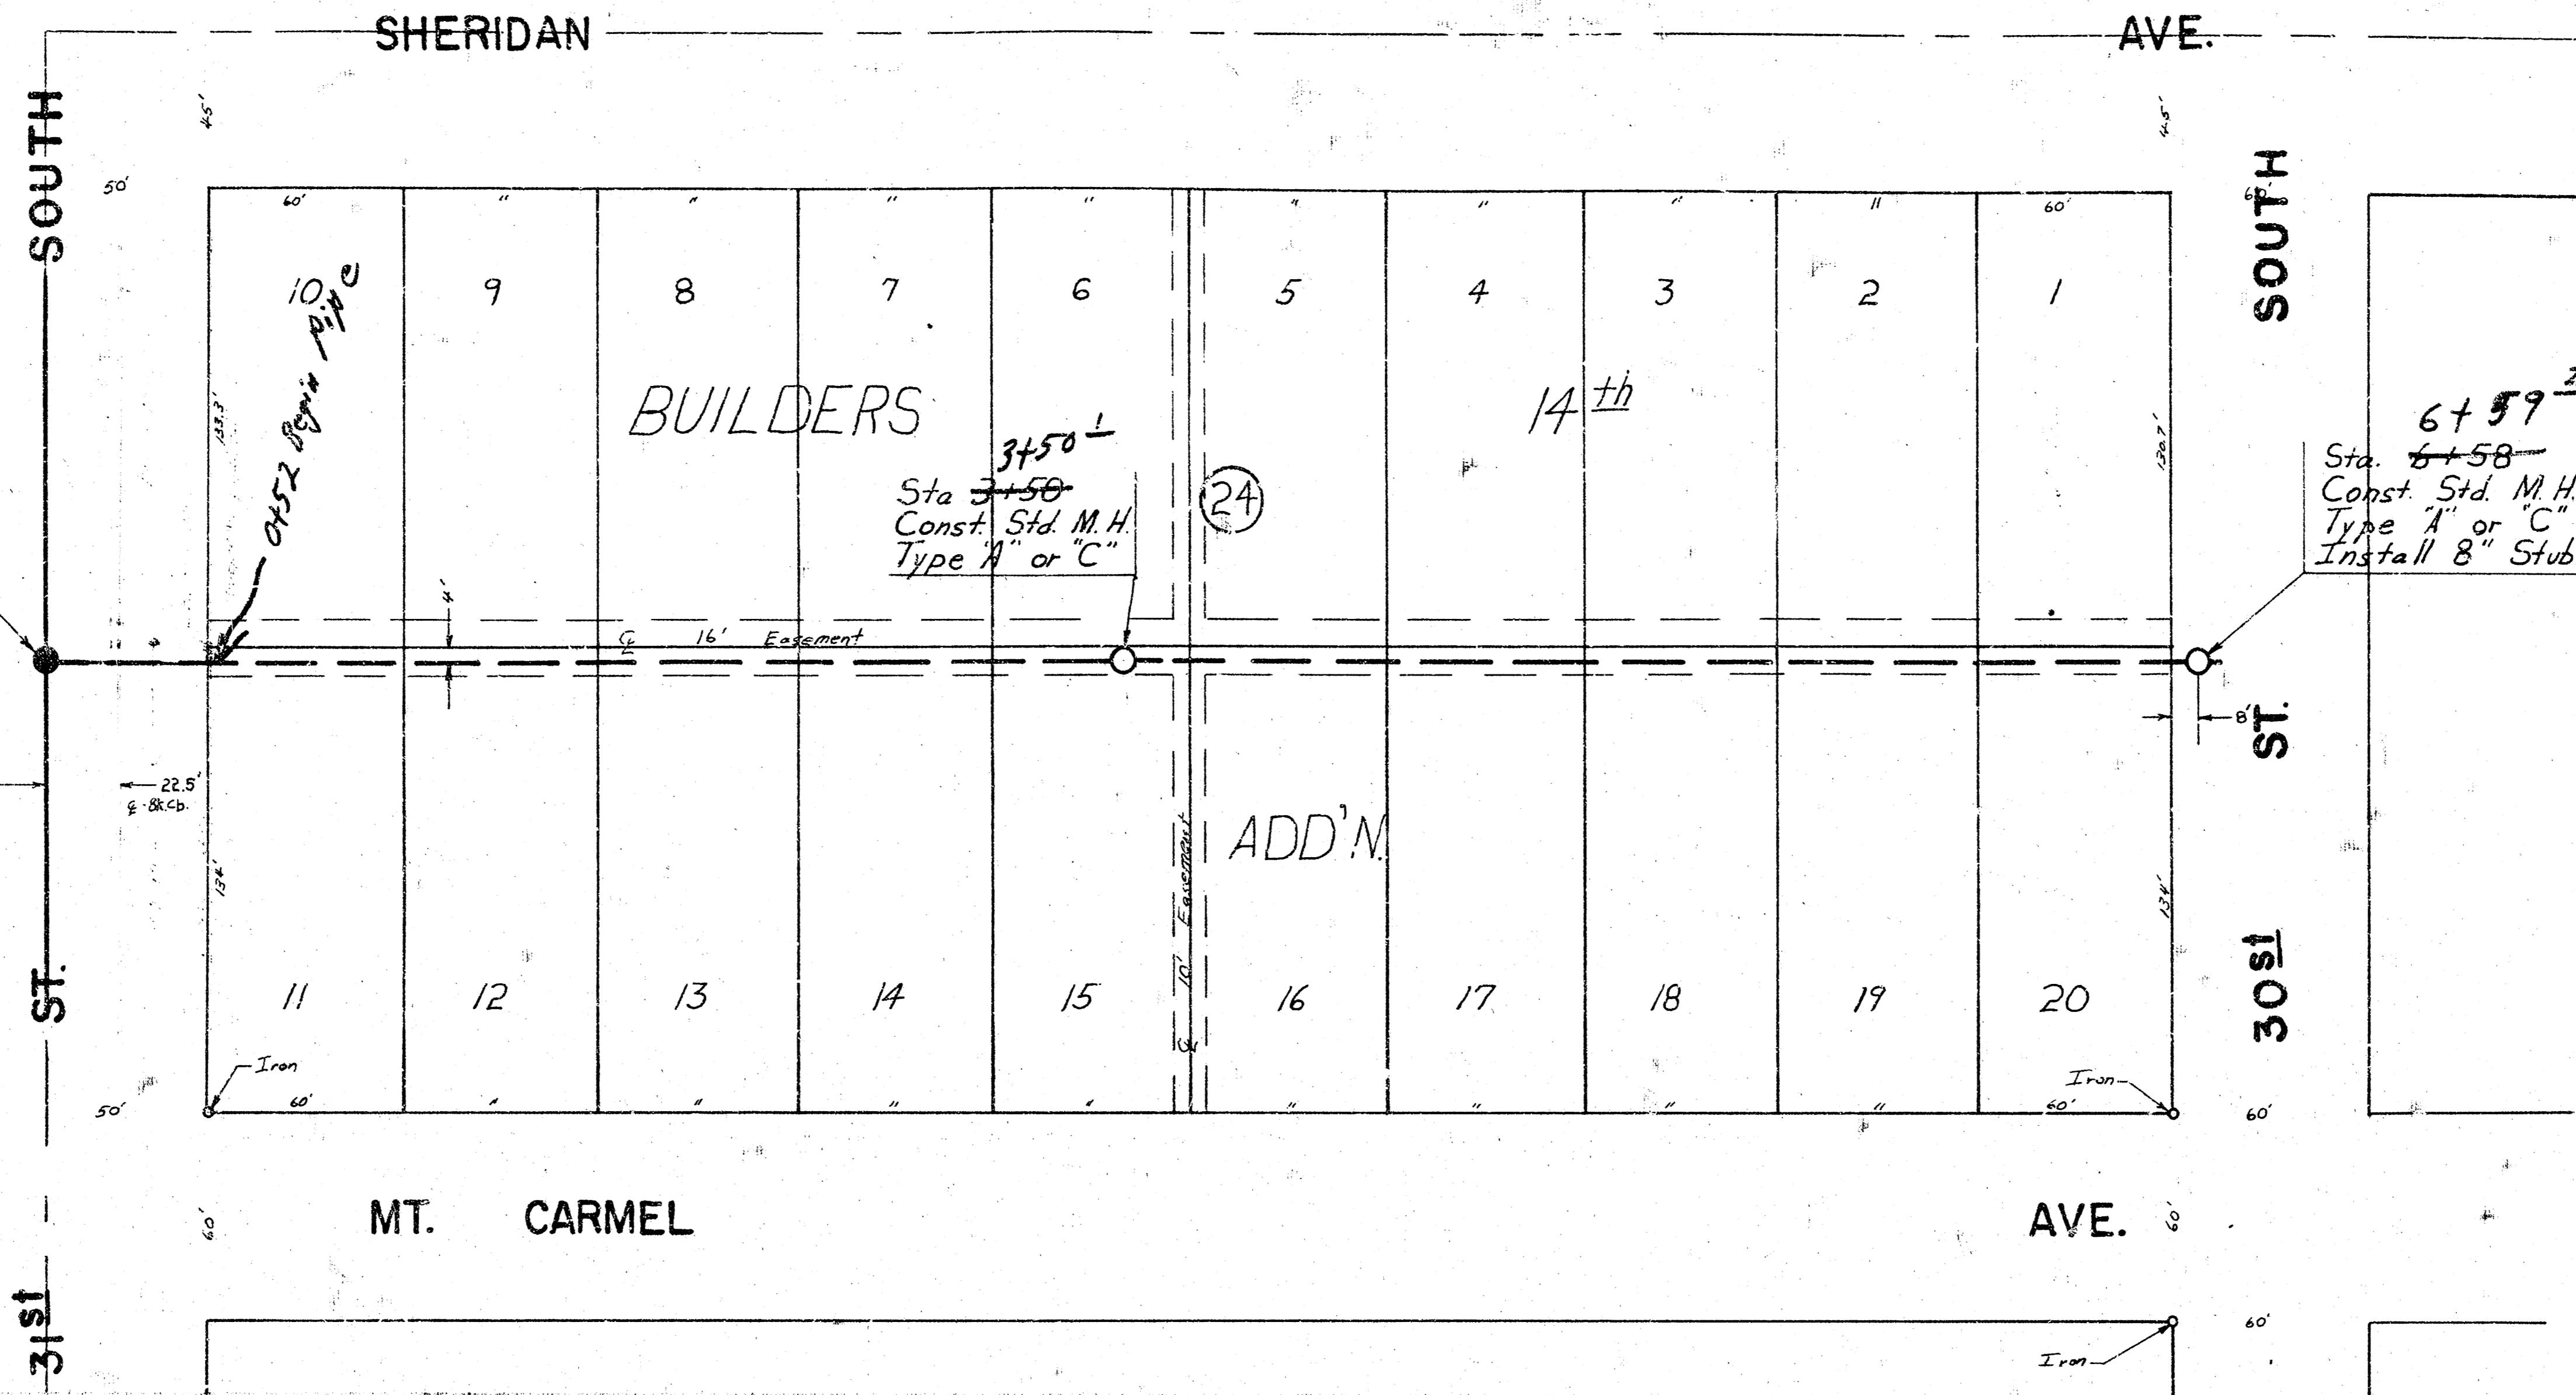


BM 103 City Sid Top East End Handrail  
to Roof Conc. Box at Sheridan & 31st

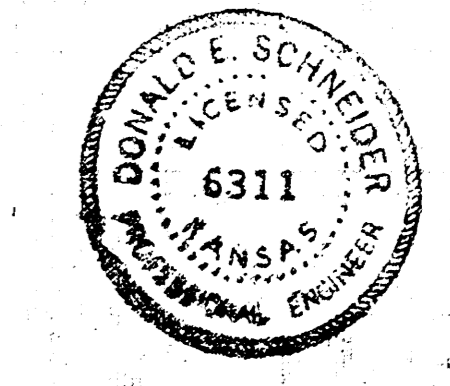

Plan Scale 1" = 40'

Profile Scale 1" = 40' Horz.  
1" = 5' Vert.

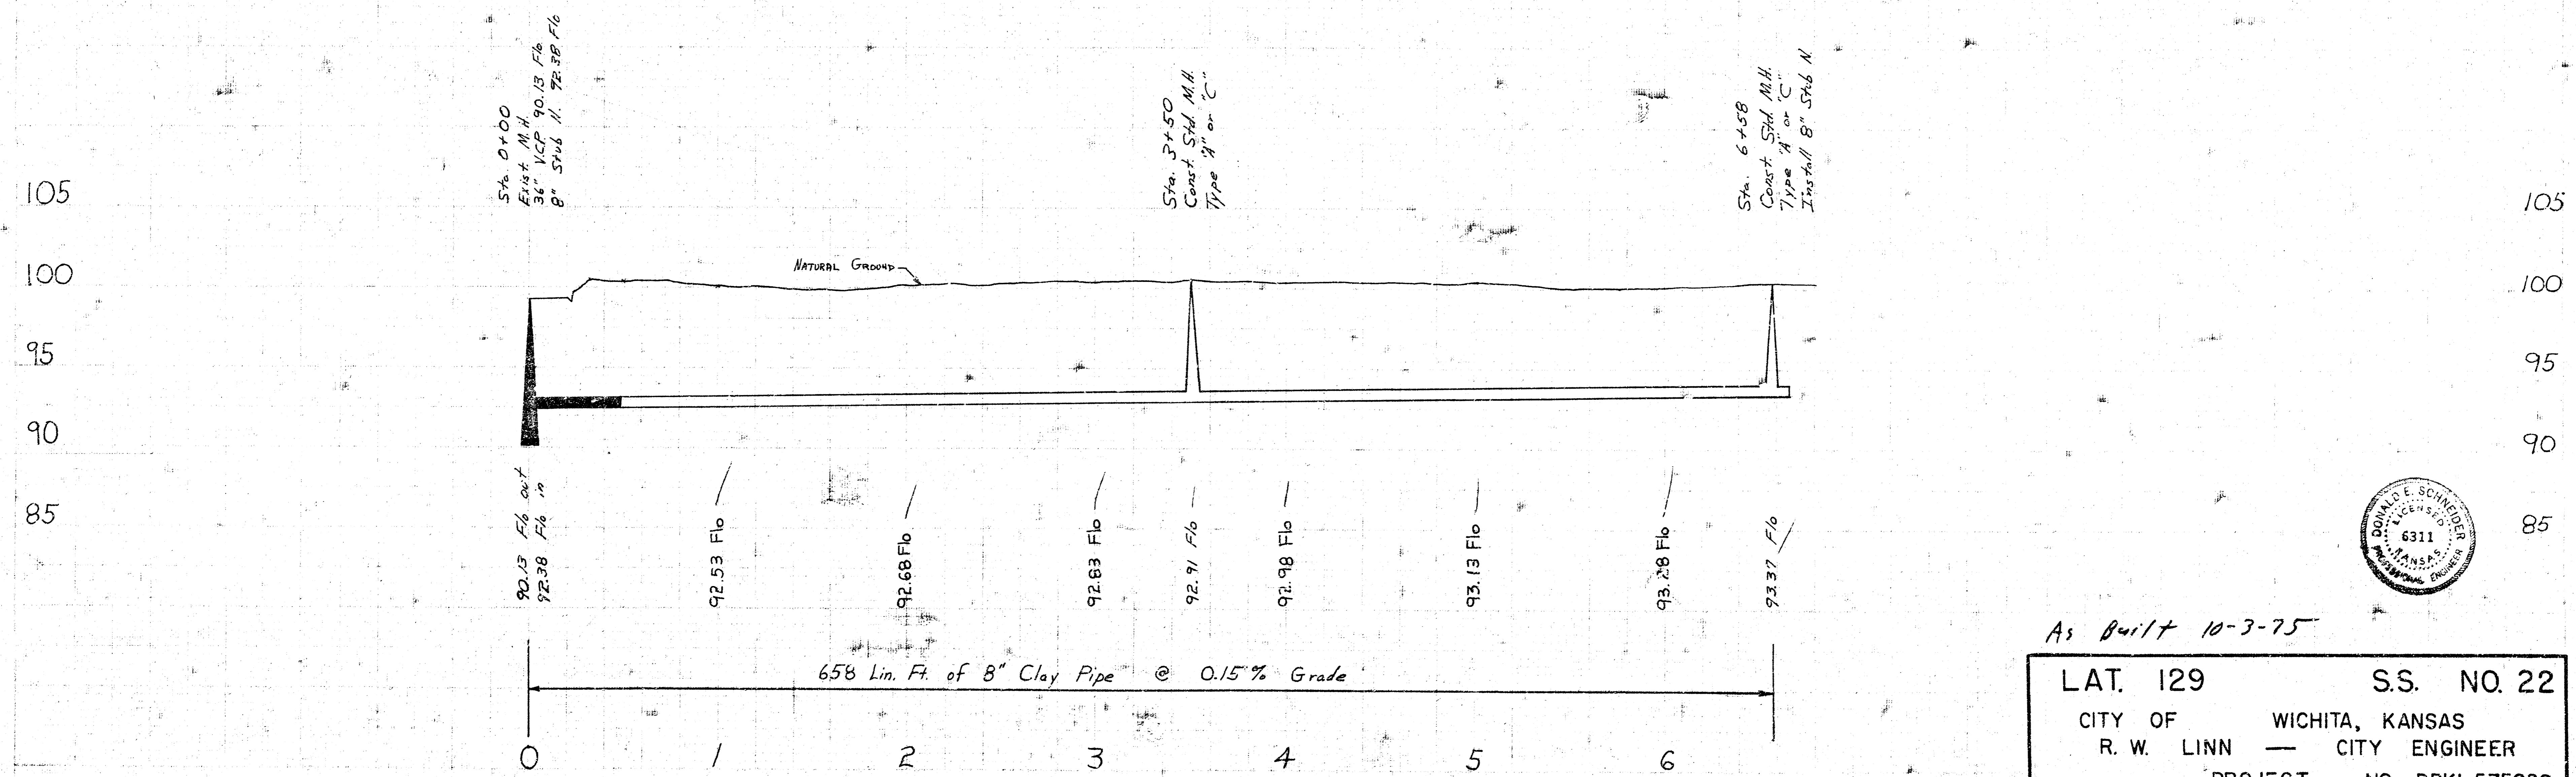

As Built 10-3-75

LAT. 129 S.S. NO. 22

CITY OF WICHITA, KANSAS

R. W. LINN — CITY ENGINEER

PROJECT NO. DBKL575029