

10-80


J. Lindsey

10-80

D. Dallas
J. Lindsey


10-00 DT

CAUTION
UNDERGROUND
UTILITIES
Please check with K & E or
Southwestern Bell
Telephone Co. for Location.

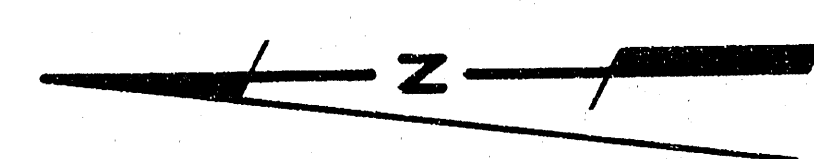


Scale: 1" = 40' Plan
Horz. 1" = 40' Profile
Vert. 1" = 5'


© - Irons -

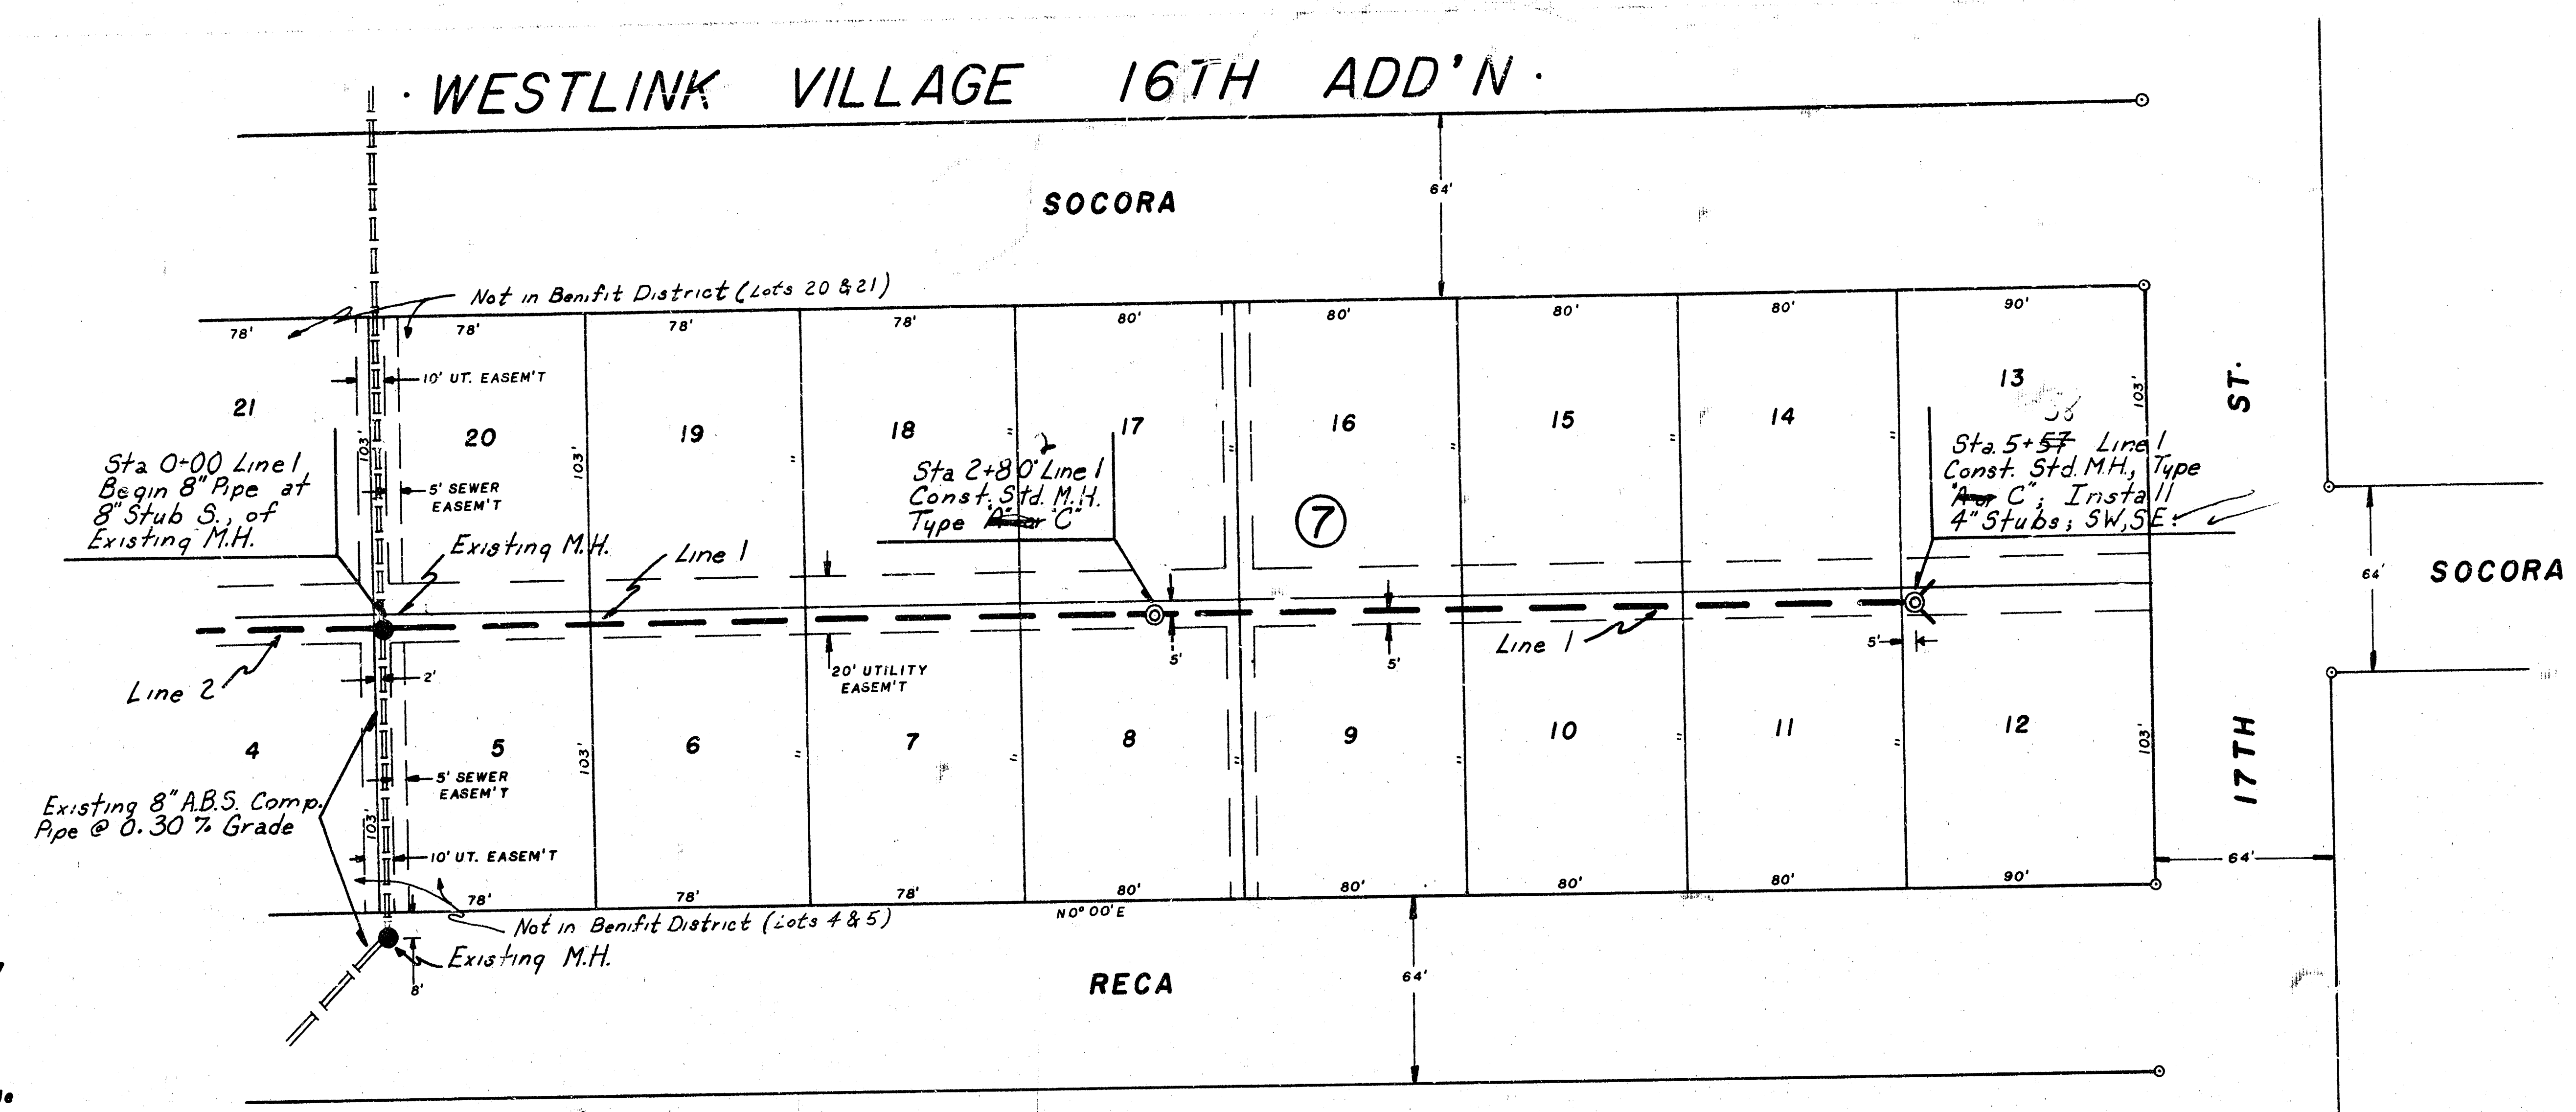

B.M. 172.479 - City Std. Disc, 31' S. & 36' E.
of 1/4 Sec. Corner; TYLER RD.
& 17TH ST. N.

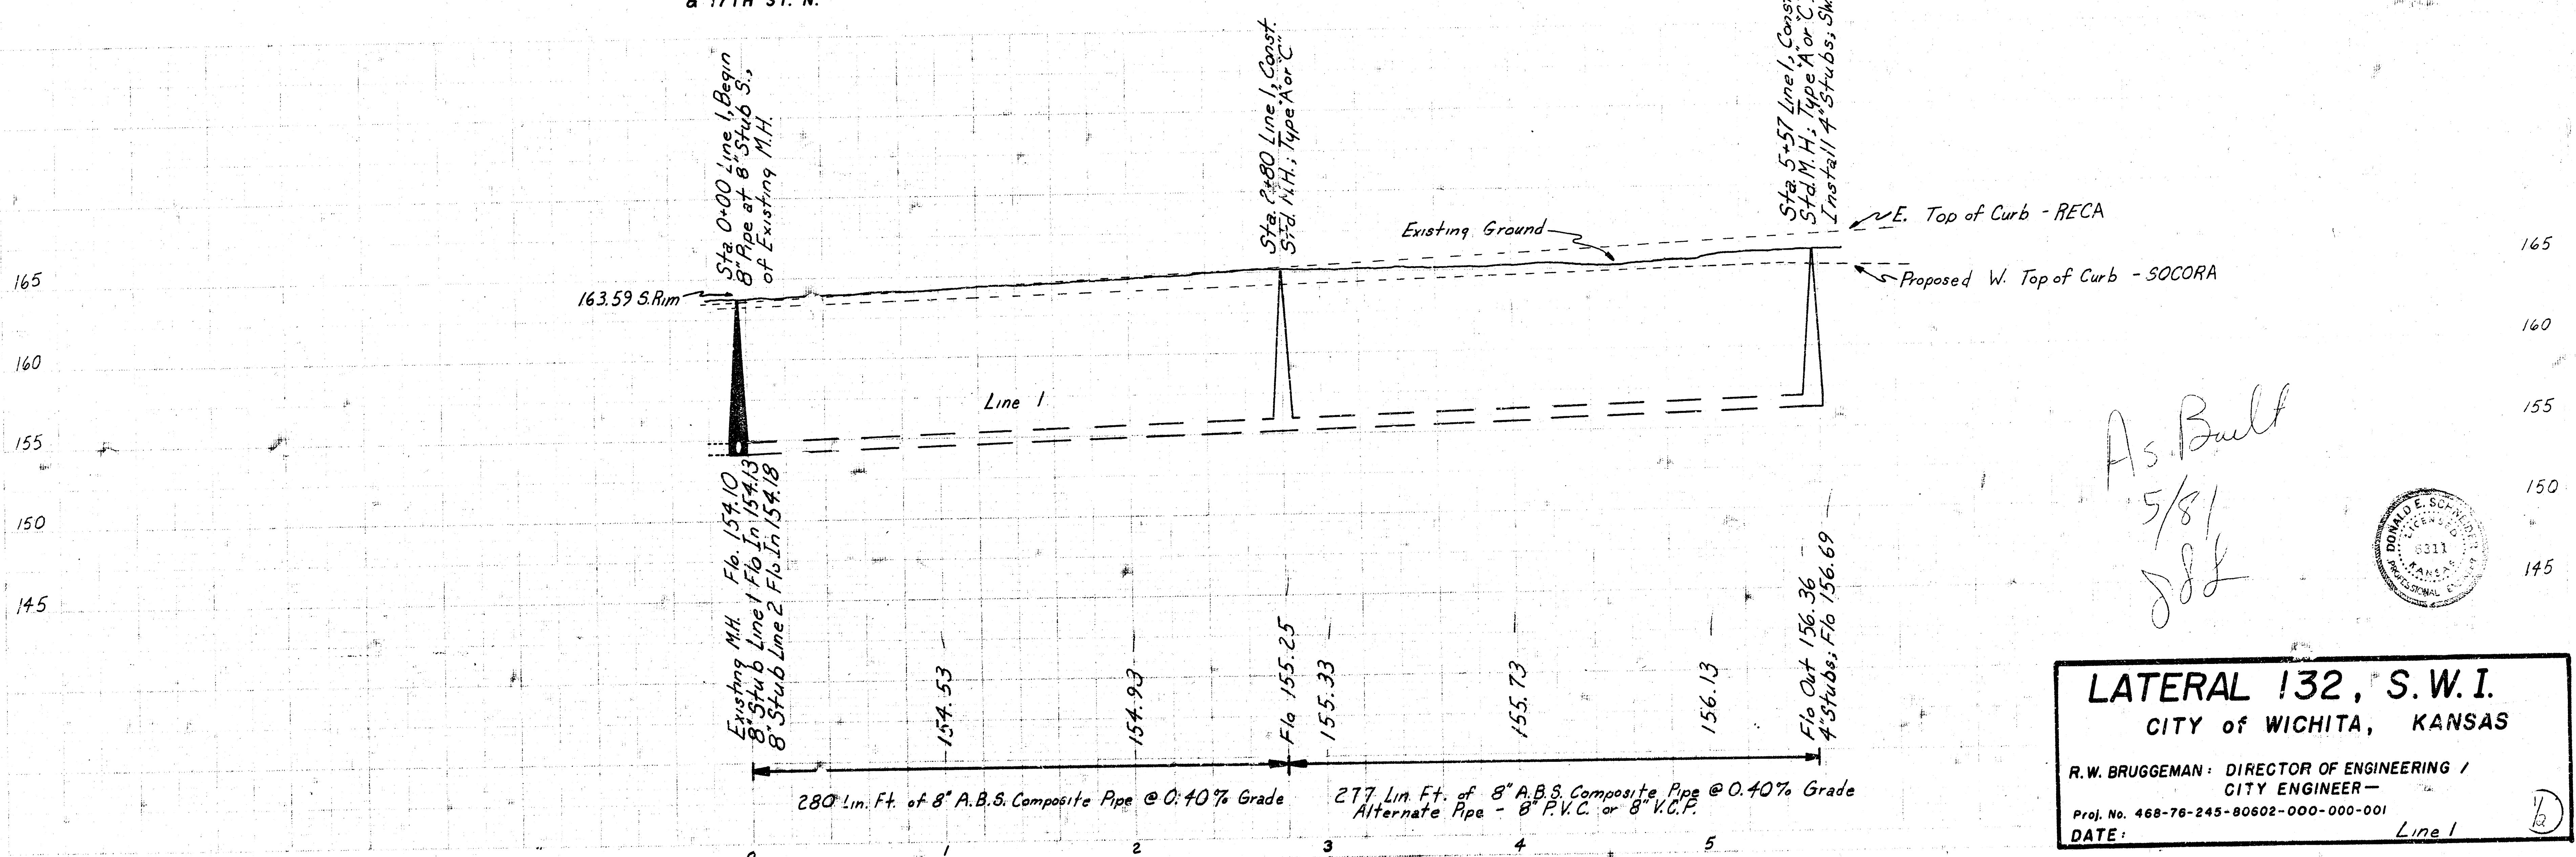

As Built
5/81
JSL

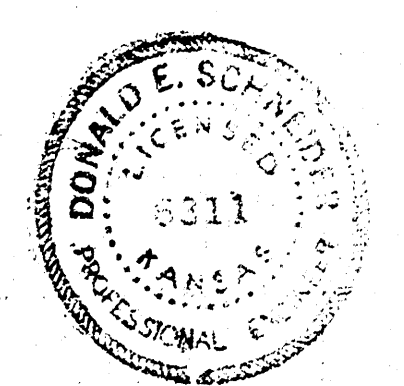

LATERAL 132, S.W.I.
CITY OF WICHITA, KANSAS
R.W. BRUGGEMAN: DIRECTOR OF ENGINEERING /
CITY ENGINEER -
Proj. No. 468-76-245-80602-000-000-001
DATE: _____ Line 1

9-80
J. Lindsey

9-80
J. Lindsey

D.C.D.M

