

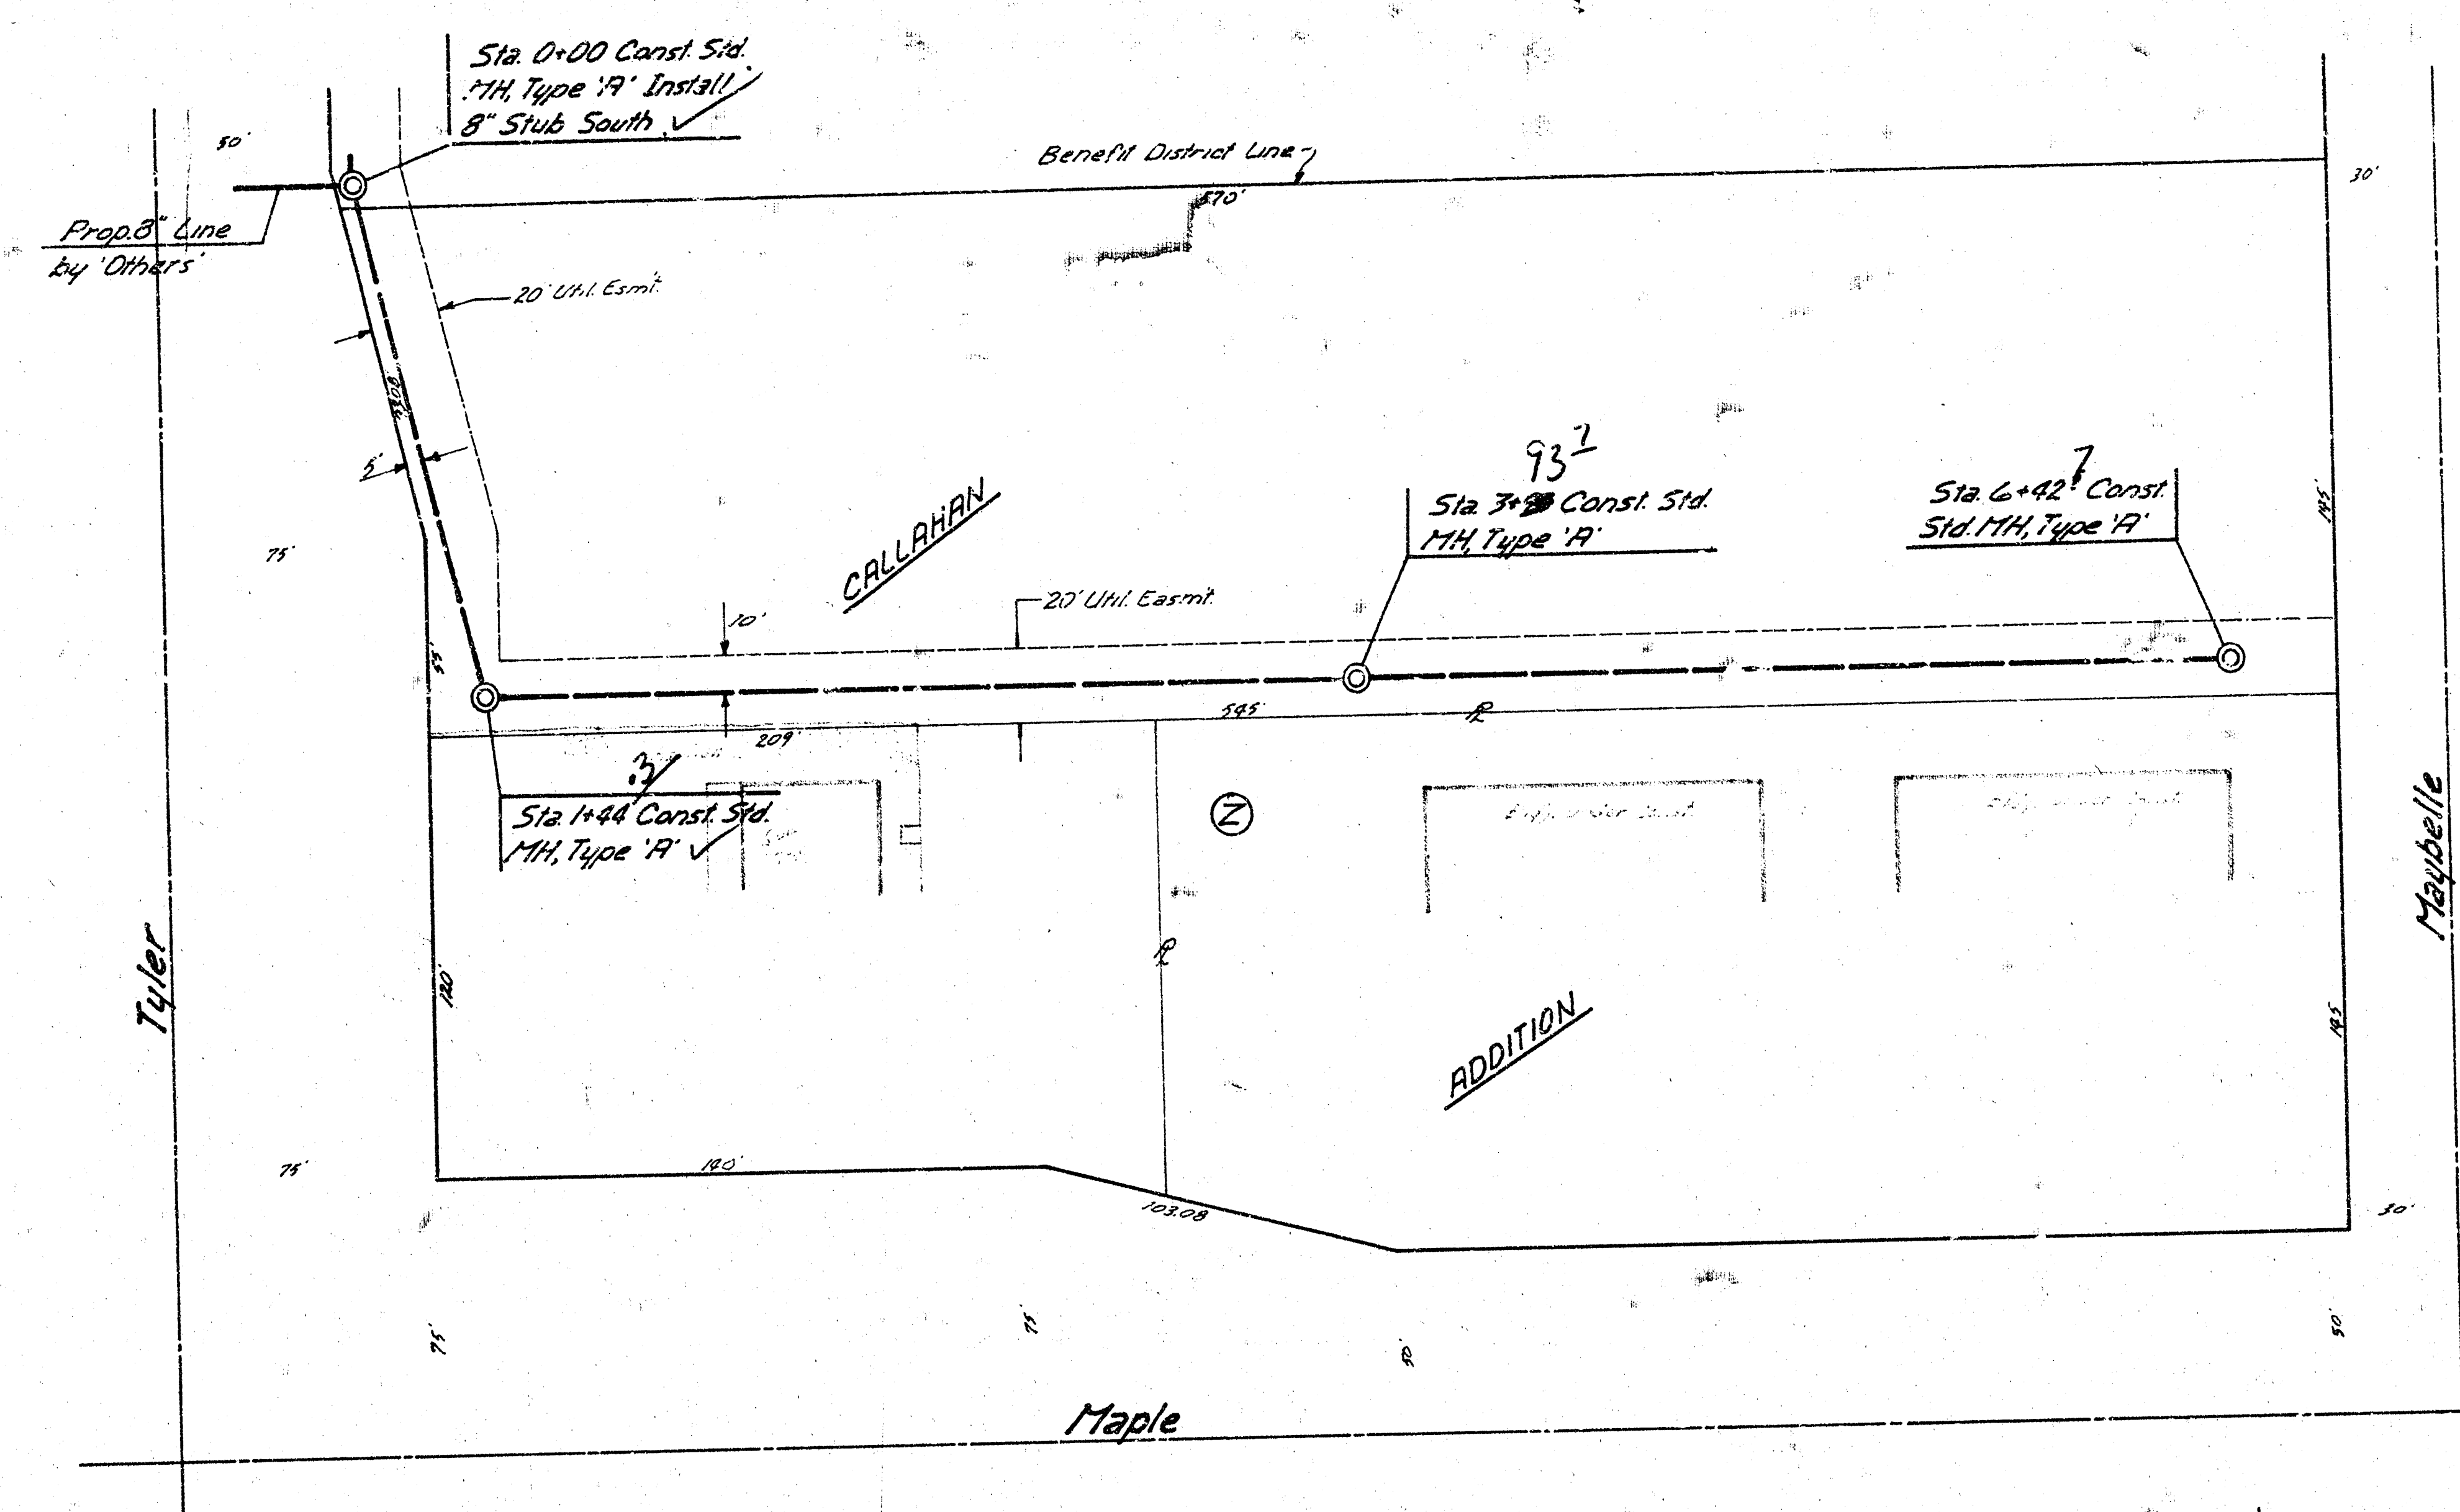


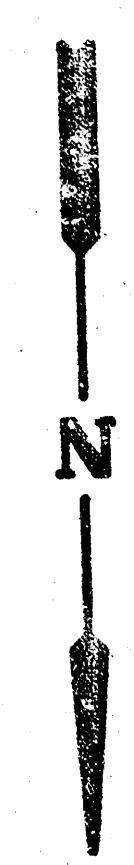


Field Engineer to Set Top of Manholes
to Finish Grade as Determined by
the Developer.

B.M. 143.41 City Std. 342' E & 272' S. of Q's
Maple & Tyler Rd.

SCALE
Plan 1"=40'
Profile Horiz 1"=40'
Vert 1"=5'

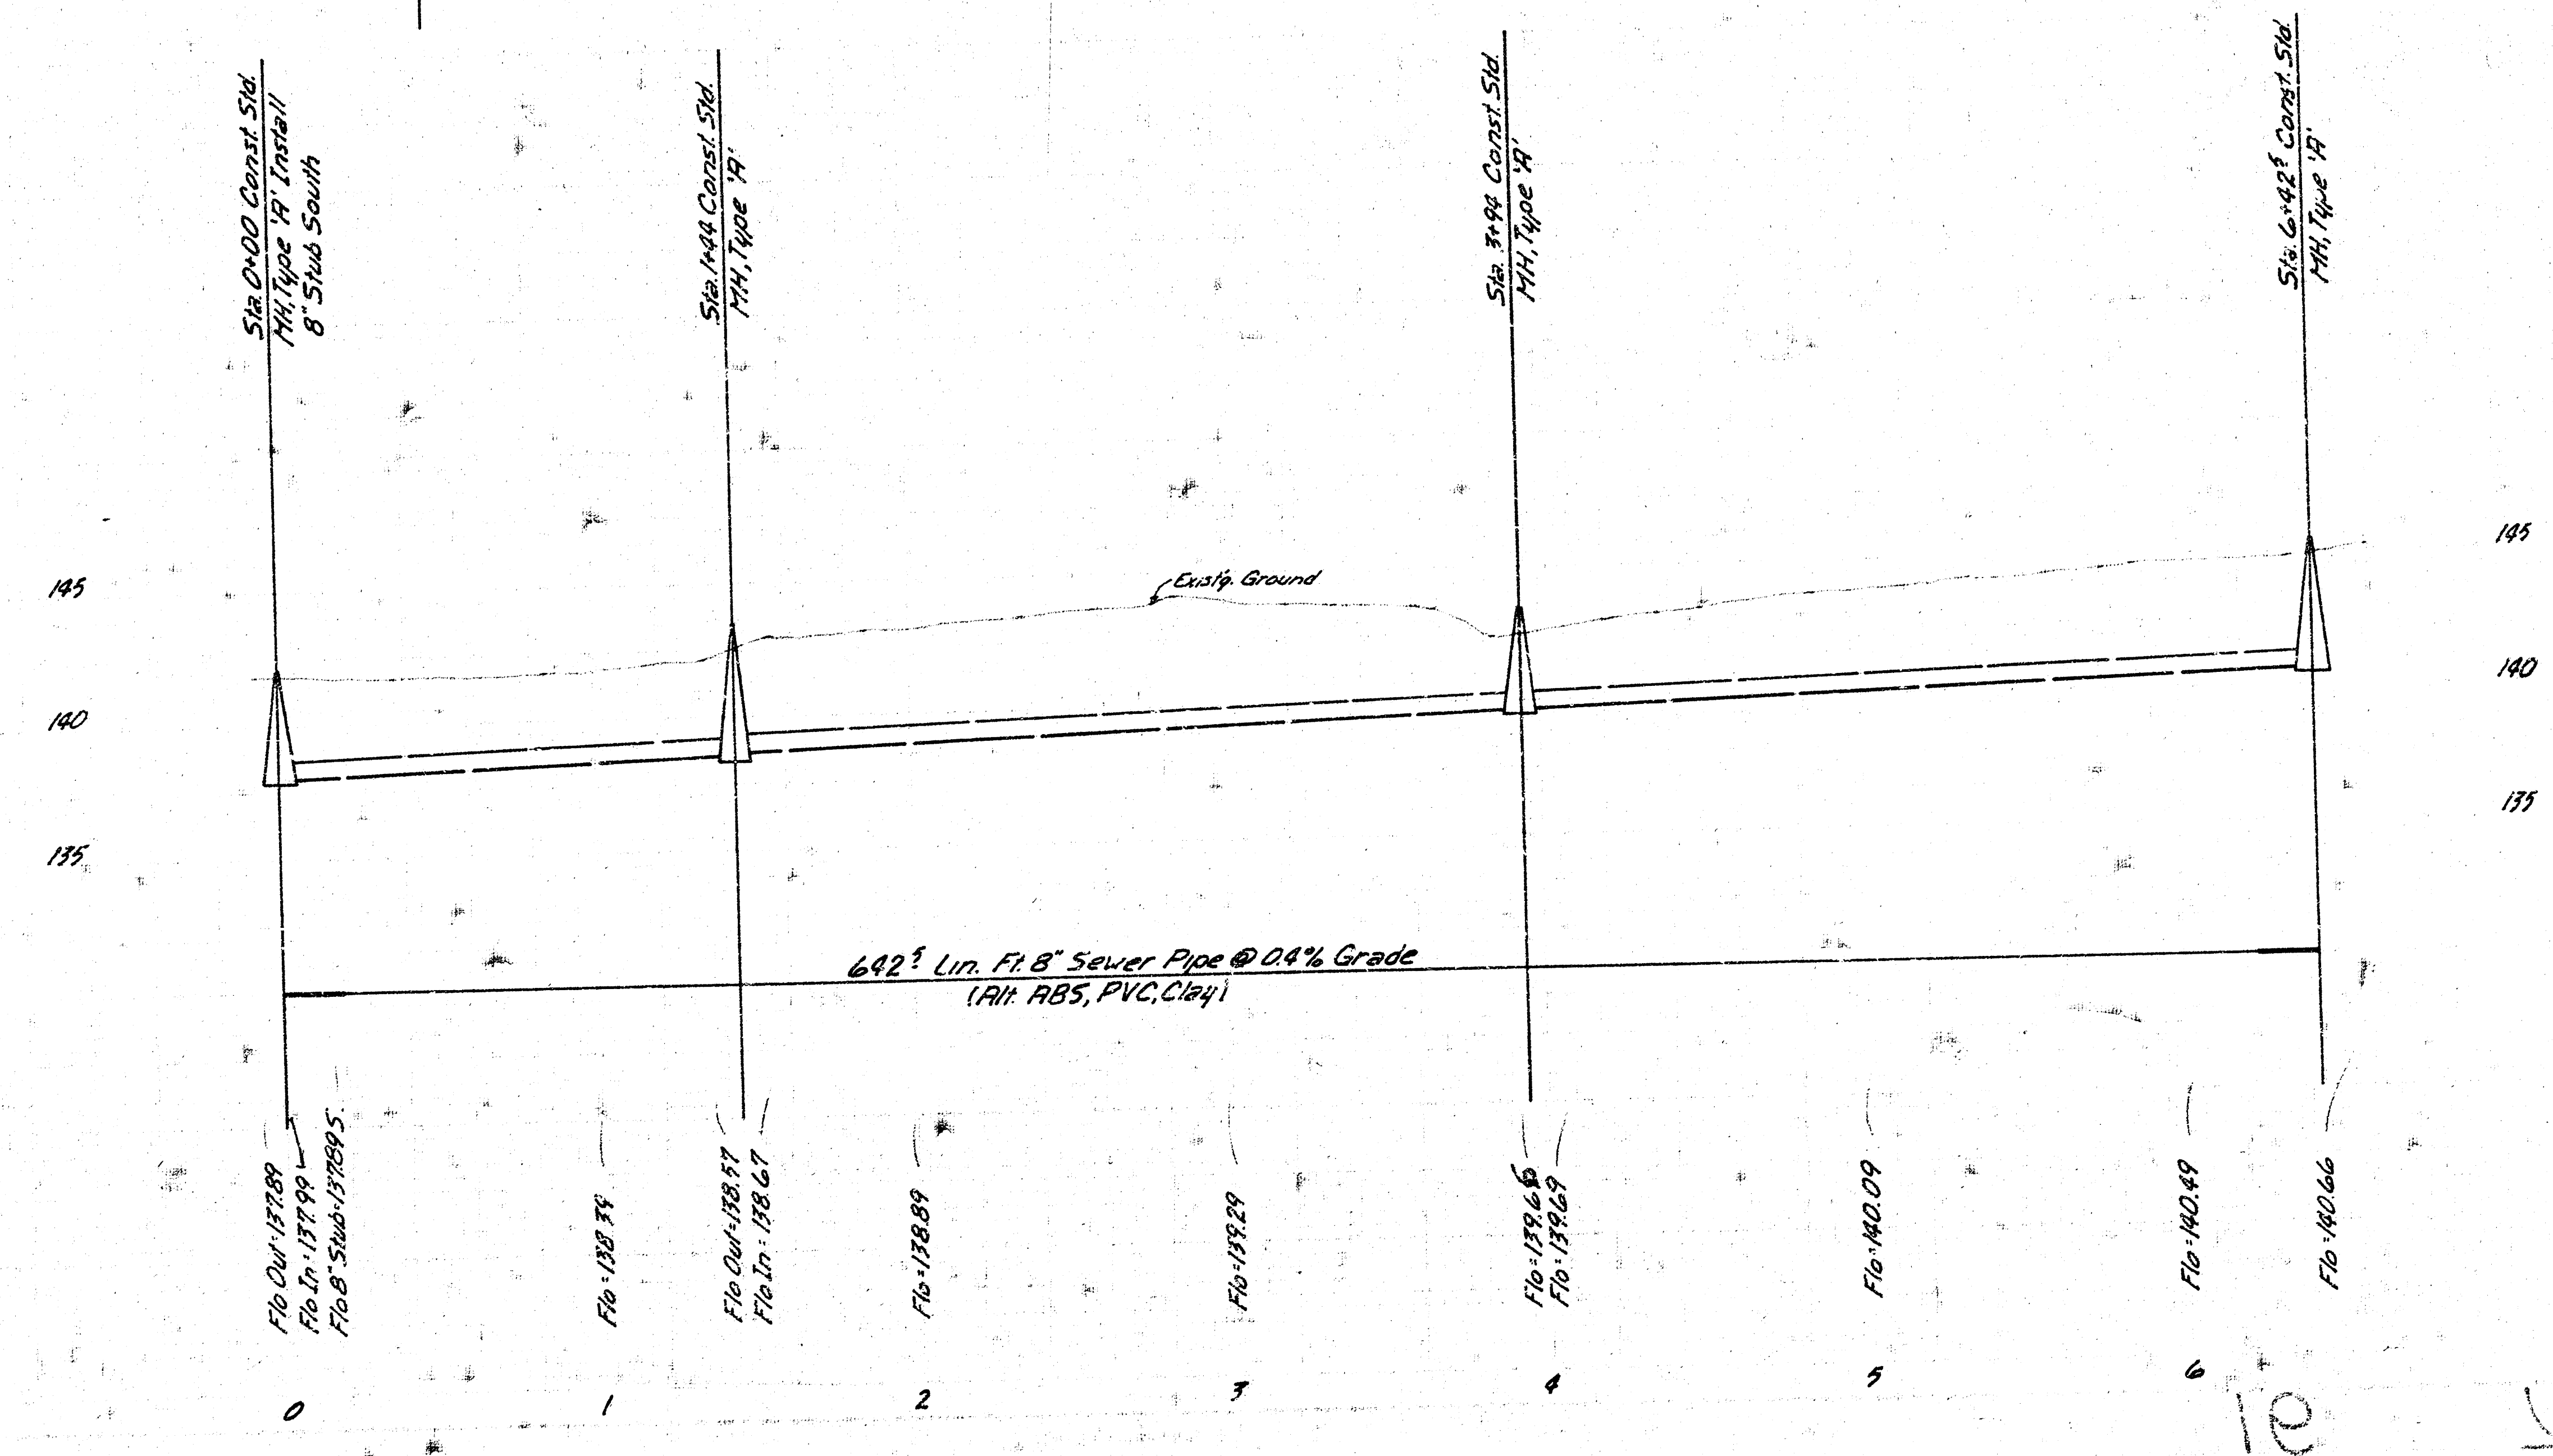

As Built
7-27-81
JHL

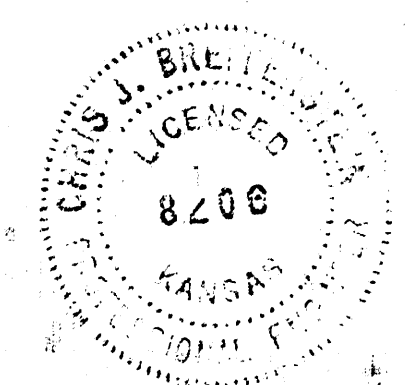

Lat. 145, SW Interceptor Sewer
468-76-245-80861-000-000-001
City of Wichita, Kansas
Dept. of Public Works - Eng. Div.
Dean S. Sellers - Acting City Engineer

FILMED FROM THE BEST
AVAILABLE COPY