


CONSTRUCTION PLANS FOR
LATERAL 184
OF THE
SOUTHWEST INTERCEPTOR SEWER

THE CITY OF WICHITA,
SEDGWICK COUNTY, KANSAS
MICHAEL E. LINDEBAK, P.E., CITY ENGINEER

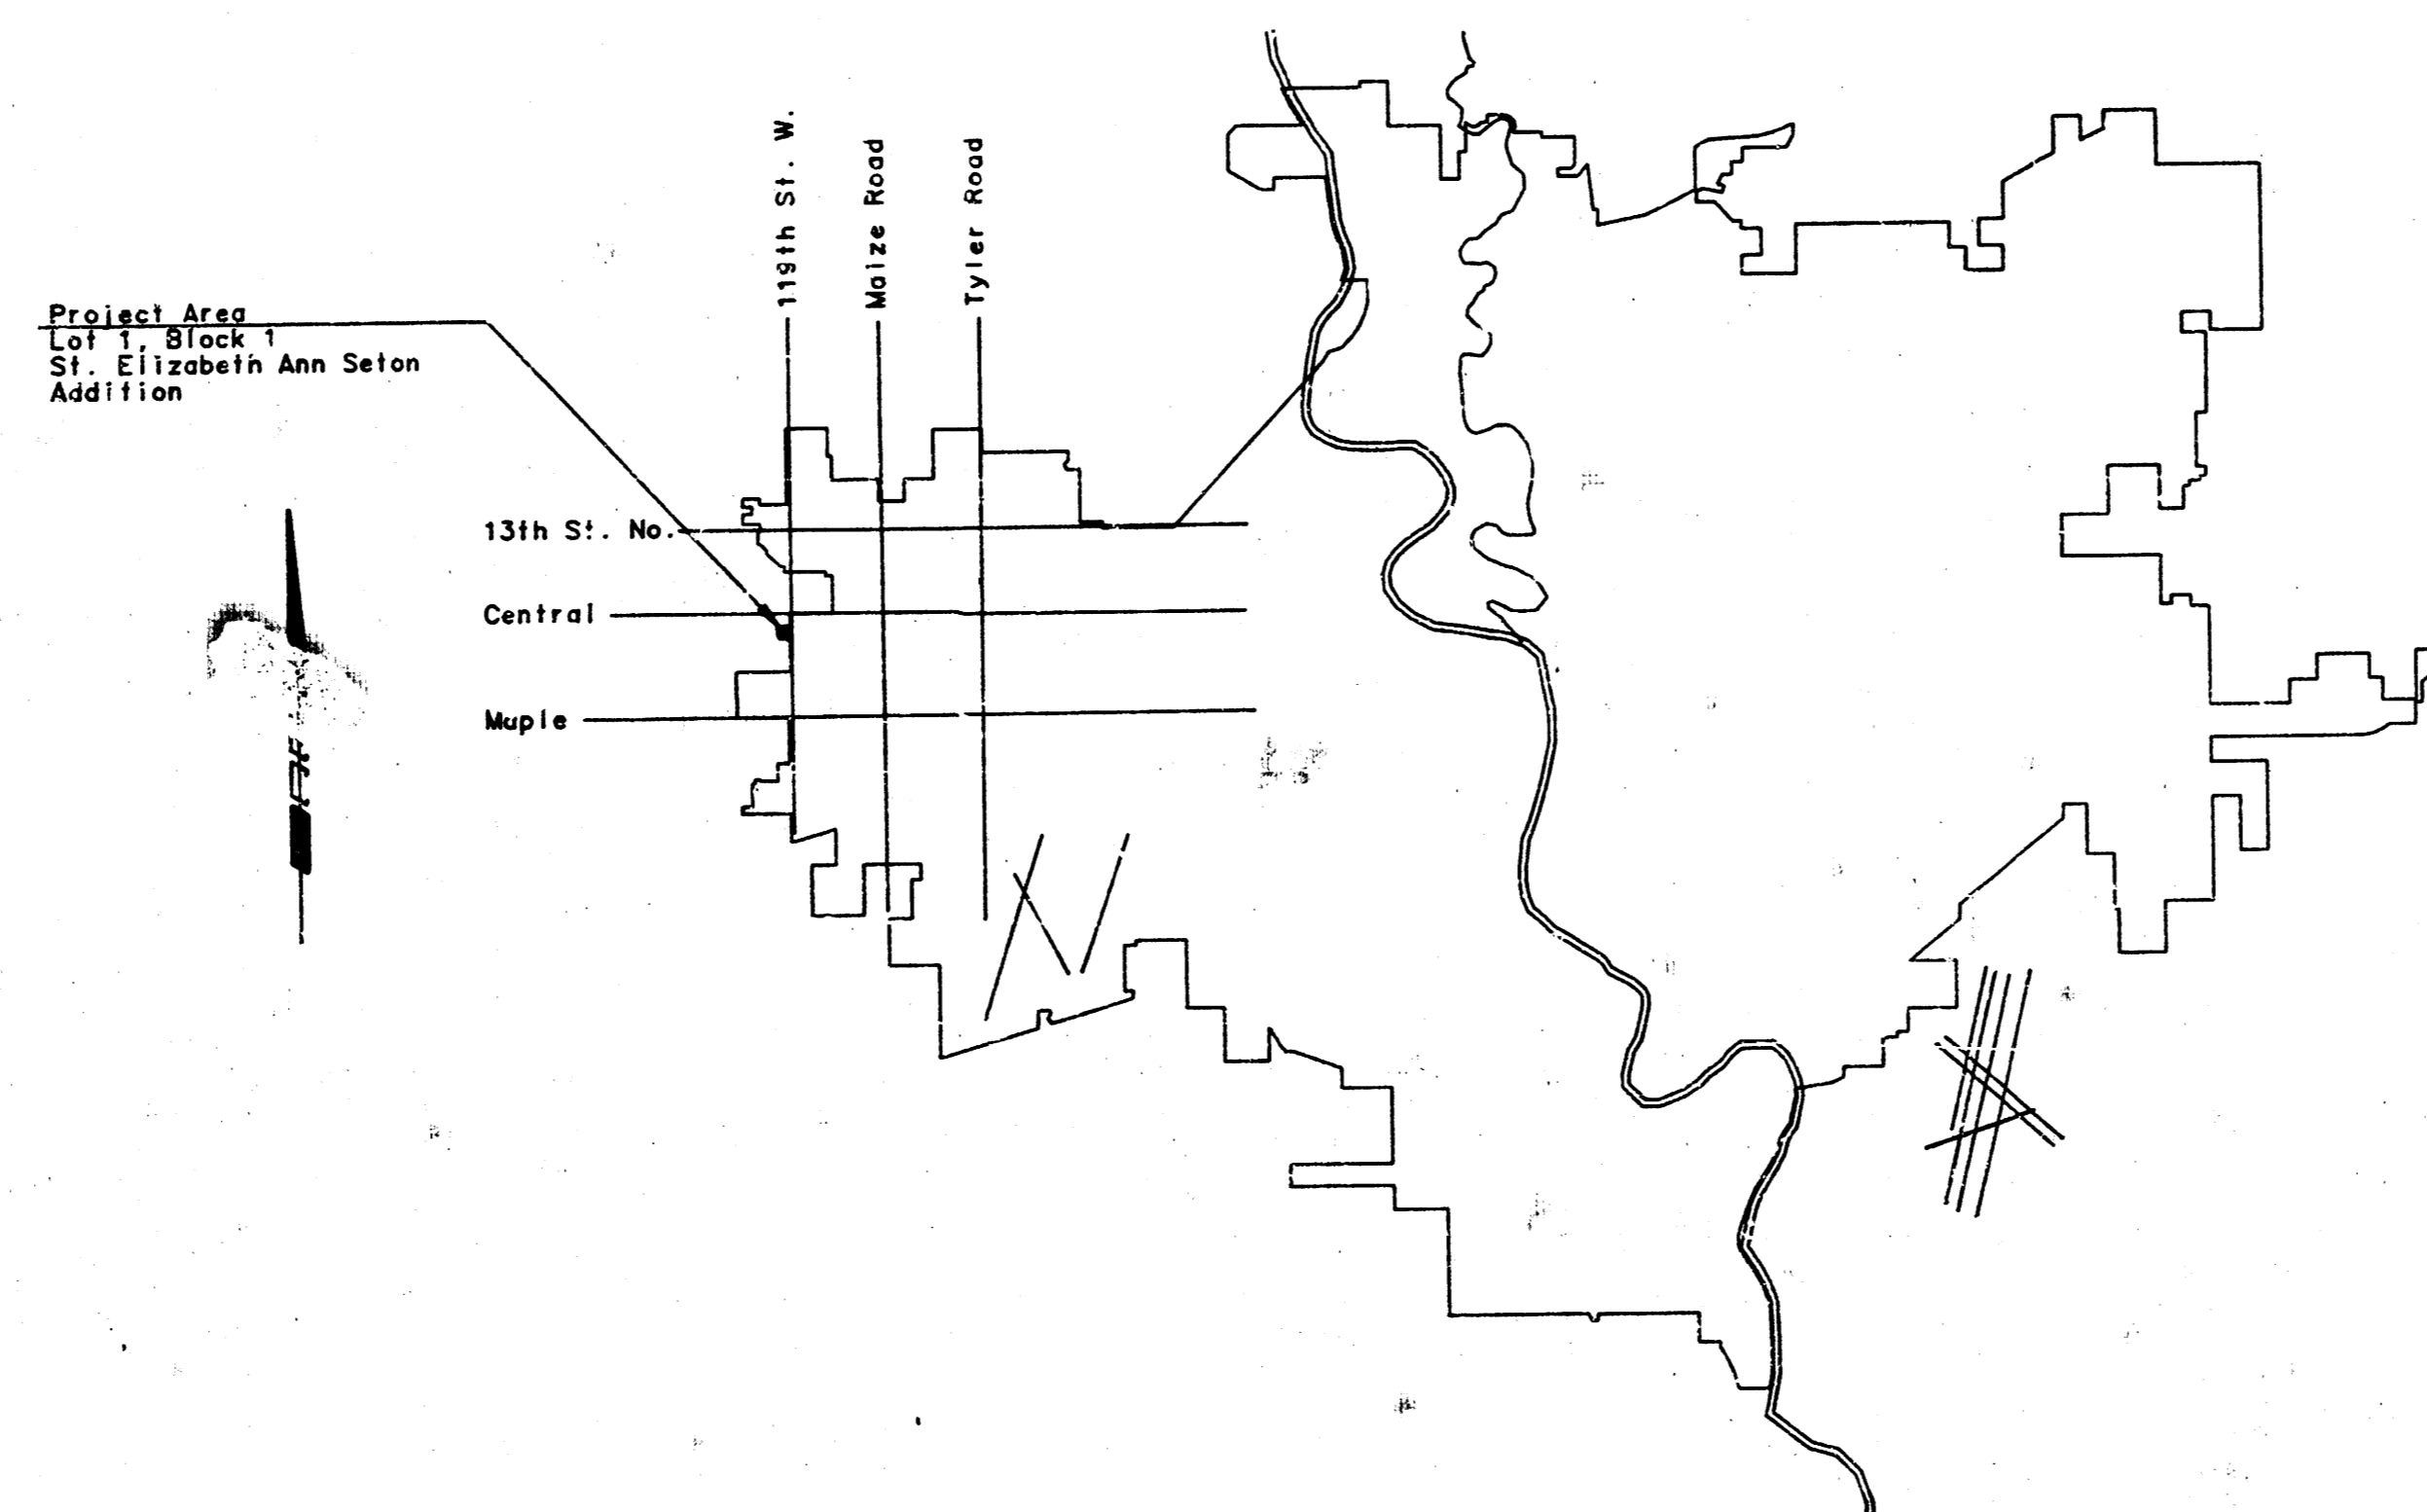


LOCATION MAP

CITY OF WICHITA PROJECT NO. 468-76-245-81364-000-000-001

SEPTEMBER, 1984

PLANS PREPARED BY

PROFESSIONAL ENGINEERING CONSULTANTS, P.A.
ENGINEERS
WICHITA, KANSAS

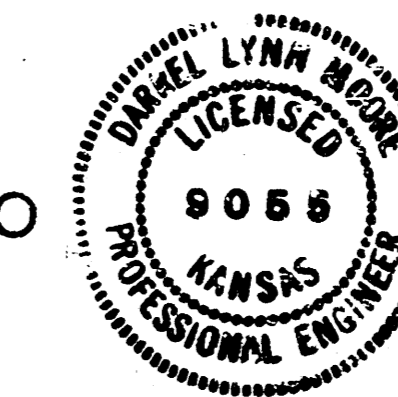

*As Built
3/85
CFL*

1/2

FILMED FROM THE BEST
AVAILABLE COPY

