

LATERAL 200, S. W. INTERCEPTOR


PROJECT NO.

468-76-245-81438-000-000-001

CITY OF WICHITA, KANSAS
MICHAEL E. LINDEBAK, CITY ENGINEER

GENERAL NOTES

1. The contractor shall be responsible for preserving property irons. The contractor shall be required to re-establish any property irons which are damaged or destroyed by his construction operations. Such irons shall be re-established by a licensed land surveyor or a licensed professional engineer in accordance with state laws.
2. Contractor shall contact Kan U Dig It, phone no. 267-2809 and/or the operating authority responsible for each utility, prior to construction. The contractor shall be responsible for location of all utilities, and shall protect all utilities from damage due to construction operations. All costs of repair and restoration of existing utilities damaged by the contractor shall be the responsibility of the contractor.
3. All work required to complete the project in accordance with the plans and standard specifications not specifically listed in the bid form shall be considered incidental to the project.

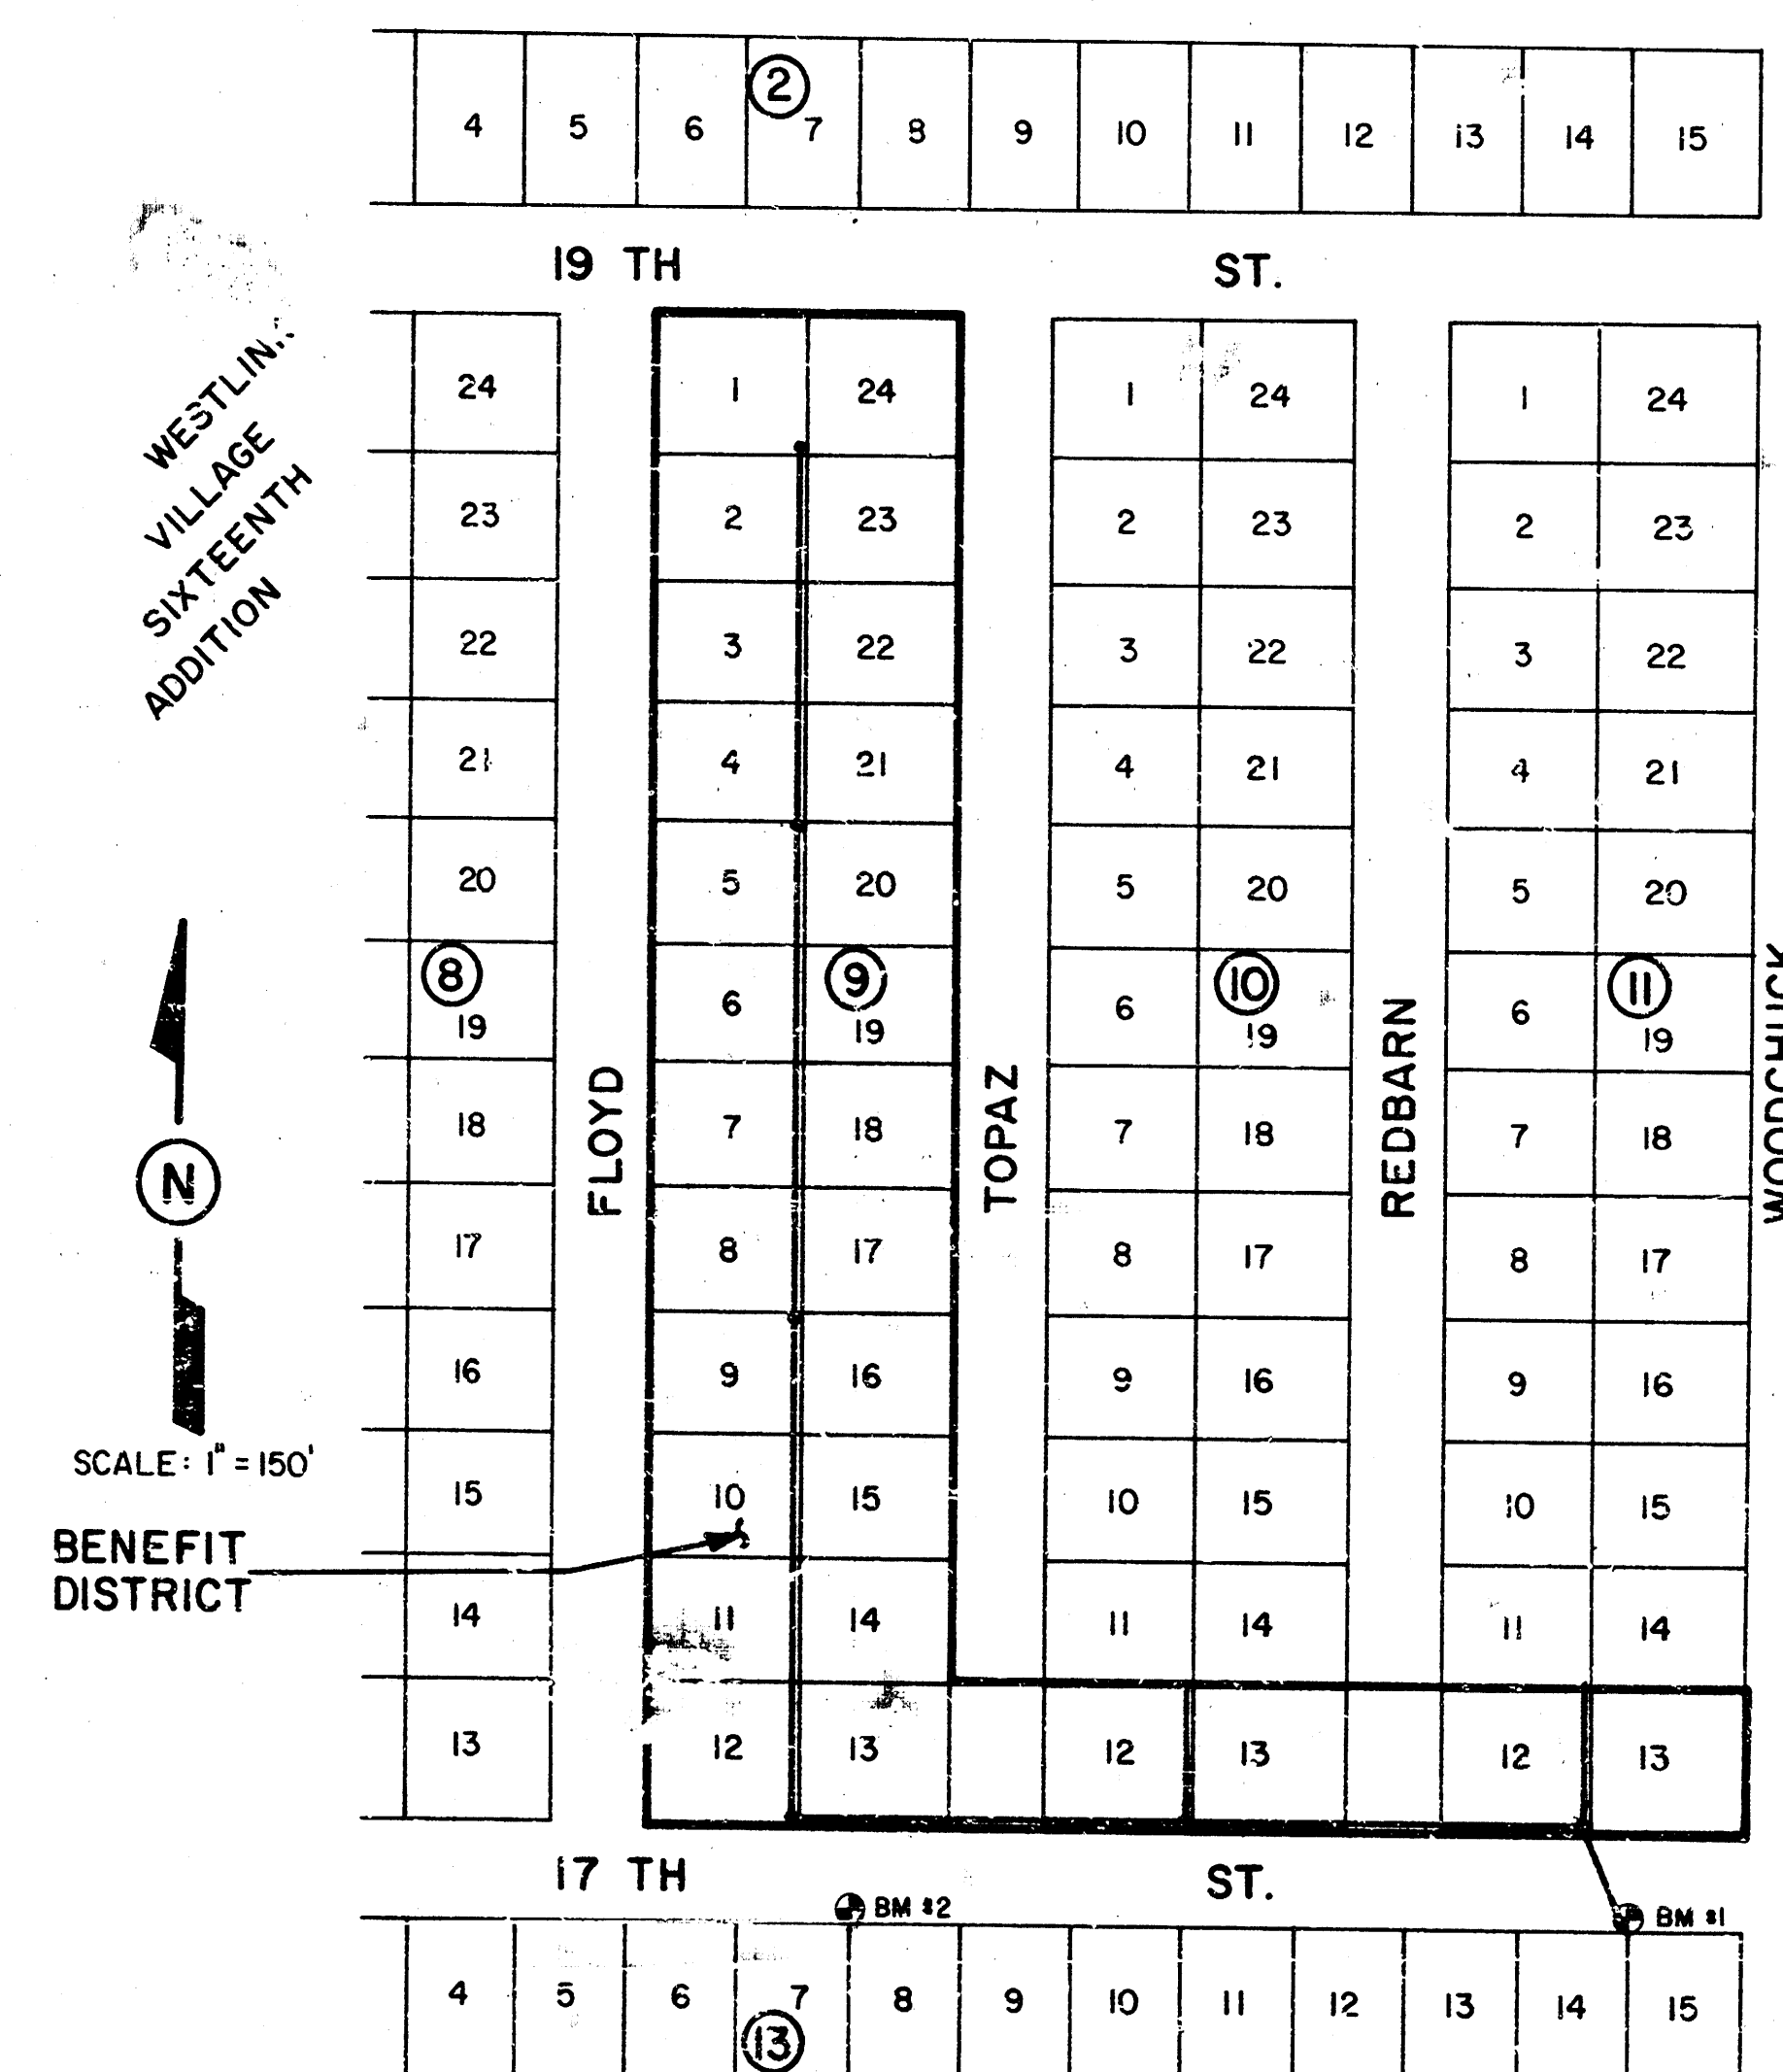



INDEX

- 1 Title Sheet
- 2-3 Plan Profile
- 4 Type A Manhole Detail
- 5 Type C Manhole Detail
- 6 Final Plat




Van Doren Hazard Stallings
Architects - Engineers - Planners

Sheet 1
1/2

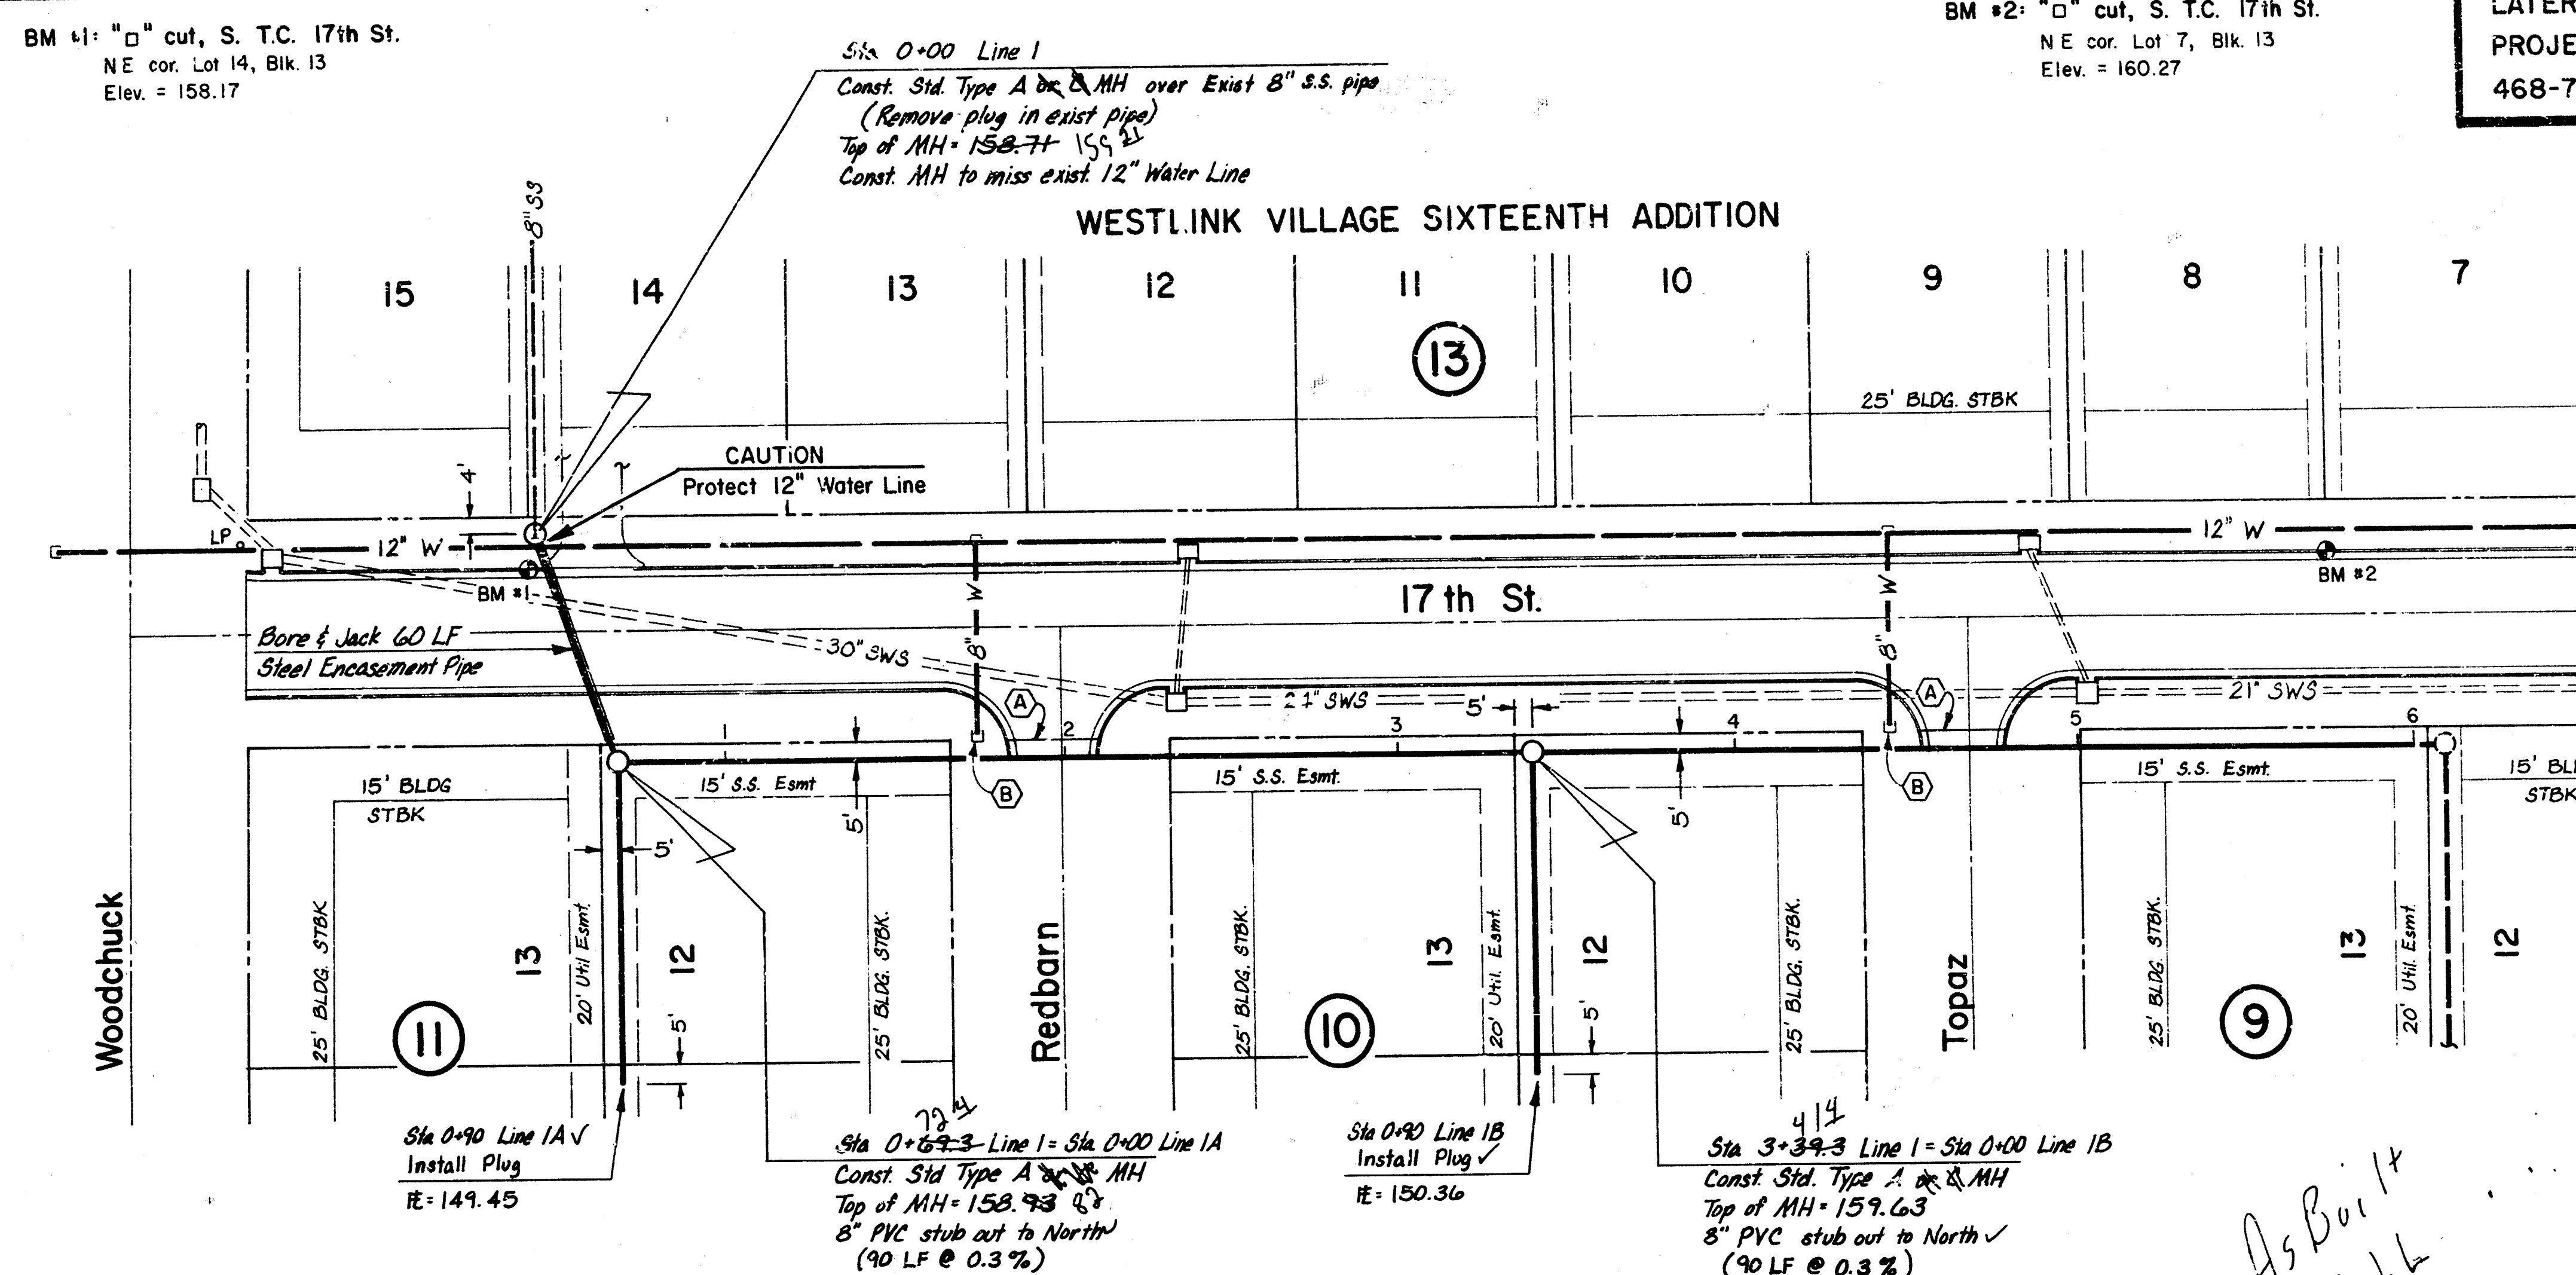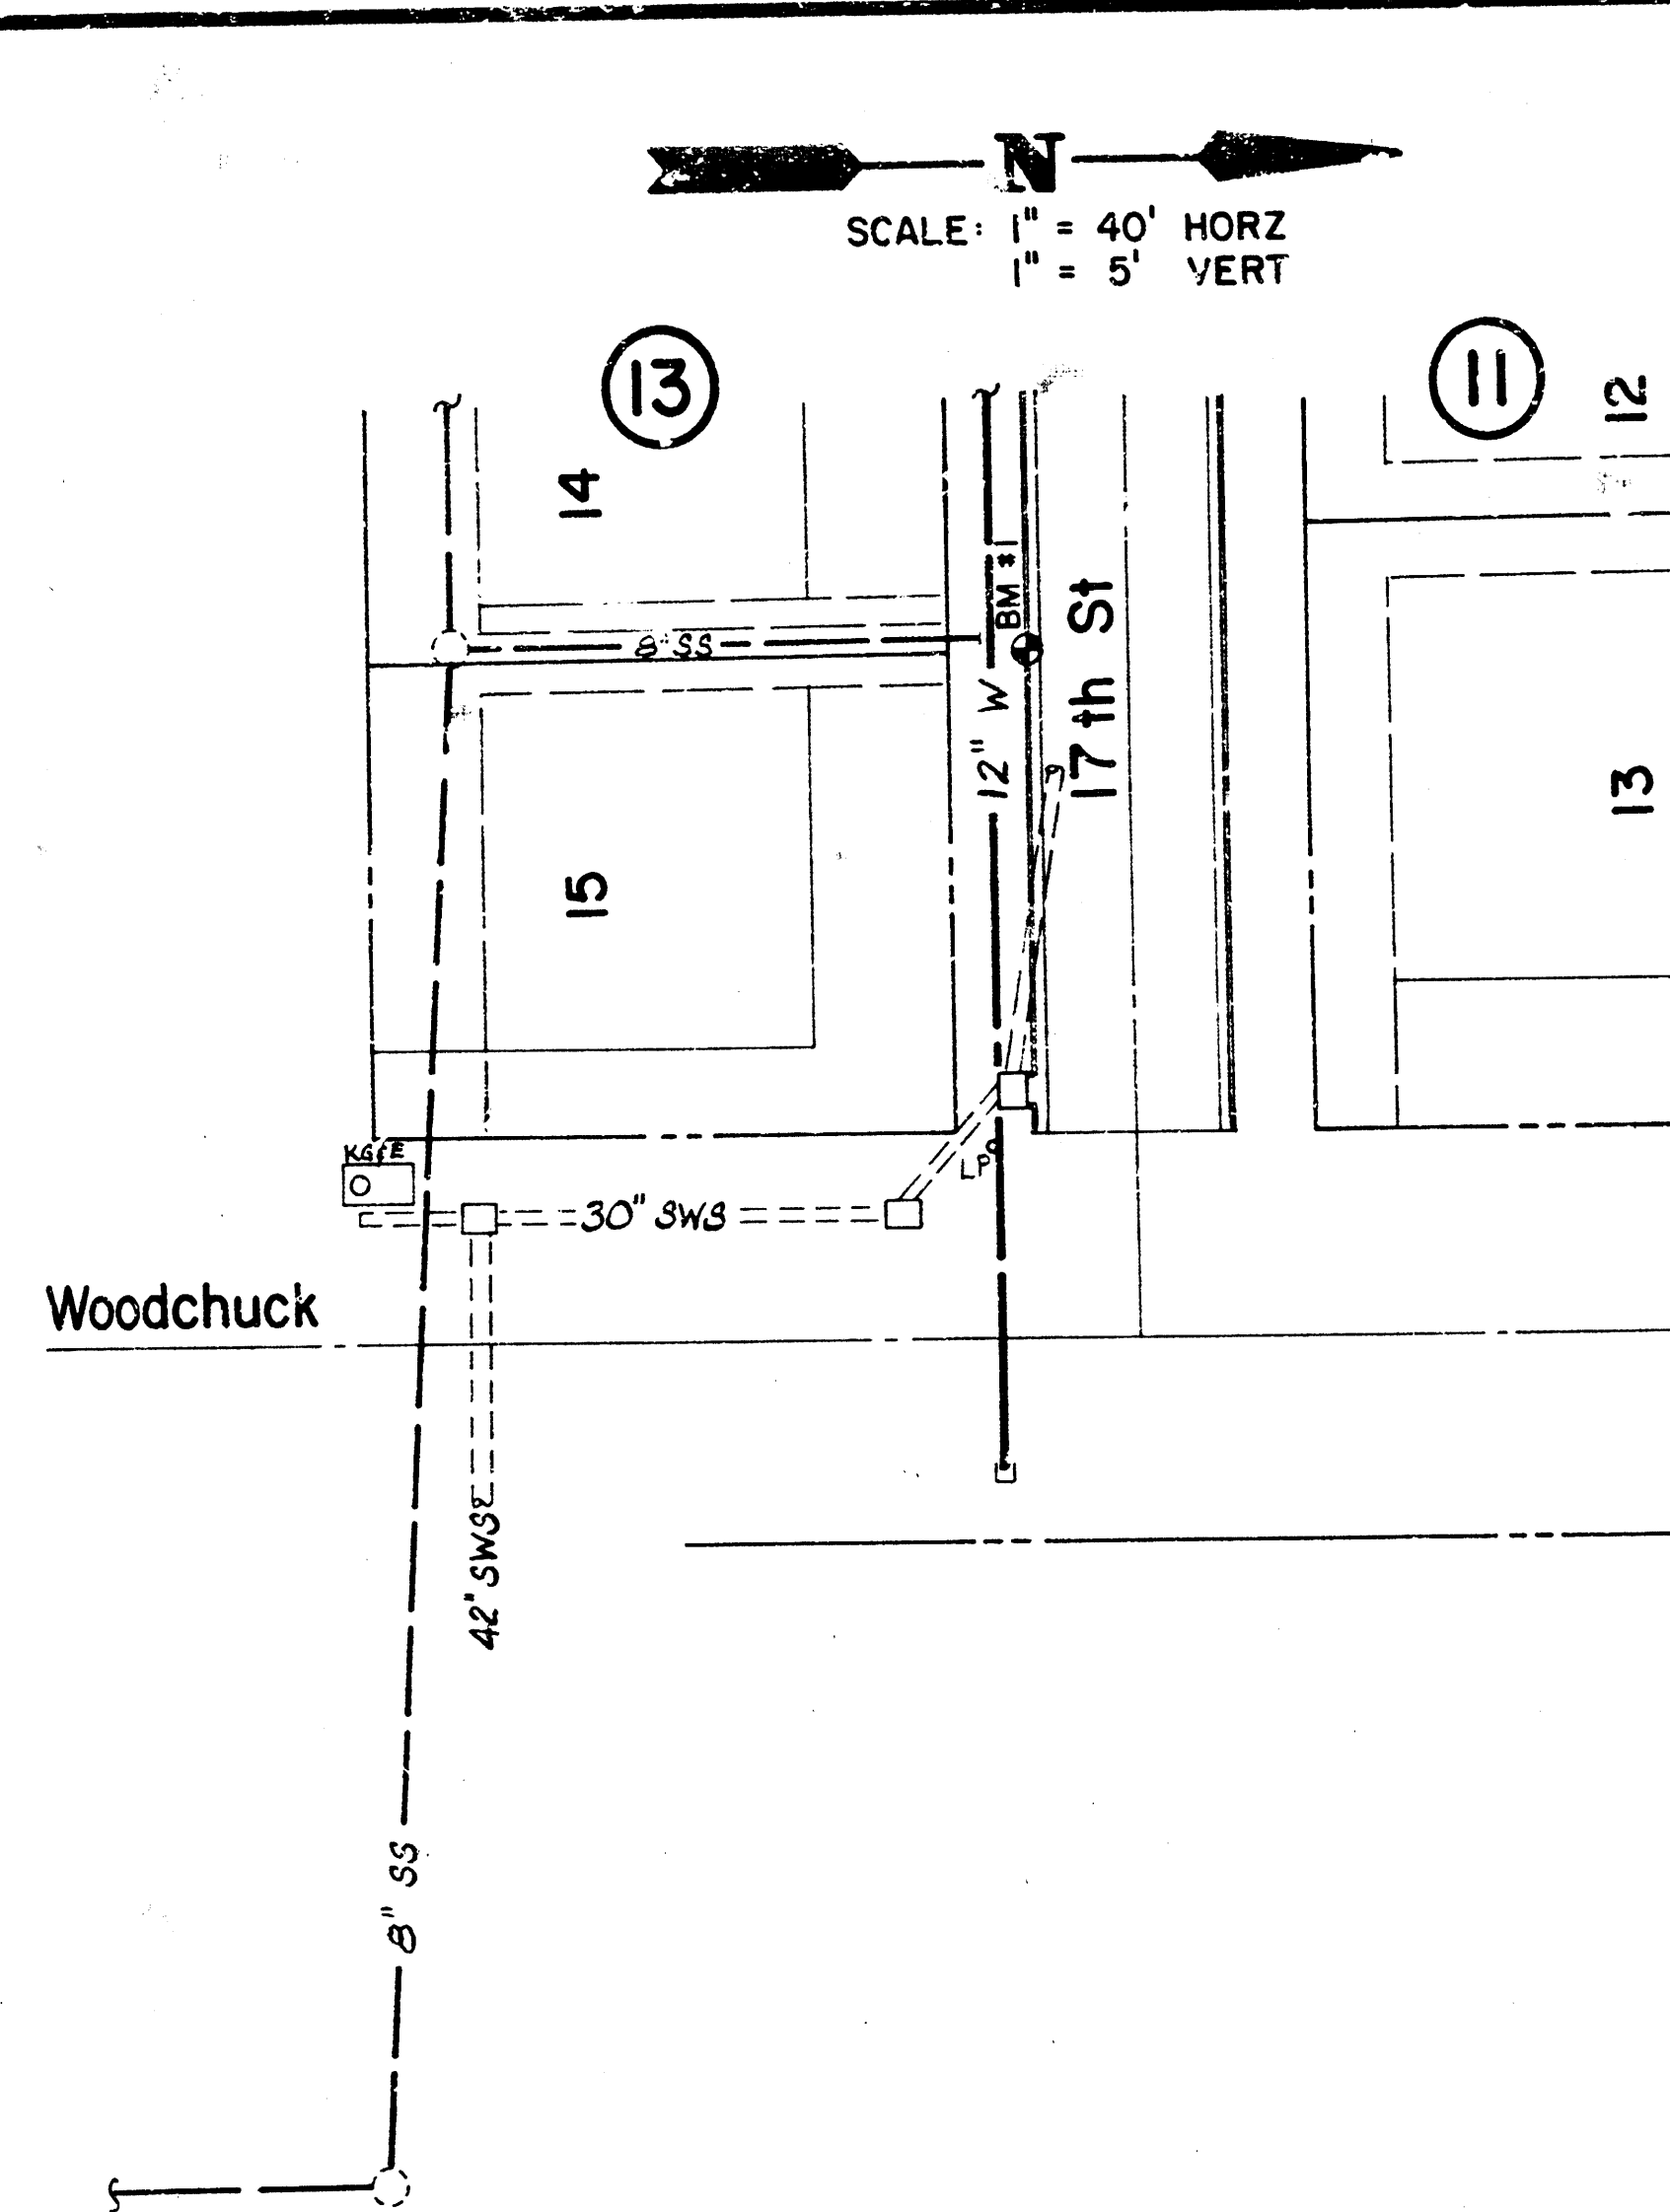

LATERAL 200, S.W. INTERCEPTOR
PROJECT NO.
468-76-245-81438-000-001


- NOTES
- (A) Saw Cut, remove conc curb & gutter & asphalt as reqd. Cost incidental (2 places)
 - (B) Caution: Protect Water Line stubs (2 places)

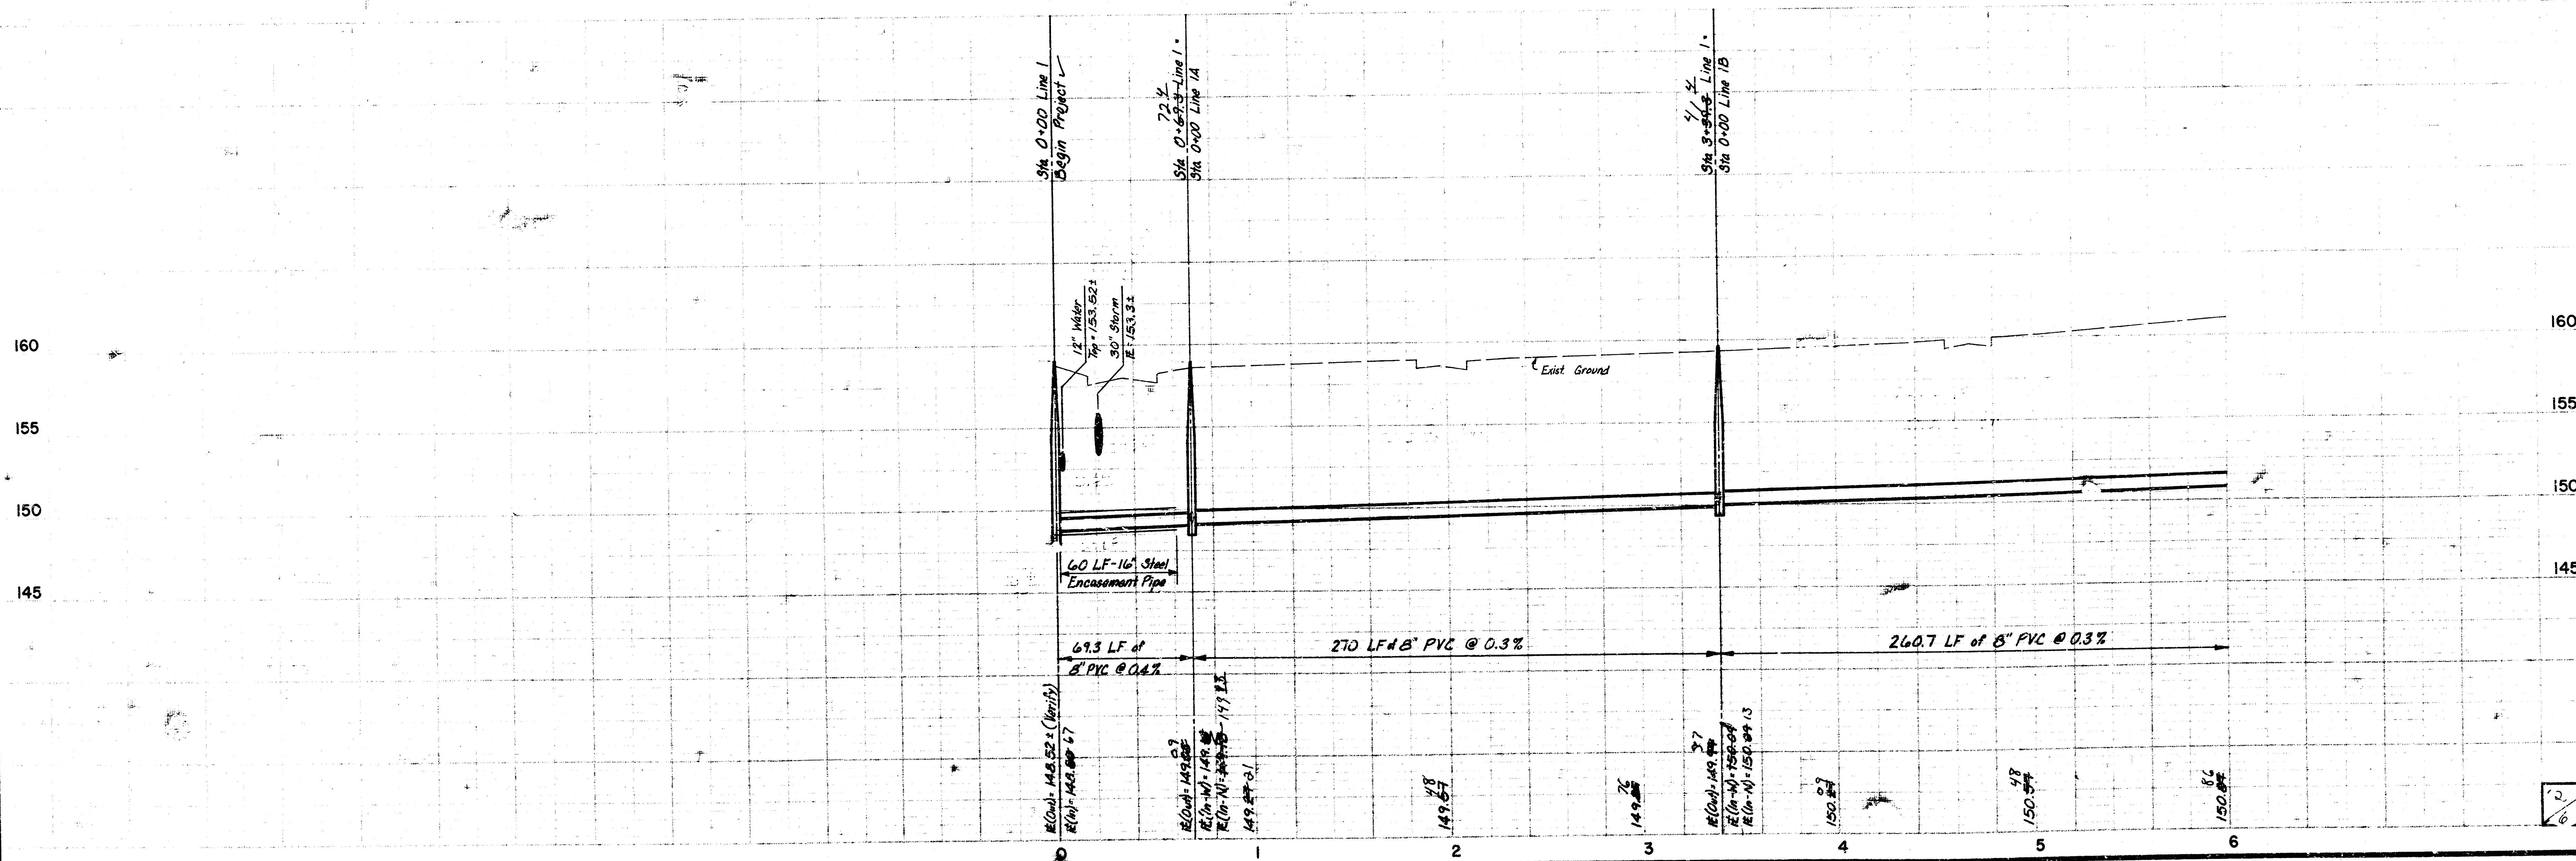


BM #2: "d" cut, S.T.C. 17th St.
N.E. cor. Lot 7, Blk. 13
Elev. = 160.27

LATERAL 200, S.W. INTERCEPTOR
PROJECT NO.
468-76-245-81438-000-001

SCALE: 1" = 40' HORZ
1" = 5' VERT

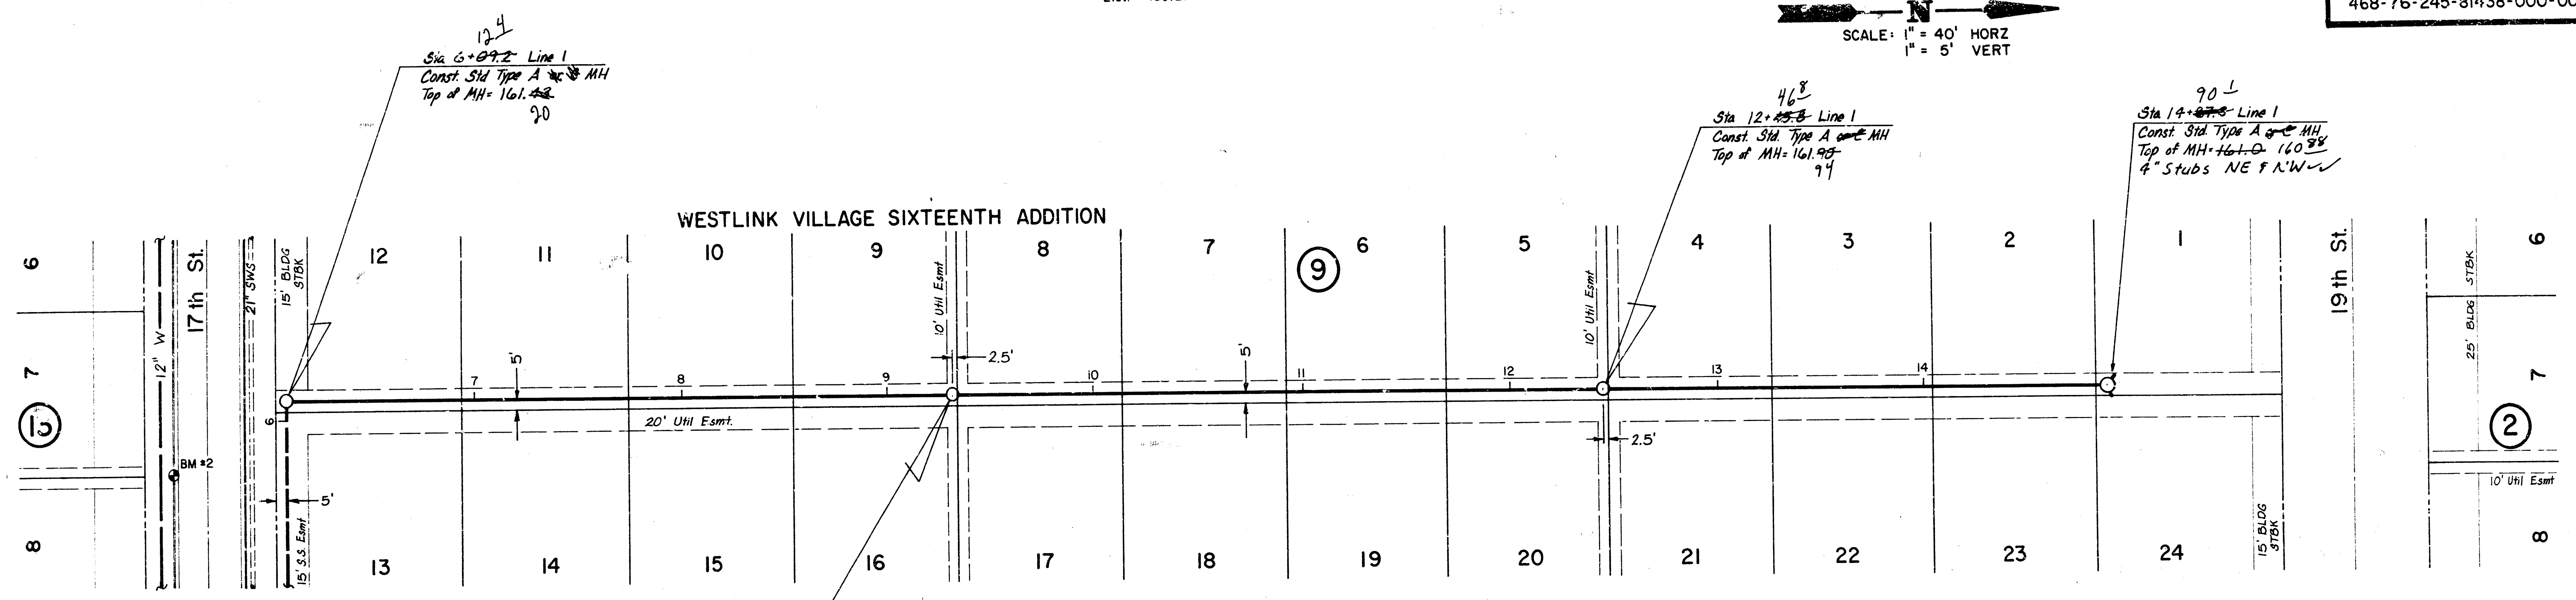

As Built
J.L.L.
8-85

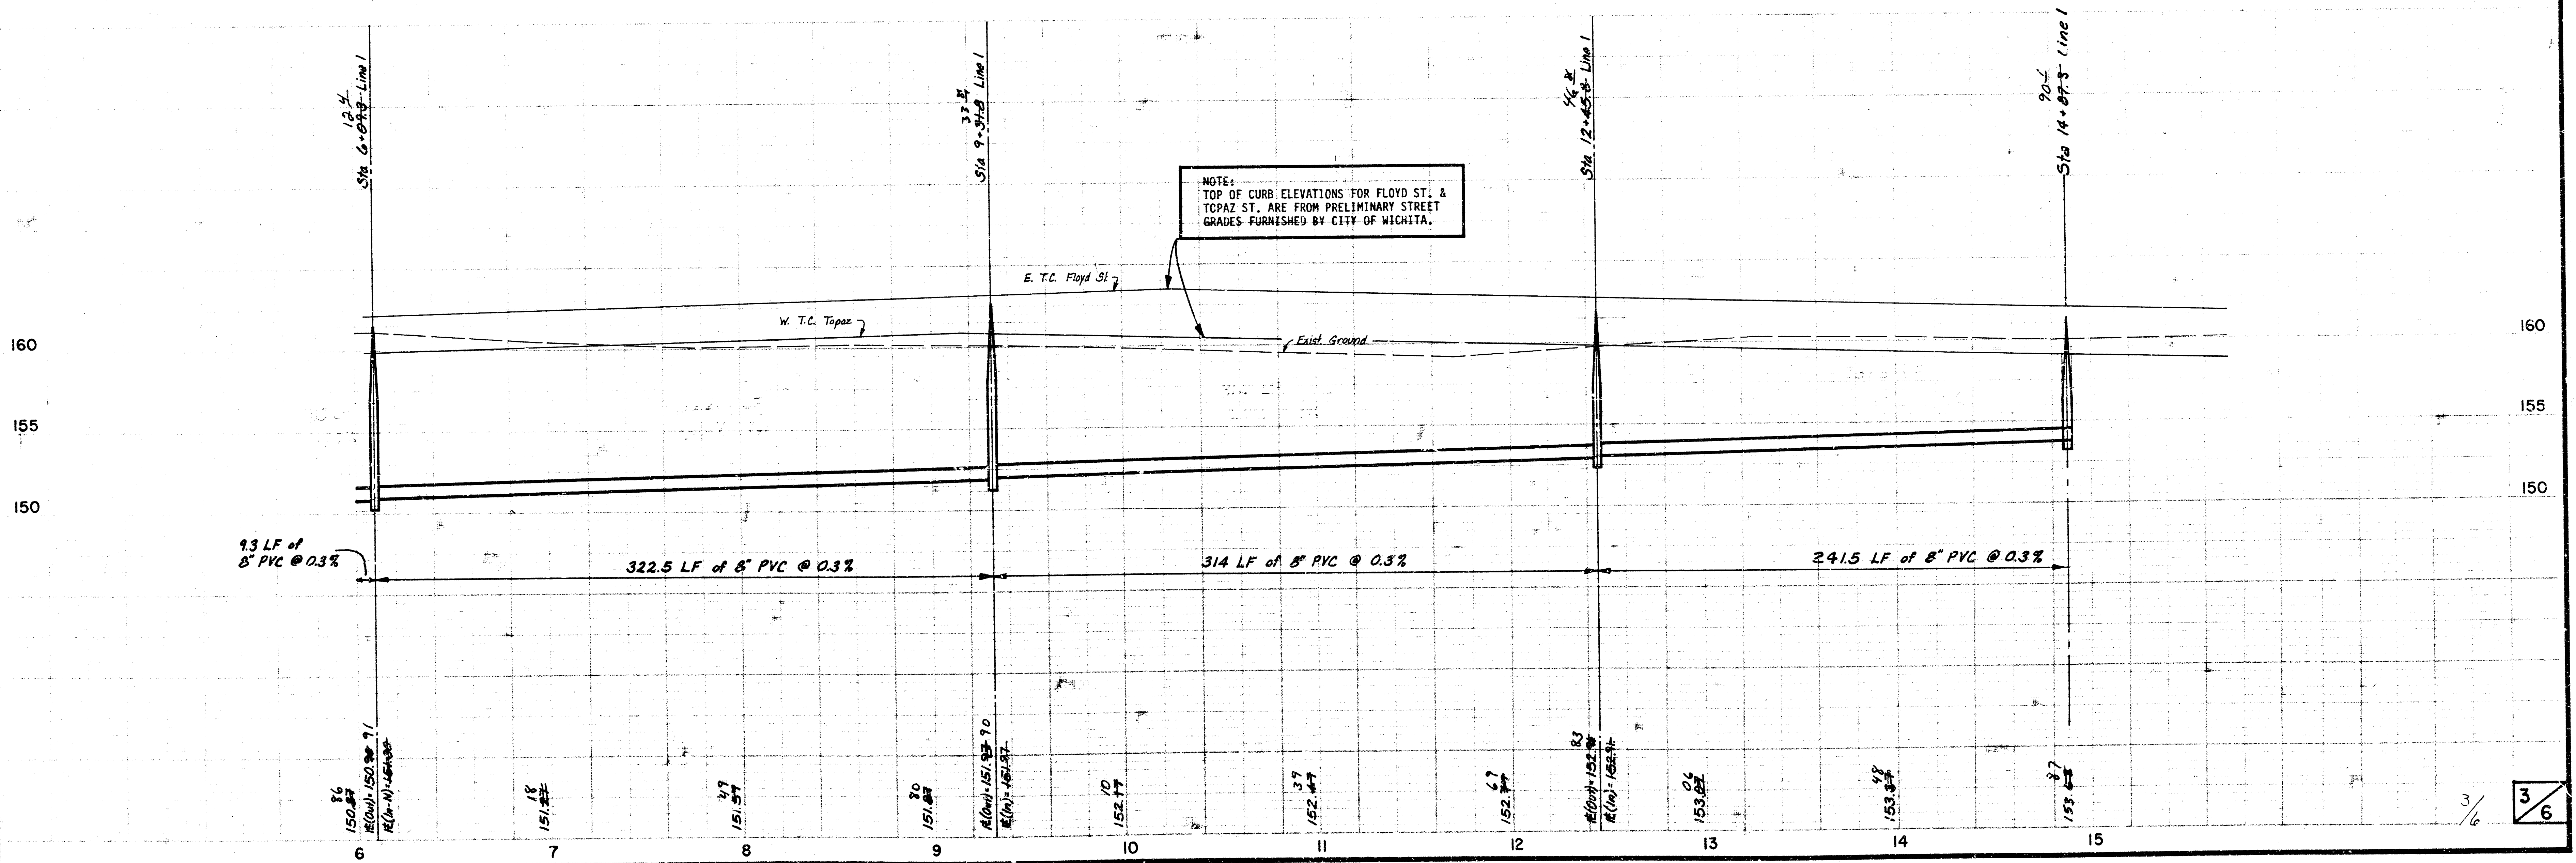


SEWER APPURTENANCES DETAILS

ADOPTED AS STANDARD DESIGN
BY


CITY of WICHITA, KANSAS

REVISED SEPTEMBER 1980

TYPE "A" MANHOLE

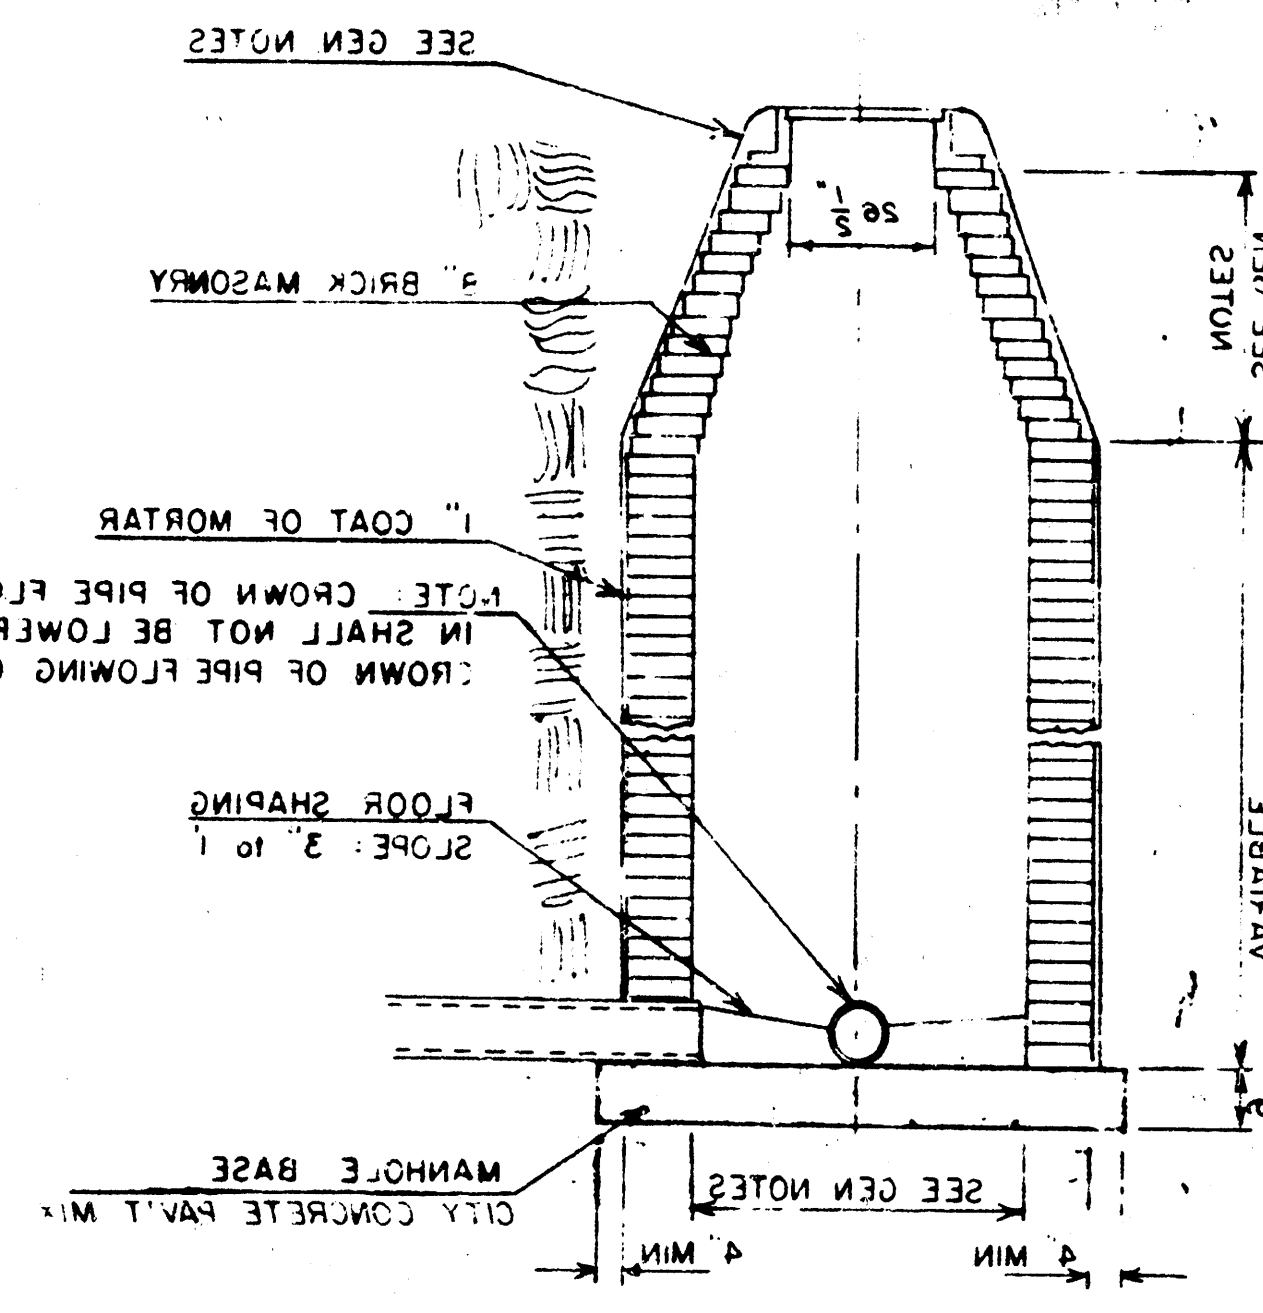


TYPE "A" INSIDE DROP MANHOLE

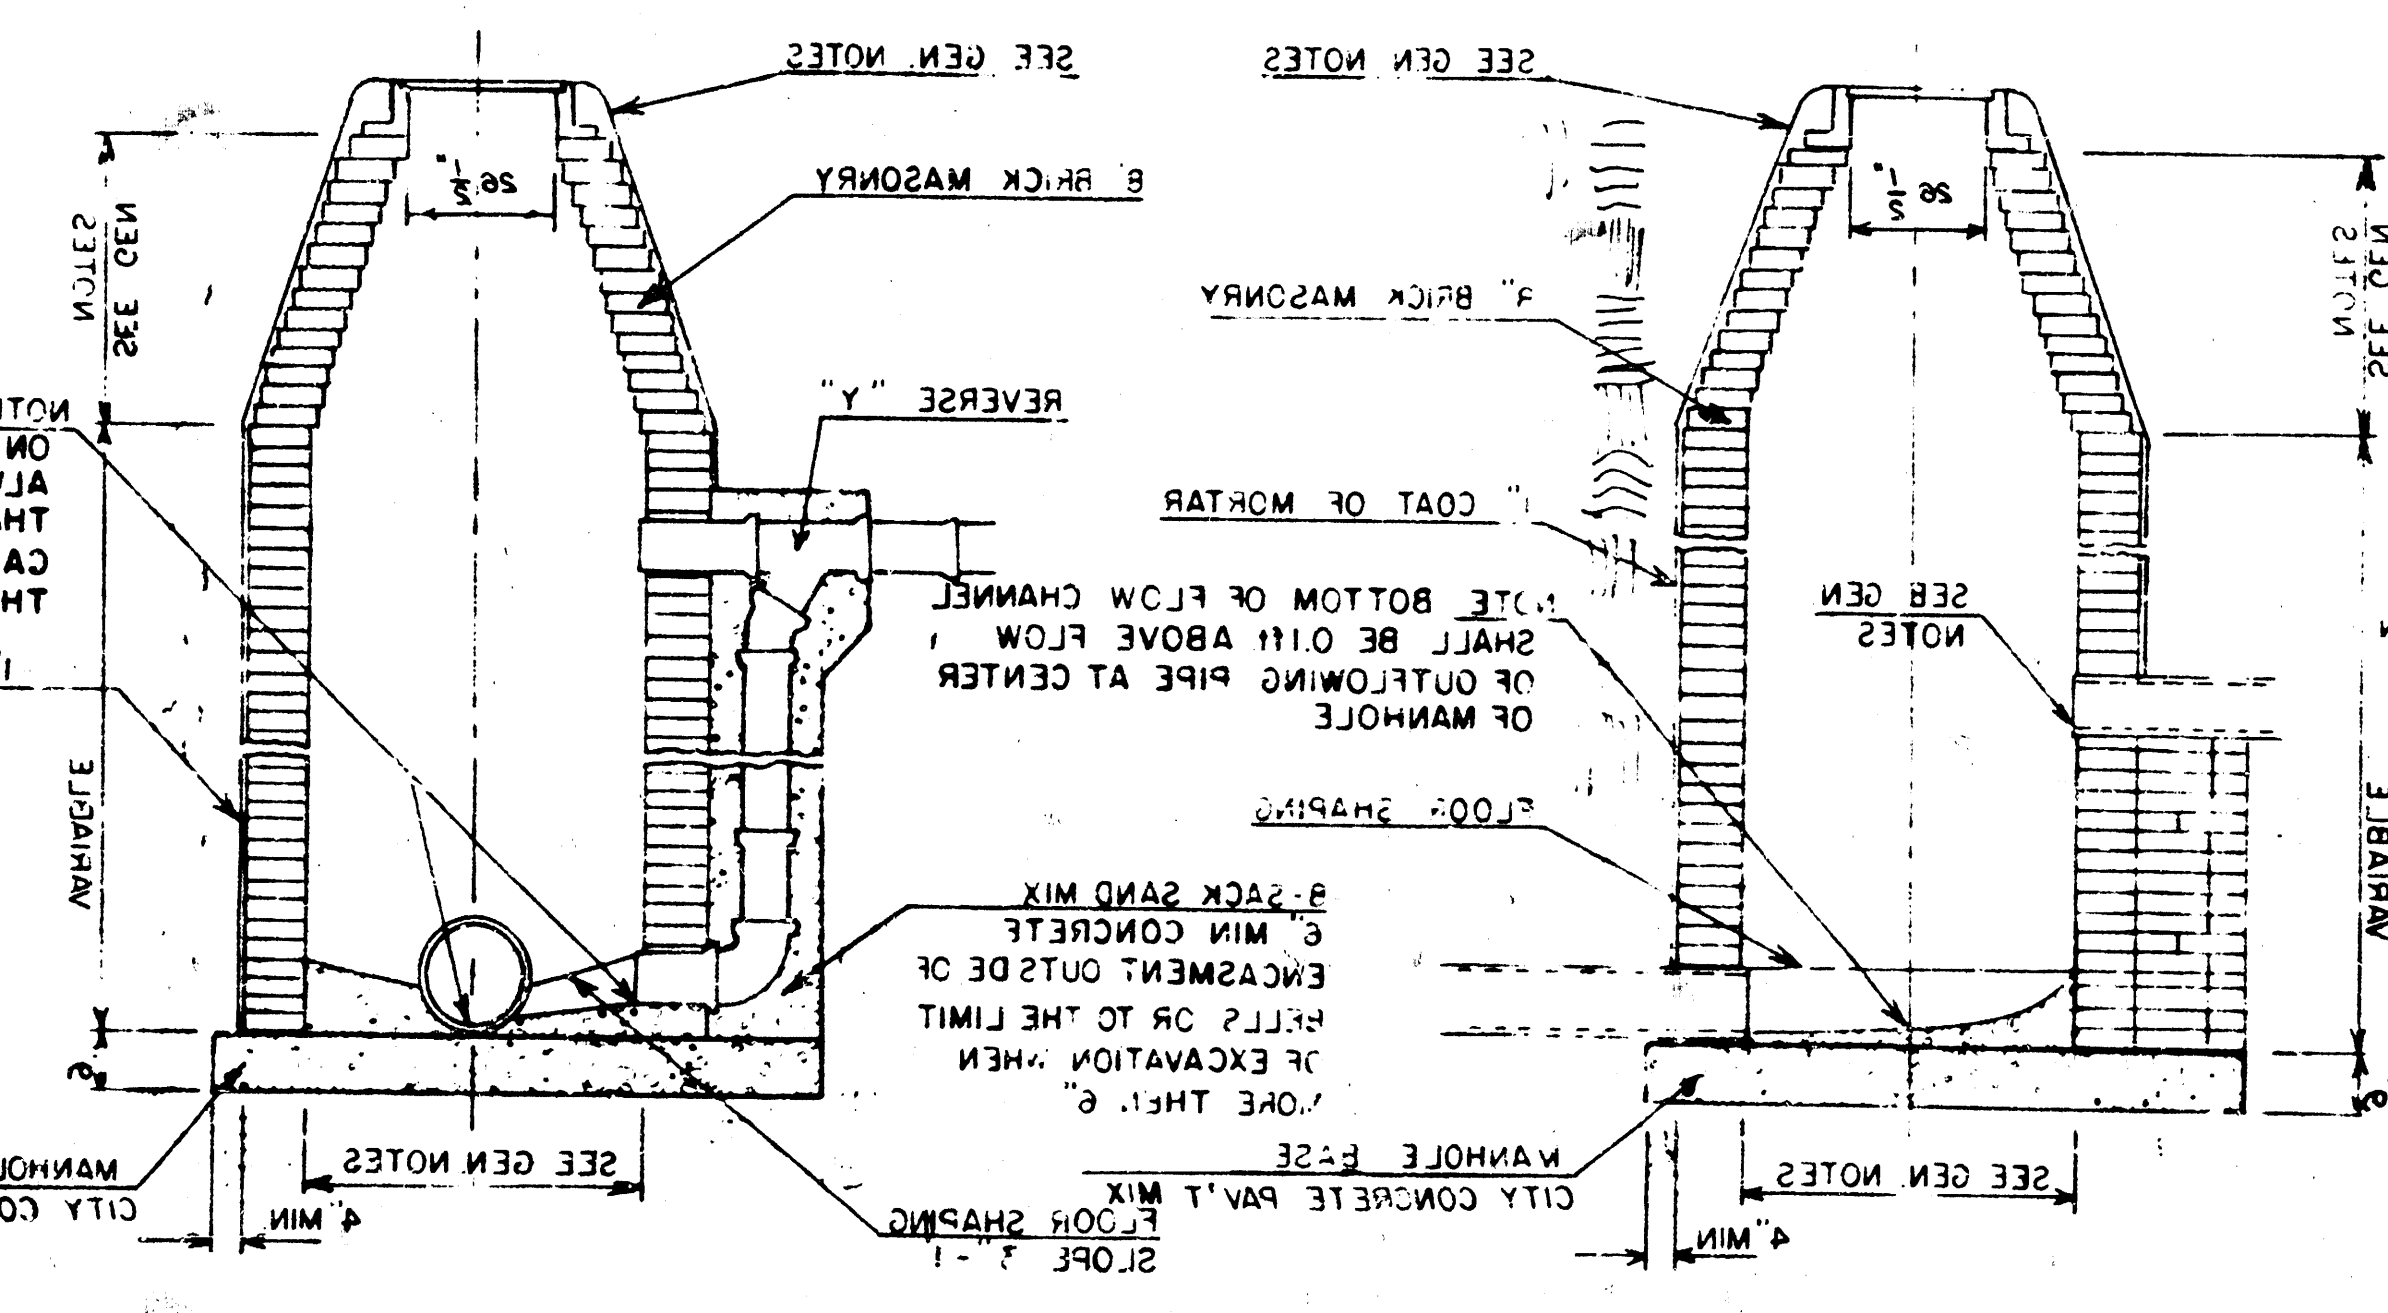

TYPE "A" OUTSIDE DROP MANHOLE

DETAIL OF OUTSIDE DROP
CONSTRUCTED ON EXISTING MANHOLE

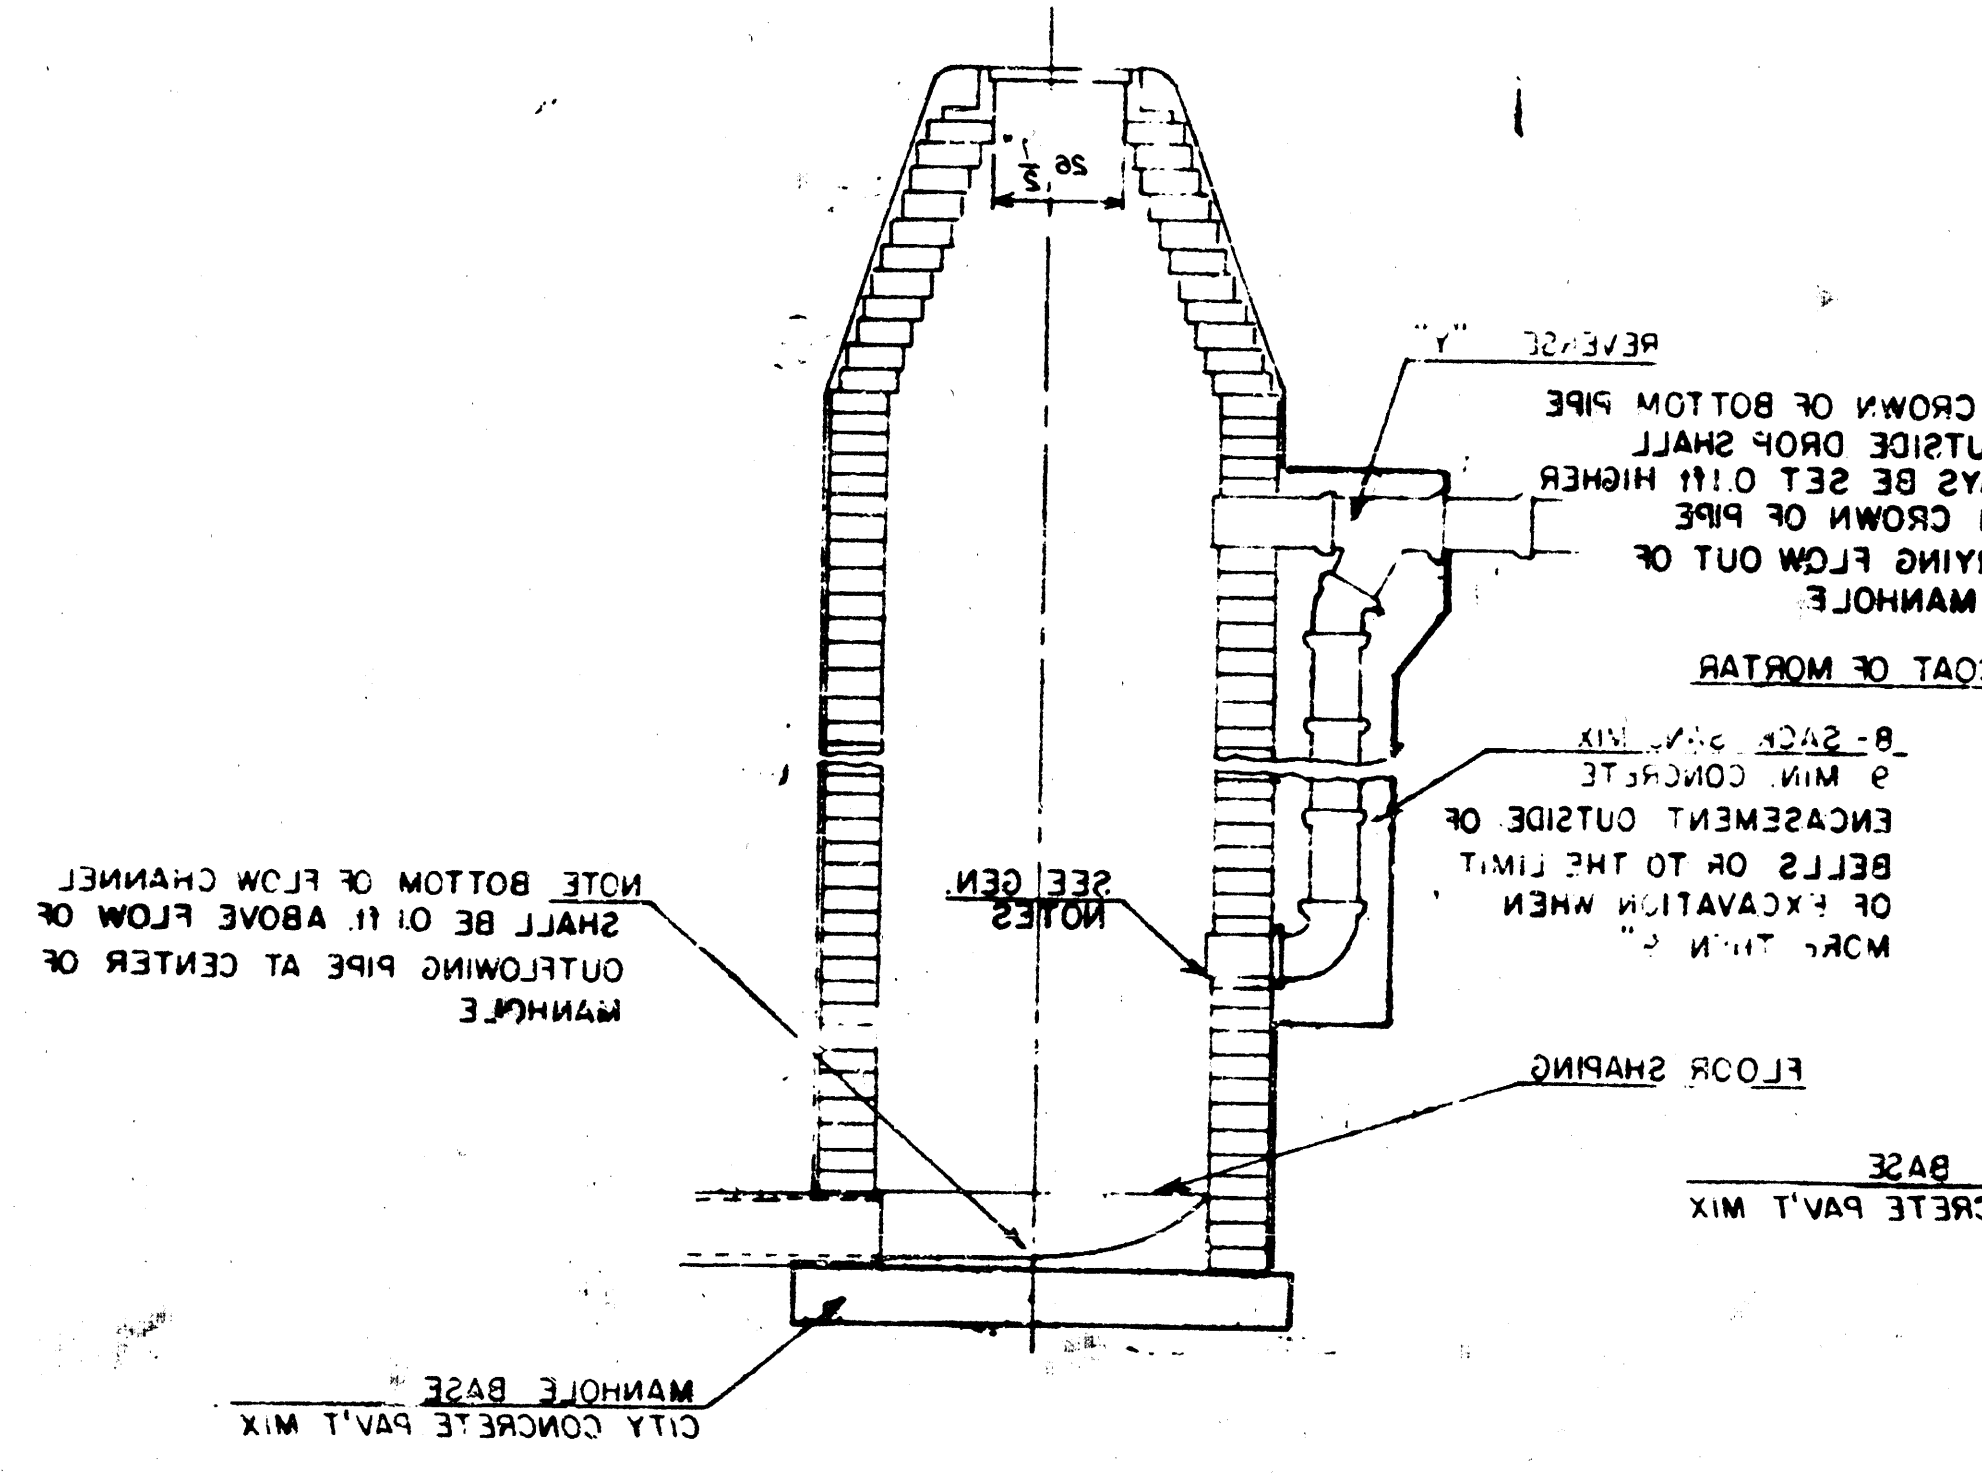


SEWER APPURTENANCES DETAILS

ADOPTED AS STANDARD DESIGN


BY

City of Wichita, Kansas


STANDARD MANHOLE TYPE "C"

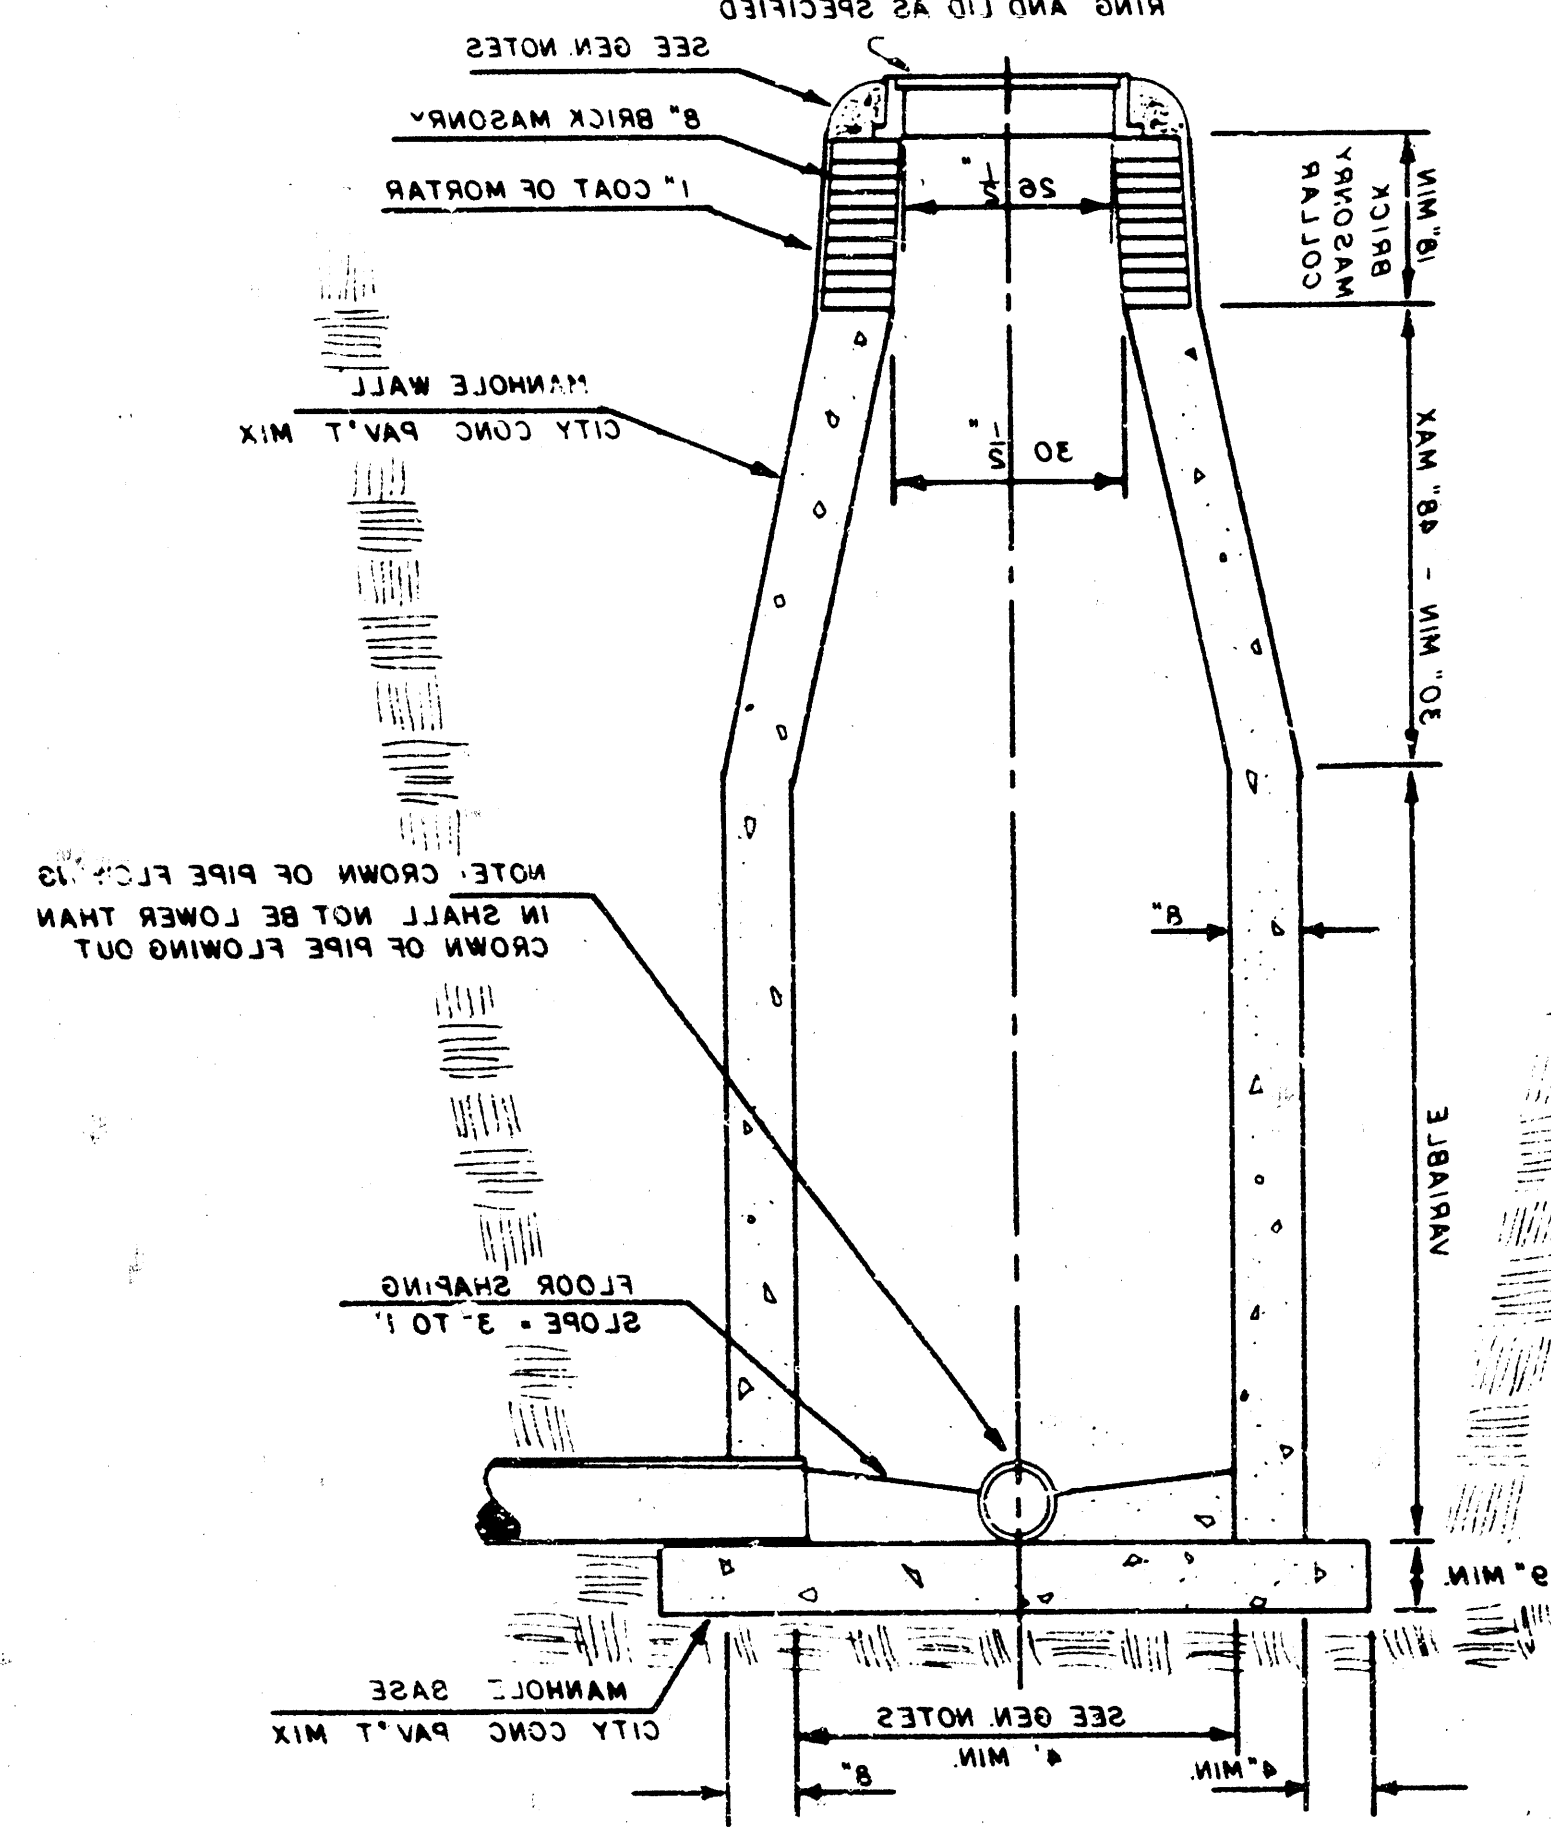

INSIDE DROP MANHOLE TYPE "C"

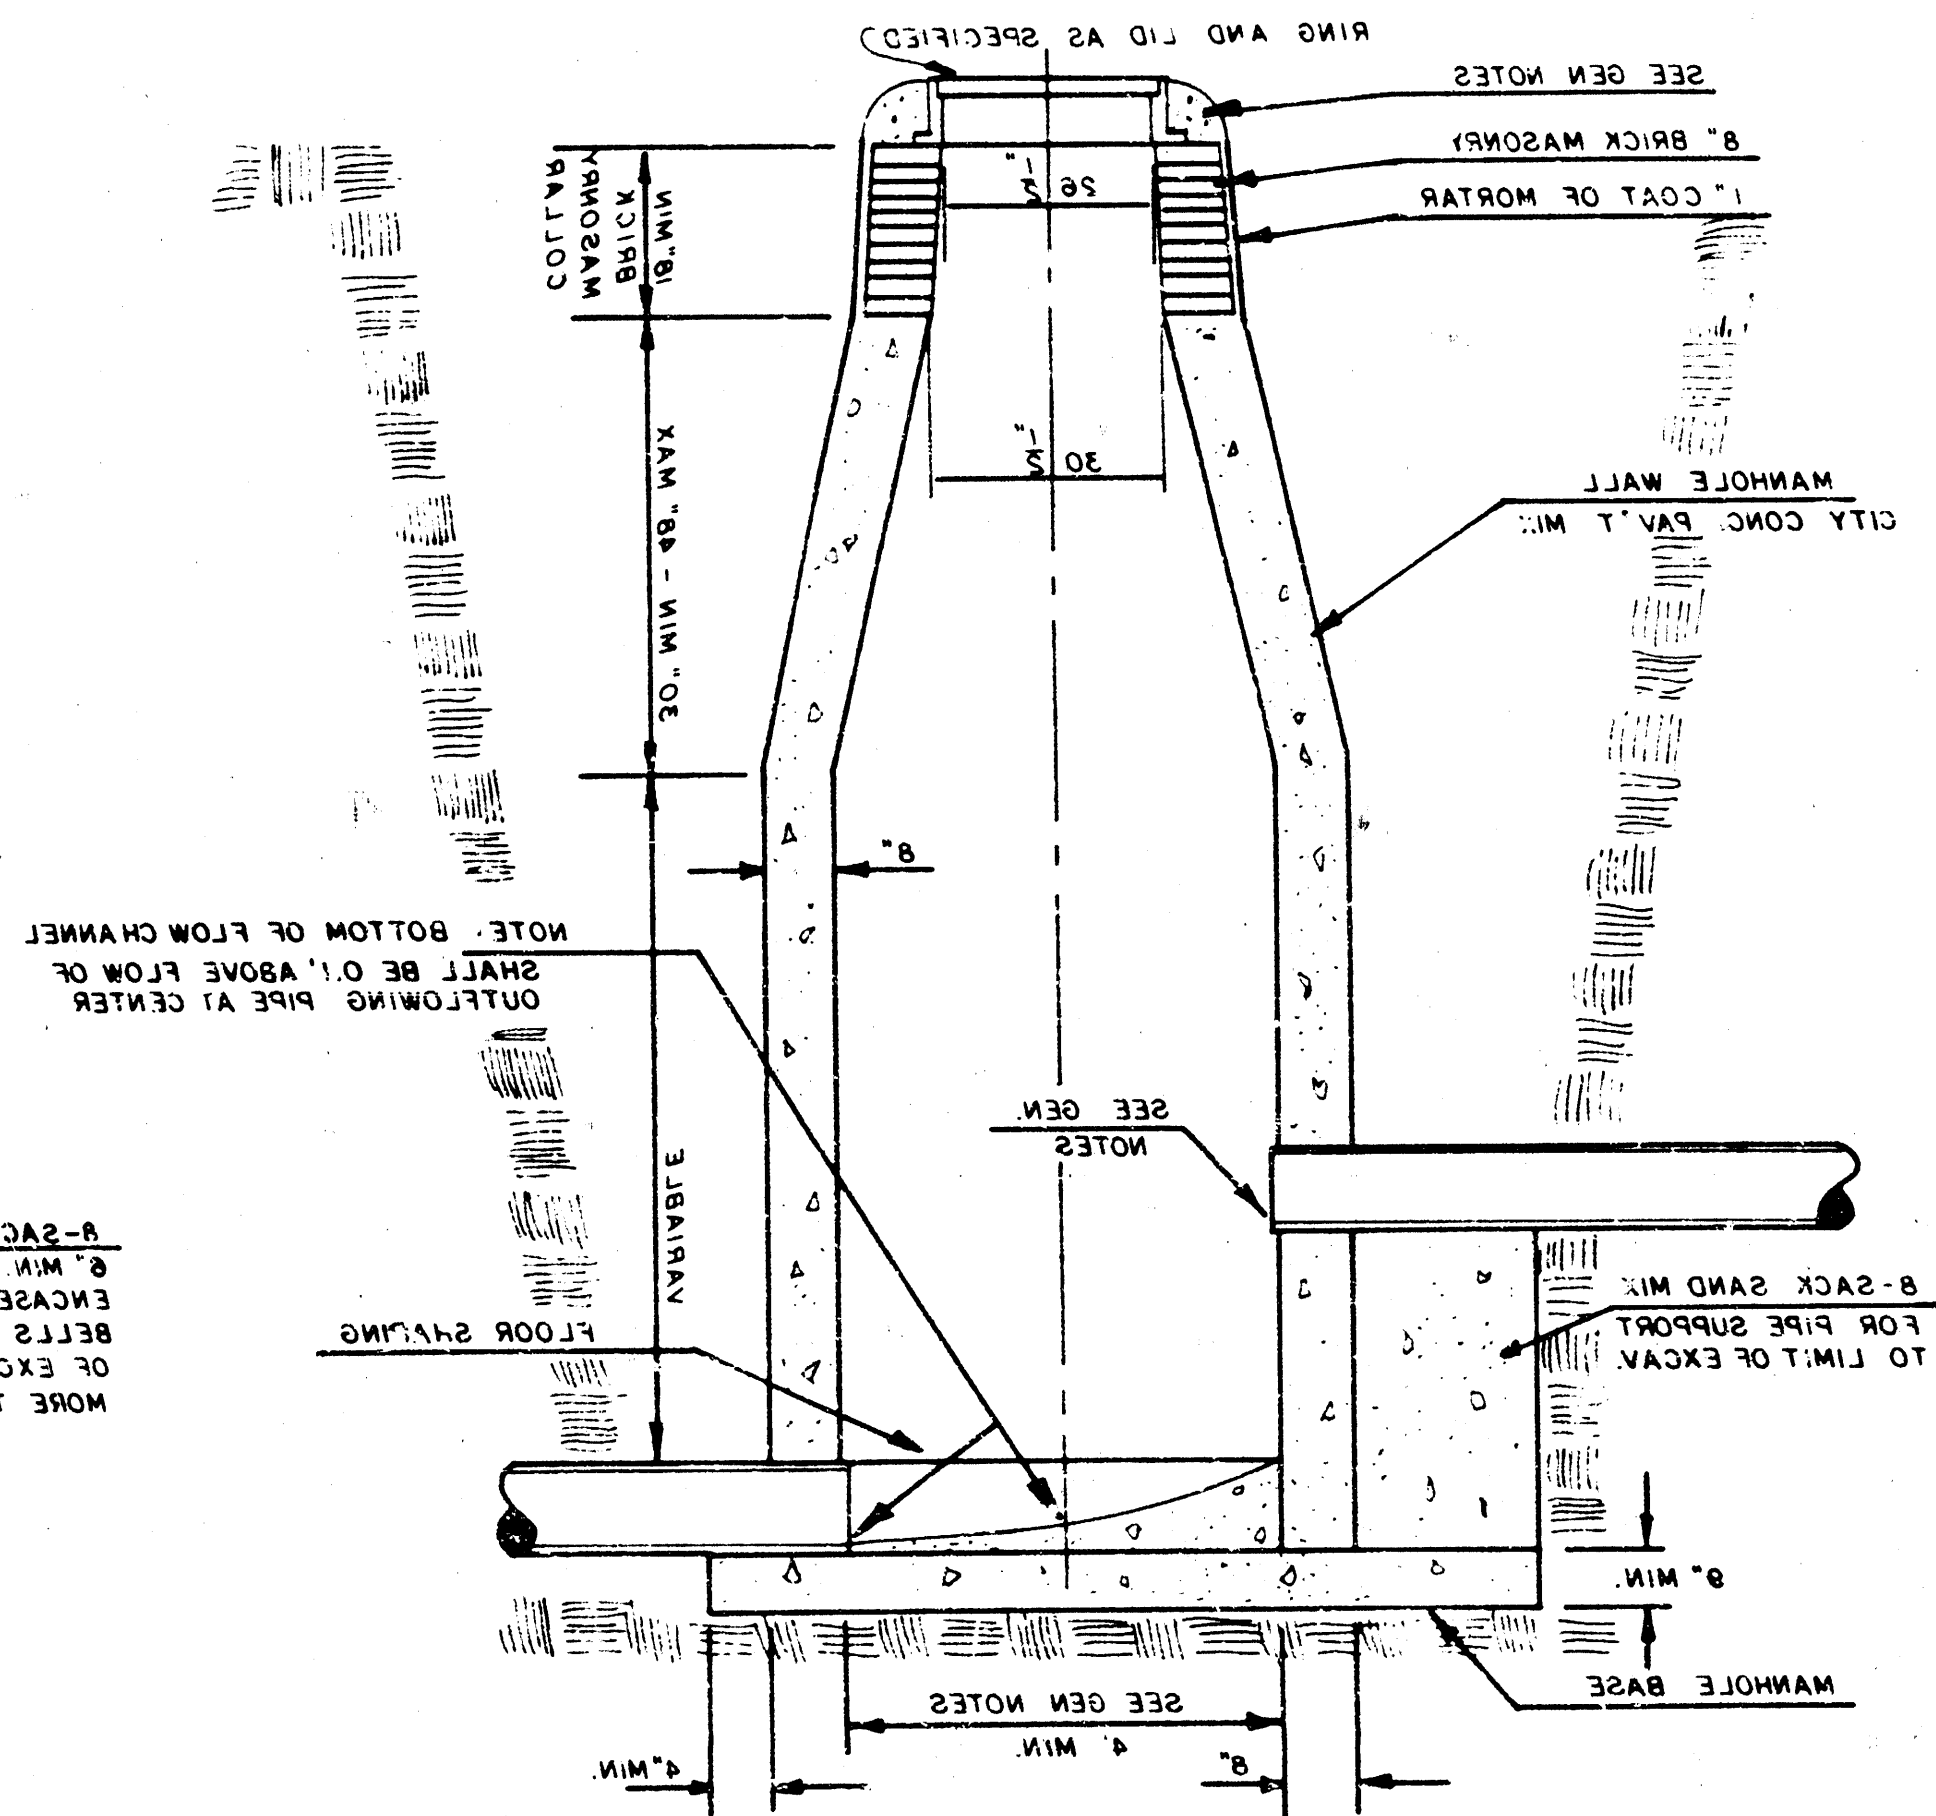

OUTSIDE DROP MANHOLE TYPE "C"

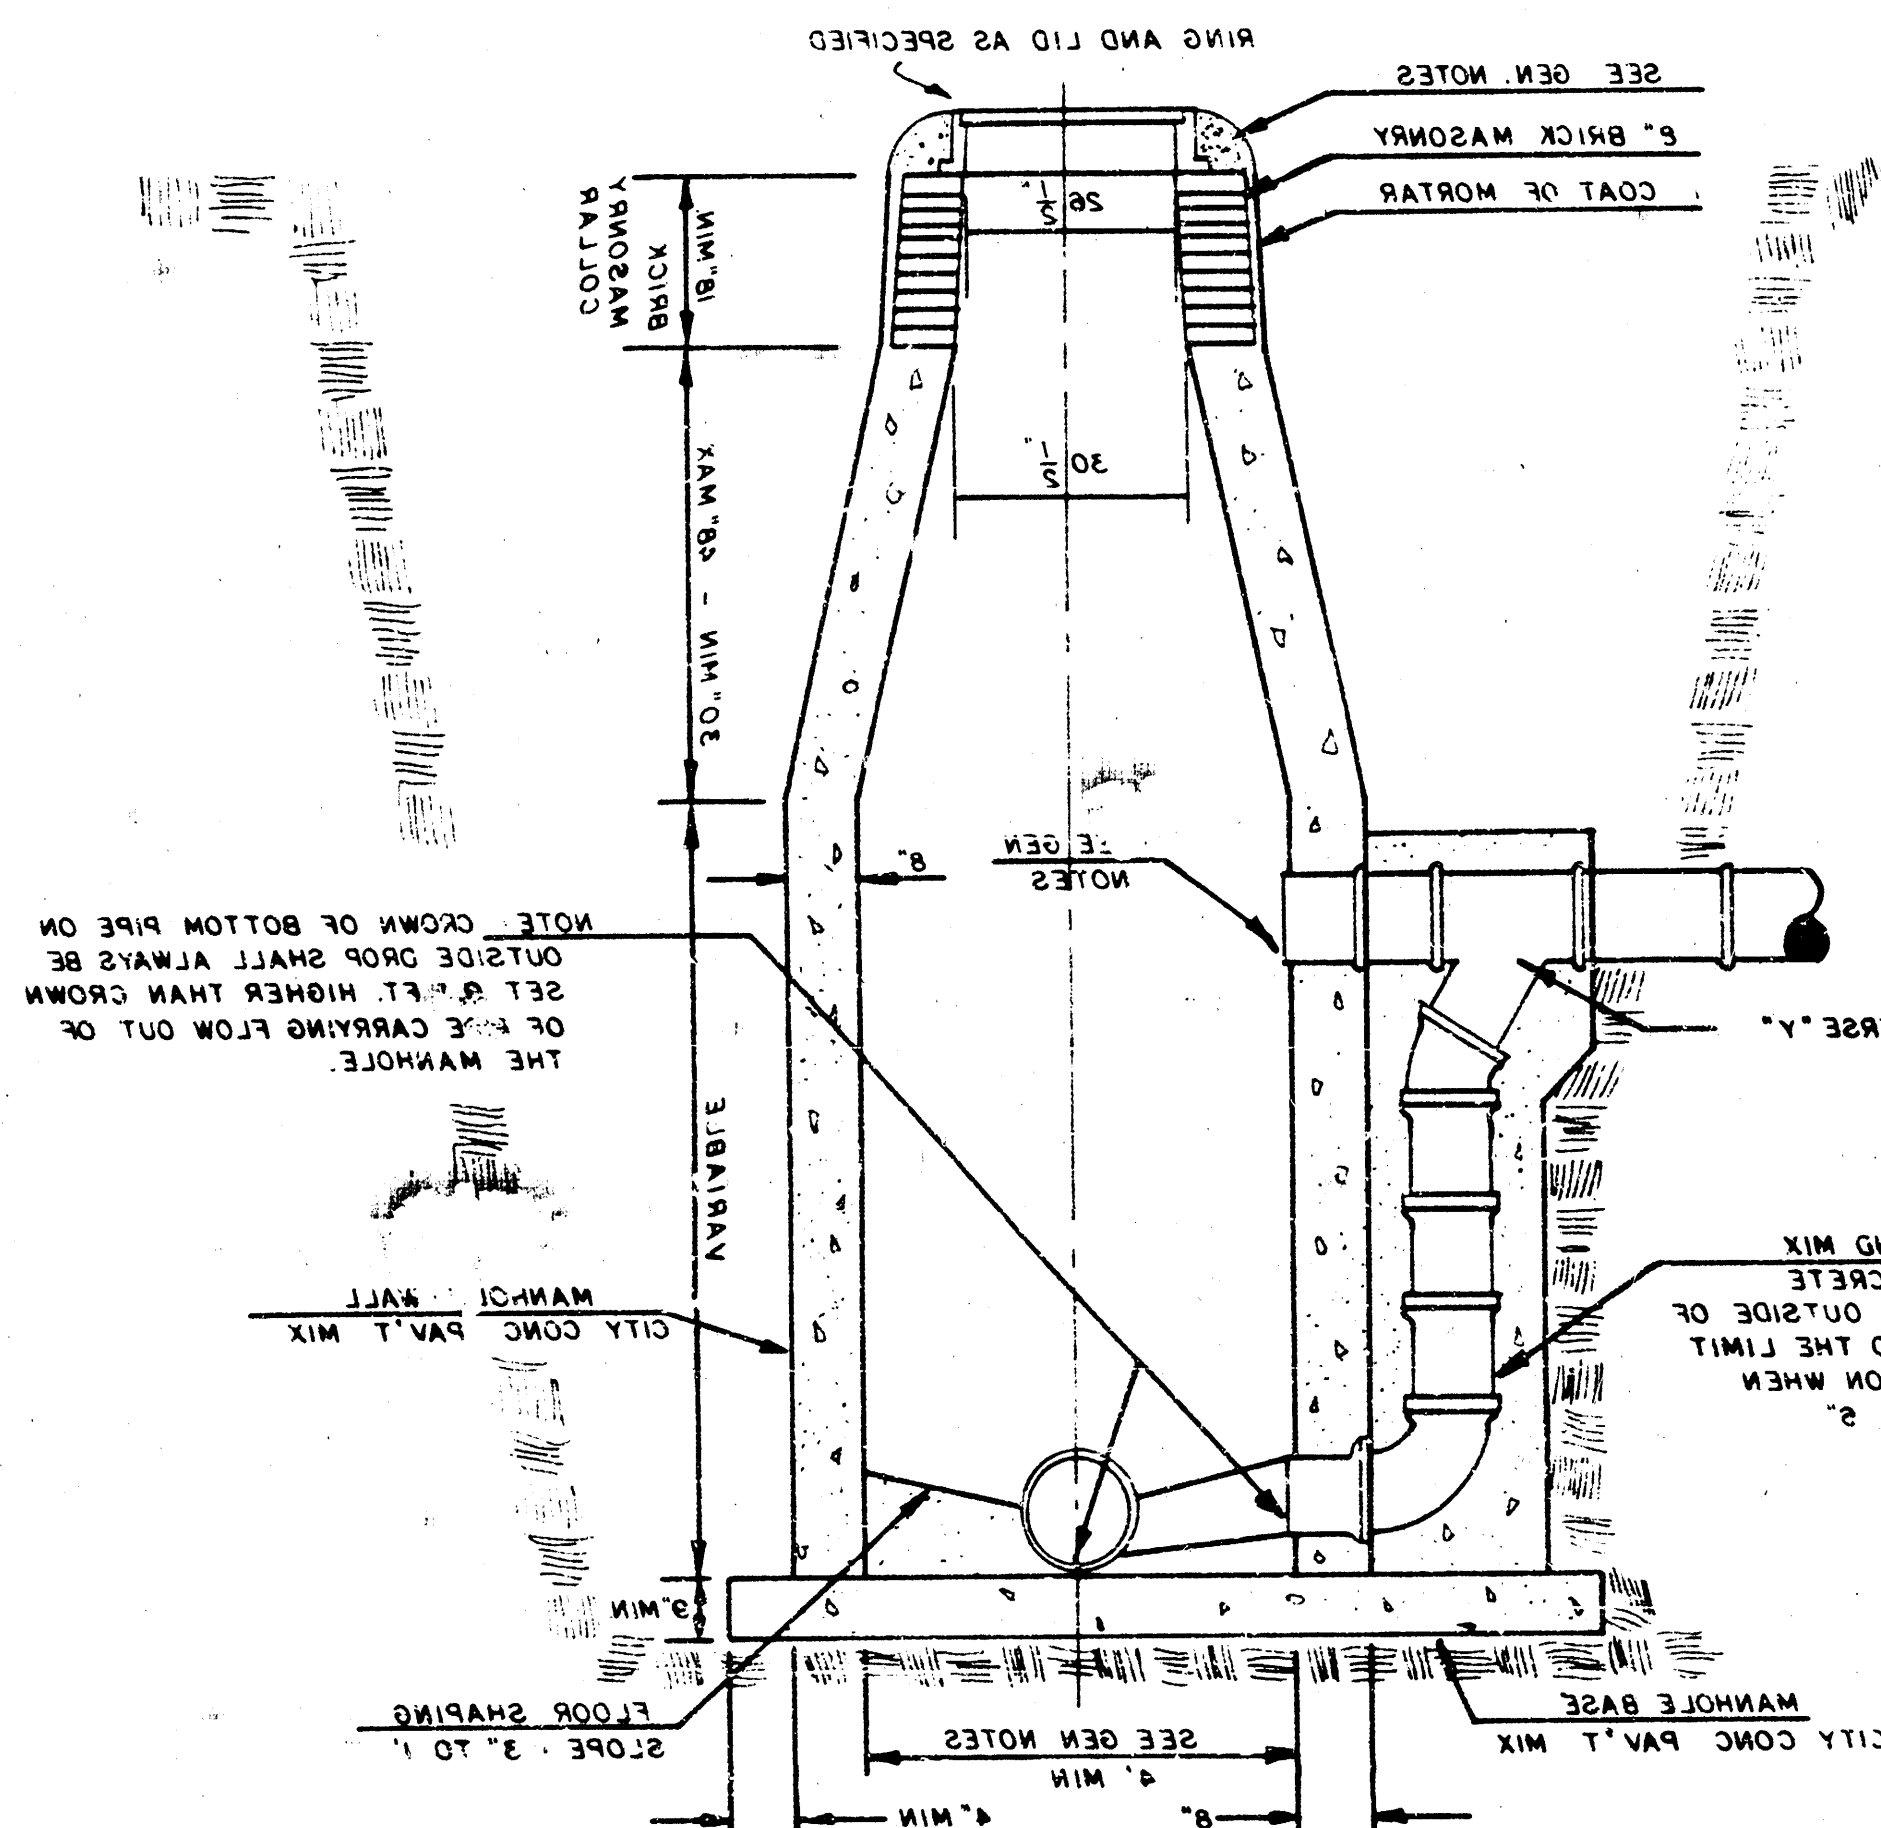

Notes and specifications for the manhole details, including material requirements and construction standards.

1. All masonry shall be constructed in accordance with the latest edition of the Building Code of the City of Wichita, Kansas.

2. The concrete base shall be a minimum of 12 inches thick and shall be reinforced with steel bars.

3. The brick masonry shall be laid in a running bond pattern and shall be finished with a smooth coat of mortar.

4. The manhole shall be installed in a vertical position and shall be aligned with the sewer line.

5. The manhole shall be installed in a location that is accessible for maintenance and repair.

6. The manhole shall be installed in a location that is not subject to flooding or other water damage.

7. The manhole shall be installed in a location that is not subject to vibration or other damage.

8. The manhole shall be installed in a location that is not subject to fire or other damage.

9. The manhole shall be installed in a location that is not subject to theft or other damage.

10. The manhole shall be installed in a location that is not subject to any other damage.

[illegible]