

B. M. 88.34 Head E. Bolt on Fire Plug N.W. Cor. Selma & Hydraulics.

Sta. 01000 H. Const. M. H. Type "A" or "C" over exist. 8" stub west.


Sta. 01450 Const. M. H. Type "A" or "C" over exist. 8" stub west.

Sta. 21850 Const. "C" Std. M. H. Type "A" or "C"

Sta. 41980 Const. Std. M. H. Type "A" or "C"

Sta. 71450 Const. Std. M. H. Type "A" or "C"

Sta. 91650 Const. Std. M. H. Type "A" or "C" Install 8" stub west. Plug stub west.

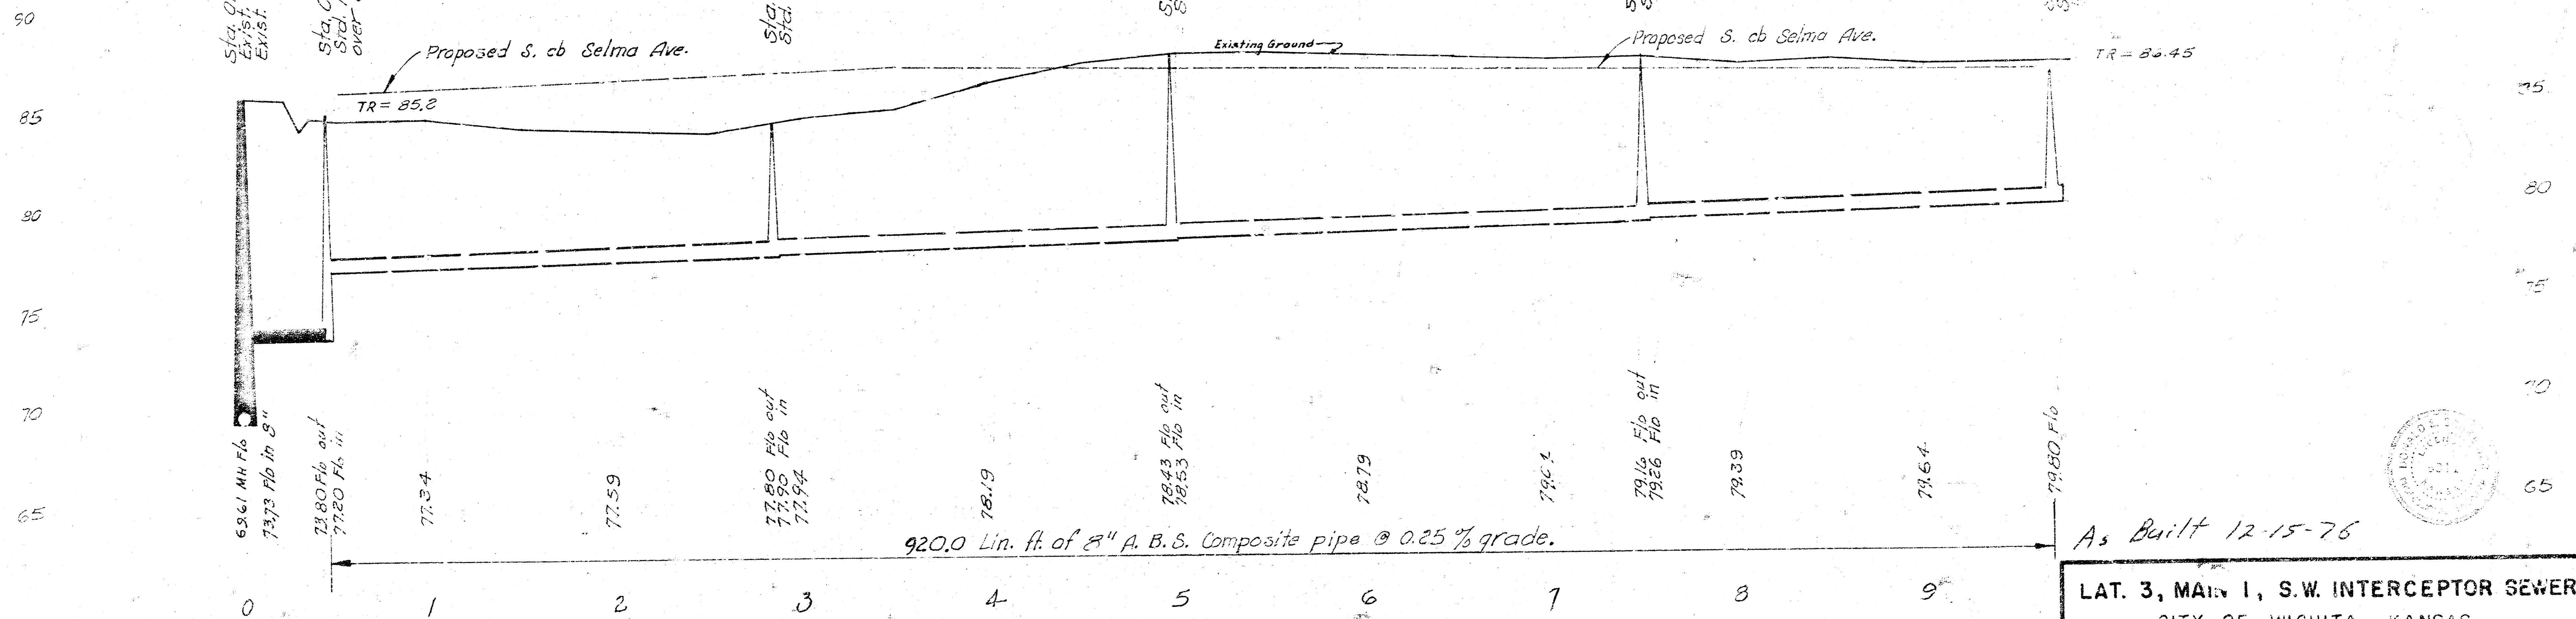

PLAN SCALE 1" = 40'
PROFILE SCALE 1" = 20'

As Built 12-15-76

LAT. 3, MAIN 1, S.W. INTERCEPTOR SEWER
CITY OF WICHITA, KANSAS
R. W. LINN CITY ENGINEER
1976 PROJECT NO. D3 KL569020