



DATE 10-20	RENS AND GOODNESS ENGINEERS	CAT # SUB	SHEET NO.
	260 E DOUGLAS WICHITA-KANSAS	SM INTERCEPTOR	31
		EXTENSION	

B.M. 6542 at 1st corner of lot 14 & 15th St
 B.M. 6543 at 1st corner of lot 14 & 15th St
 South Elev.

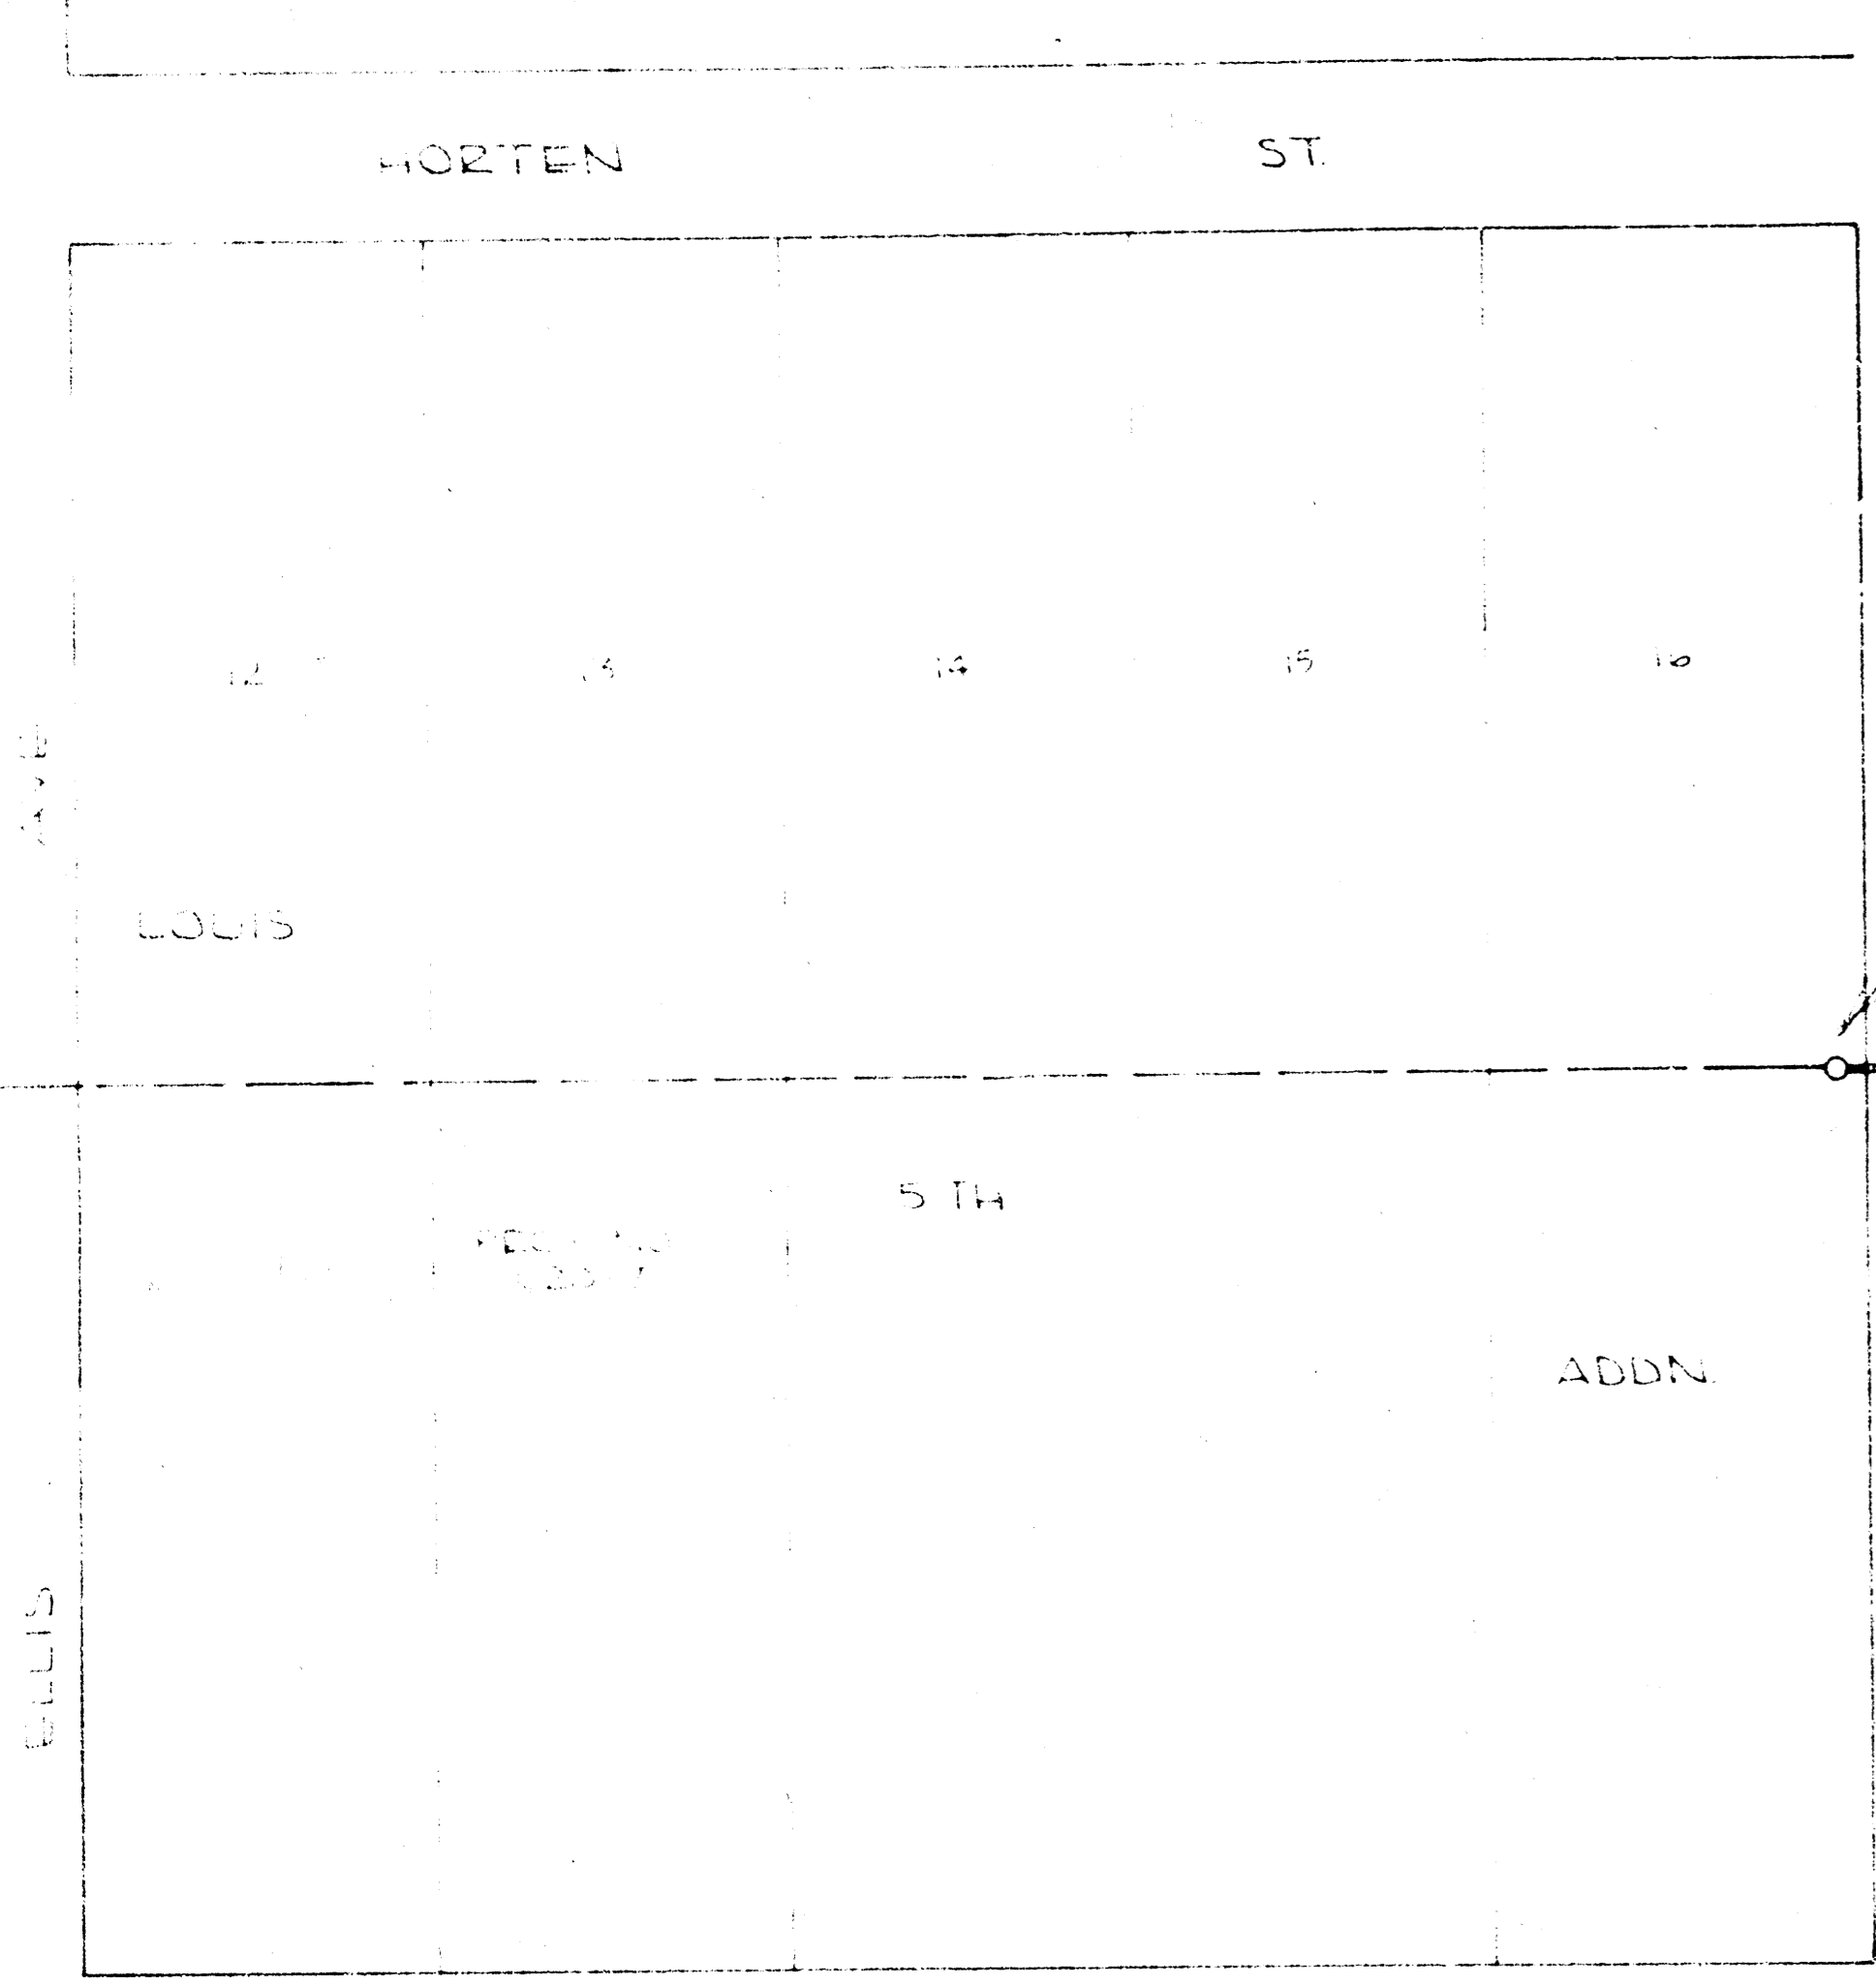


C O U R T E

SCALE
 PLAN 1"=40'
 PROFILE HORIZ 1"=40'
 VERT 1"=4'

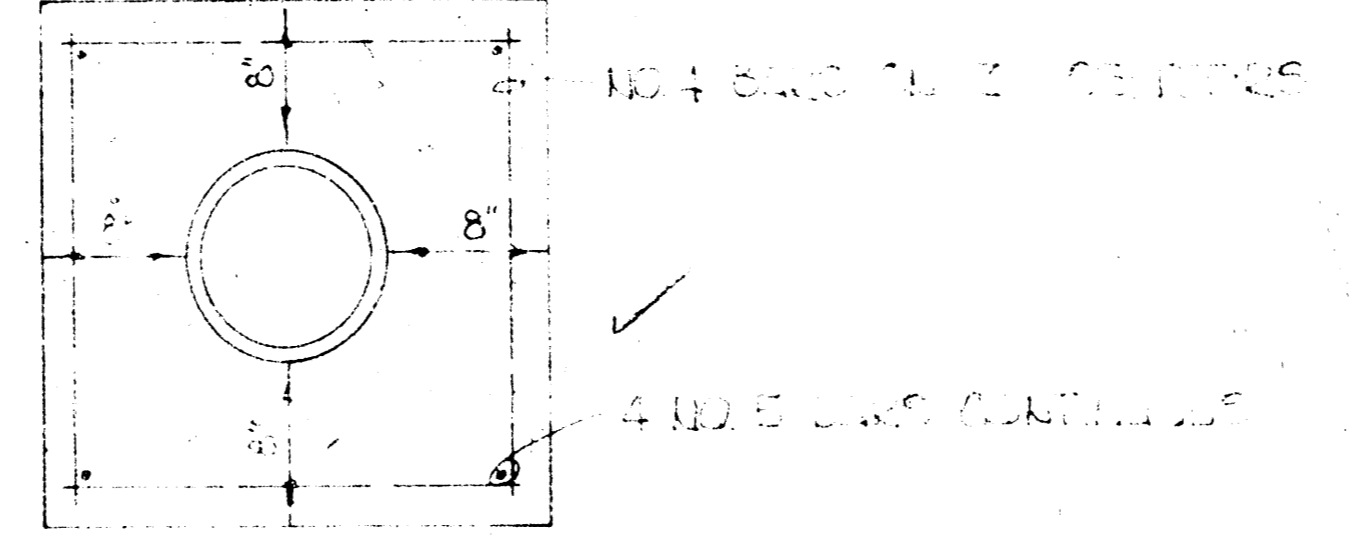


3000 RCP MANHOLE

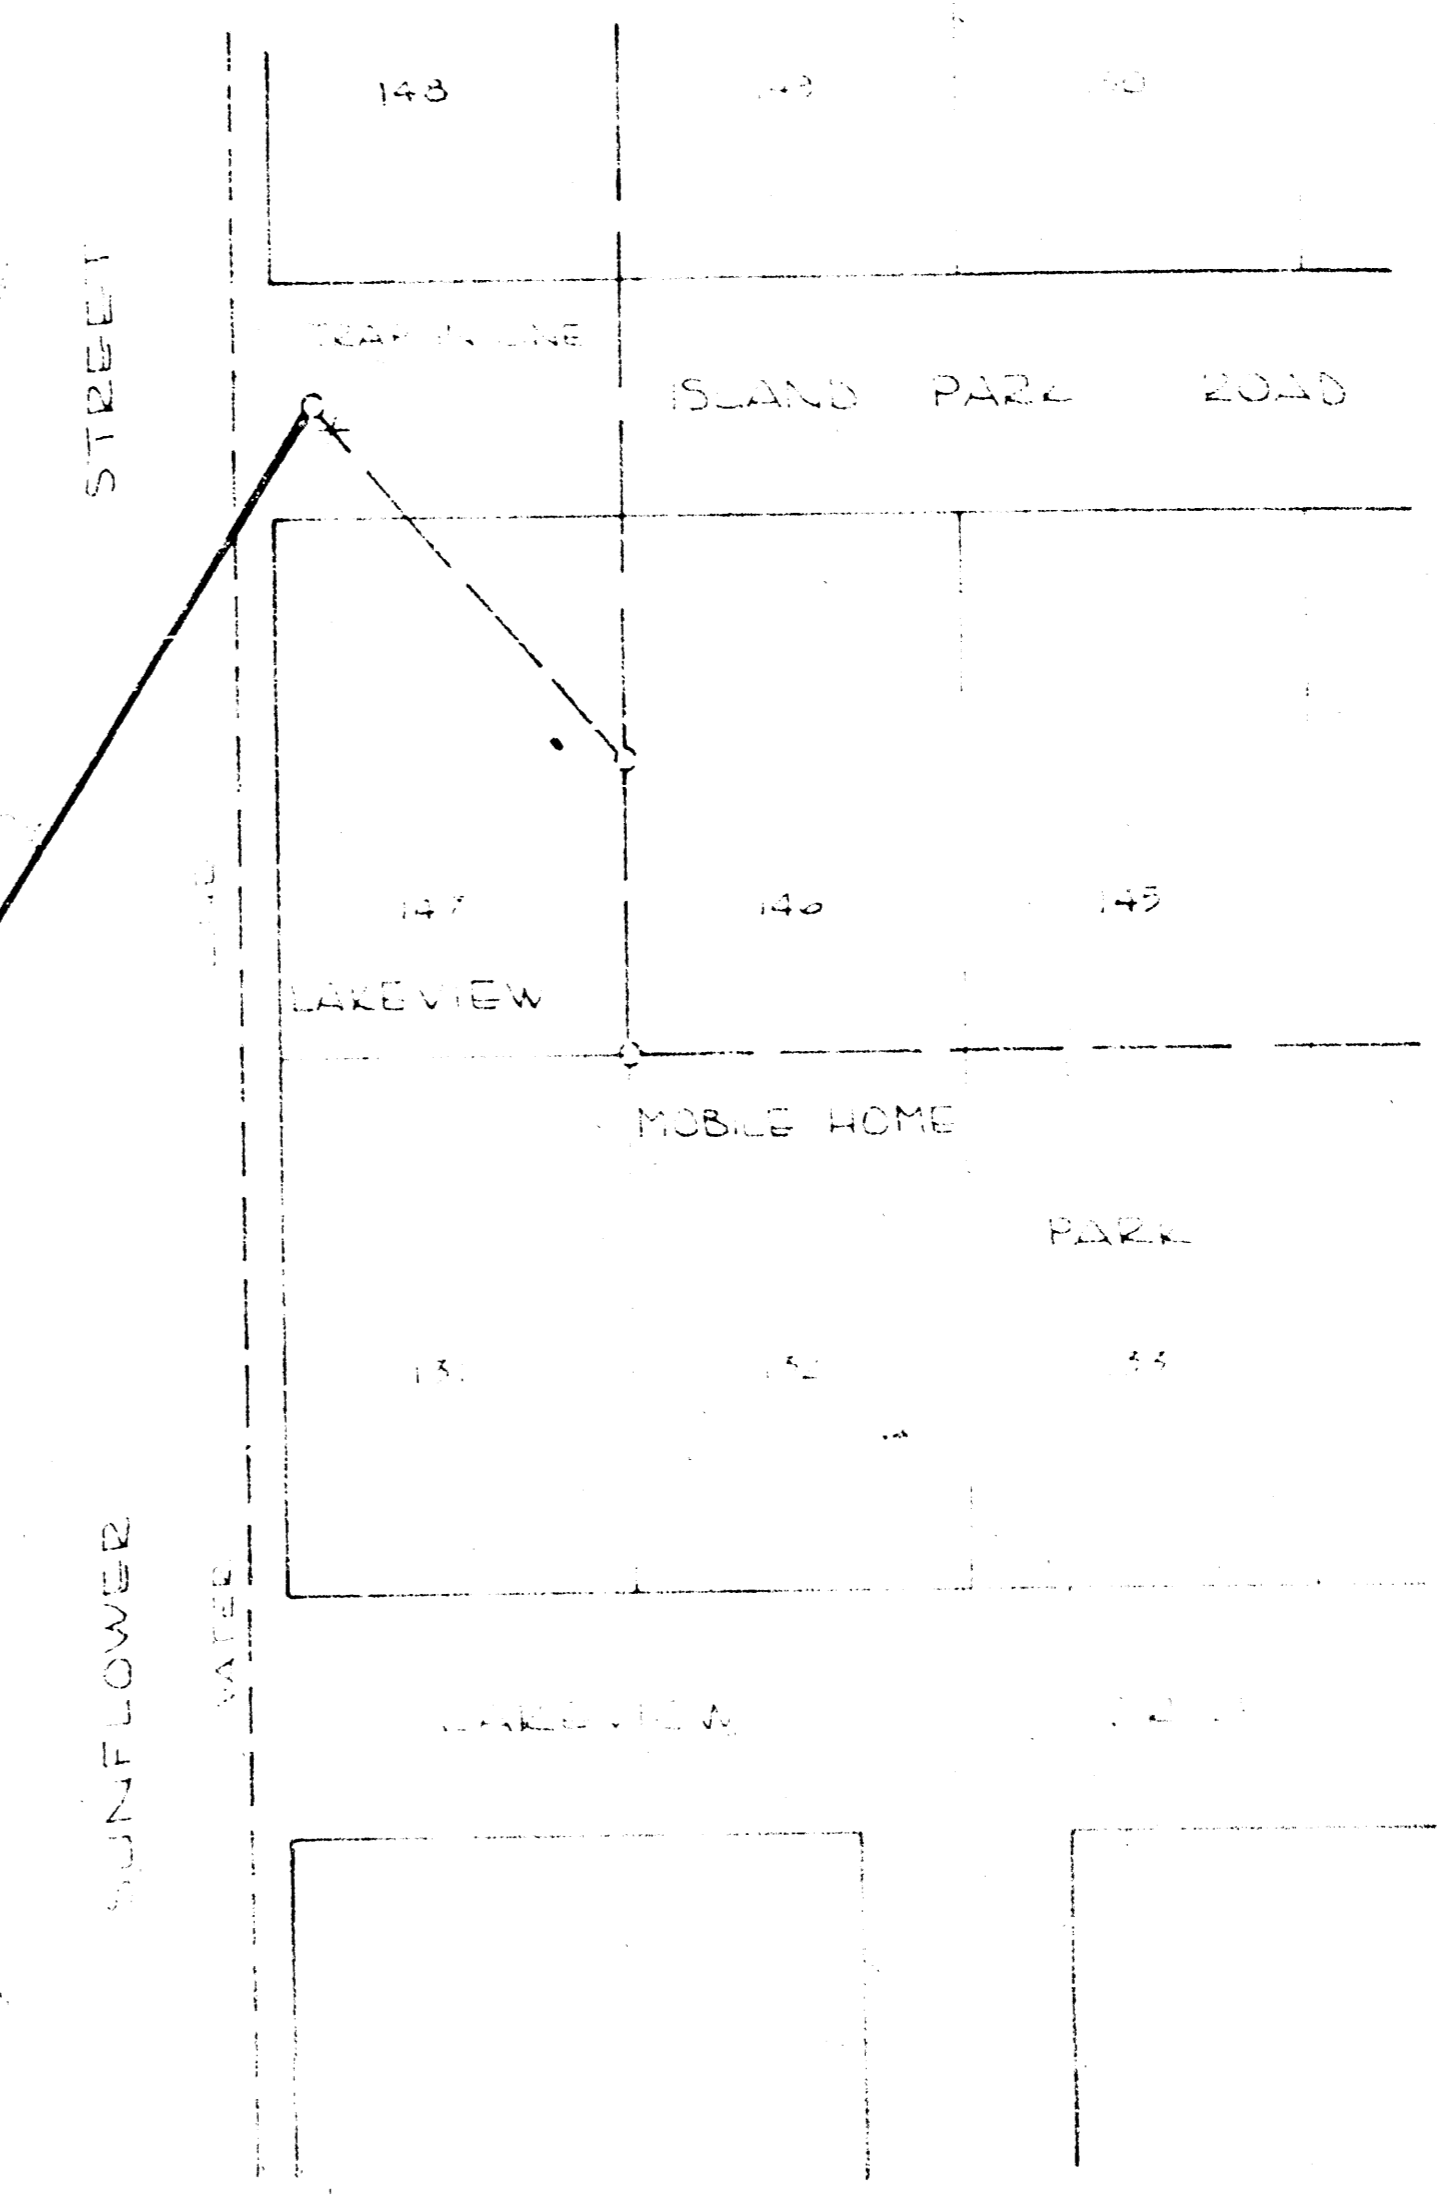

LICENSED CONTRACTOR
 This plan shall be constructed in accordance with the specifications of the City of Wichita, Kansas, and the specifications of the Kansas Department of Transportation, and the City of Wichita, Kansas, and the City of Wichita, Kansas, and the City of Wichita, Kansas.

APPROVED AS NOTED
BY THE CITY OF WICHITA
Storm
Utility Approaches

CONCRETE PLACEMENT DETAILS

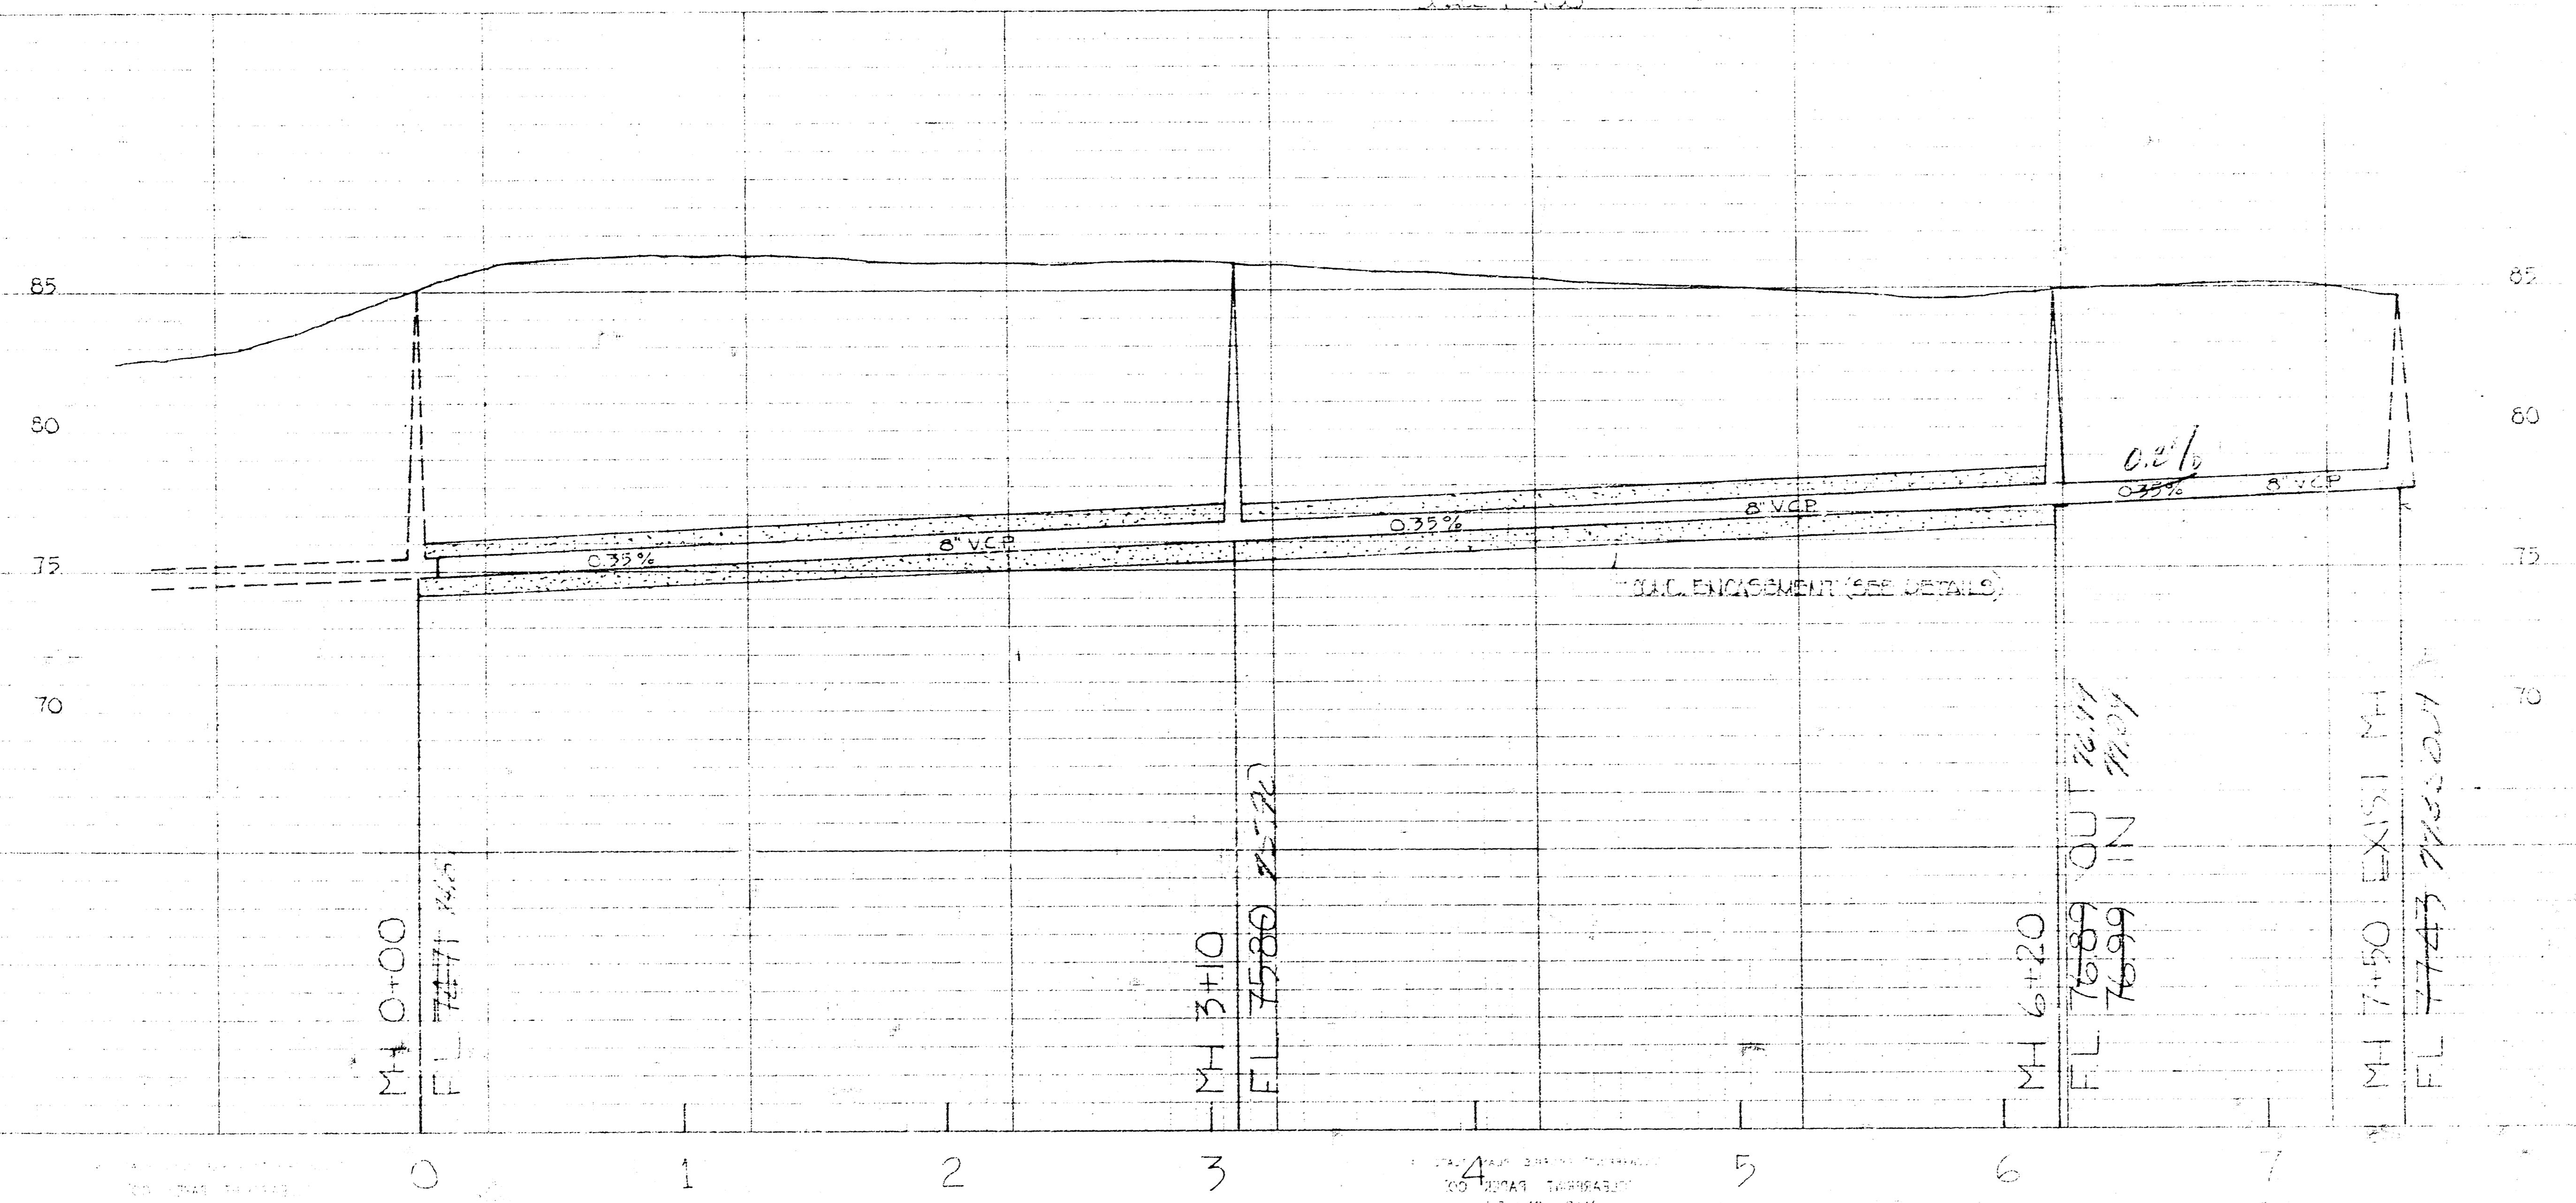

LAT. 9, CUR 1, SM INTERCEPTOR
 EXT.