
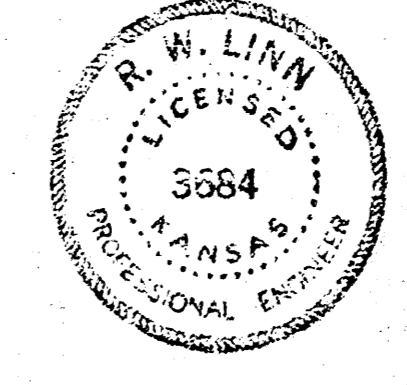
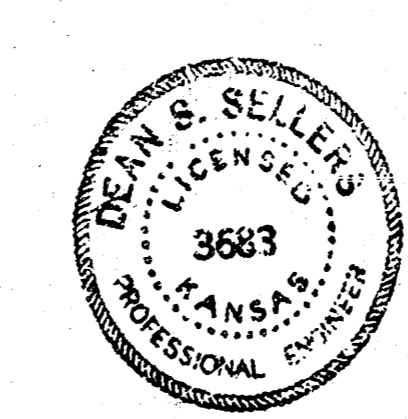


N
 Plan Scale 1" = 40'
 Profile Scale 1" = 5' Vert.

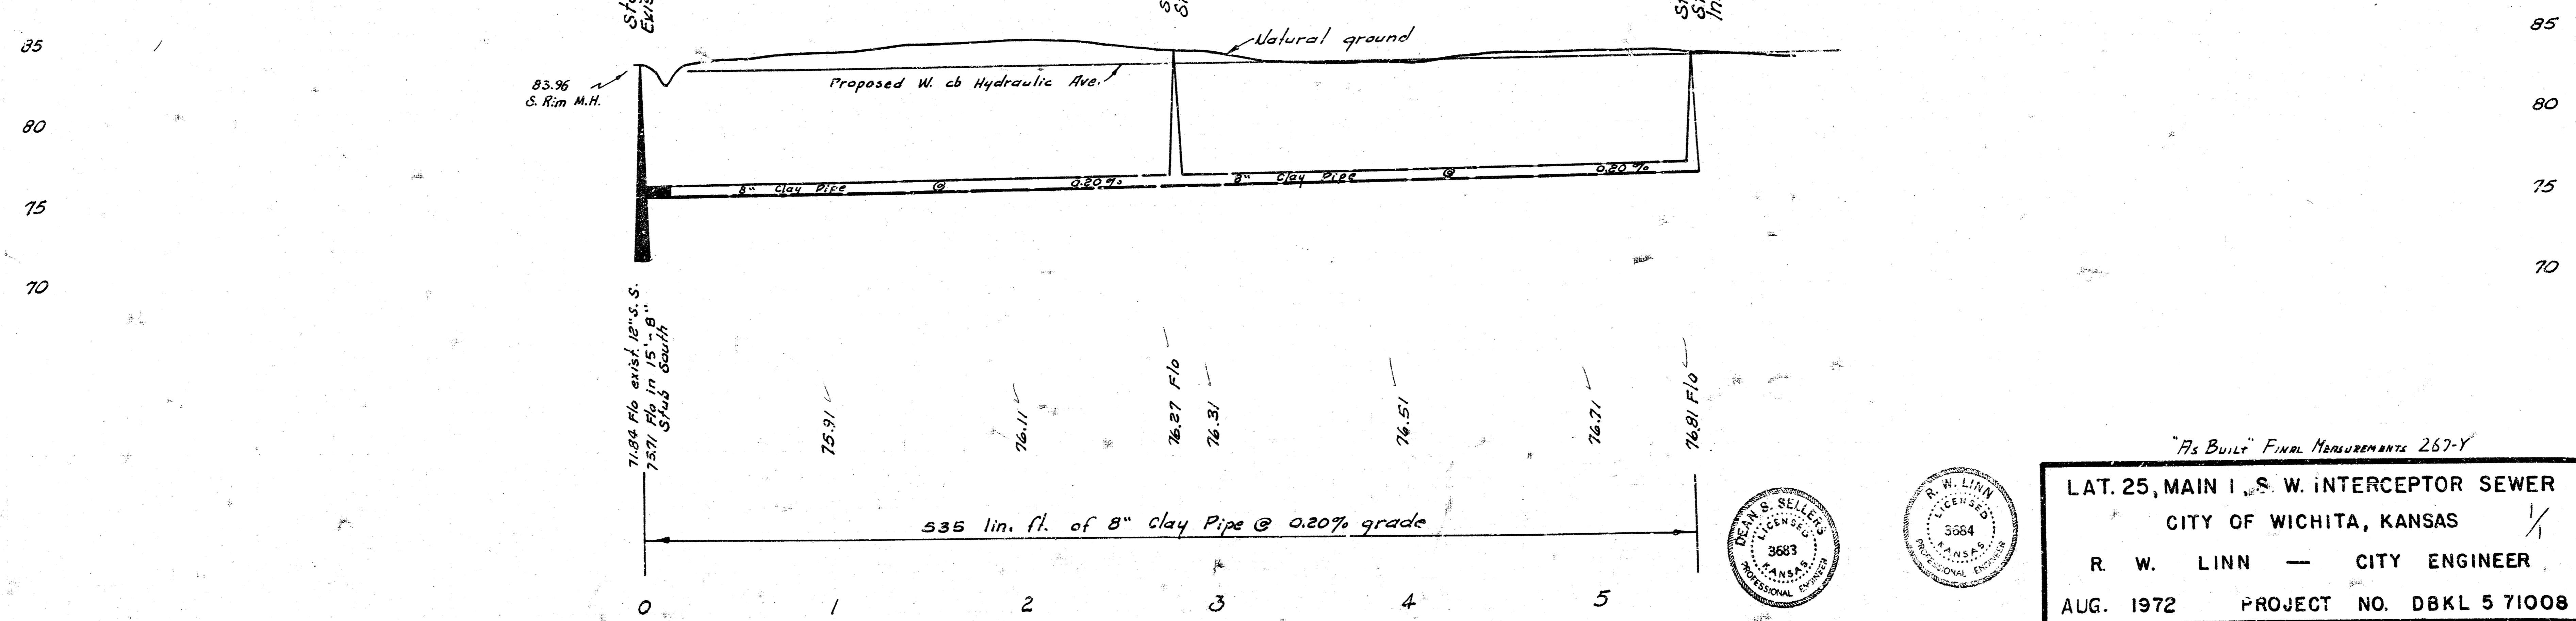

"As Built" FINAL MEASUREMENTS 267-Y
 LAT. 25, MAIN I, S. W. INTERCEPTOR SEWER
 CITY OF WICHITA, KANSAS
 R. W. LINN — CITY ENGINEER
 AUG. 1972 PROJECT NO. DBKL 5 71008

FILMED FROM THE BEST AVAILABLE COPY