


DCD 104
MSR


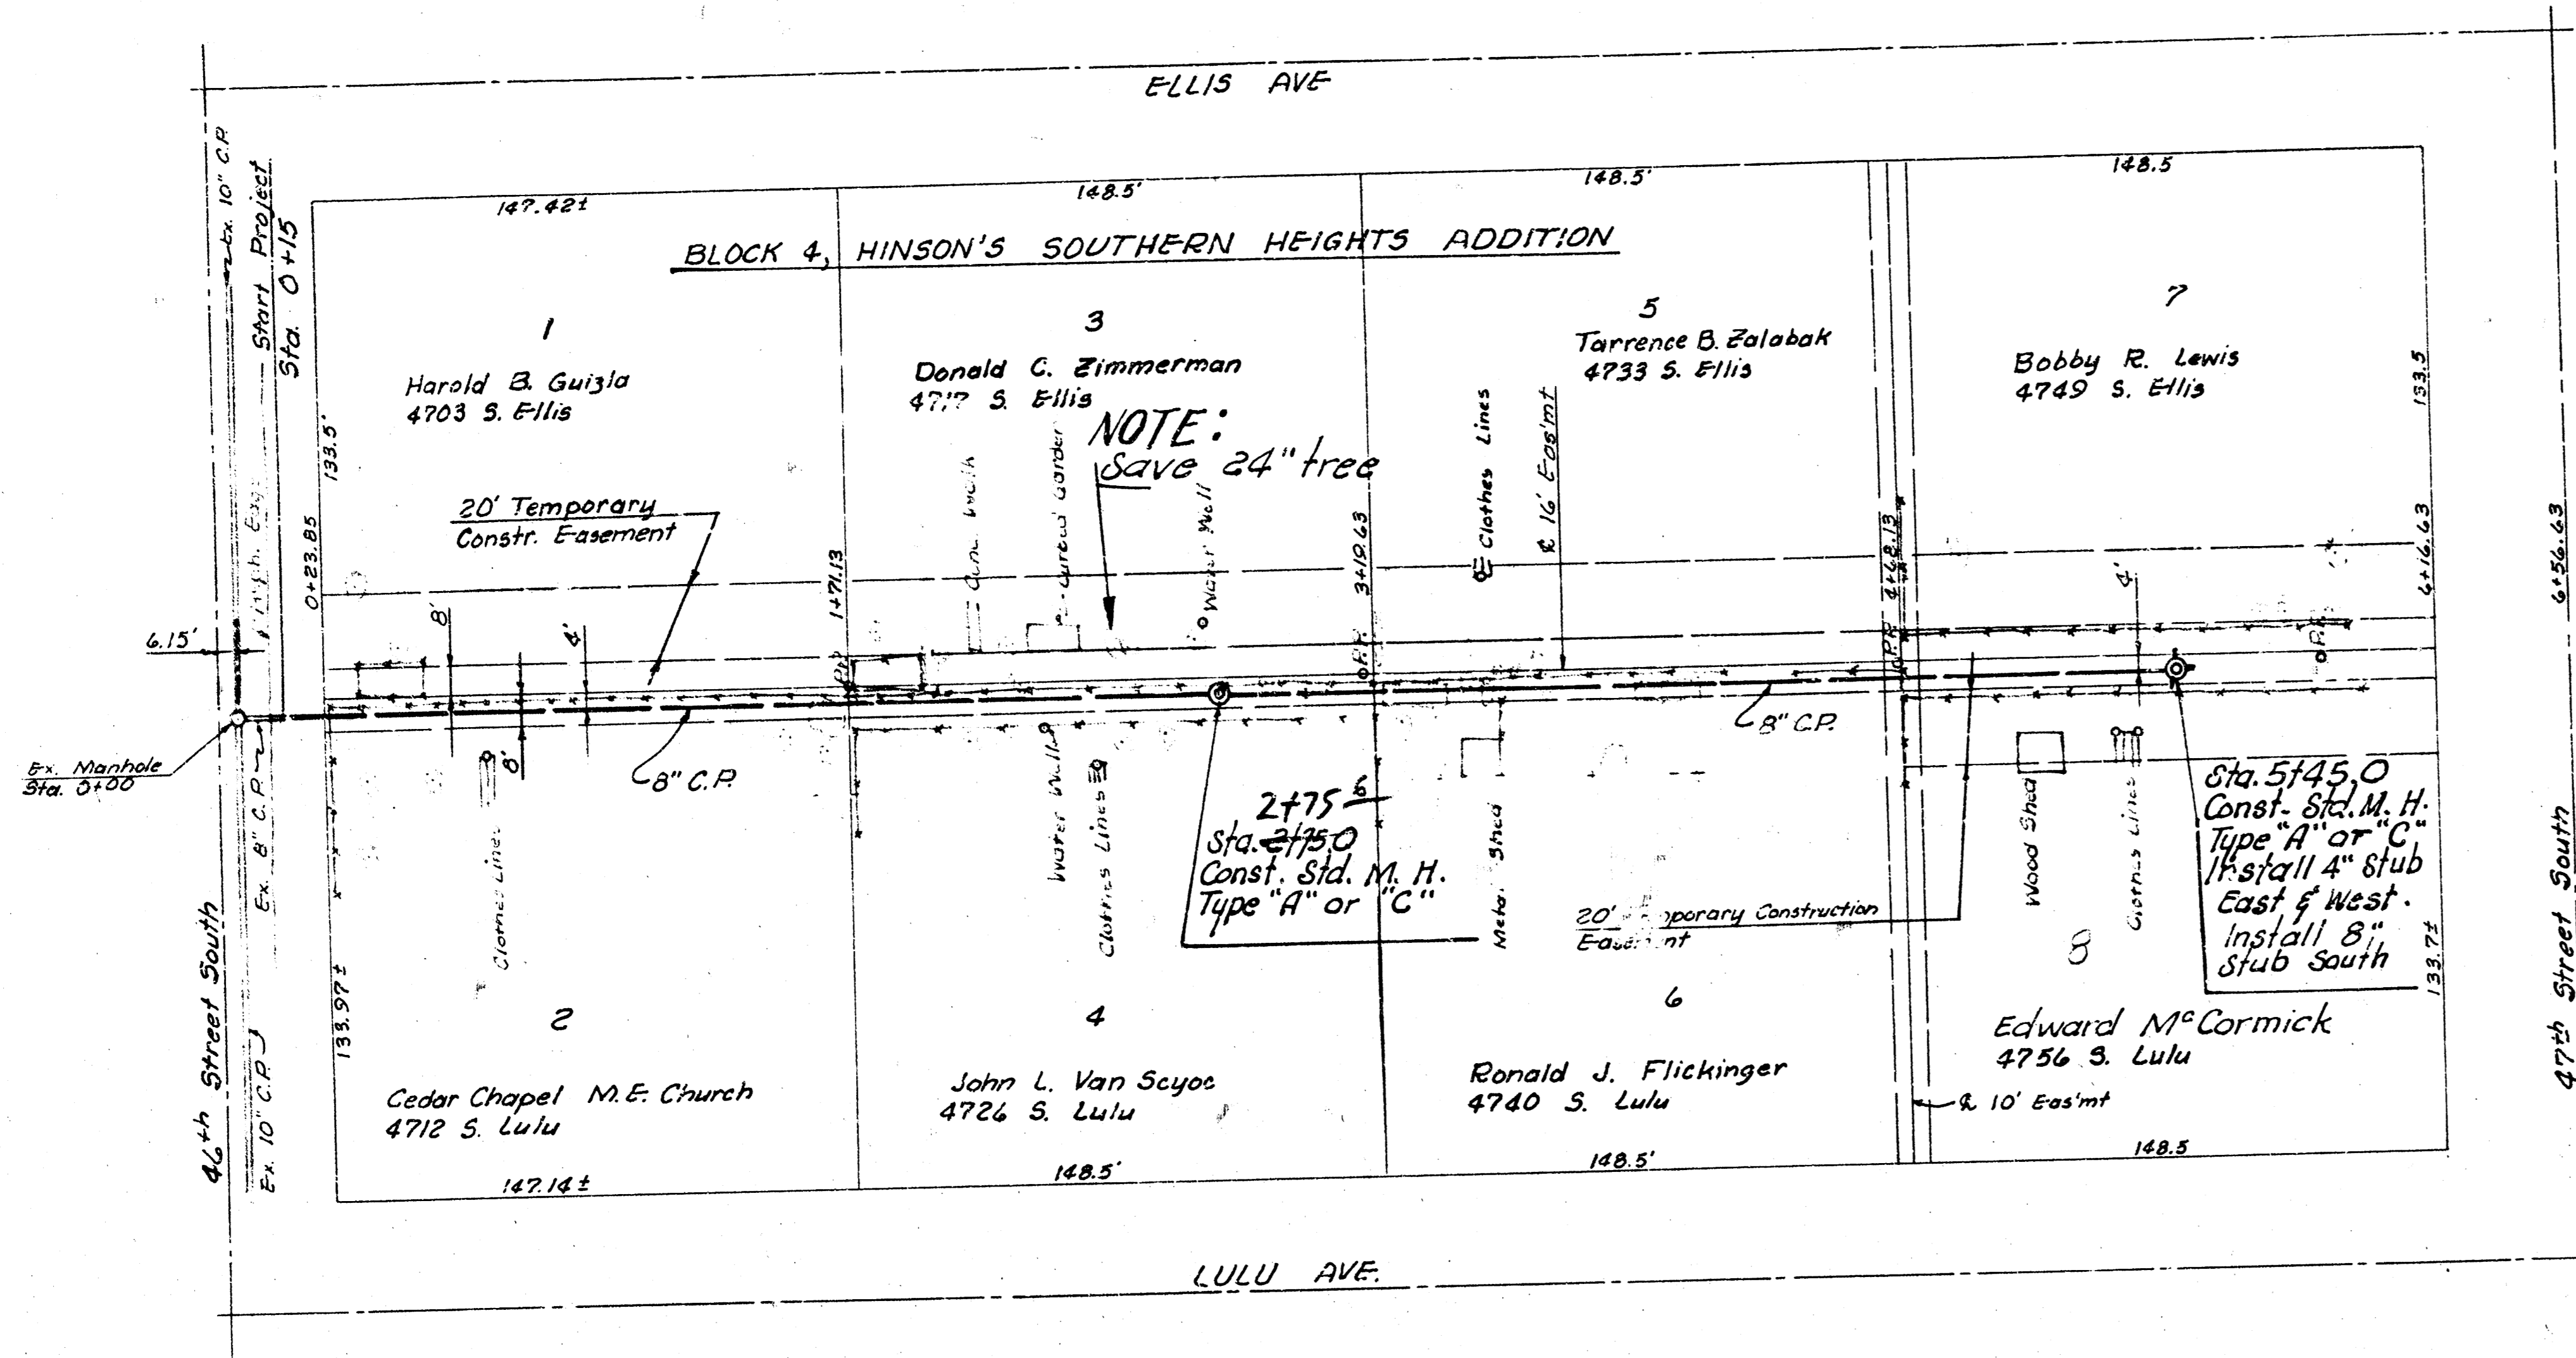


BM 86.14 "M" in Mueller, Fire Hyd. Flange @ N.E. cor. Lulu & 47th St. S.

BM 82.53 City Std N.E. cor Ida & 47th St. S.

Benefit Dist: Lots 1 thru 8 incl, Blk 4, Hinson's Southern Heights, Sec. 16, T28S, R1E, Wichita, Kansas.

General Location: Between Lulu & Ellis and 46th So. & 47th So.

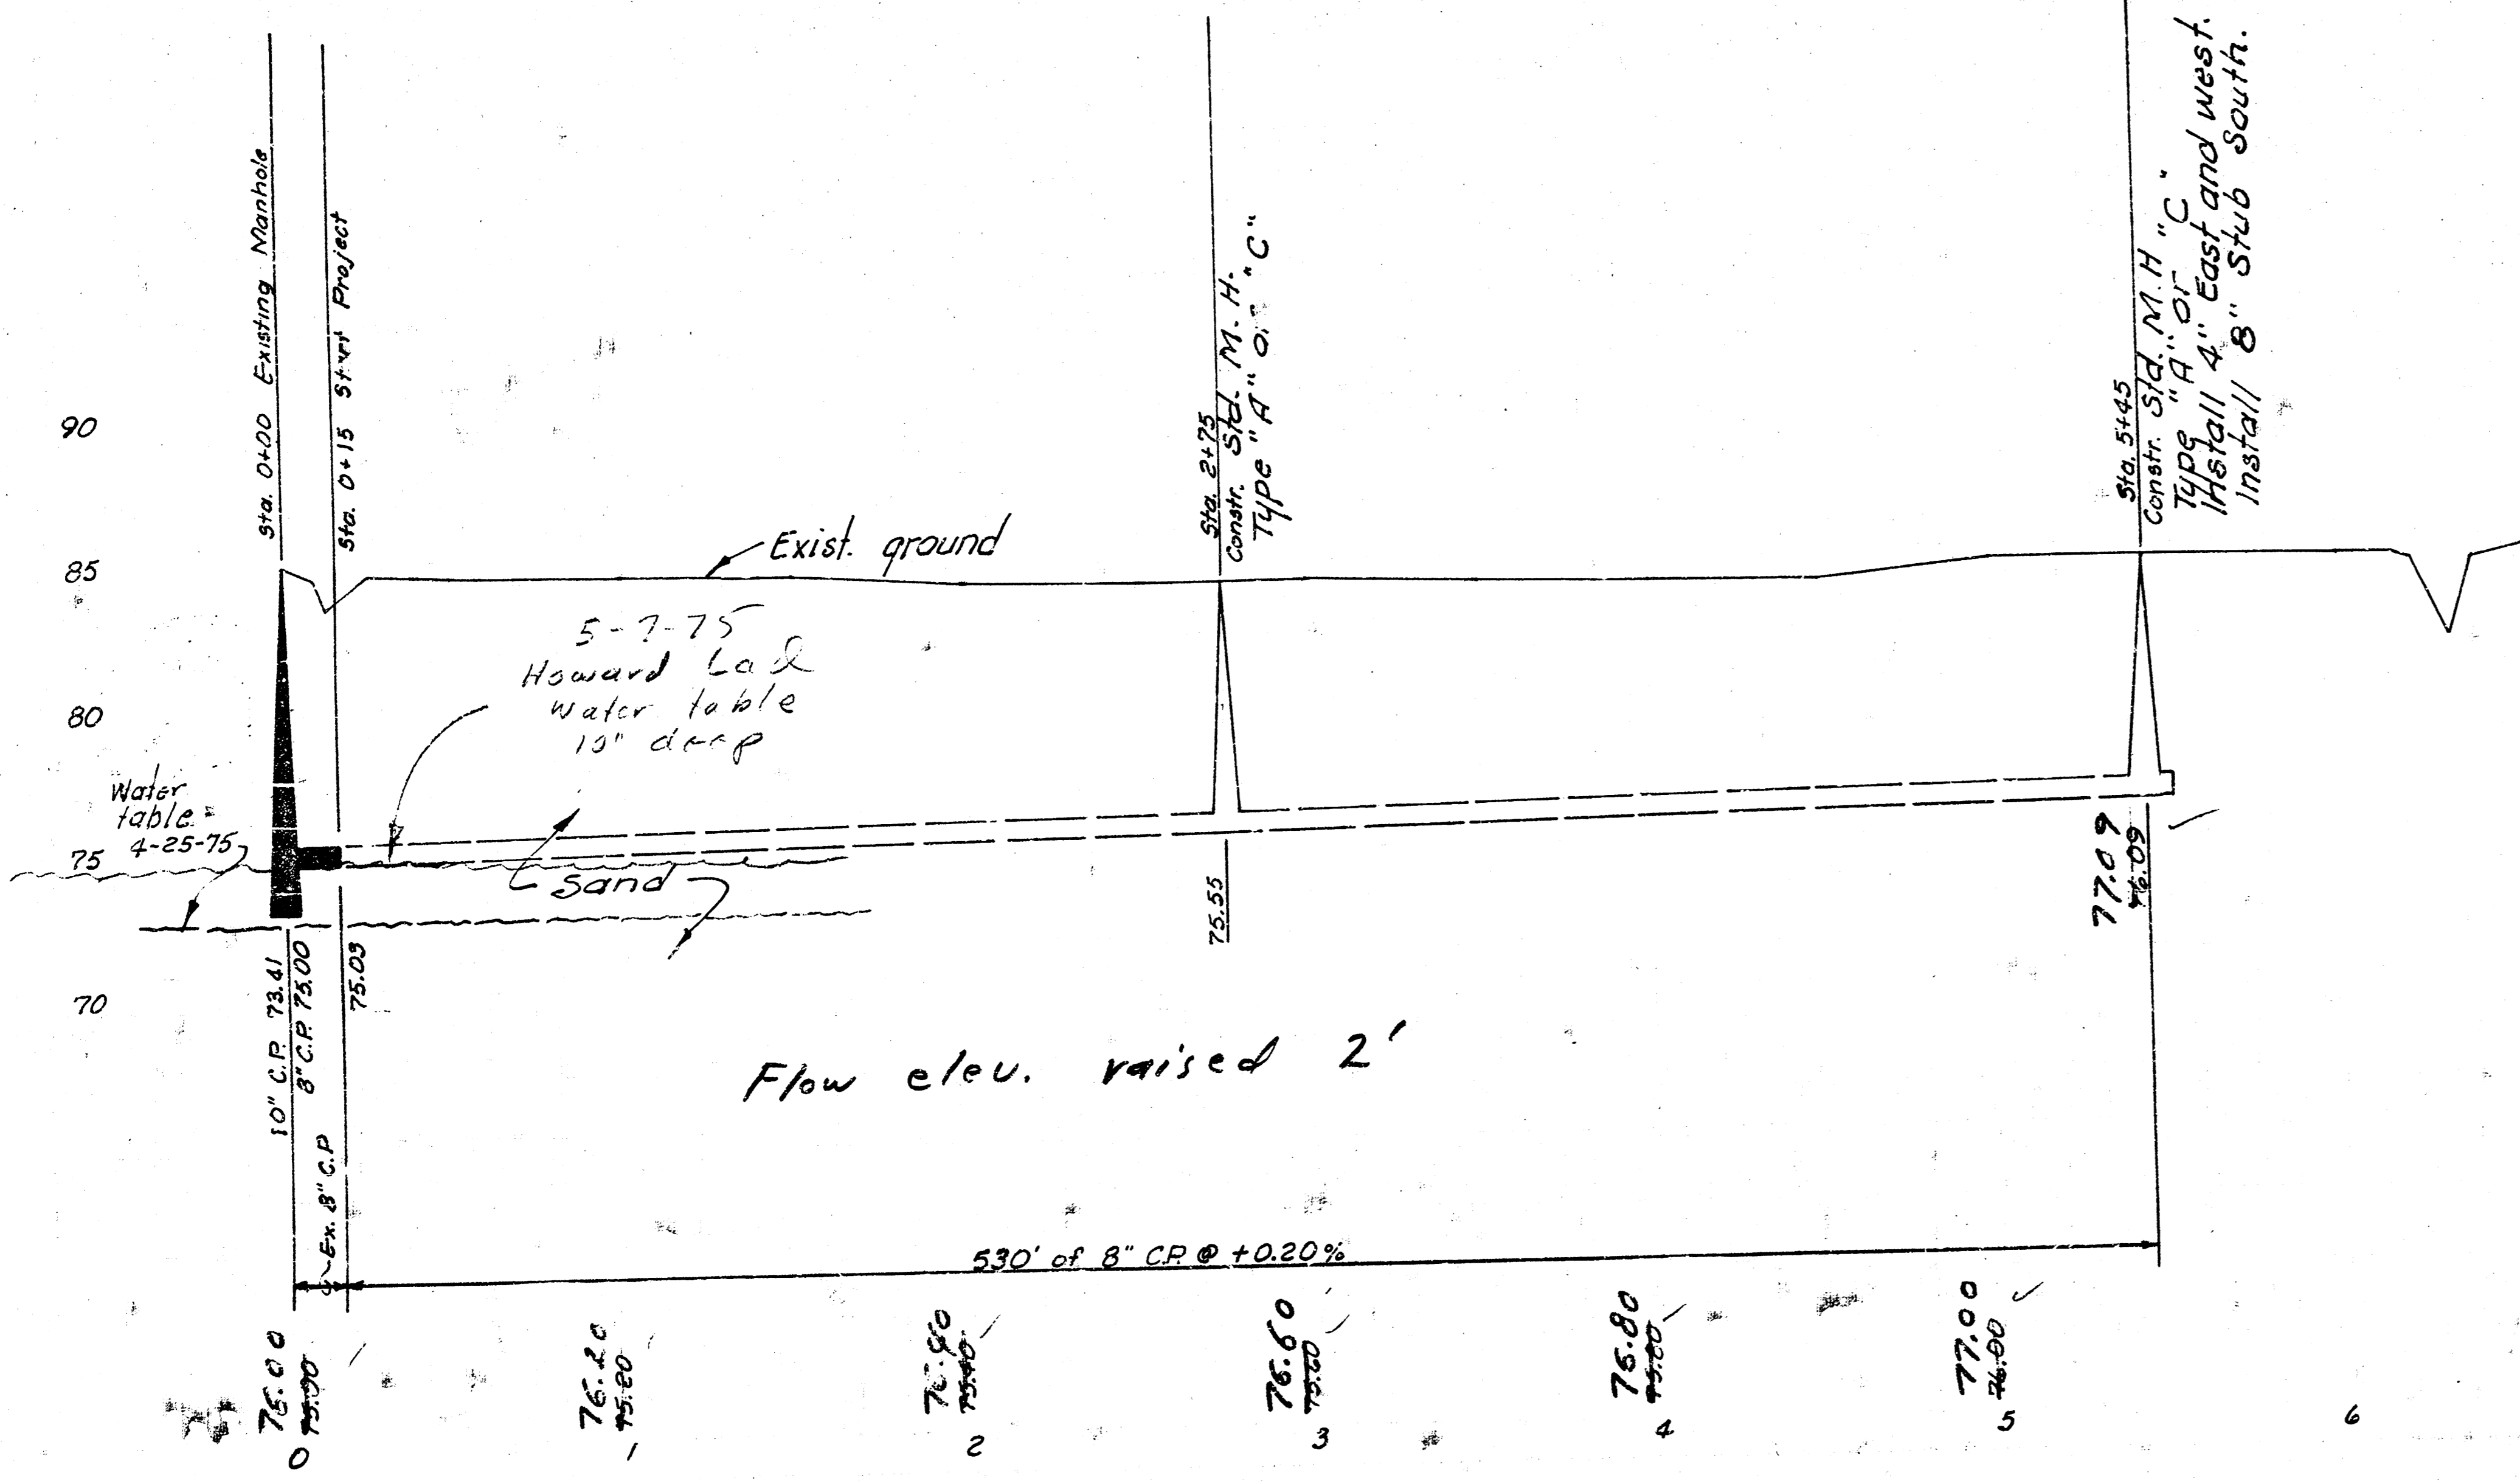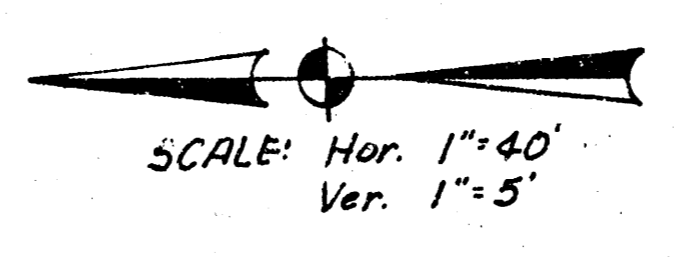

As Built 8-26-75

LAT. 37, SUB. I, S.W. INTERCEPTOR SEWER

CITY OF WICHITA, KANSAS

R.W. LINN, CITY ENGINEER

PROJECT NO. DBKL574020

DATE _____

Sheet 1/1