


B. M. 86.195 60 D Nail N. Face P.P. W.L. of Ellis 180° N. of E. Alta.

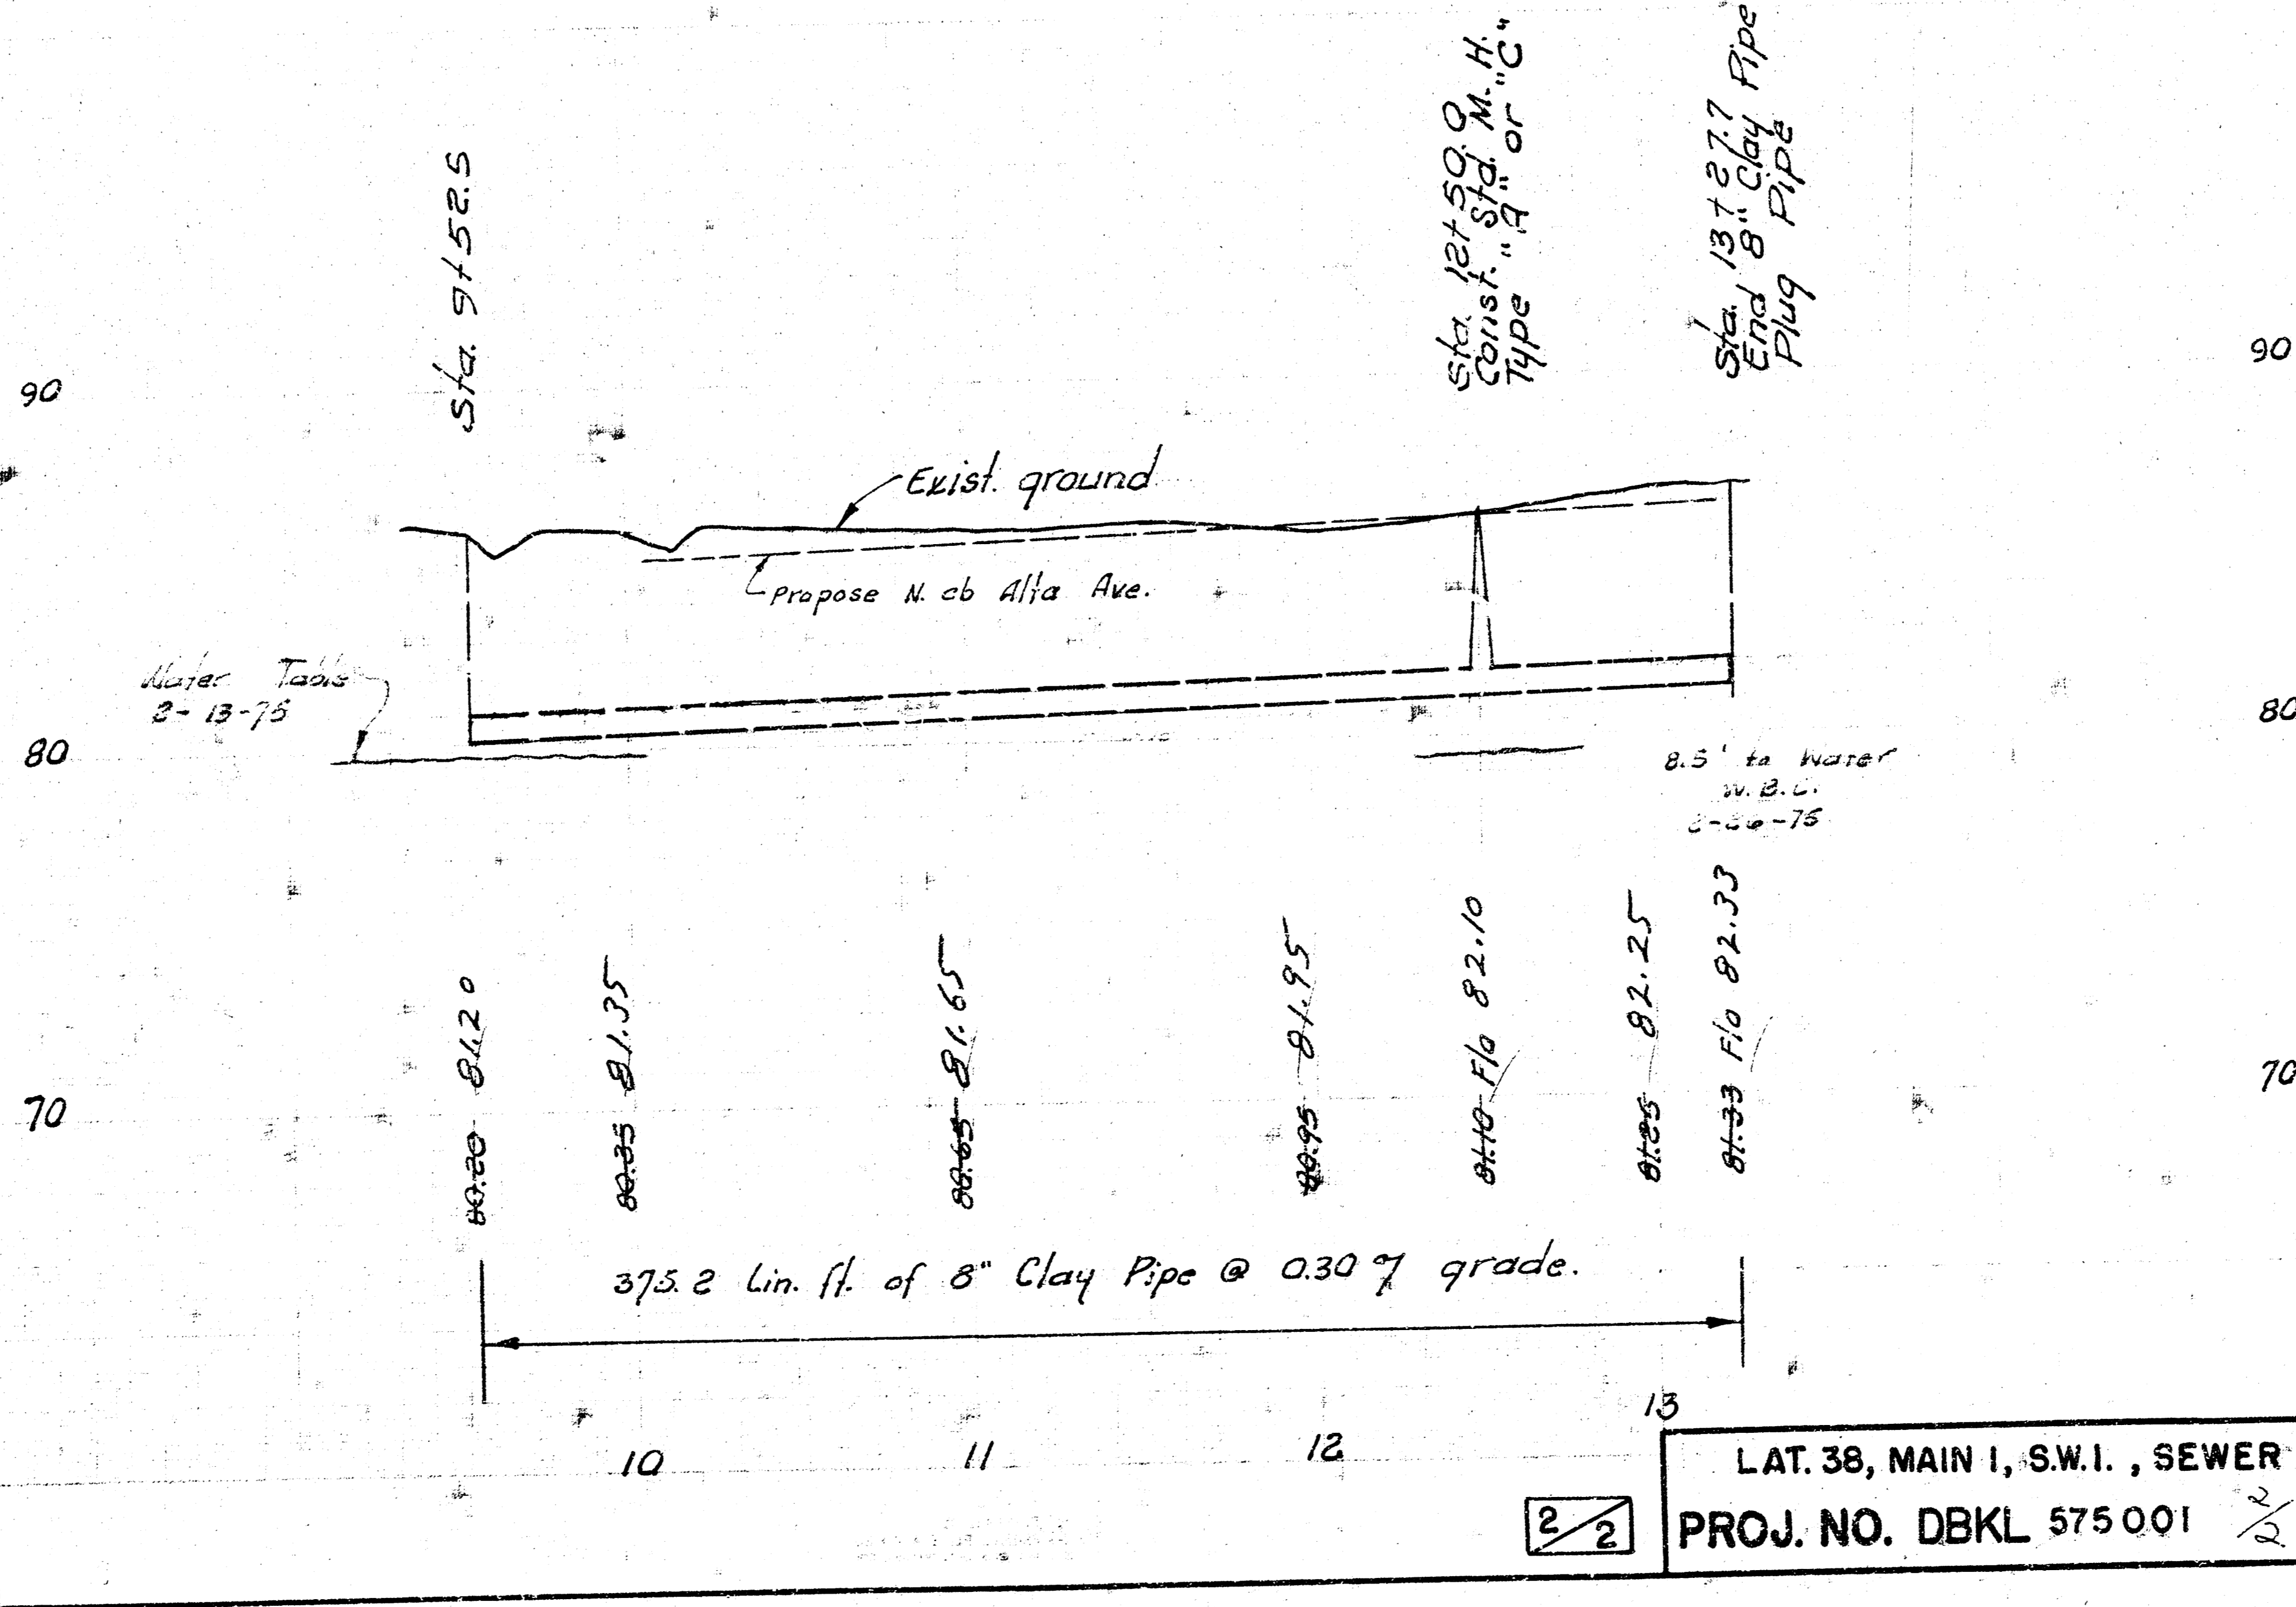

LAT. 38, MAIN I, S.W.I., SEWER  
 PROJ. NO. DBKL 575 001