
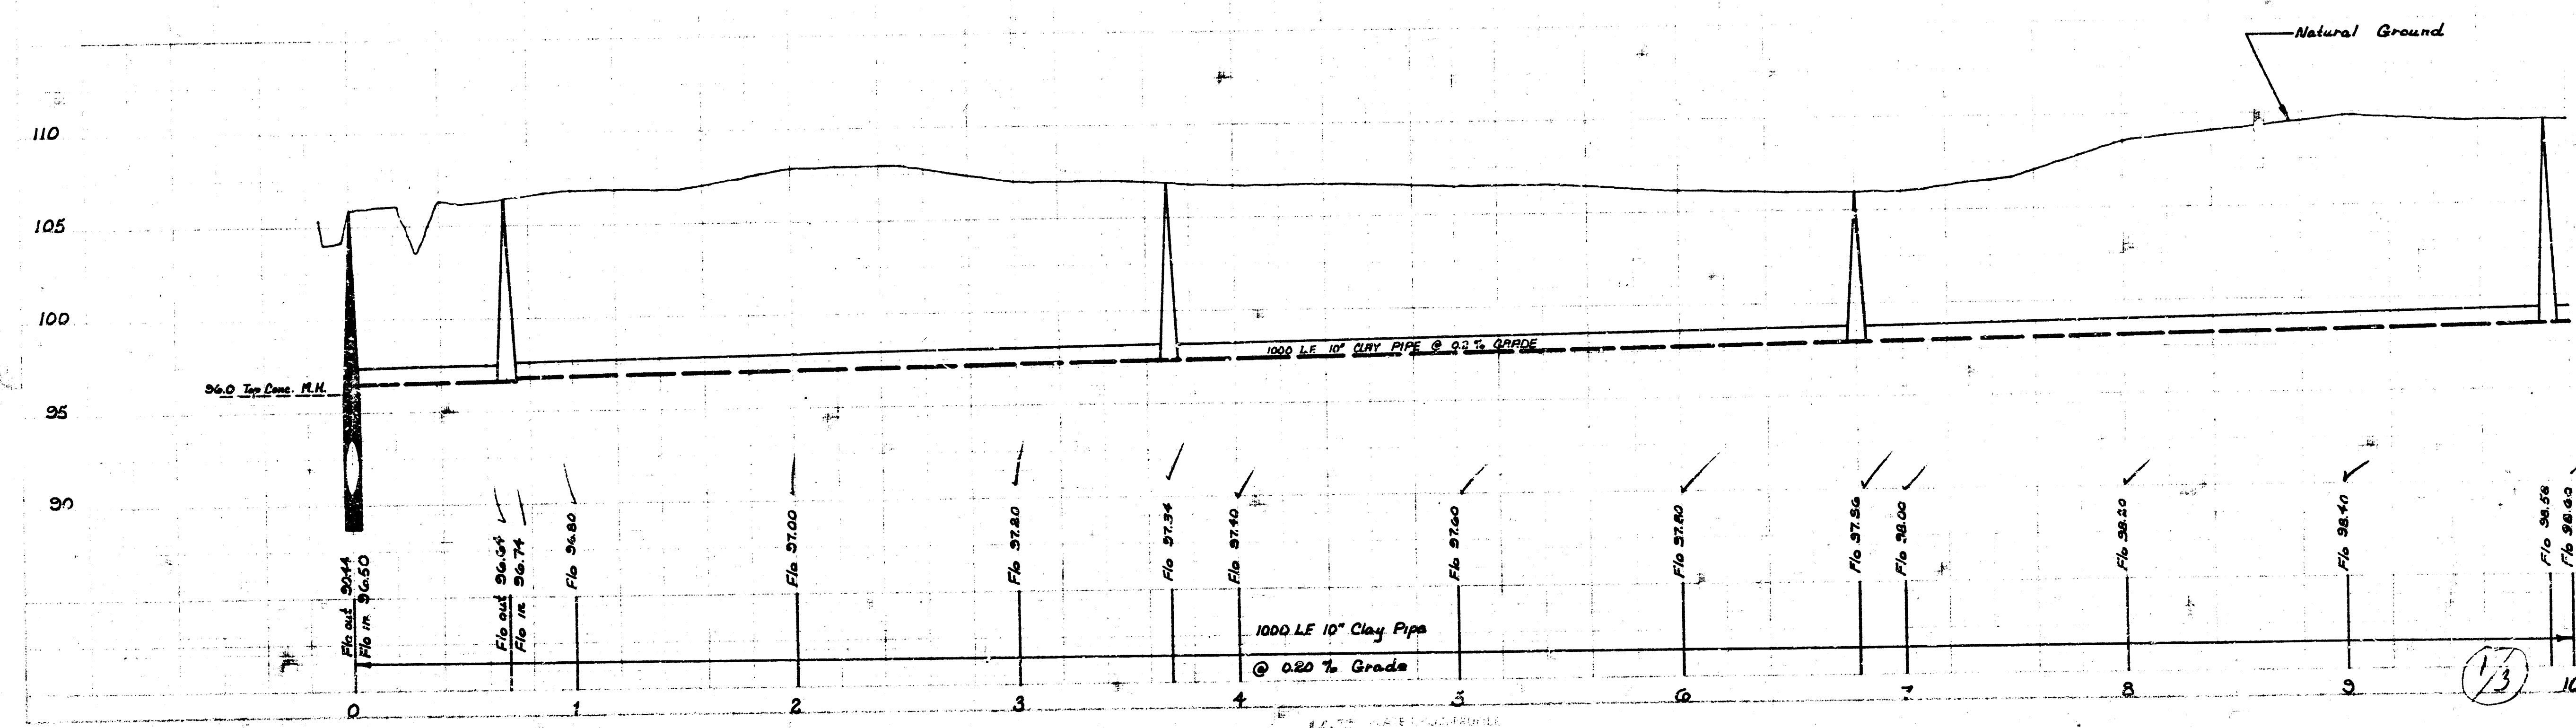



B.M. #1 ~ 108.43 City Std. 31" St. South + Hoover Road 14'E. 432' N. of # both
 B.M. #2 ~ 106.965 RR. Spike E-face PP. W-side Hoover 1/4 mile S. of 31" St. South

Plan Scale ~ 1"=40'
 Profile Scale ~ Horiz. 1"=40'
 ~ Vert. 1"=5'

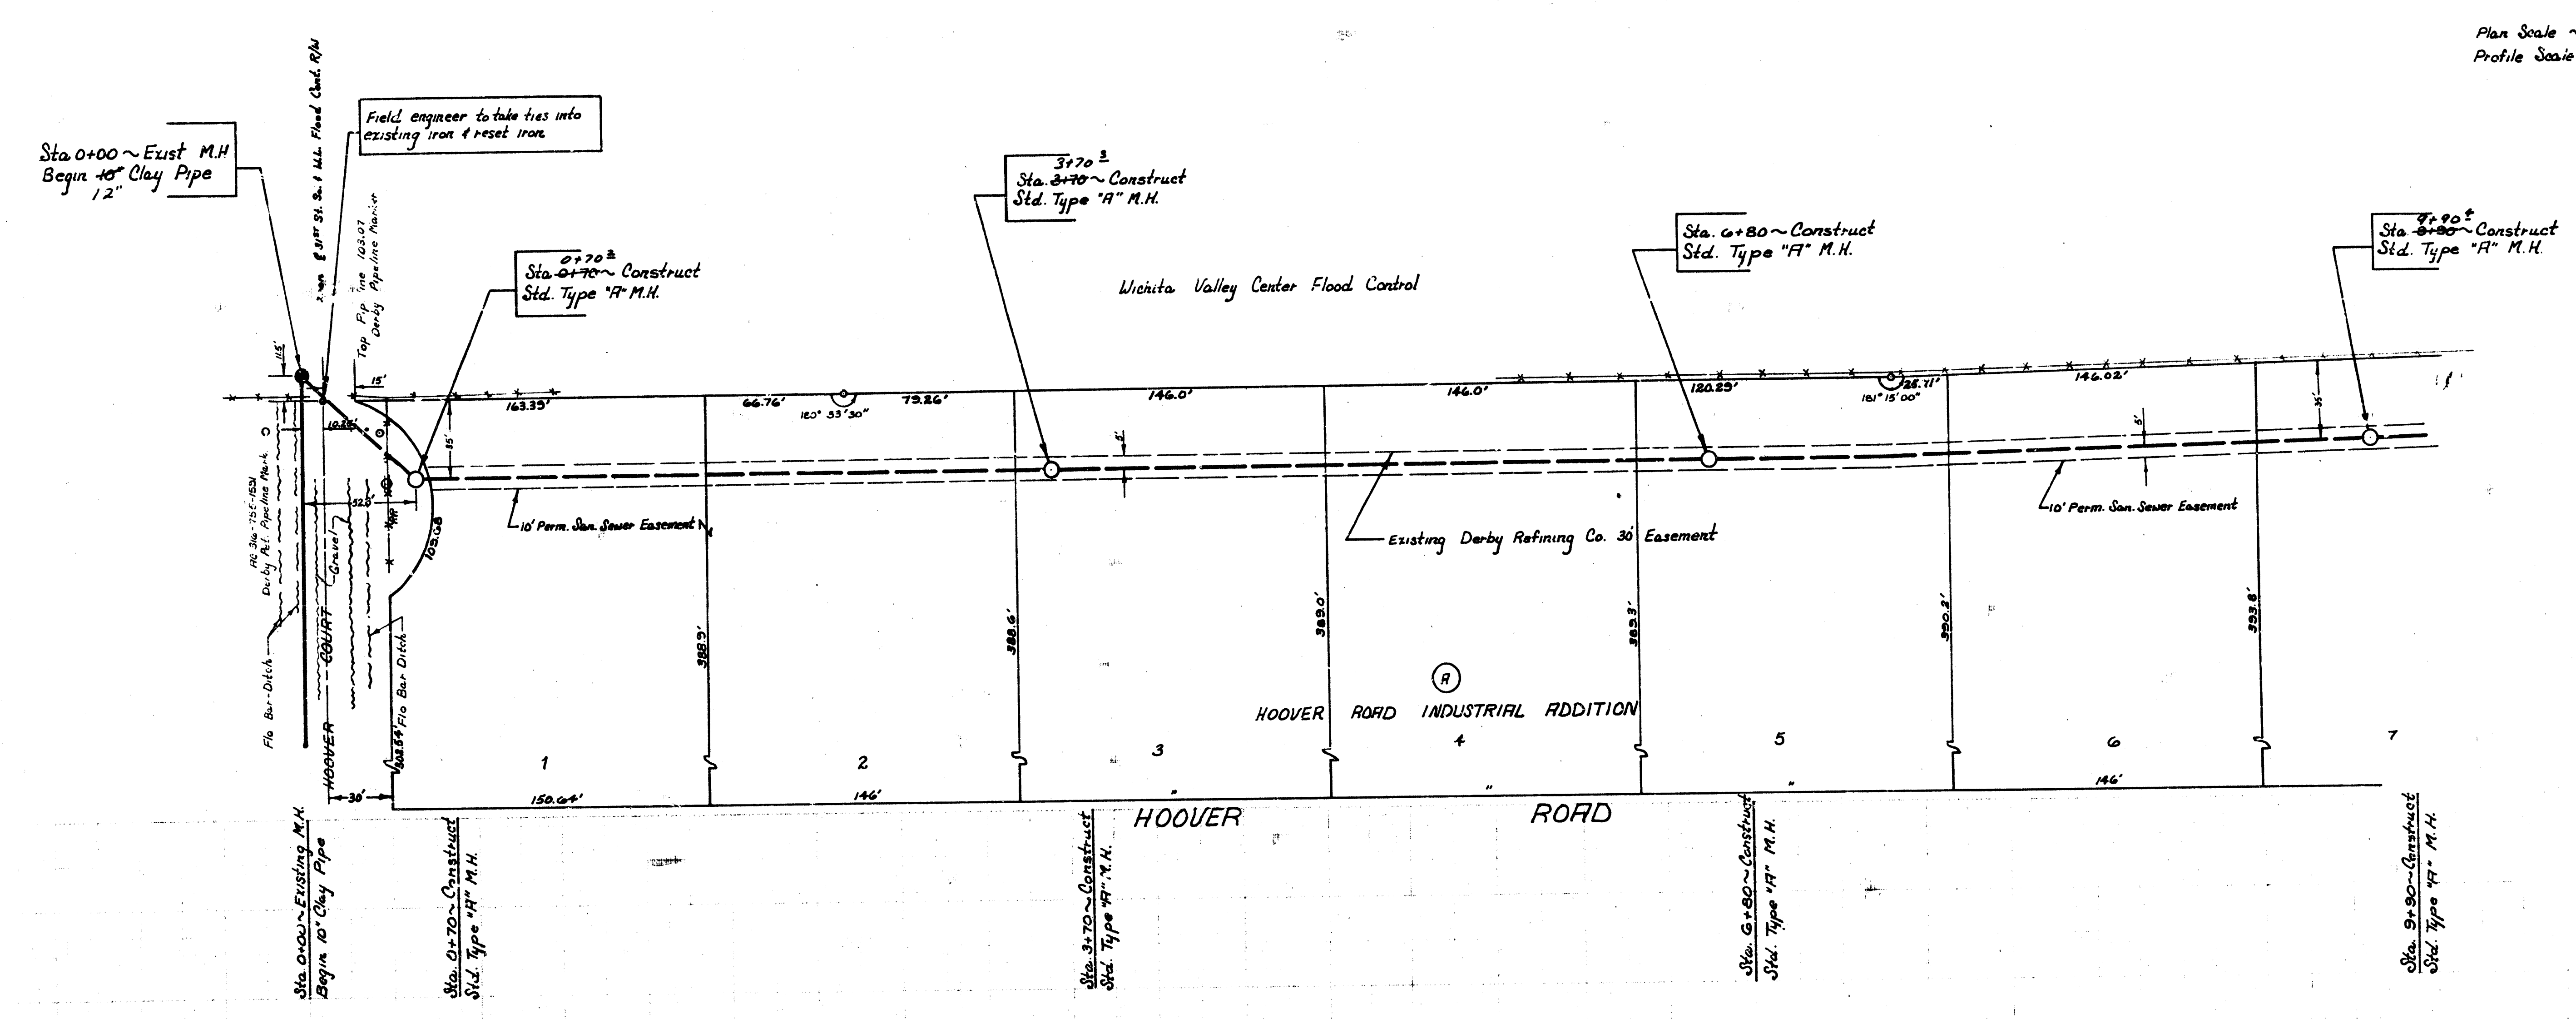

As Built Final Meas. SS Jan. '10
 LPT. 42, S.W.I.
 CITY OF WICHITA
 R.W. LINN-CITY ENGINEER
 DATE NOV. 1973 PROJ. NO. BHKBS02054

FILED FROM THE BEST AVAILABLE COPY....

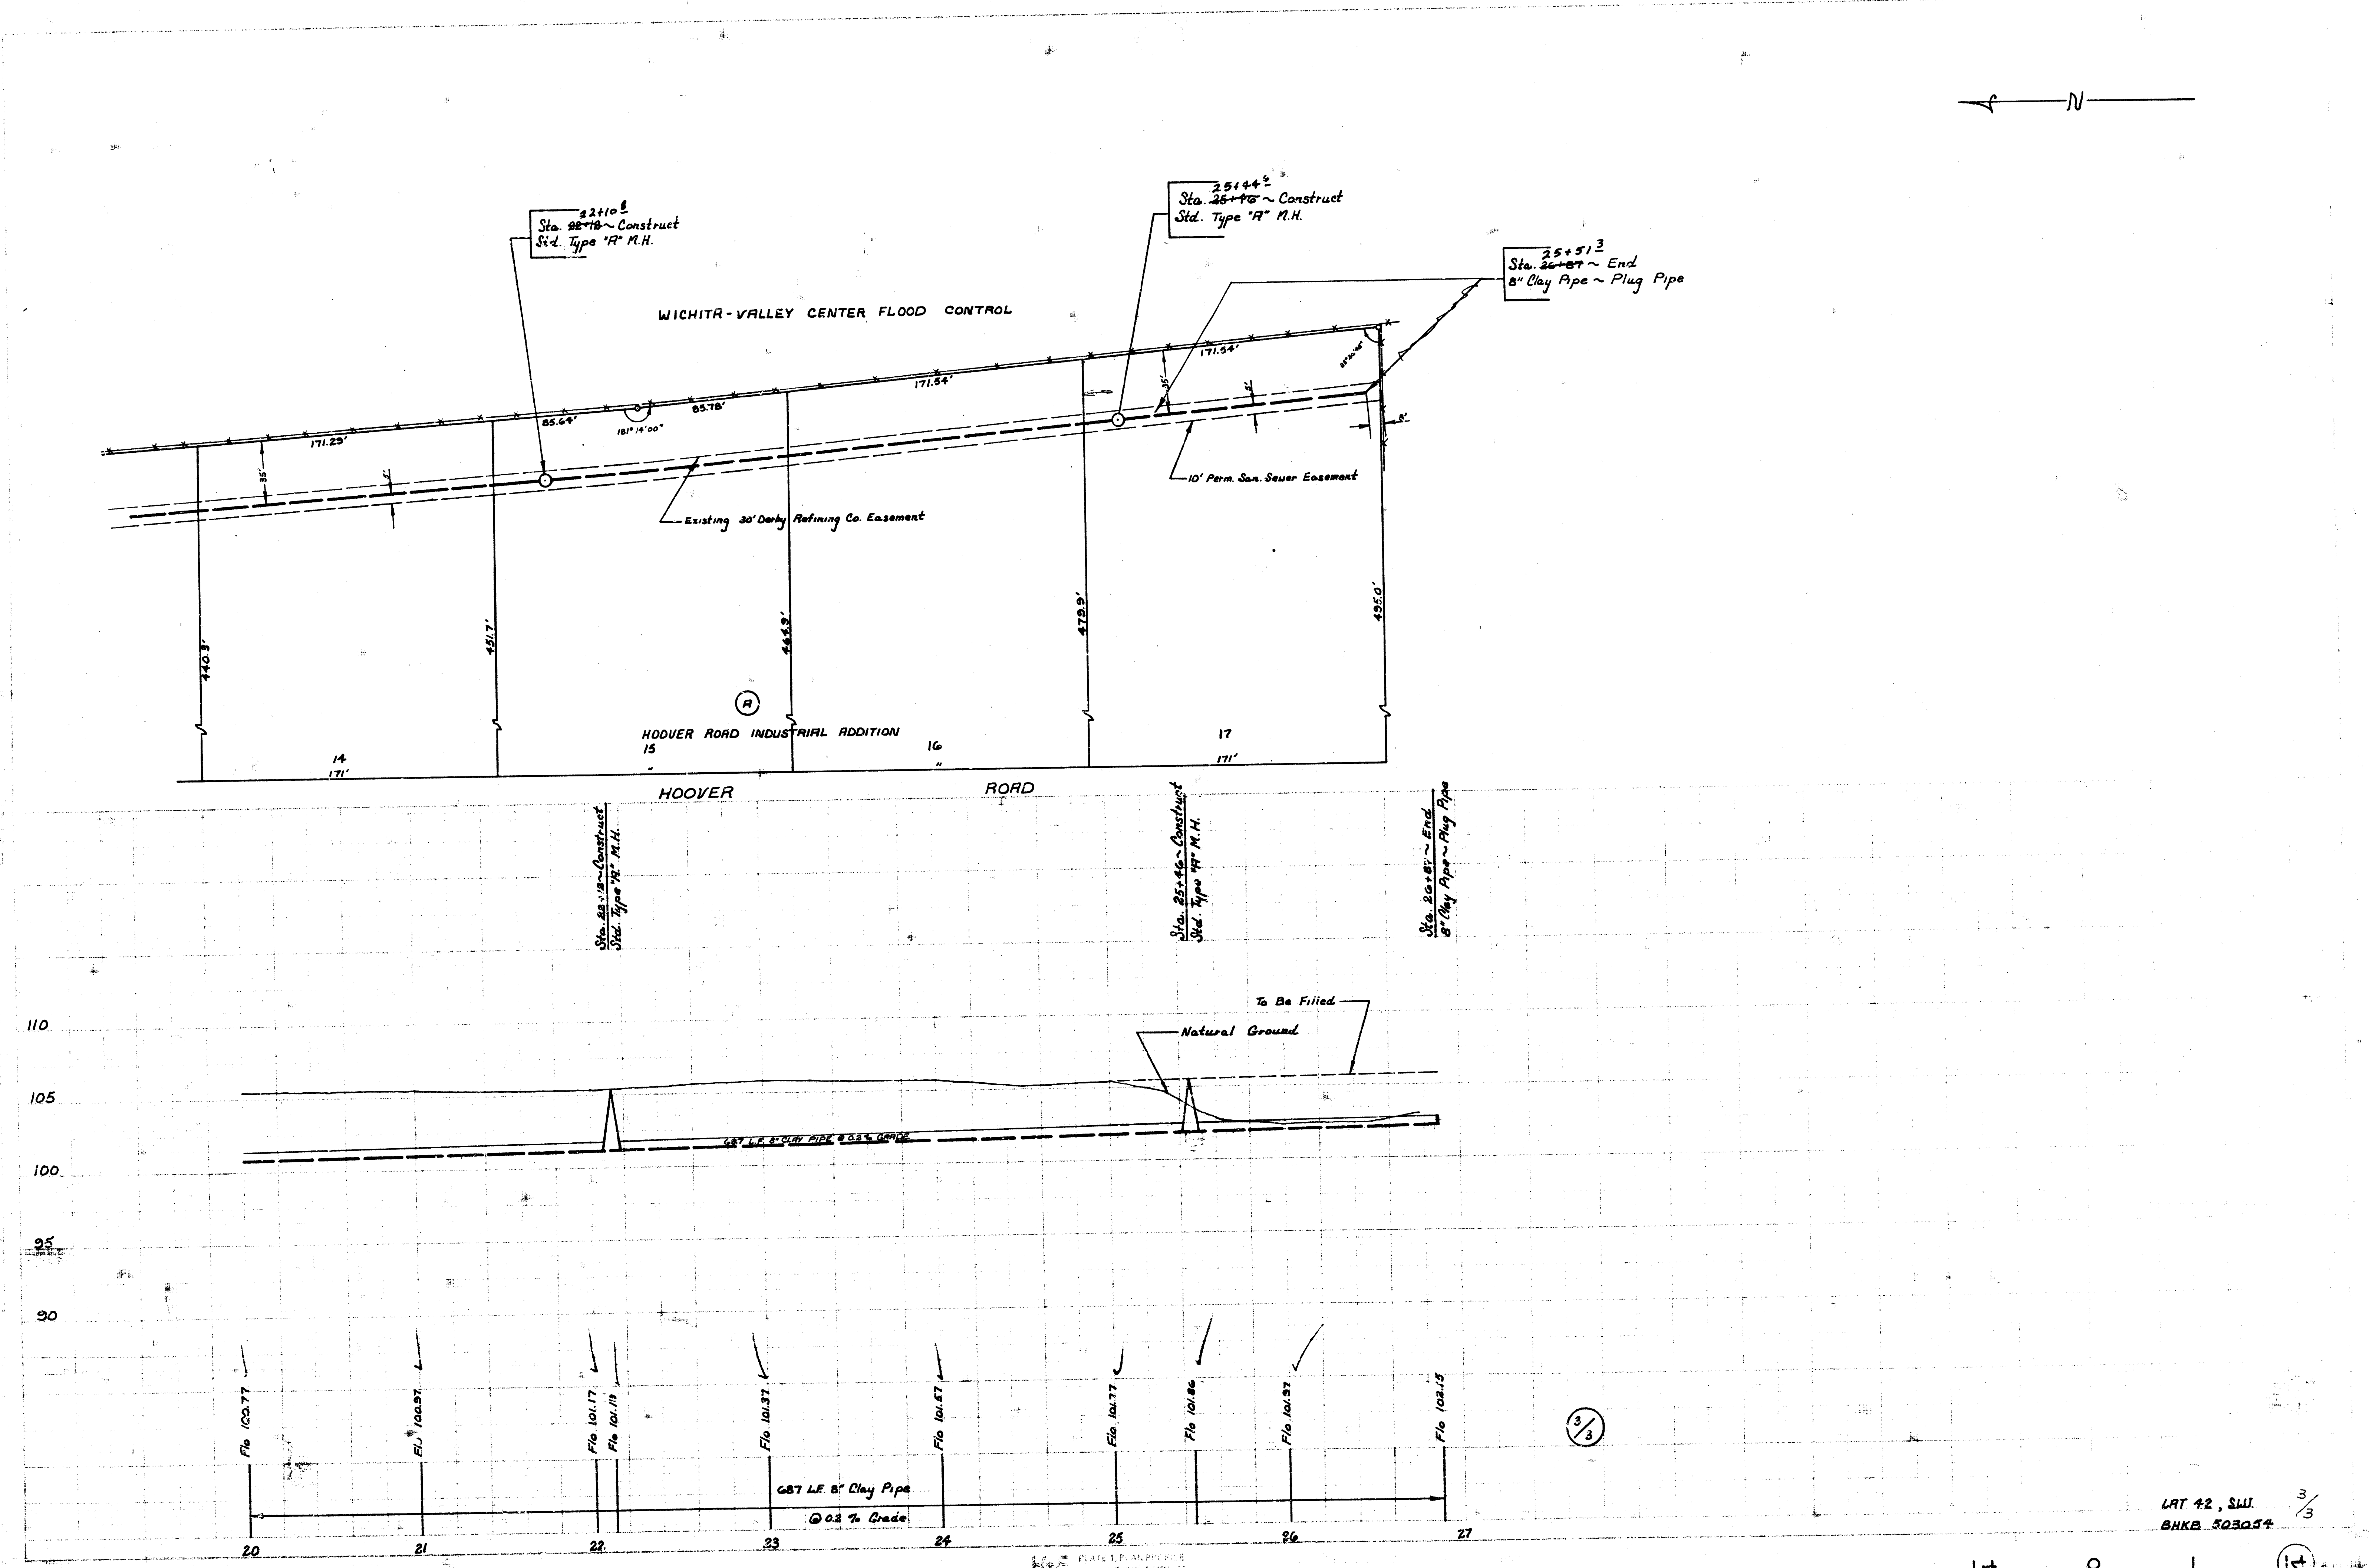

LAT 42, SW 1/4
 SHKB 503054