

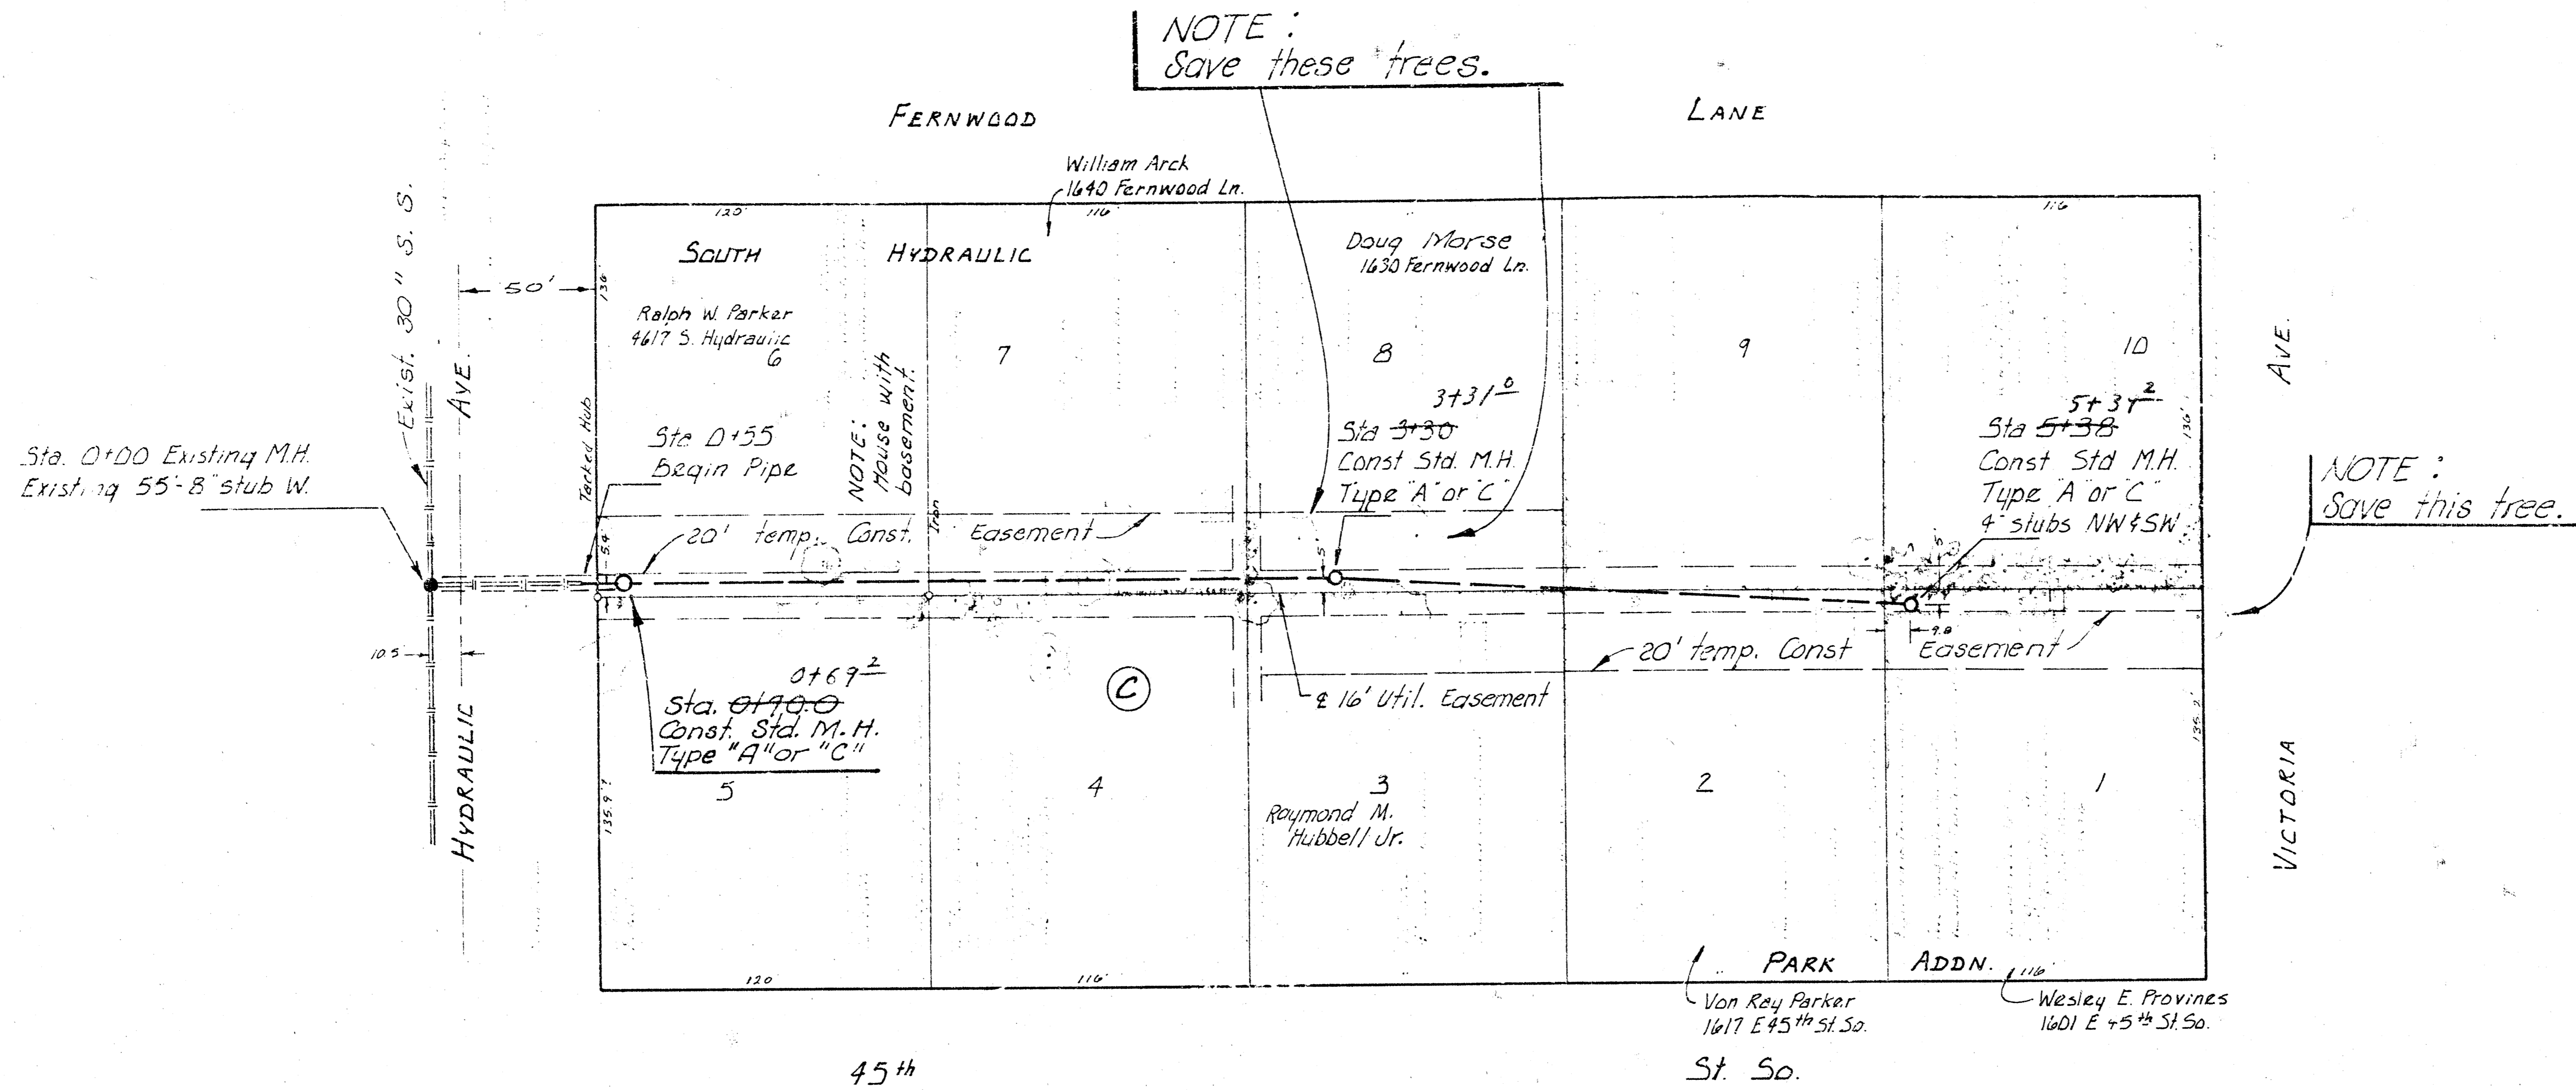


R. W. Linn, Inc.

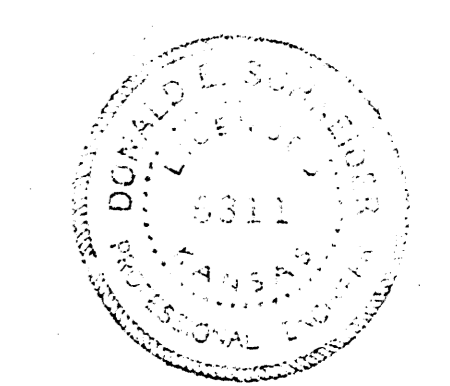

Plan Scale 1"=40'
Profile Scale 1"=40' Horiz.
1"=5' Vert.

B.M. 8211 City St. Disc 44' W 142' N of E
E 43' St So + Hydraulic

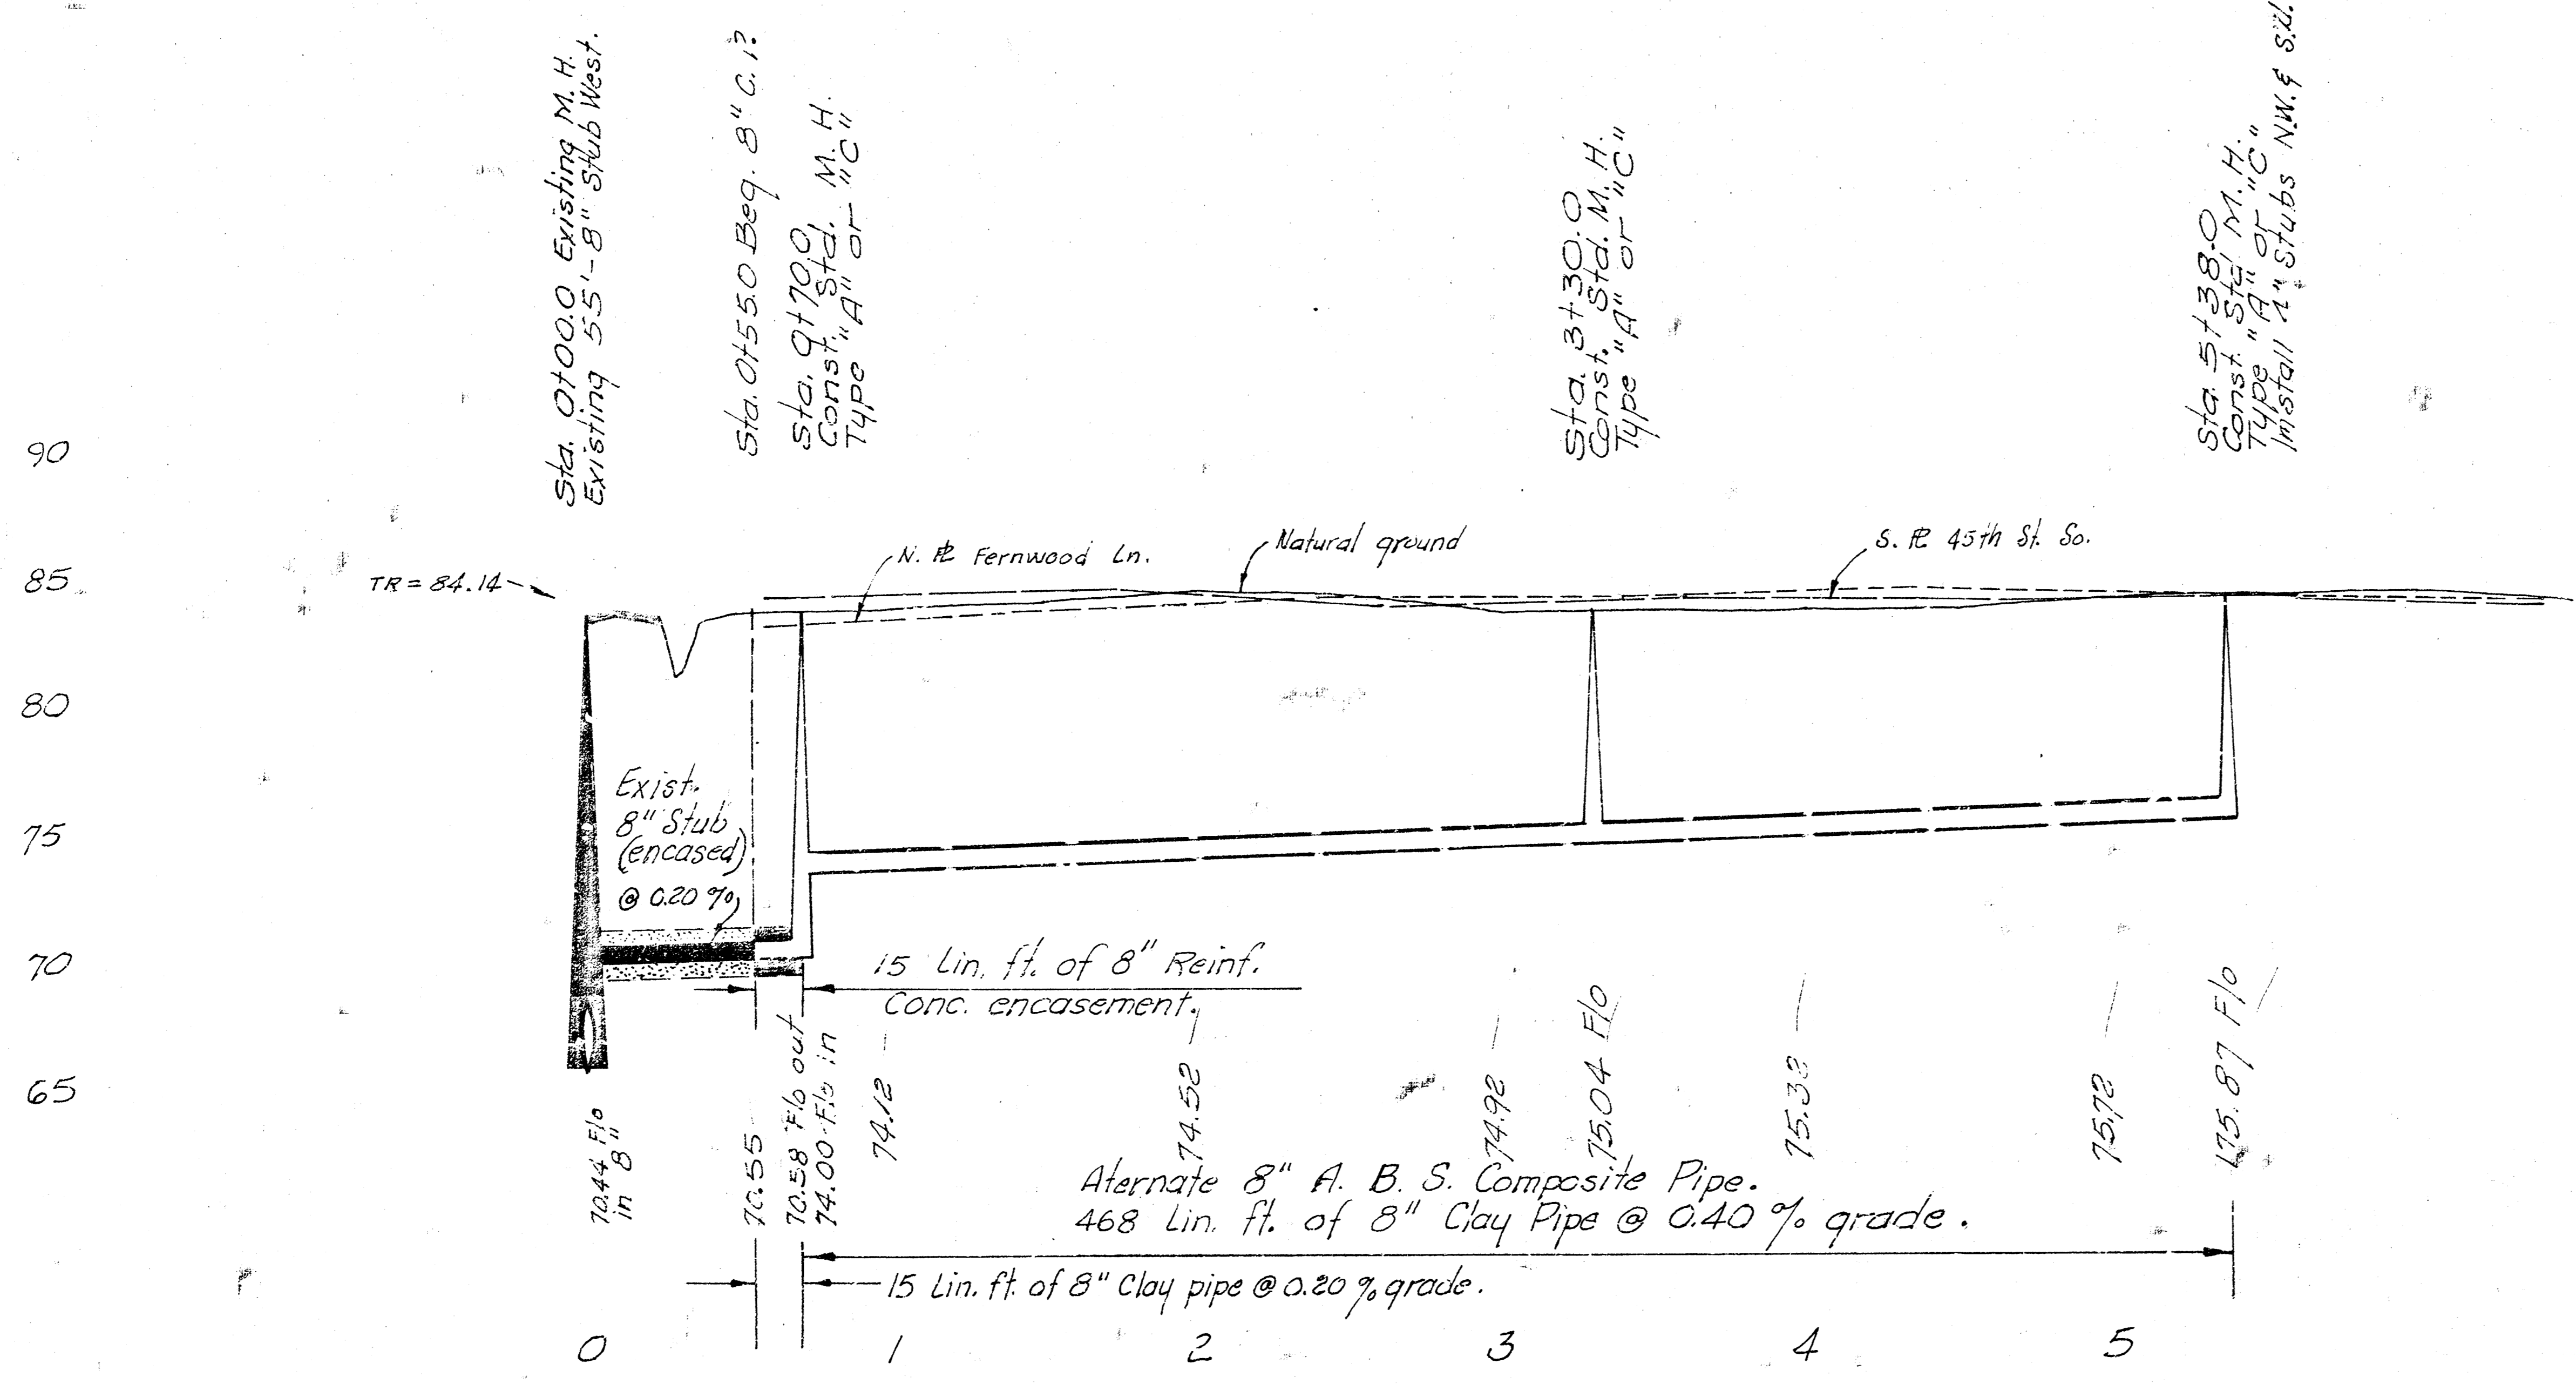

As built 1-11-77

LAT 41, MAIN I, S.W.!
 CITY OF WICHITA, KANSAS
 R. W. LINN — CITY ENGINEER
 PROJECT NO. DBKL575035

SEPT. 1976