


- B. M. 85.78 Top N. bolt Fire Hyd., N.E. cor 46th & Hydraulic.
- B. M. 86.86 S.E. bolt Top Flange, Fire Hyd. N.E. cor Lulu & 46th.
- B. M. 84.51 R. R. Sok, S. Side R.P. betw. Pattie & Lulu N. Side 46th.


Sta. 01000  
Exist. M.H.  
Exist. 8"-25" stub No.  
Stub not encased.

**NOTE:**  
Const. temp. fence along west side of the 20' temp. Const. easement. This will keep the dogs in on lot No. 8.  
This work will not be paid for directly and the cost shall be considered as subsidiary to other items of work.

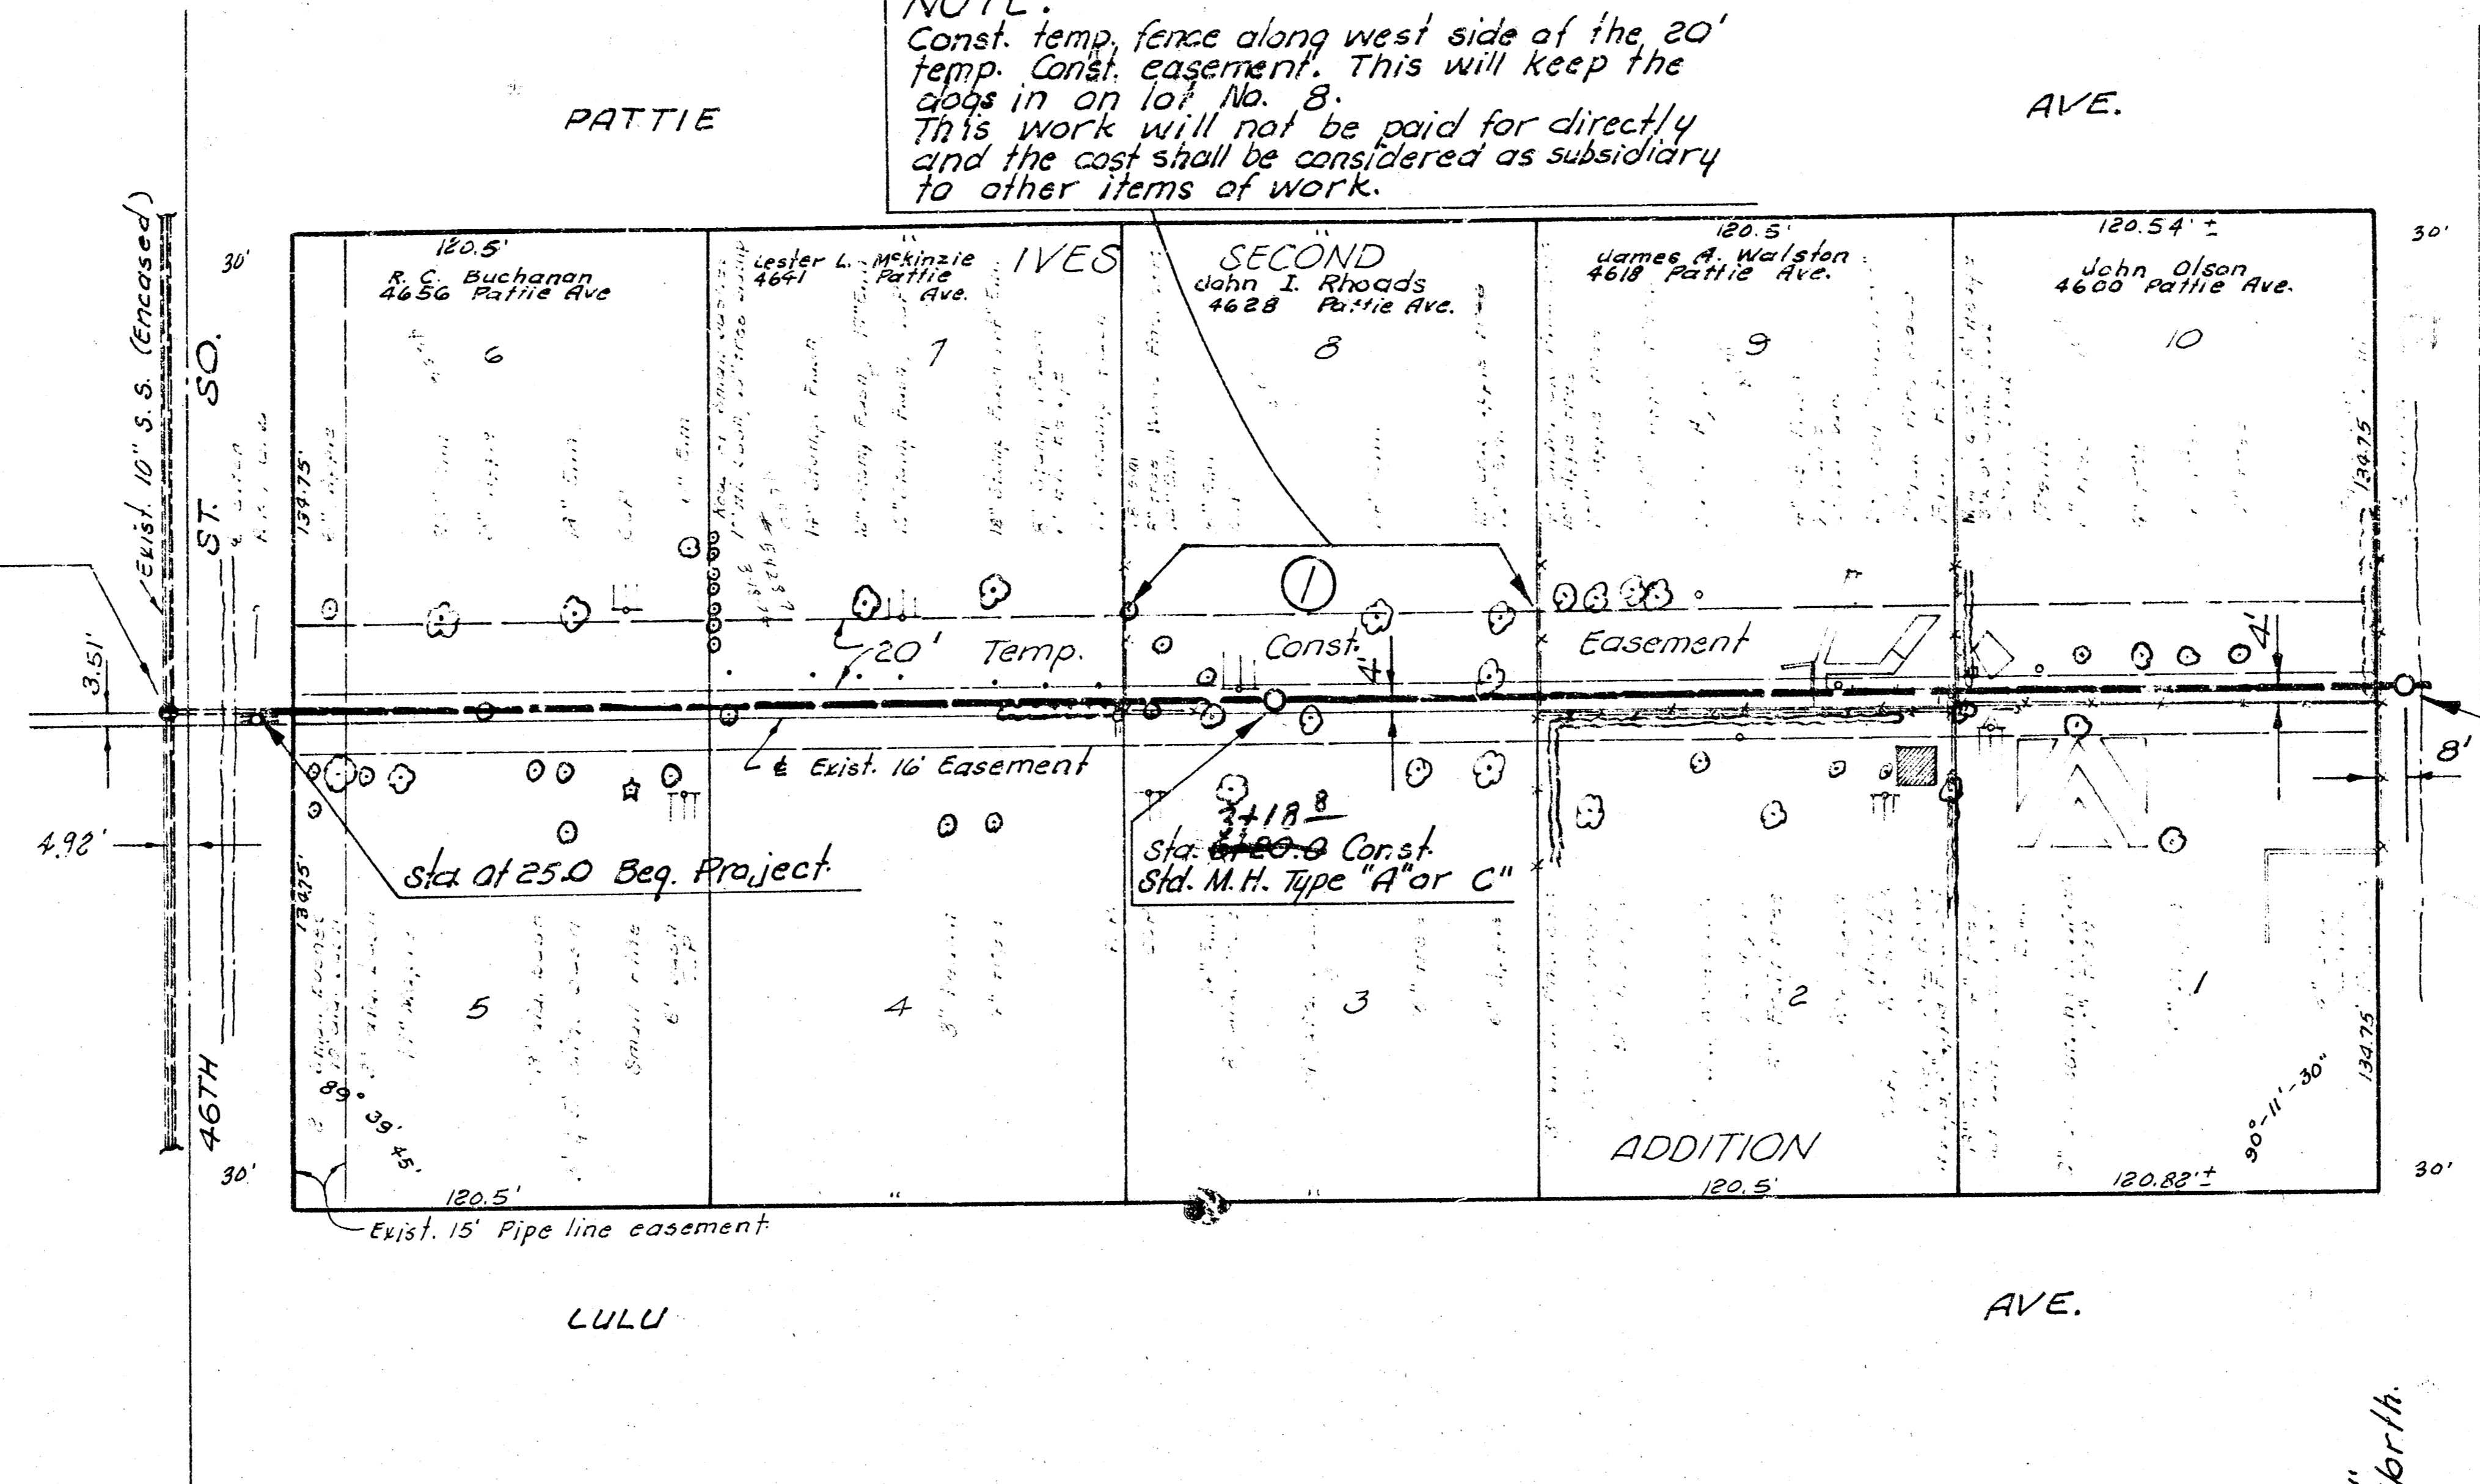

Plan Scale 1" = 40'  
Profile Scale 1" = 40' Vert.

6+47.5  
Sta. 6+67.6 Const.  
Std. M.H. Type "A" or "C"  
Install 8" stub North

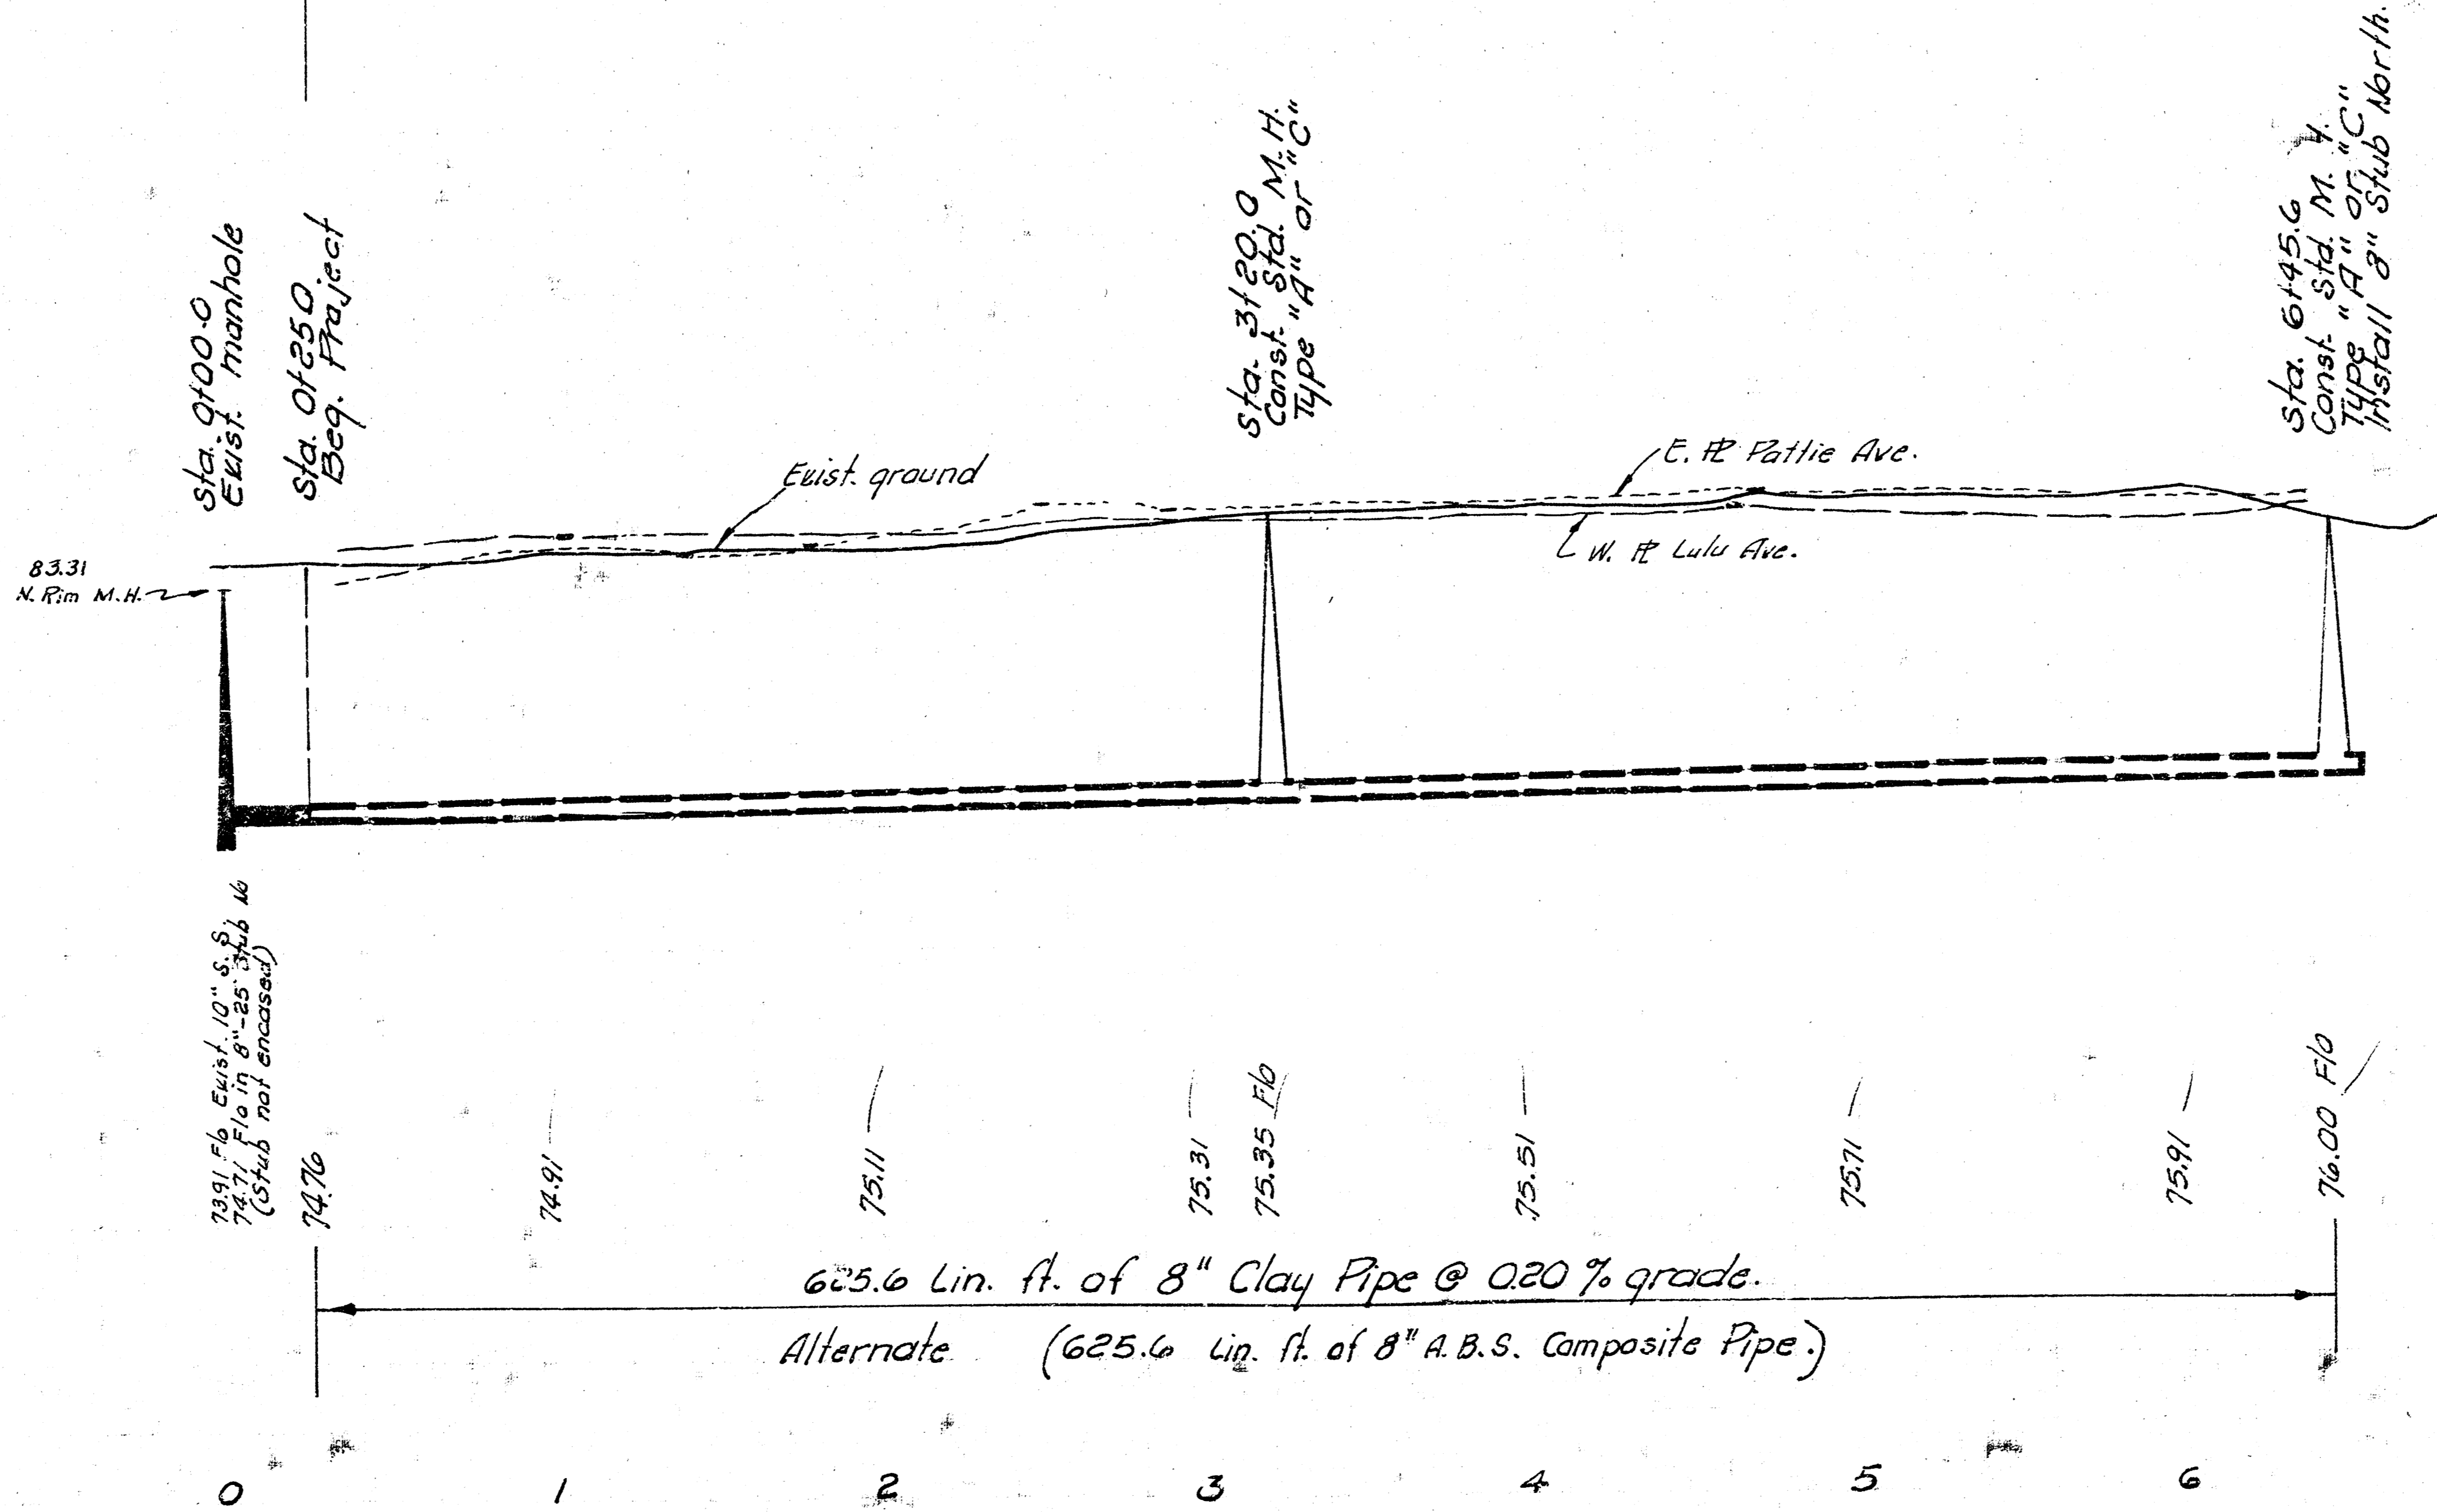

As Built 3-22-76

LAT. 43, MAIN I, S. W. INTERCEPTOR SEWER  
CITY OF WICHITA, KANSAS  
R. W. LINN — CITY ENGINEER  
DATE: 75 PROJECT NO. DBKL 575073

