


LATERAL 55 , MAIN 1 SOUTHWEST INTERCEPTOR SEWER

Project no. 468-76-245-80795-000-000-001

CITY OF WICHITA, KANSAS
MIKE LINDEBAK CITY ENGINEER

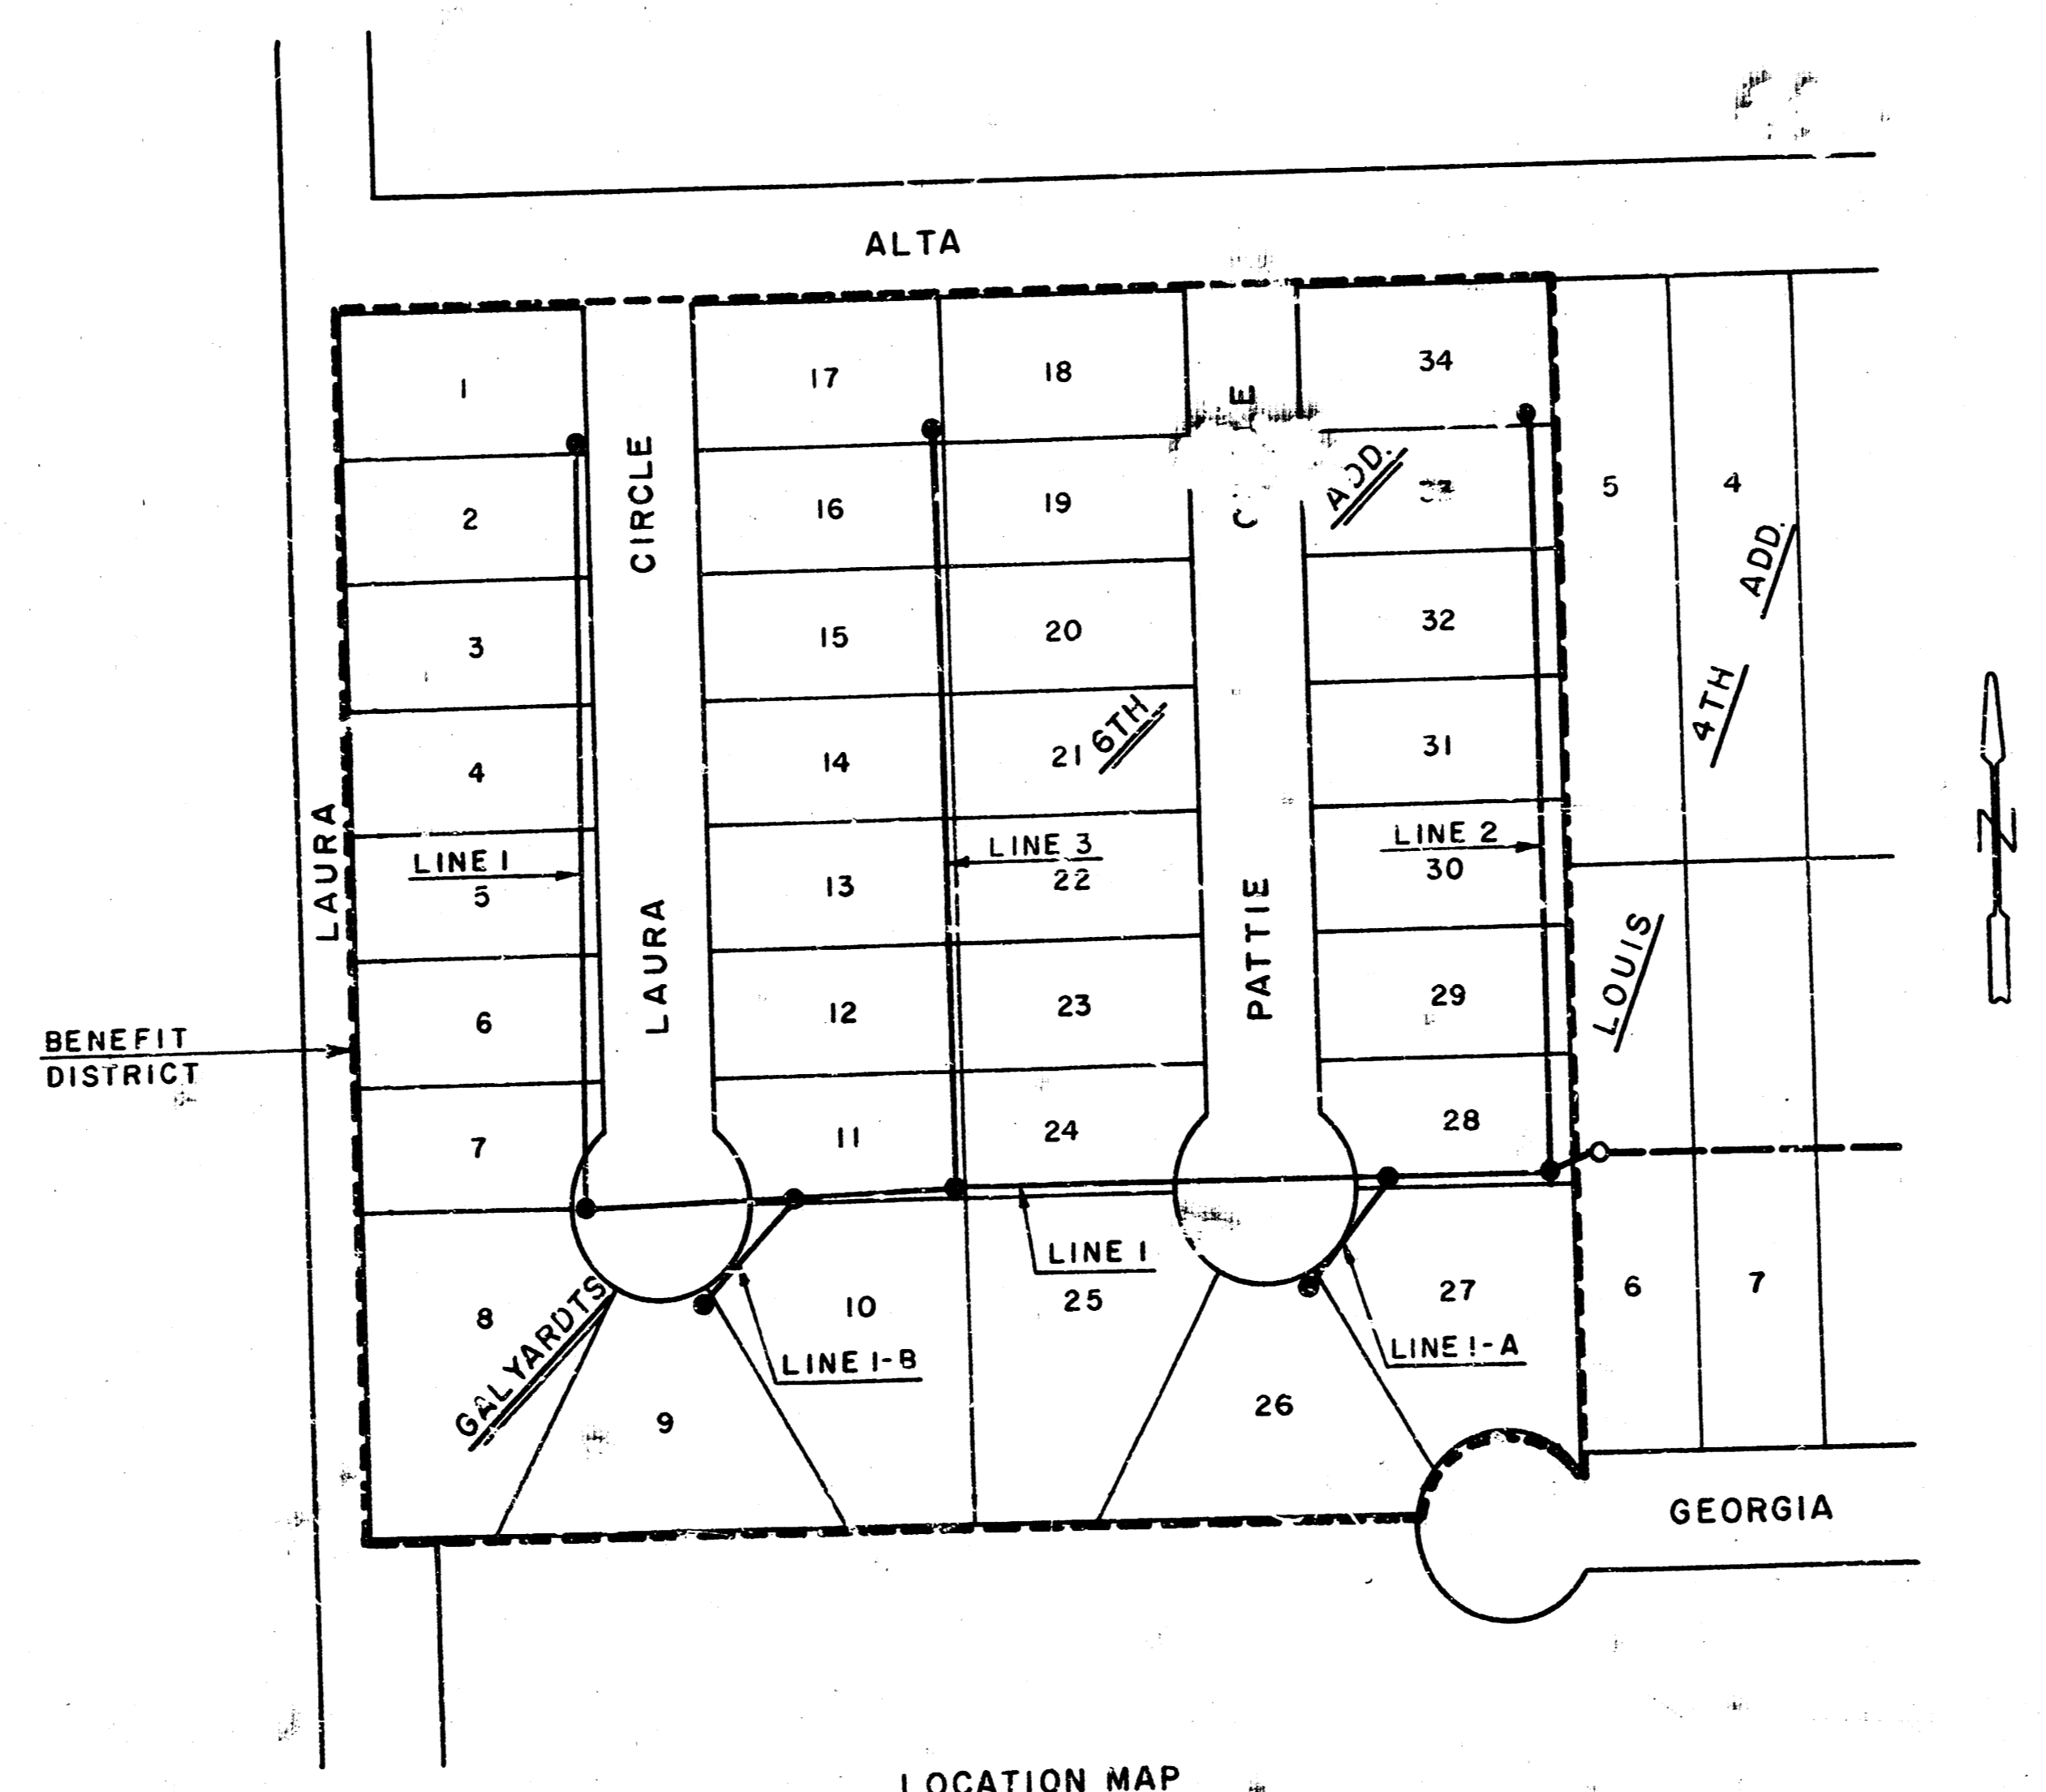


LOCATION MAP






APR 12, 2011

BAUGHMAN COMPANY, P.A.
SURVEYING & ENGINEERING
316/262-7271 • 200 LAURA • WICHITA, KANSAS 67211

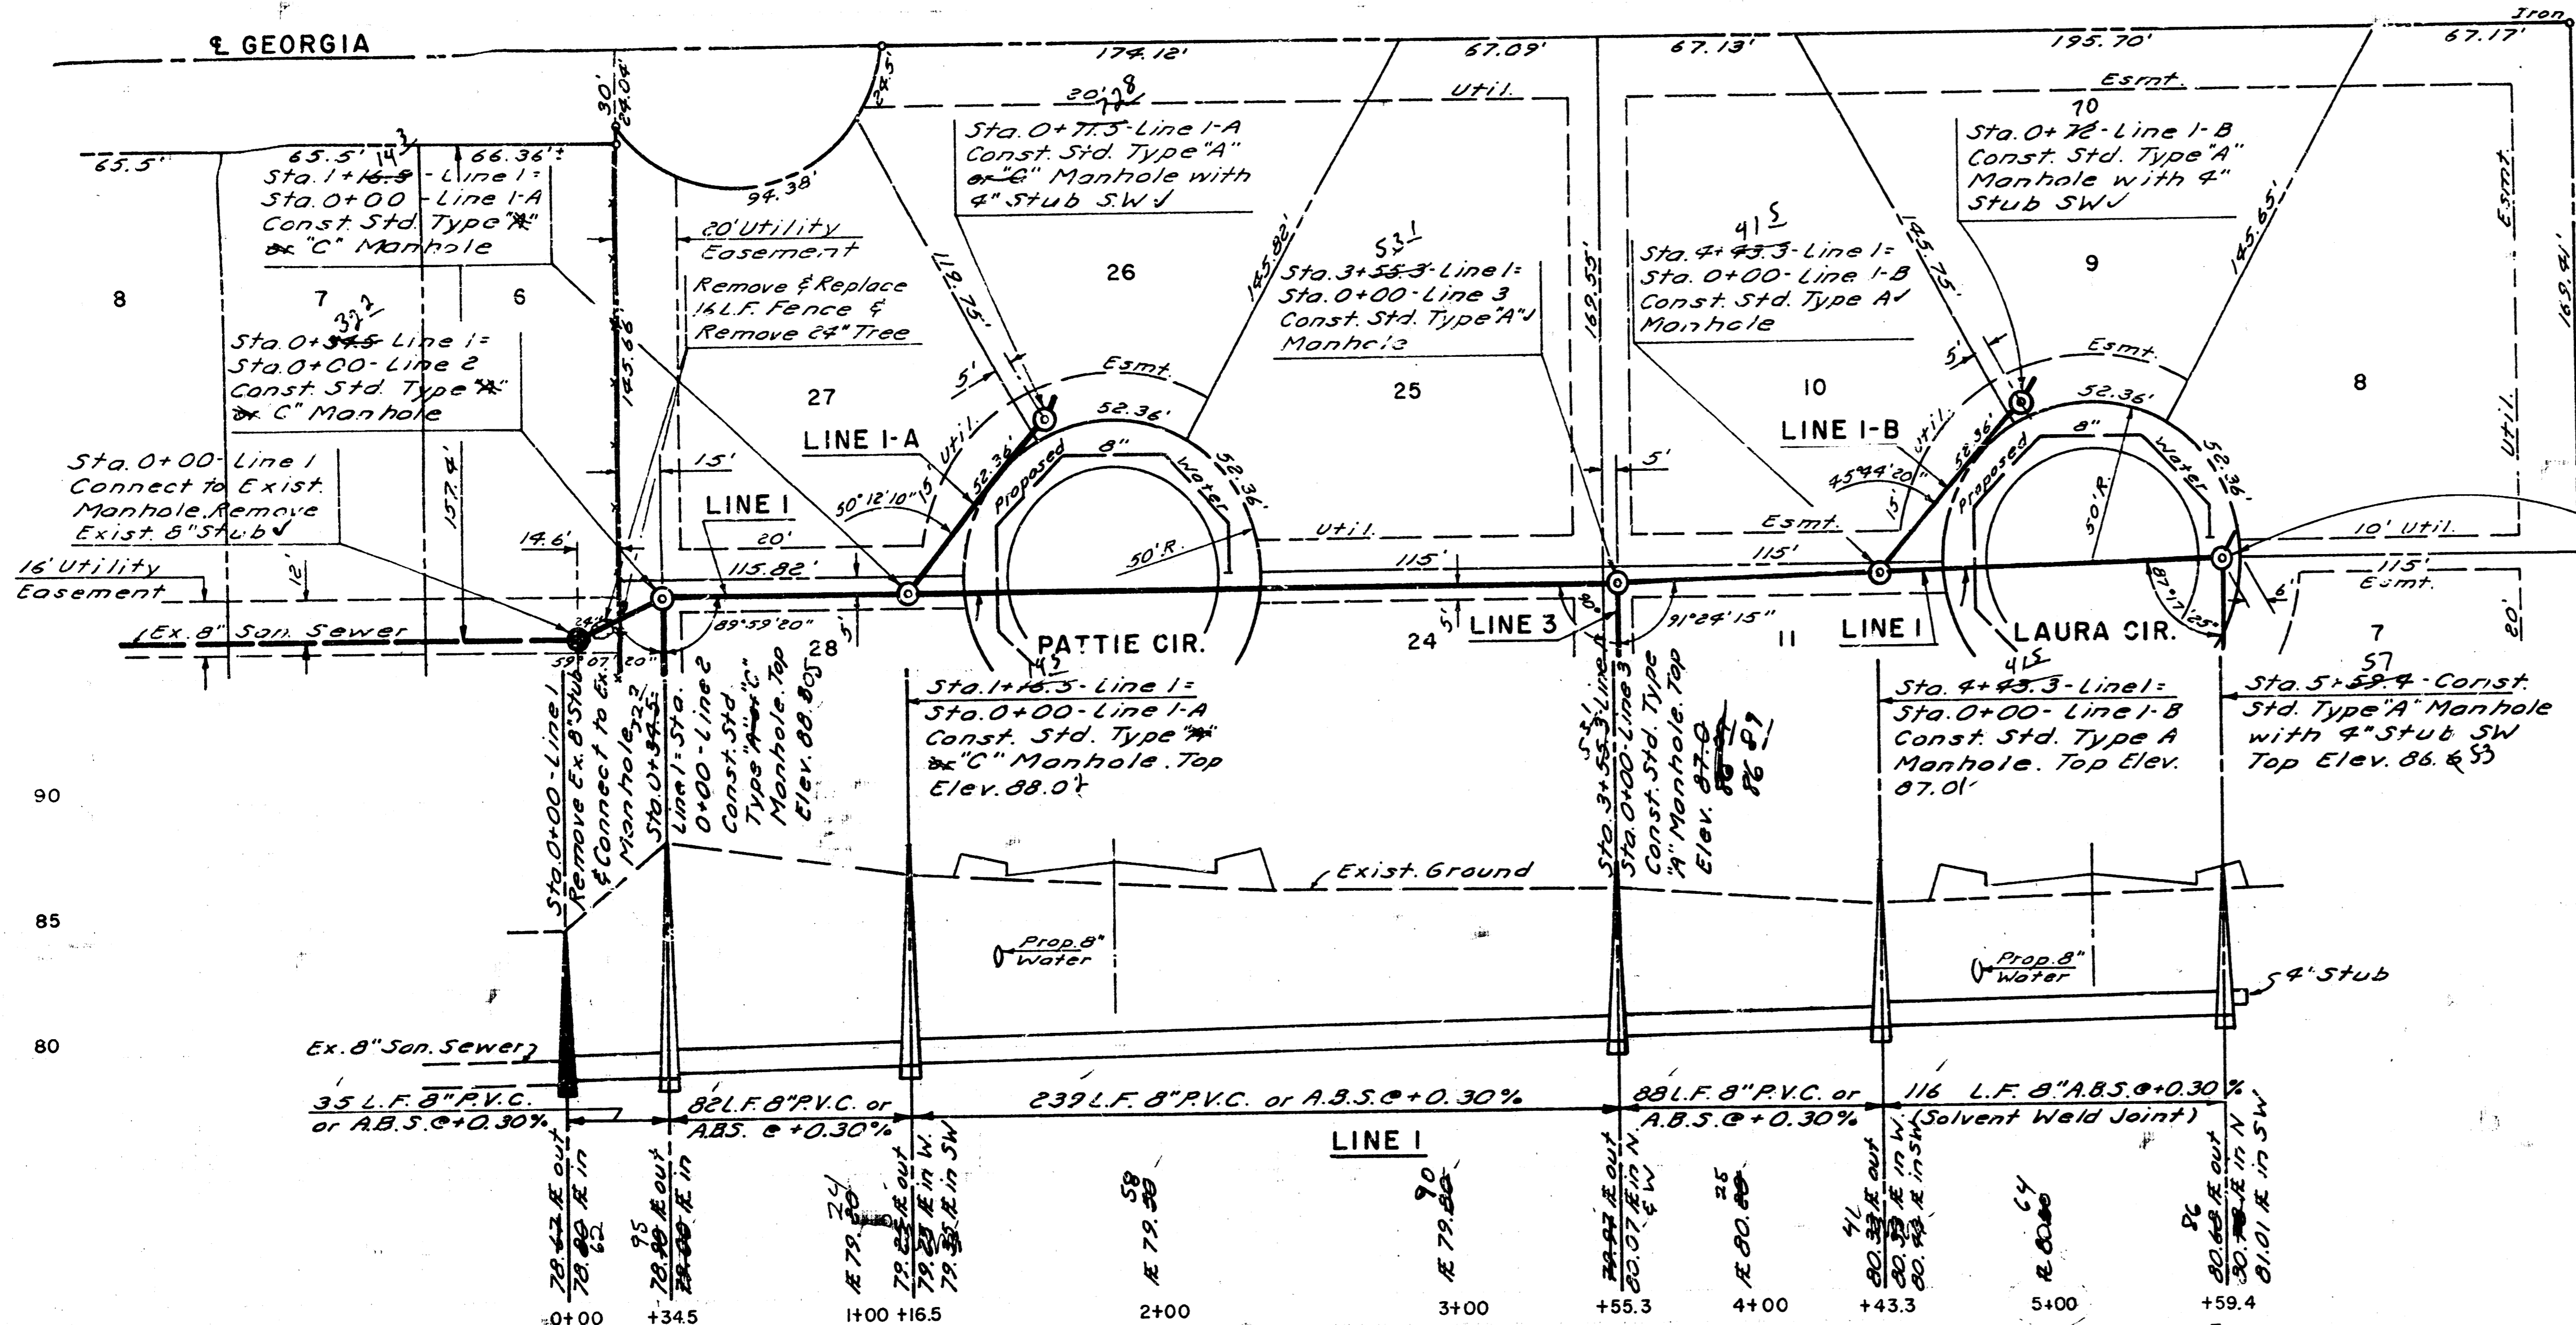

Scale: Hor. 1"=40'
Ver. 1"=5'


As Built
S L L
6-84

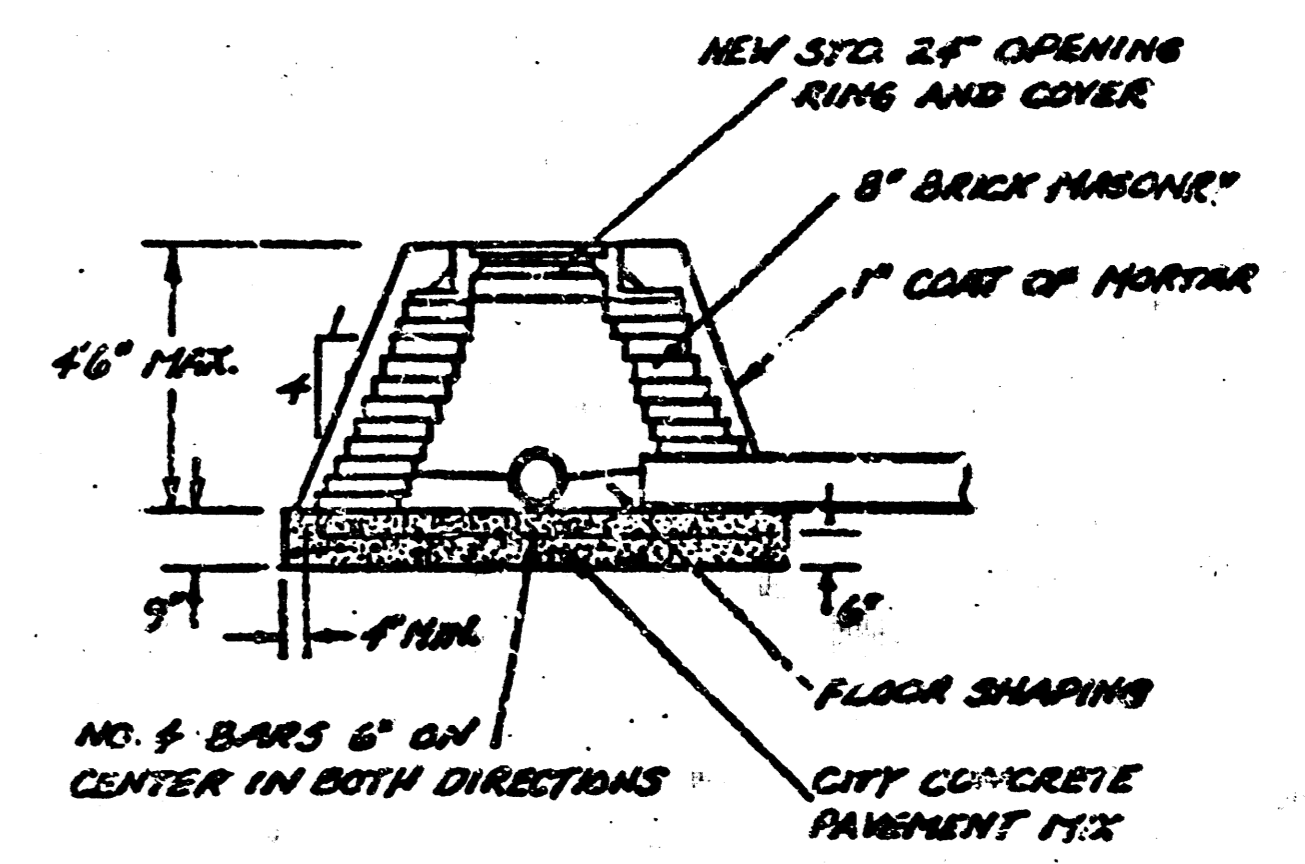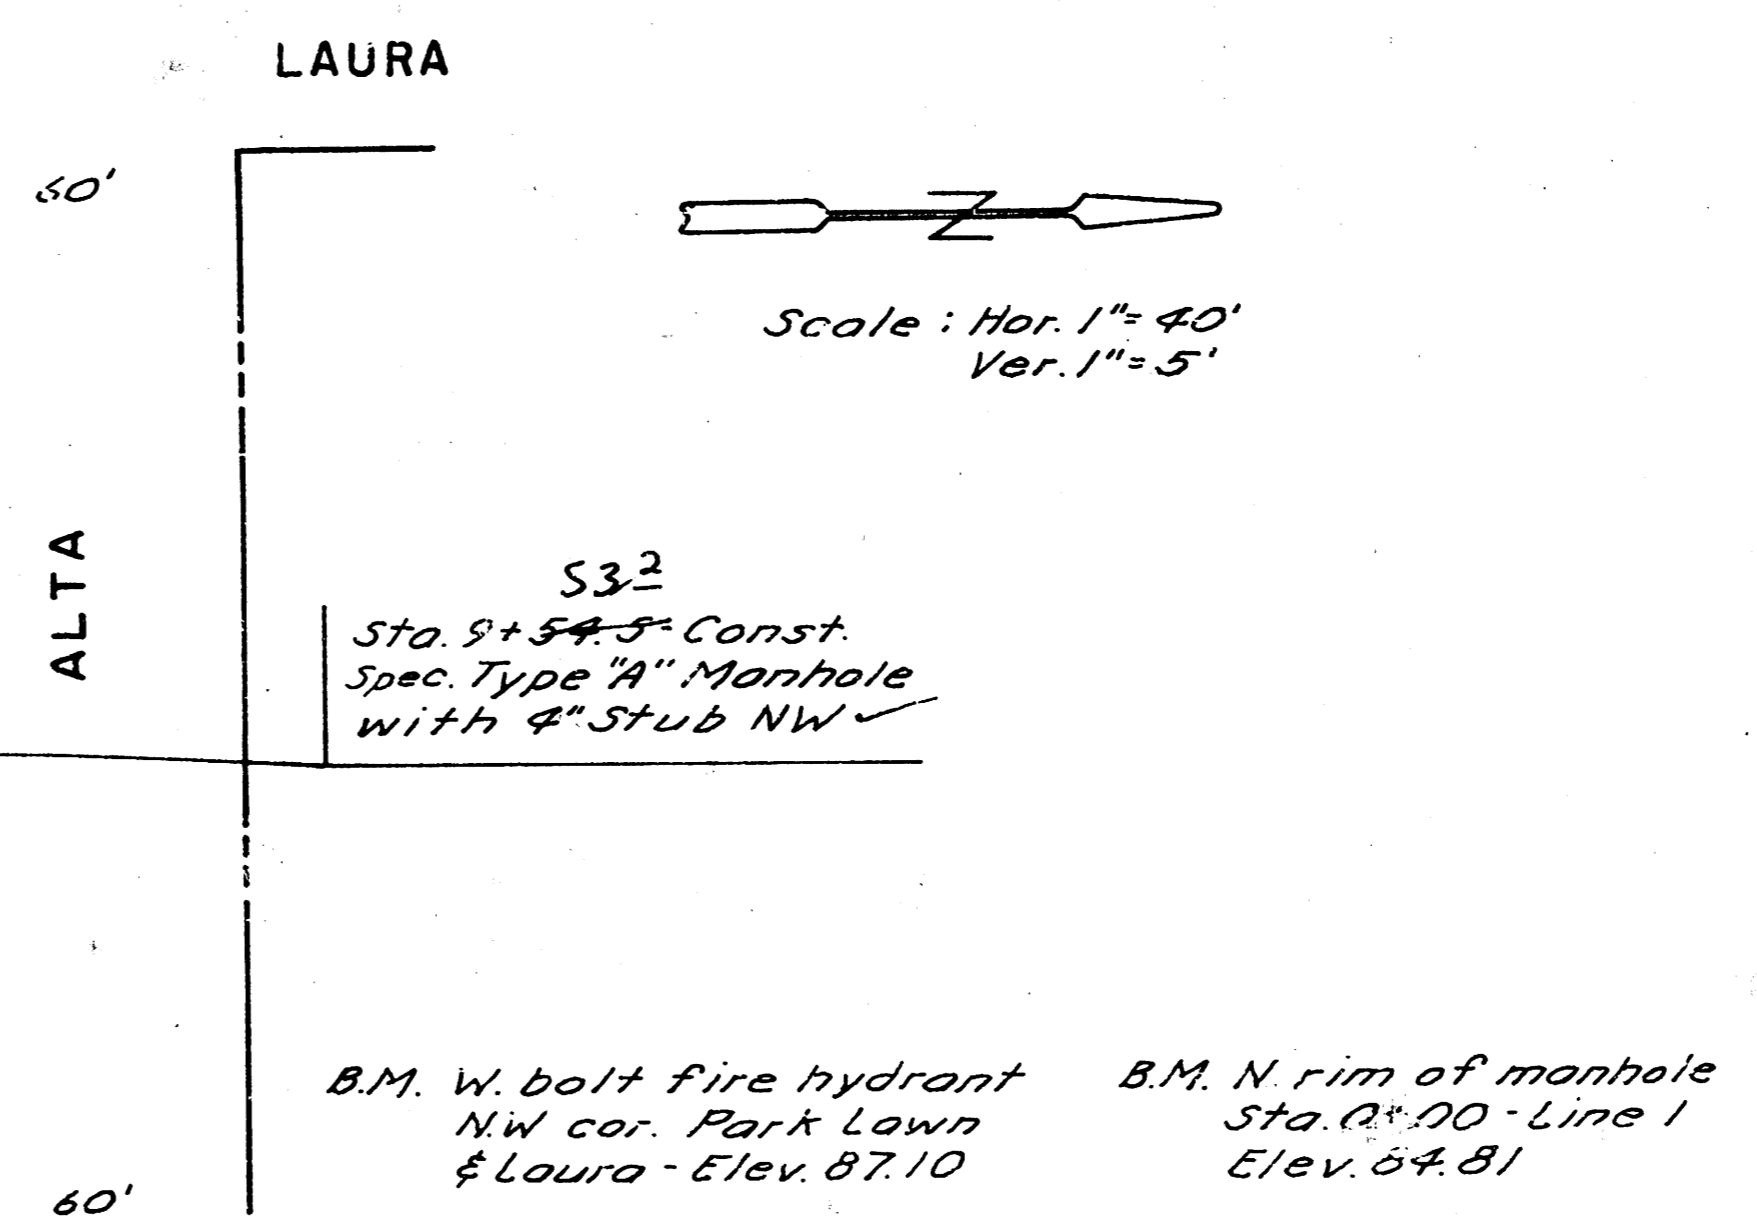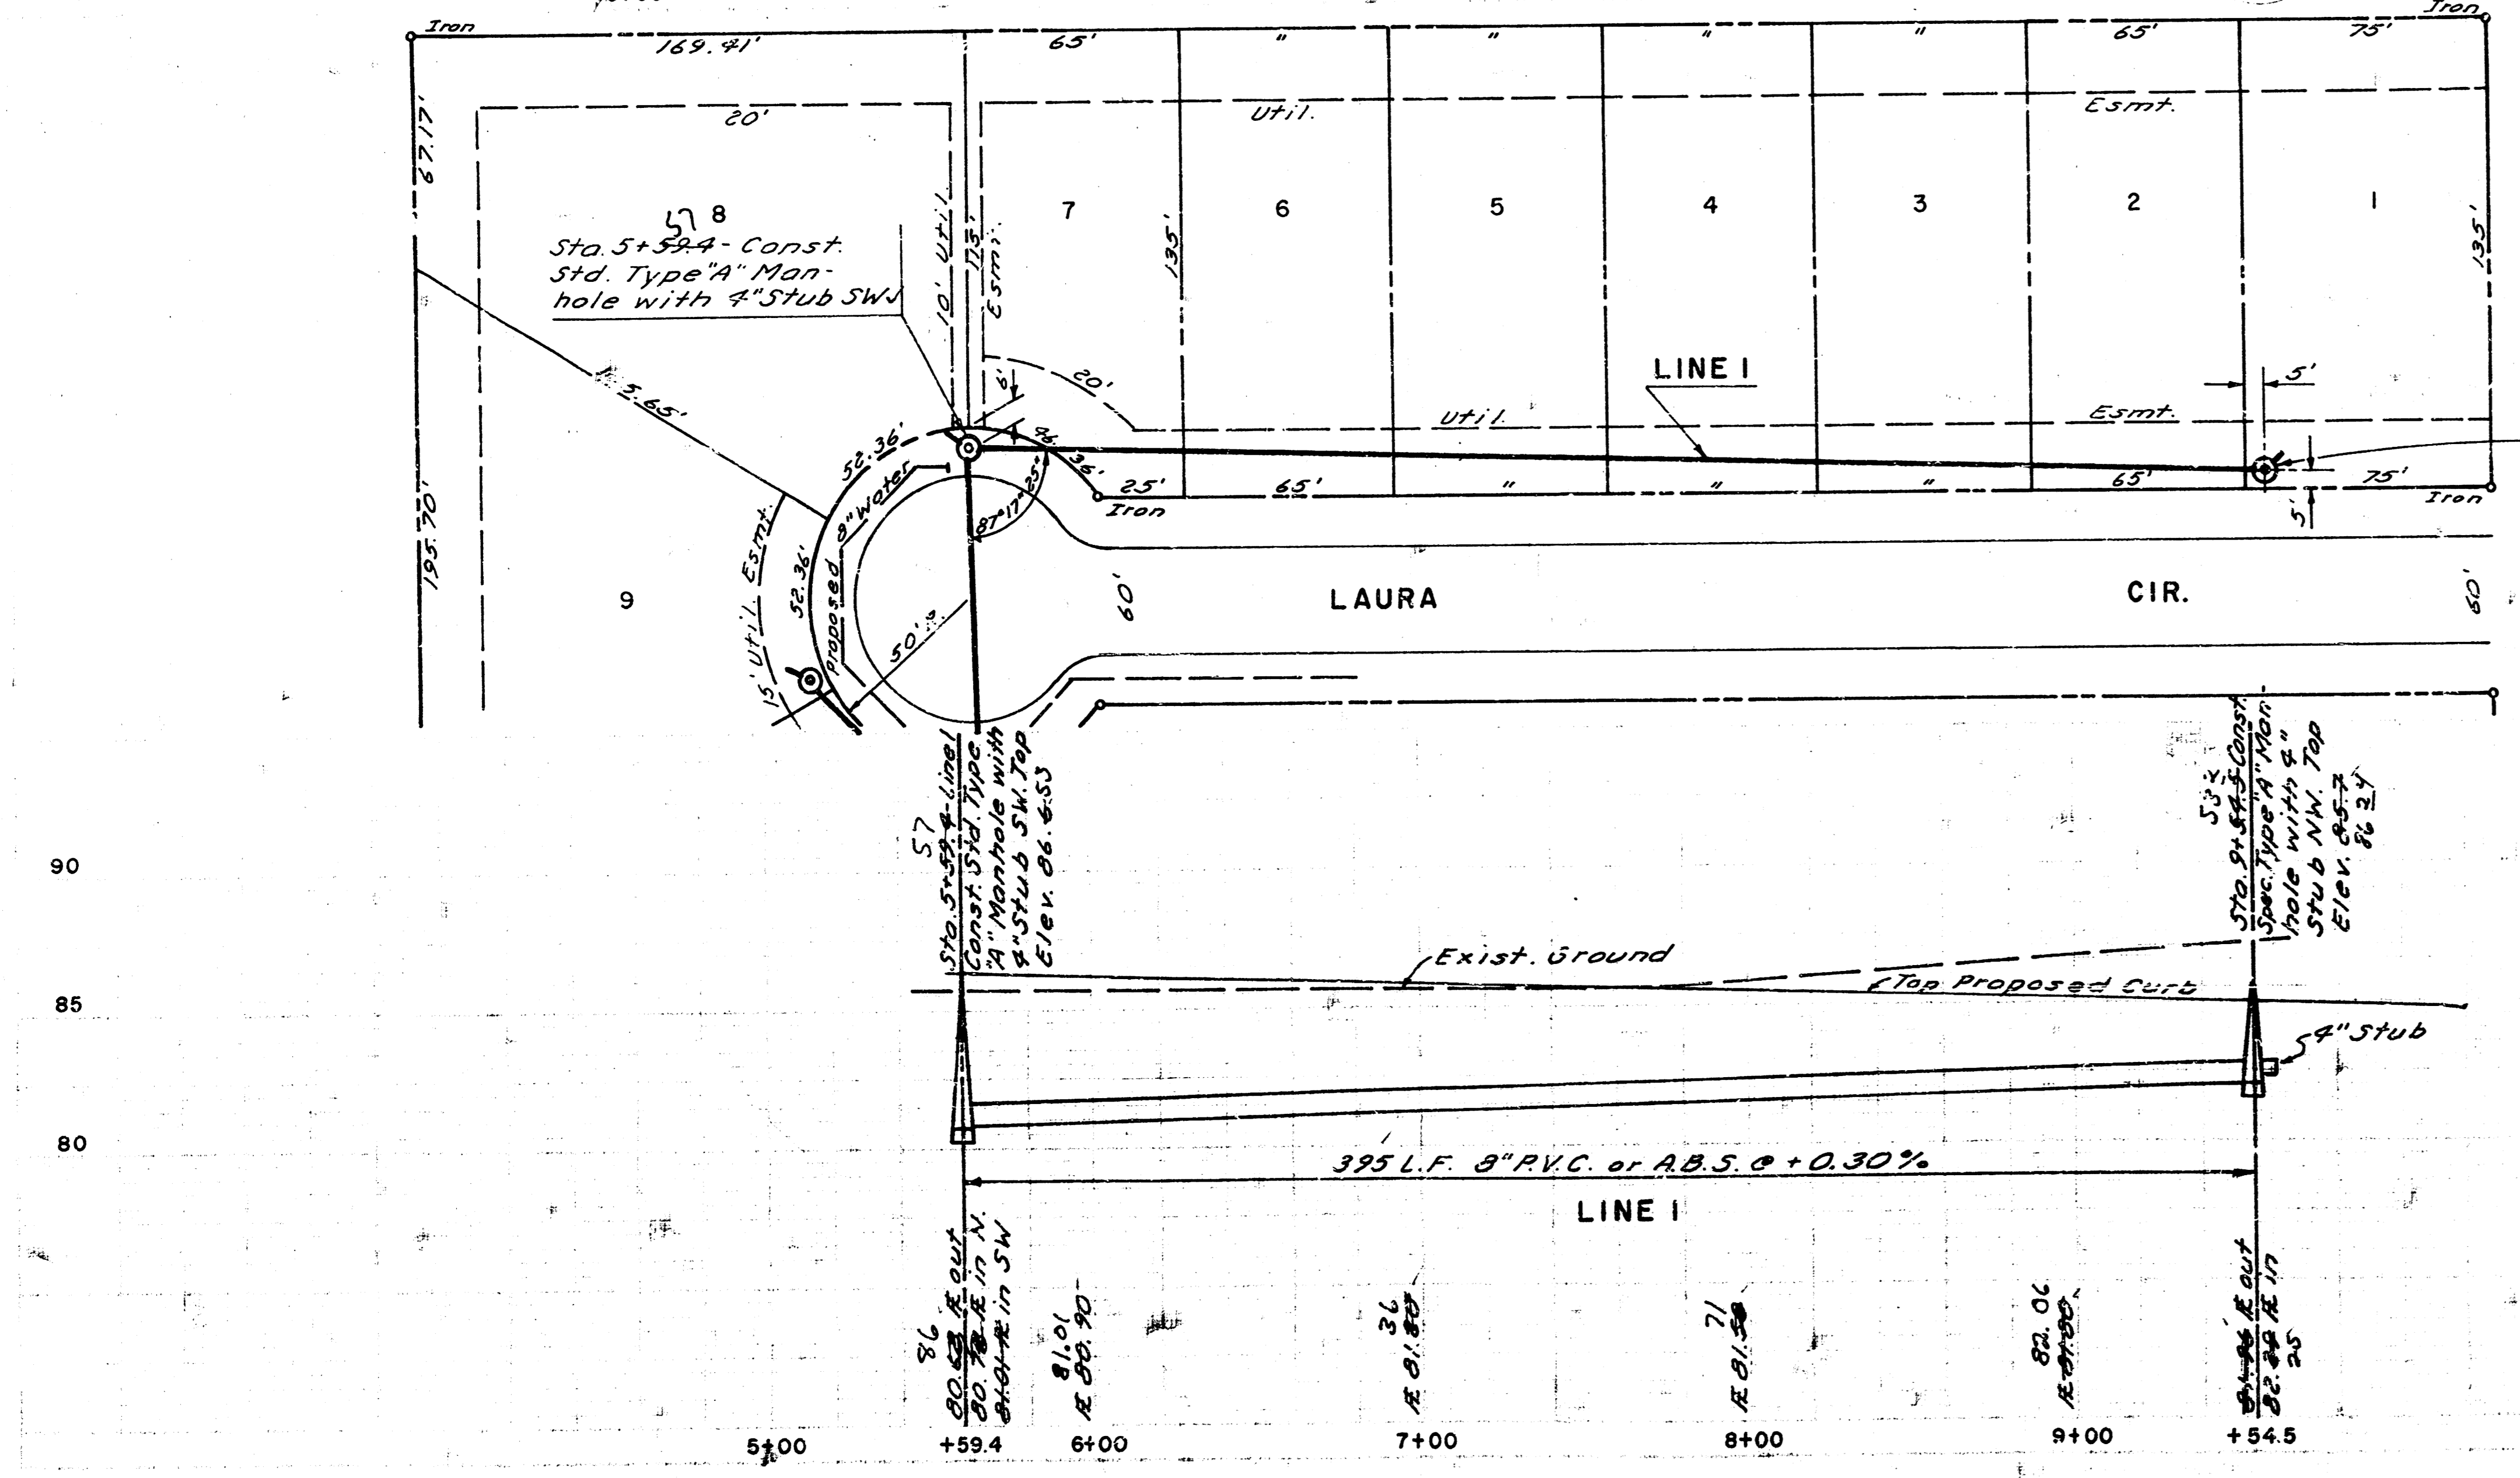


SPECIAL MANHOLE "TYPE A"

LATERAL 55, MAIN I
SOUTHWEST INTERCEPTOR SEWER
SANITARY SEWER TO SERVE
GALYARDT'S 6TH ADDITION
PROJ. NO. 468-76-245-80795-000-000-001

CITY OF WICHITA, KANSAS
MIKE LINDEBAK CITY ENGINEER


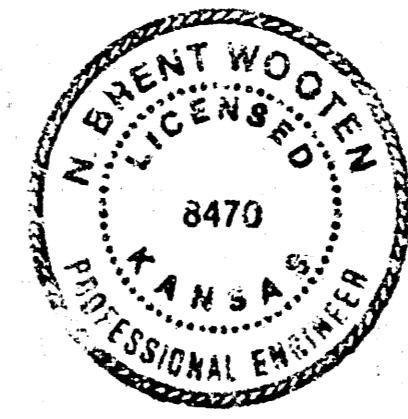


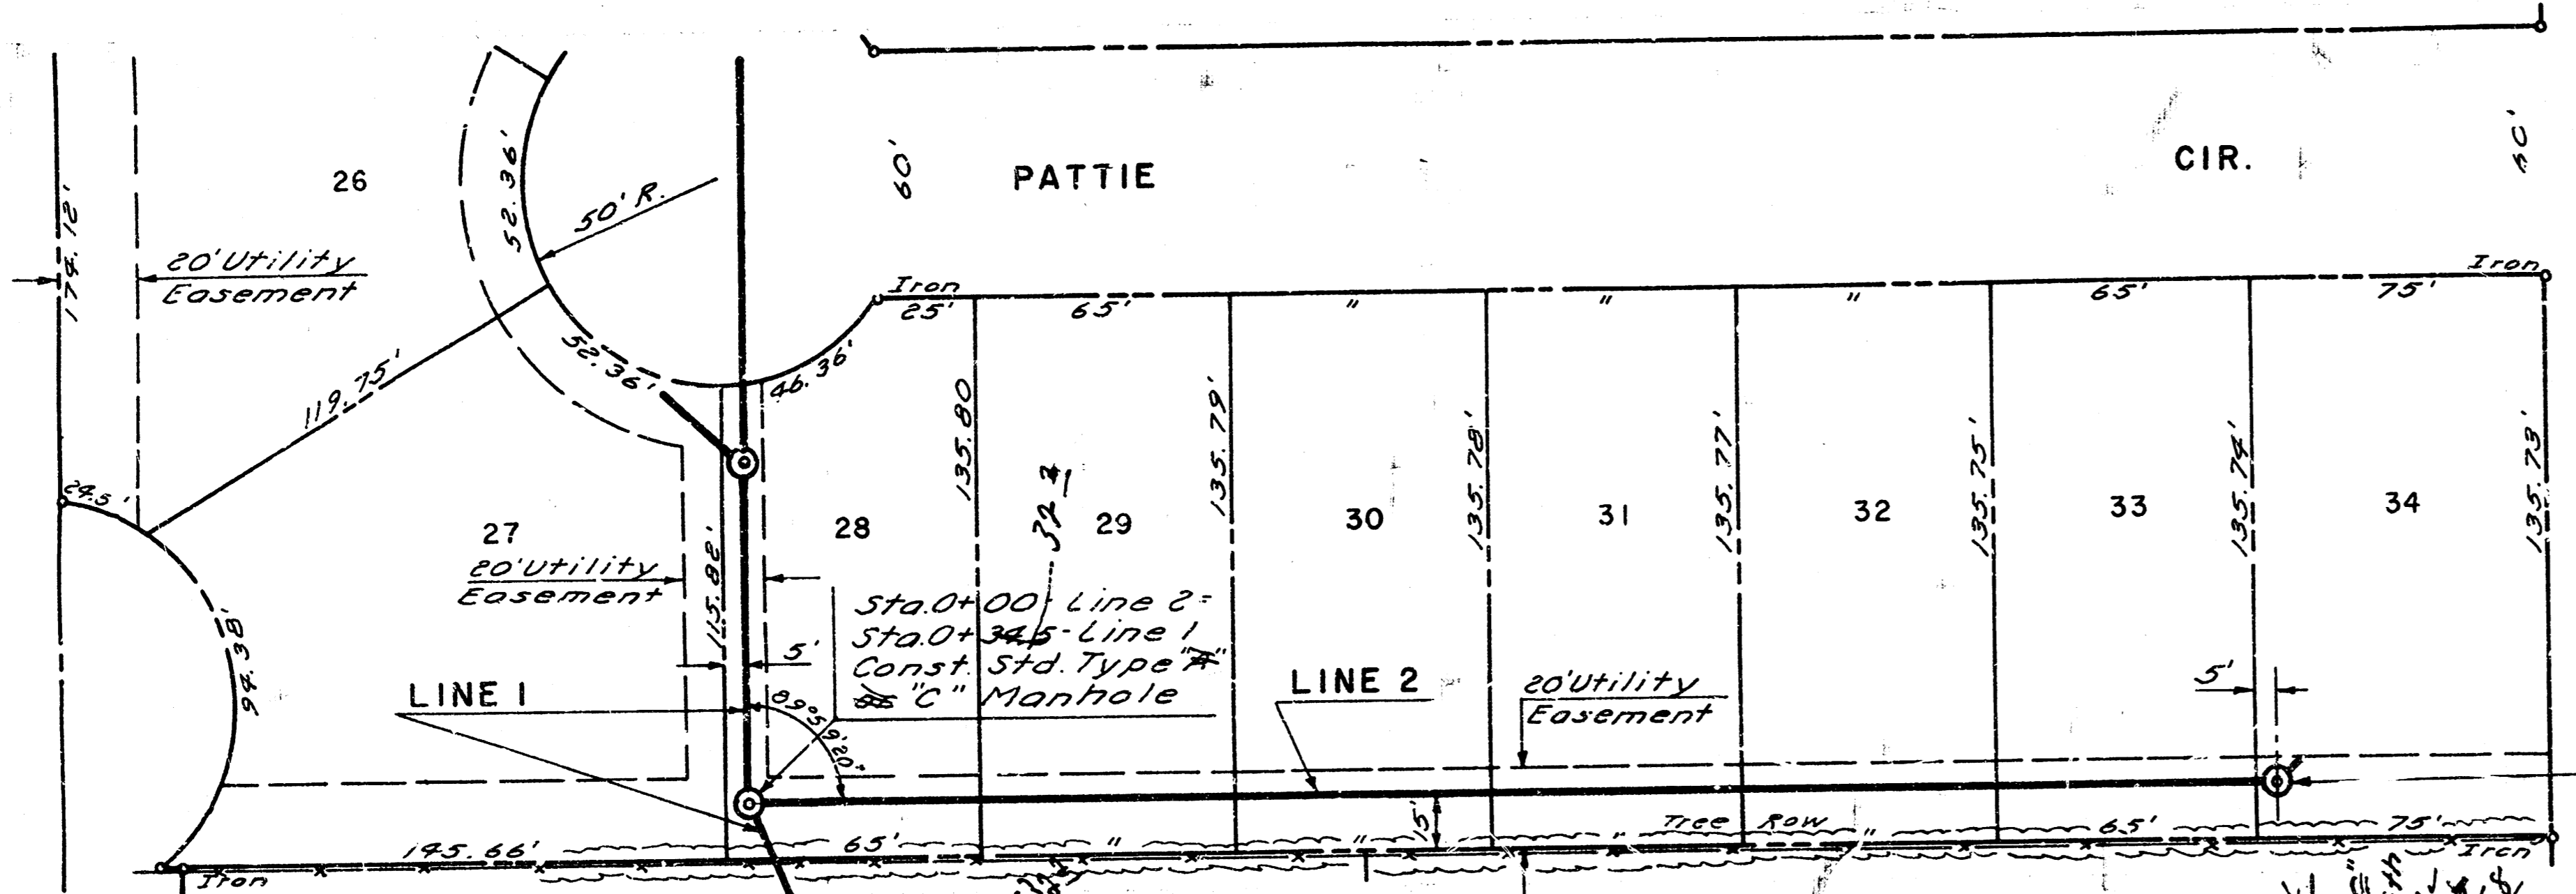

Scale: Hor. 1"=40'
Ver. 1"=5'


Sta. 3+90.0 - Line 2
Const. Std. Type "A"
8" Manhole
with 4" Stub NW

As Built
J.H.
6-84

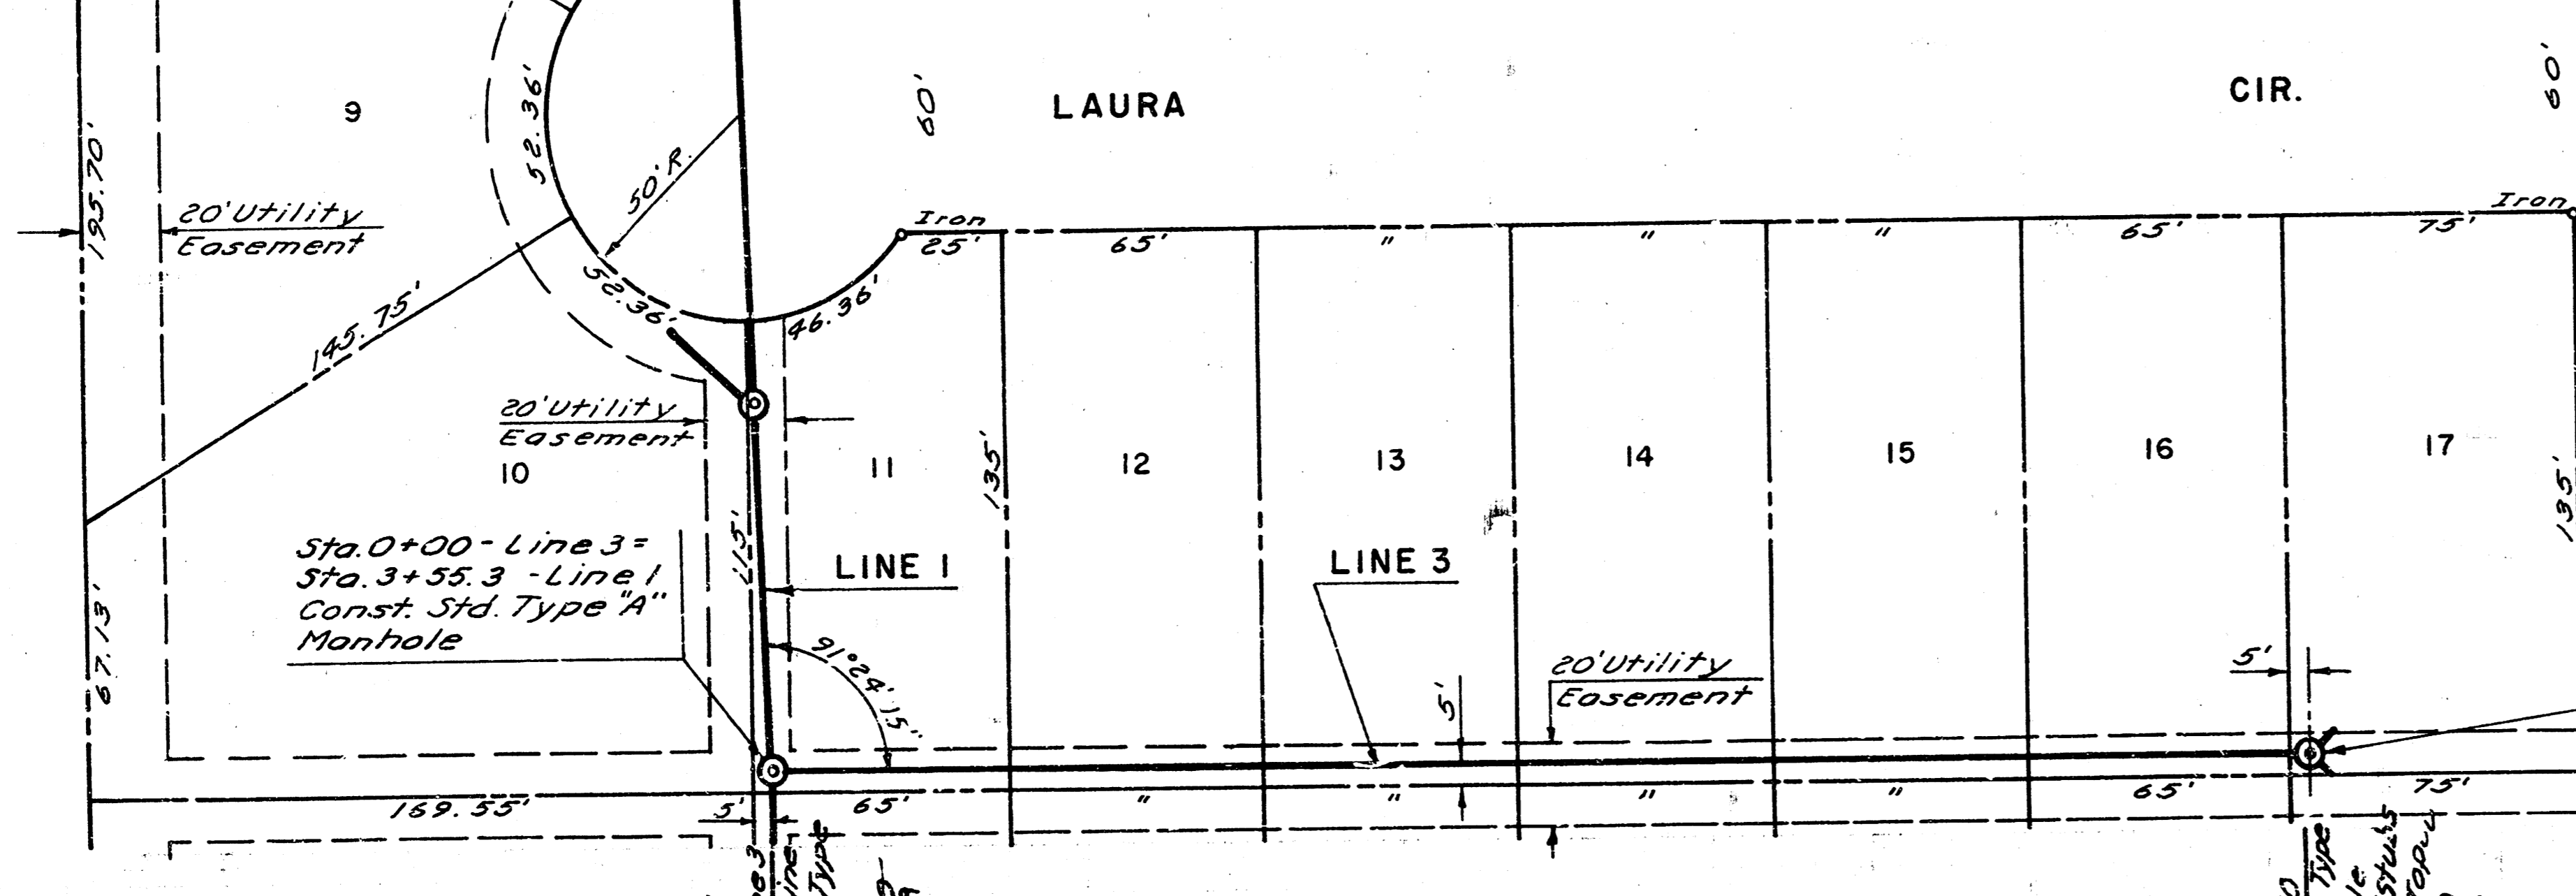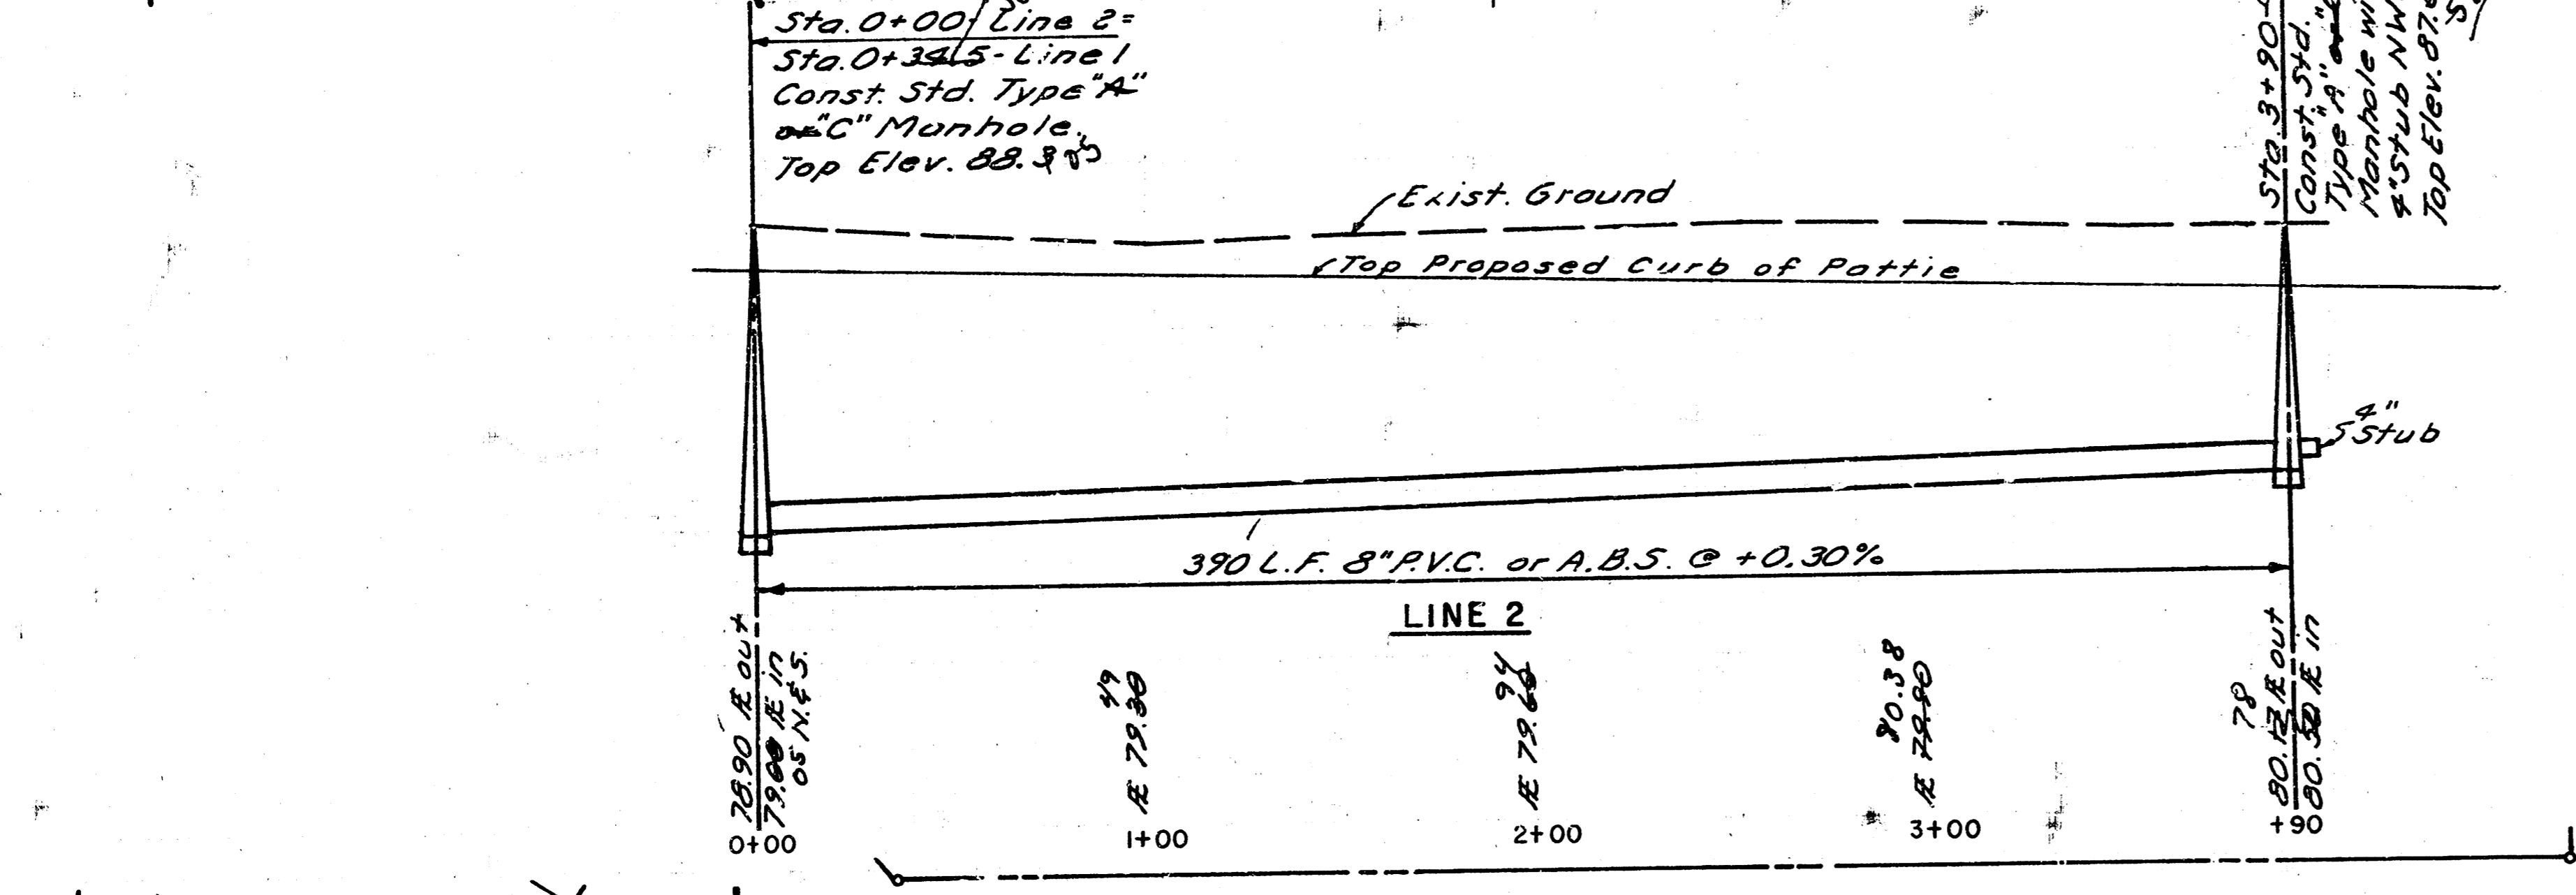

Scale: Hor. 1"=40'
Ver. 1"=5'

Sta. 3+90.0 - Const. Std.
Type "A" Manhole with
2-4" Stubs NW & NE ✓

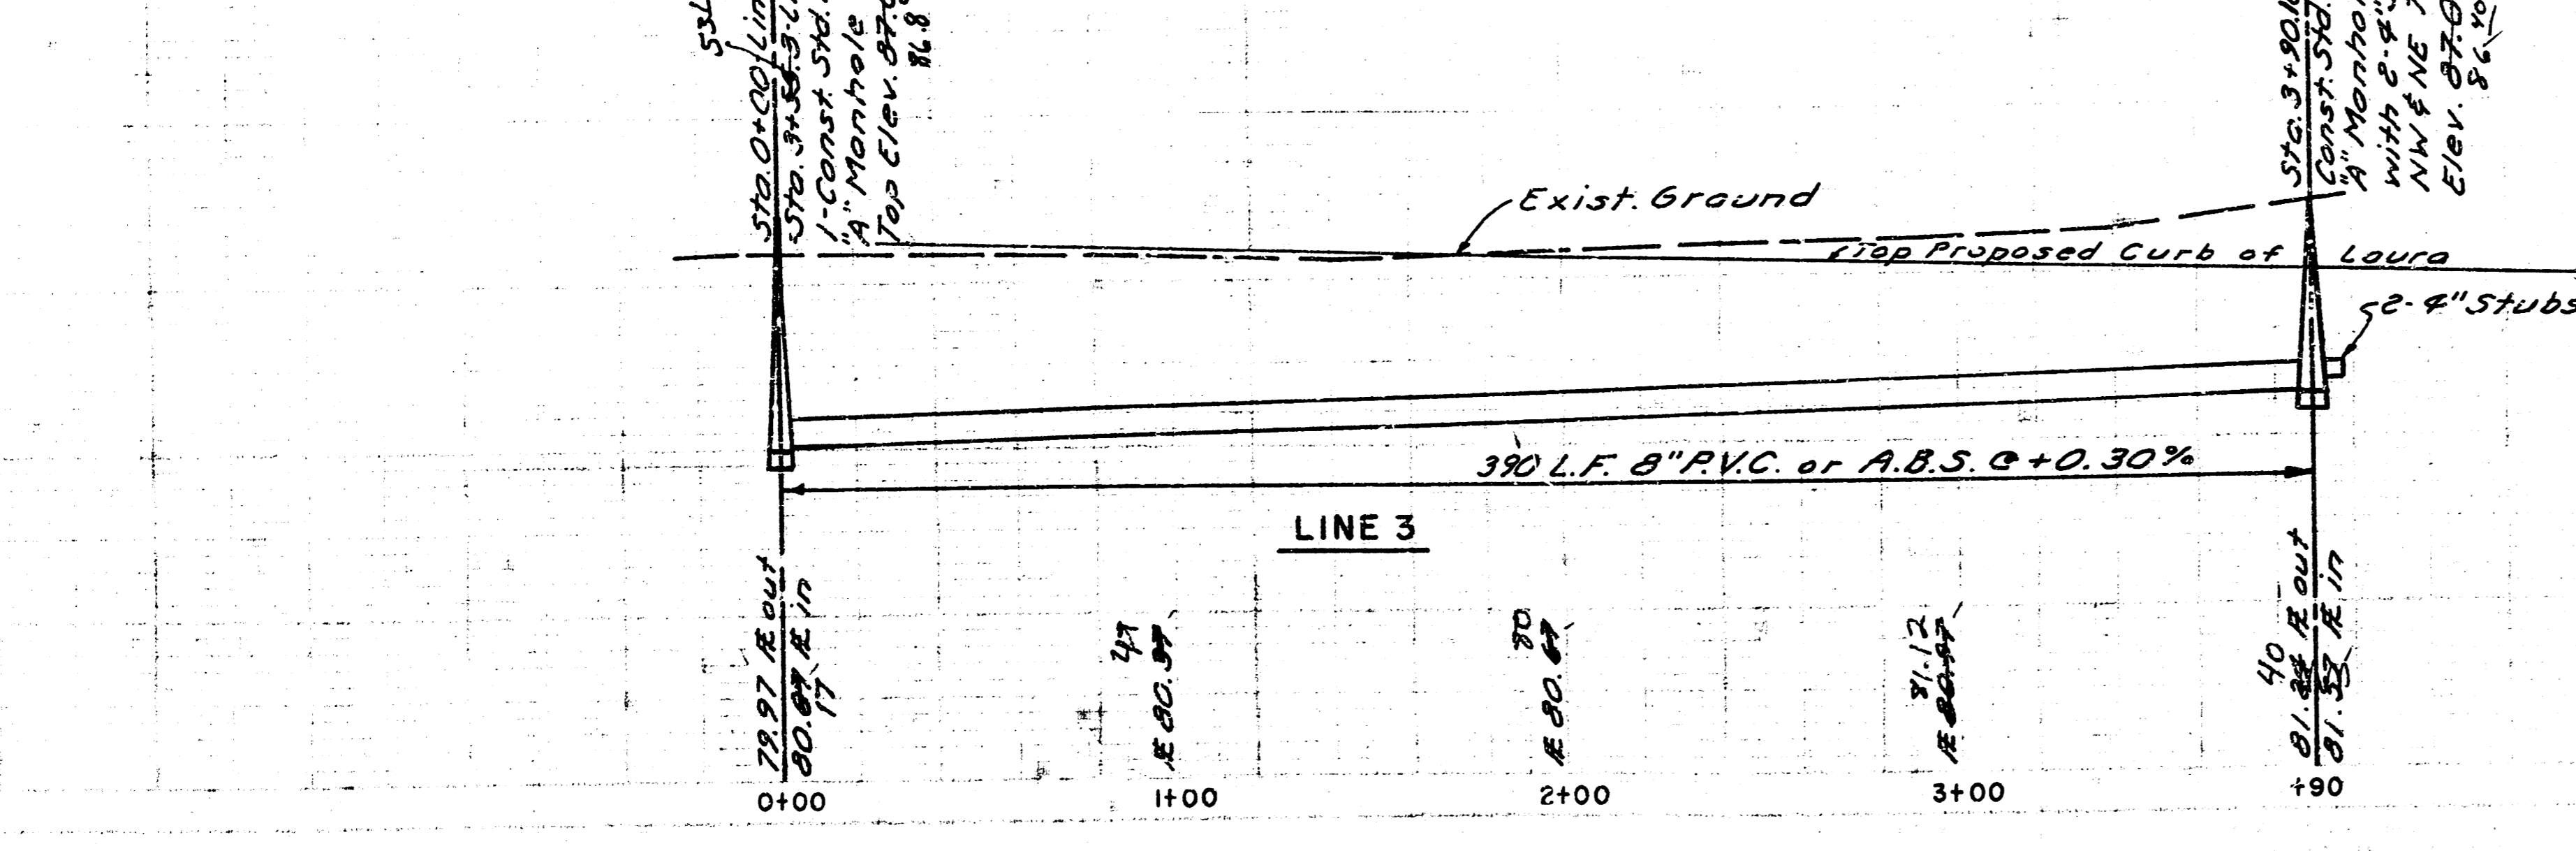

LATERAL 55, MAIN 1
SOUTHWEST INTERCEPTOR SEWER

SANITARY SEWER TO SERVE
GALYARDT'S 6TH ADDITION

PROJ. NO. 468-76-245-80795-000-000-001

CITY OF WICHITA, KANSAS
MIKE LINDEBAK CITY ENGINEER

3/3
SH. 3 OF 3

10 3 5