
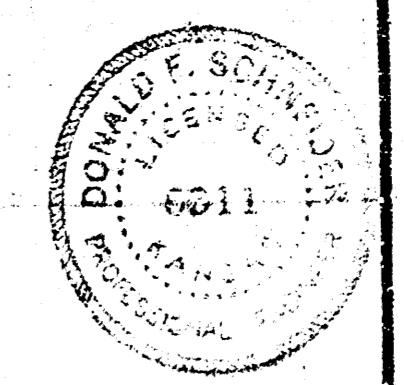
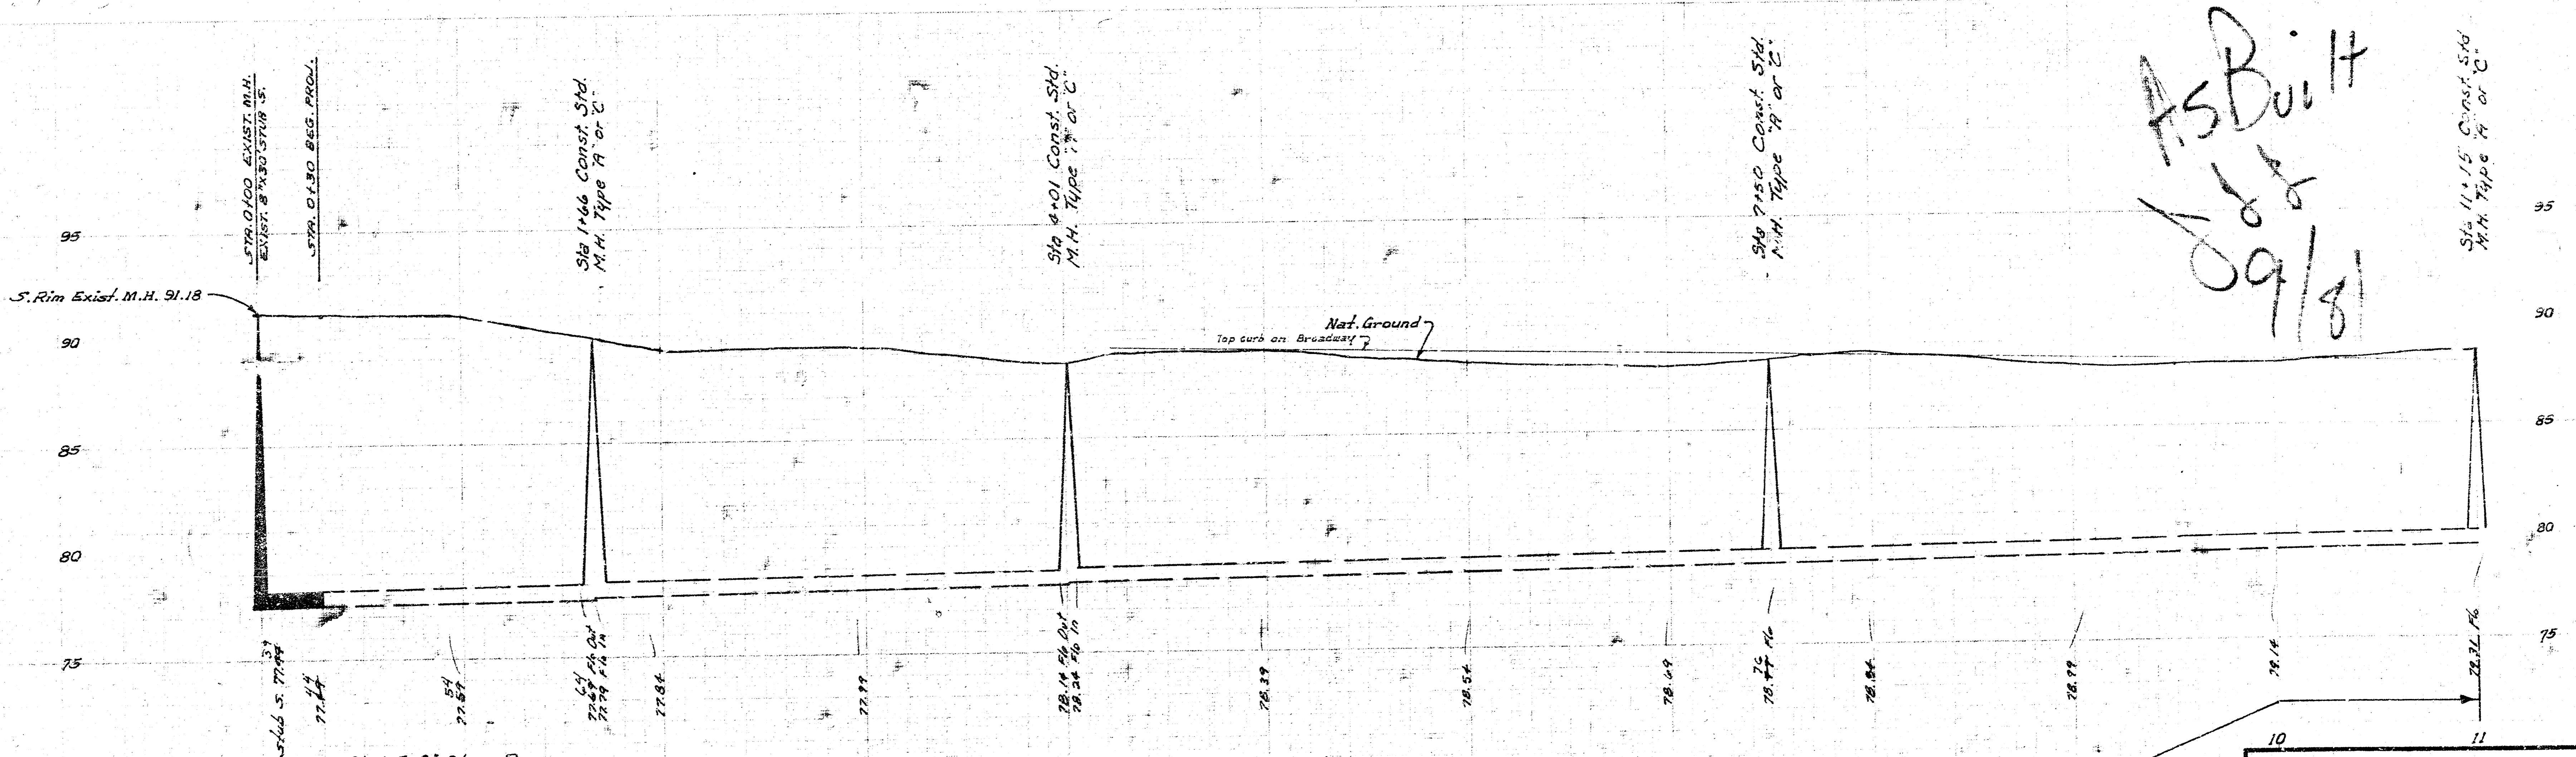




G. Young  
D. Cherner

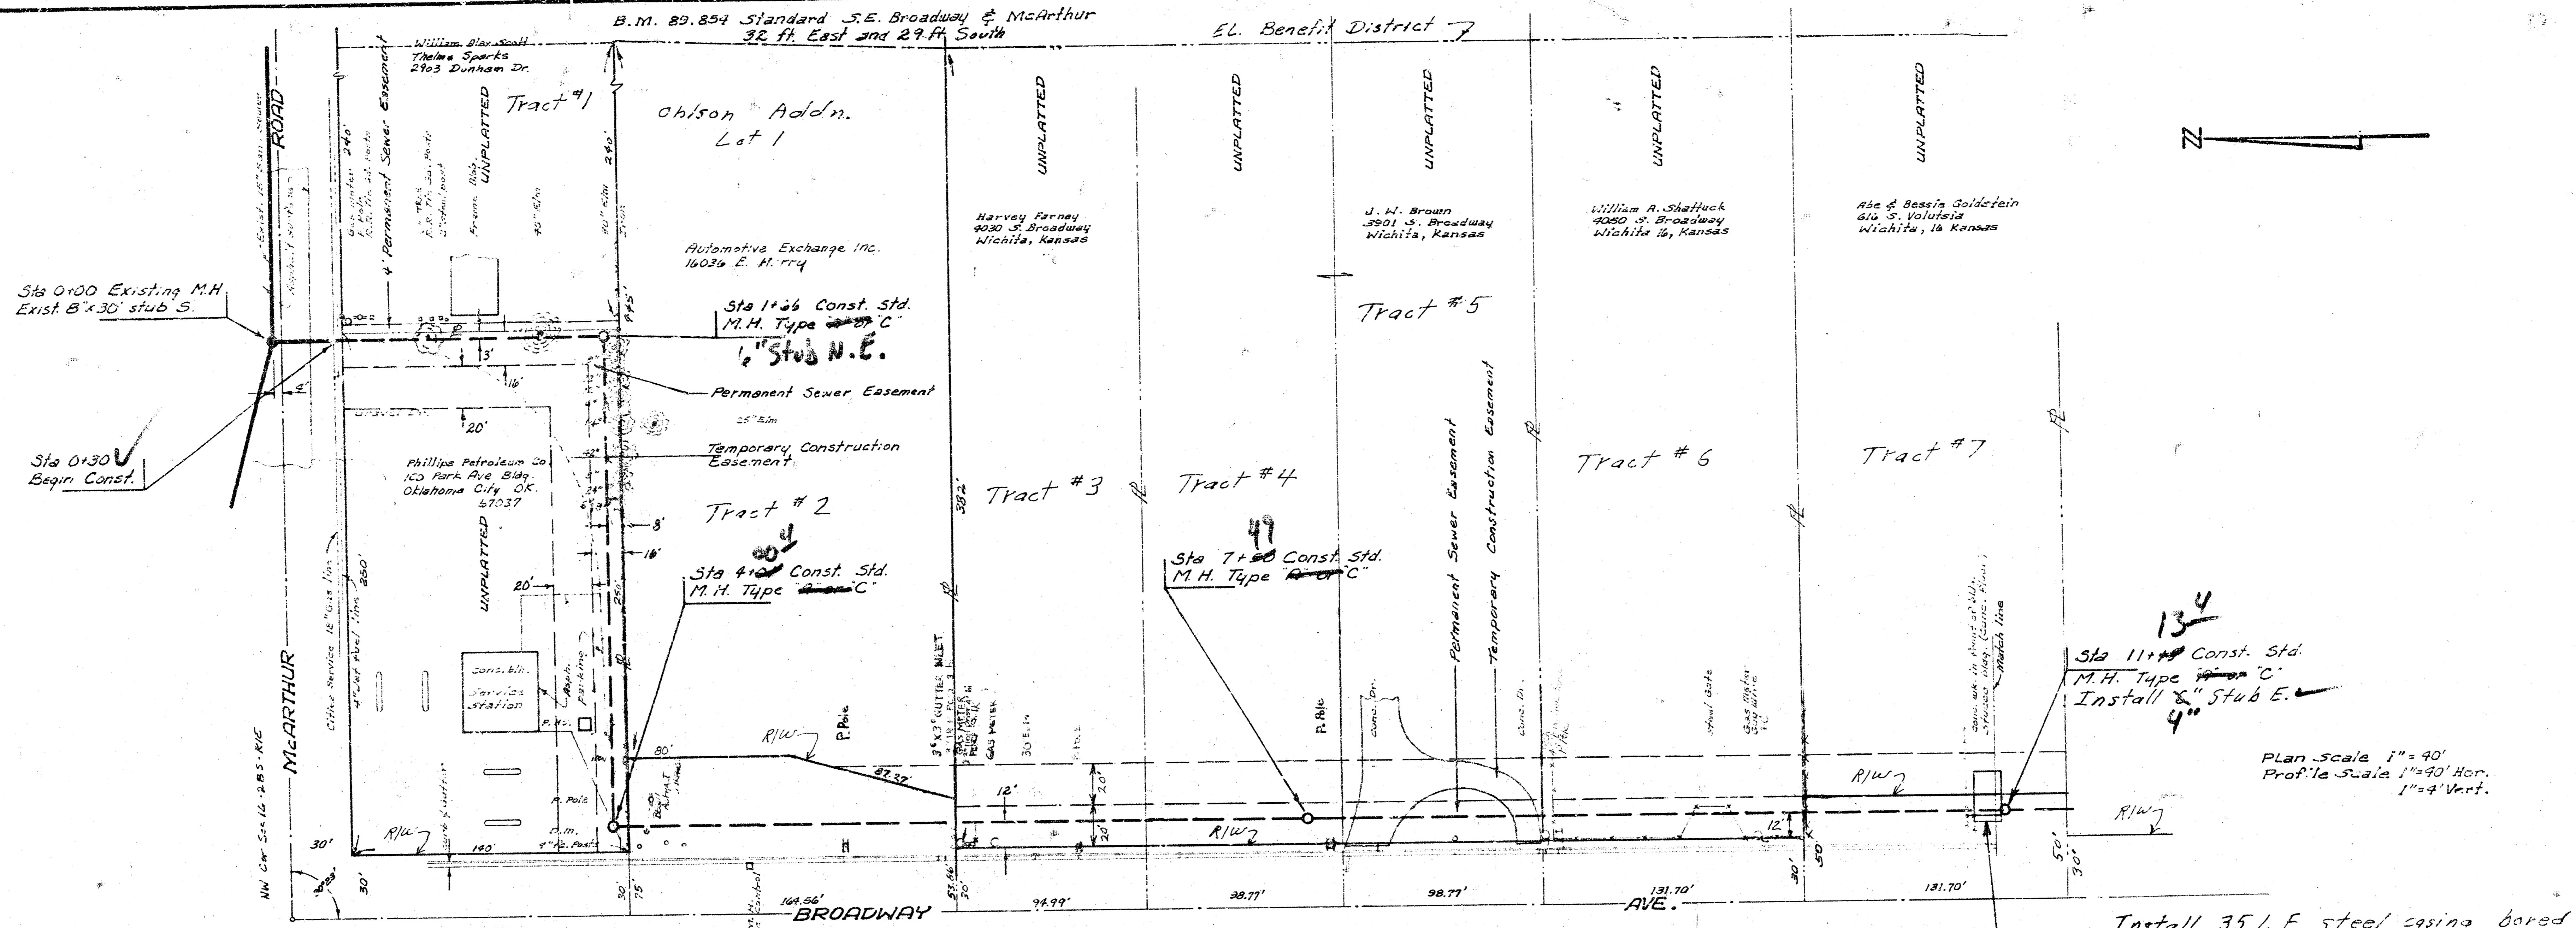

LAT. 3, SUB. 2, S.W. INTERCEPTOR  
CITY OF WICHITA, KANSAS



PROJ. NO. 418 76-245 62053-000 000 000

DATE:  
Sheet 1 of 3

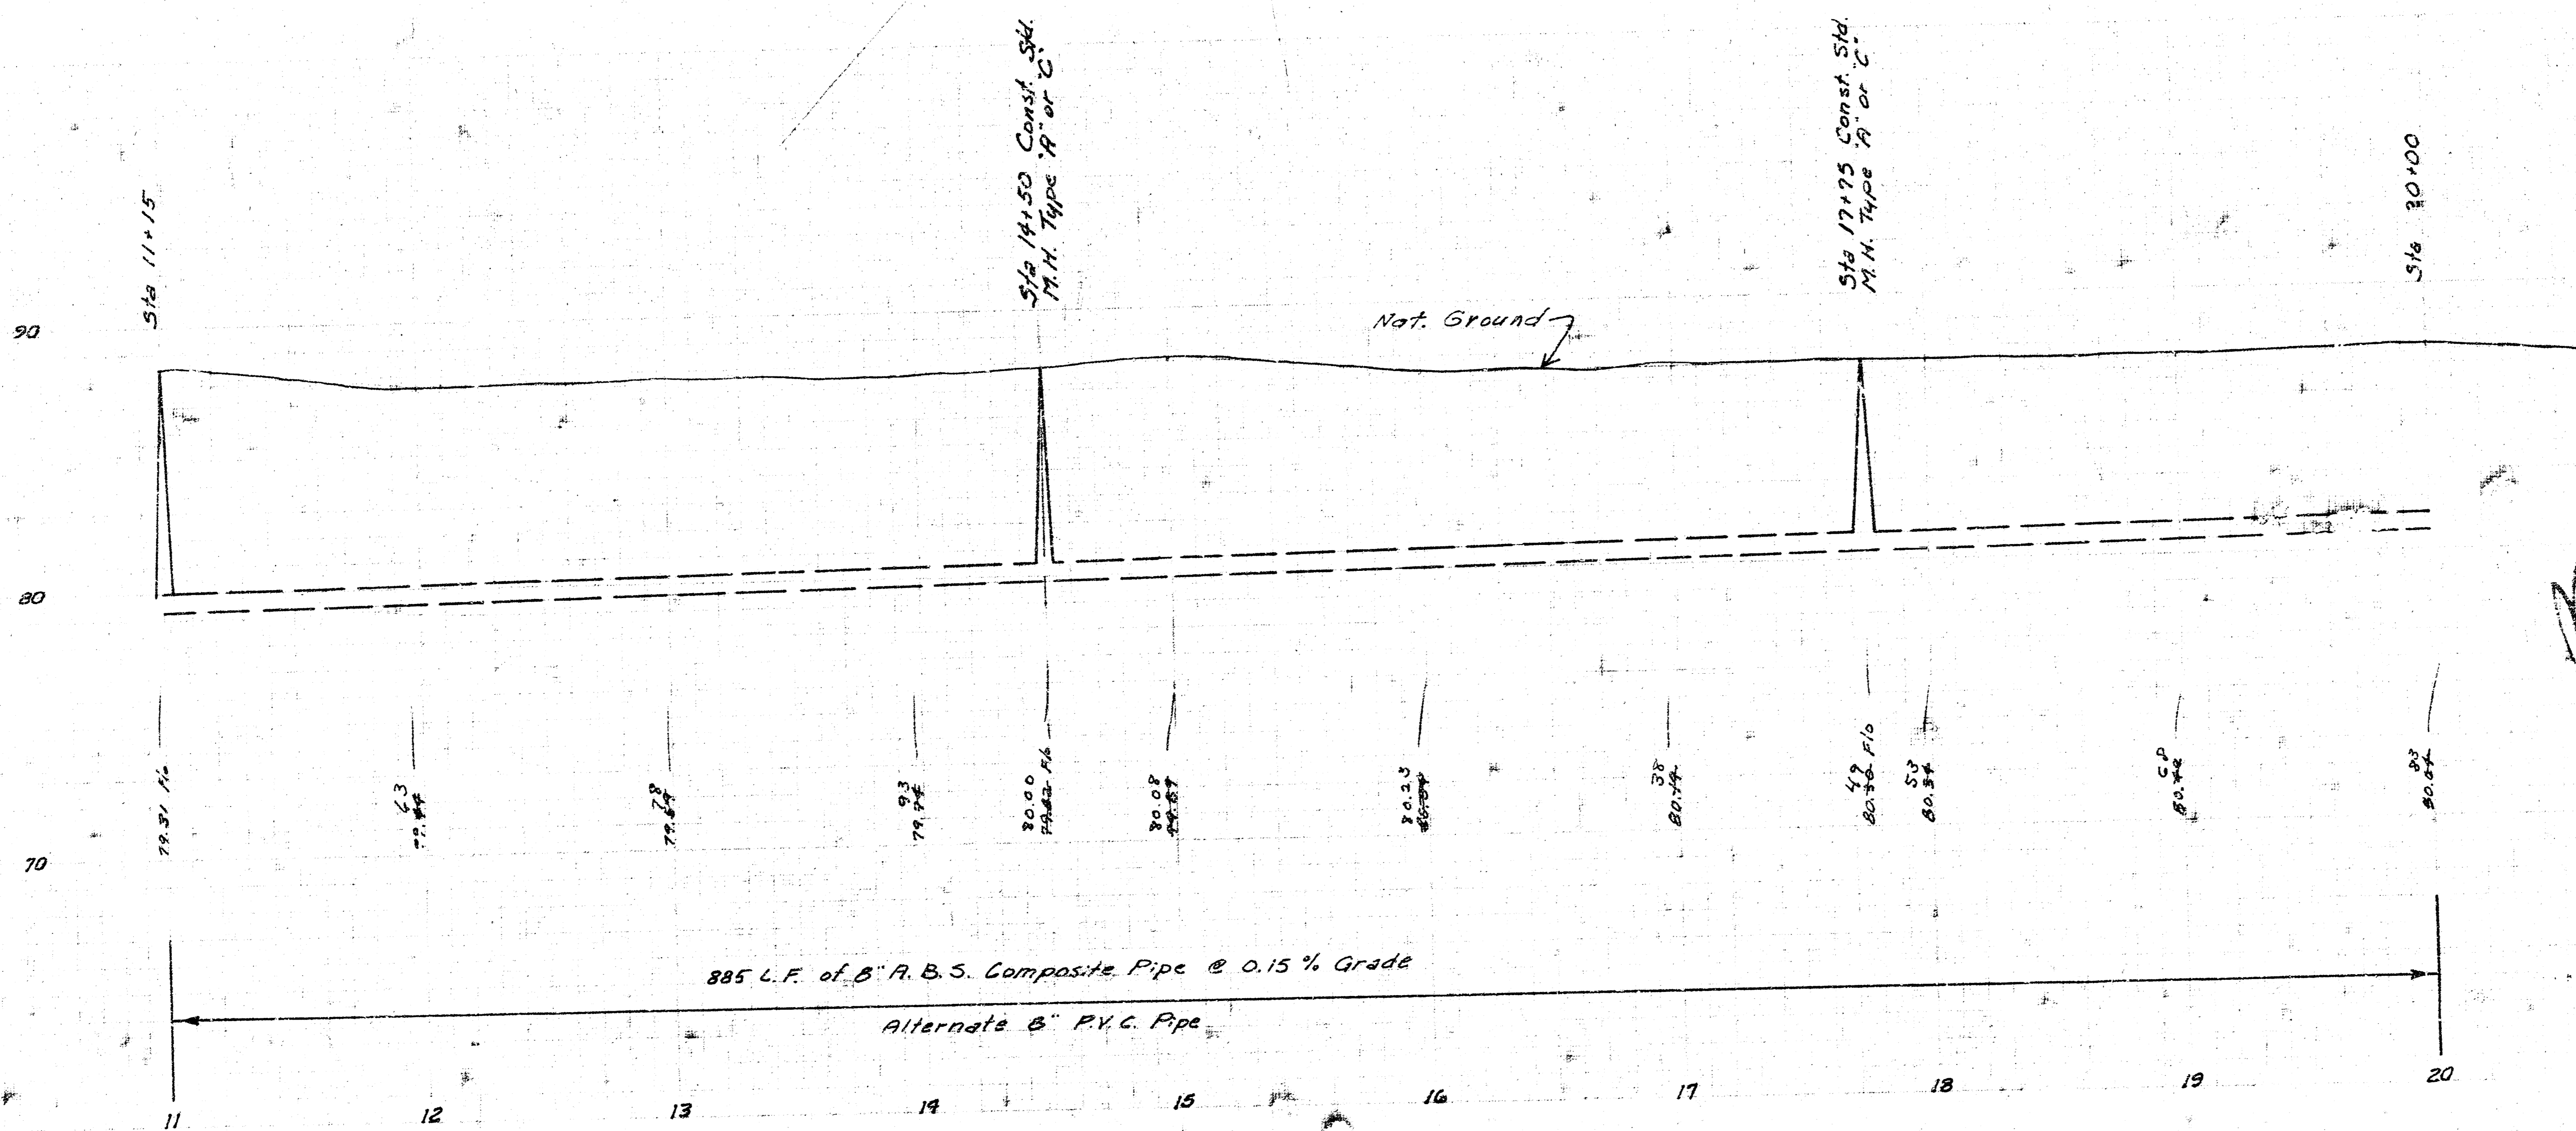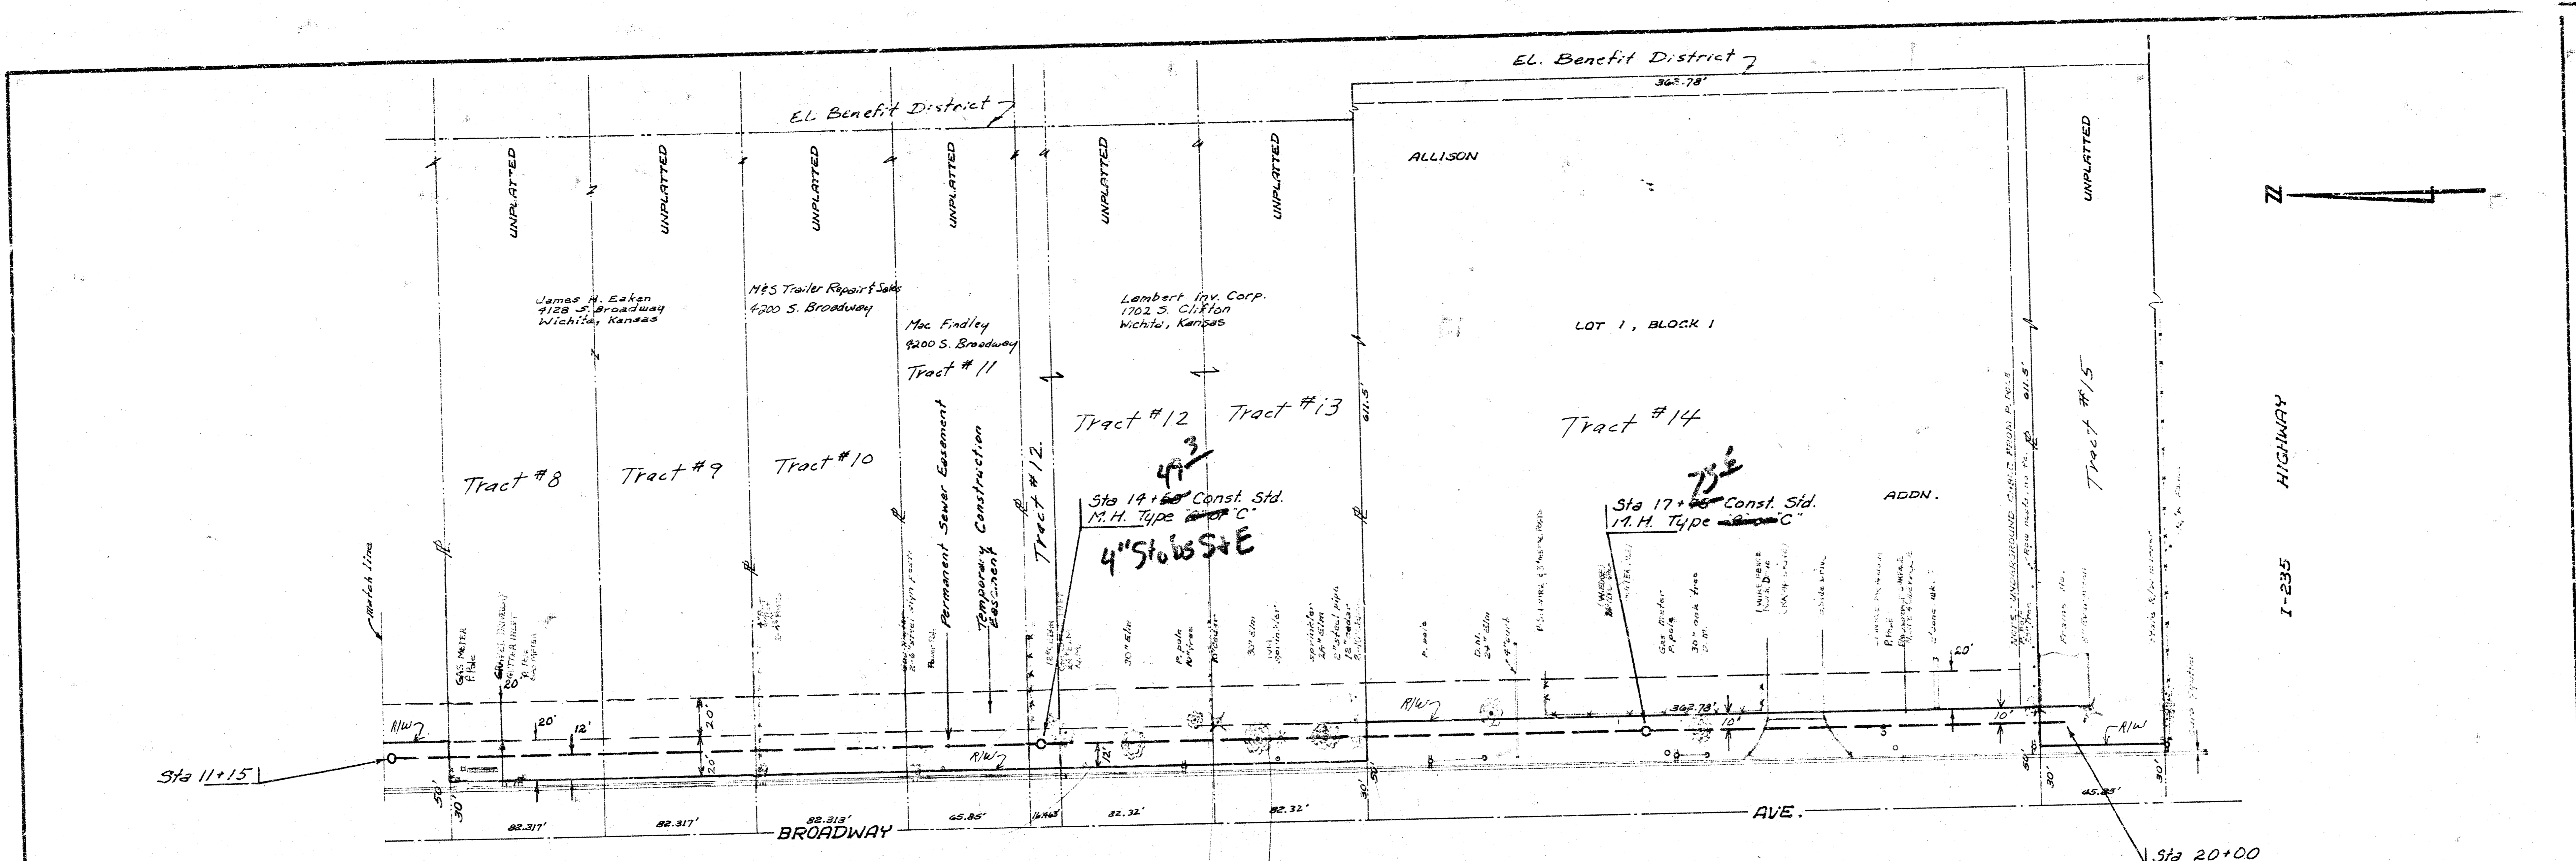

As Built  
9/18/18  
JSS

PLANS  
9/18  
De Ciego  
7/20/12

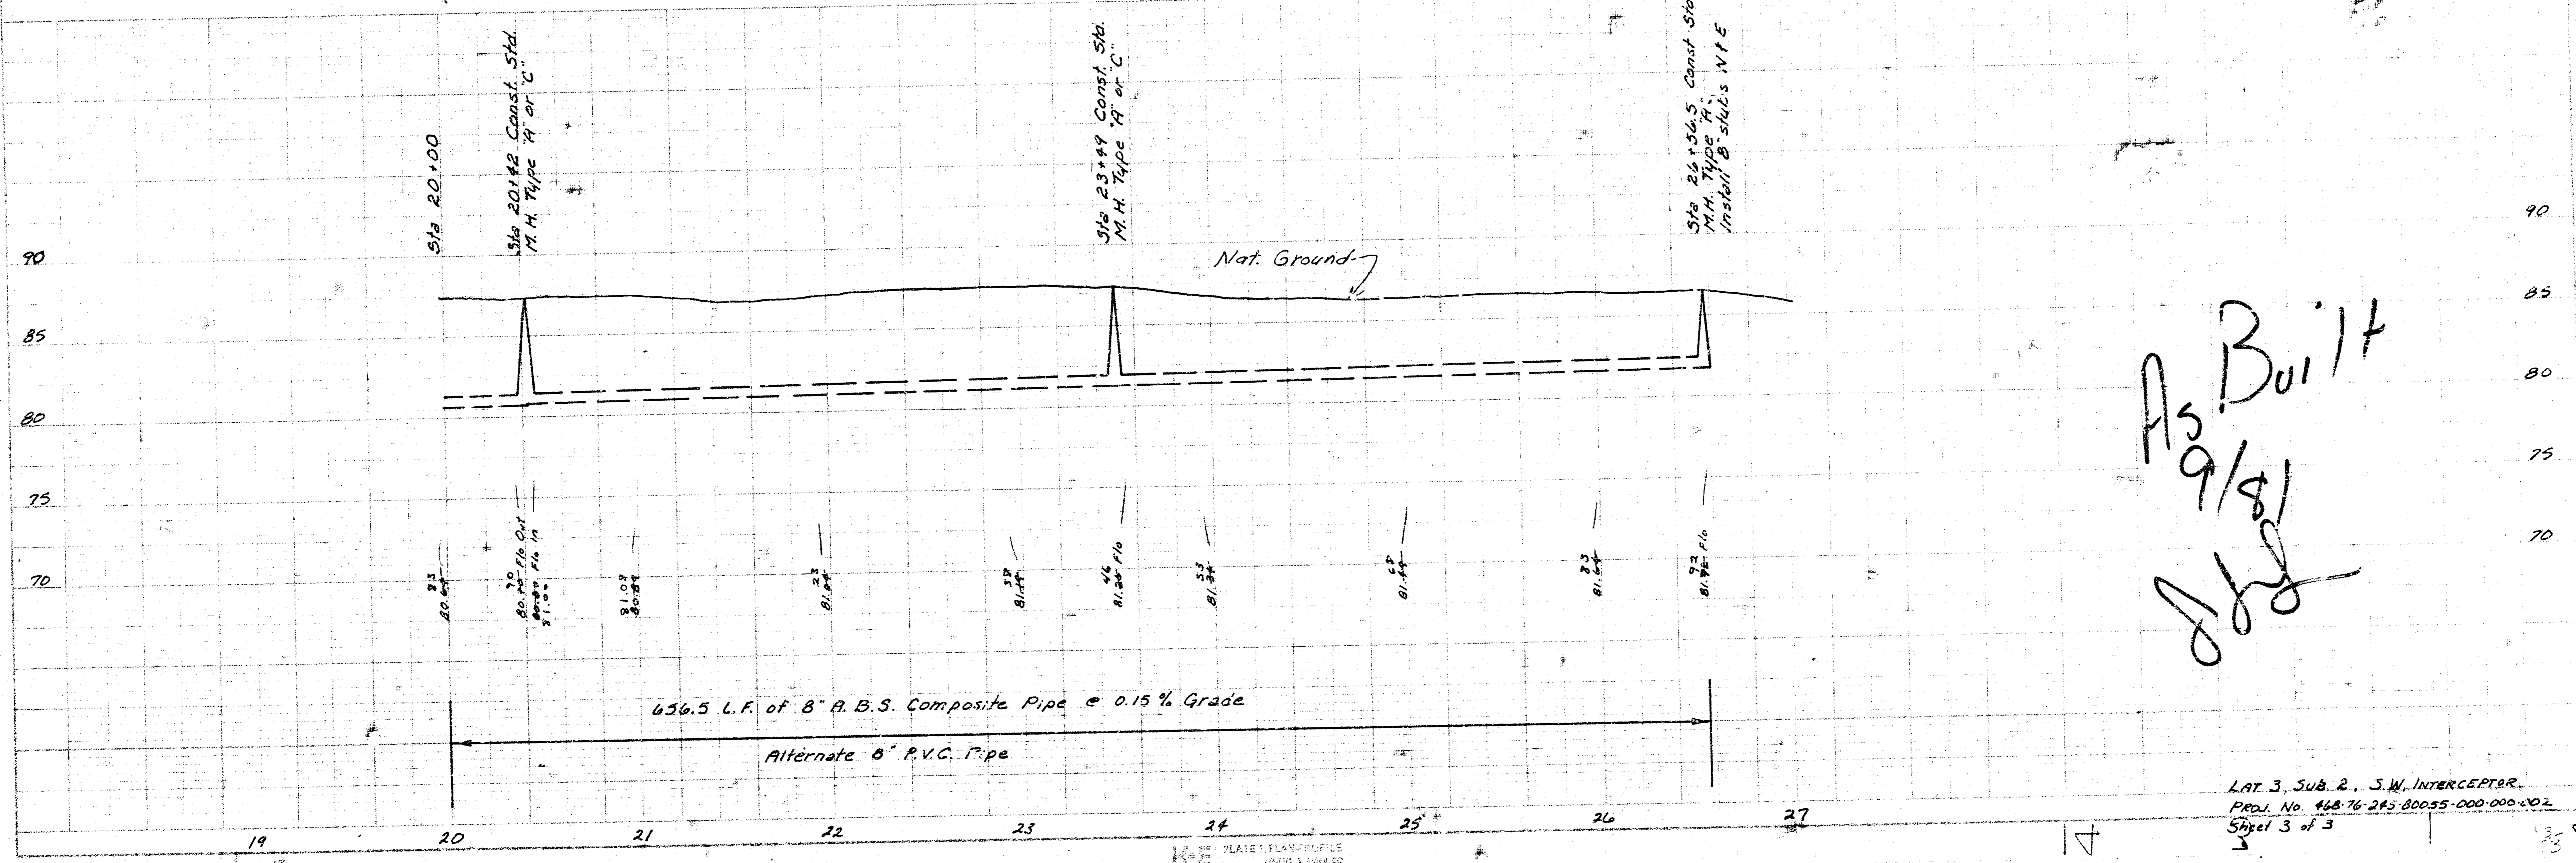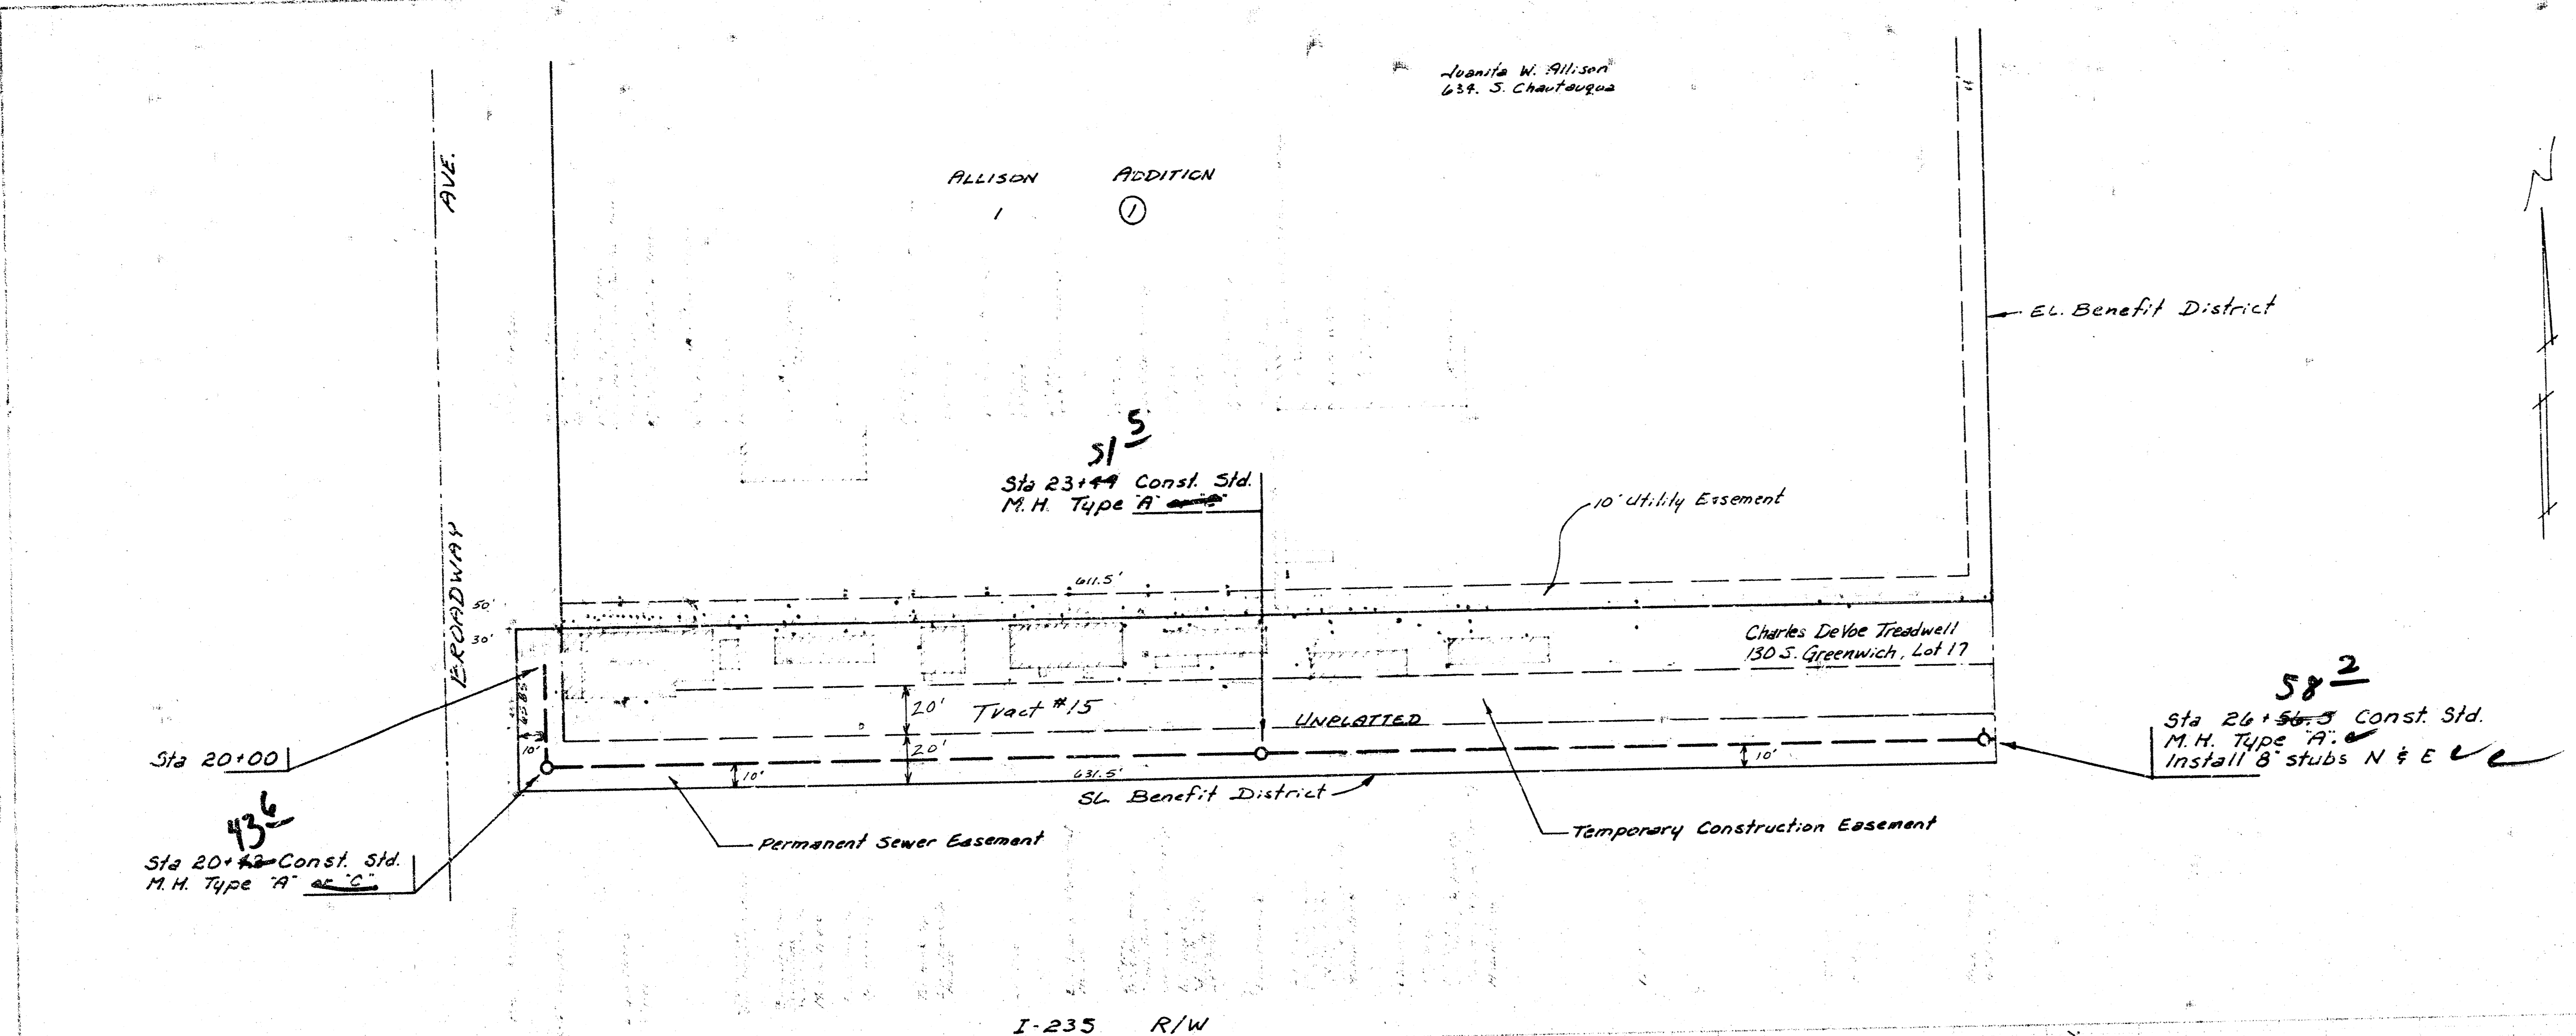

As Built  
9/18/12  
[Signature]

LAT. 3, SUB. 2, S.W. INTERCEPTOR  
PROJ. No. 468-76-243-80055-000-000-102  
Sheet 3 of 3

PLATE 1 PLAN PROFILE  
15/04/12 1:00PM

FINISHED FROM THE BEST