


Plan Scale 1" = 40'  
 Profile Scale 1" = 40' Hor.  
 1" = 5' Vert.

B.M. 88.01 City Std. Disc. 42.8' S. & 48' E. of E. 43rd St. & Seneca  
 B.M. 89.82 R.R. Spk S. Face Street Lite Pole N.E. Cor. Handley-43rd St. So.

NOTE:  
 Replace all fences.  
 Replace all clothes line poles.

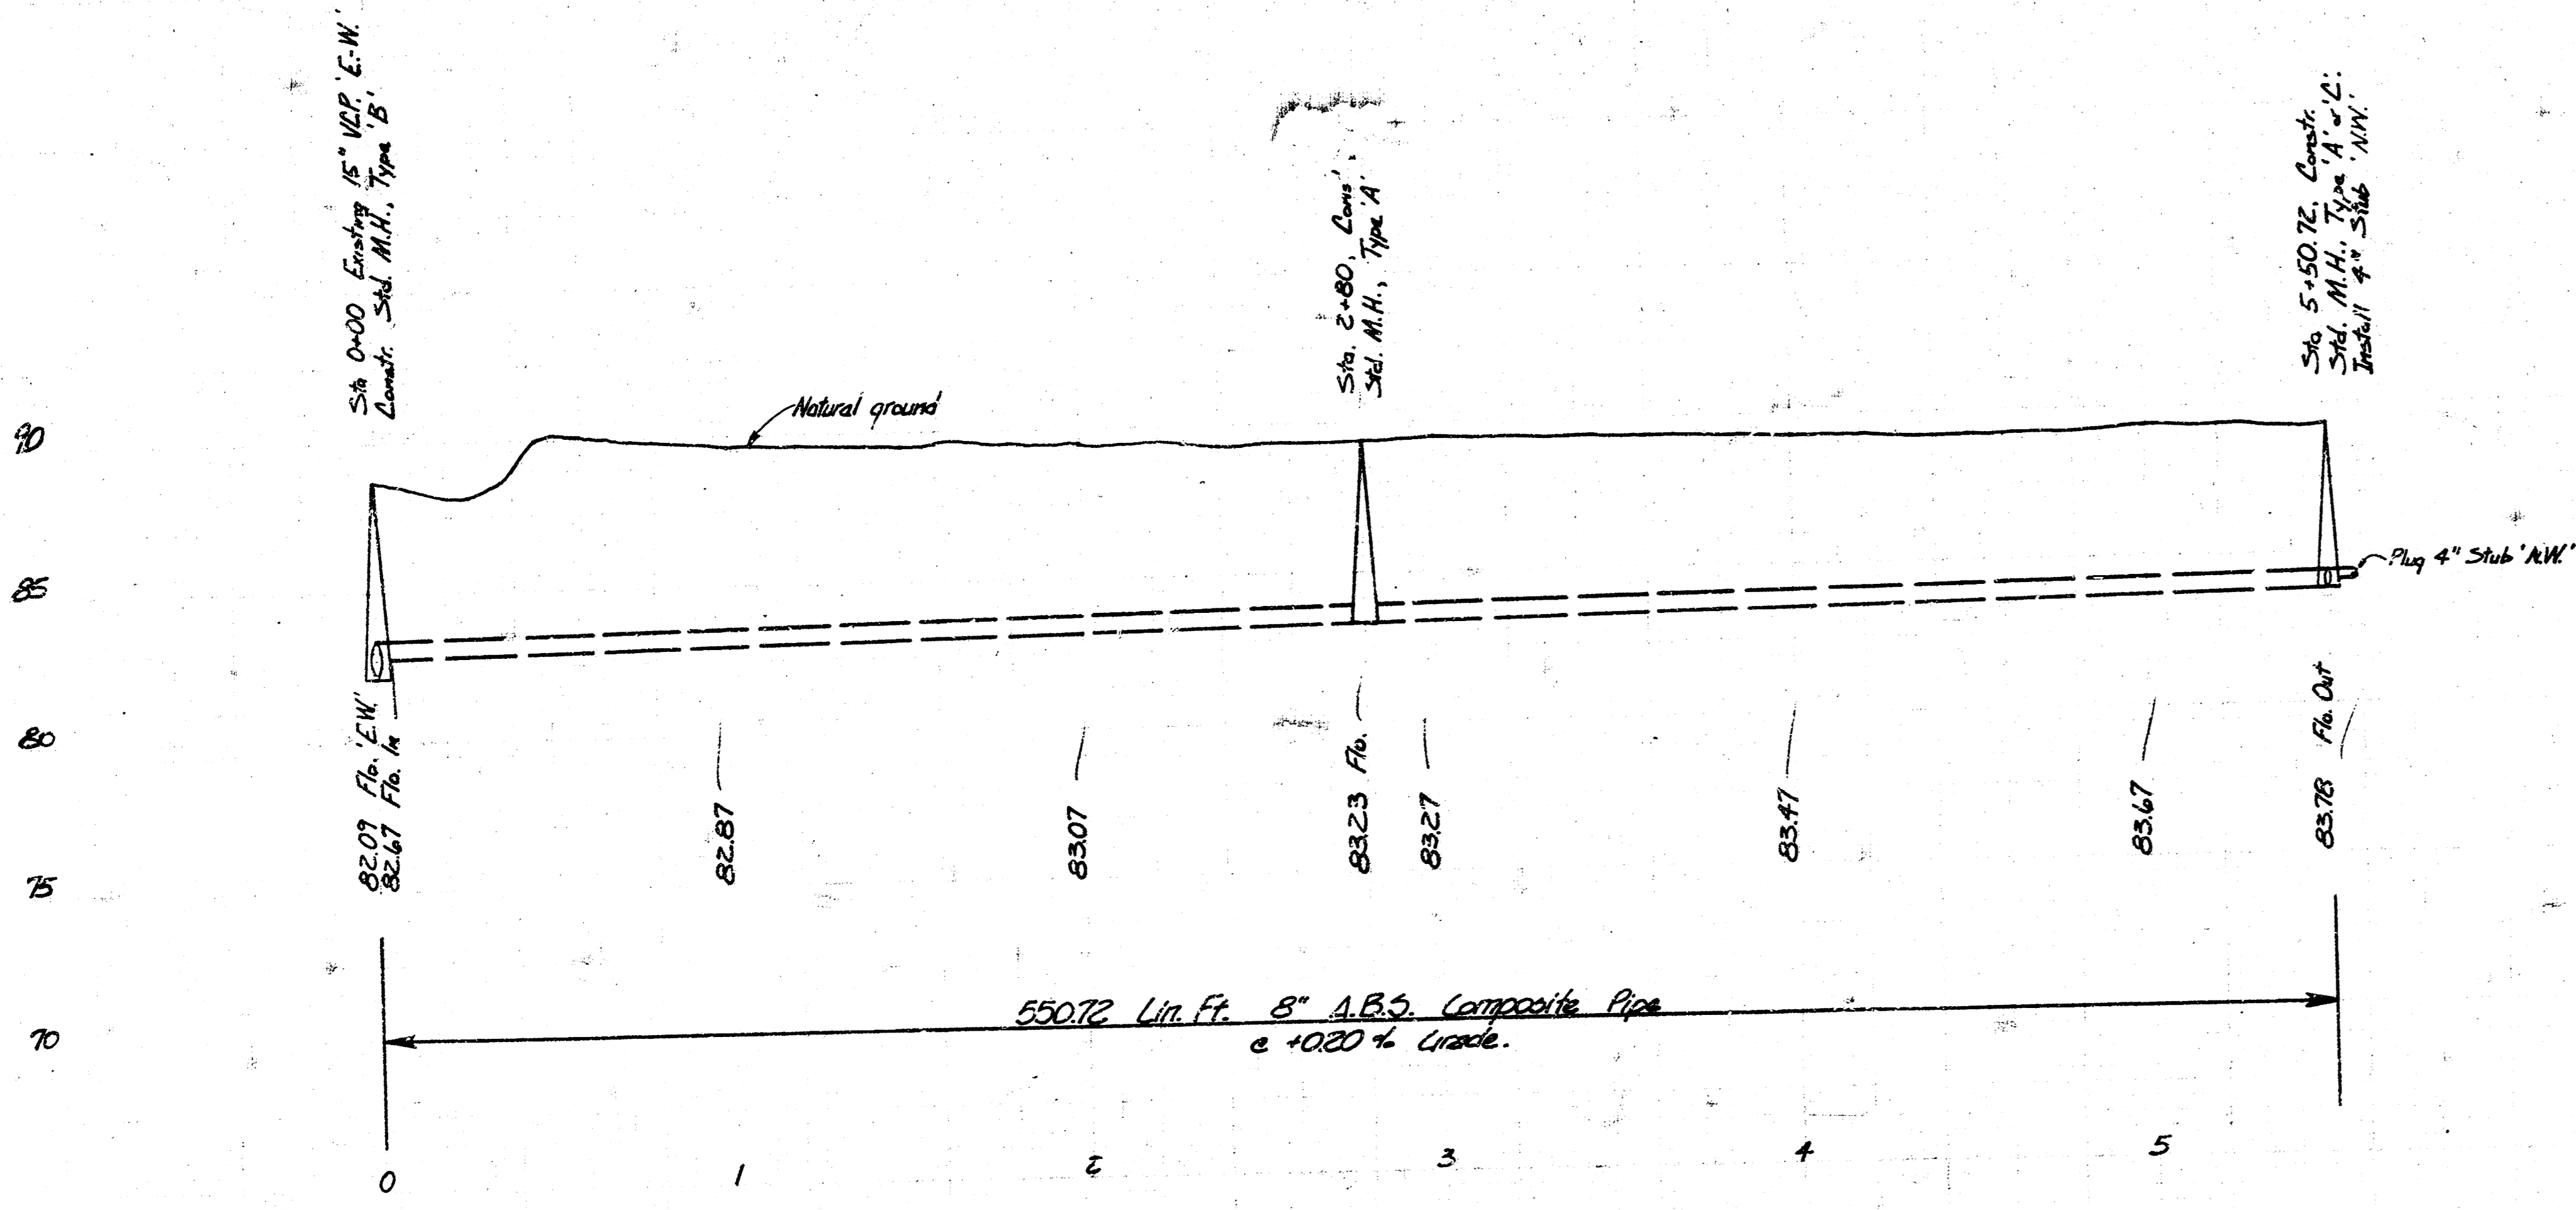

As Built 6-23-76

LAT. 10, MAIN 2, S.W.1.  
 CITY OF WICHITA, KANSAS  
 R. W. LINN CITY ENGINEER  
 PROJECT NO. DBKL 575027  
 MARCH 1976