


LAT 17, MAIN 2, SOUTHWEST INTERCEPTOR

CITY OF WICHITA, KANSAS

R. W. BRUGGEMAN - DIRECTOR OF ENGINEERING / CITY ENGINEER



PROJECT NO. 468-76-245-80619-000-000-001

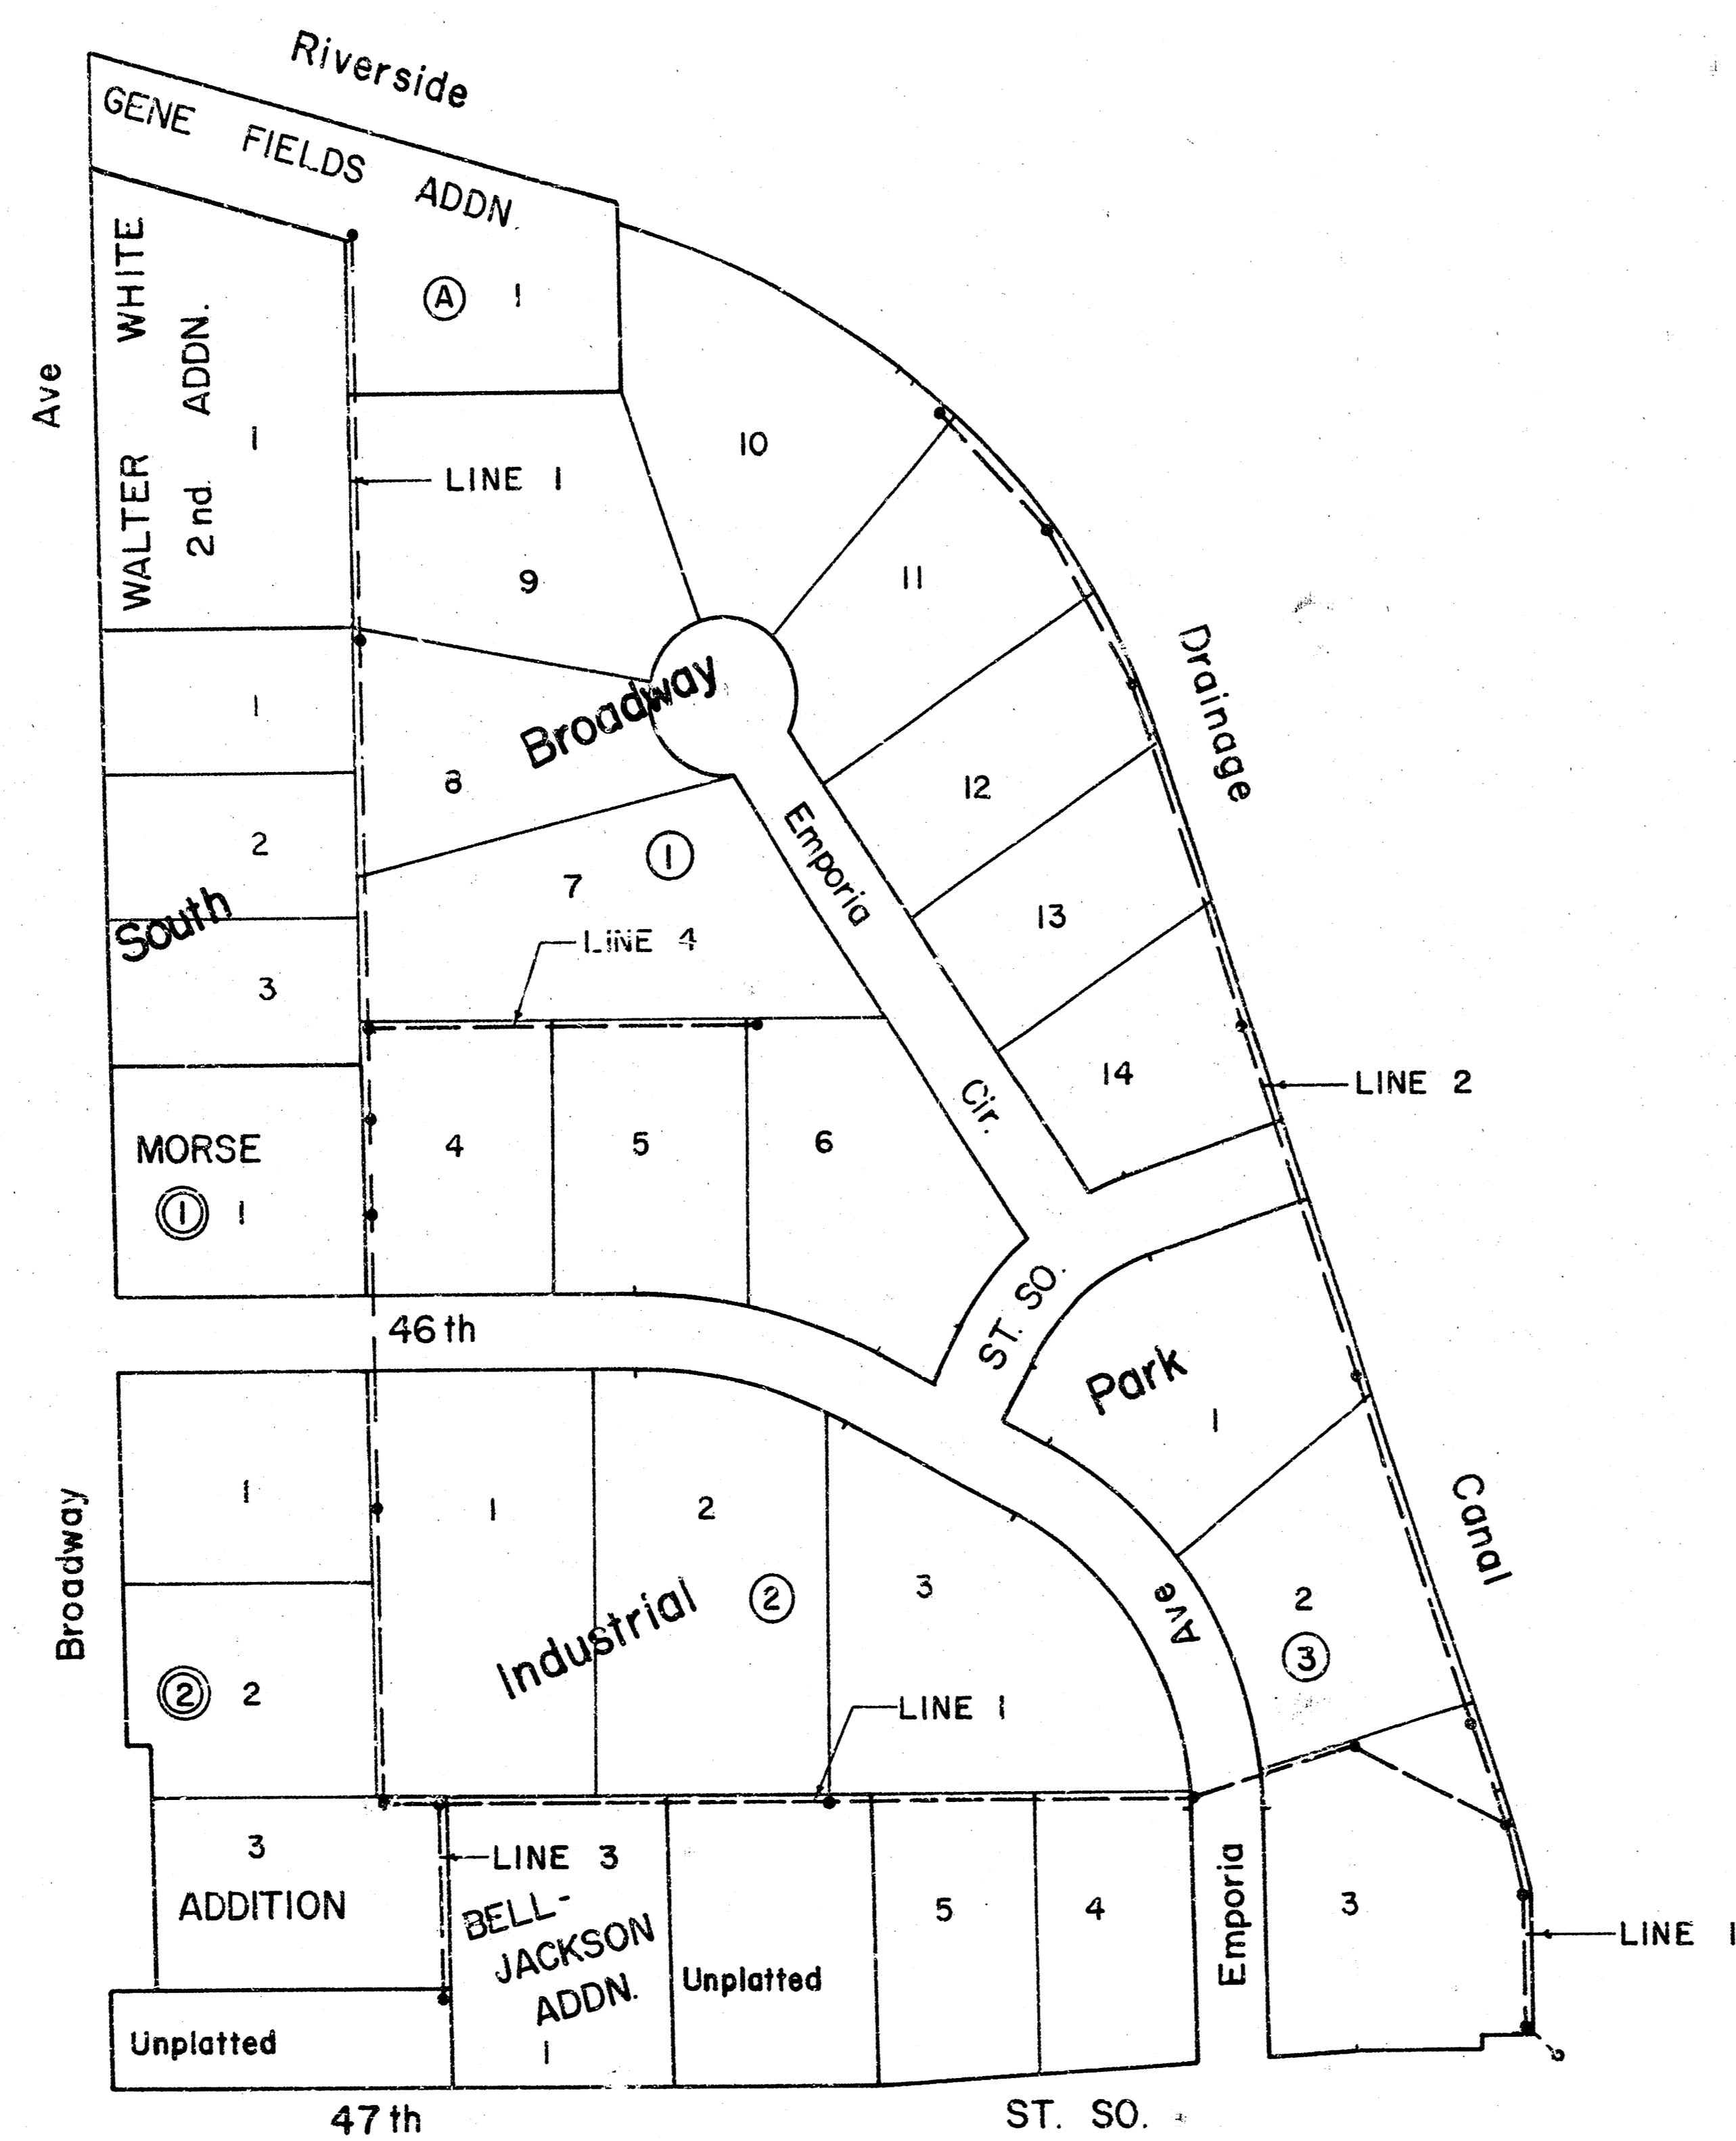

As Built
1/4/82
JBB





Scale Plan 1" = 40'
 Profile 1" = 40' Horiz
 1" = 5' Vert.

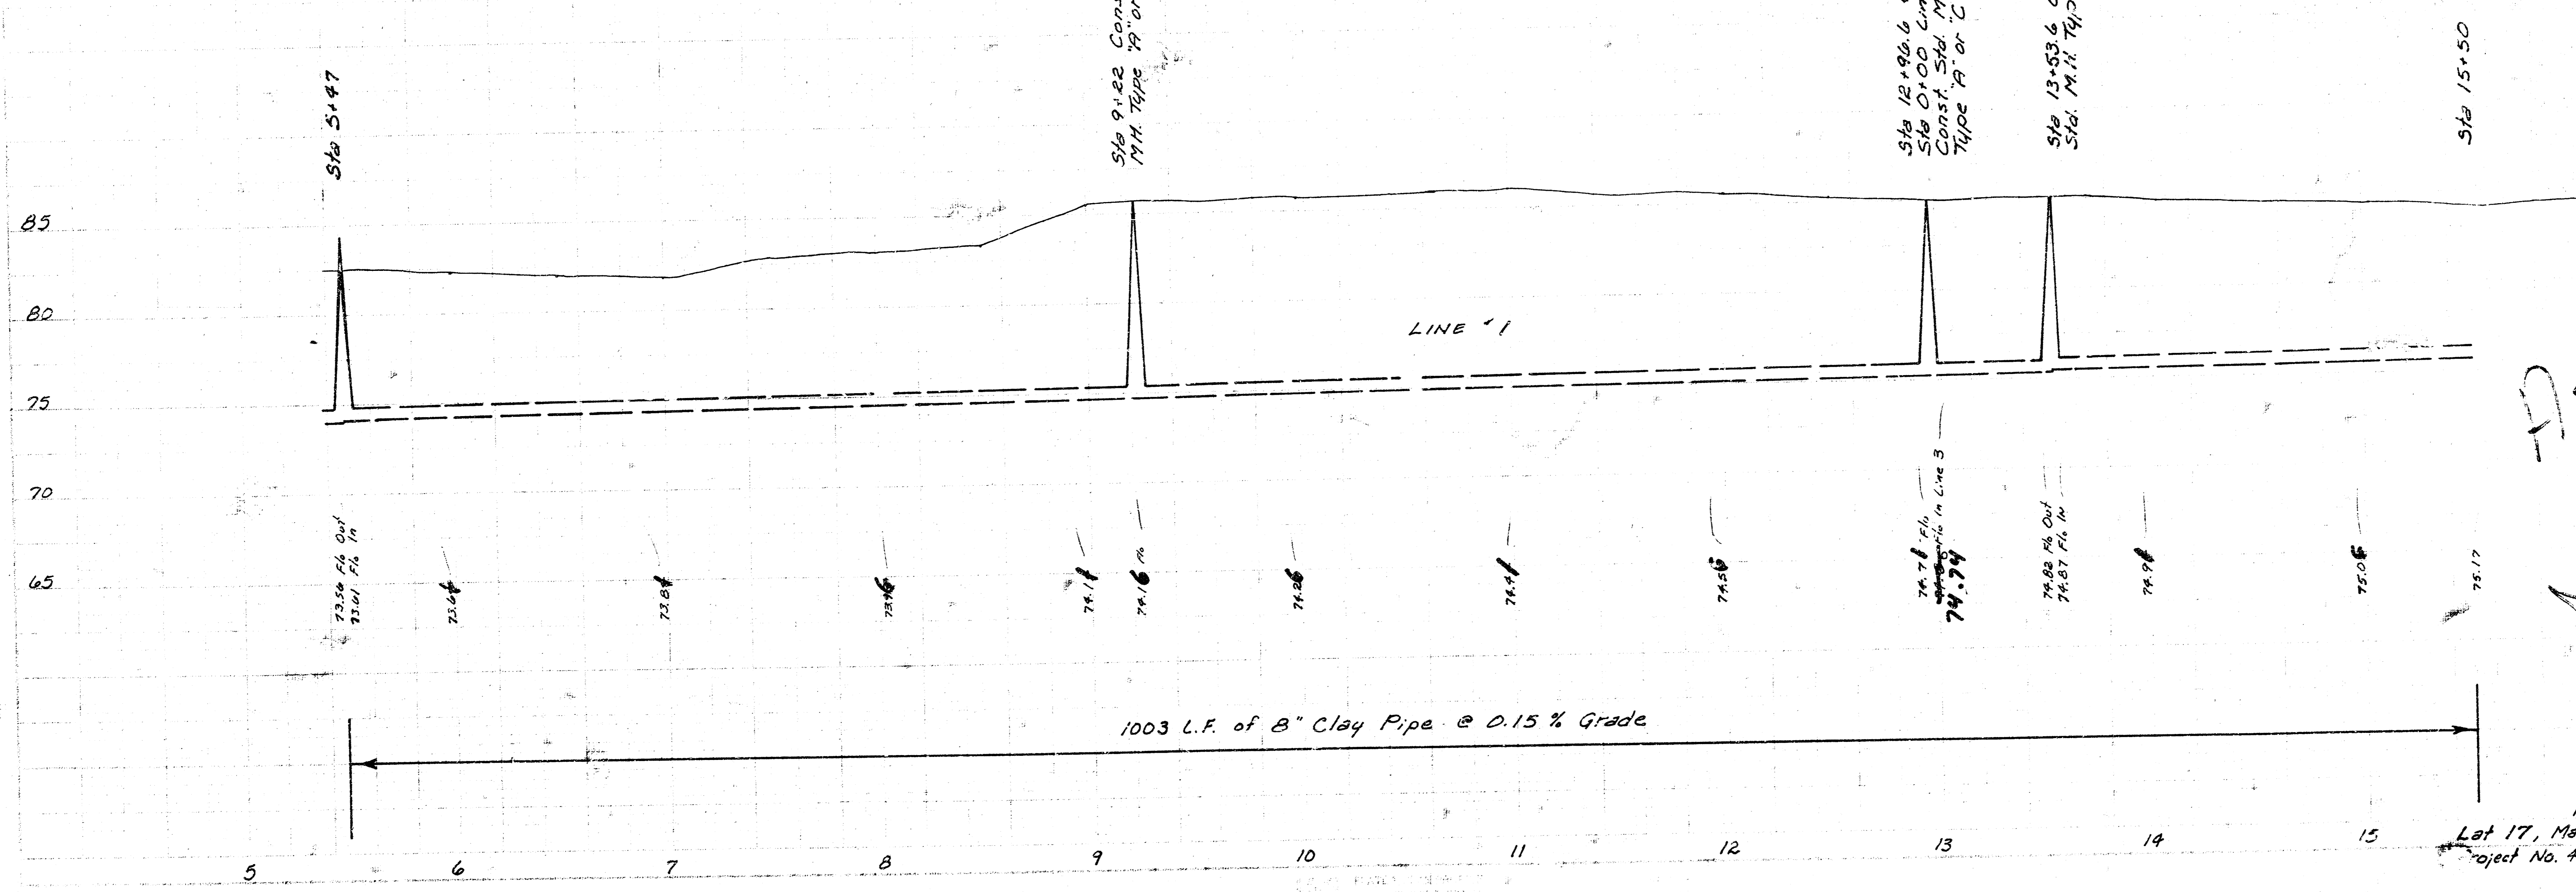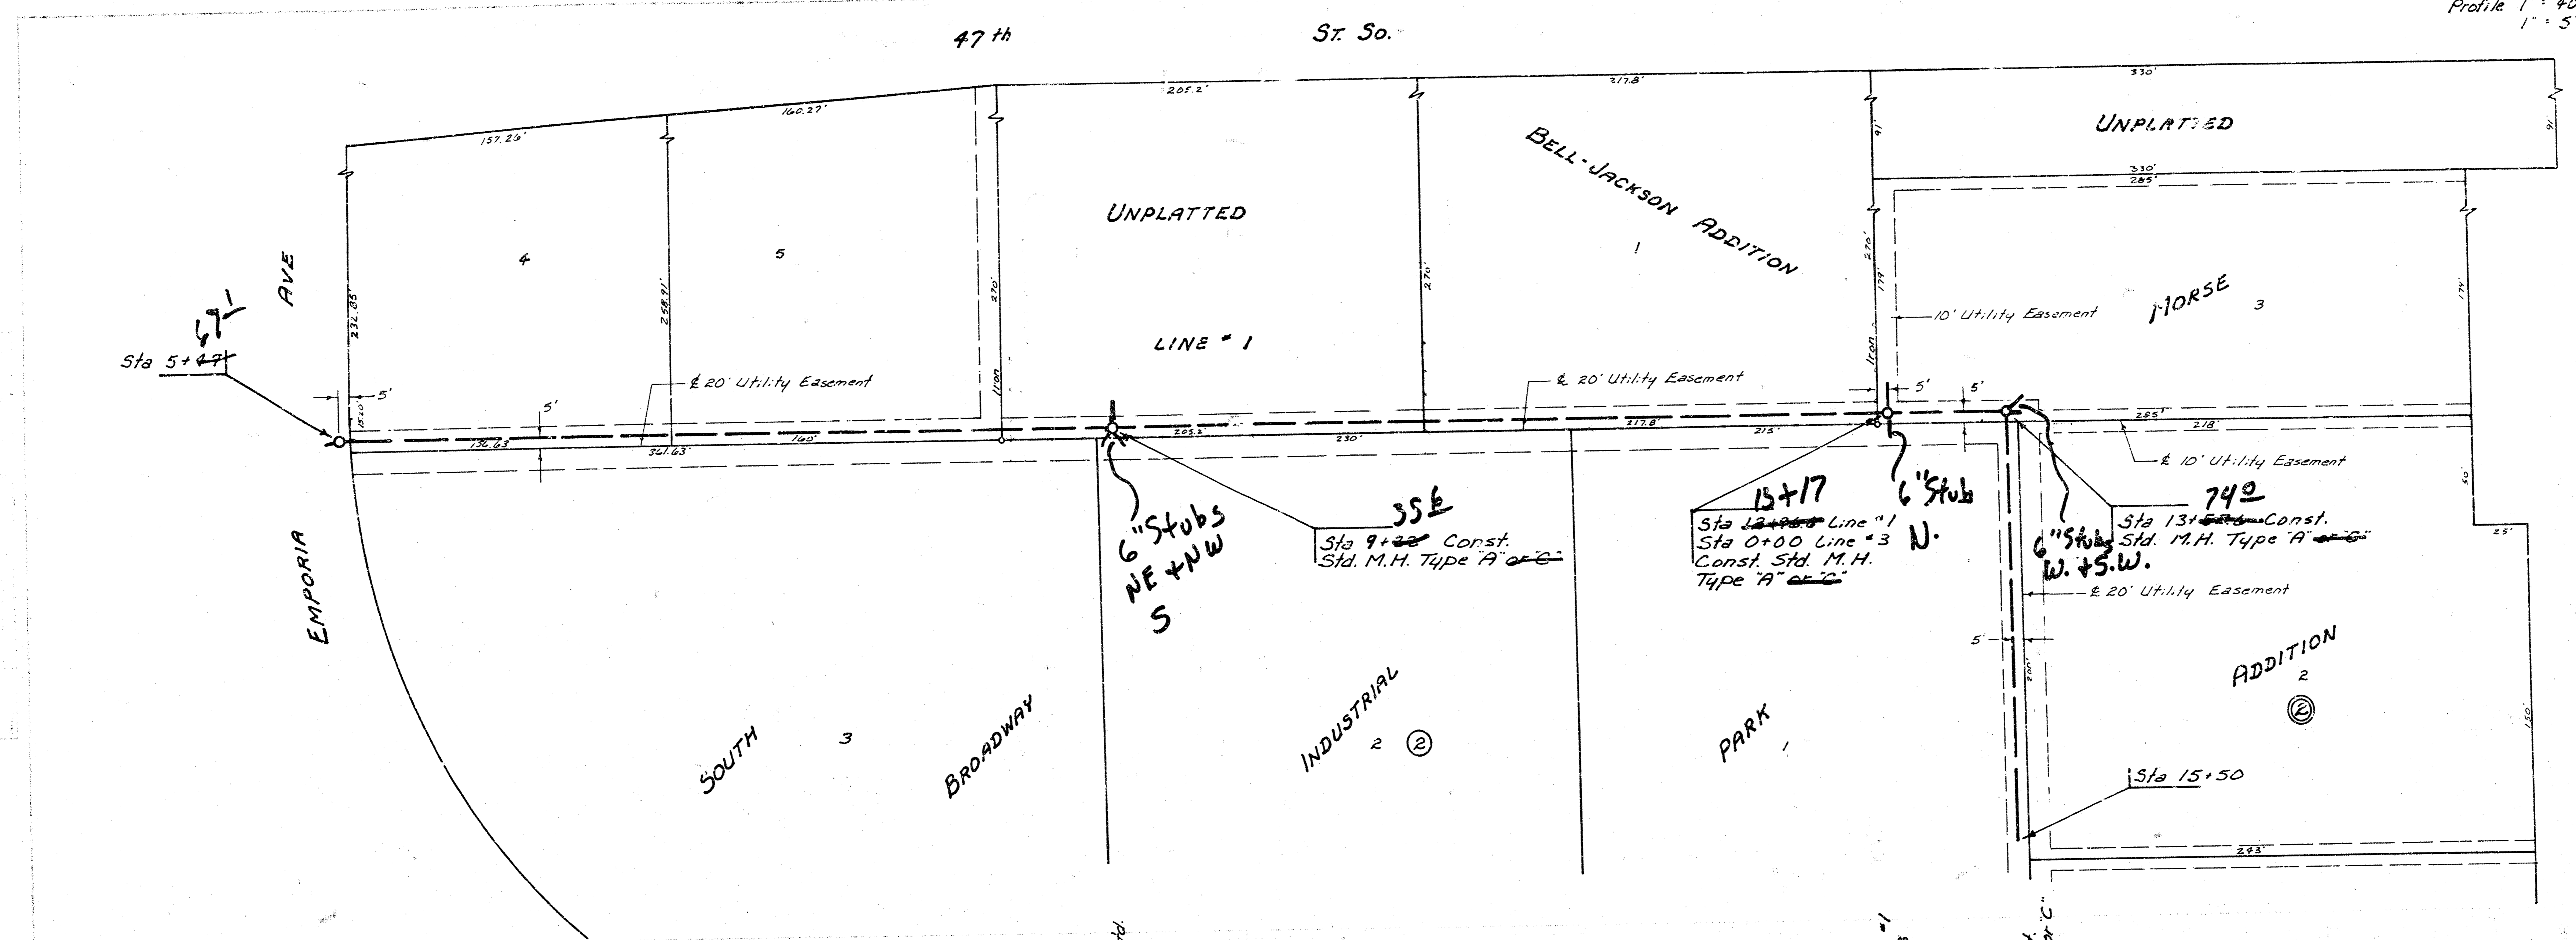


As Built
 1/4/82
 JLL

3/8

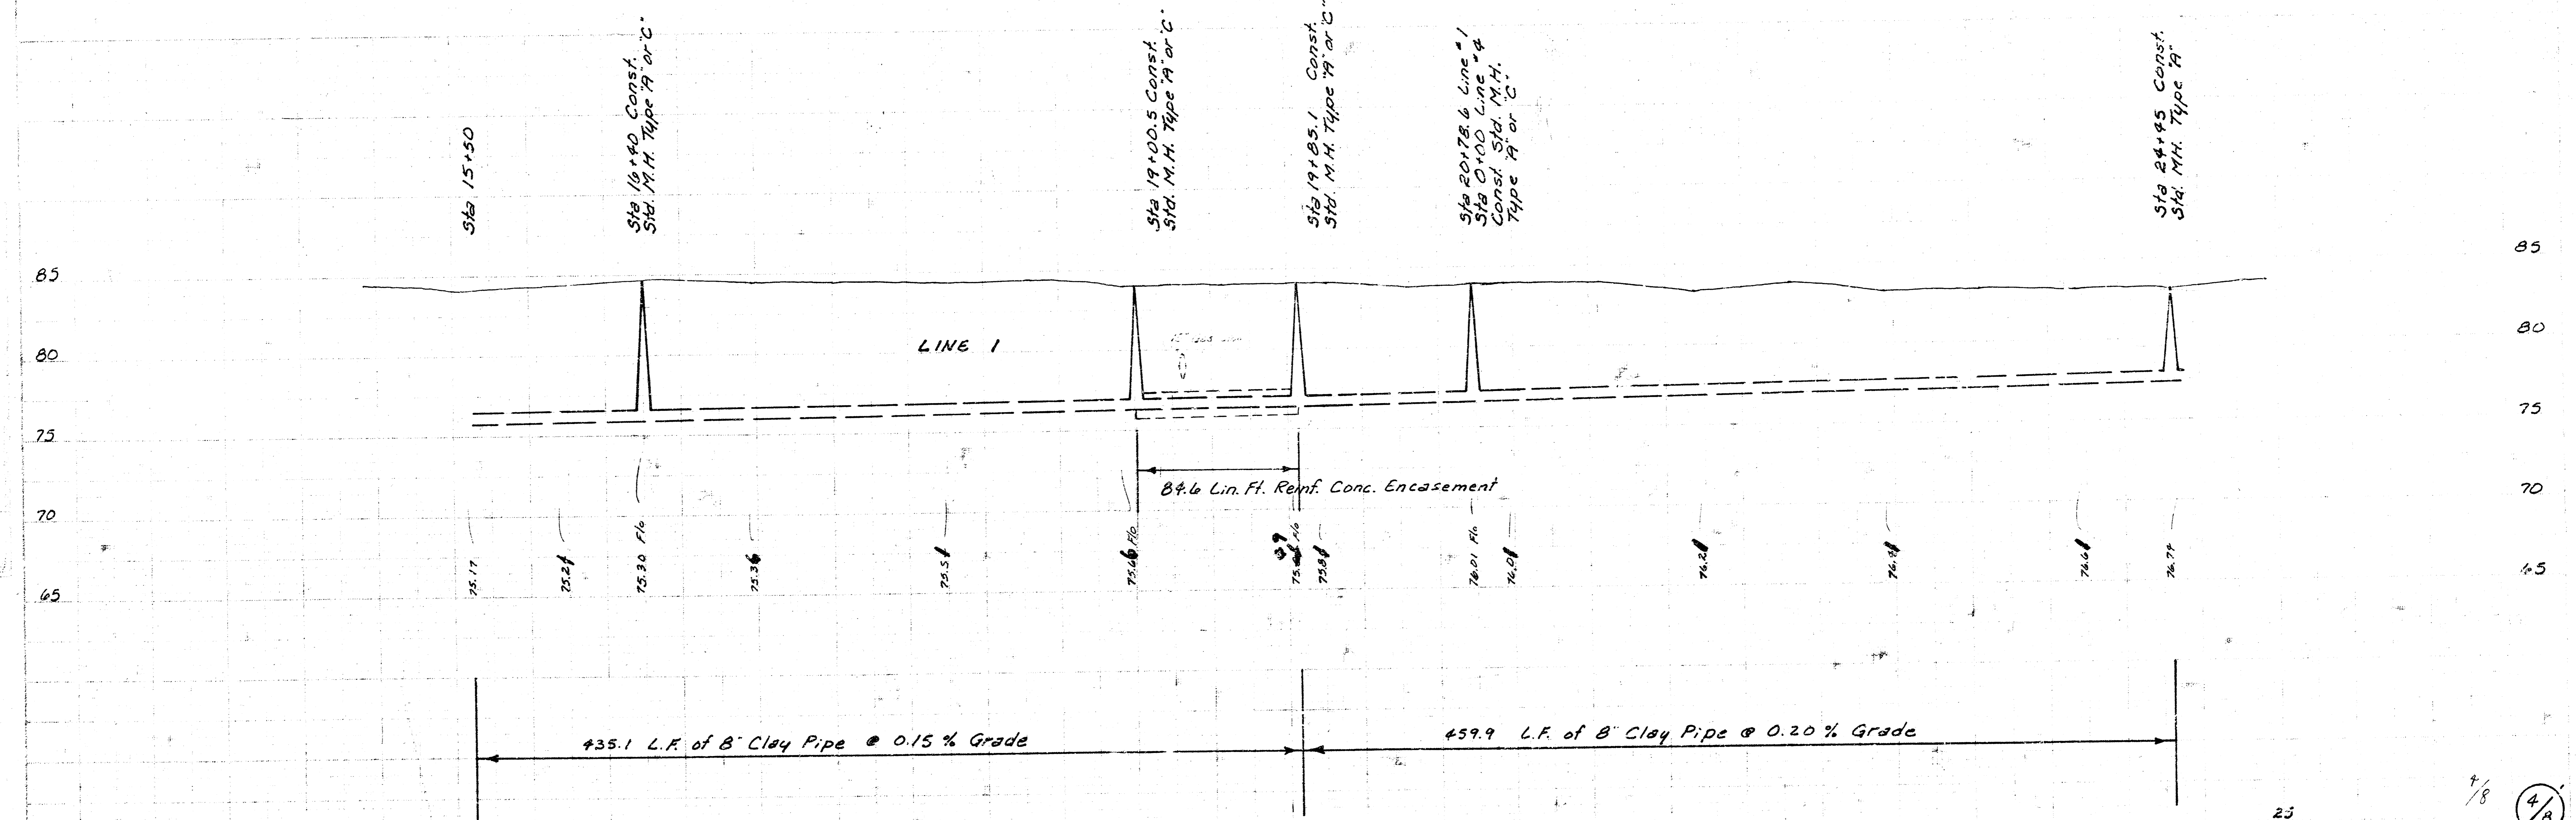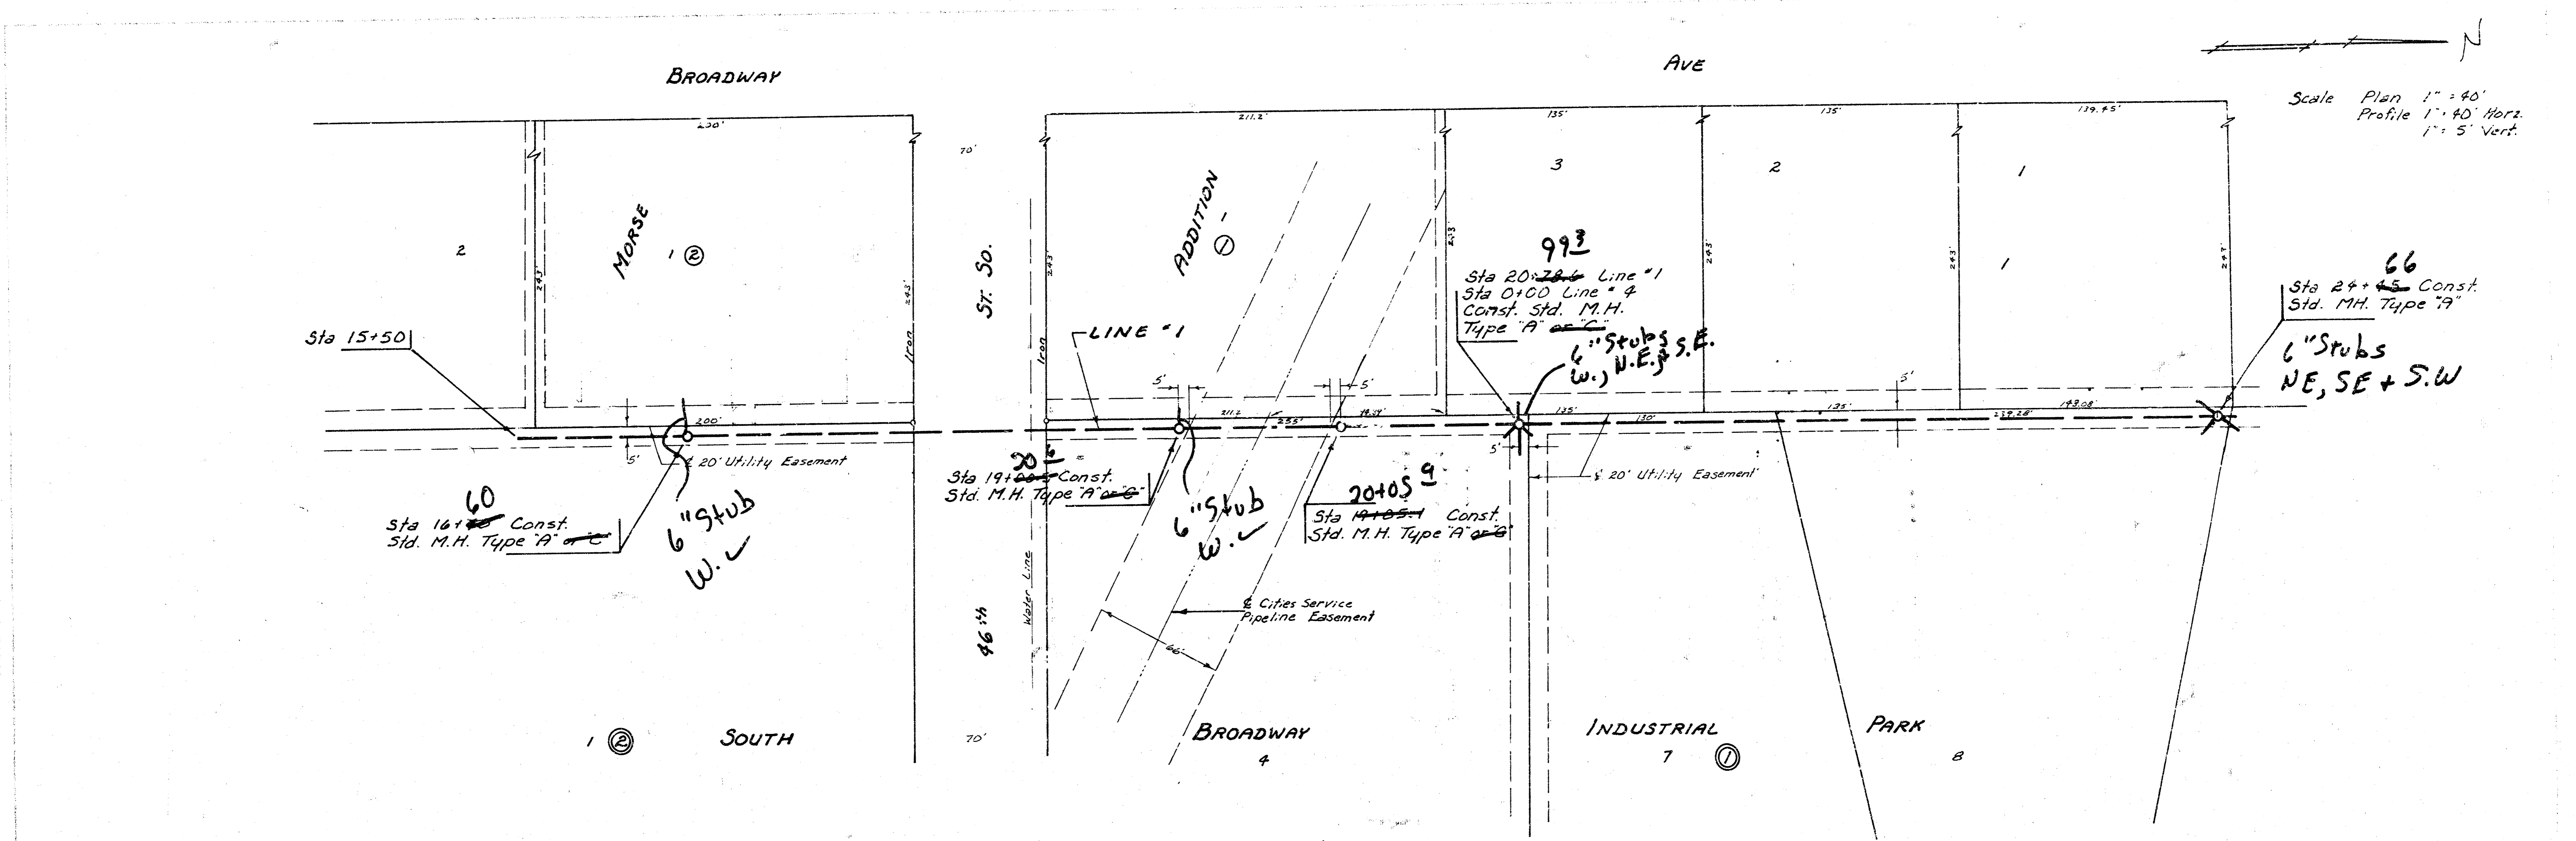


BROADWAY AVE

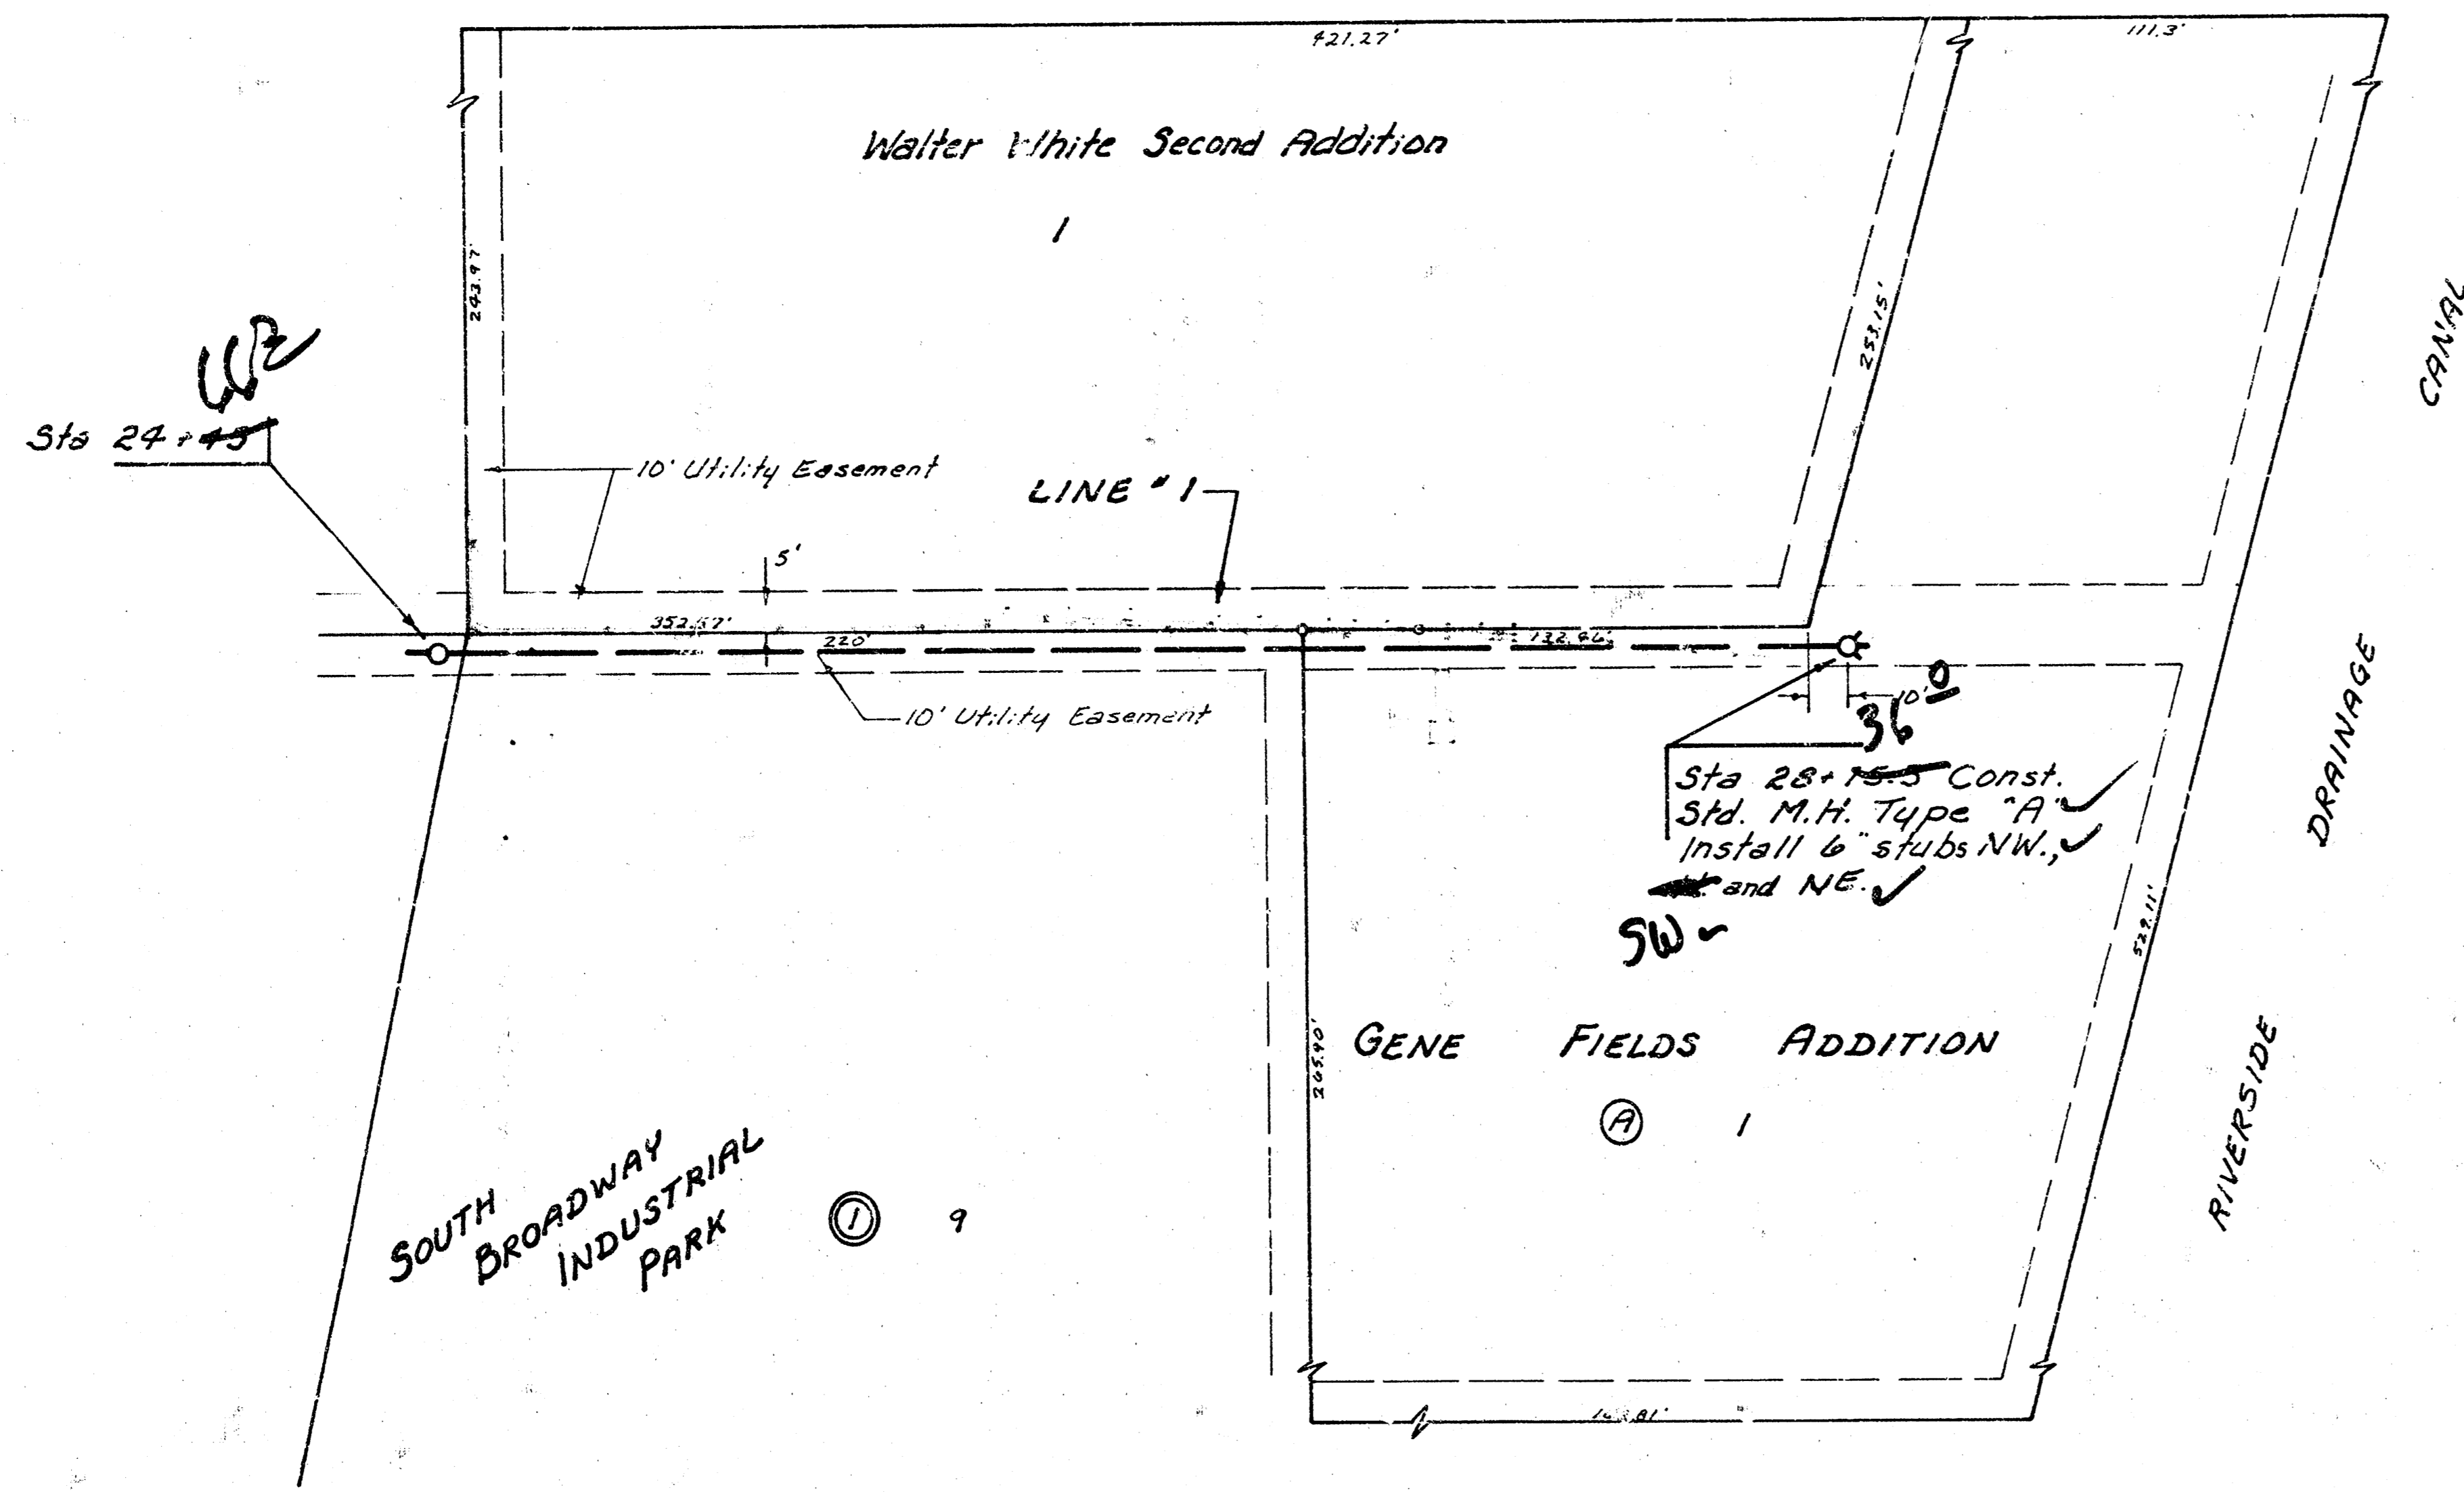


Scale Plan 1" = 40' Horiz.
 Profile 1" = 40' Vert.
 1" = 5' Vert.

PLAN


PROFILE

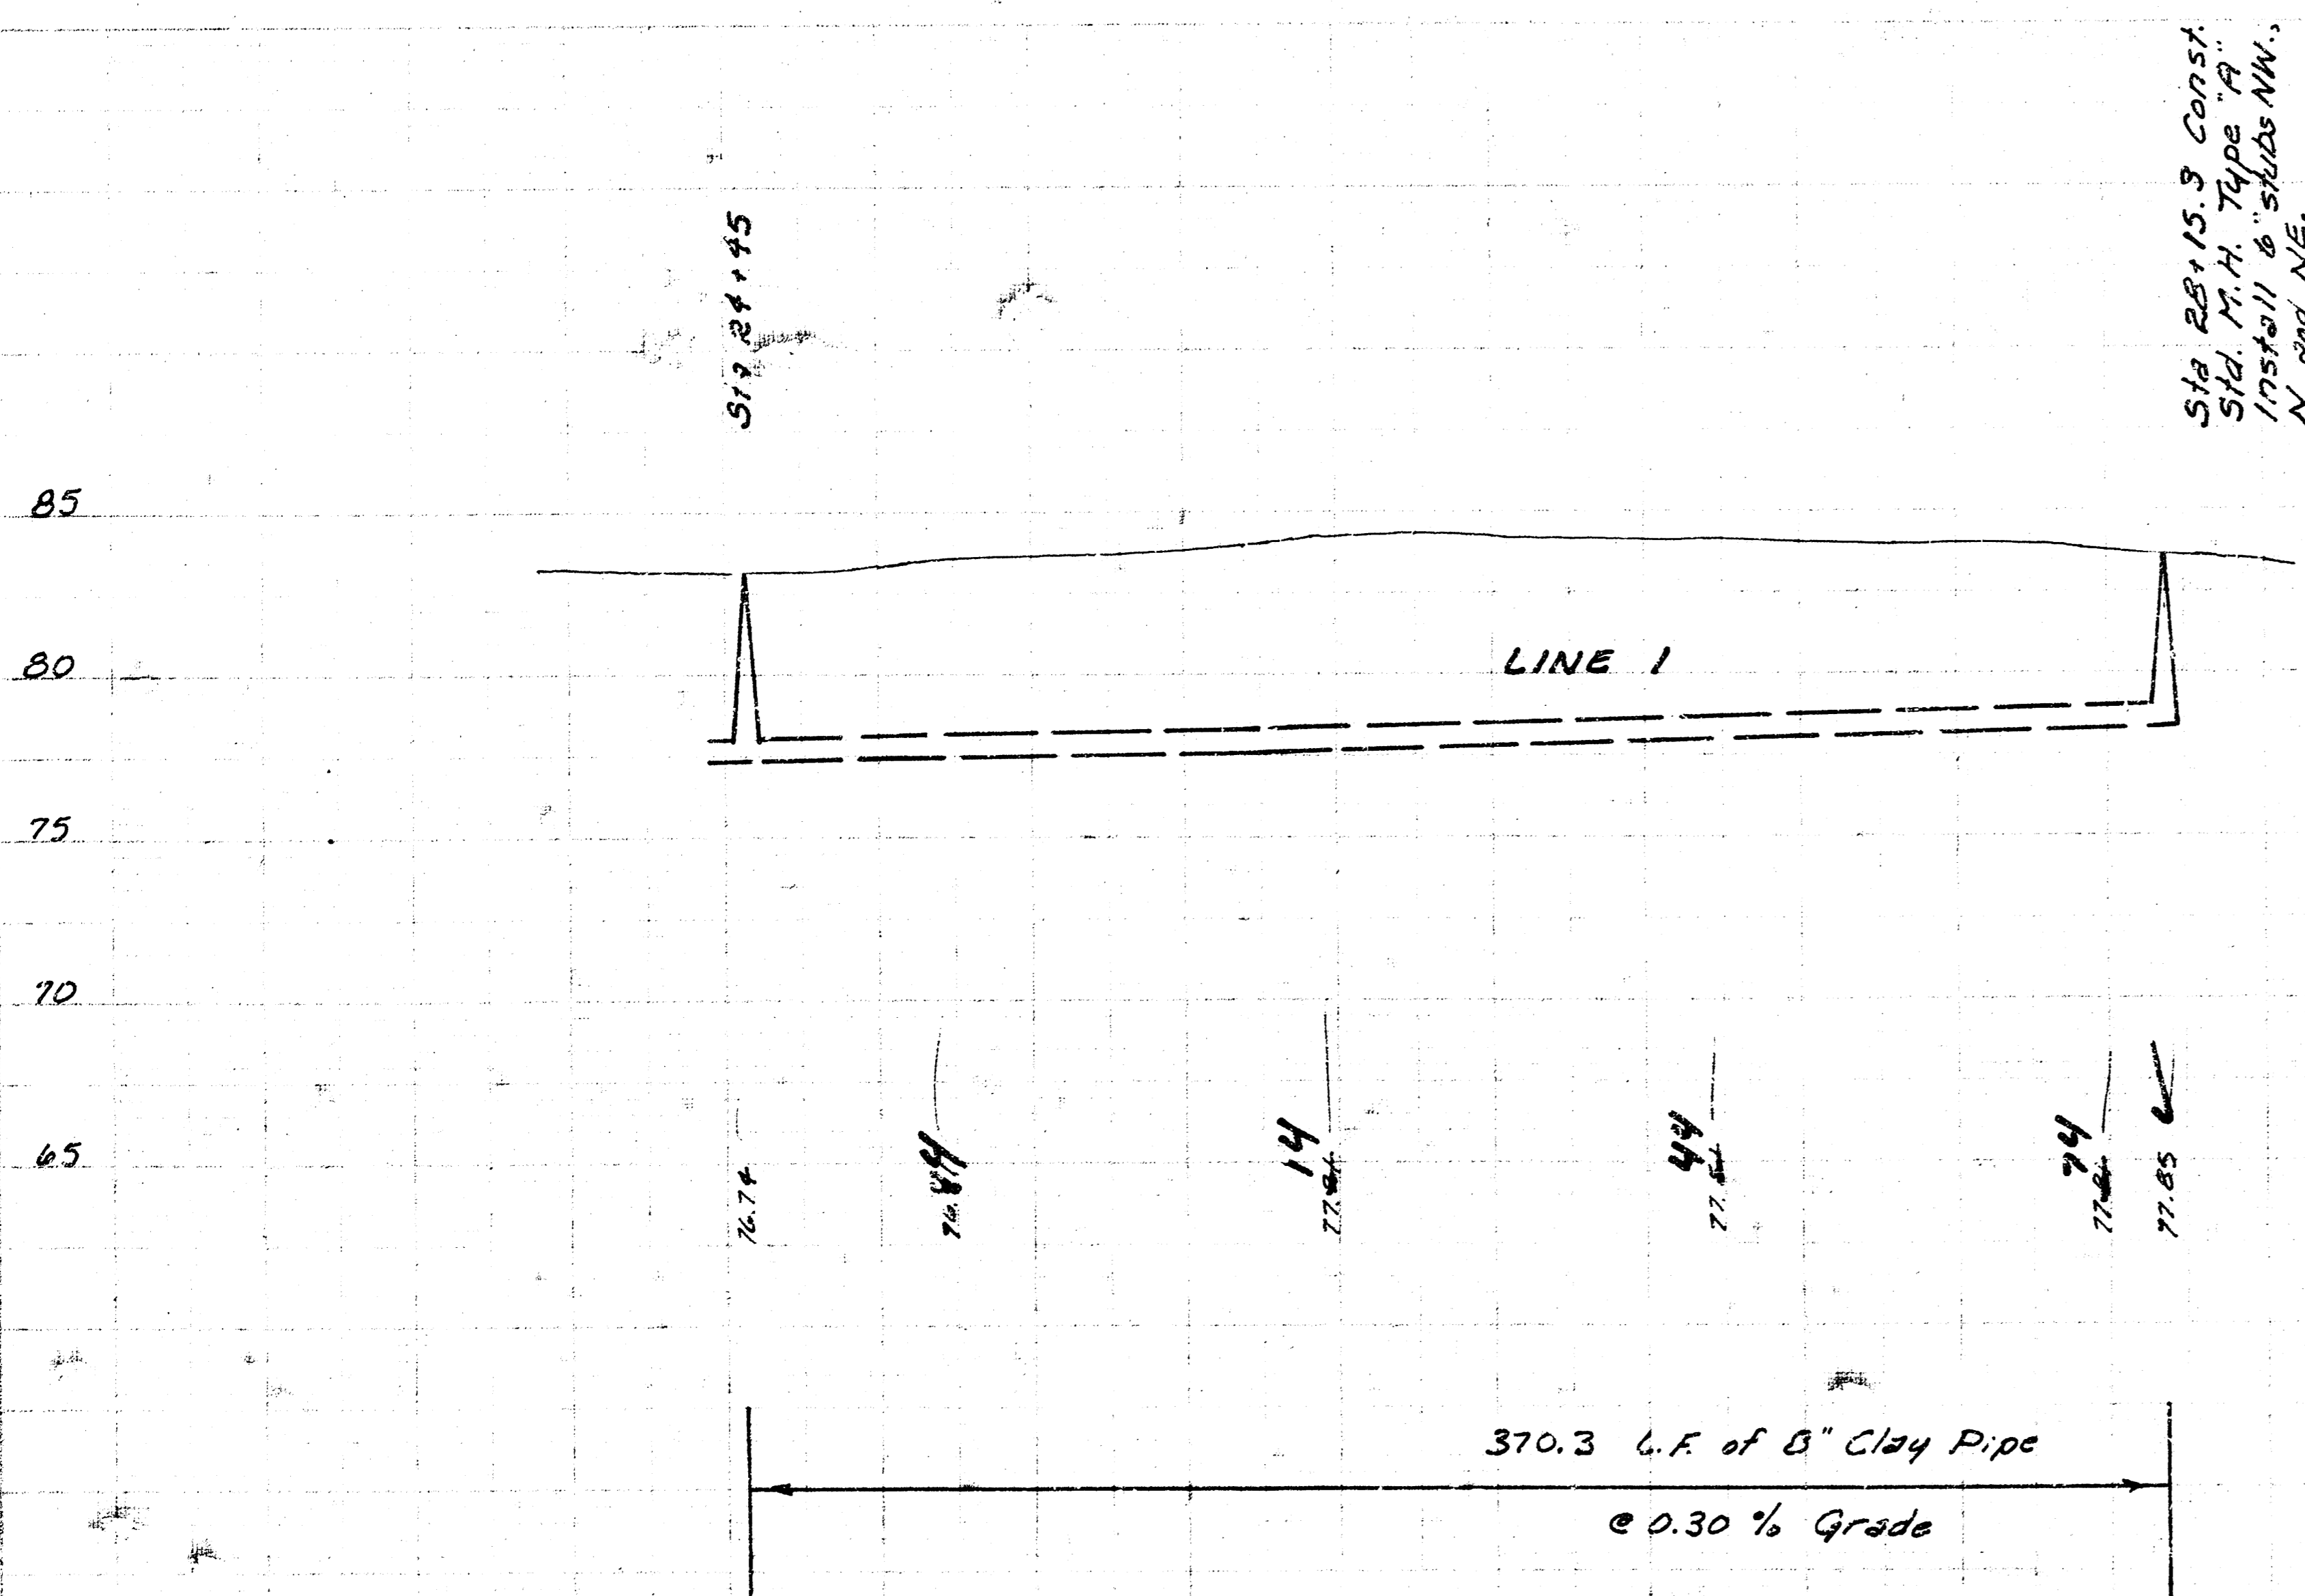

As Built
 JSS
 1/4/82


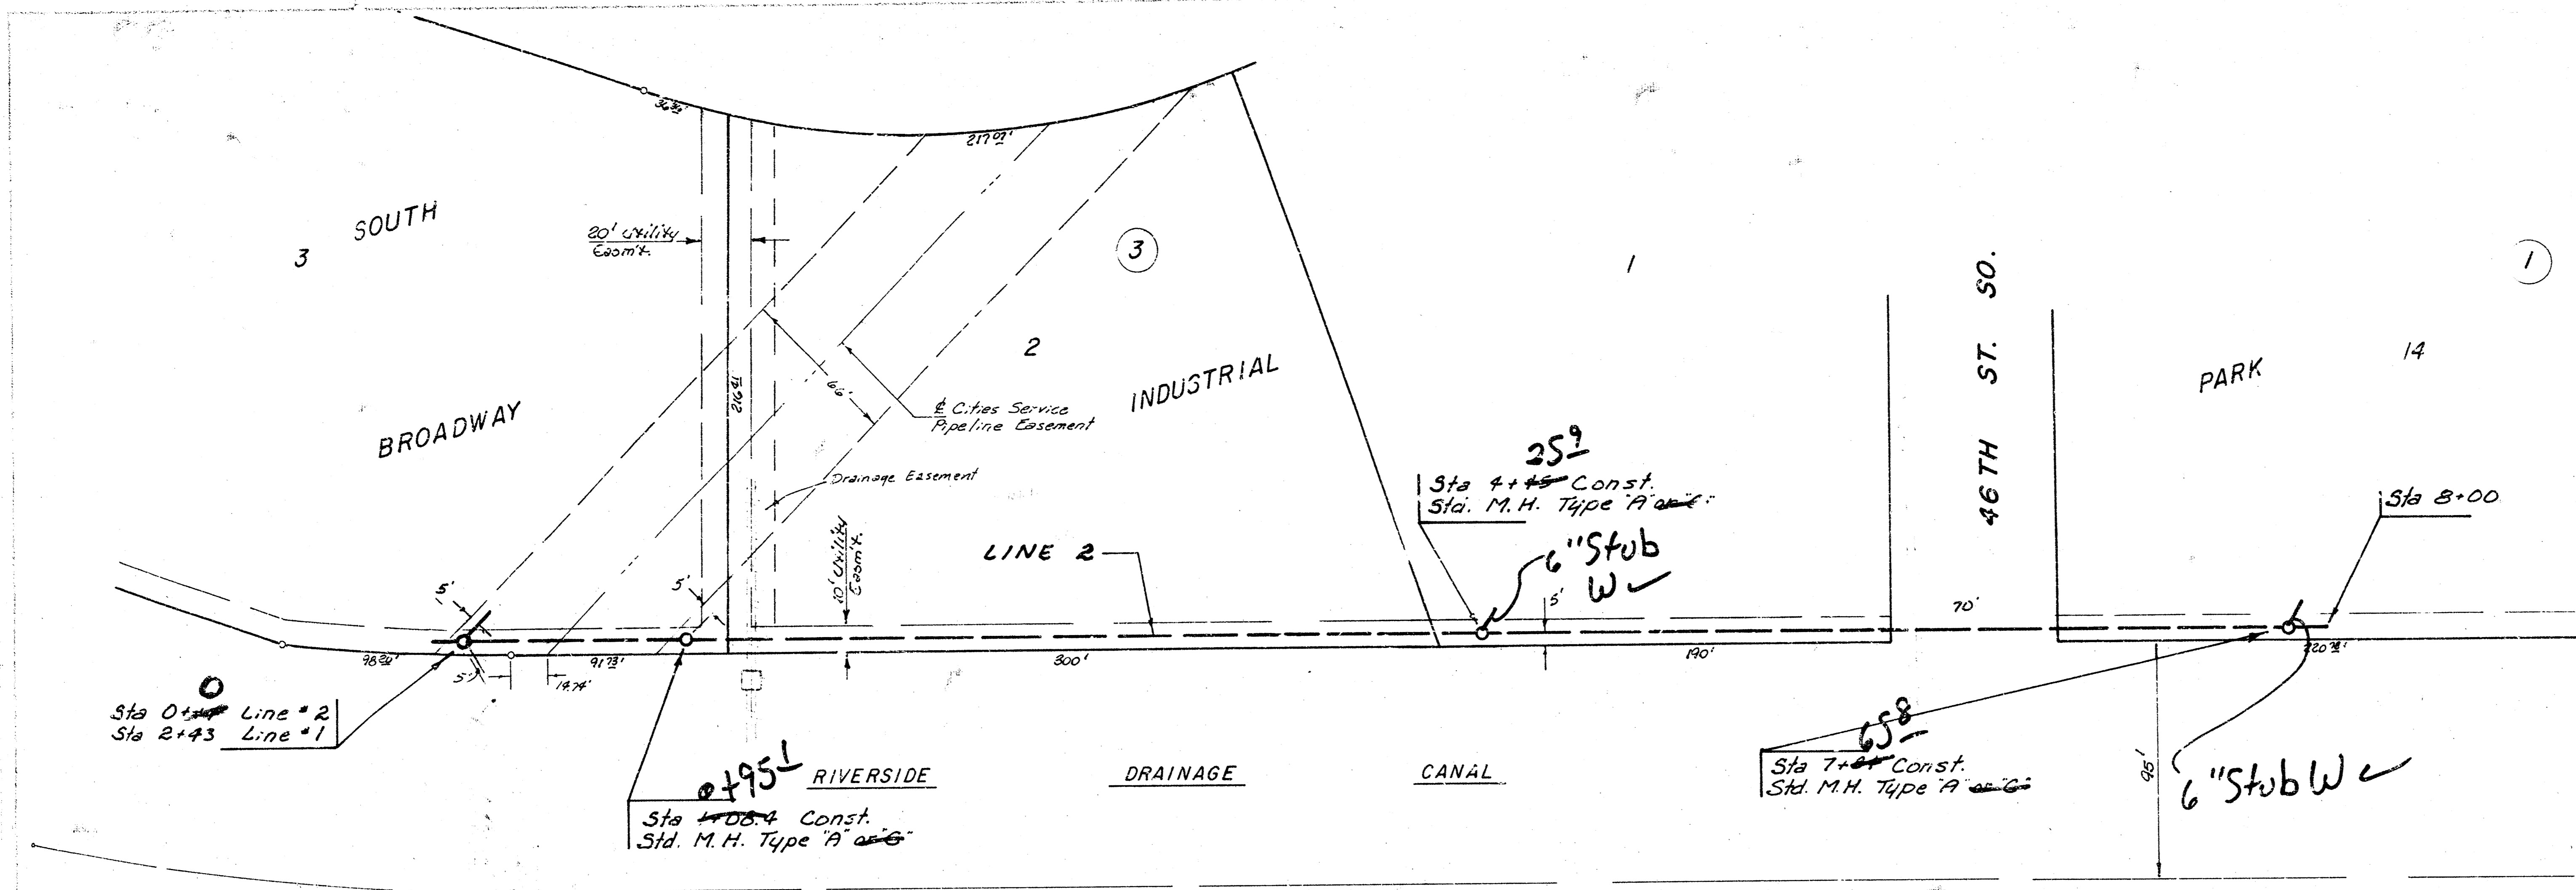


Scale Plan 1" = 40'
 Profile 1" = 40' Horiz.
 1" = 5' Vert.

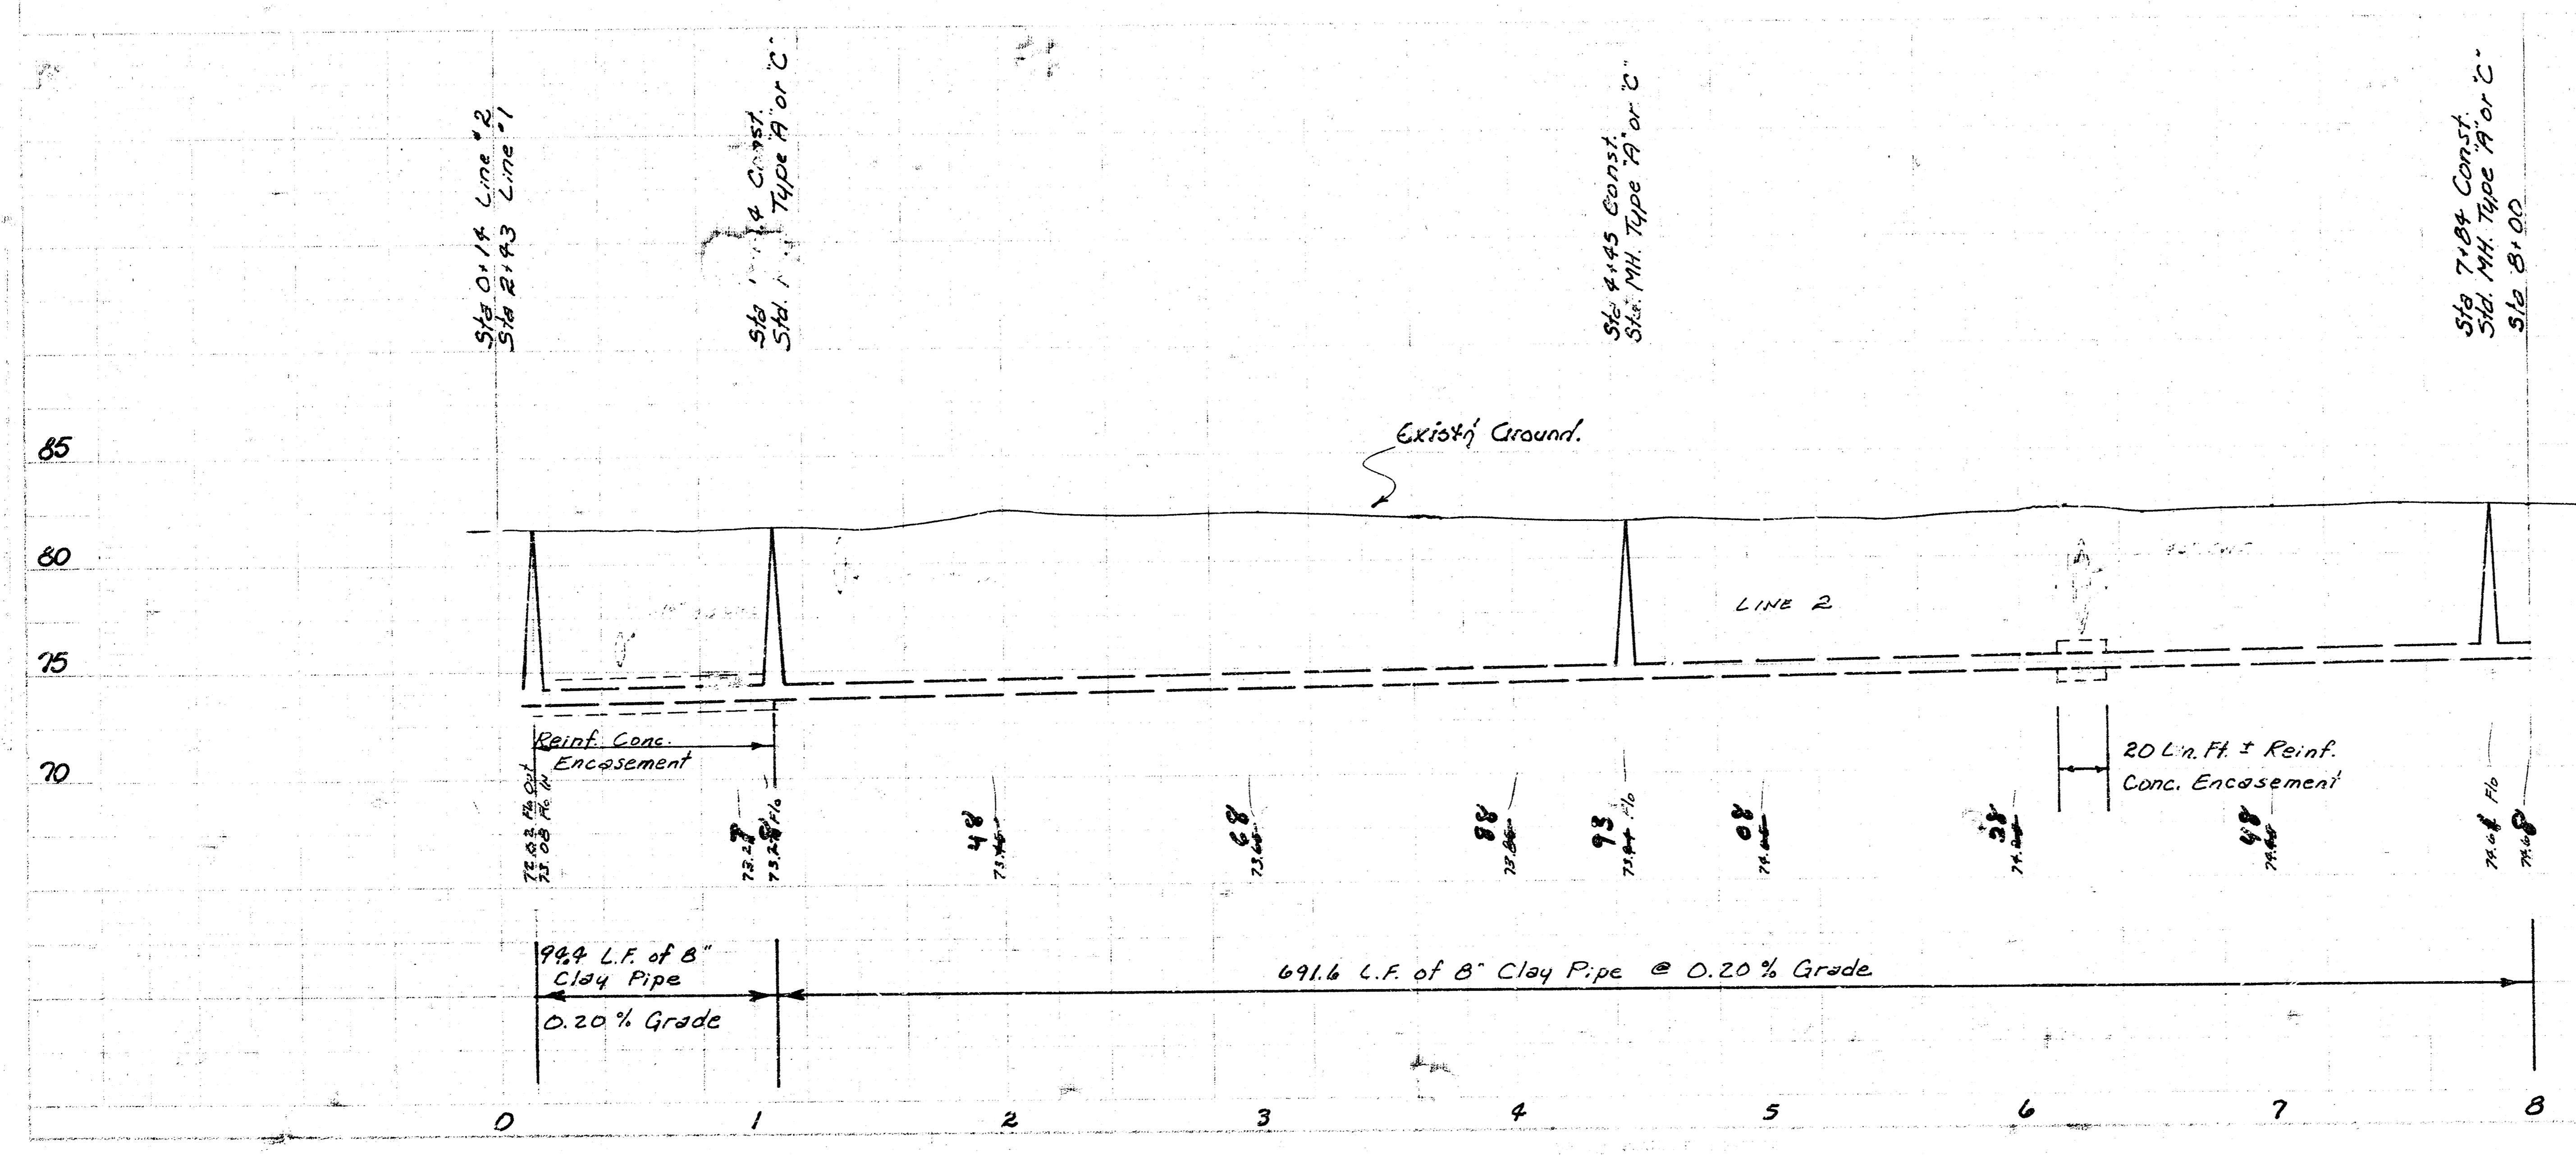


Revised 9-9-81
 Lat 17, Main 2, SW Interceptor
 Project No. 468-76-245-90619-000-000-001

6/8

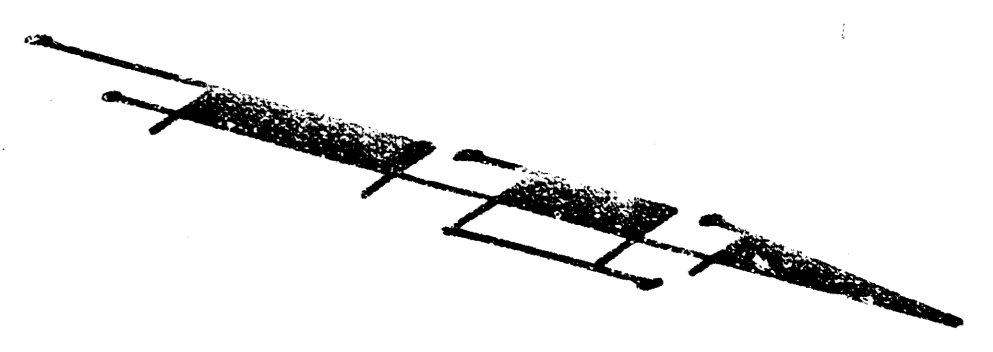
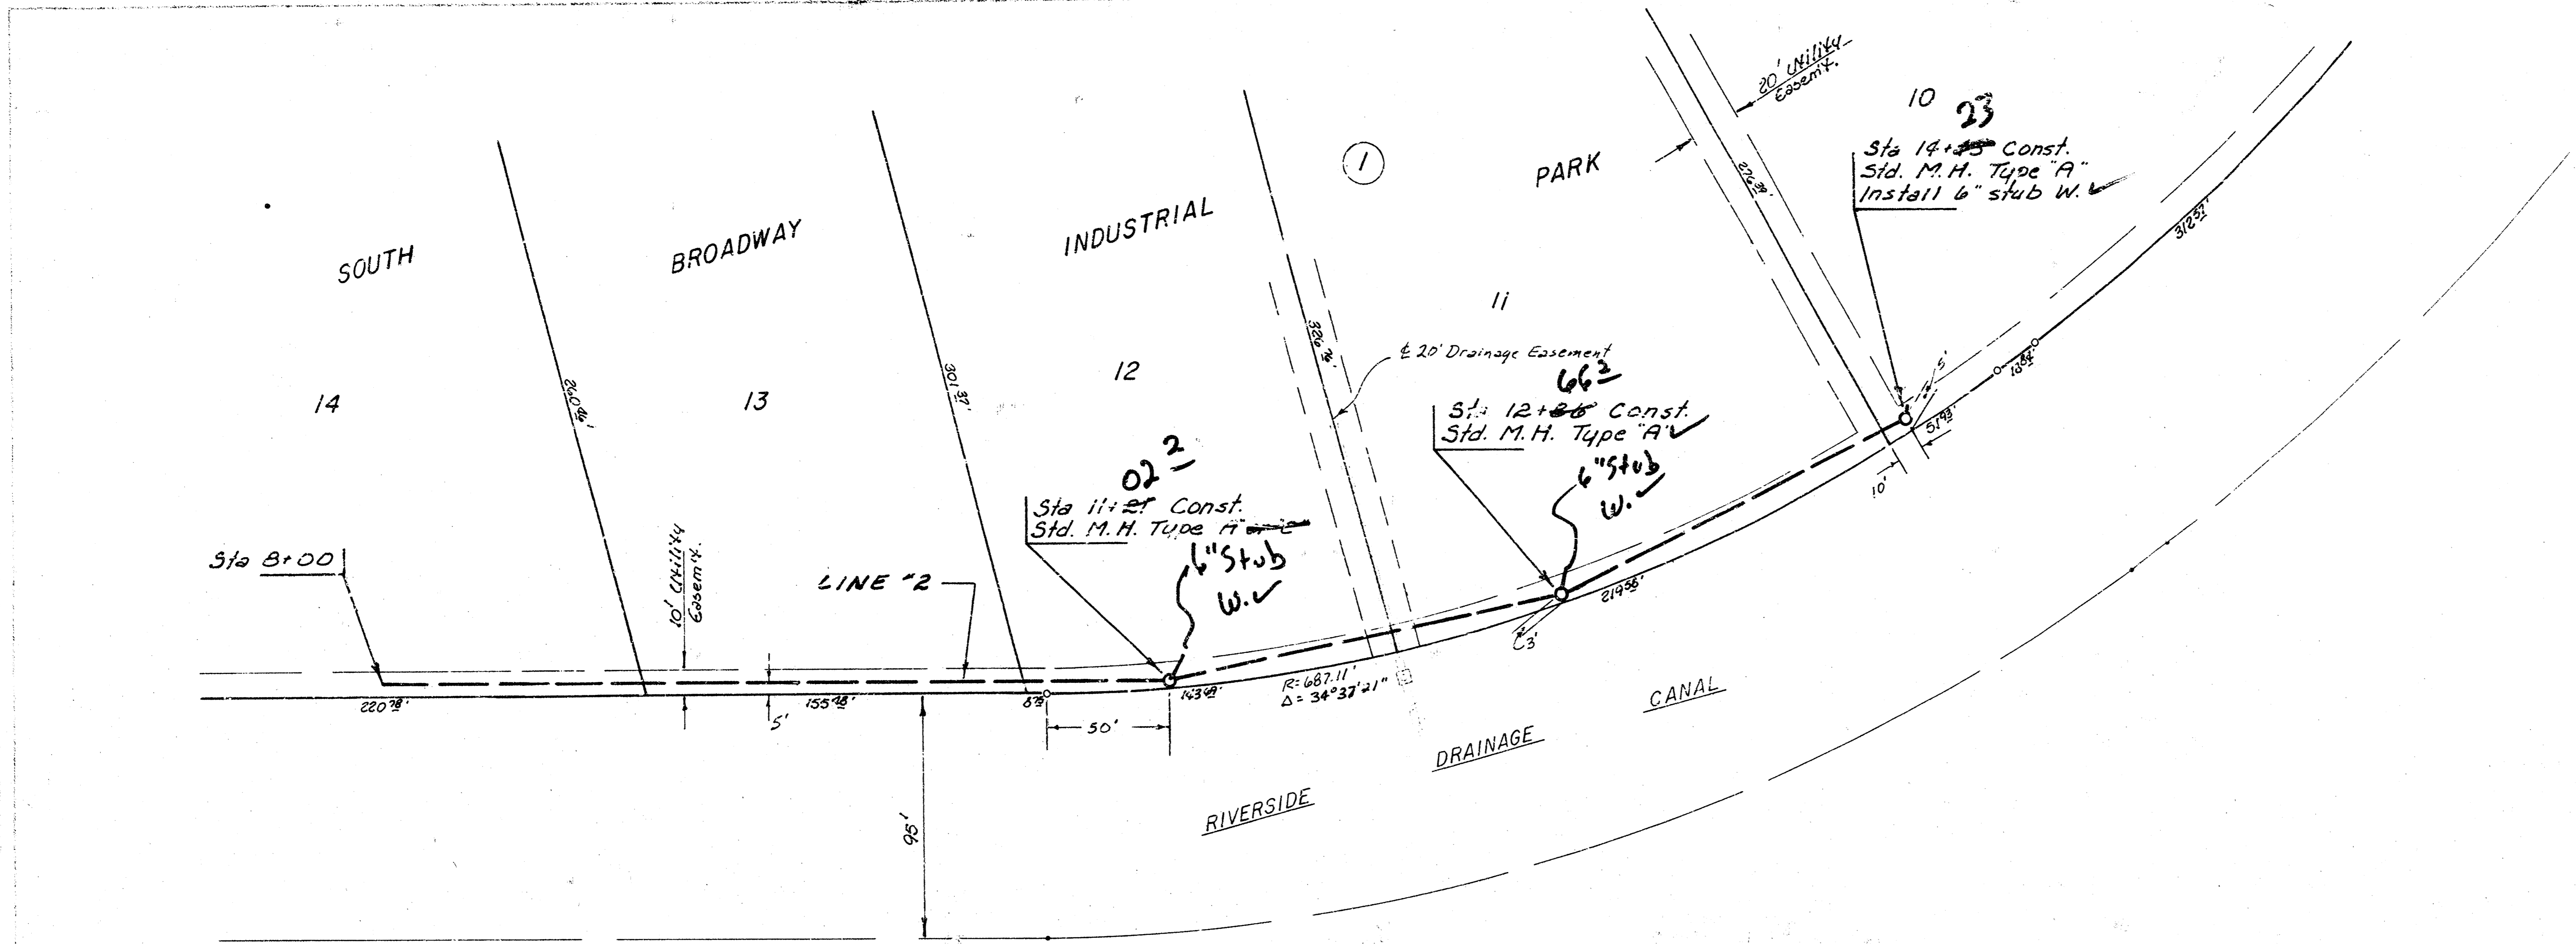


Scale Plan 1" = 40'
Profile 1" = 10' Horiz
1" = 5' Vert.

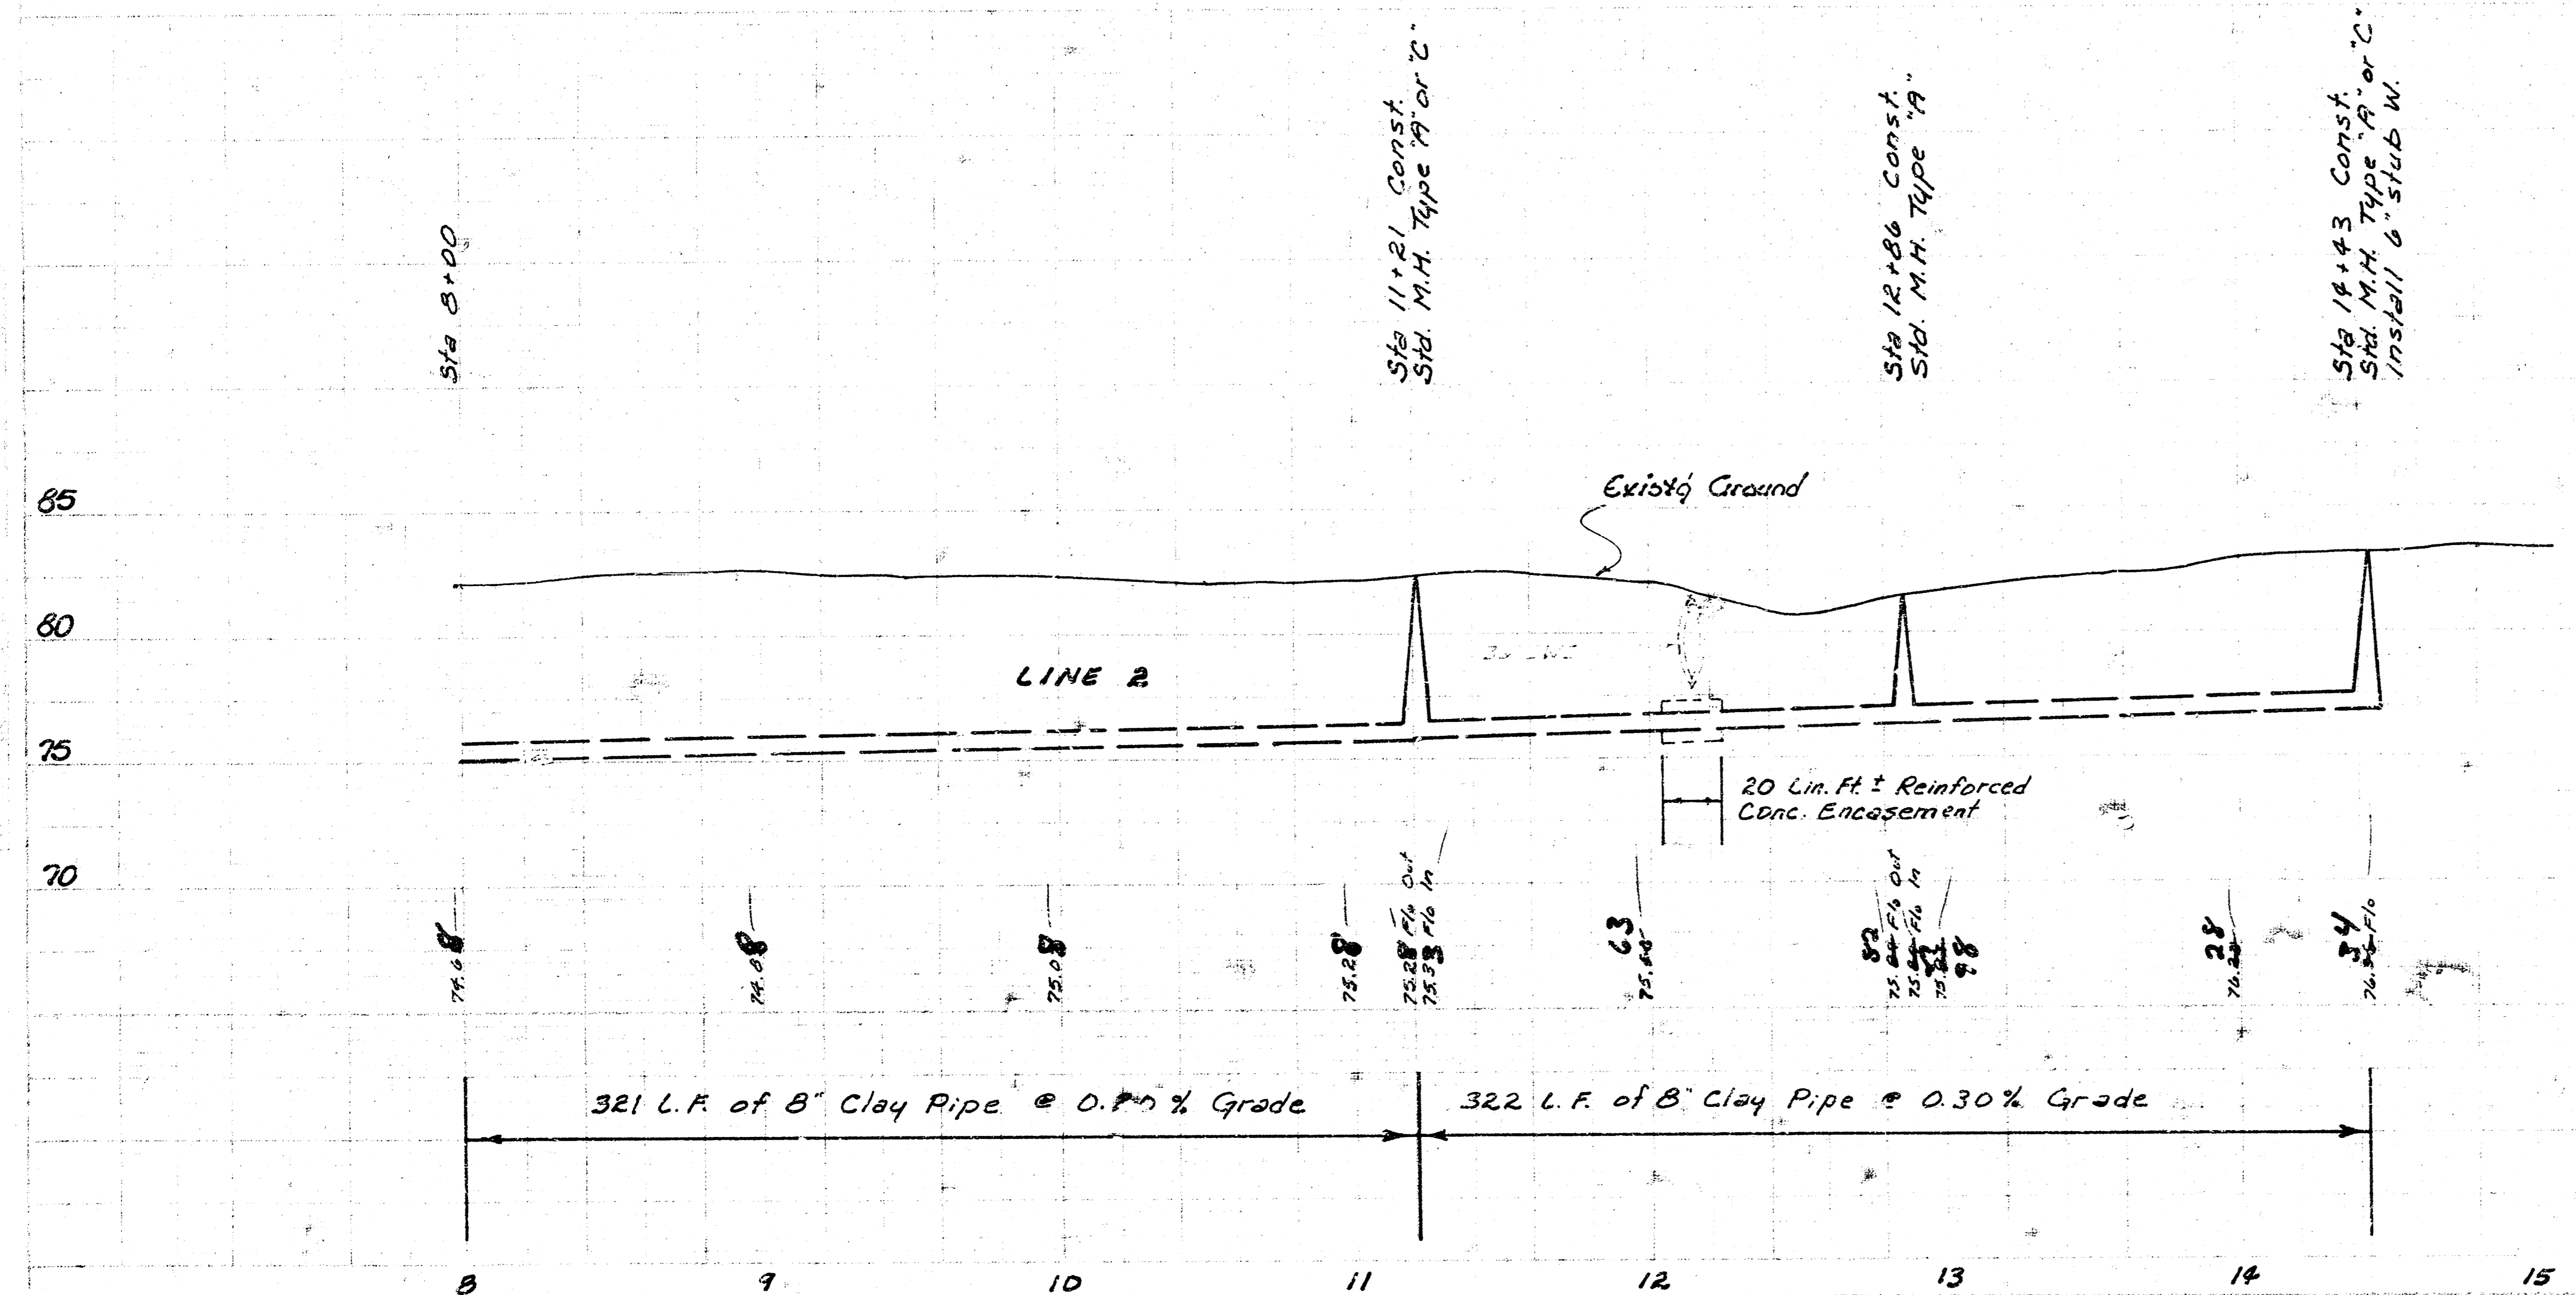

As Built
JJD
1/4/82

Scale Plan 1" = 40'
Profile 1" = 40' Horiz.
1" = 5' Vert.

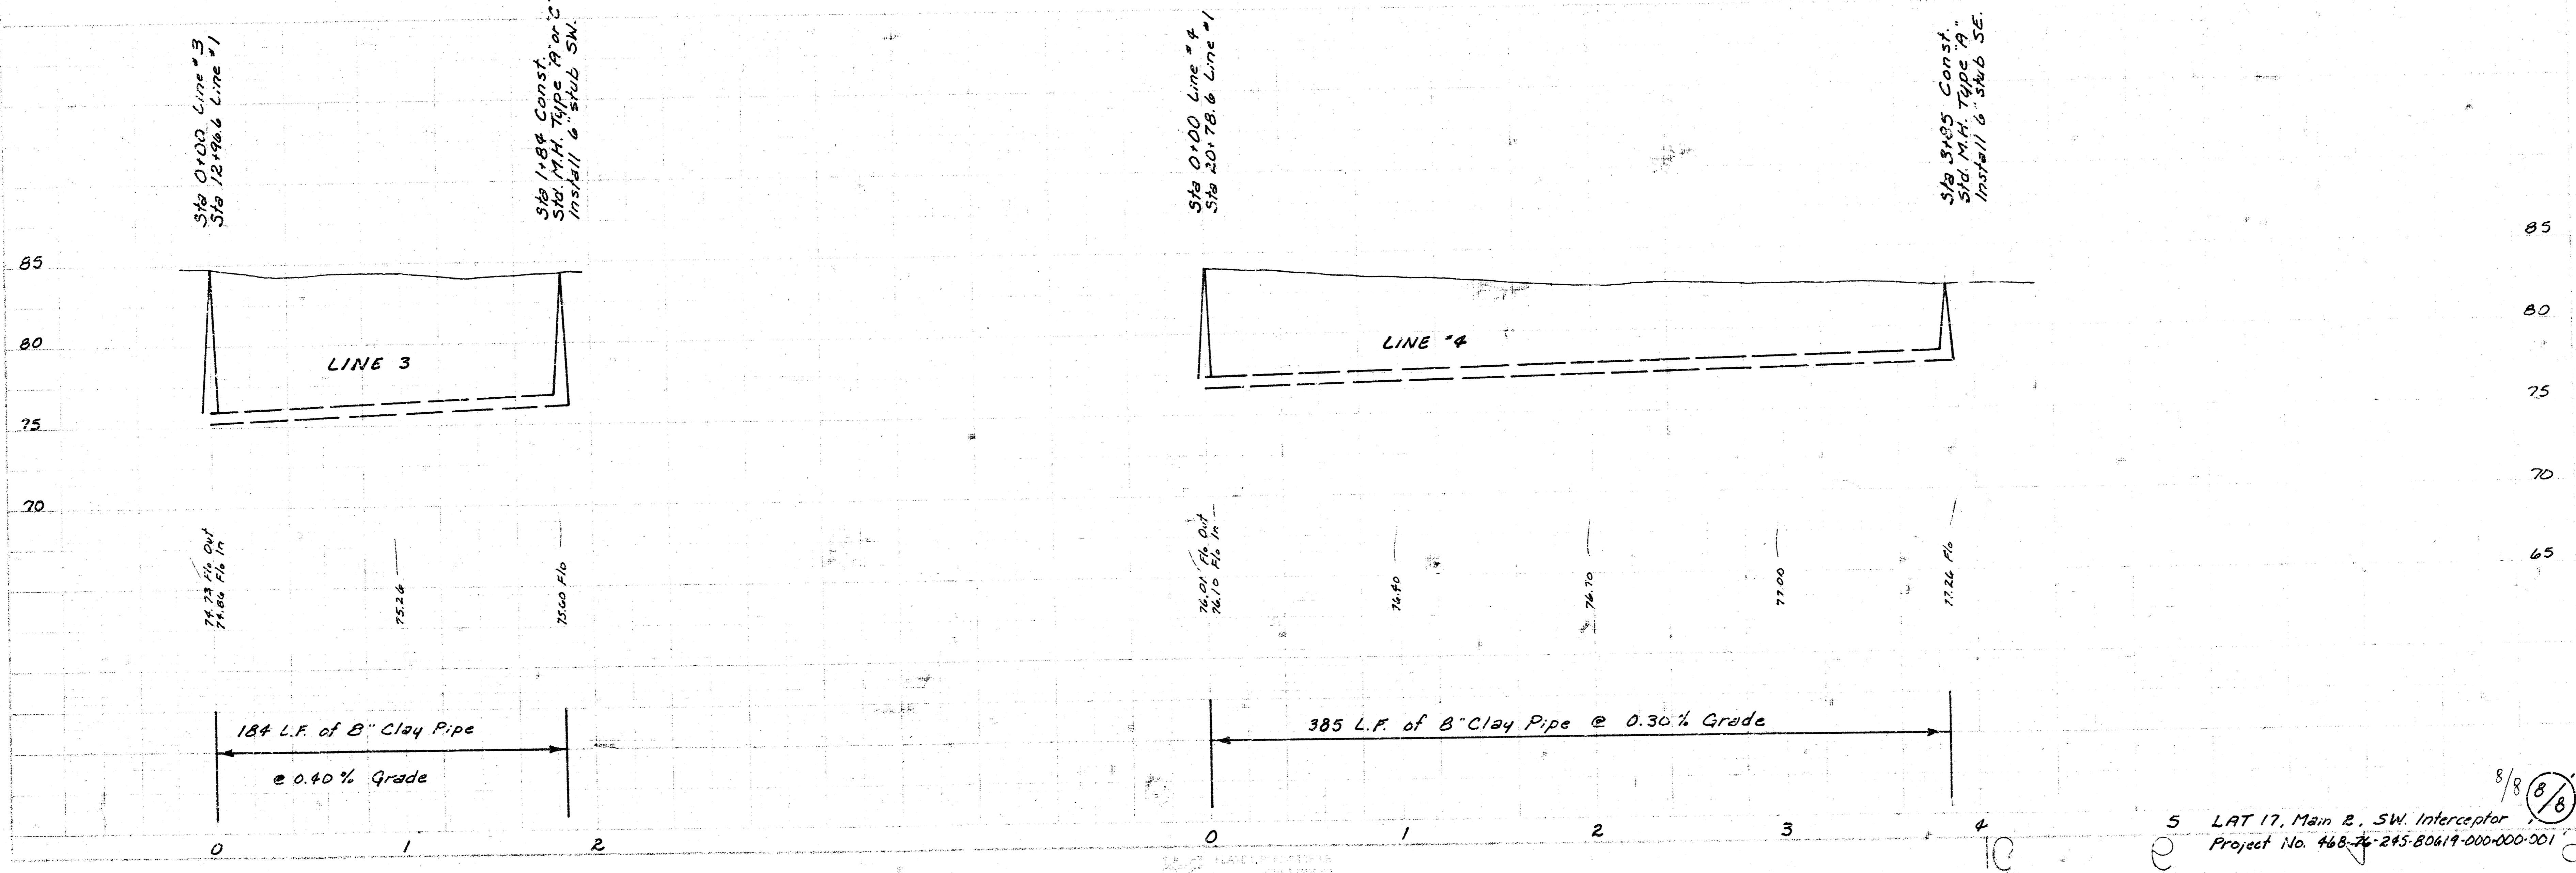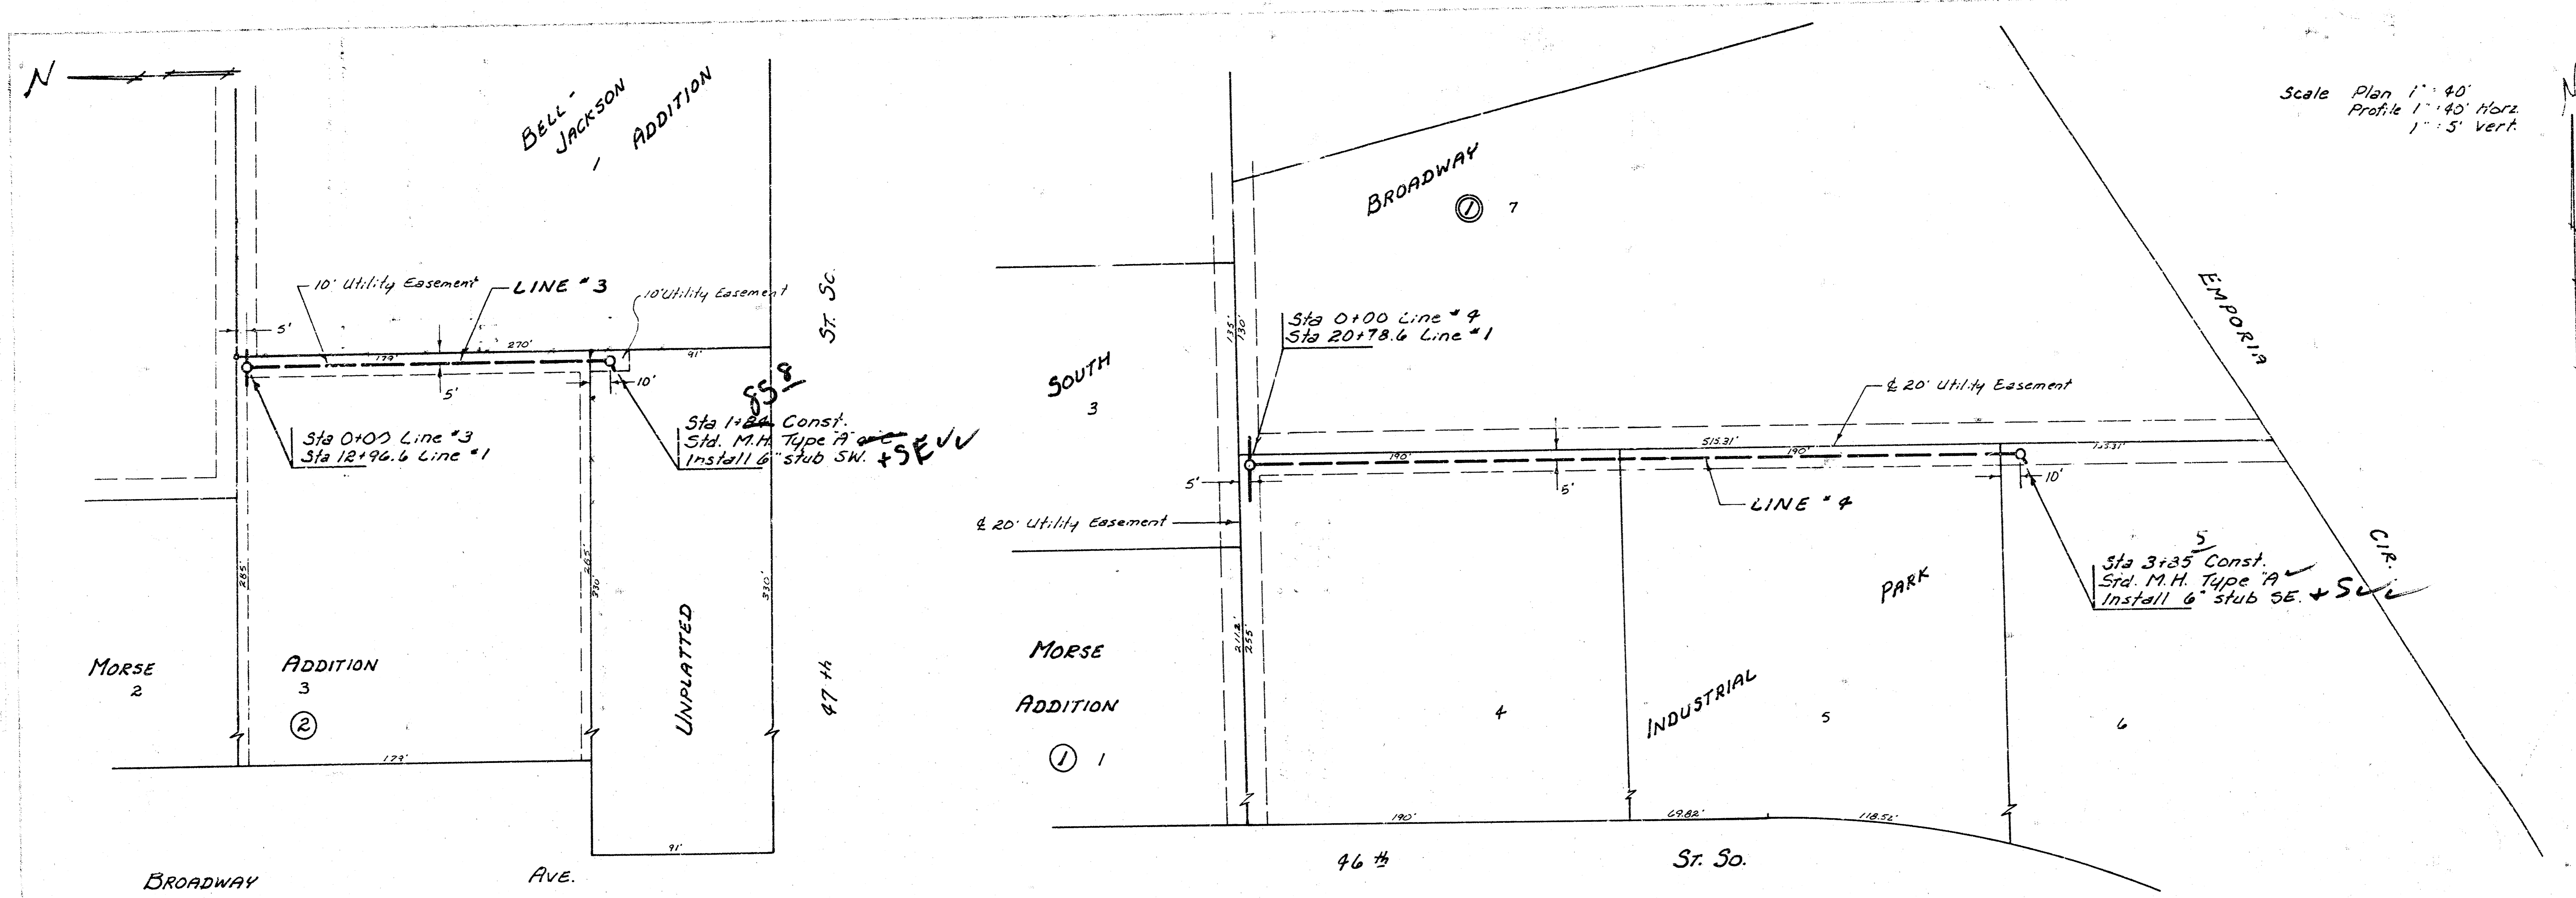

5 LAT 17, Main 2, SW Interceptor
Project No. 468-245-80619-000-000-001

8/8 (B/B)