
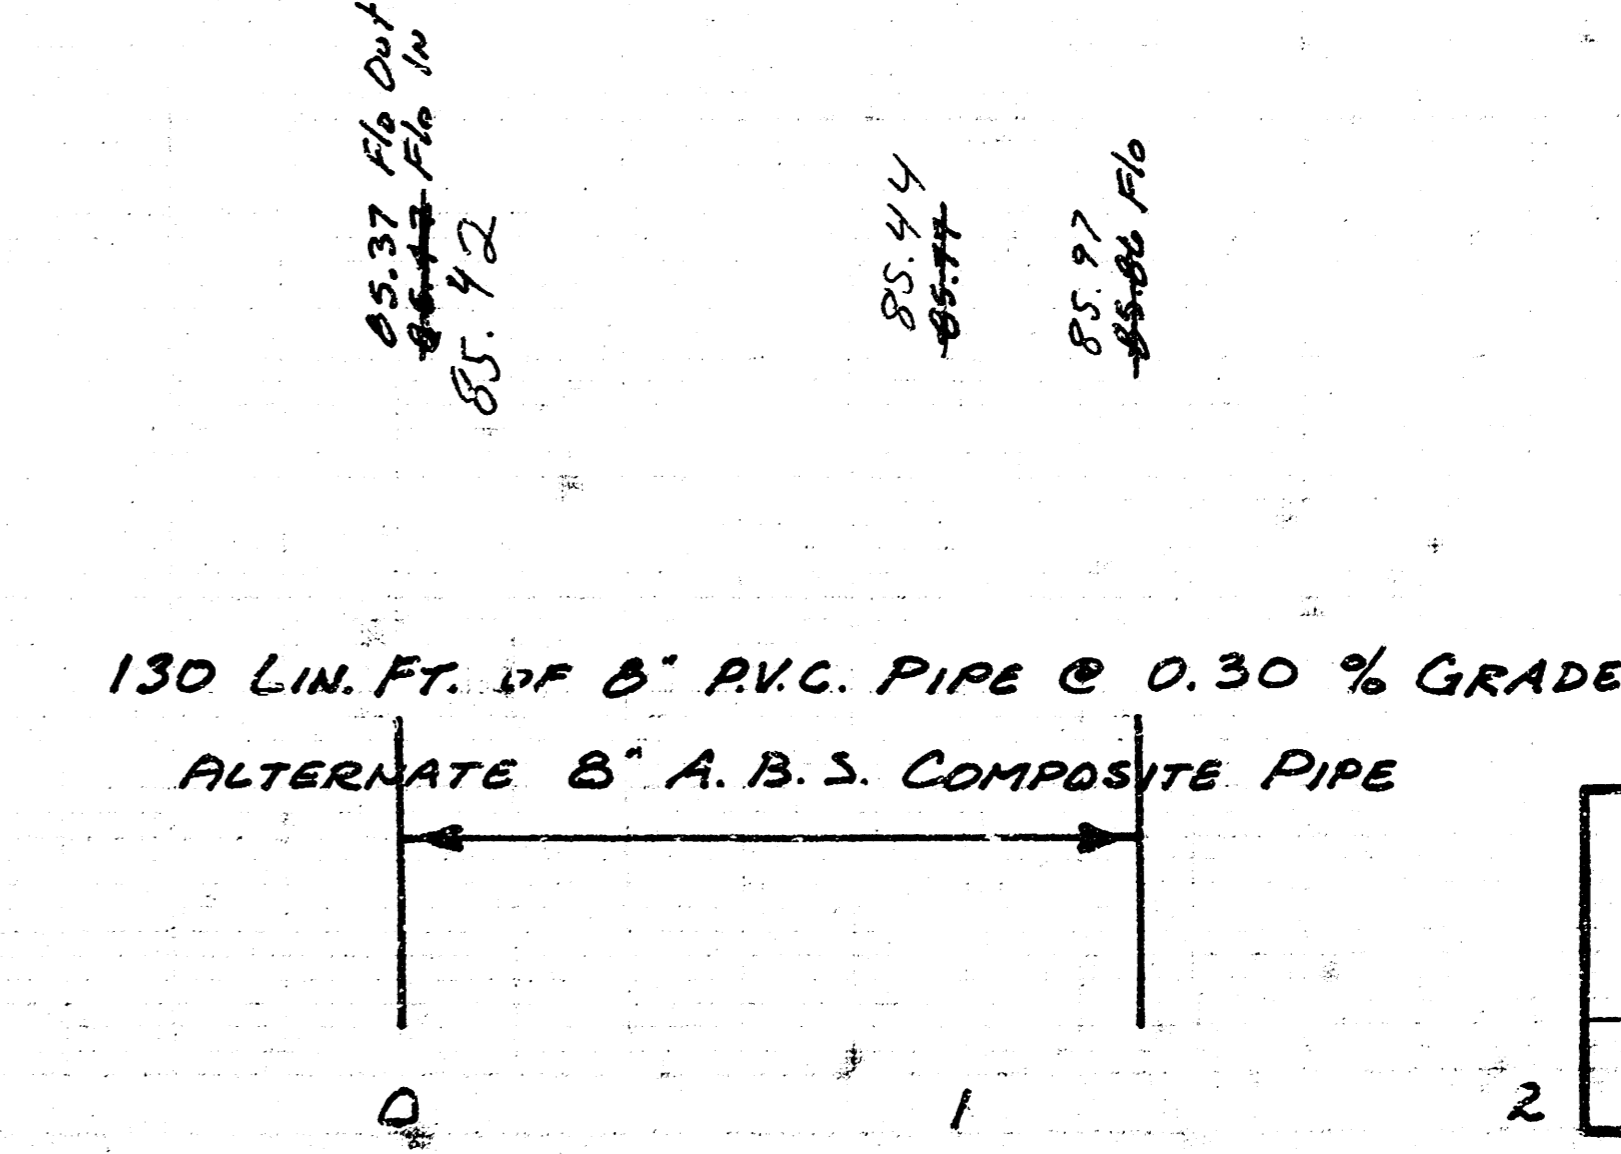
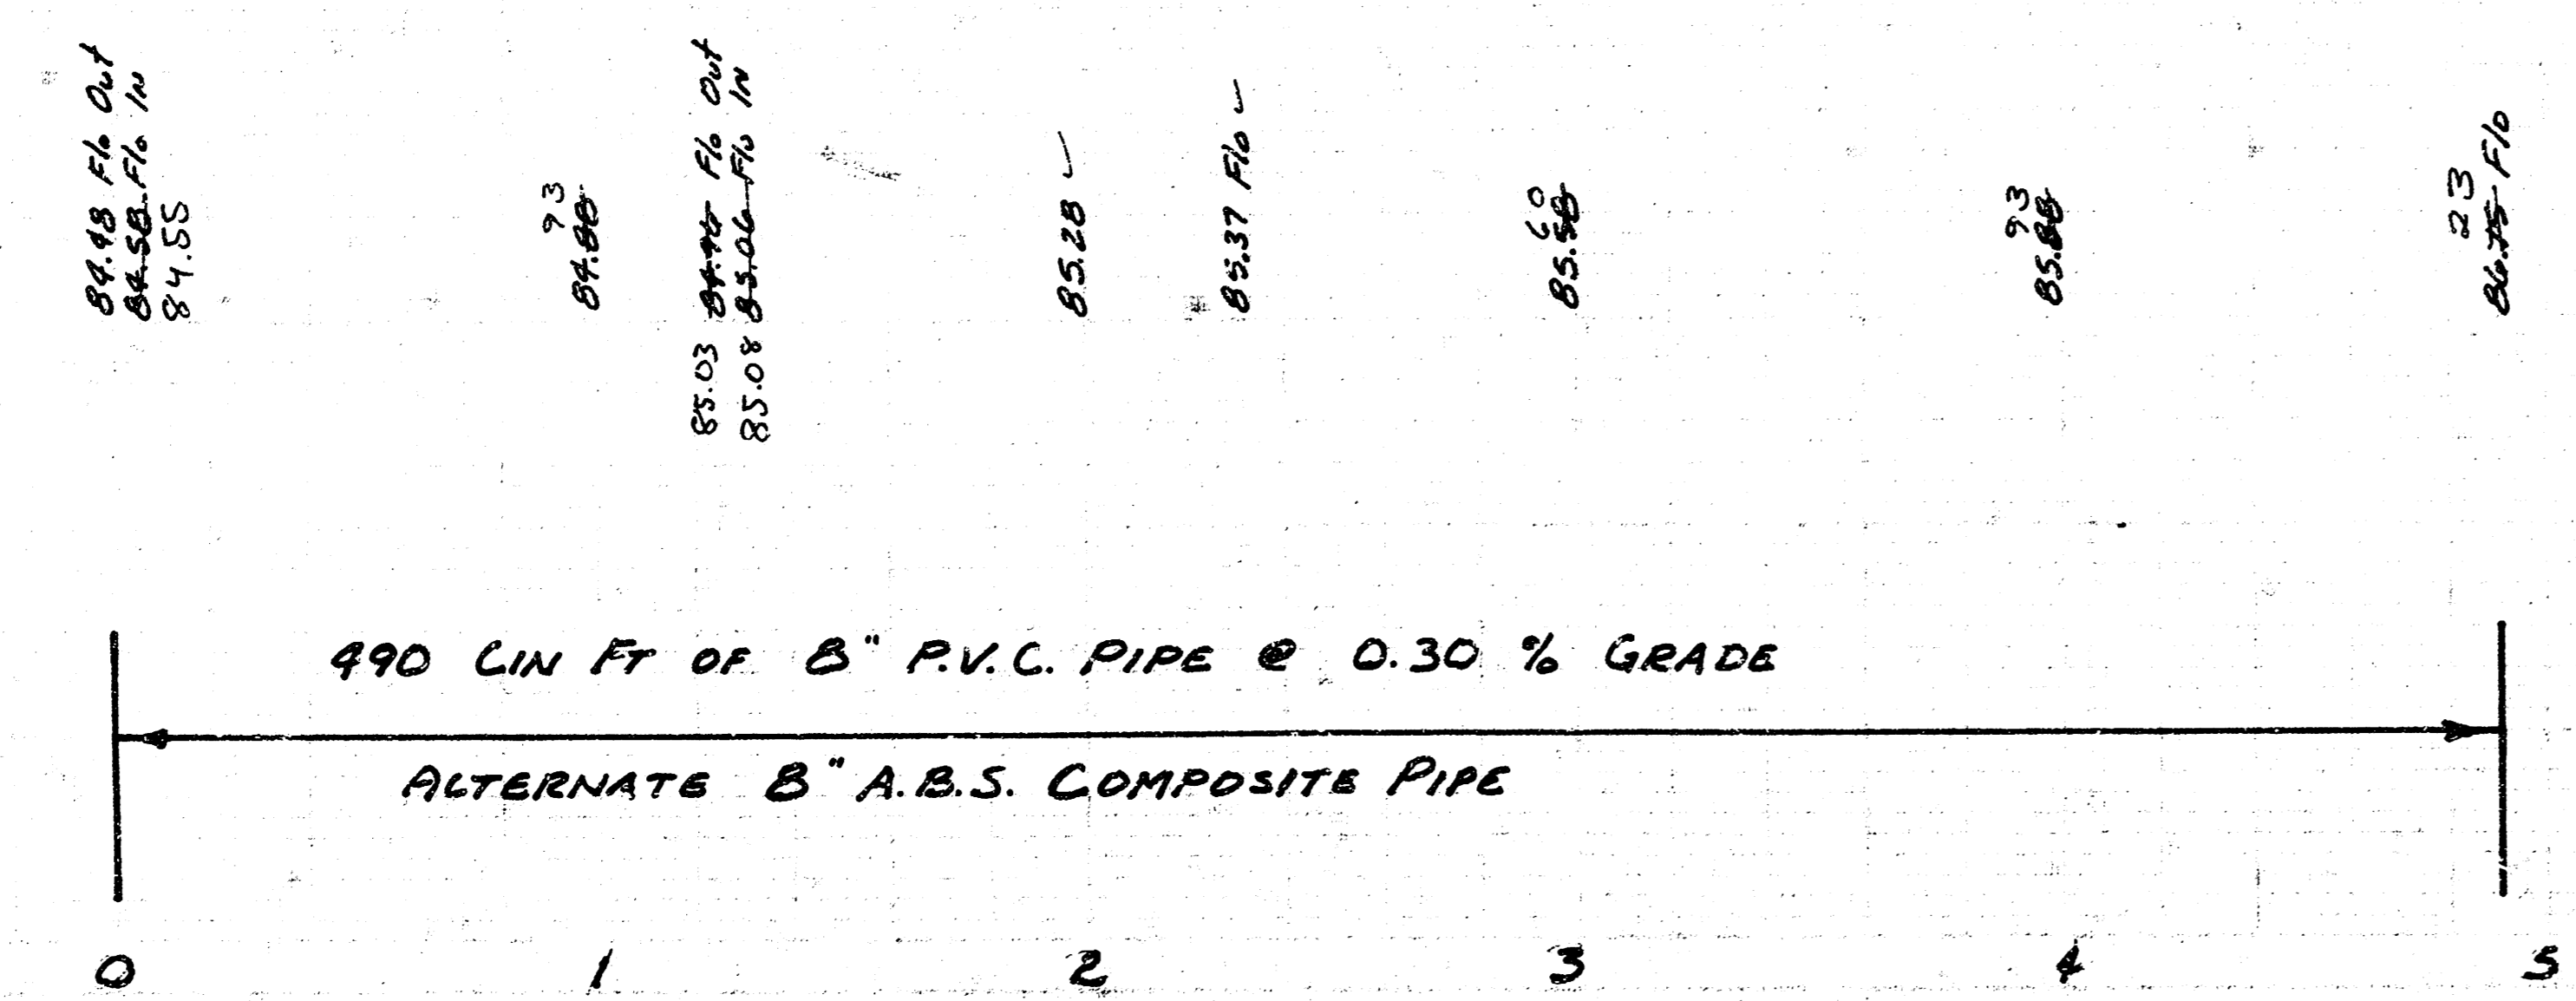


As Built
J.H.
1/83

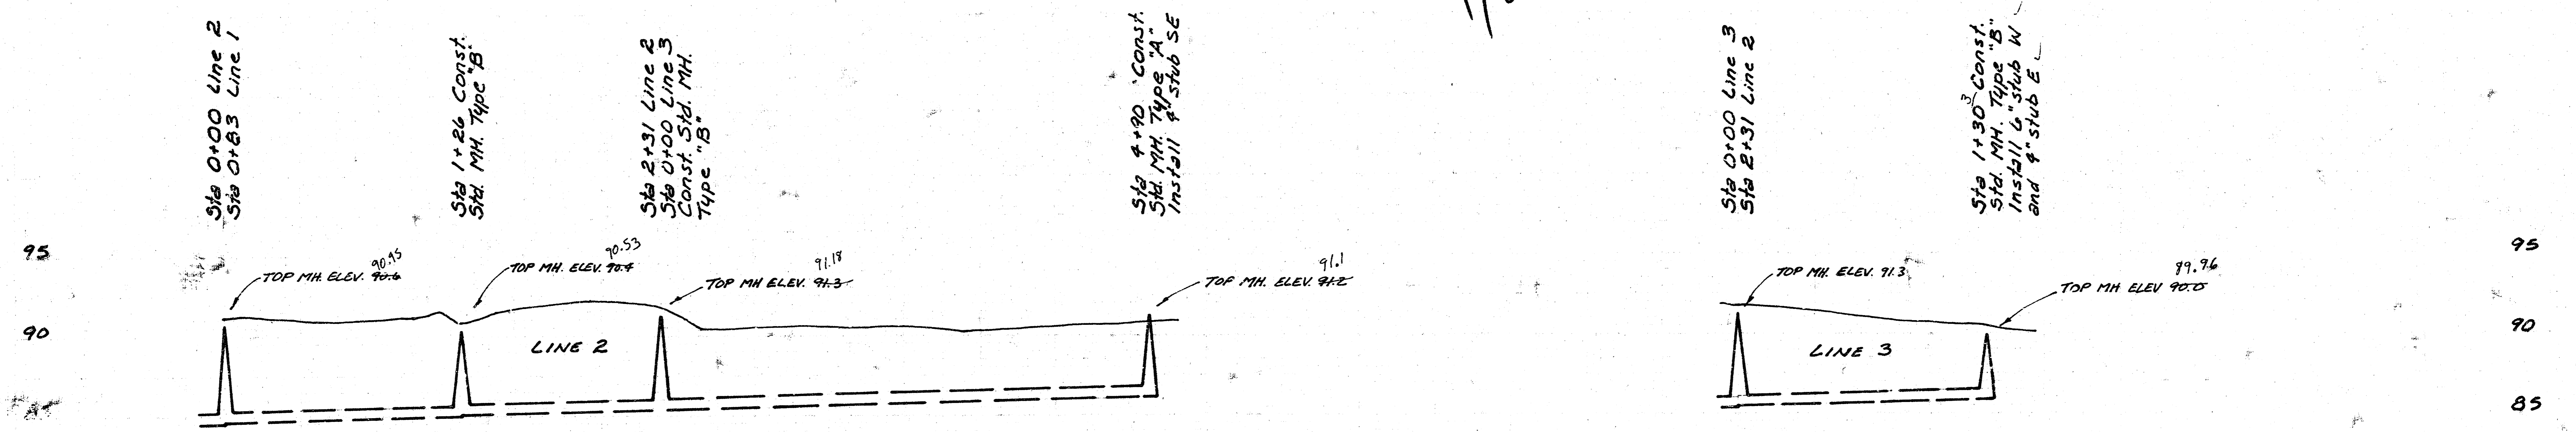

PROJECT DESCRIPTION	7/2
LAT 3, SUB 3, SW. INTERCEPTOR	
PROJECT NUMBER	
468-76-245-80035-000-031	