
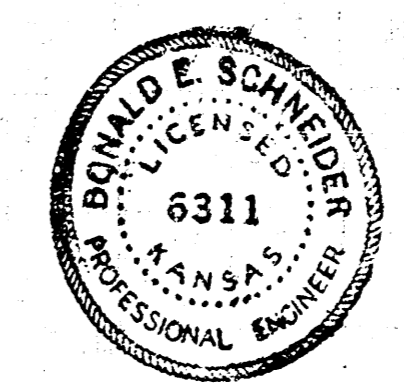
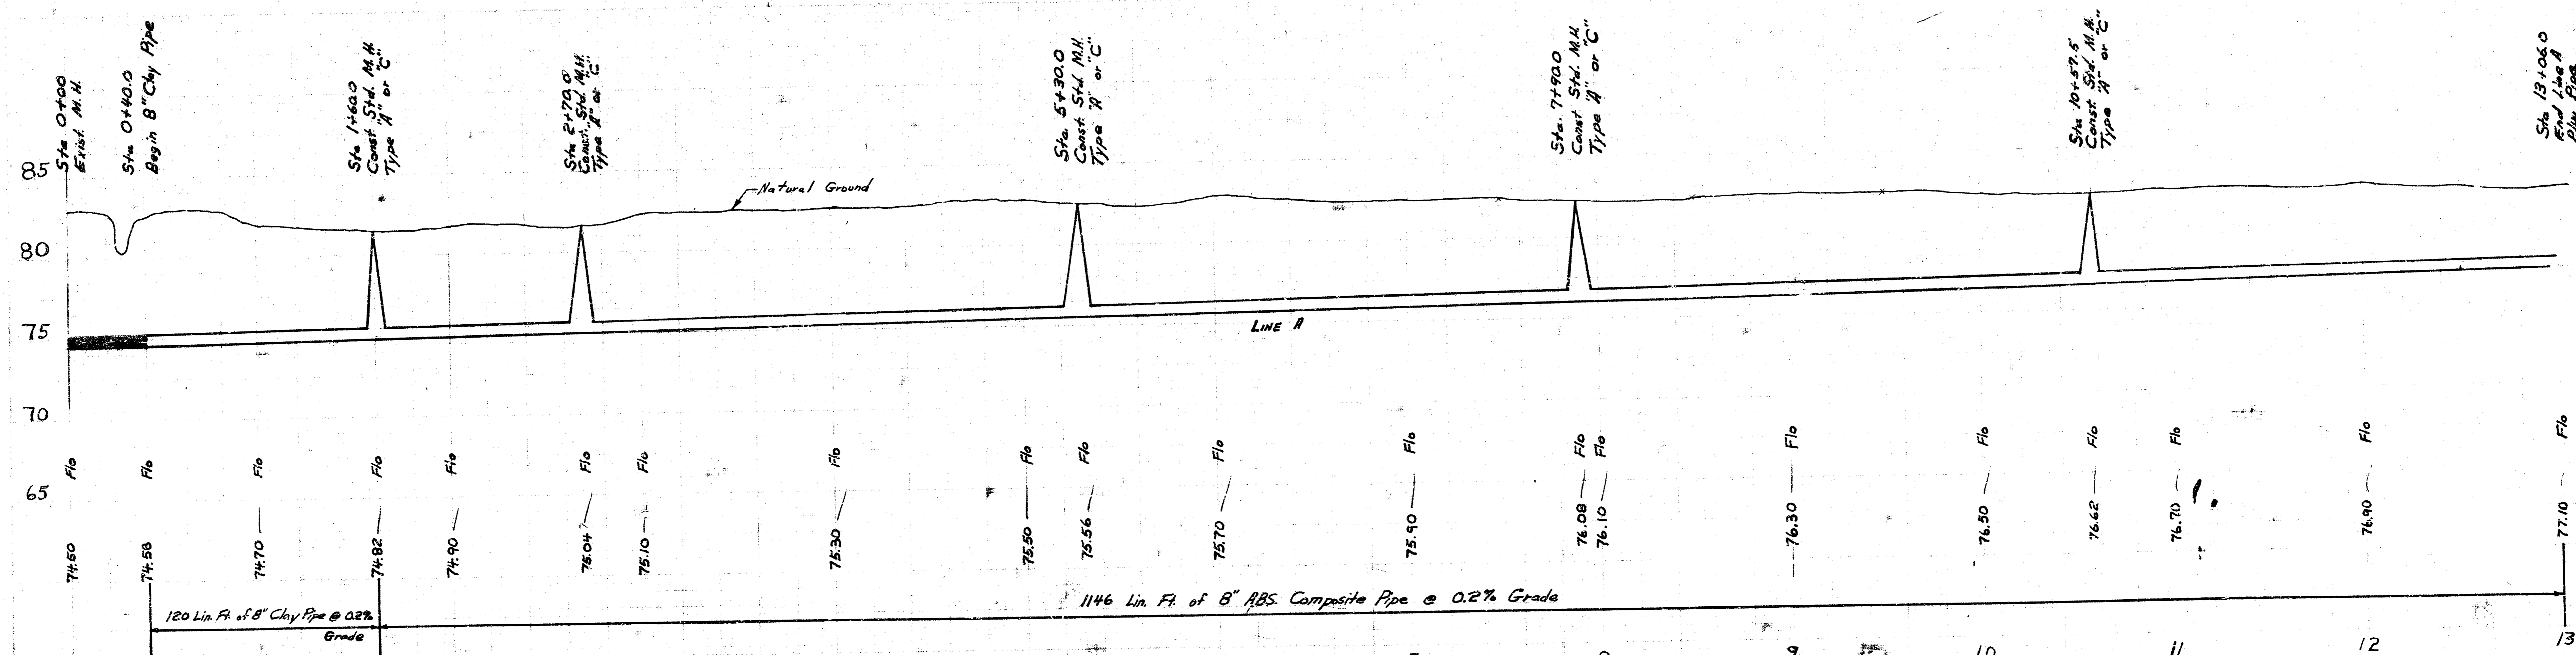
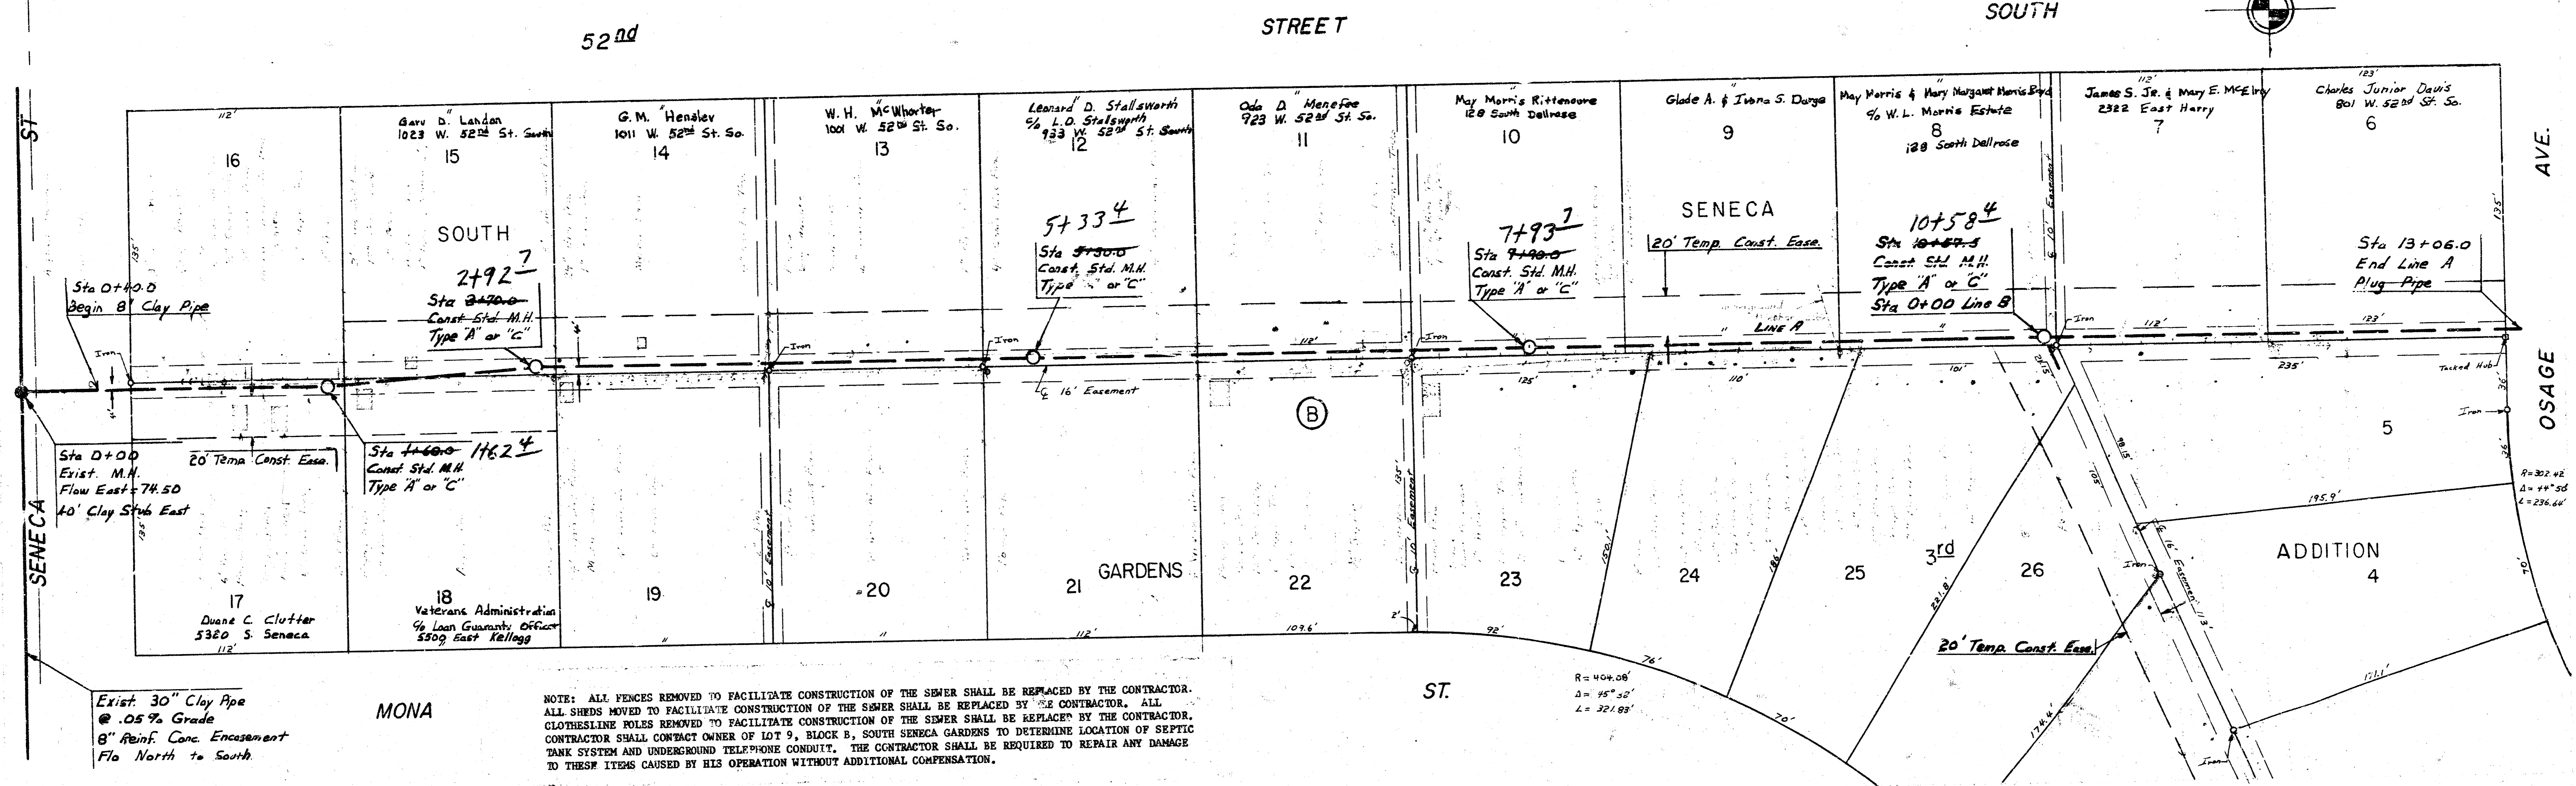




BM = 83.05 - R.R. Spk. East Side P.P. at NW. Cor. Seneca & 52<sup>nd</sup> St.  
 BM = 80.72 - City Std. Disc 30' South & 45' East of C of 55<sup>th</sup> St. S. & Seneca.

Plan Scale 1" = 40'  
 Profile Scale 1" = 40' Horiz.  
 1" = 5' Vert.

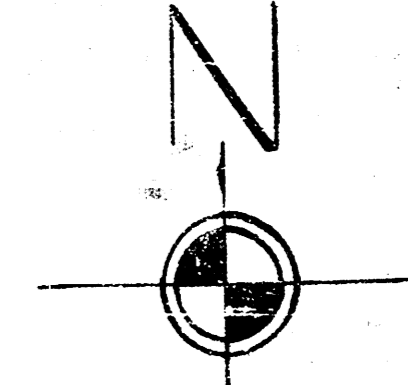


LAT. 14 MAIN 3 SWI  
 CITY OF WICHITA, KANSAS  
 R. W. LINN - CITY ENGINEER  
 April-76 PROJECT NO. DBKL 575018

As built 6-8-77

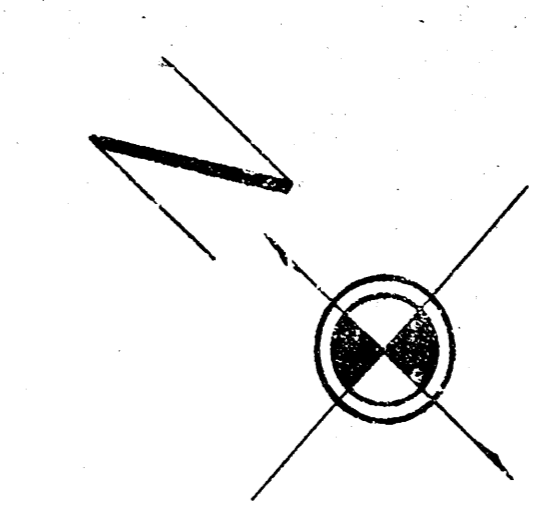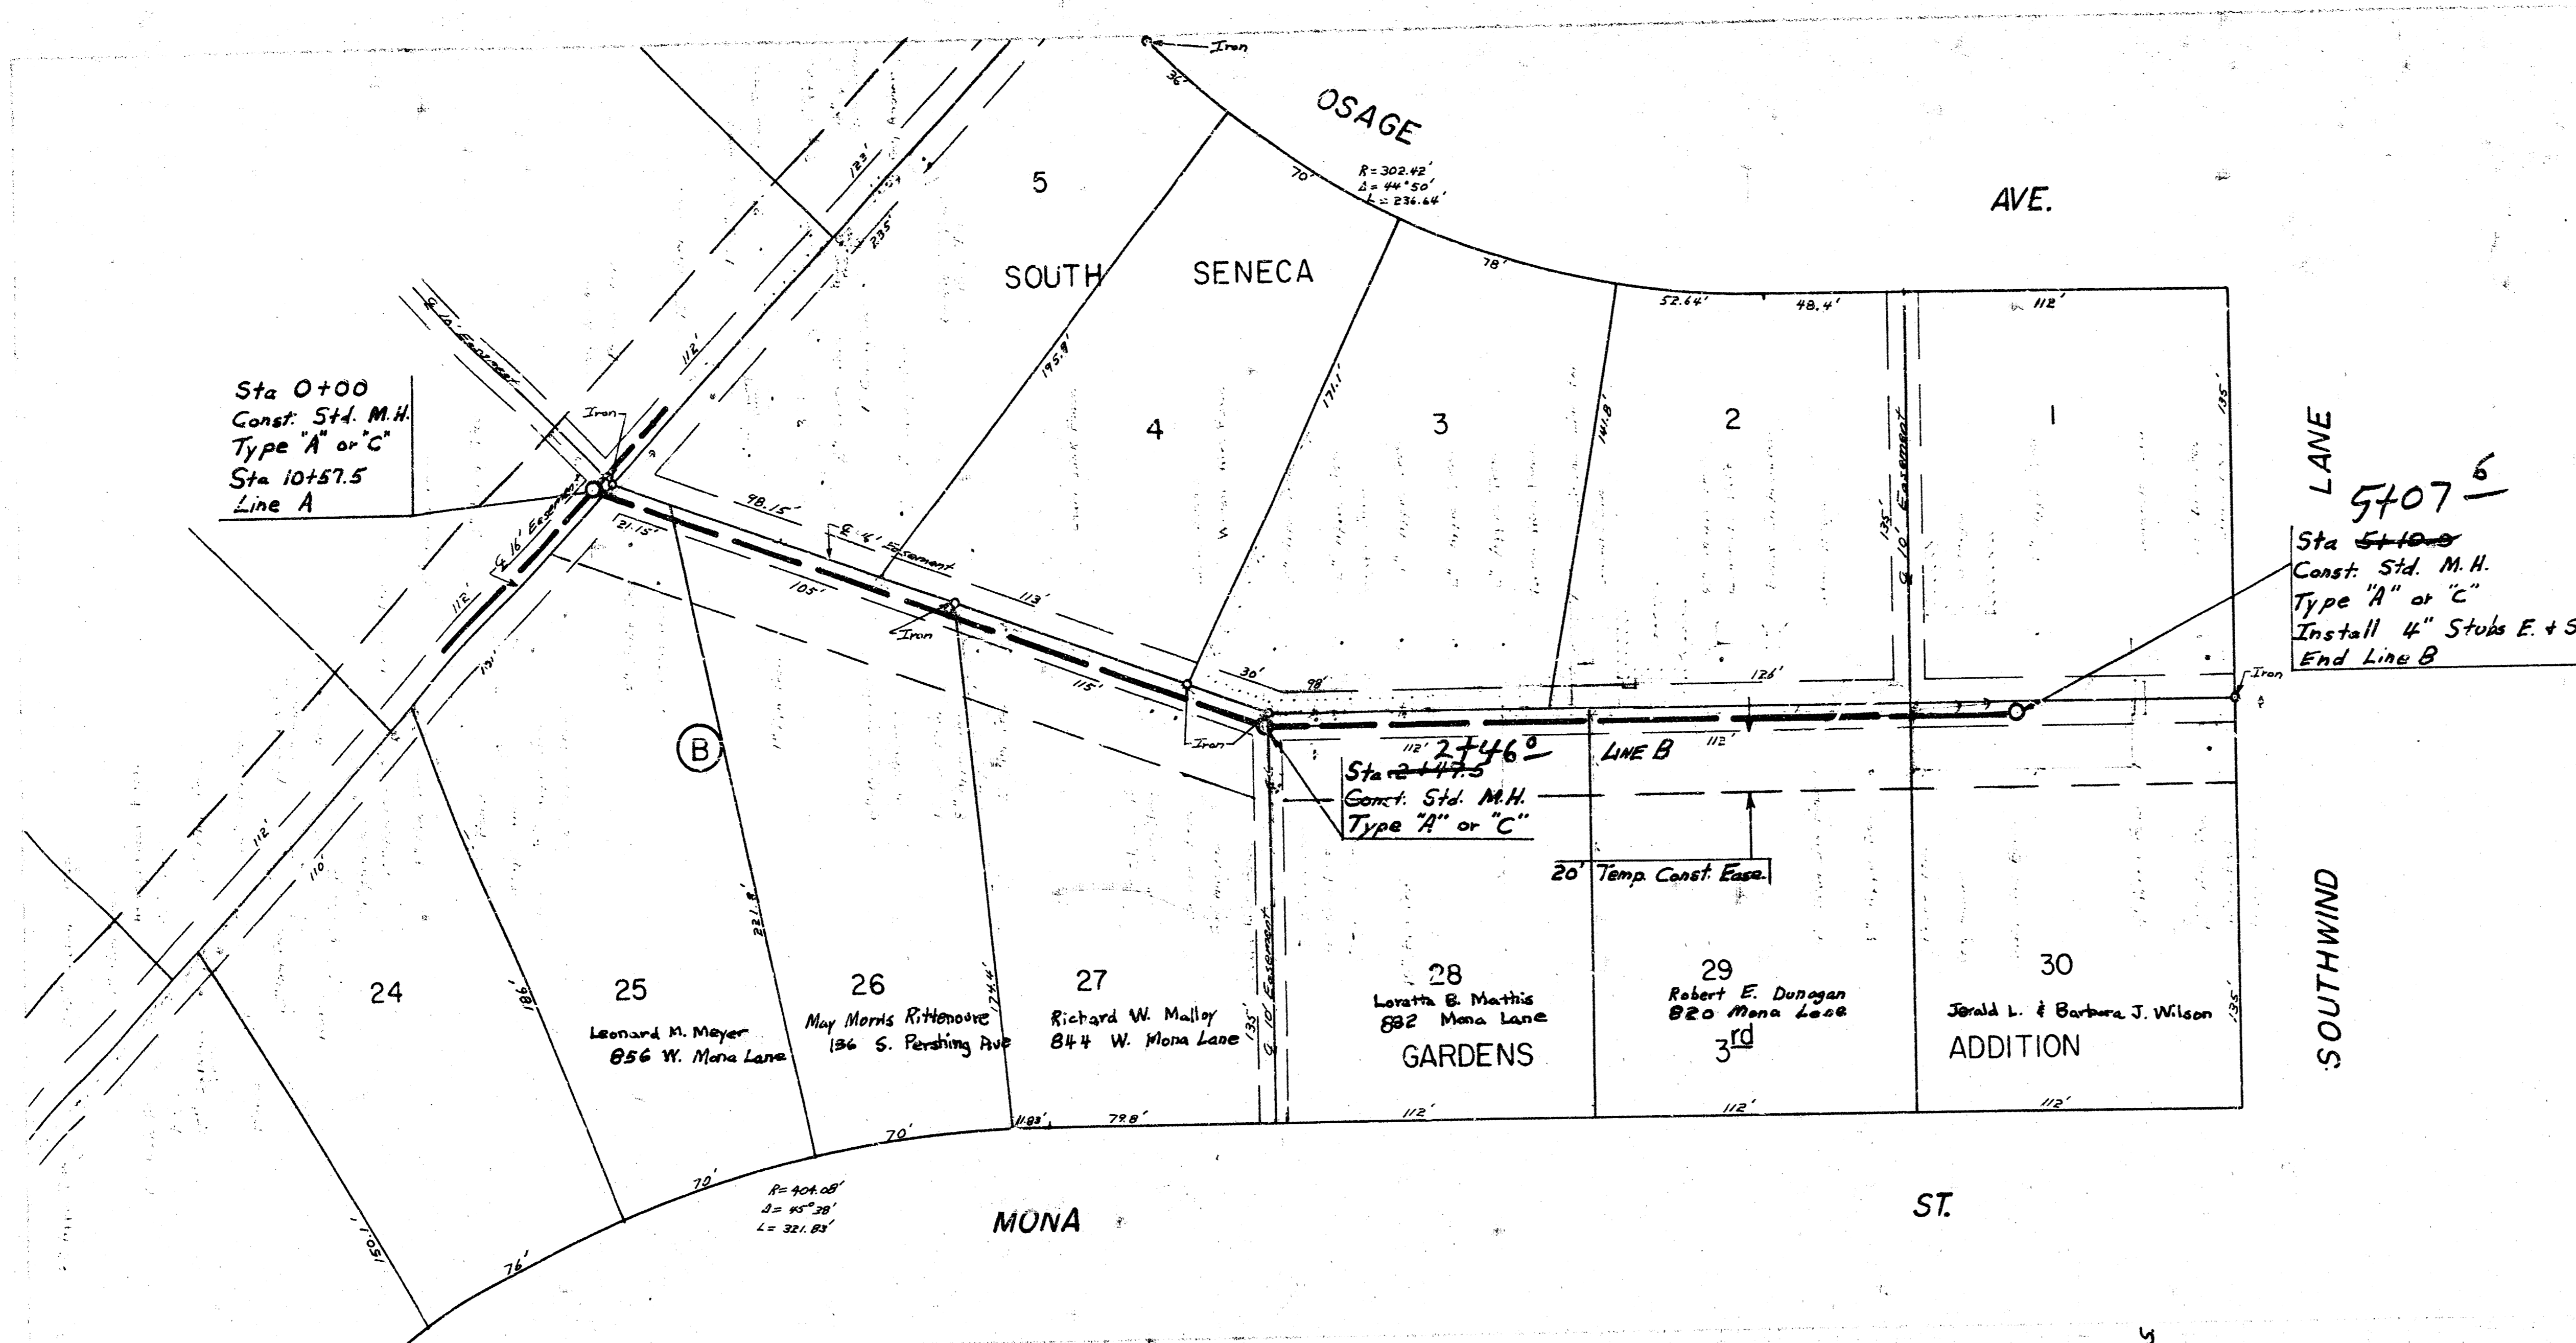

Plan Scale 1" = 40'  
 Profile Scale 1" = 40' Horz.  
 1" = 5' Vert.

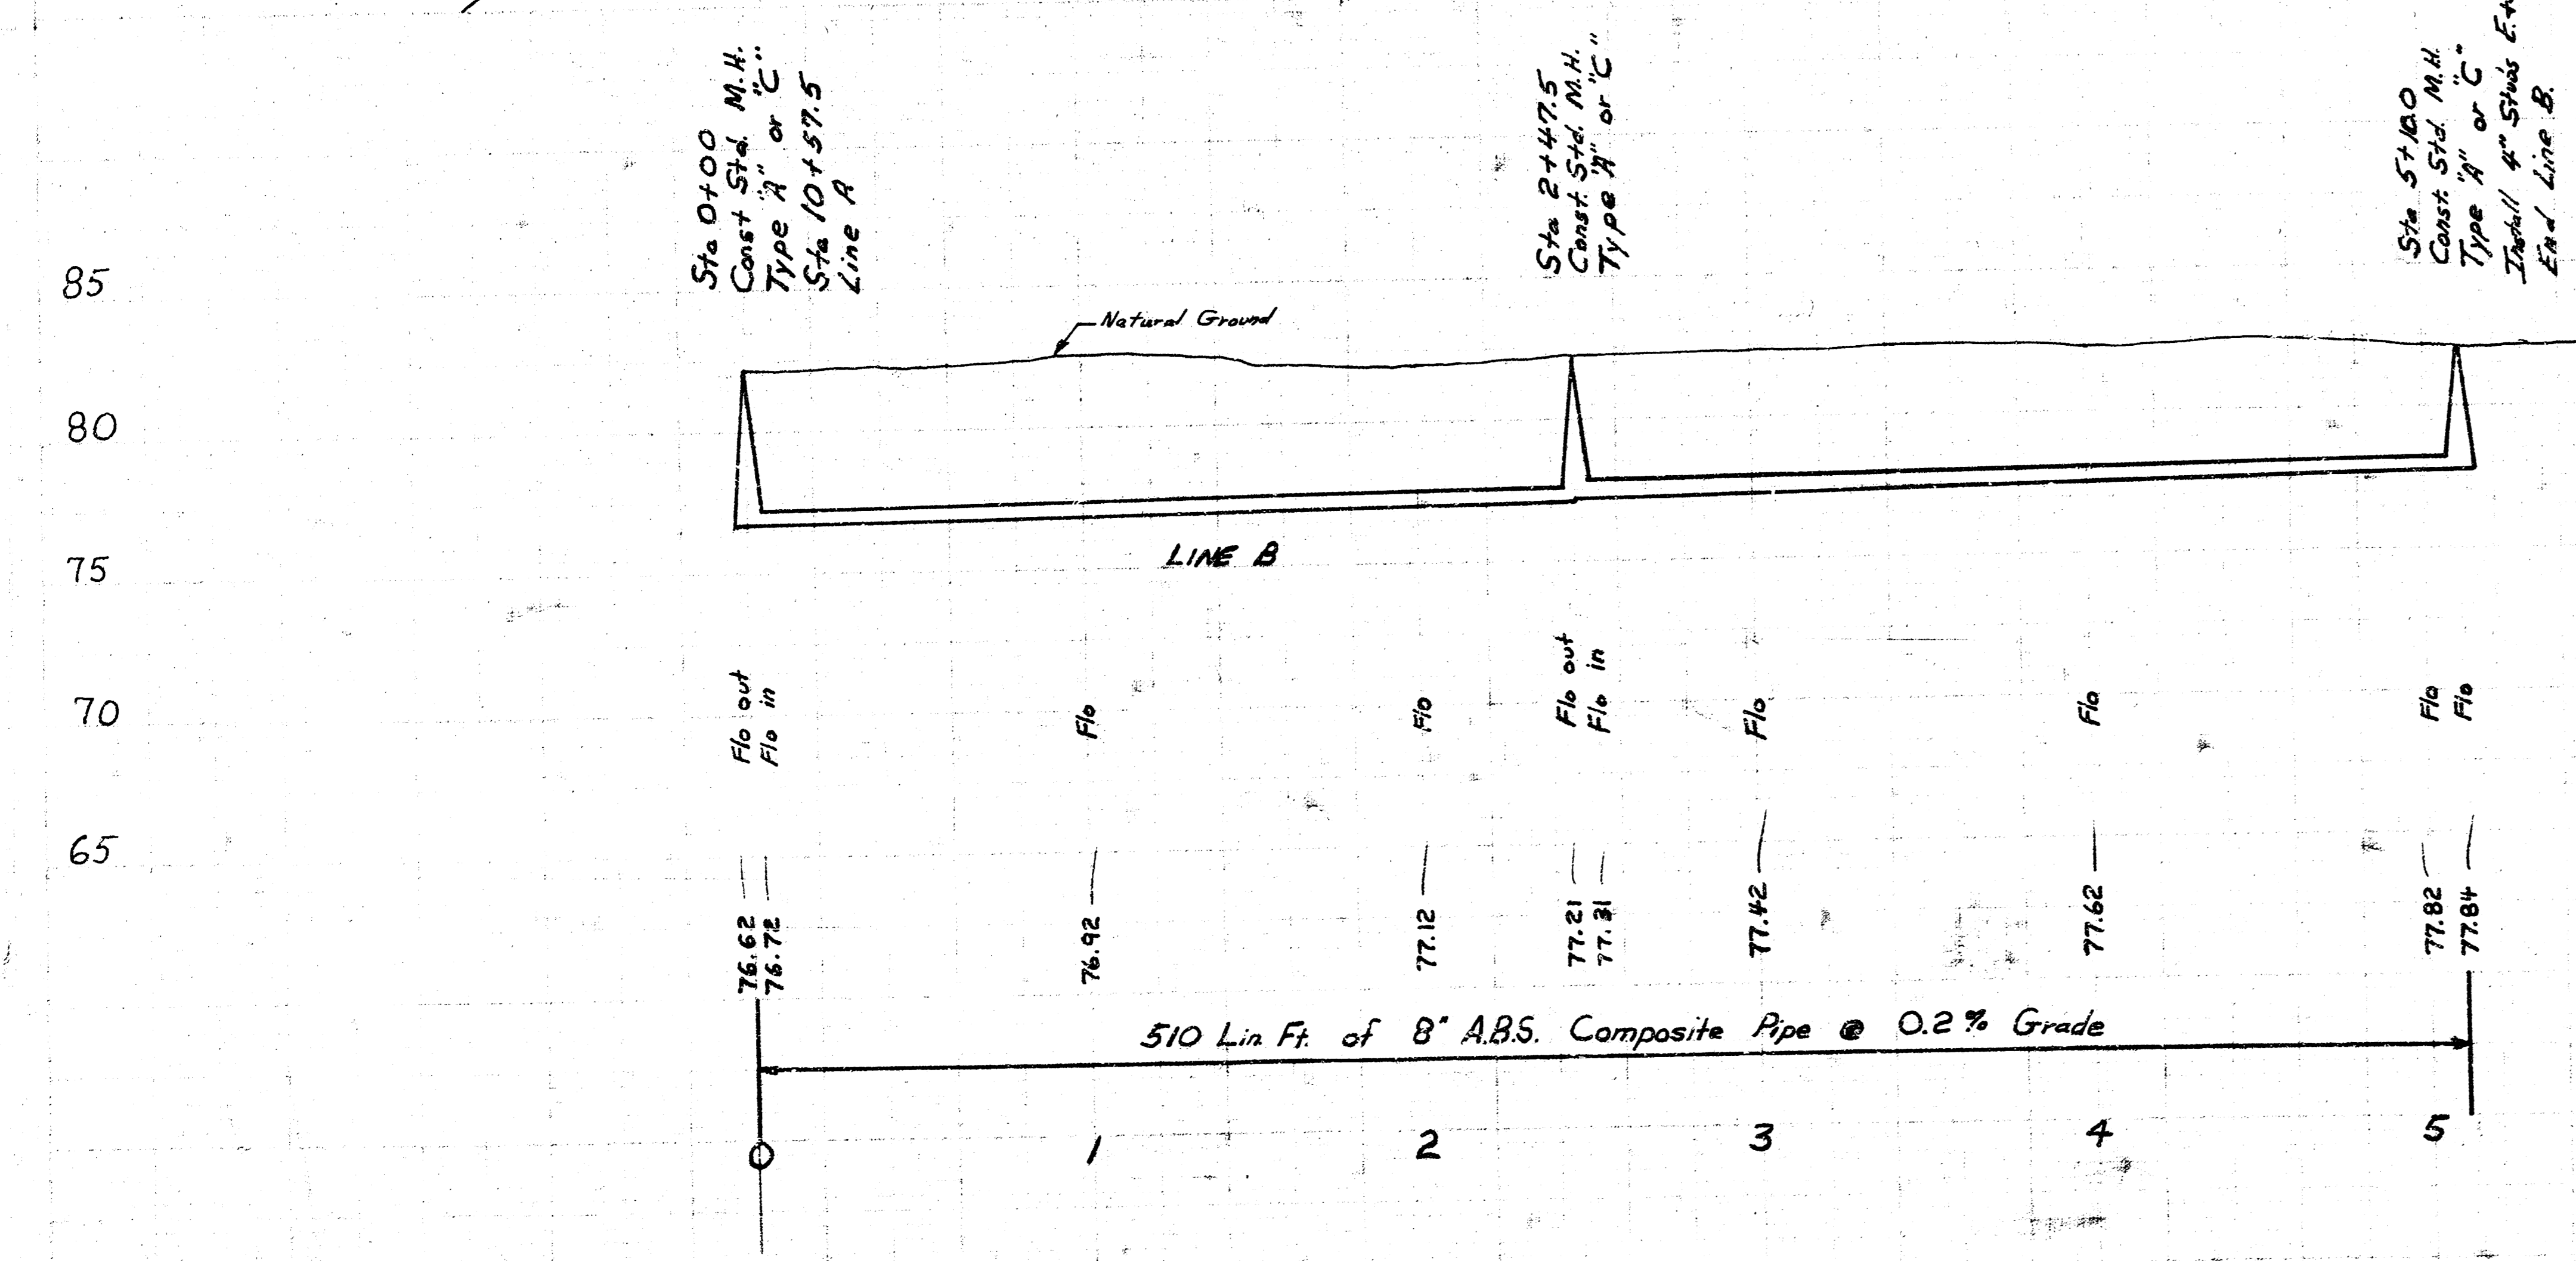

LAT. 14 MAIN 3 SWI 3/2  
 PROJECT NO. DBKL 575018