



NOTE: EXISTING PAVEMENT IS TO BE REMOVED FULL WIDTH BETWEEN COMBINED CURB AND CUTTER IN THE AREA OF SEWER CONSTRUCTION ON 46TH STREET SOUTH. EXISTING PAVEMENT SHALL BE RECONSTRUCTED AS 8" ASPHALT PAVEMENT WITH 6" BITUMINOUS BASE.

Scale Plan 1" = 40'
Profile 1" = 40' Horiz.
1" = 5' Vert.

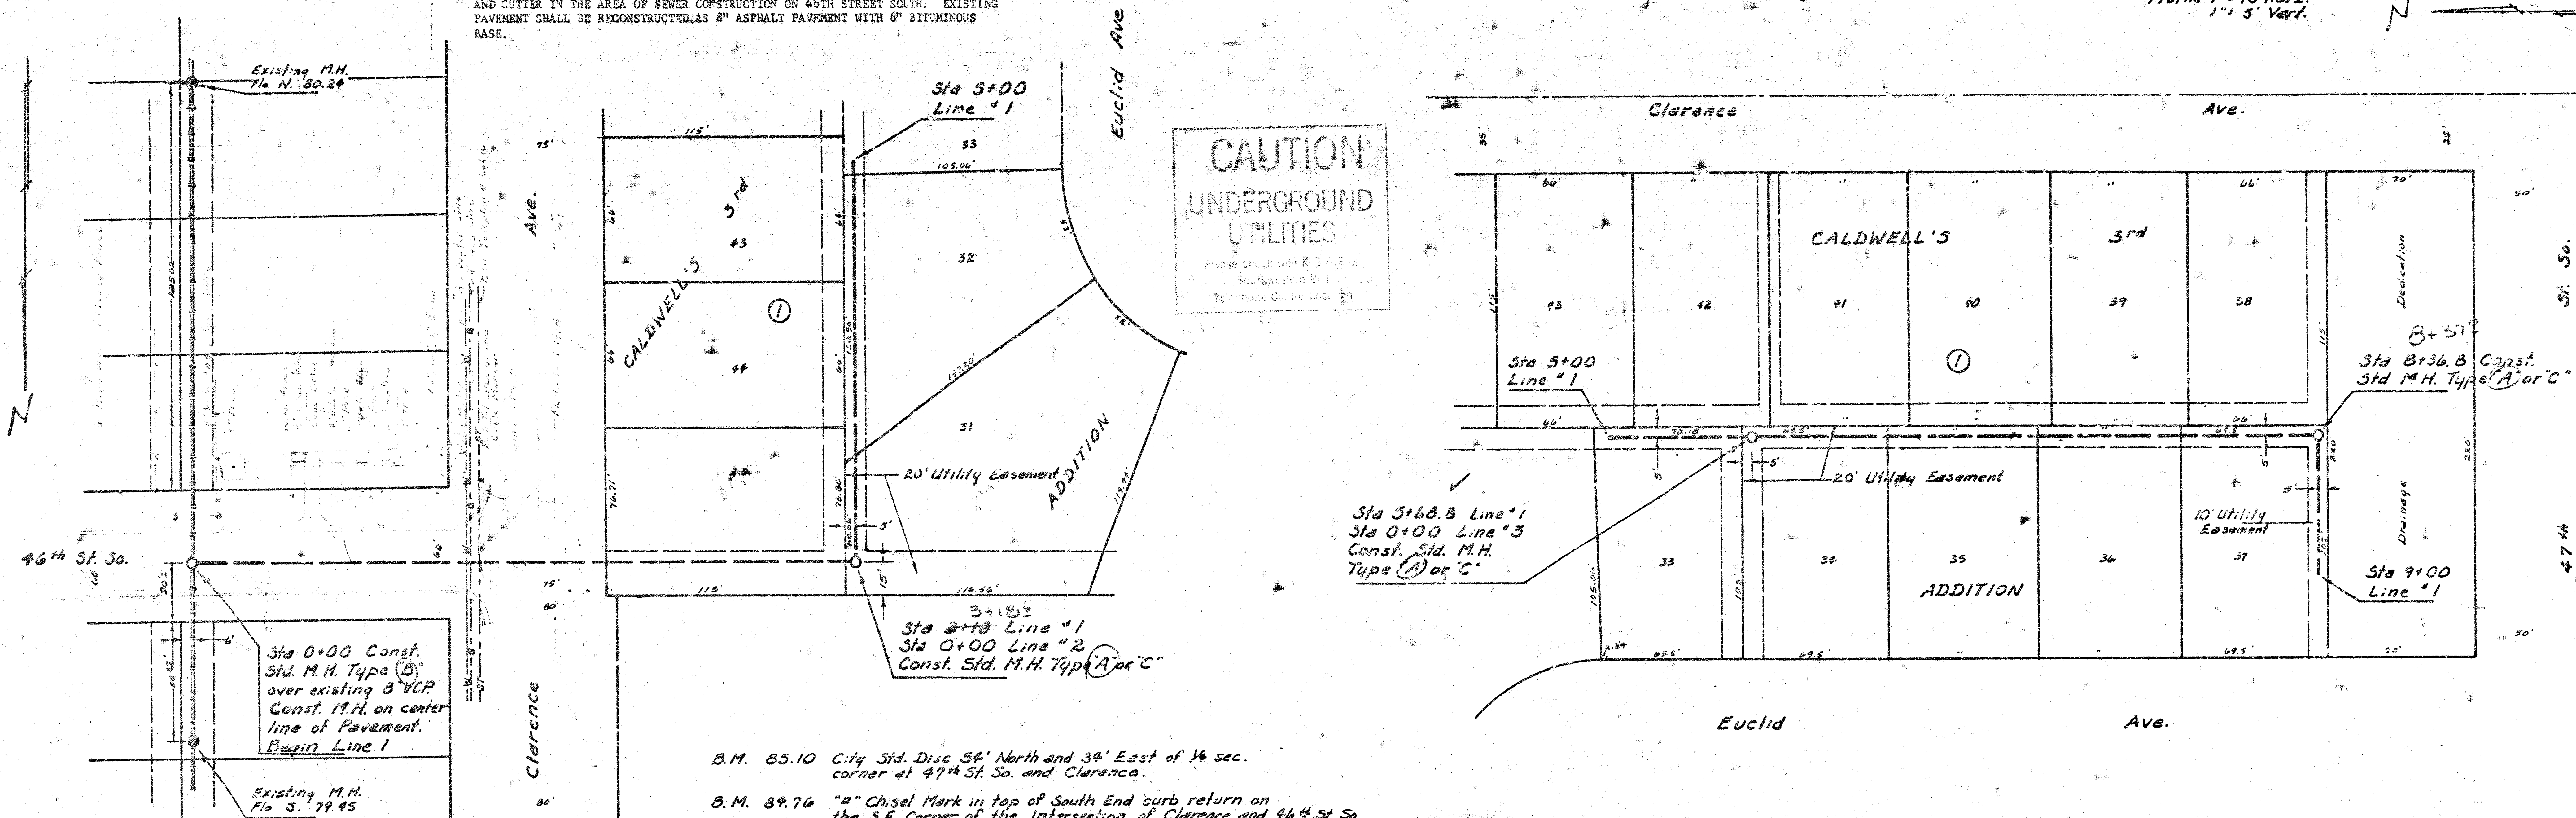


- B.M. 85.10 City Sid. Disc 34' North and 34' East of 1/4 sec. corner at 47th St. So. and Clarence.
- B.M. 84.76 "a" Chisel Mark in top of South End curb return on the S.E. Corner of the Intersection of Clarence and 46th St. So.
- B.M. 91.49 R.R. Spike in NE. side of 24" Elm tree approximately 1/4 mile East and 230 ft. North of the Intersection of Meridian & 47th St. So.

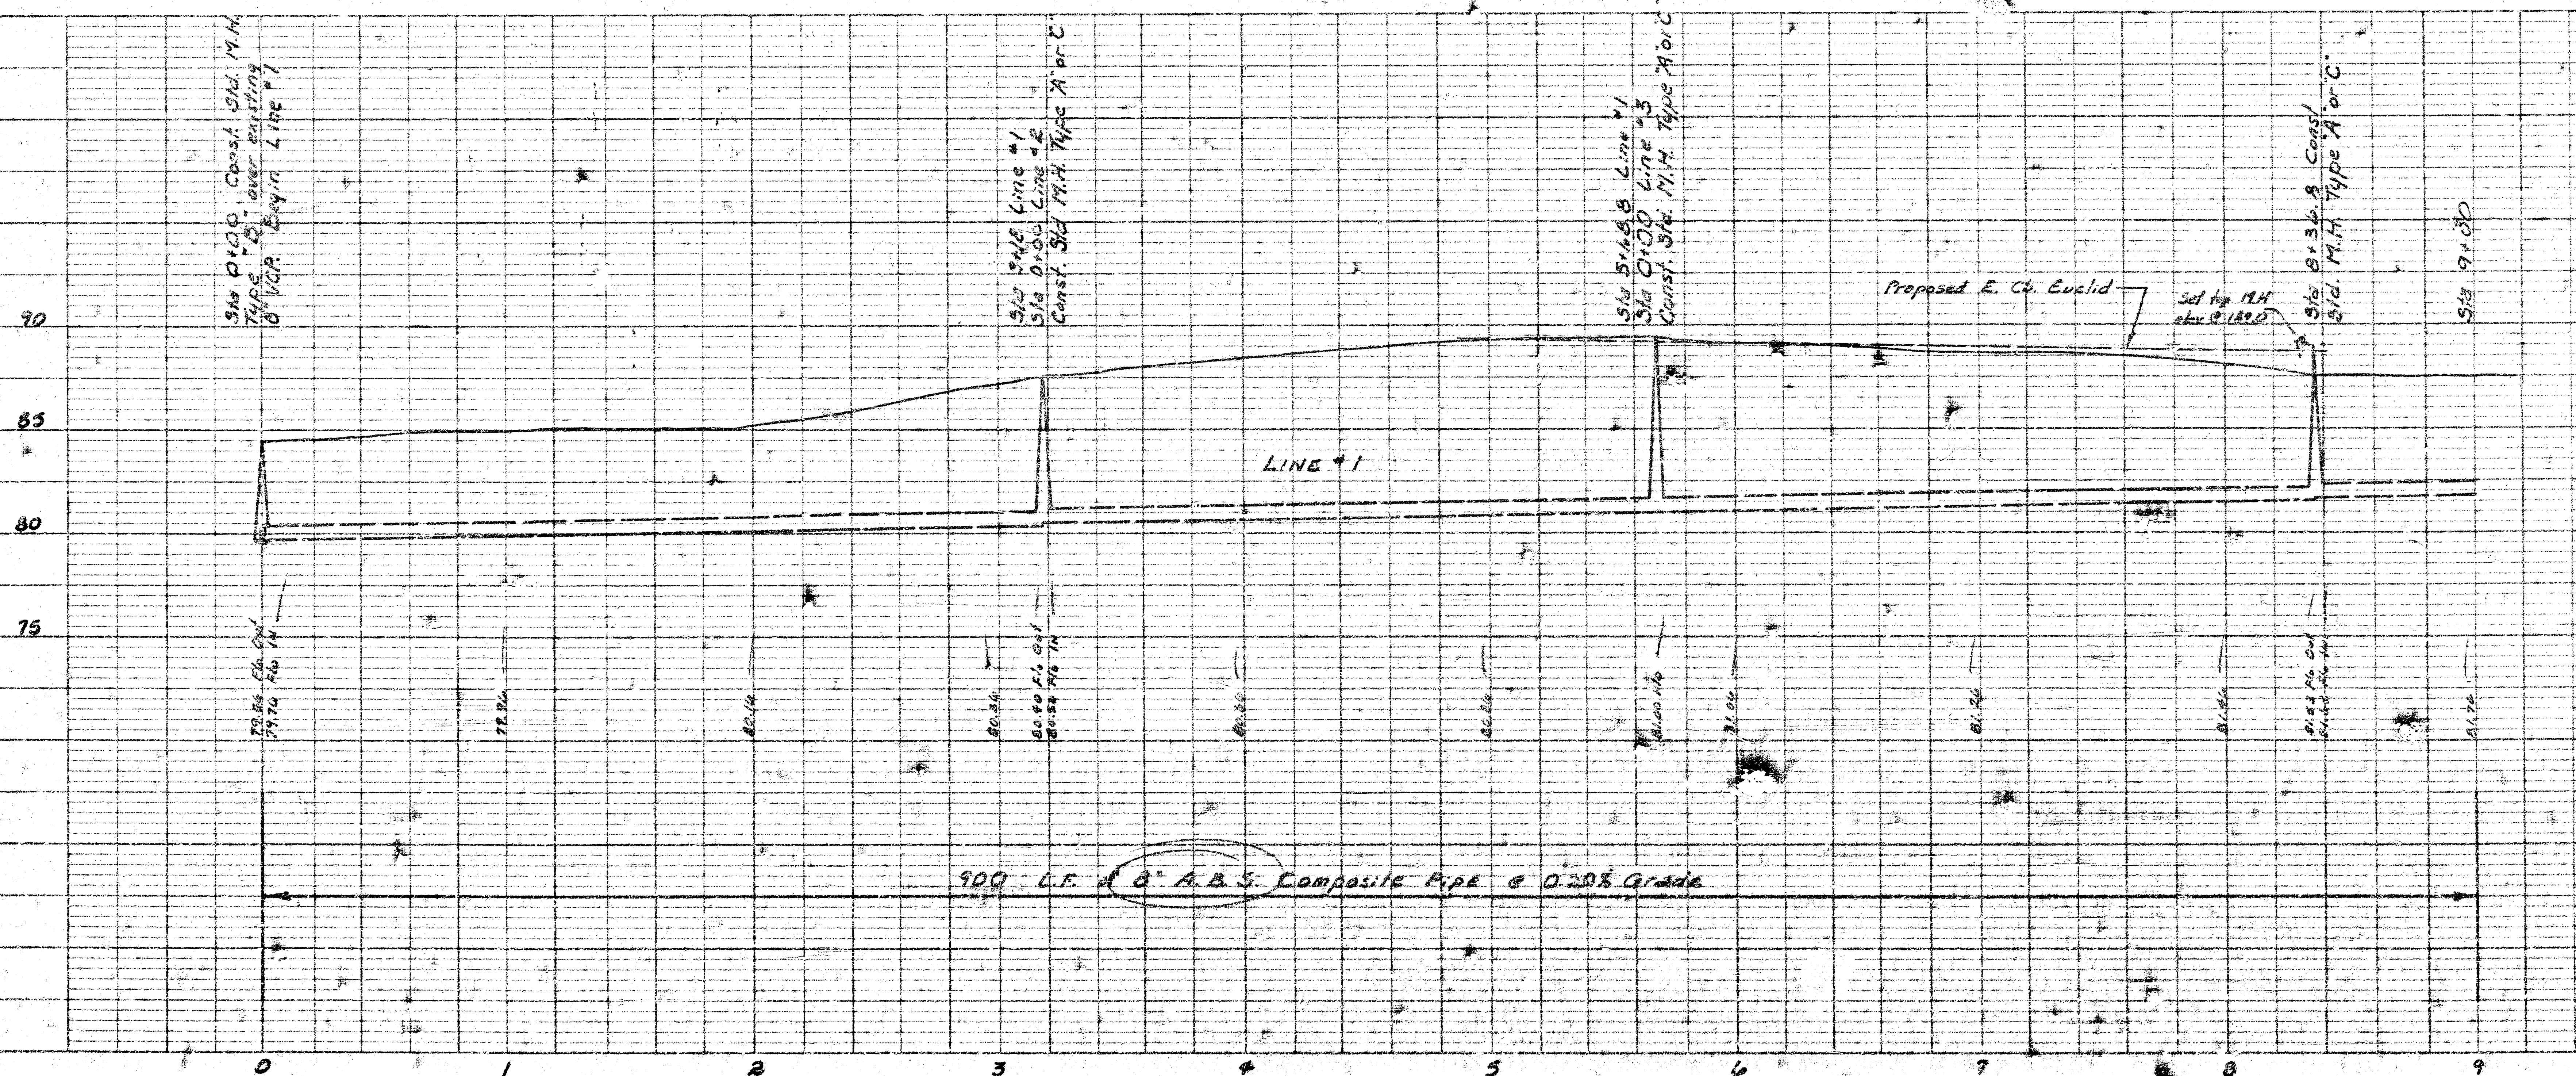

AS BUILT 4-30-79



CH 01
D 253

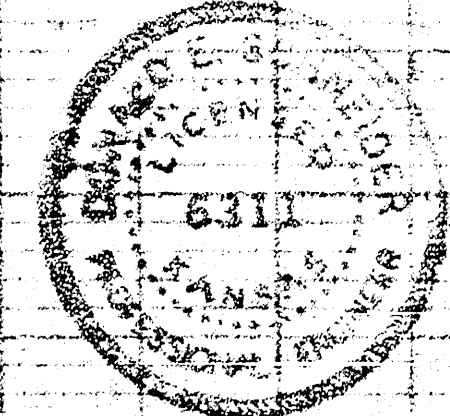

LAT 27, MAIN 3, S.W. INTERCEPT
CITY OF WICHITA, KANSAS
R. W. LINN — CITY ENGINEER


PROJECT NO. 468-76-245-80516-000-000-00

Scale Plan 1" = 40'
 Profile 1" = 40' Horiz.
 1" = 5' Vert.

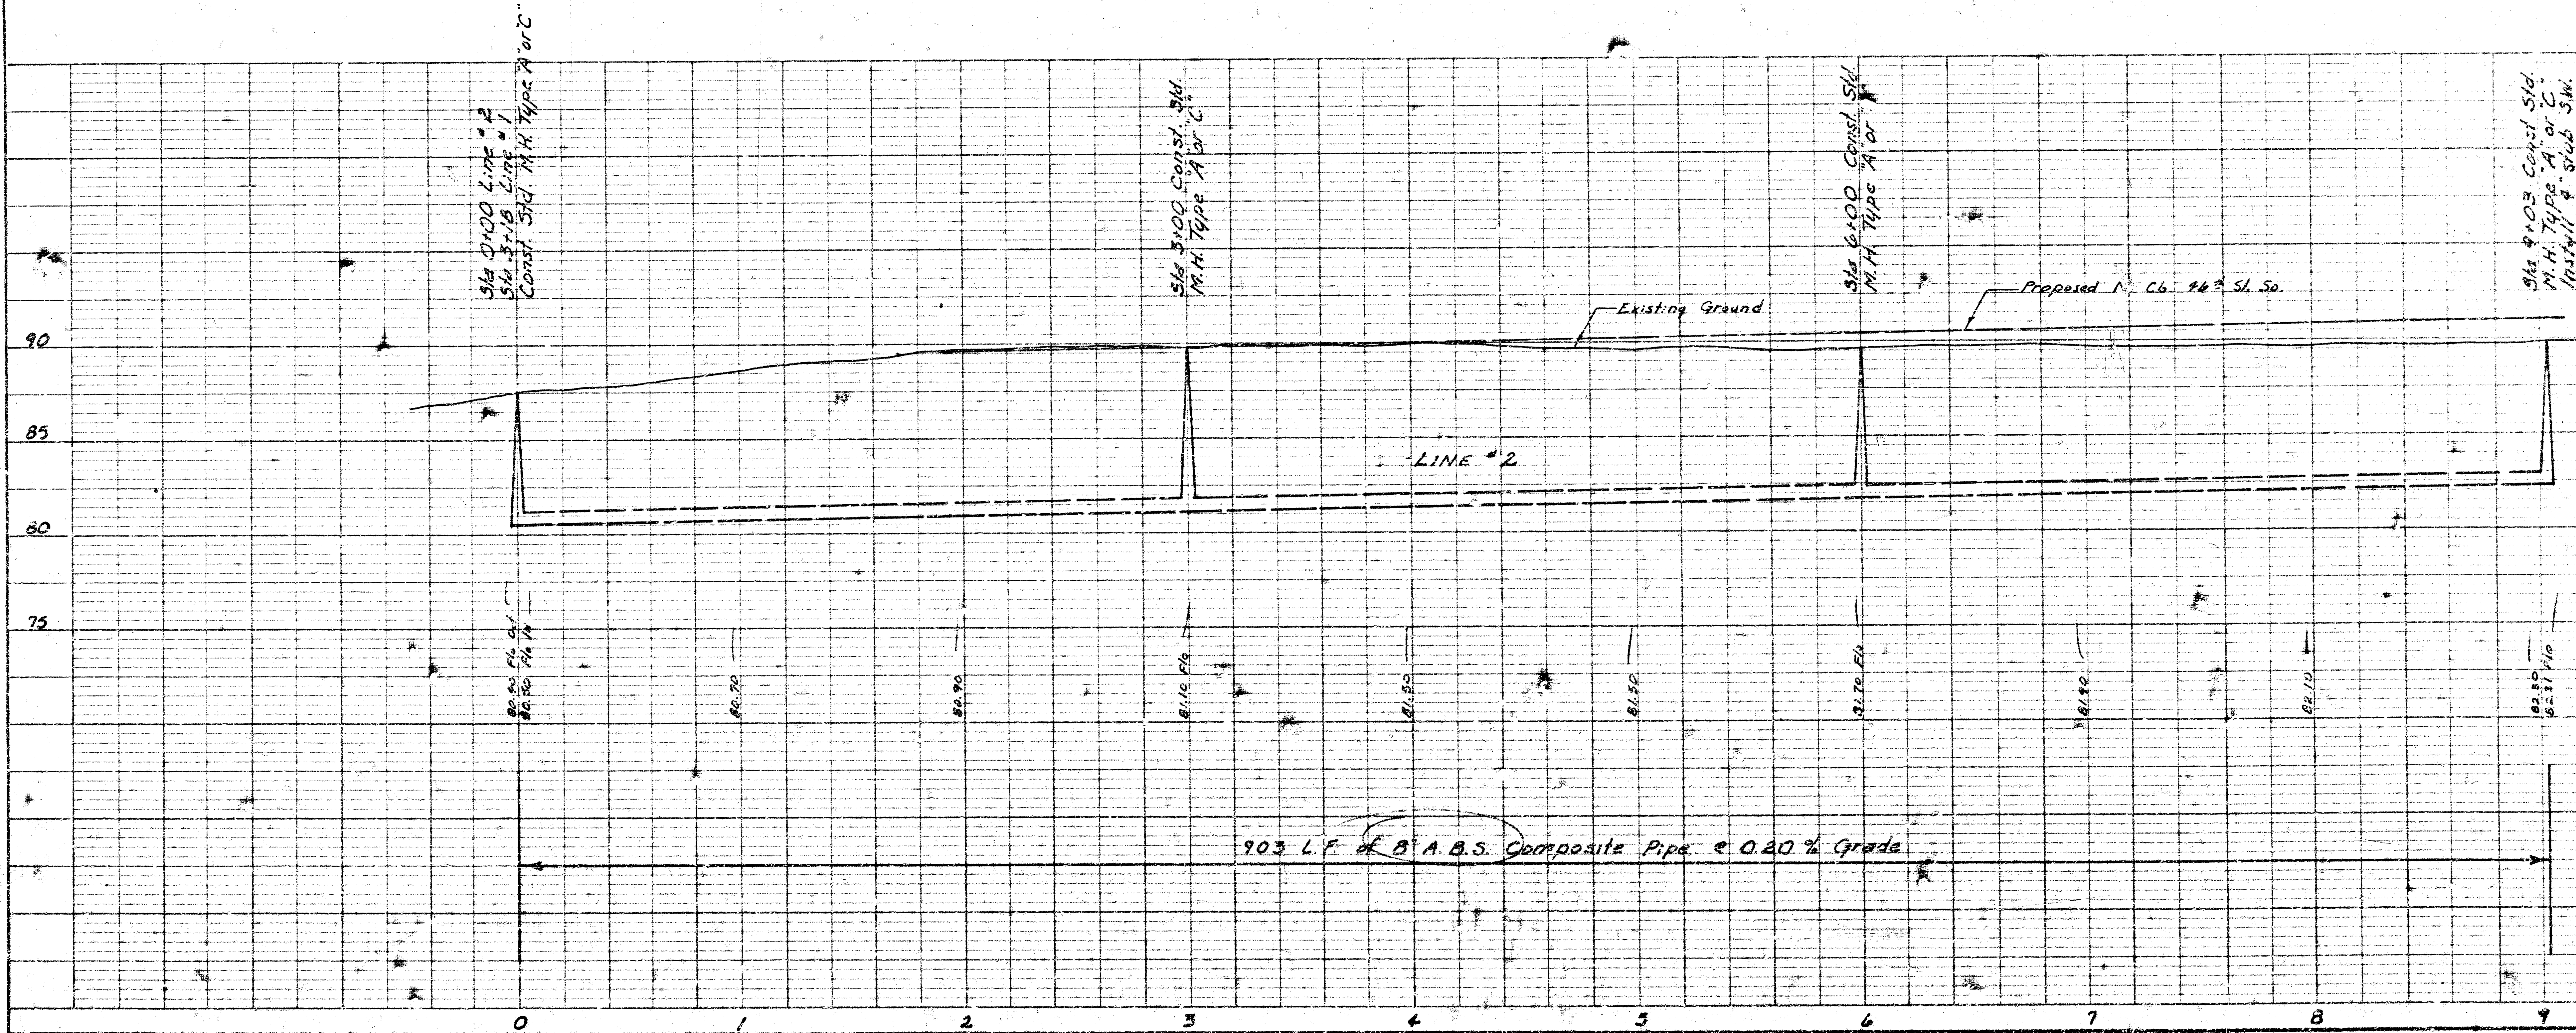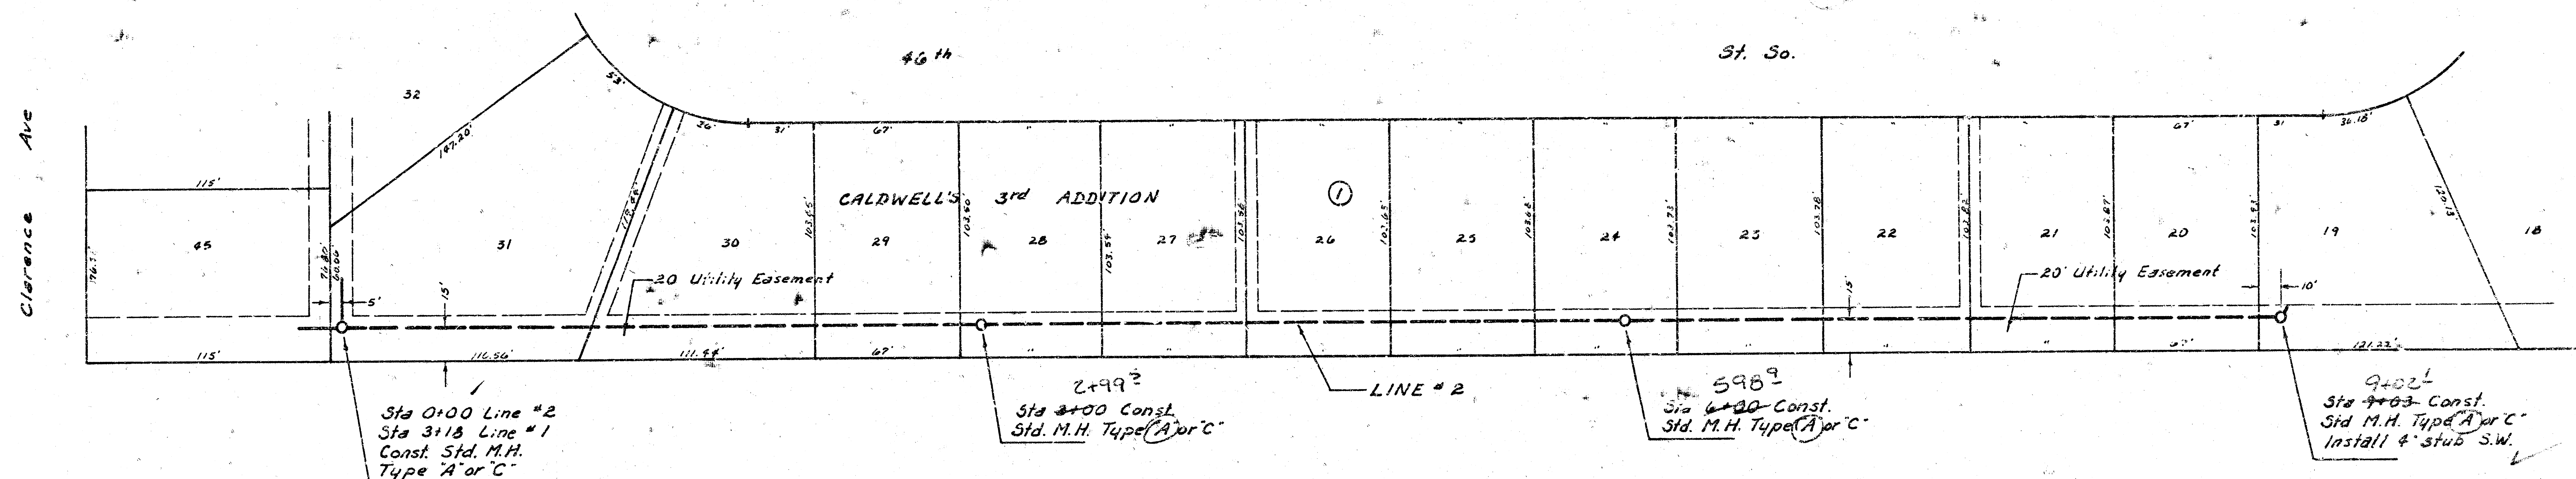


LAT 27, MAIN 3, SW. INTERCE
 Proj. No. 468-76-245-80516-000-000

NOTICE: THIS DRAWING IS THE PROPERTY OF THE ENGINEER. IT IS TO BE USED ONLY FOR THE PROJECT AND SITE SPECIFICALLY IDENTIFIED HEREON. IT IS NOT TO BE REPRODUCED, COPIED, OR TRANSMITTED IN ANY FORM OR BY ANY MEANS, ELECTRONIC OR MECHANICAL, INCLUDING PHOTOCOPYING, RECORDING, OR BY ANY INFORMATION STORAGE AND RETRIEVAL SYSTEM, WITHOUT THE WRITTEN PERMISSION OF THE ENGINEER.

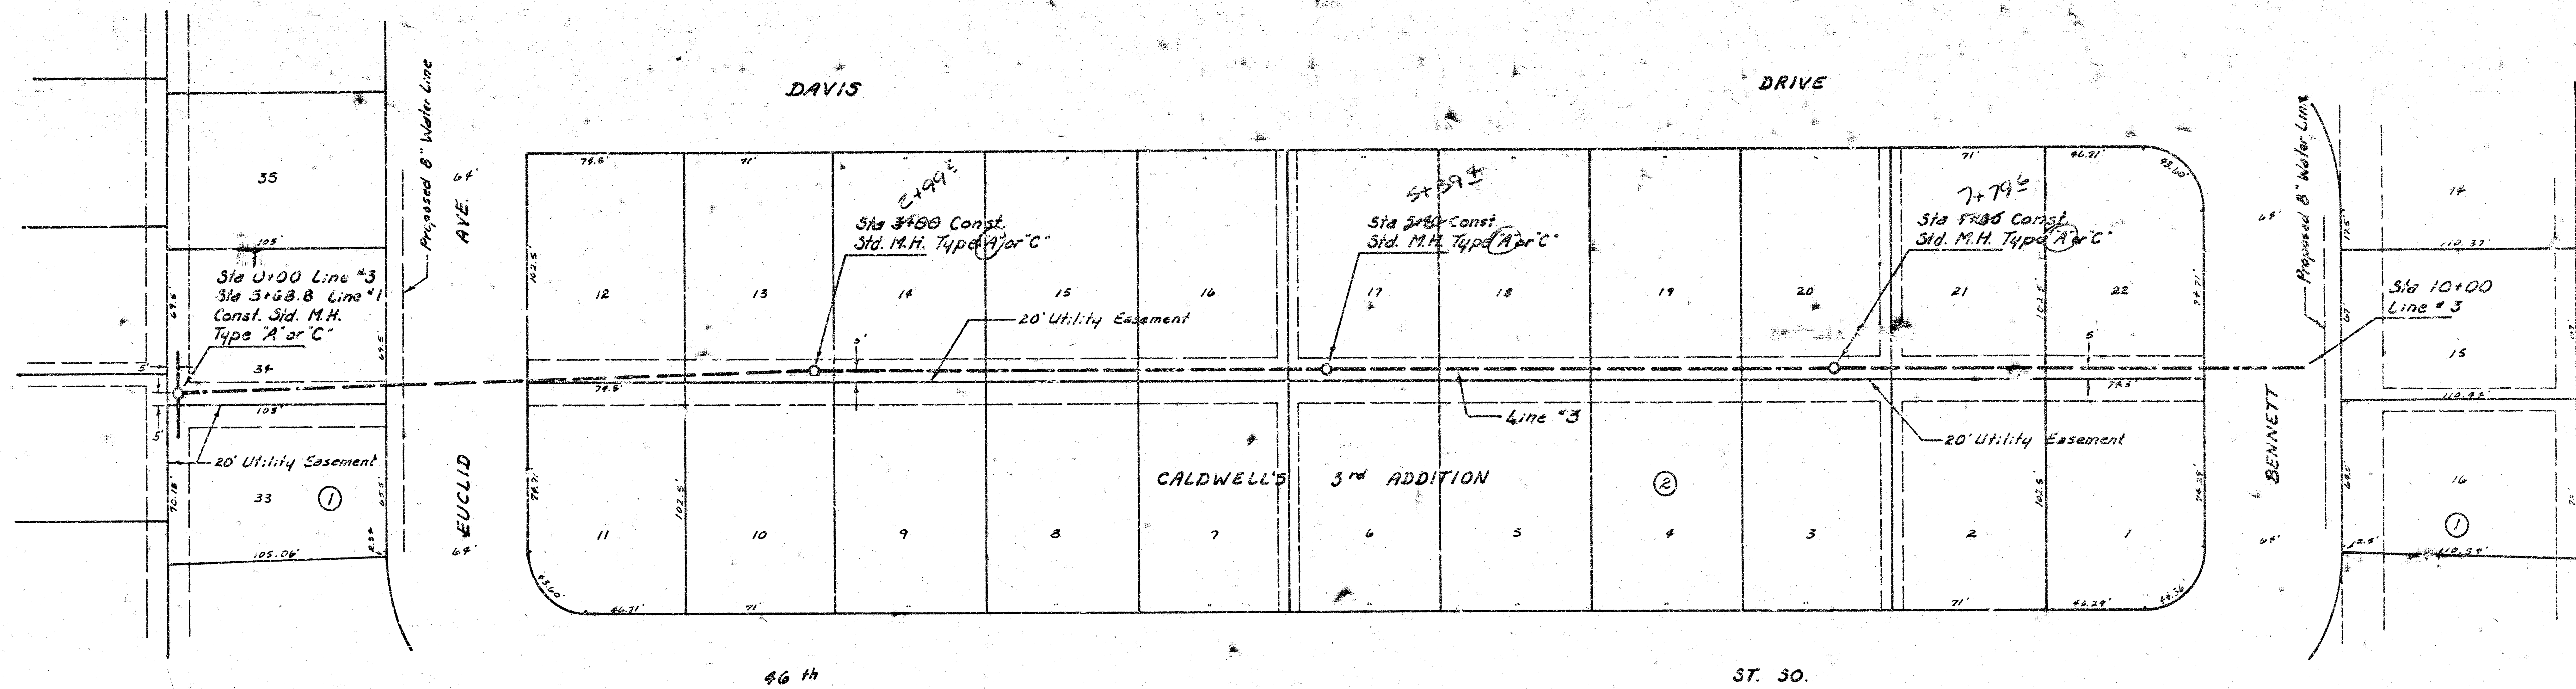


Scale: Plan 1" = 40' Profile 1" = 4'

NOTICE: THIS DRAWING IS THE PROPERTY OF THE ENGINEER. IT IS TO BE USED ONLY FOR THE PROJECT AND SITE SPECIFICALLY IDENTIFIED HEREON. IT IS NOT TO BE REPRODUCED, COPIED, OR TRANSMITTED IN ANY FORM OR BY ANY MEANS, ELECTRONIC OR MECHANICAL, INCLUDING PHOTOCOPYING, RECORDING, OR BY ANY INFORMATION STORAGE AND RETRIEVAL SYSTEM, WITHOUT THE WRITTEN PERMISSION OF THE ENGINEER.

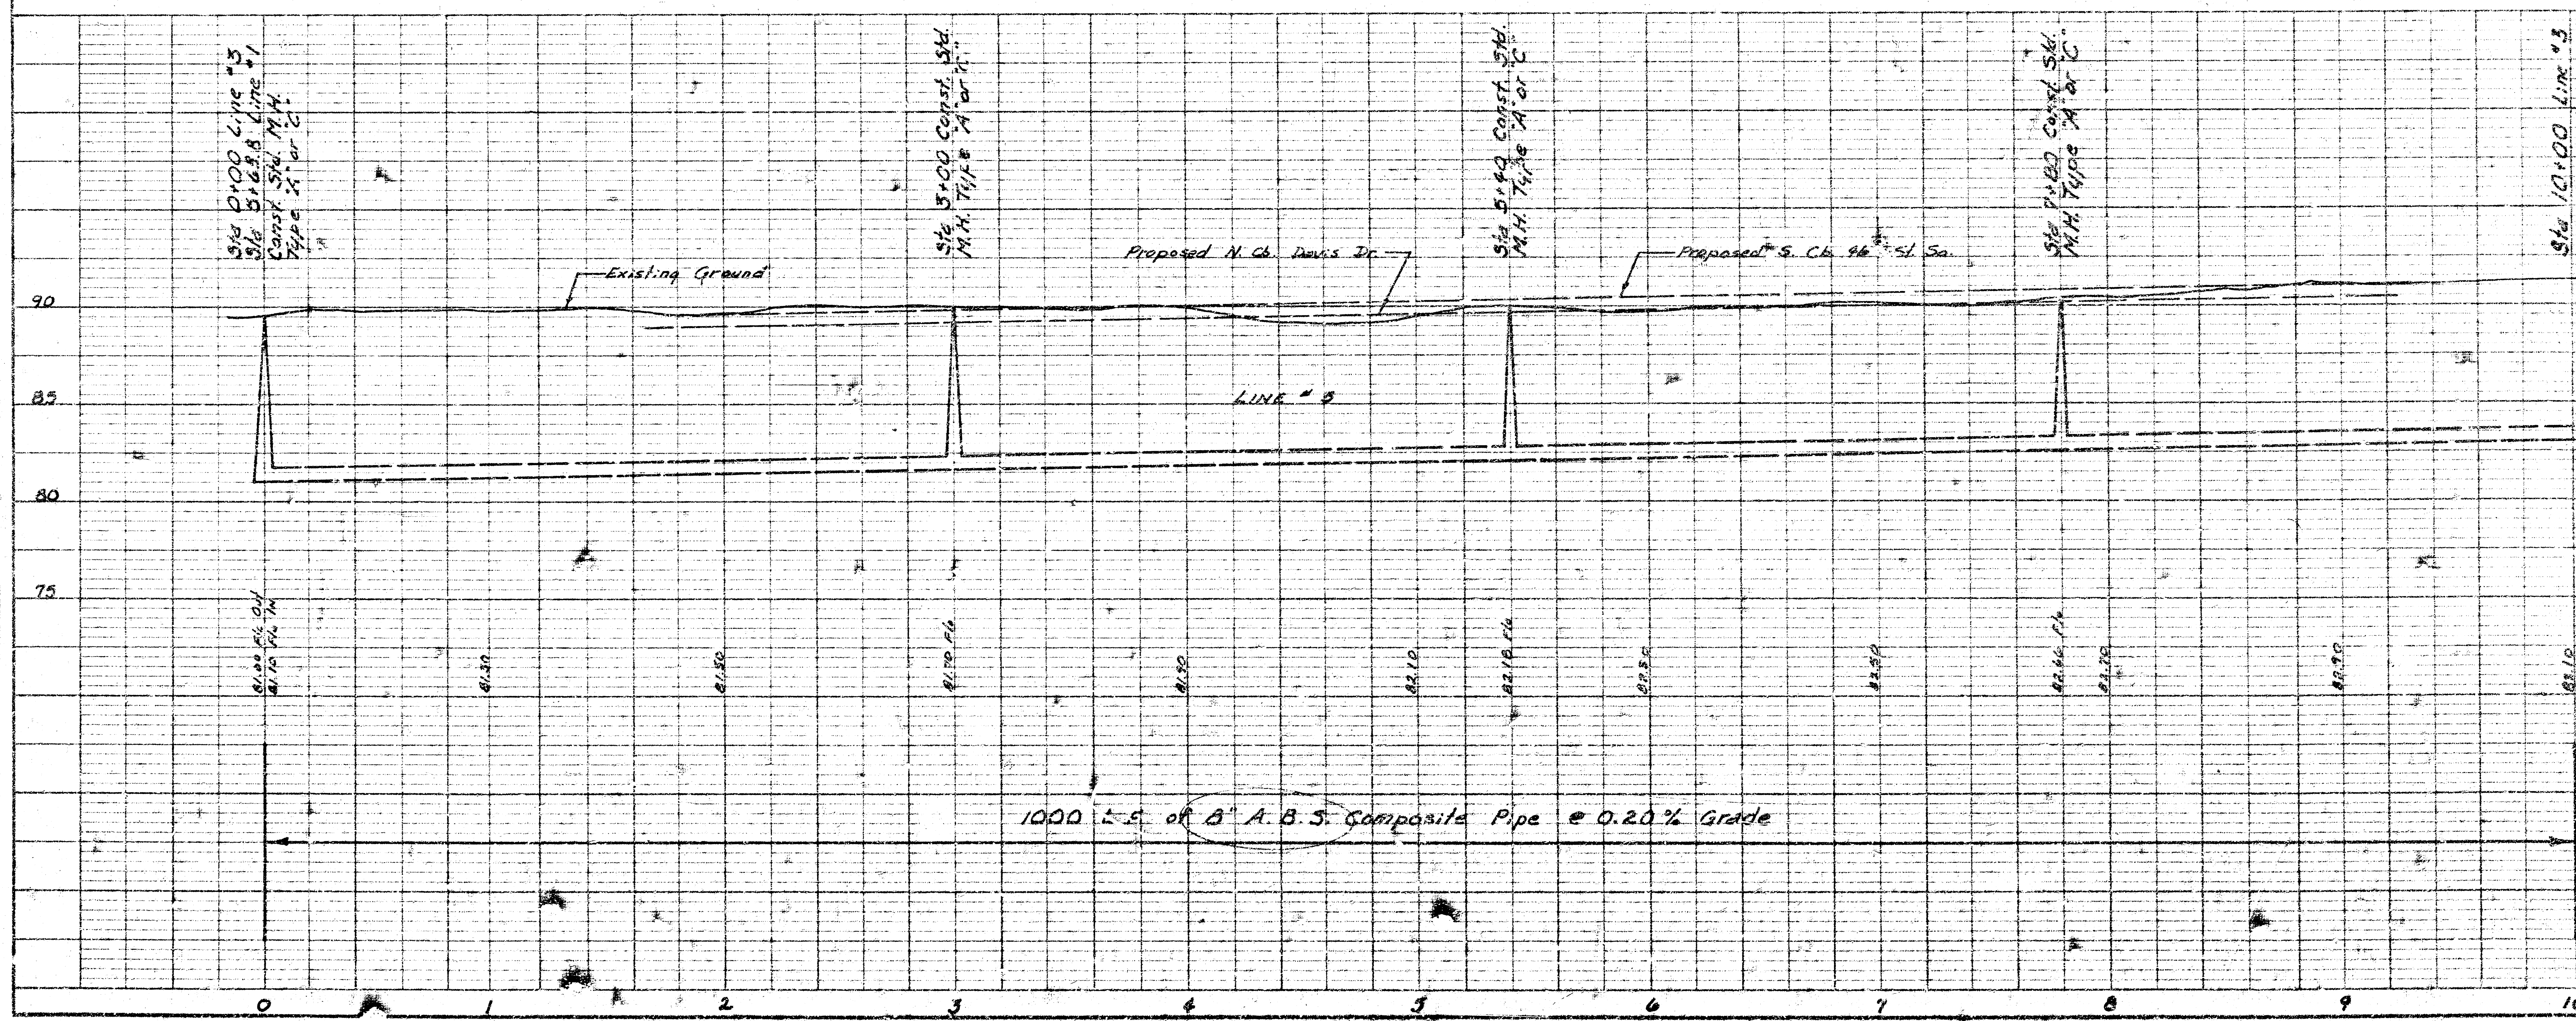

NOTE BOOK
No. 1
DATE
BY
CHECKED
BY

NOTE BOOK
No. 2
DATE
BY
CHECKED
BY

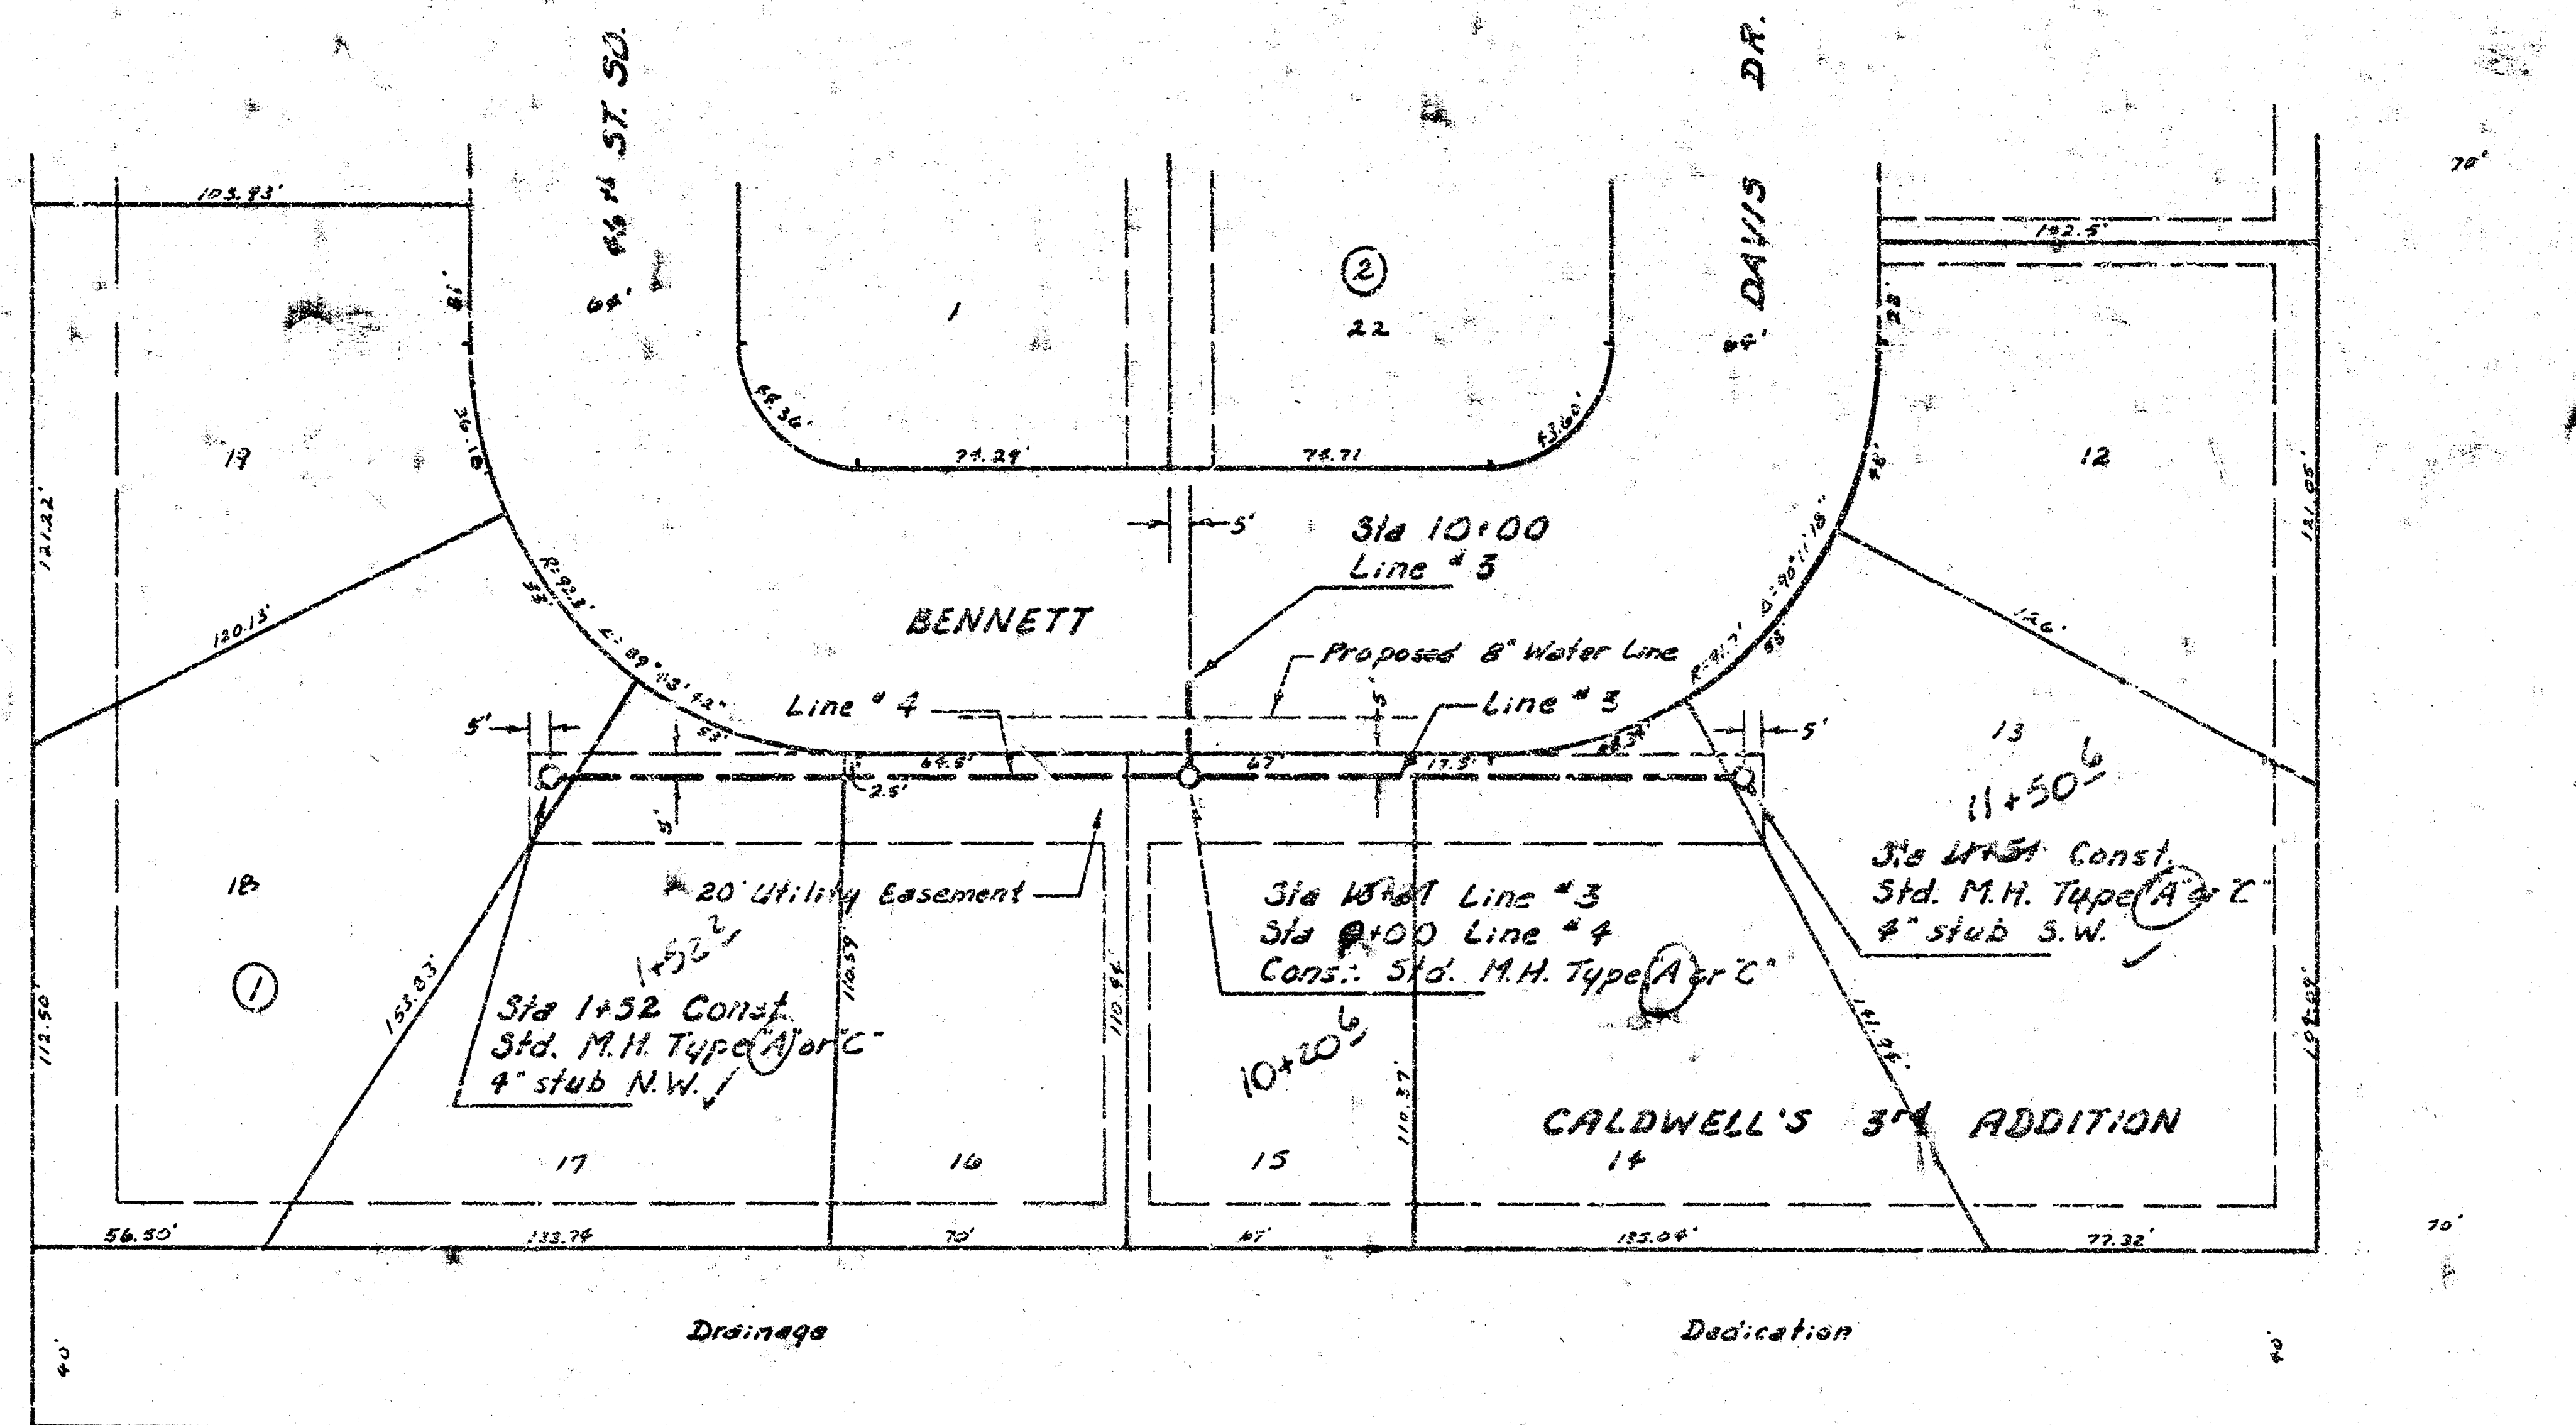

Scale Plan 1" = 40'
Profile 1" = 40' Horiz.
1" = 5' Vert.

