
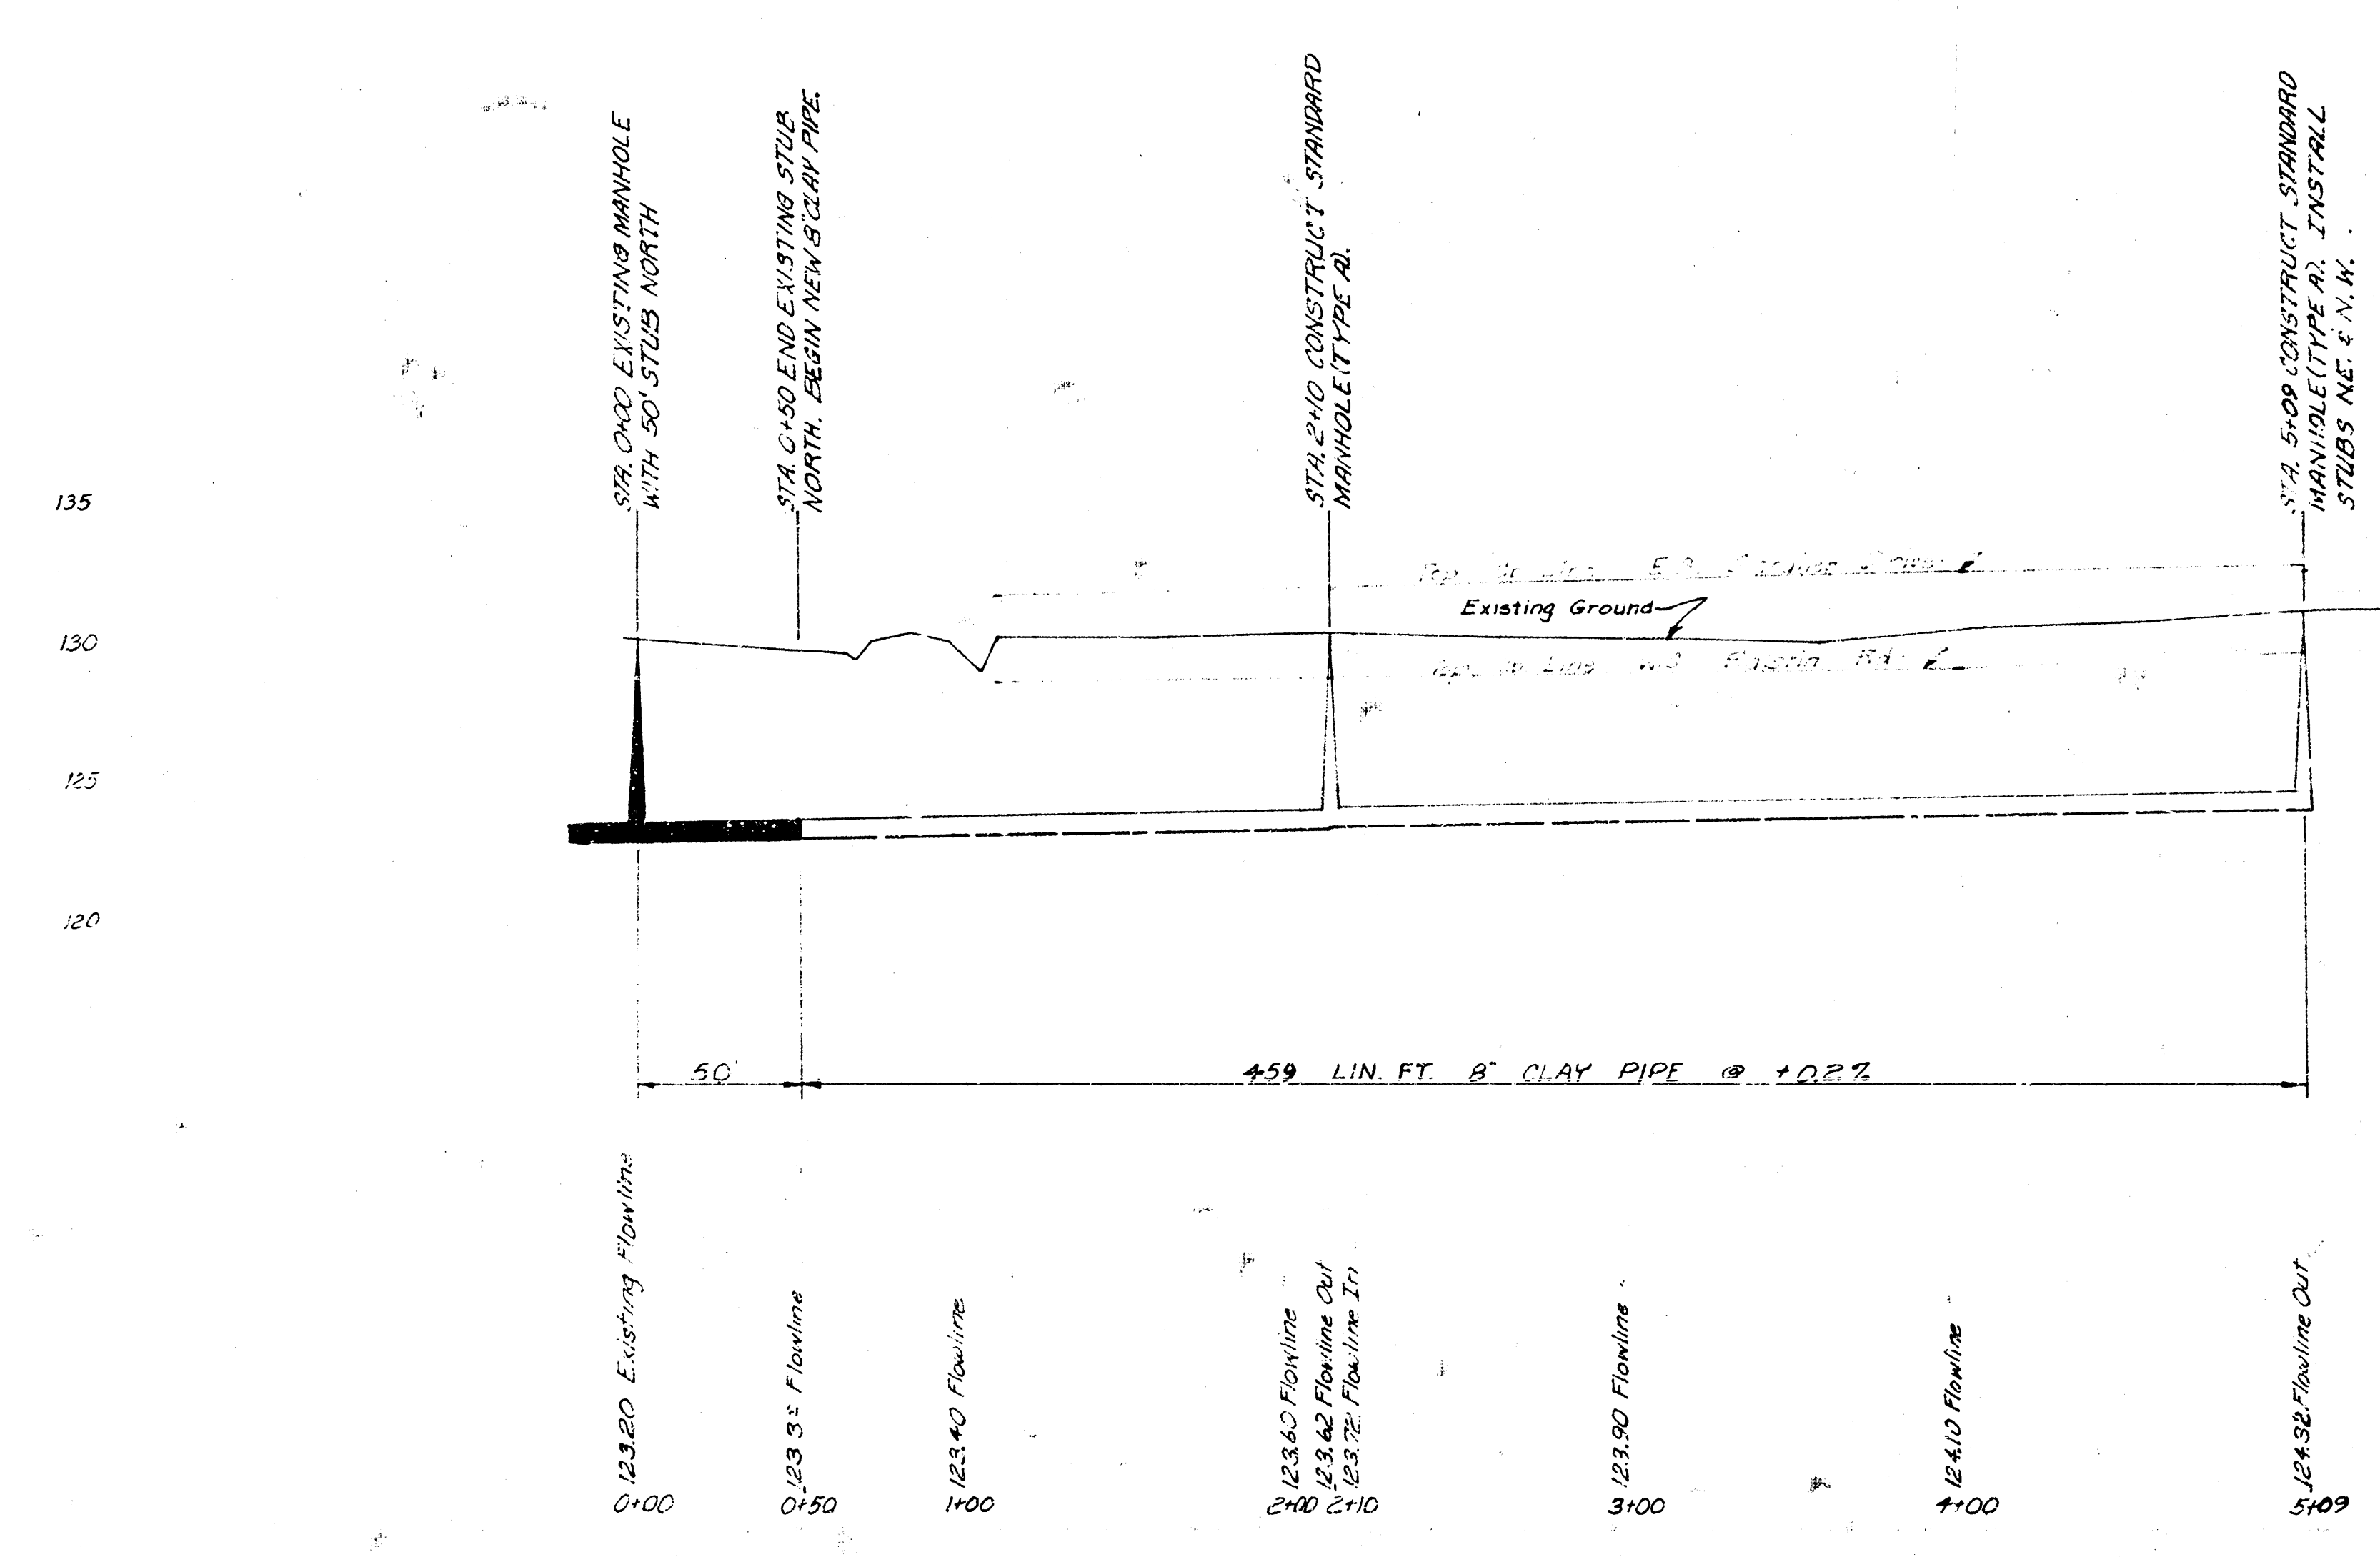


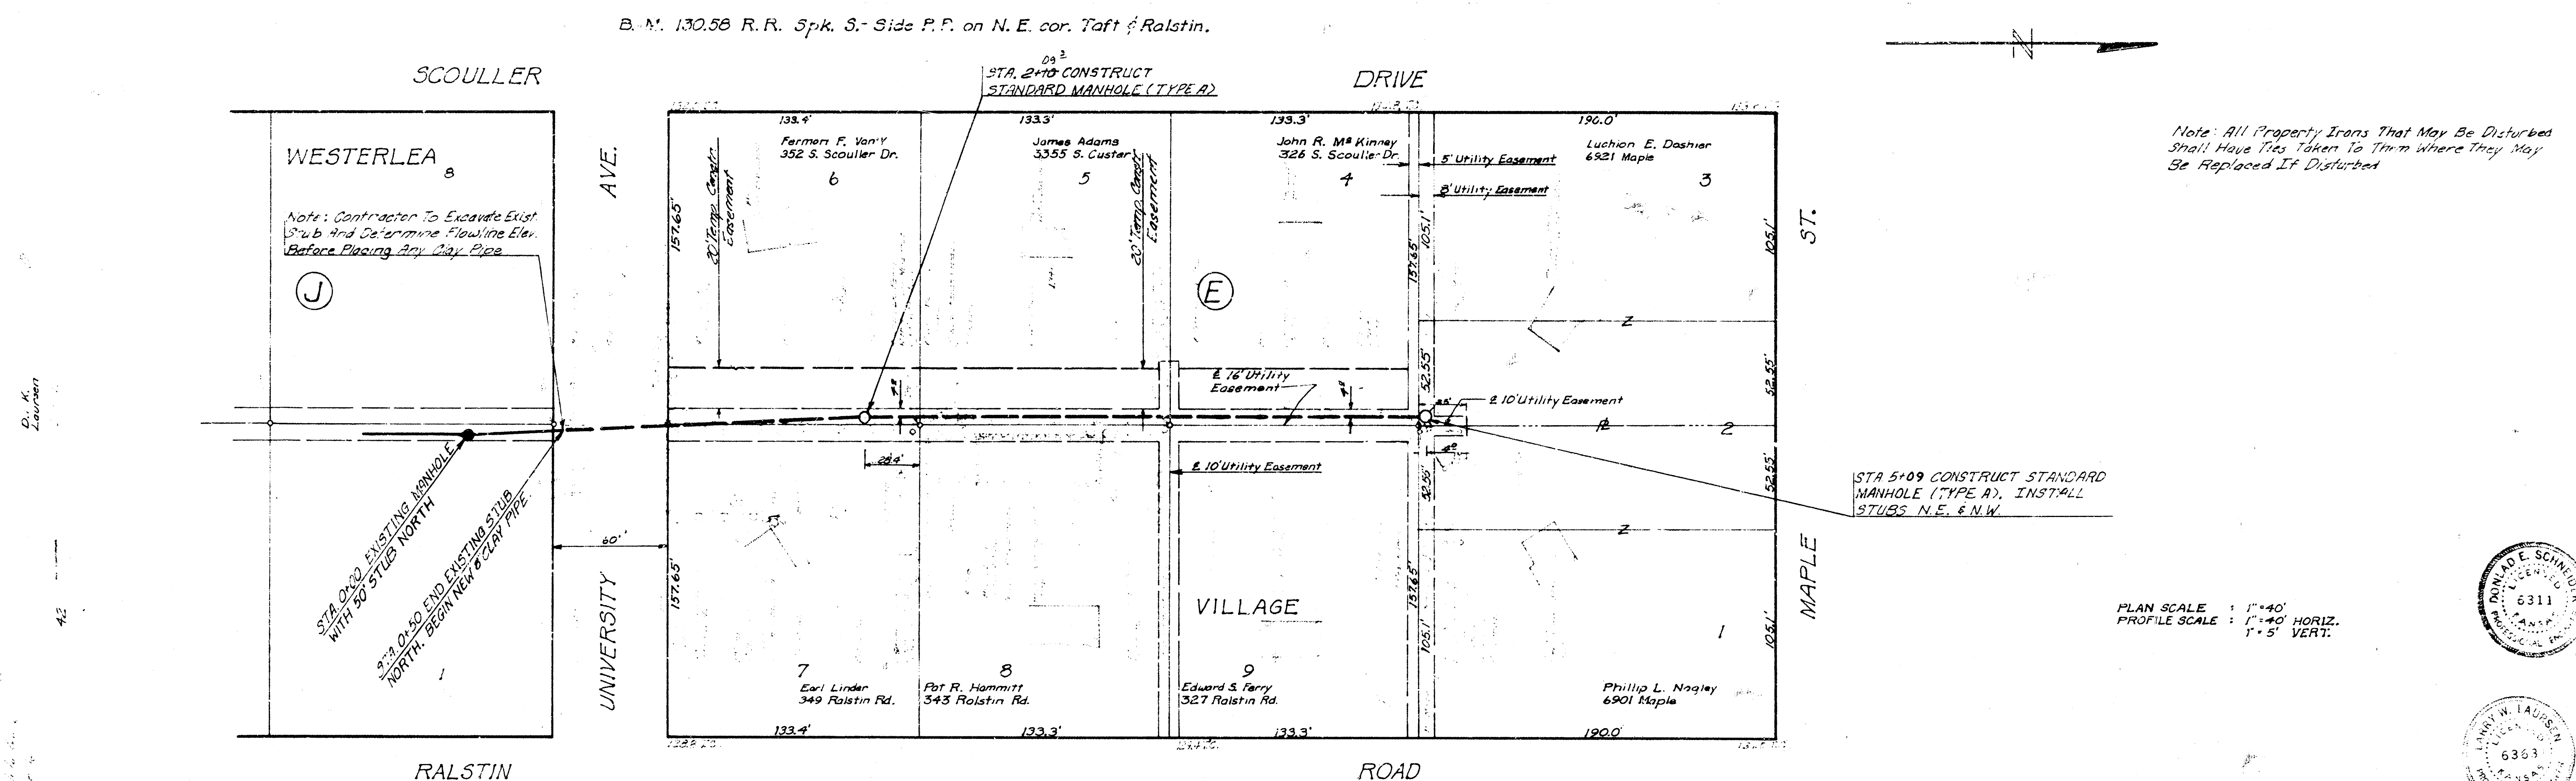

As Built From Measurements 10-10-03

LAT. 5, MAIN 4, S.W. INTERCEPT SEWER

CITY OF WICHITA, KANSAS

R. W. LINN — CITY ENGINEER

SEPT. 1972 PROJECT NO. DBKL 571028