
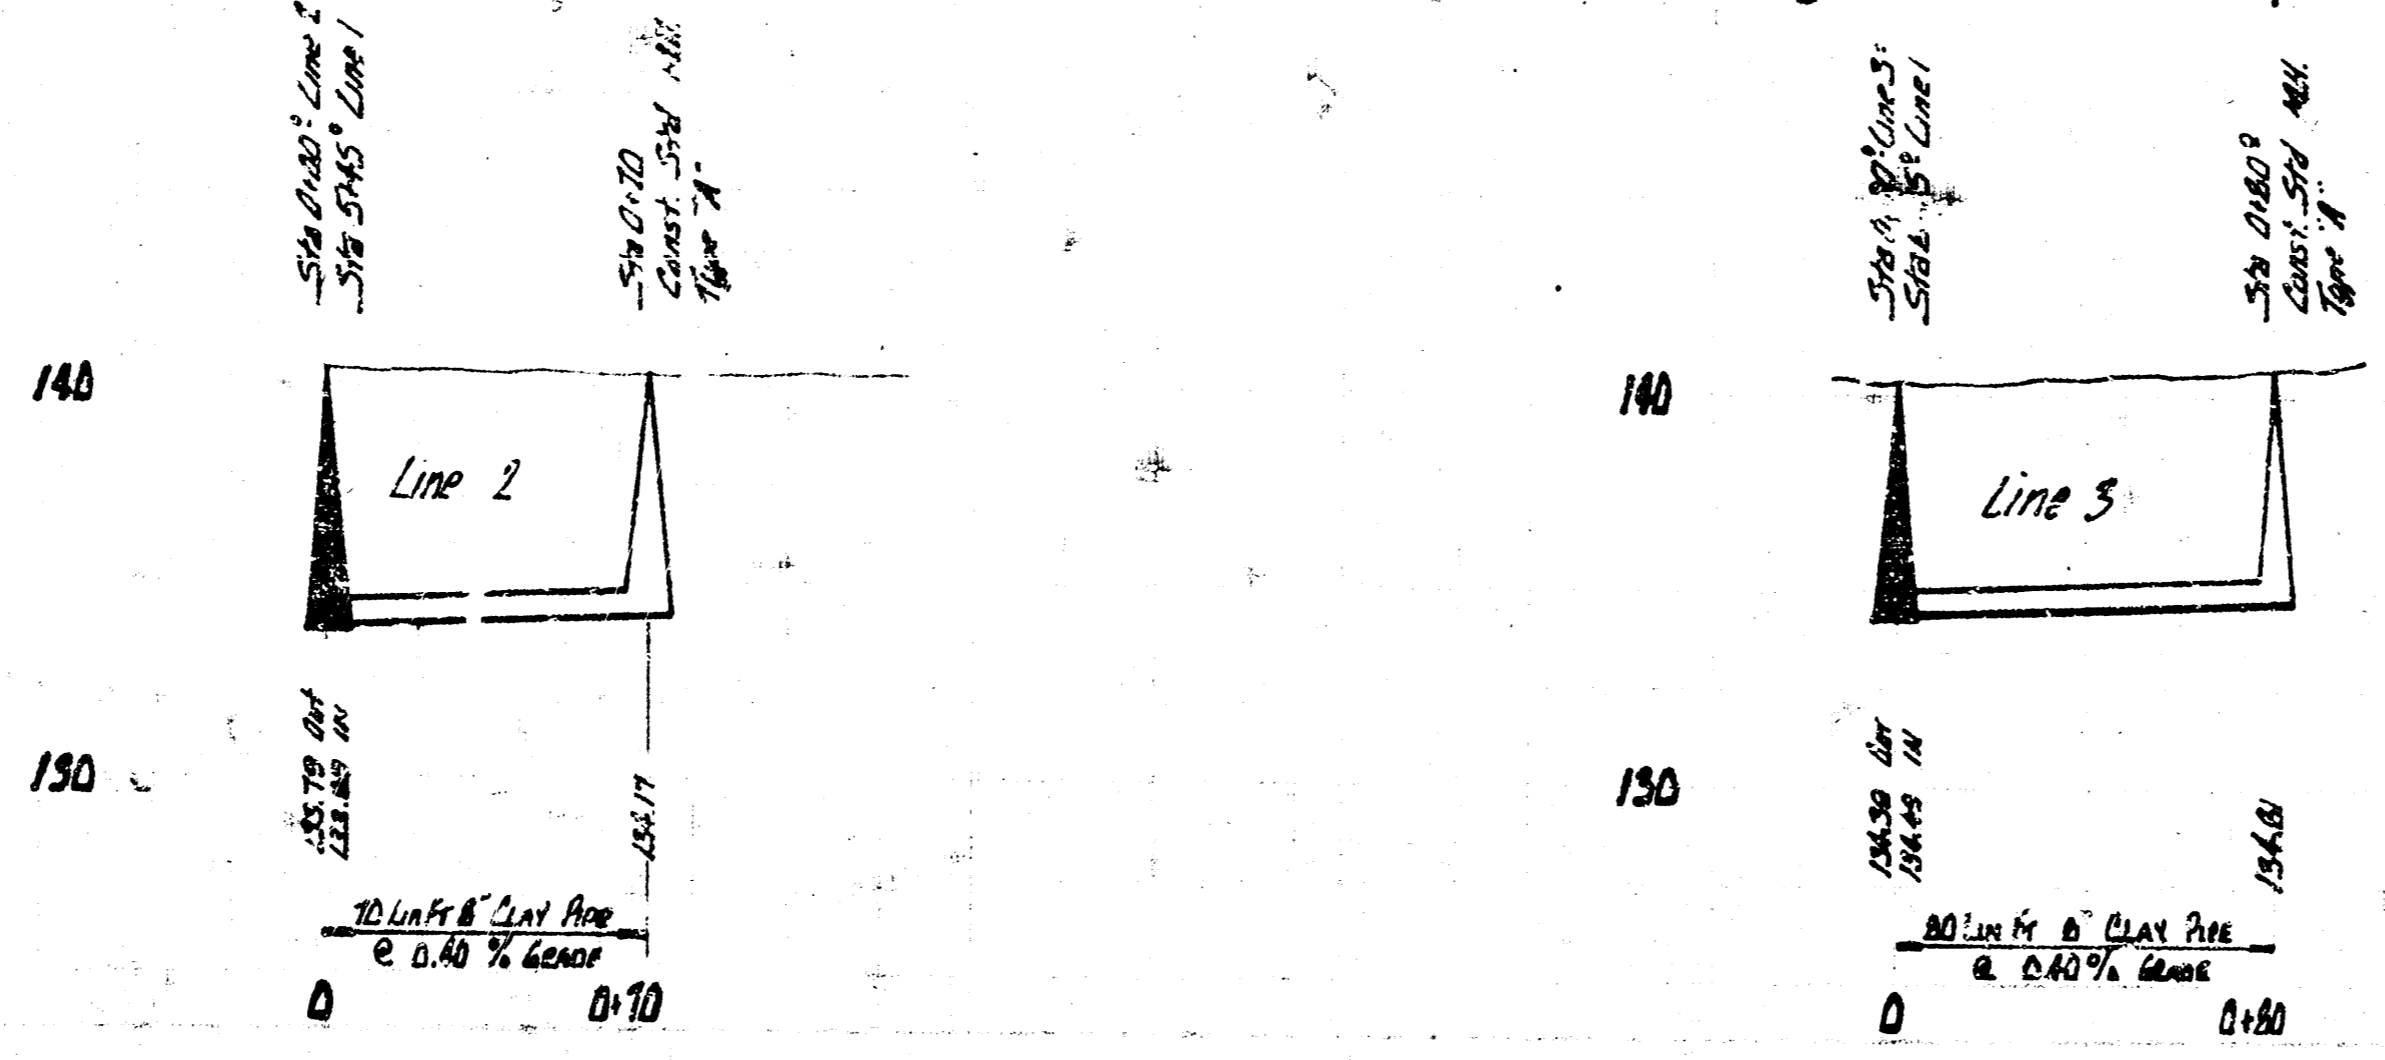
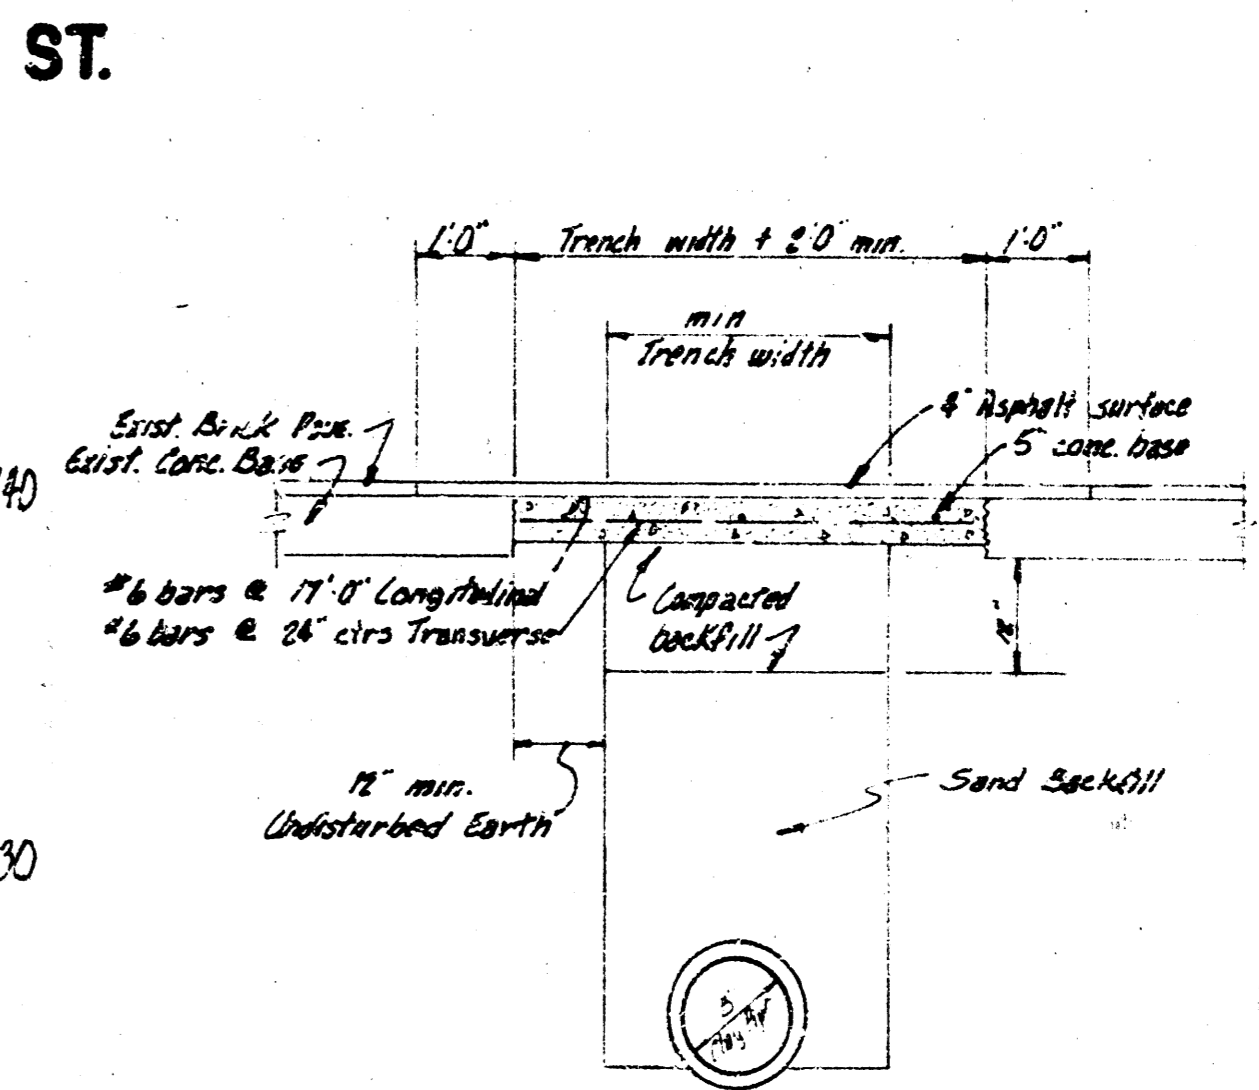


PLAN SCALE 1" = 40'
 PROFILE SCALE 1" = 40' HORIZ.
 1" = 5' VERT.

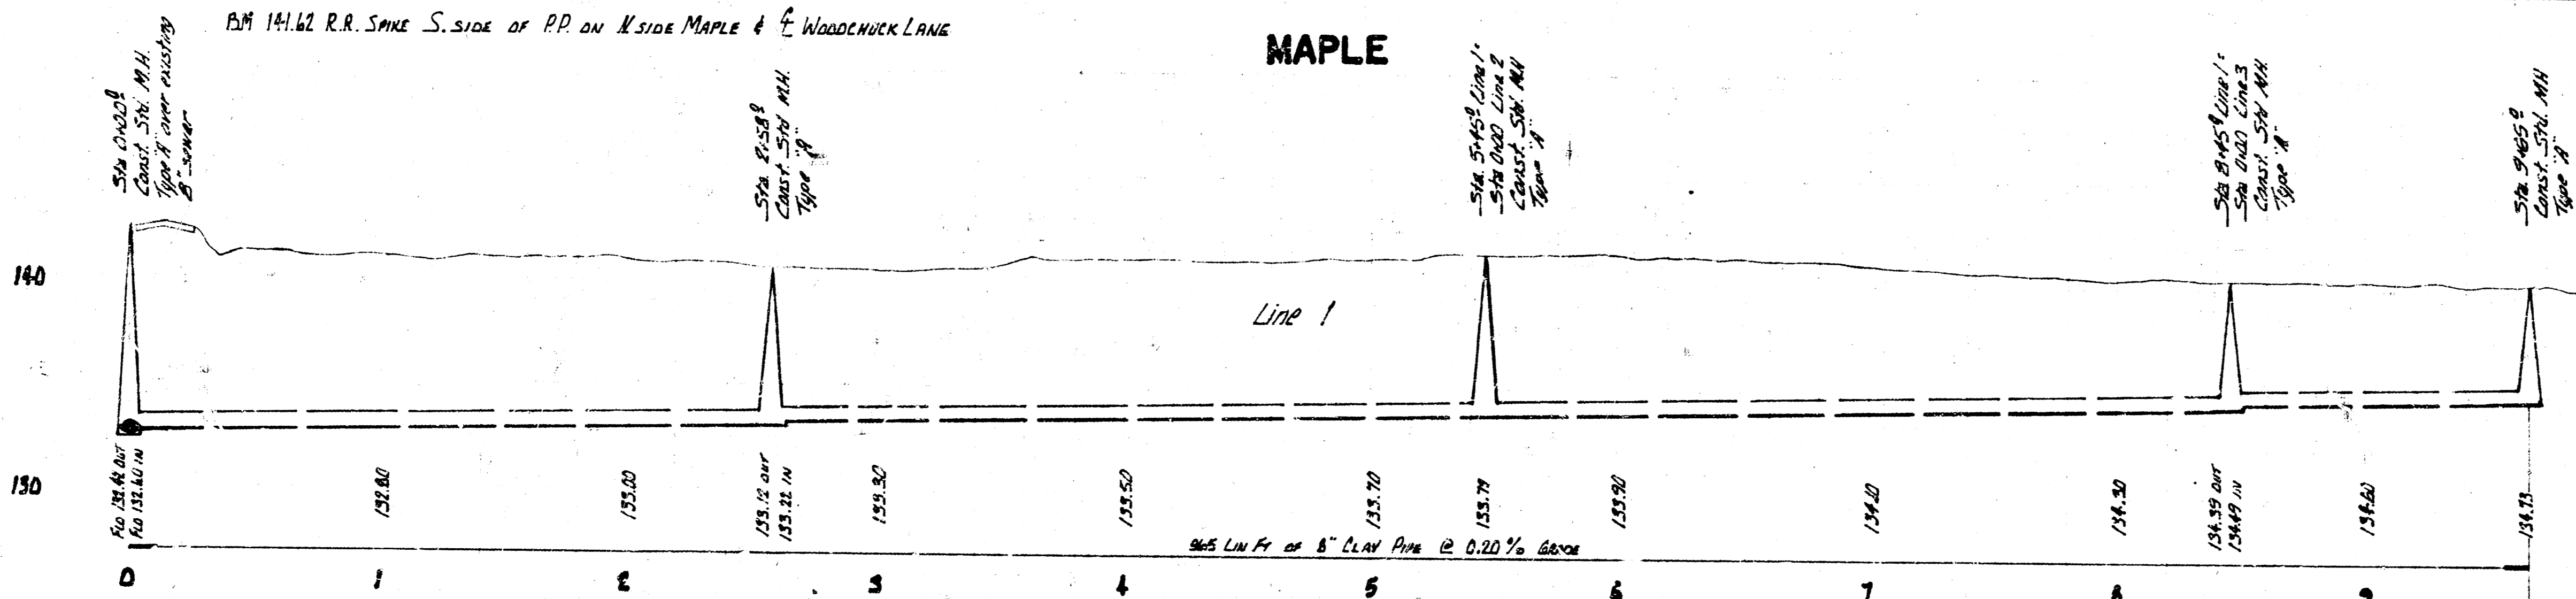

As Built Plan 14 Sept 73 From K-105
LAT 6, MAIN 4, S.W. INT.
 CITY OF WICHITA, KANSAS
 R.W. LINN, City Engineer
 PROJECT NO. DBKL571036
 Date: July 1973