


776-180


Exist. 40' stub removed and replaced

UNPLATTED

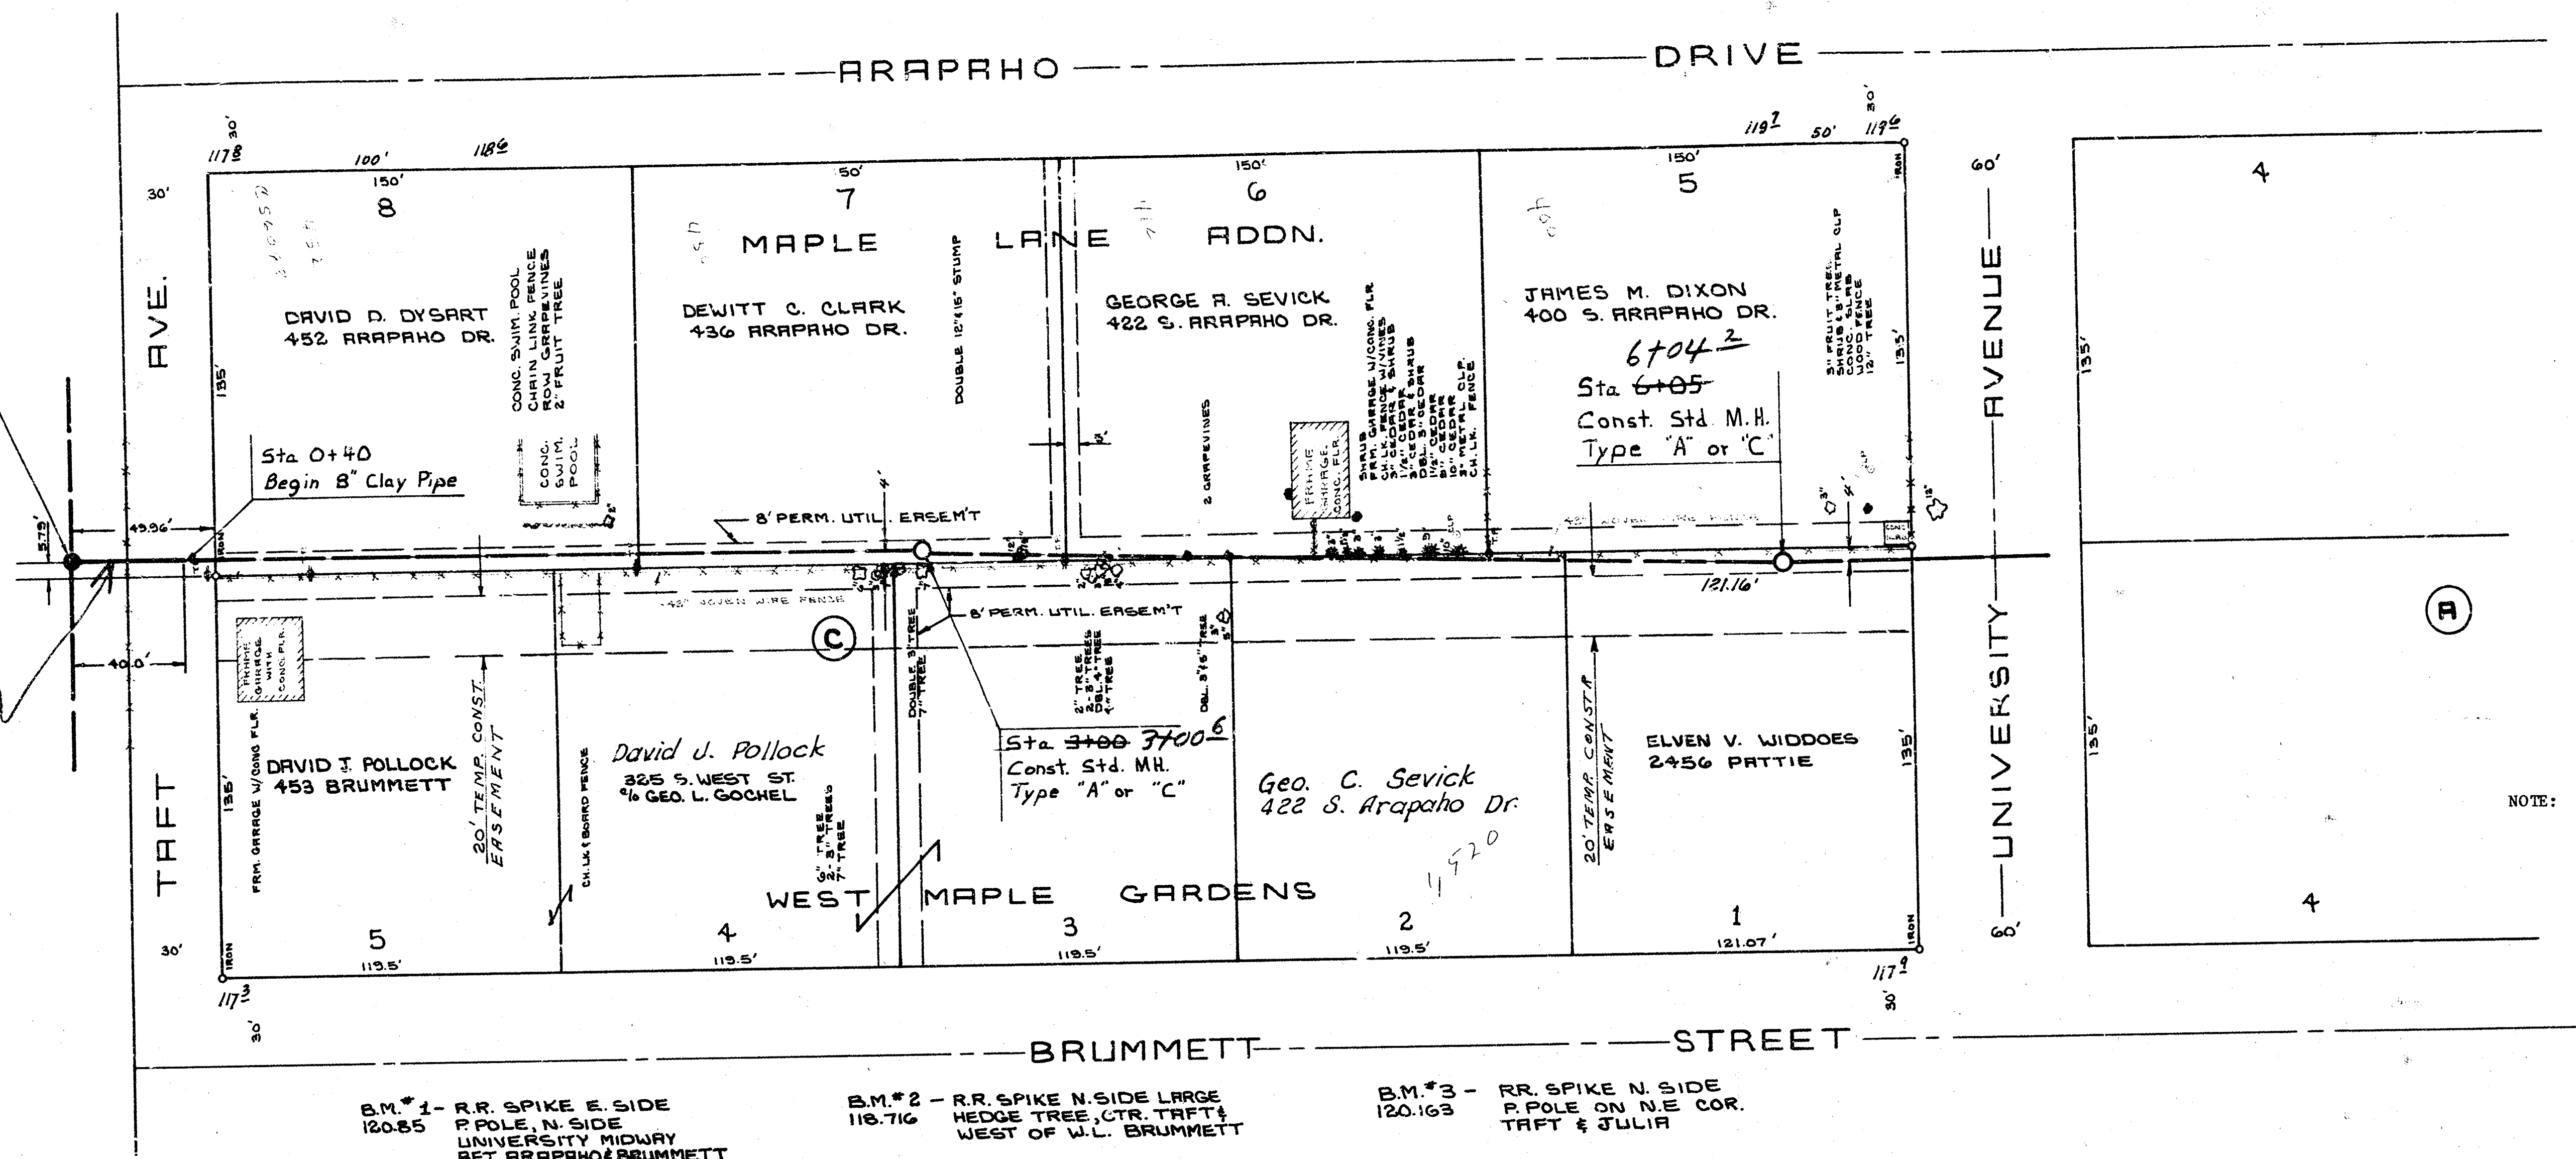


SCALE
VERTICAL ~ 1" = 5'
HORIZONTAL ~ 1" = 40'

NOTE: ALL FENCES REMOVED BY THE CONTRACTOR TO FACILITATE CONSTRUCTION OF THE SANITARY SEWER SHALL BE REPLACED.

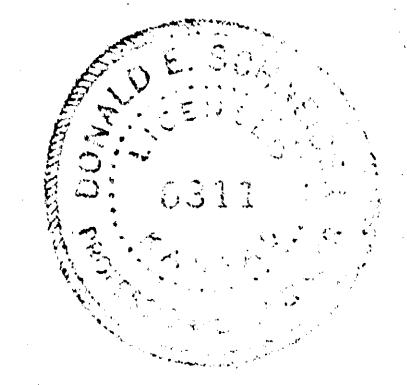


125
120
115
110
105
100


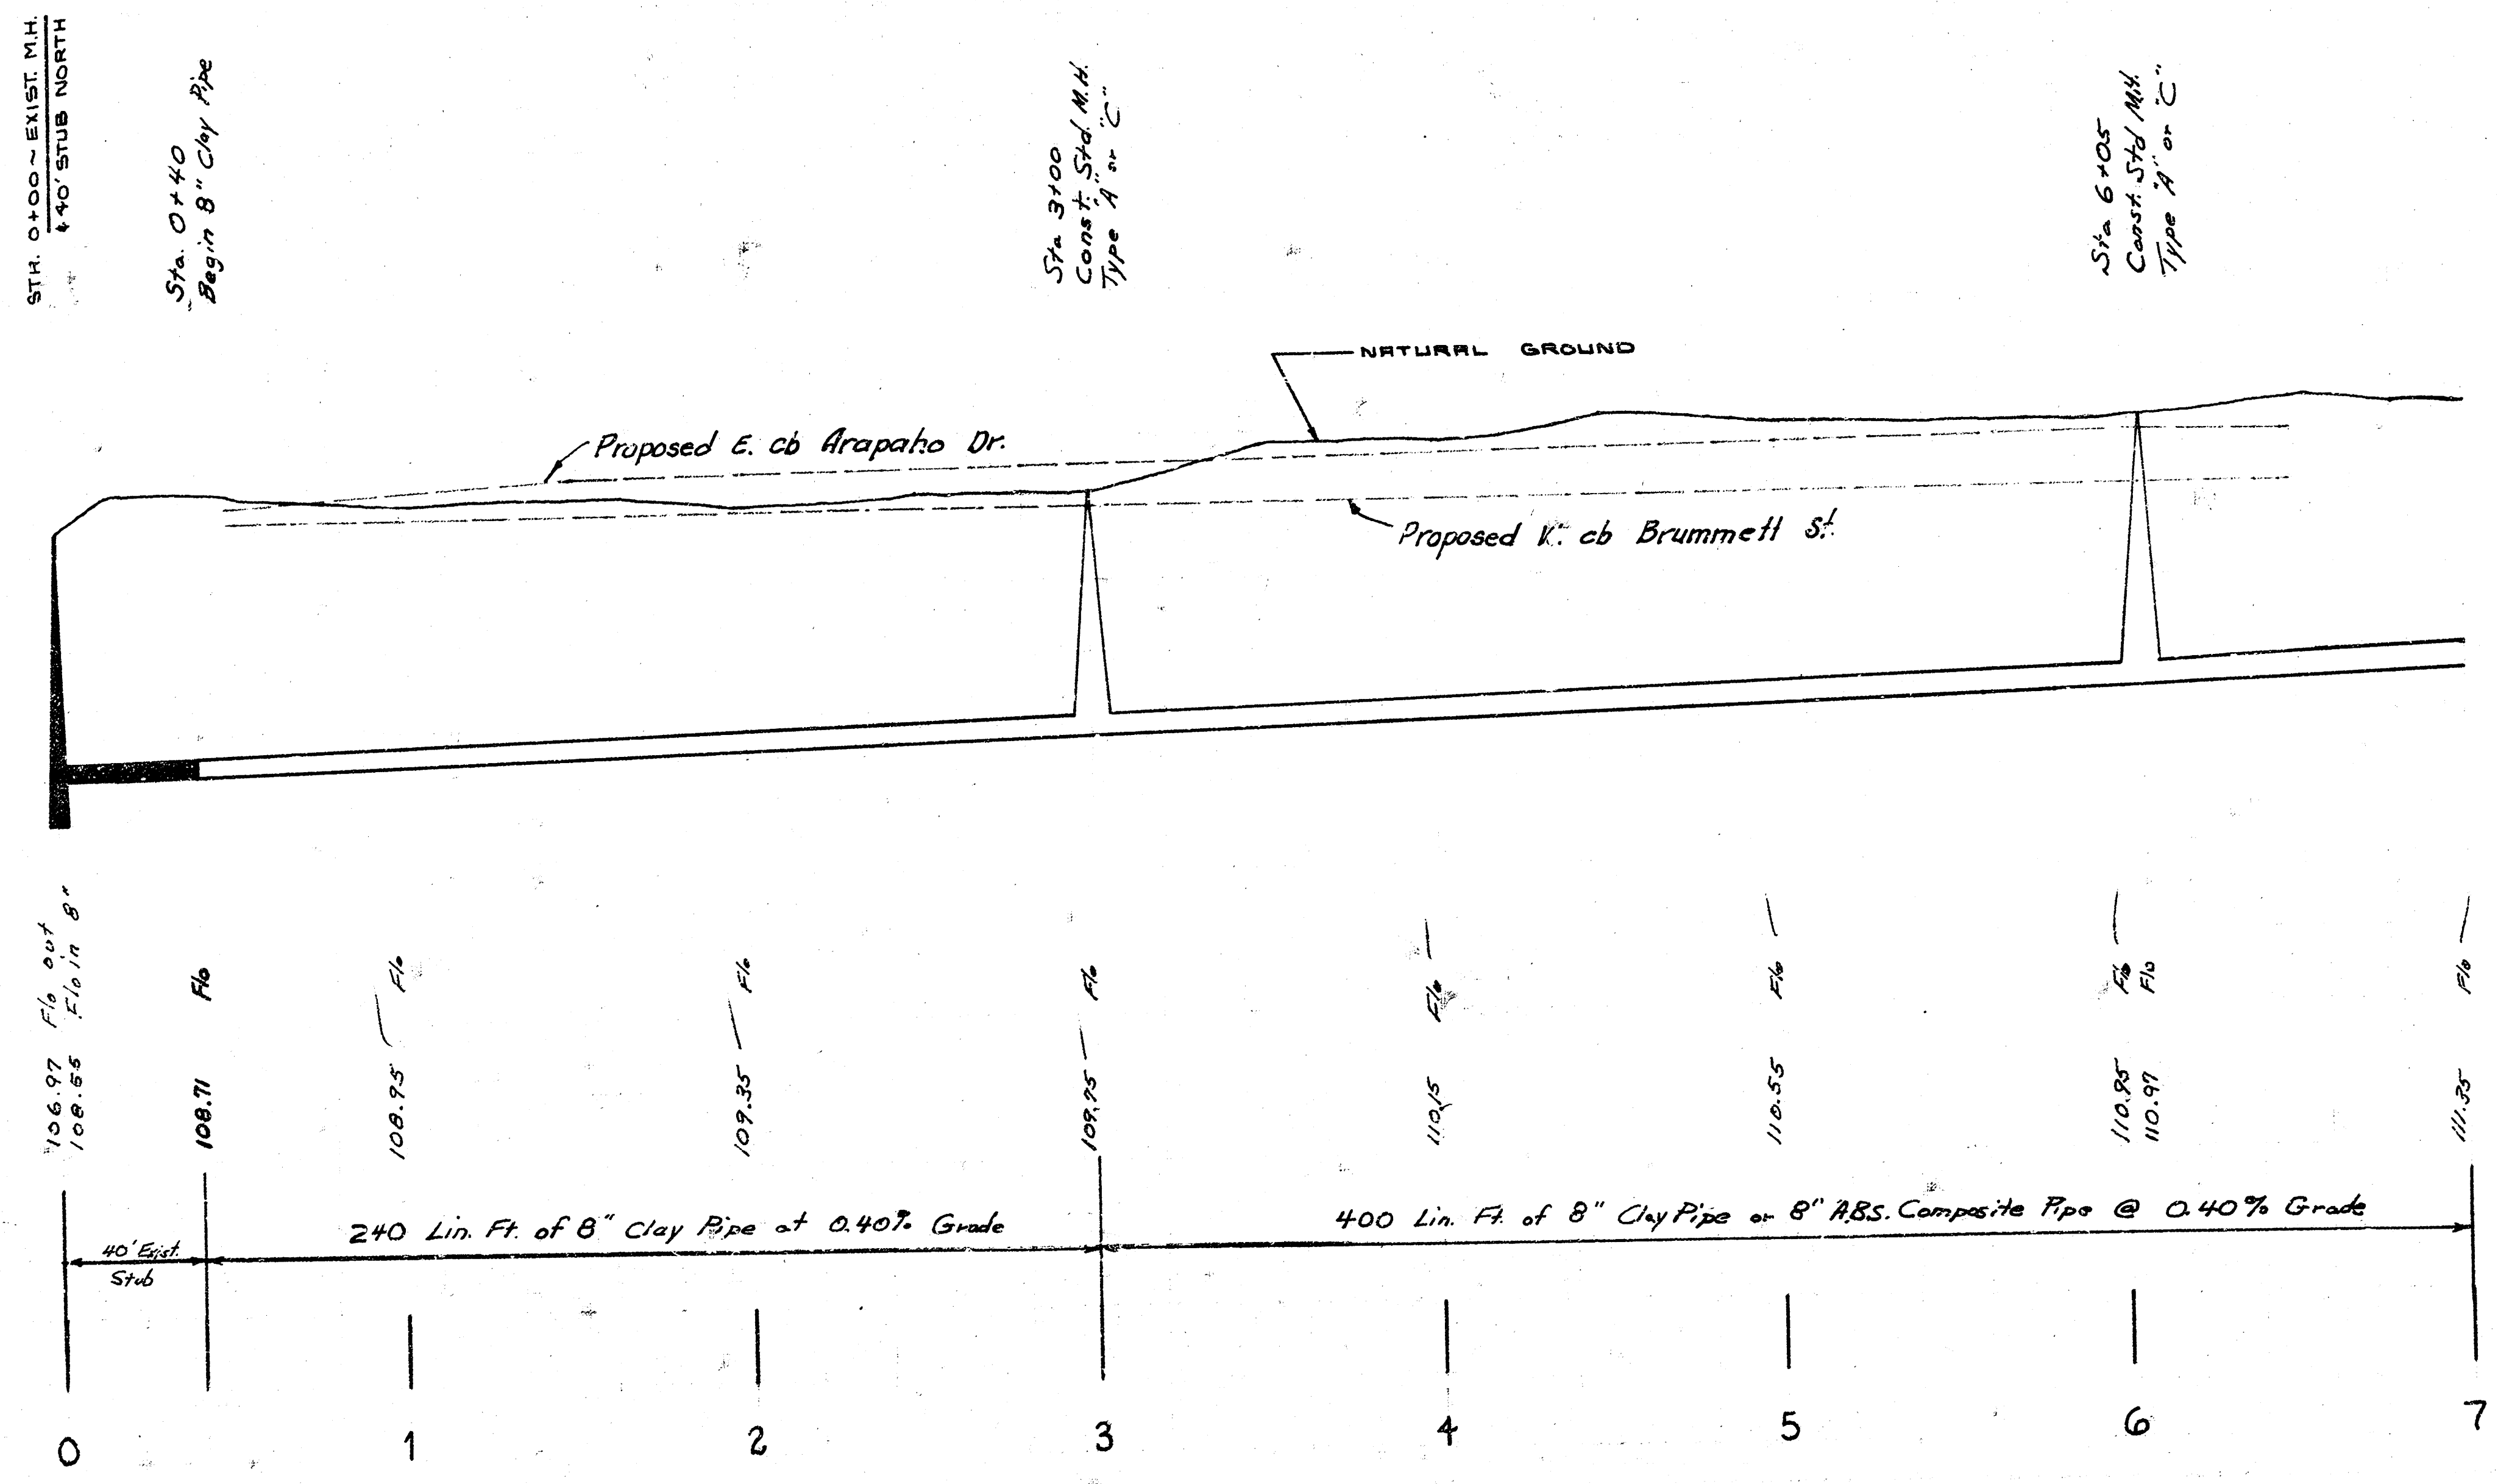


125
120
115
110
105
100


As Built 7-12-76

LAT. 9, MAIN 4, S.W. INTERCEPTOR SEWER
CITY OF WICHITA, KANSAS
R.W. LINN CITY ENGINEER
DATE MARCH, 1976 PROJECT NO. DBKL 571043

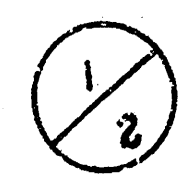

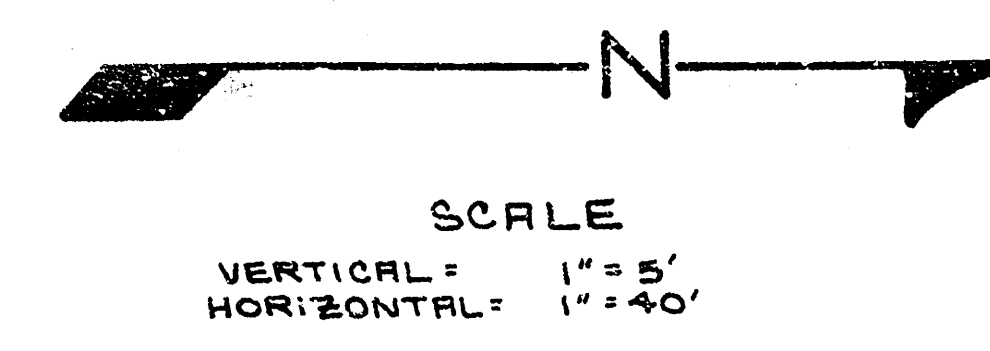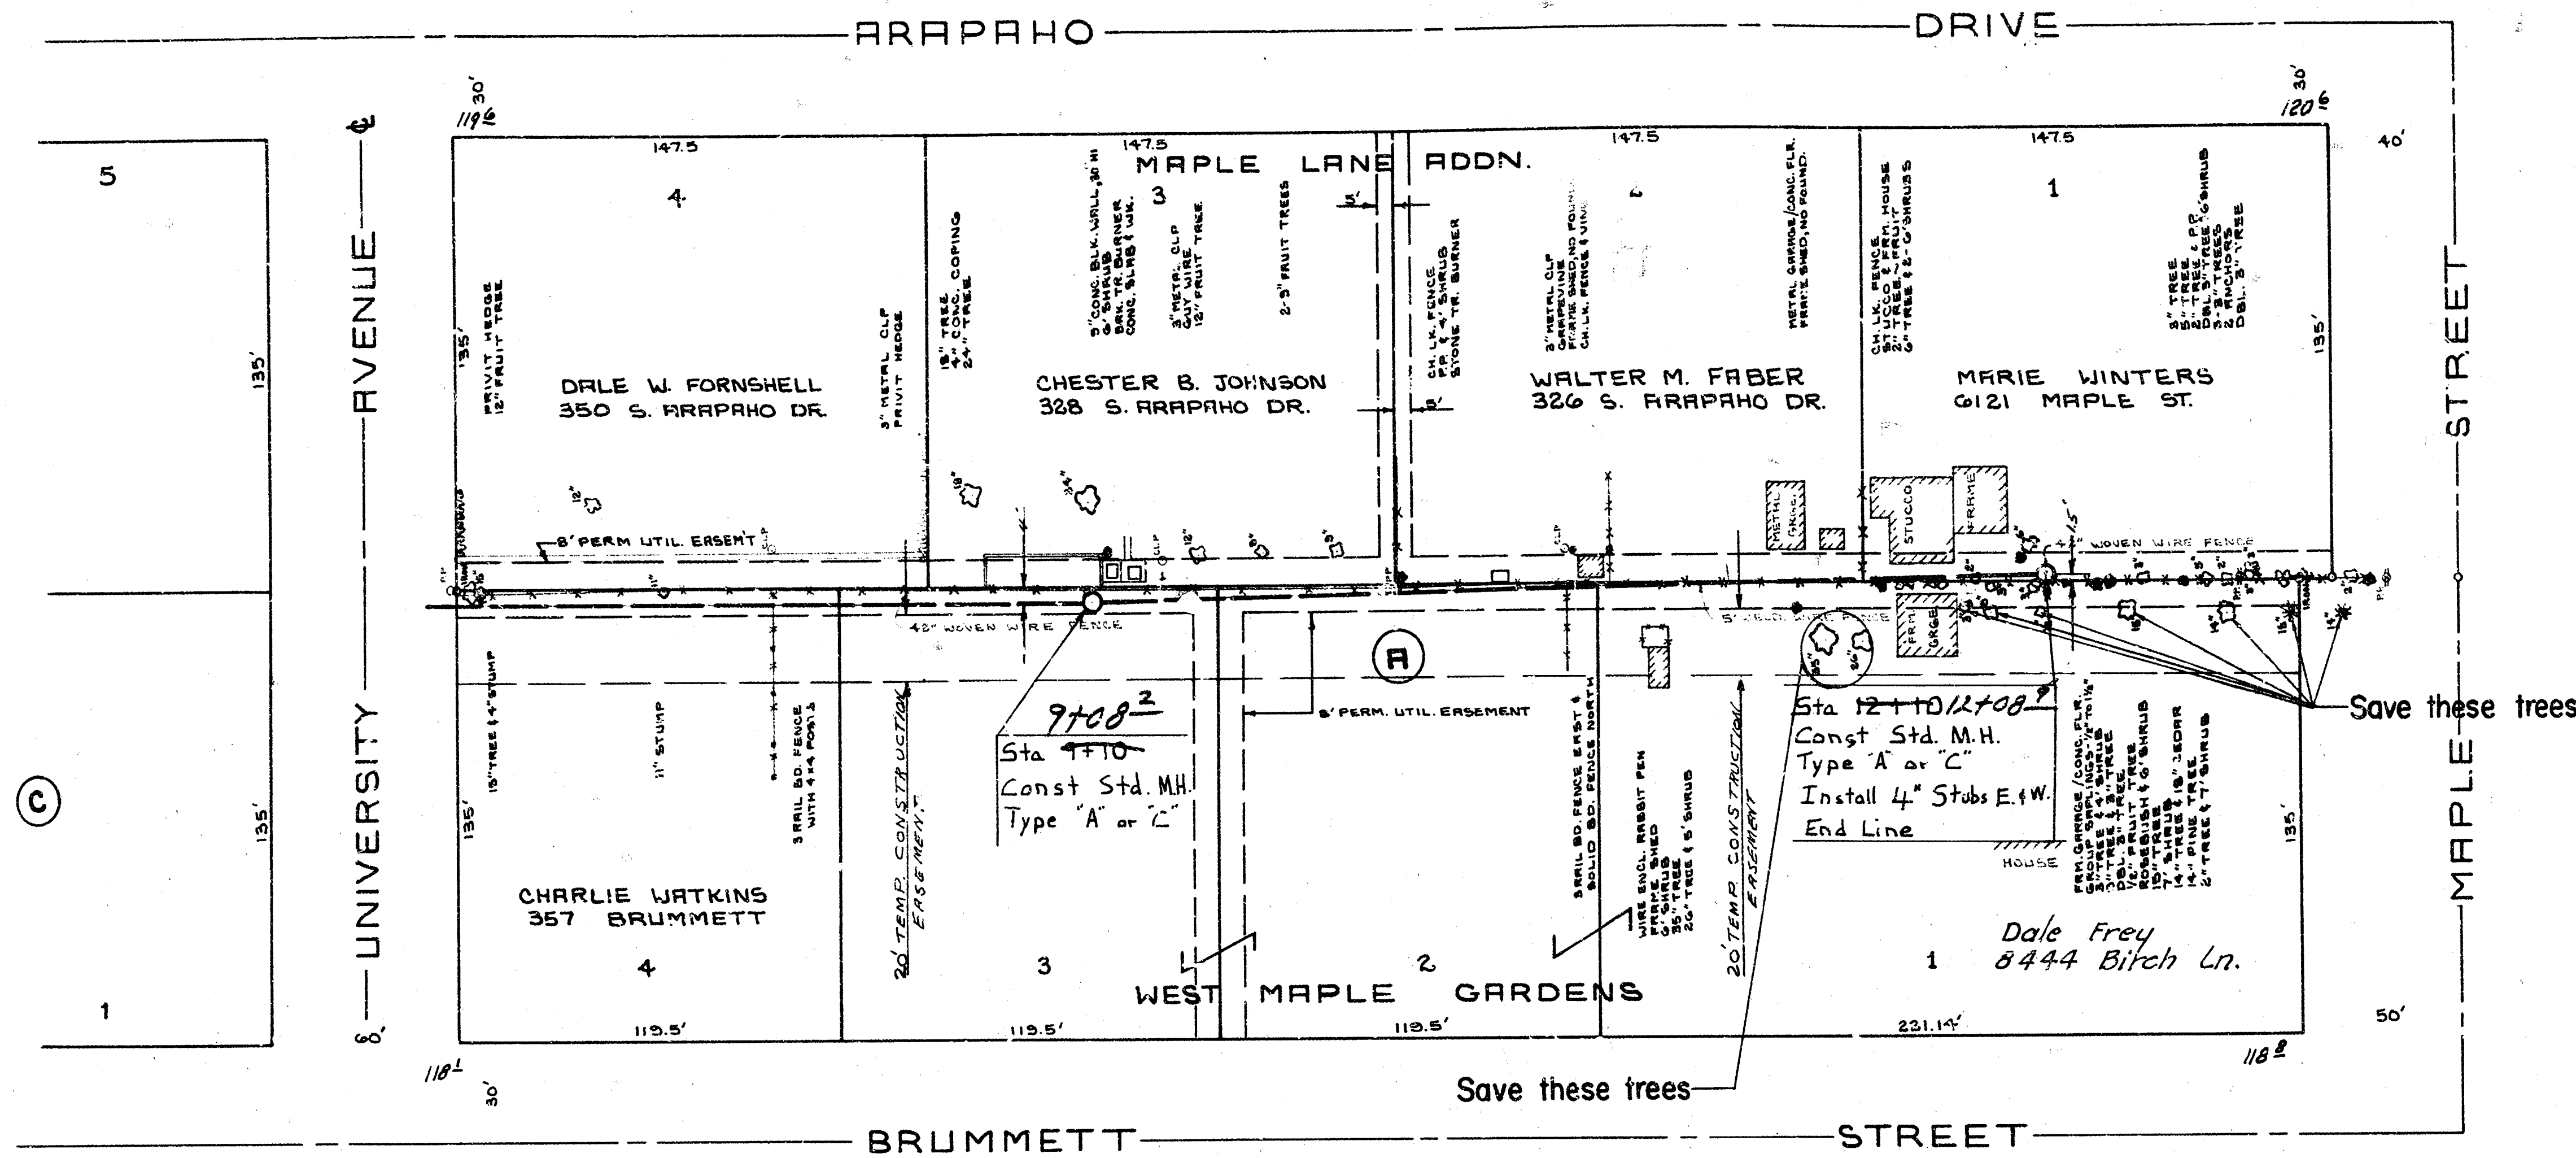

NOTE: CONTRACTOR'S CONSTRUCTION METHODS BETWEEN STA. 11+00 AND STA. 12+10 SHALL BE SUCH THAT WILL PROTECT GARAGES AND HOUSE FROM ANY DAMAGE DUE TO CONTRACTOR'S OPERATION.

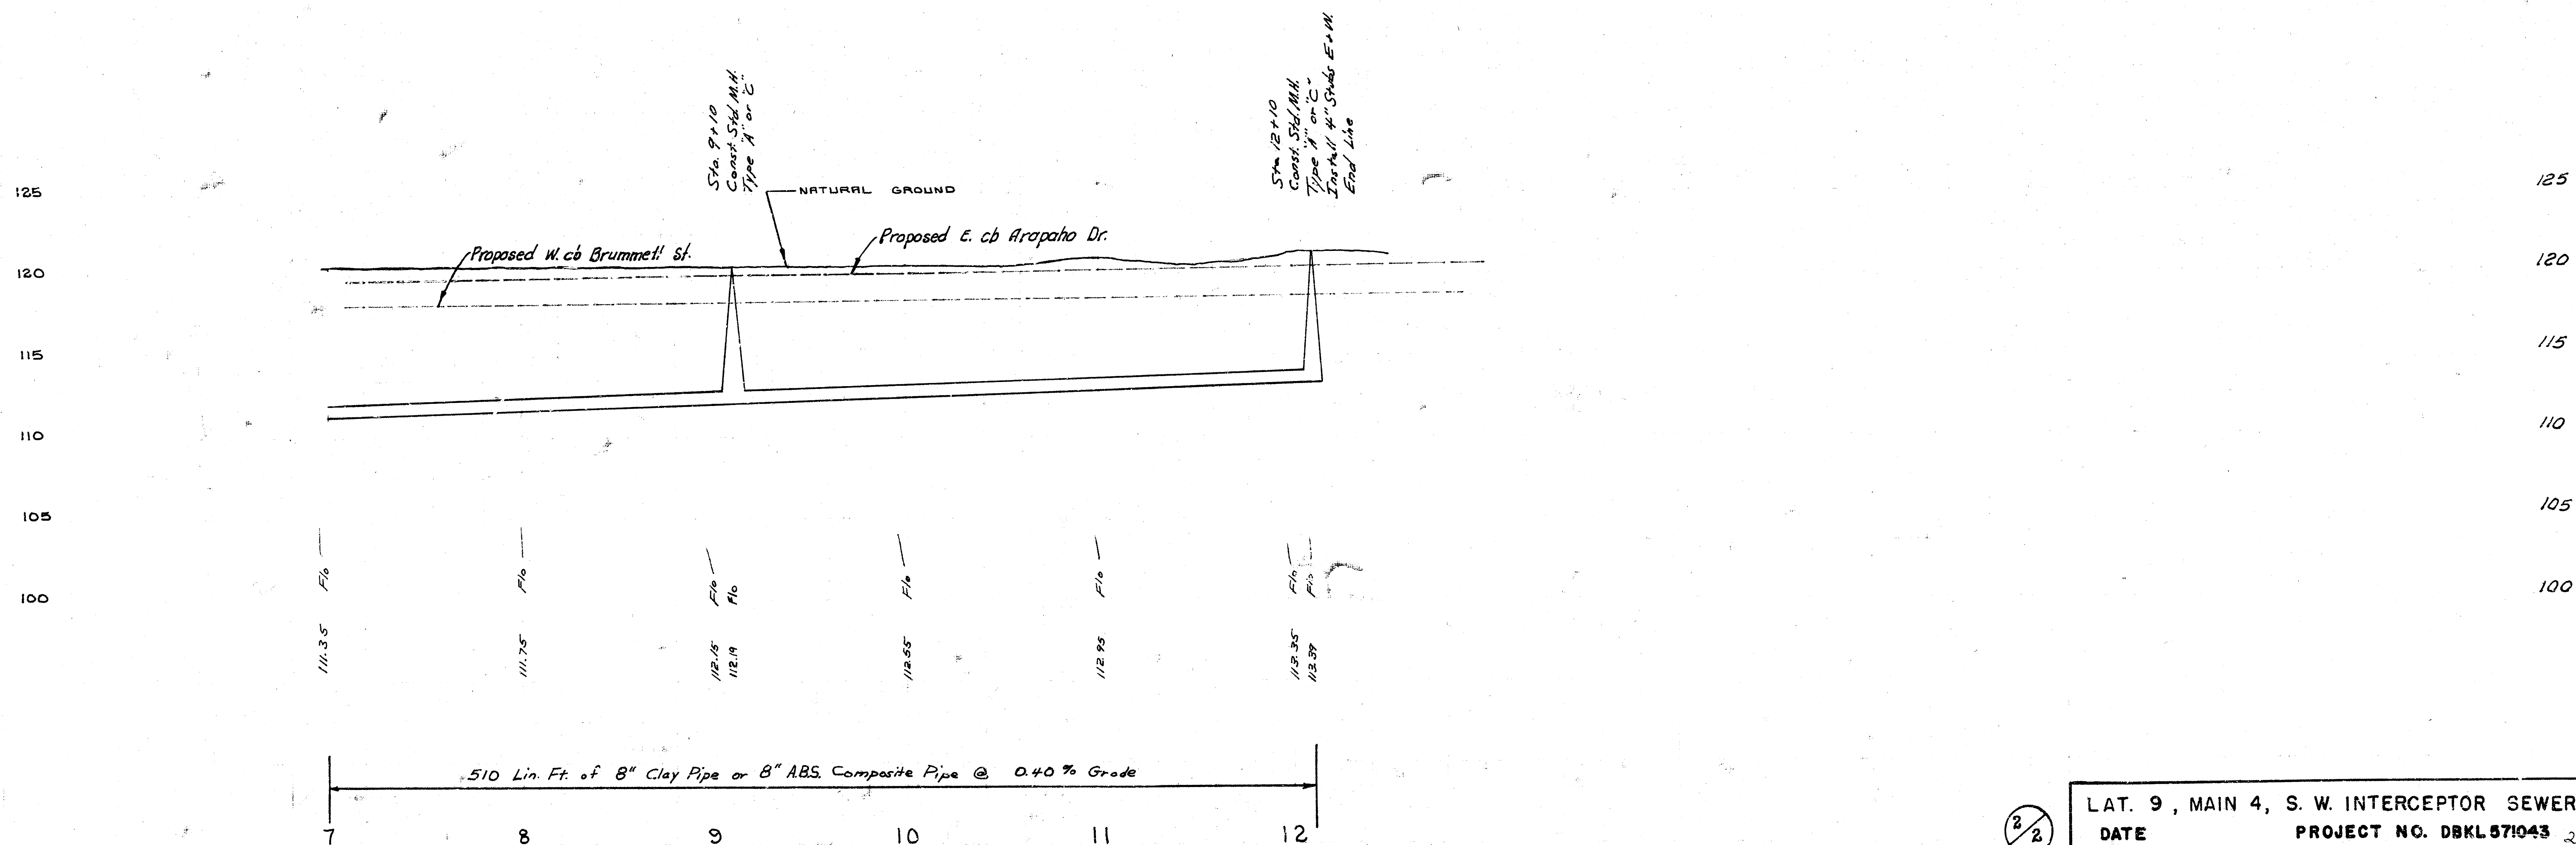

LAT. 9, MAIN 4, S. W. INTERCEPTOR SEWER
DATE PROJECT NO. DBKL571043