




B.M. 116.05 P.R. spike W. face P.P. SE. corner Lot 6, Block C, Garst Garden.  
 B.M. 28.726 1" cut on NW corner concrete Plume on SW corner Hoover & U.S. 54.



Note: Field Engineer shall check stub's flow elevation prior to construction of sanitary sewer.

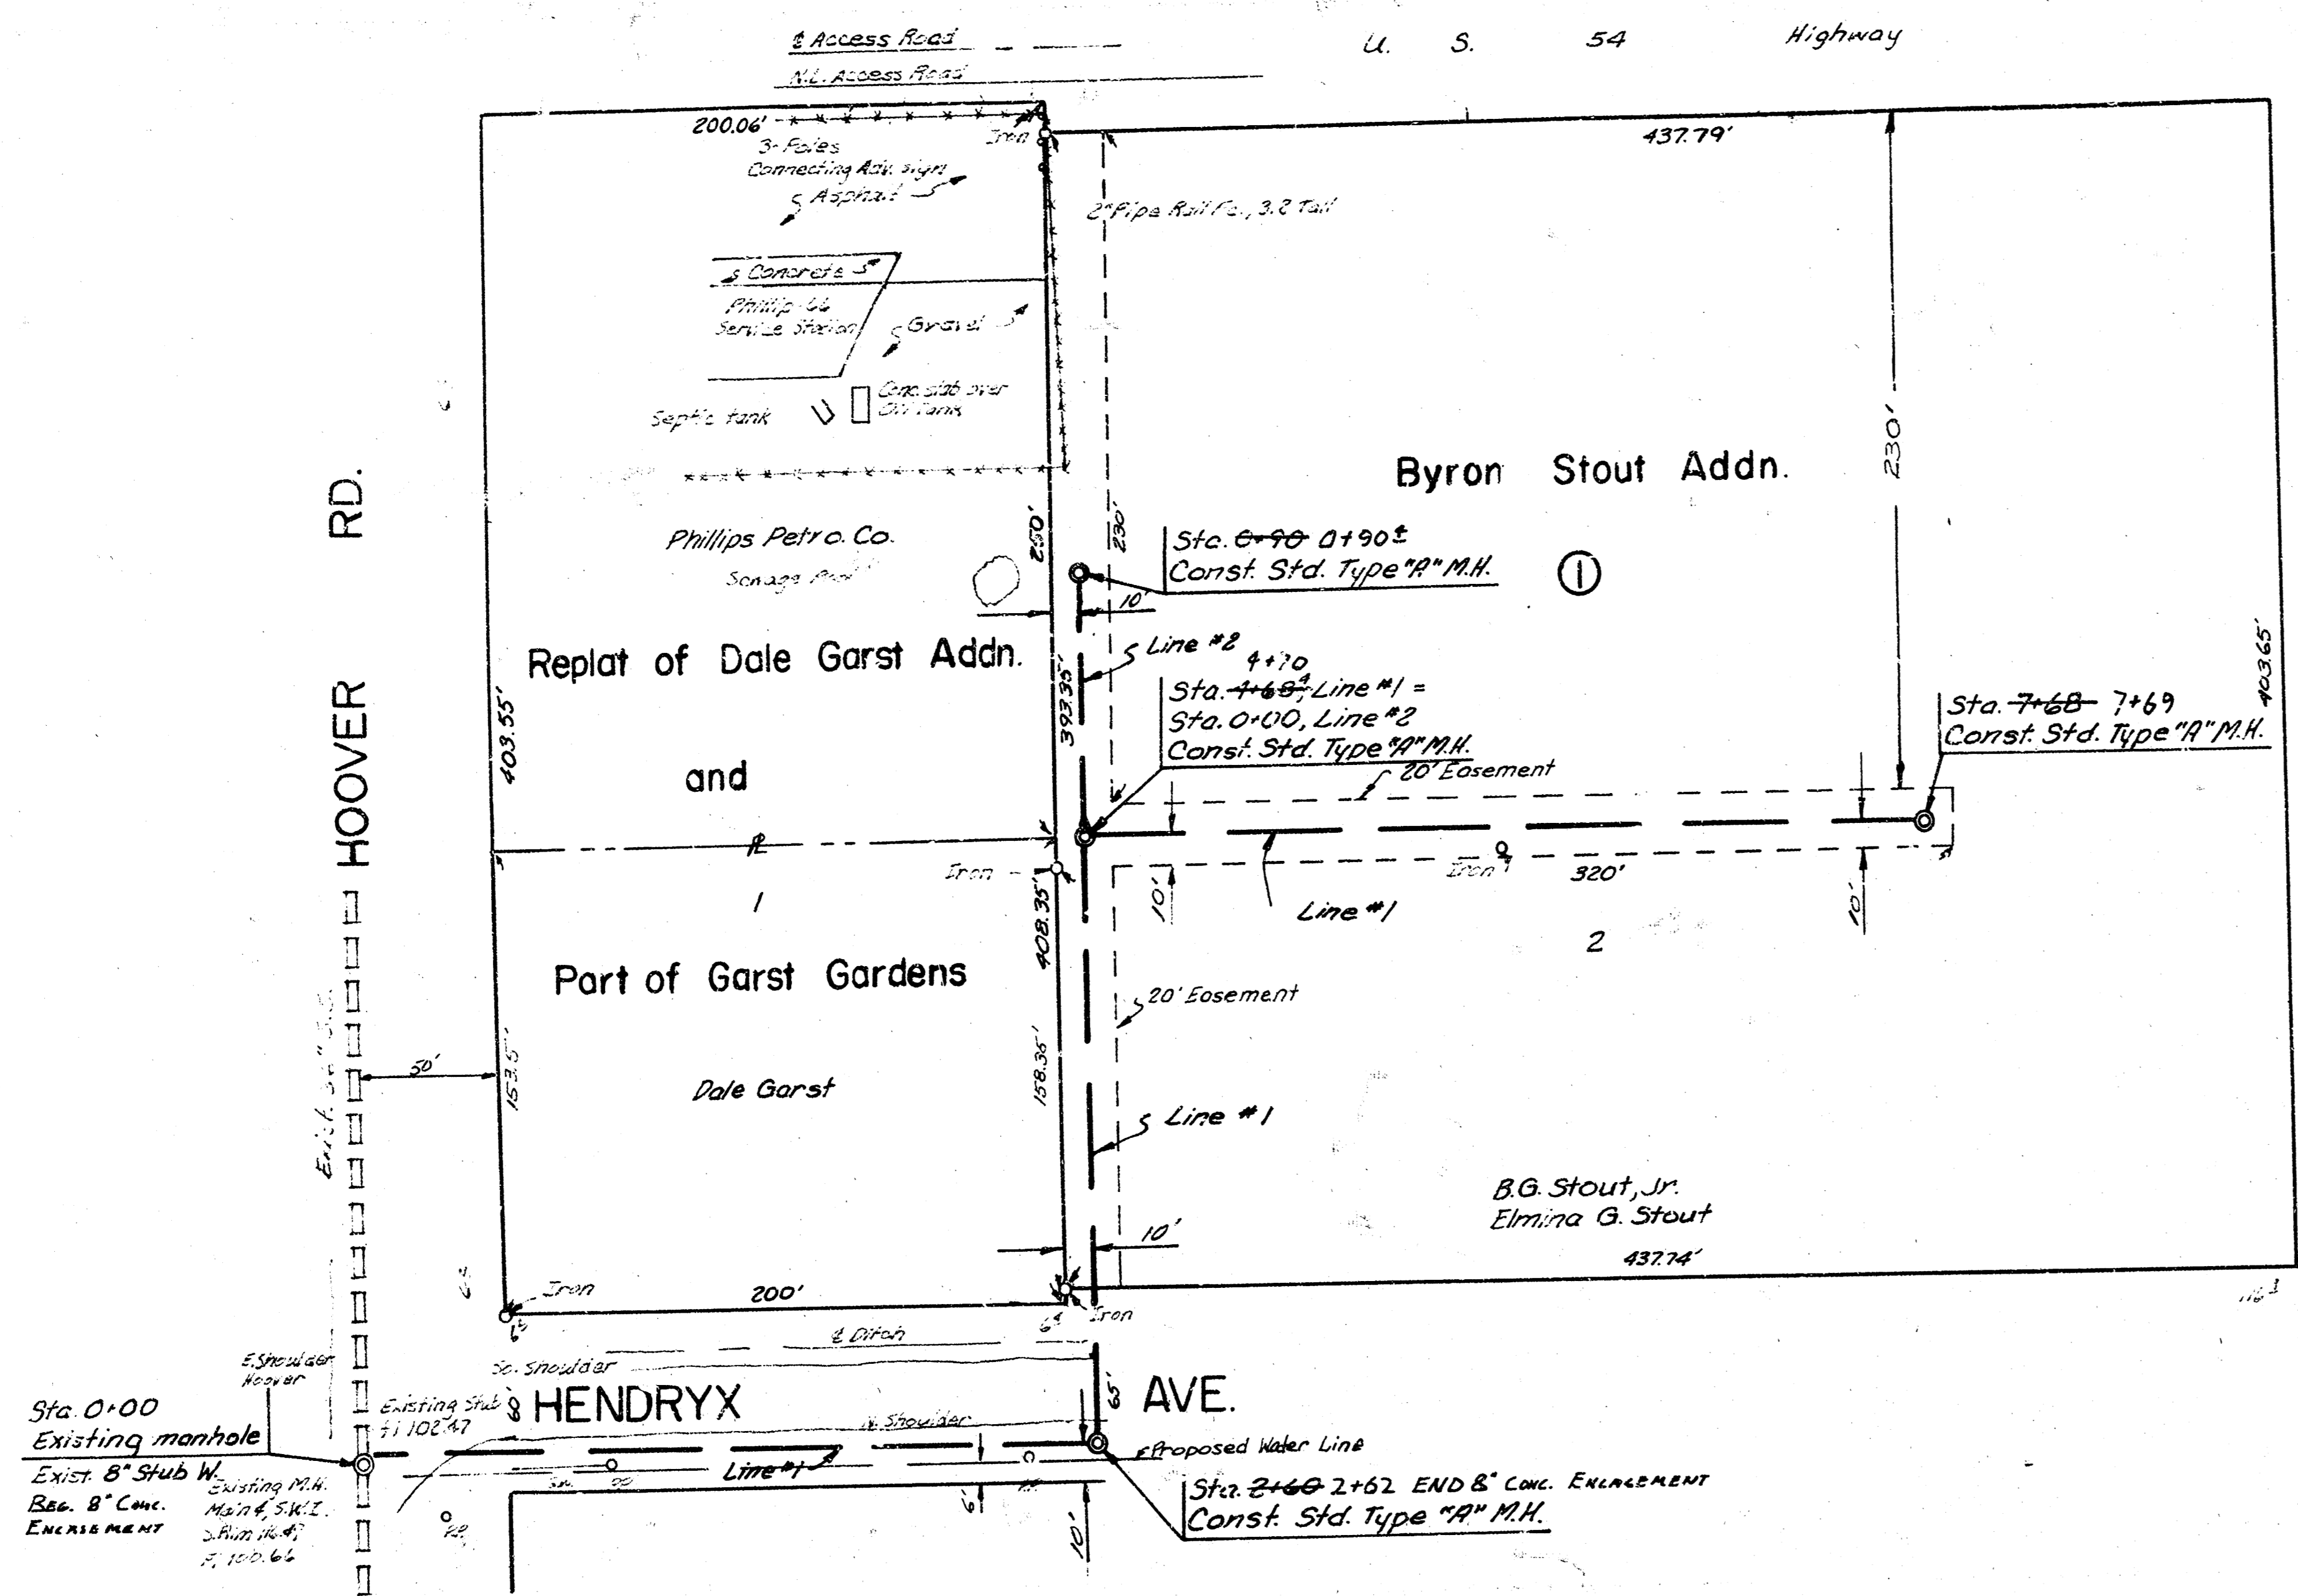

Plan Scale 1"=50'  
 Profile Scale Ver. 1"=50'  
 Profile Scale Hor. 1"=5'

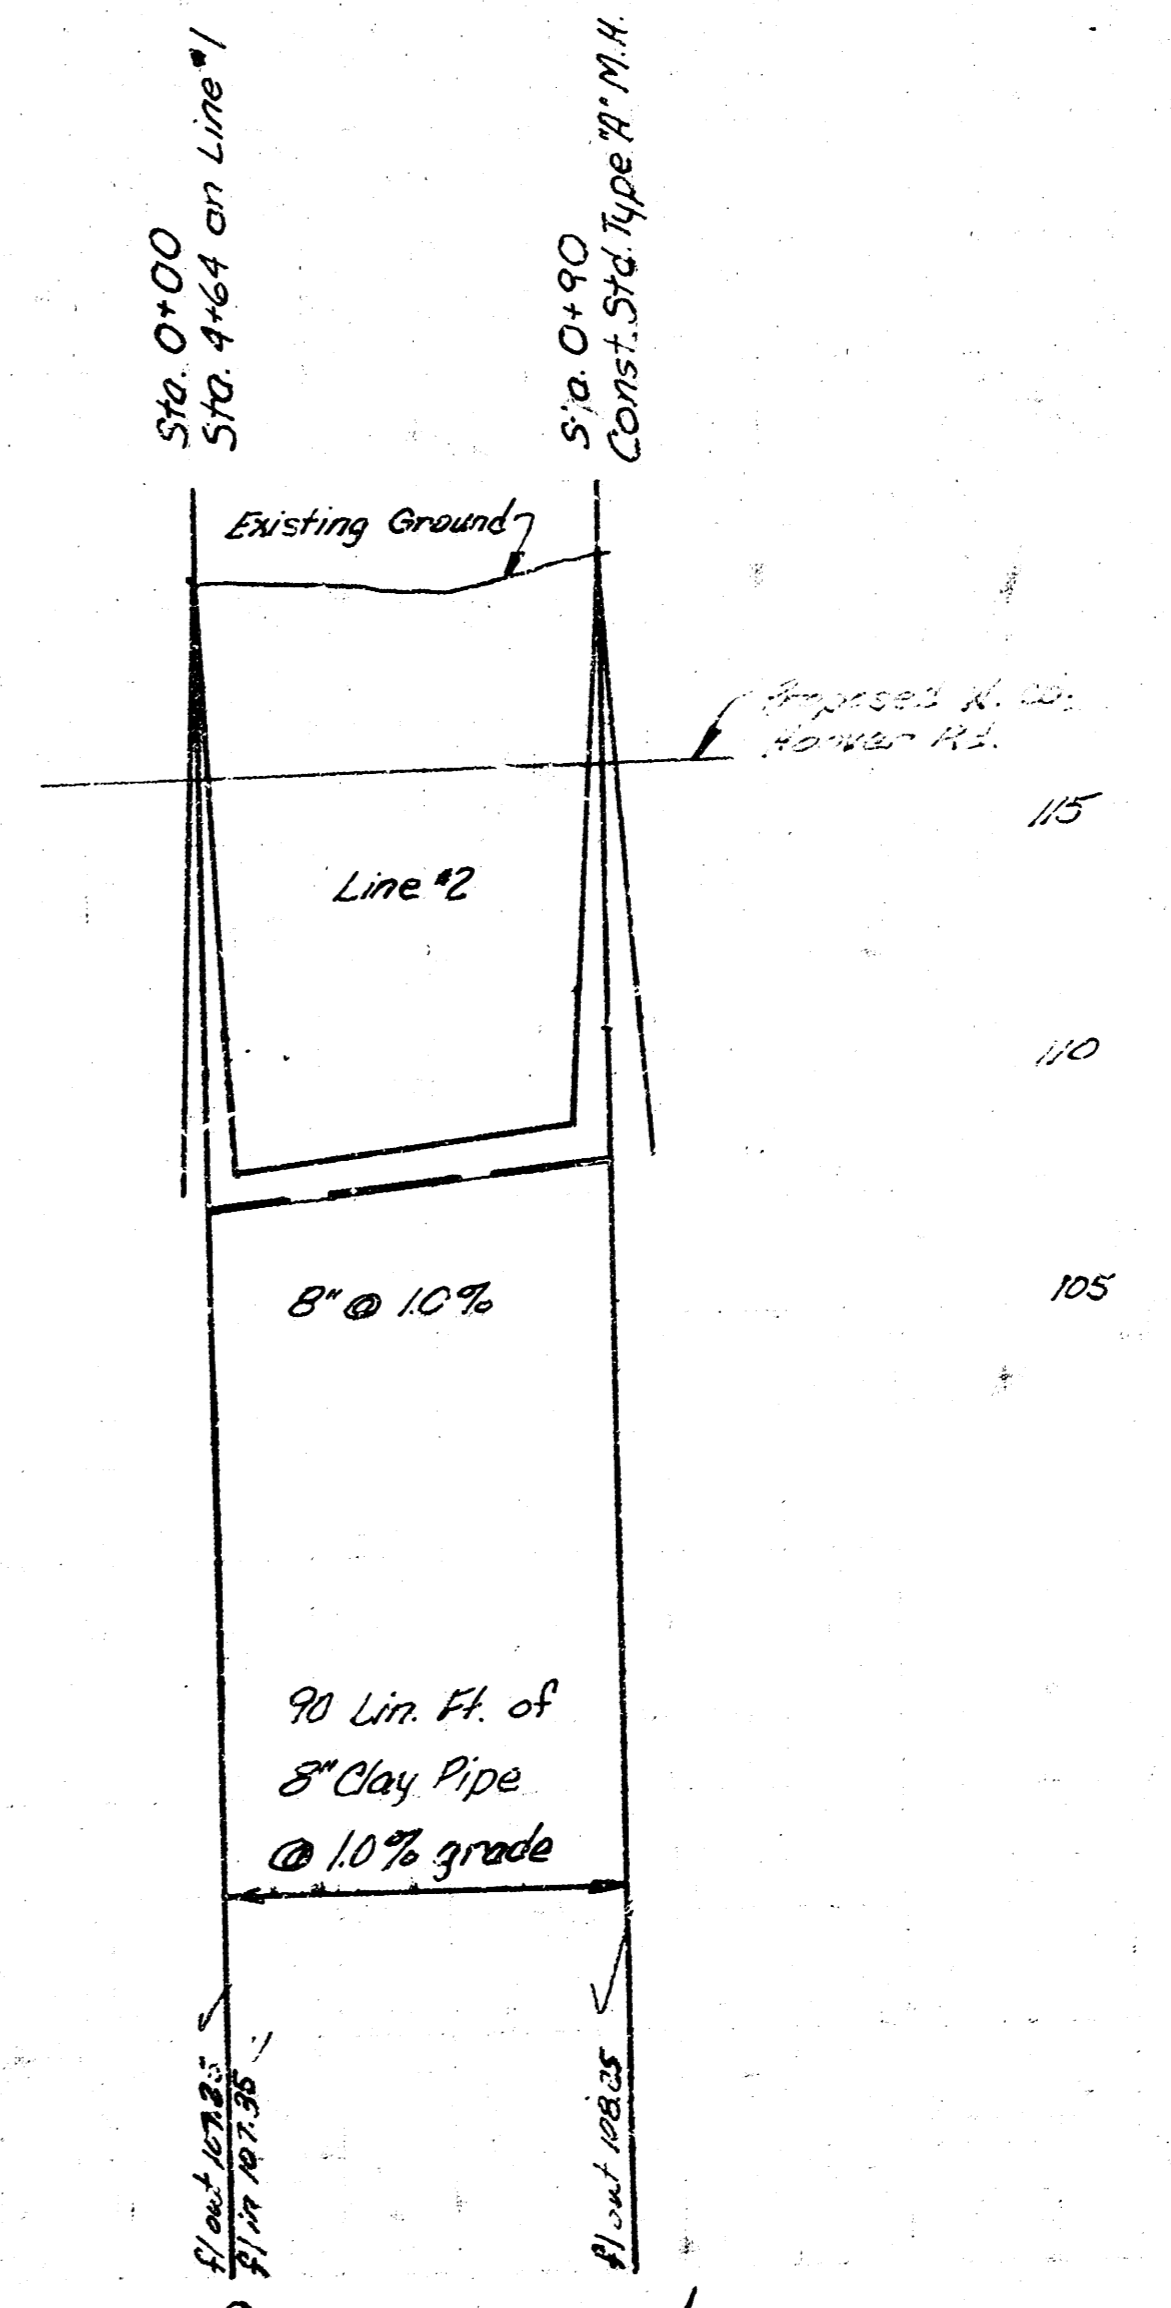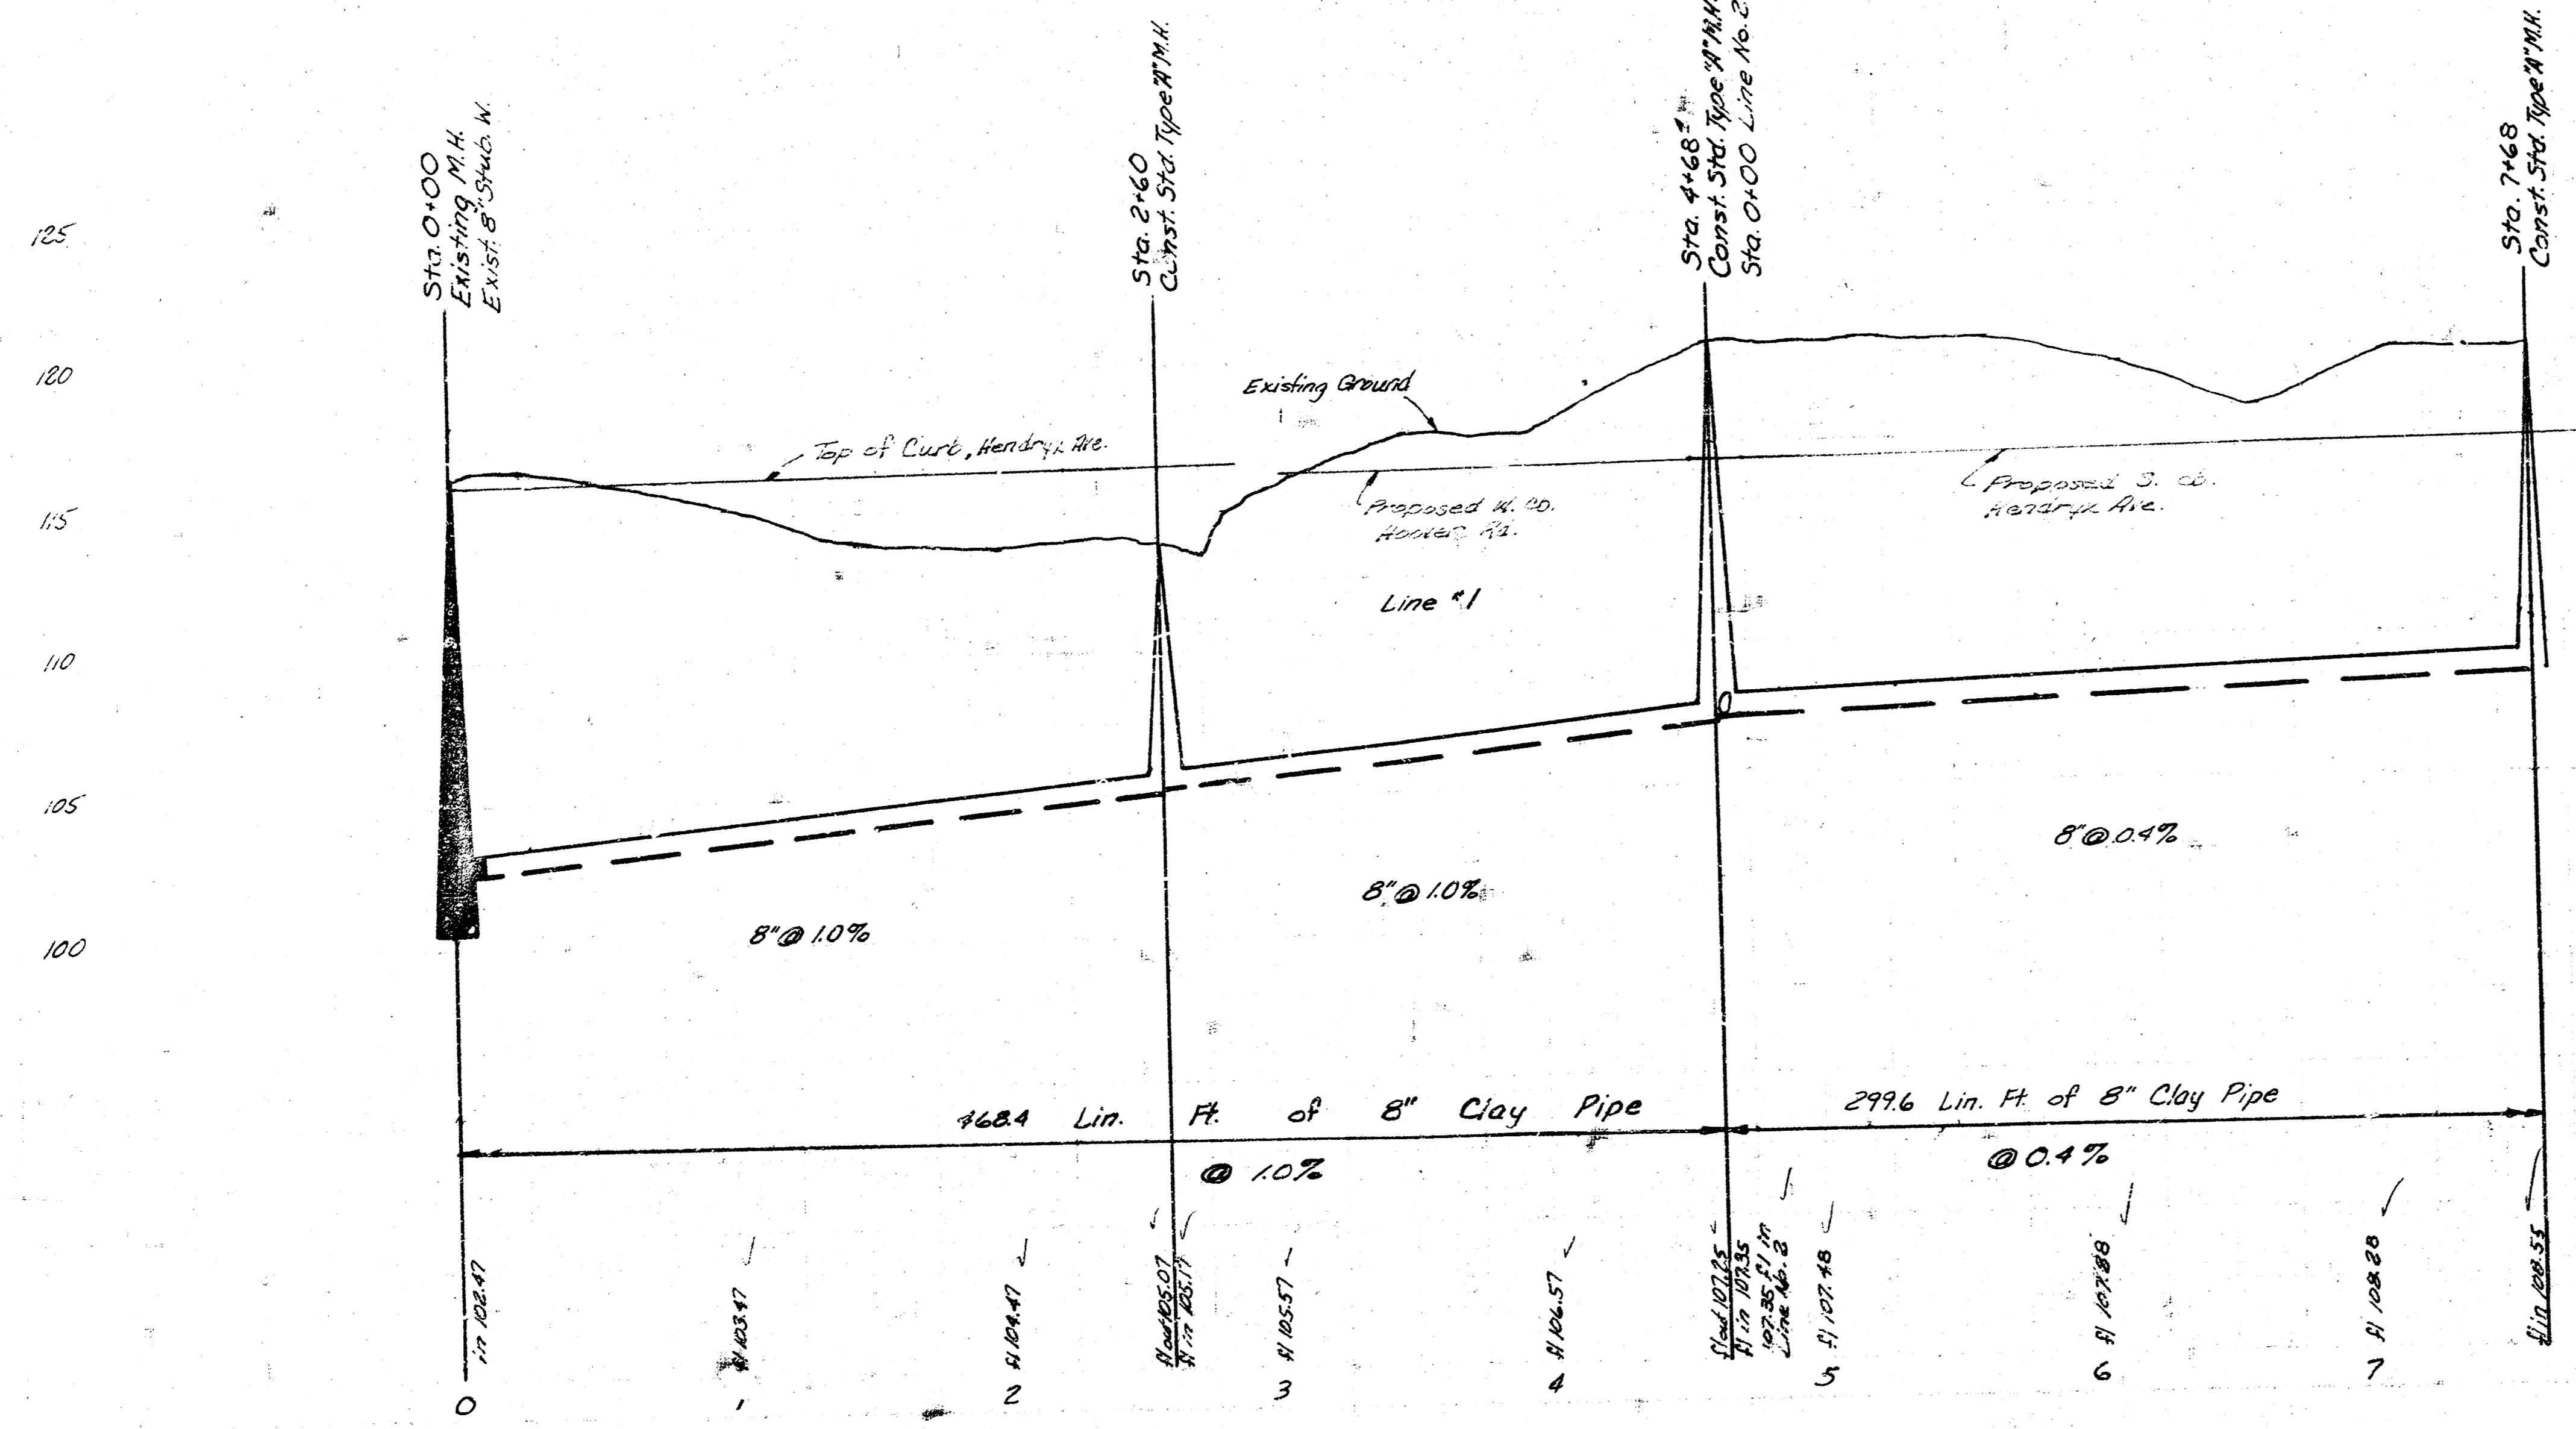

"As Built" FINAL MEASUREMENTS K-88  
 LAT 15, MAIN 4, S.W. INTERCEPTOR LINES 1 & 2  
 R. W. LINN CITY ENGINEER  
 CITY OF WICHITA, KS.  
 PR. NO. DESK 572025 DATE 7-72

FILMED FROM THE BEST