



DL King
S. Spencer
DAK/289

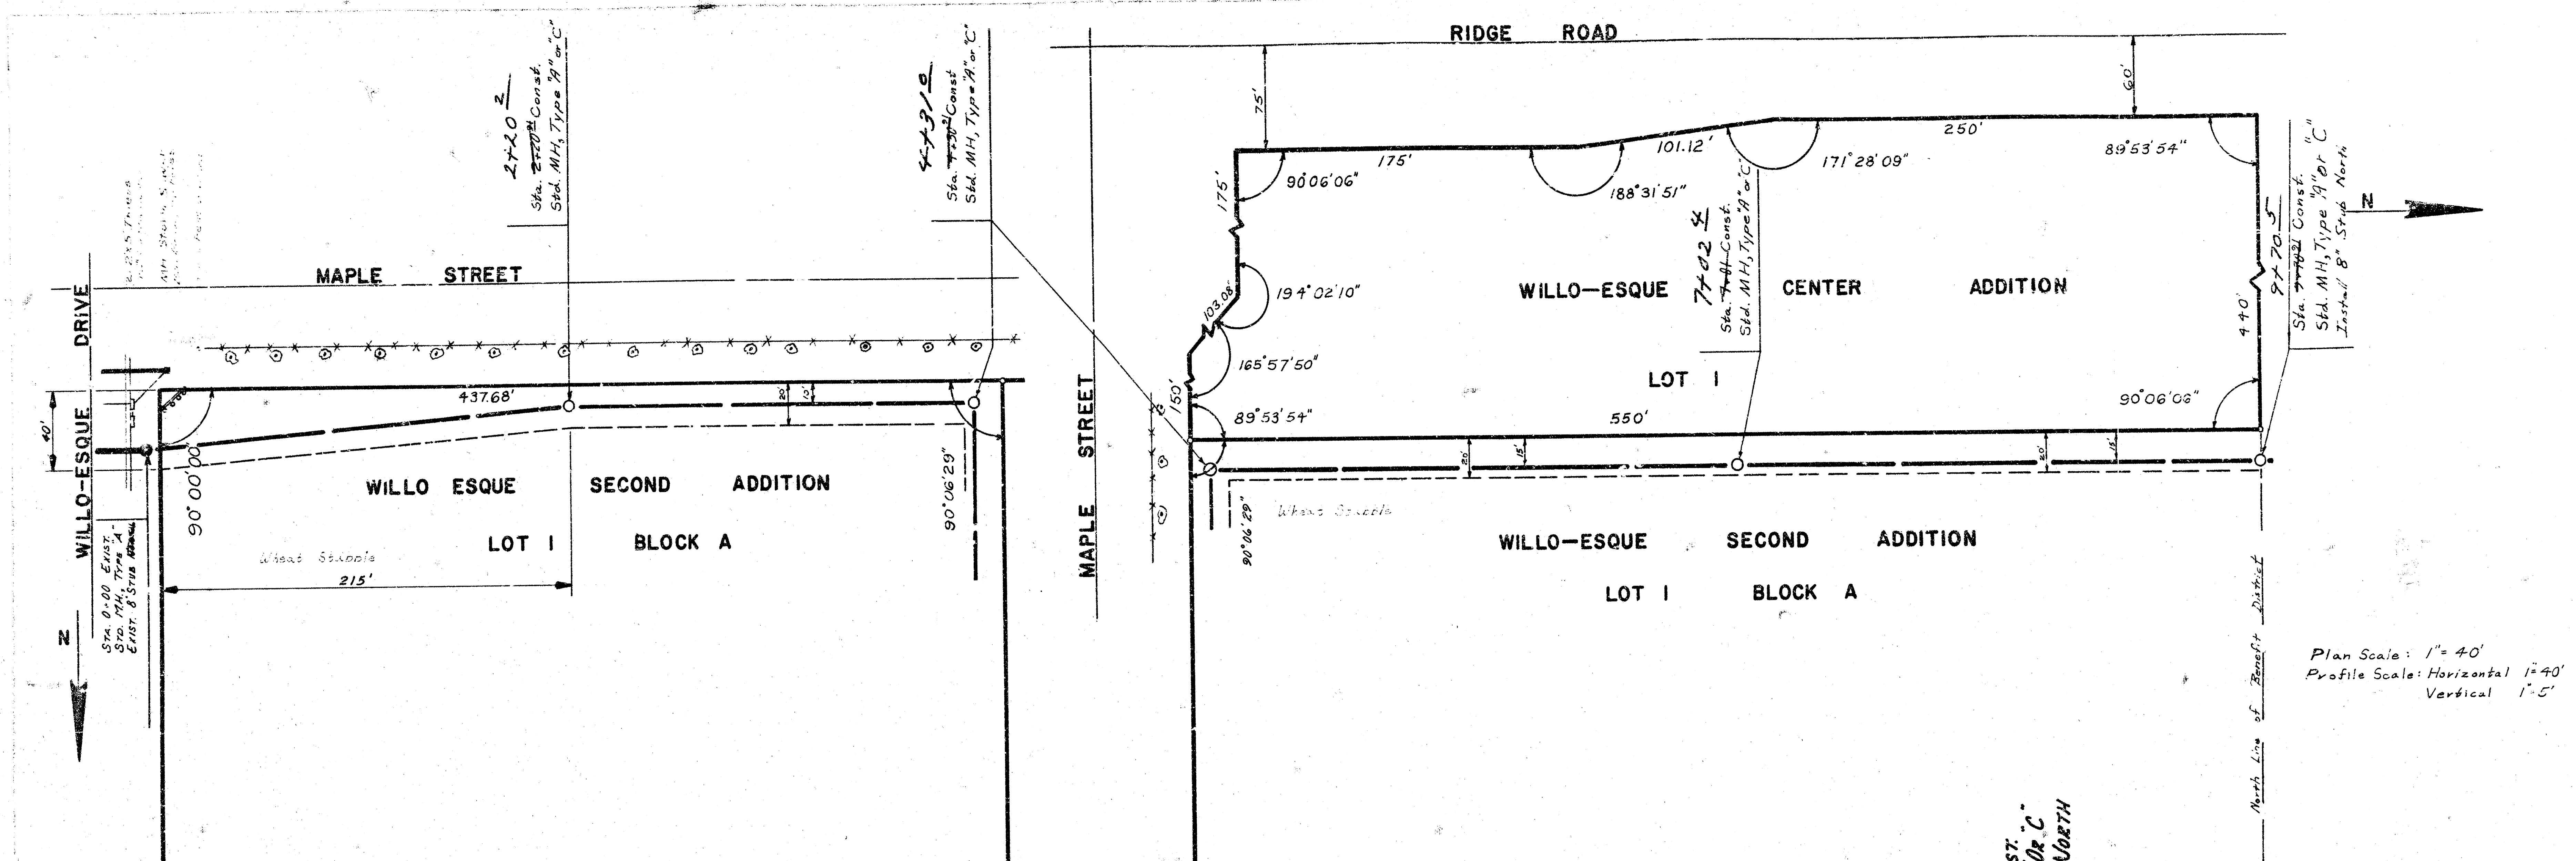

Plan Scale: 1" = 40'
Profile Scale: Horizontal 1" = 40'
Vertical 1" = 5'

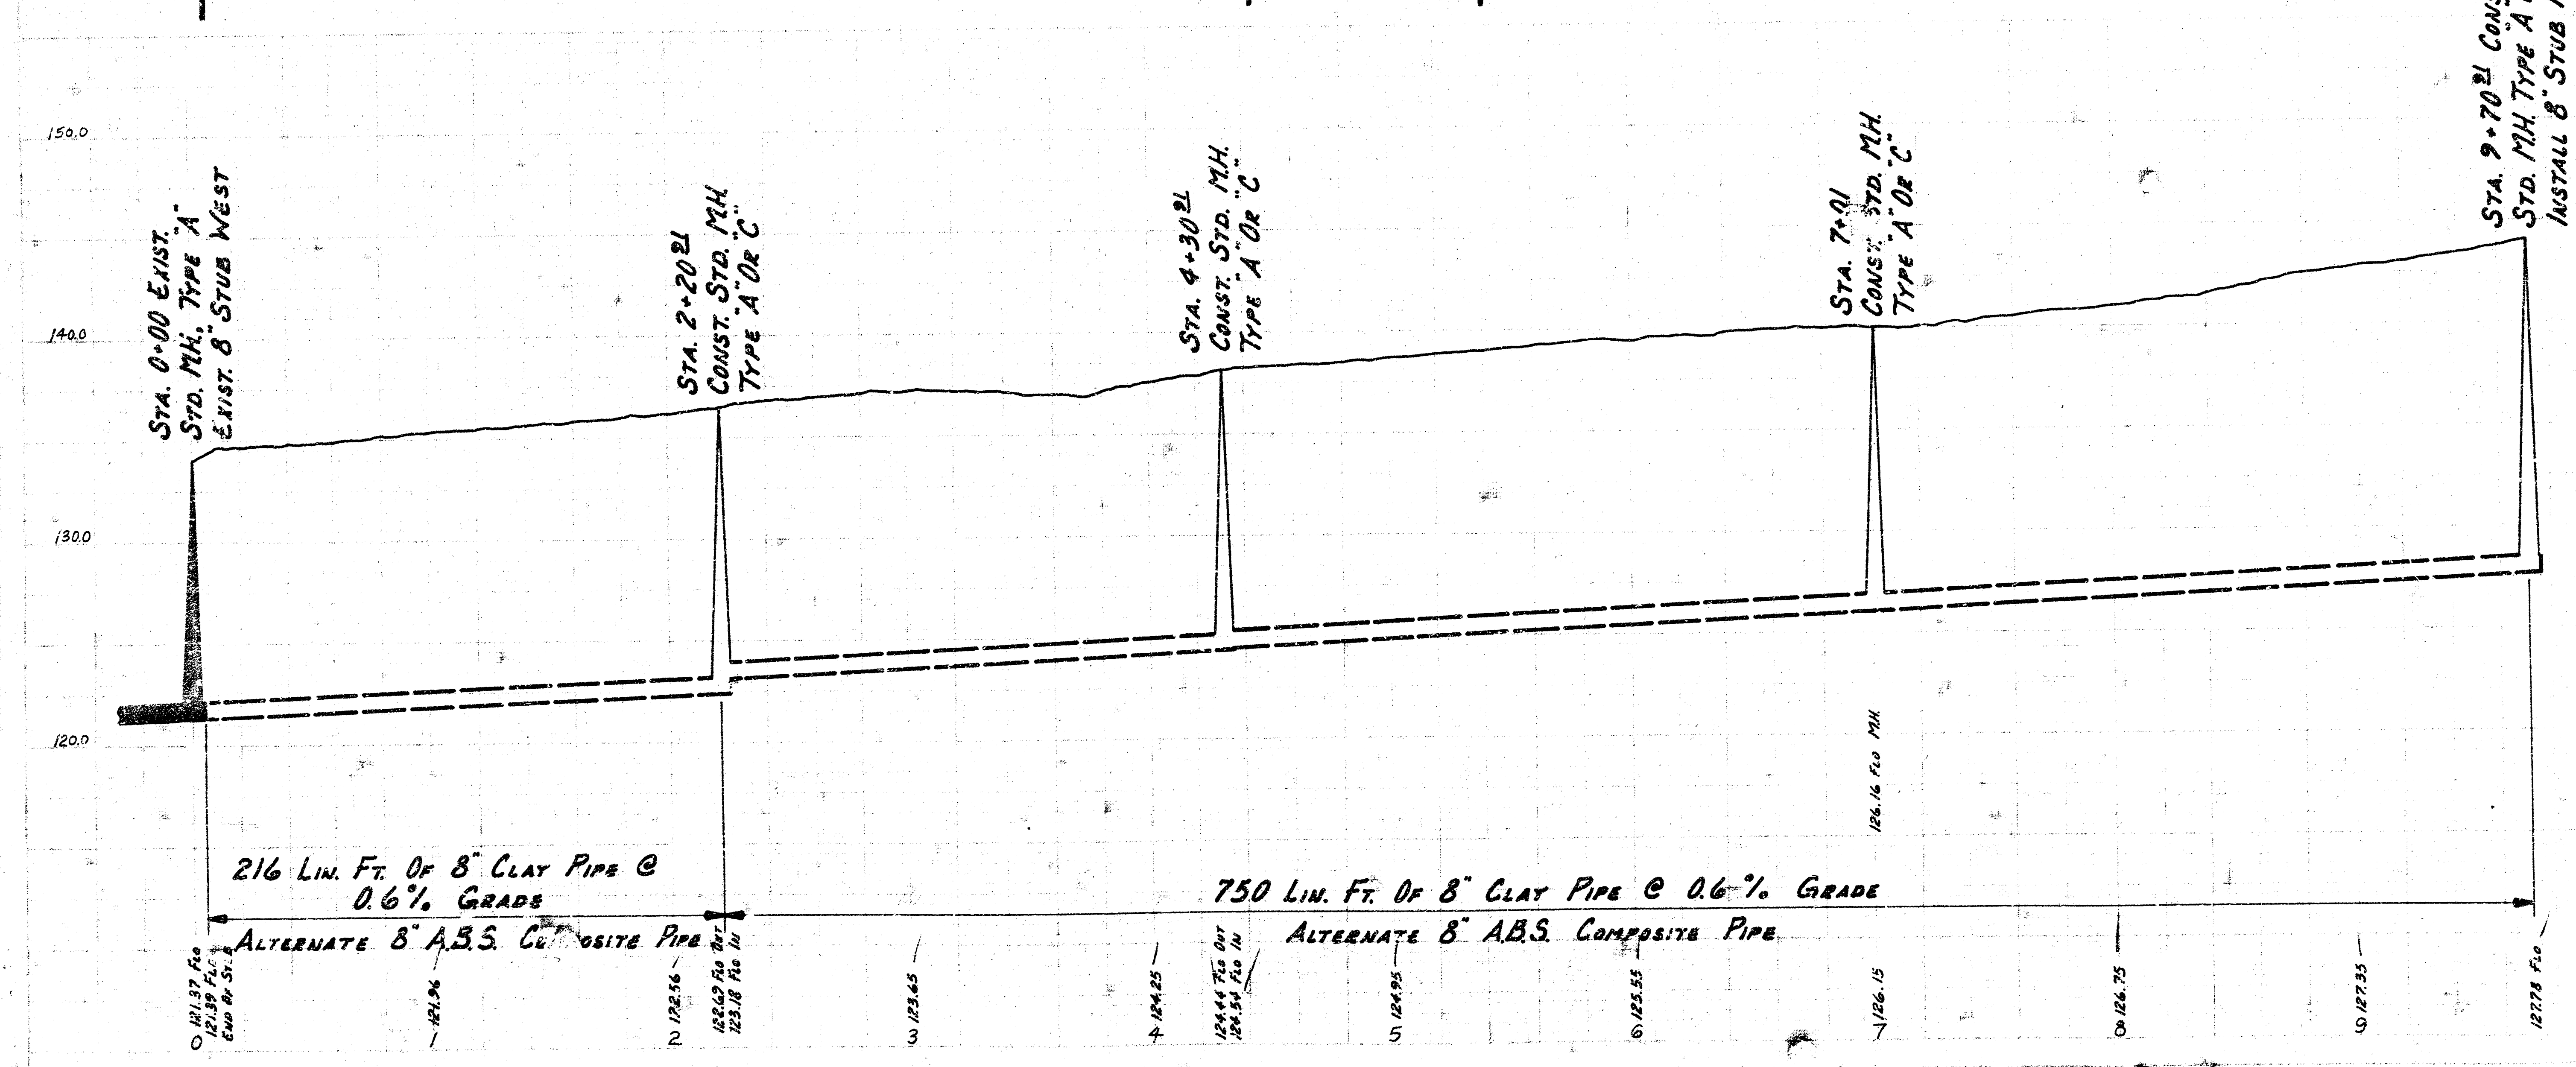

As Built 2-27-76

LATERAL 1 MAIN 6
SOUTHWEST INTERCEPTOR
CITY OF WICHITA, KANSAS
R.W. LINN CITY ENGINEER
DATE: DEC., 1975
SHEET: 1 OF 1
PROJECT NO.: DBKL 573001

