





B.M. 14166 CITY STD. 34"E+42'S. OF Q. RIDGE RD+MAPLE
 B.M. 14164 "D" TOP OF NO. CURB WILLO-ESQUE DR.+E.L. TARABURY
 B.M. 13754 "D" N.E. END RET. S.E. COR. WILLO-ESQUE DR.+CEYMARIE CVR.

WILLO-ESQUE DRIVE

TARABURY LANE

EL STANDRA CIRCLE


EL ROBELAI CIRCLE

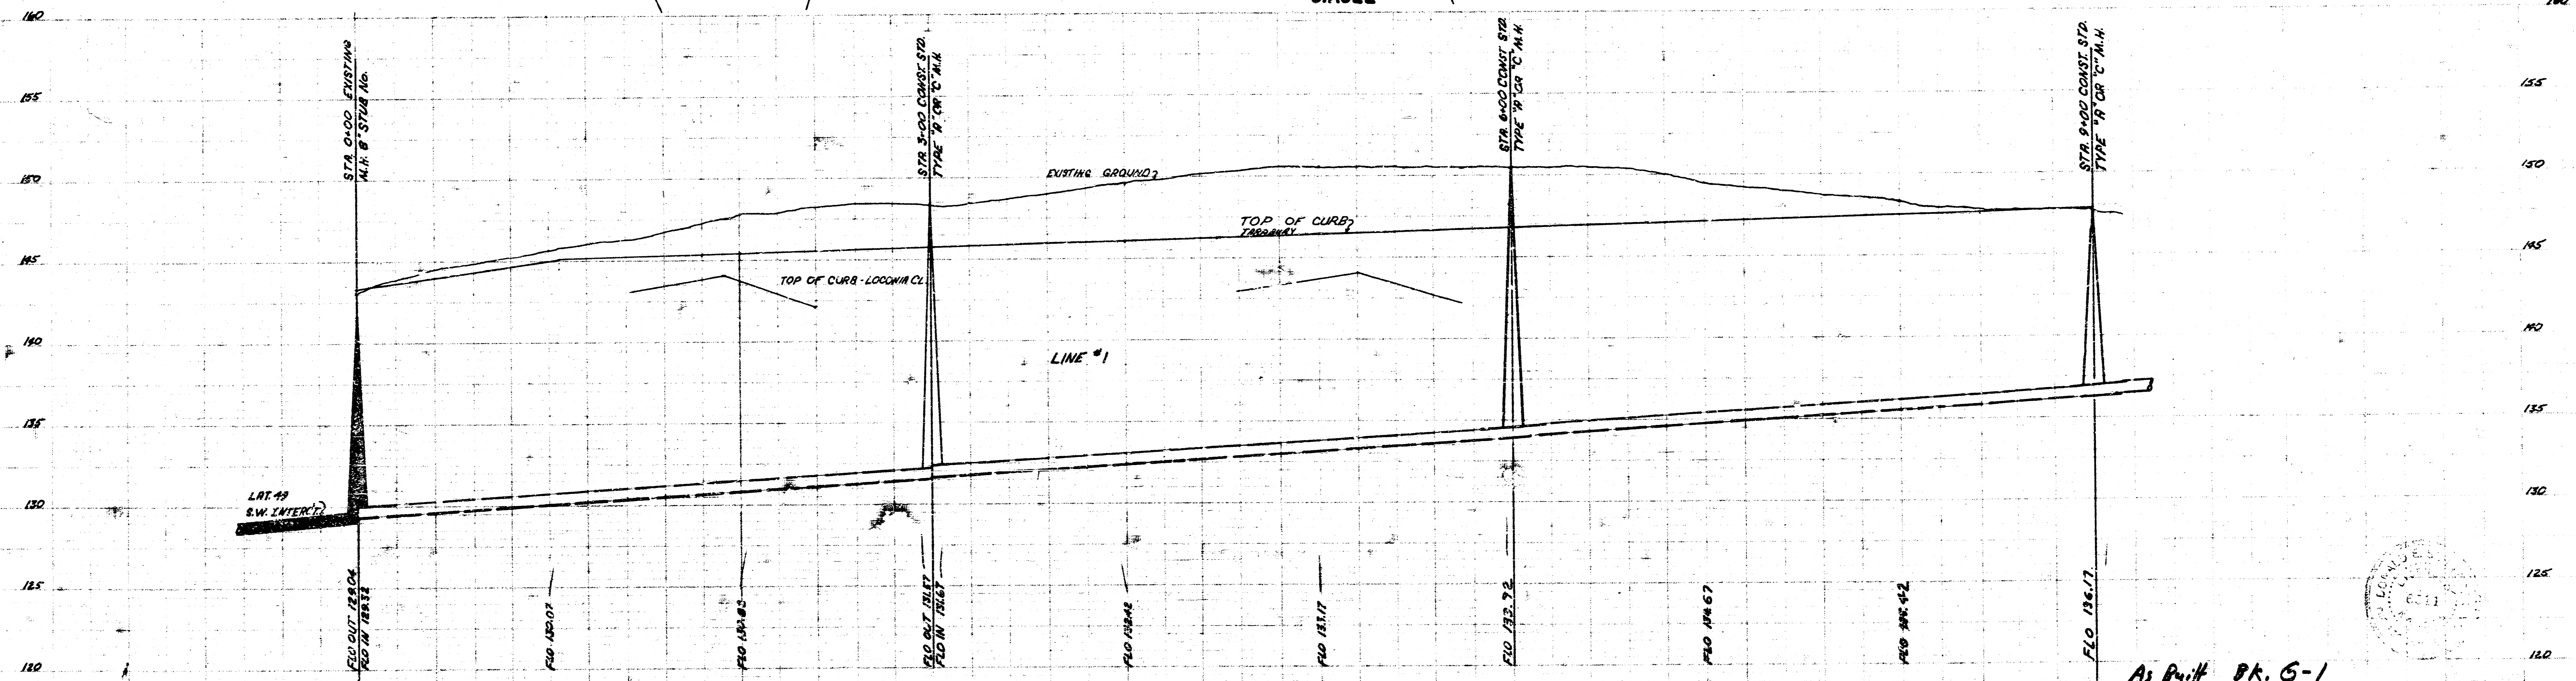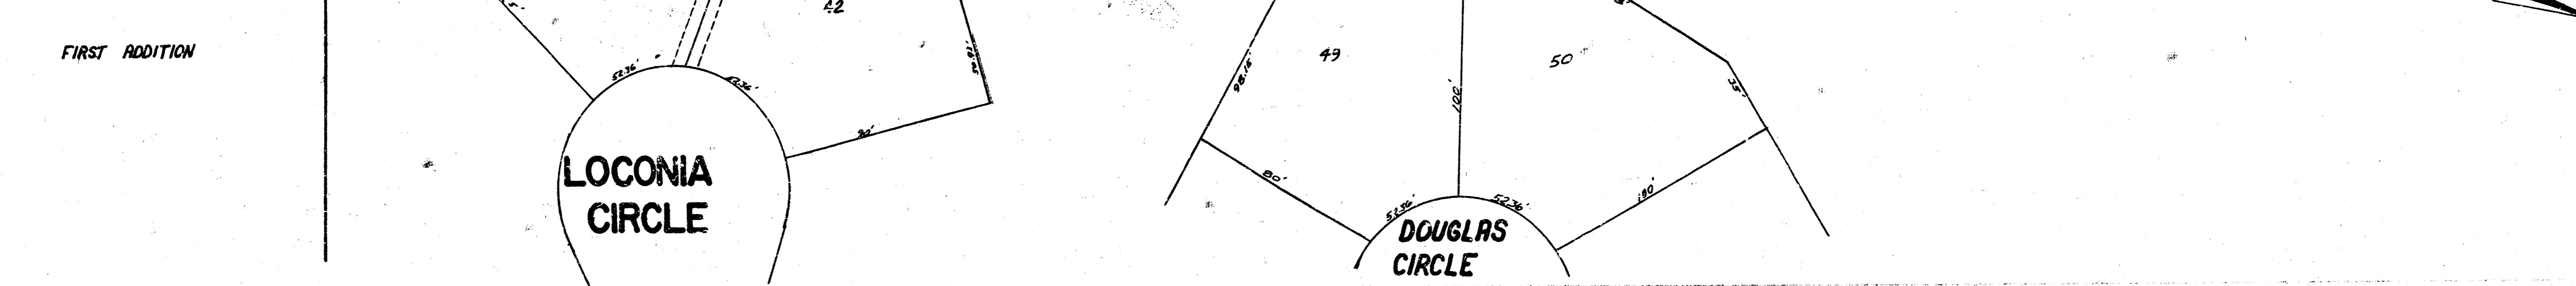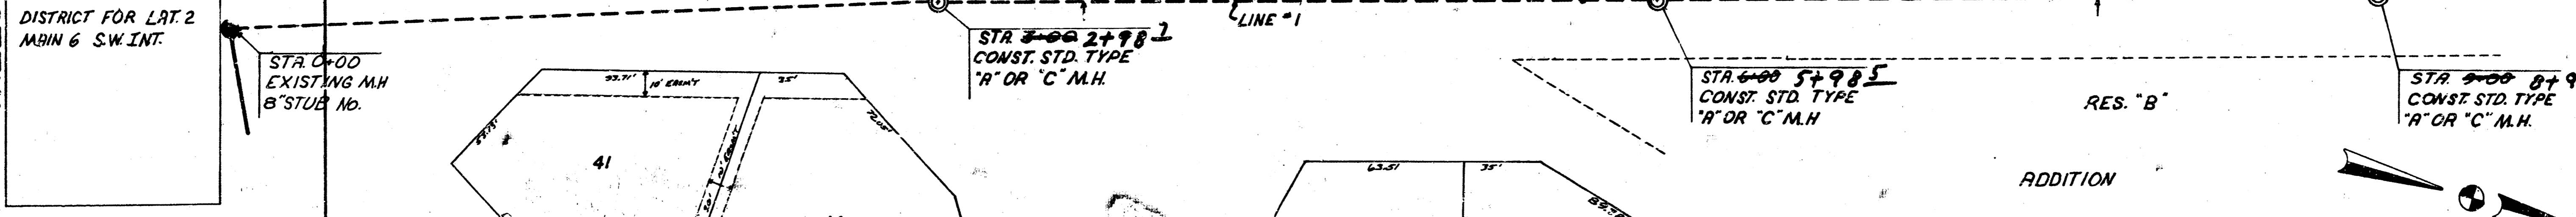
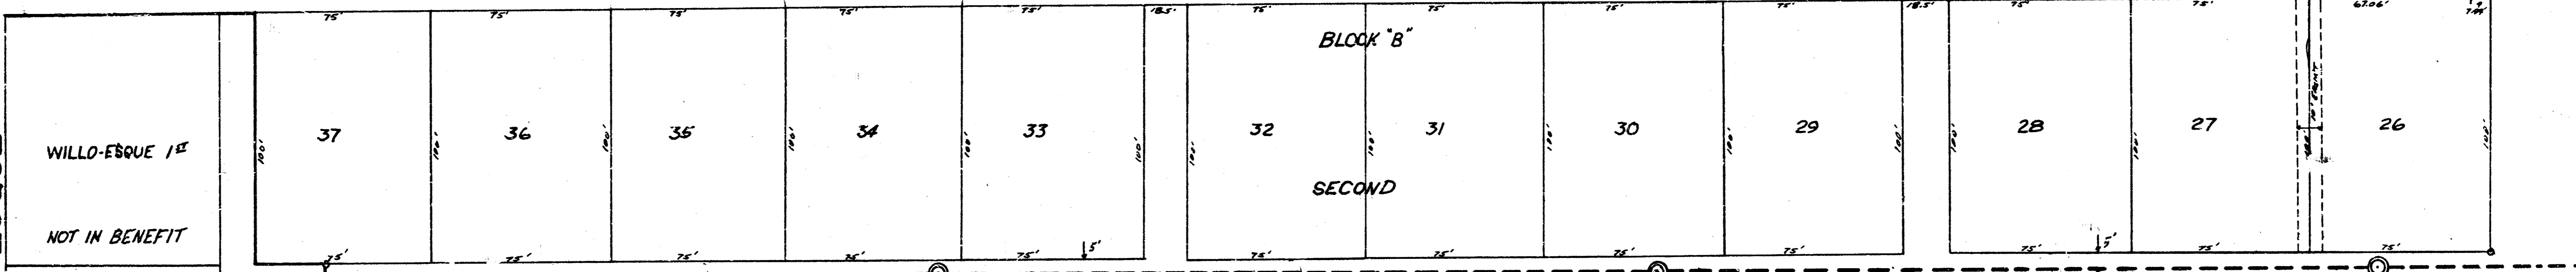


900 LIN. FT. OF 8" CLAY PIPE @ 0.75% GRADE


As Built BK. 6-1
 LAT. 2 MAIN 6 S.W. INTERCEPTOR
 CITY OF WICHITA, KANSAS
 R.W. LINN - CITY ENGINEER
 DATE: PROJ. NO. DBKL 573030
 SHEET 1 OF 5 LINE #1

SCALE:
 PLAN: 1"=40'
 PROFILE: VERT. 1"=5'
 HORT: 1"=40'

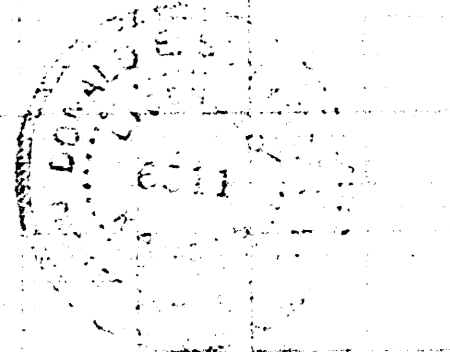

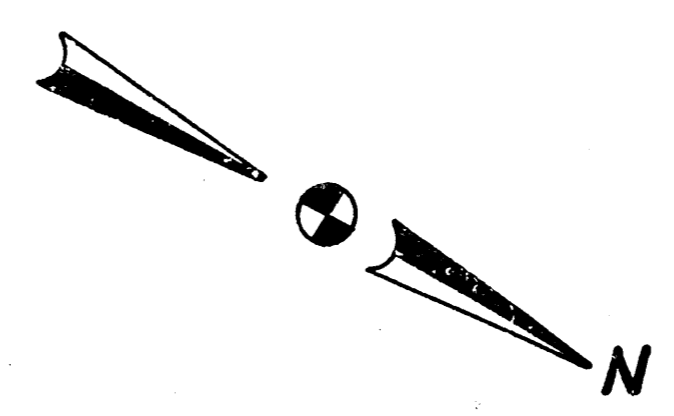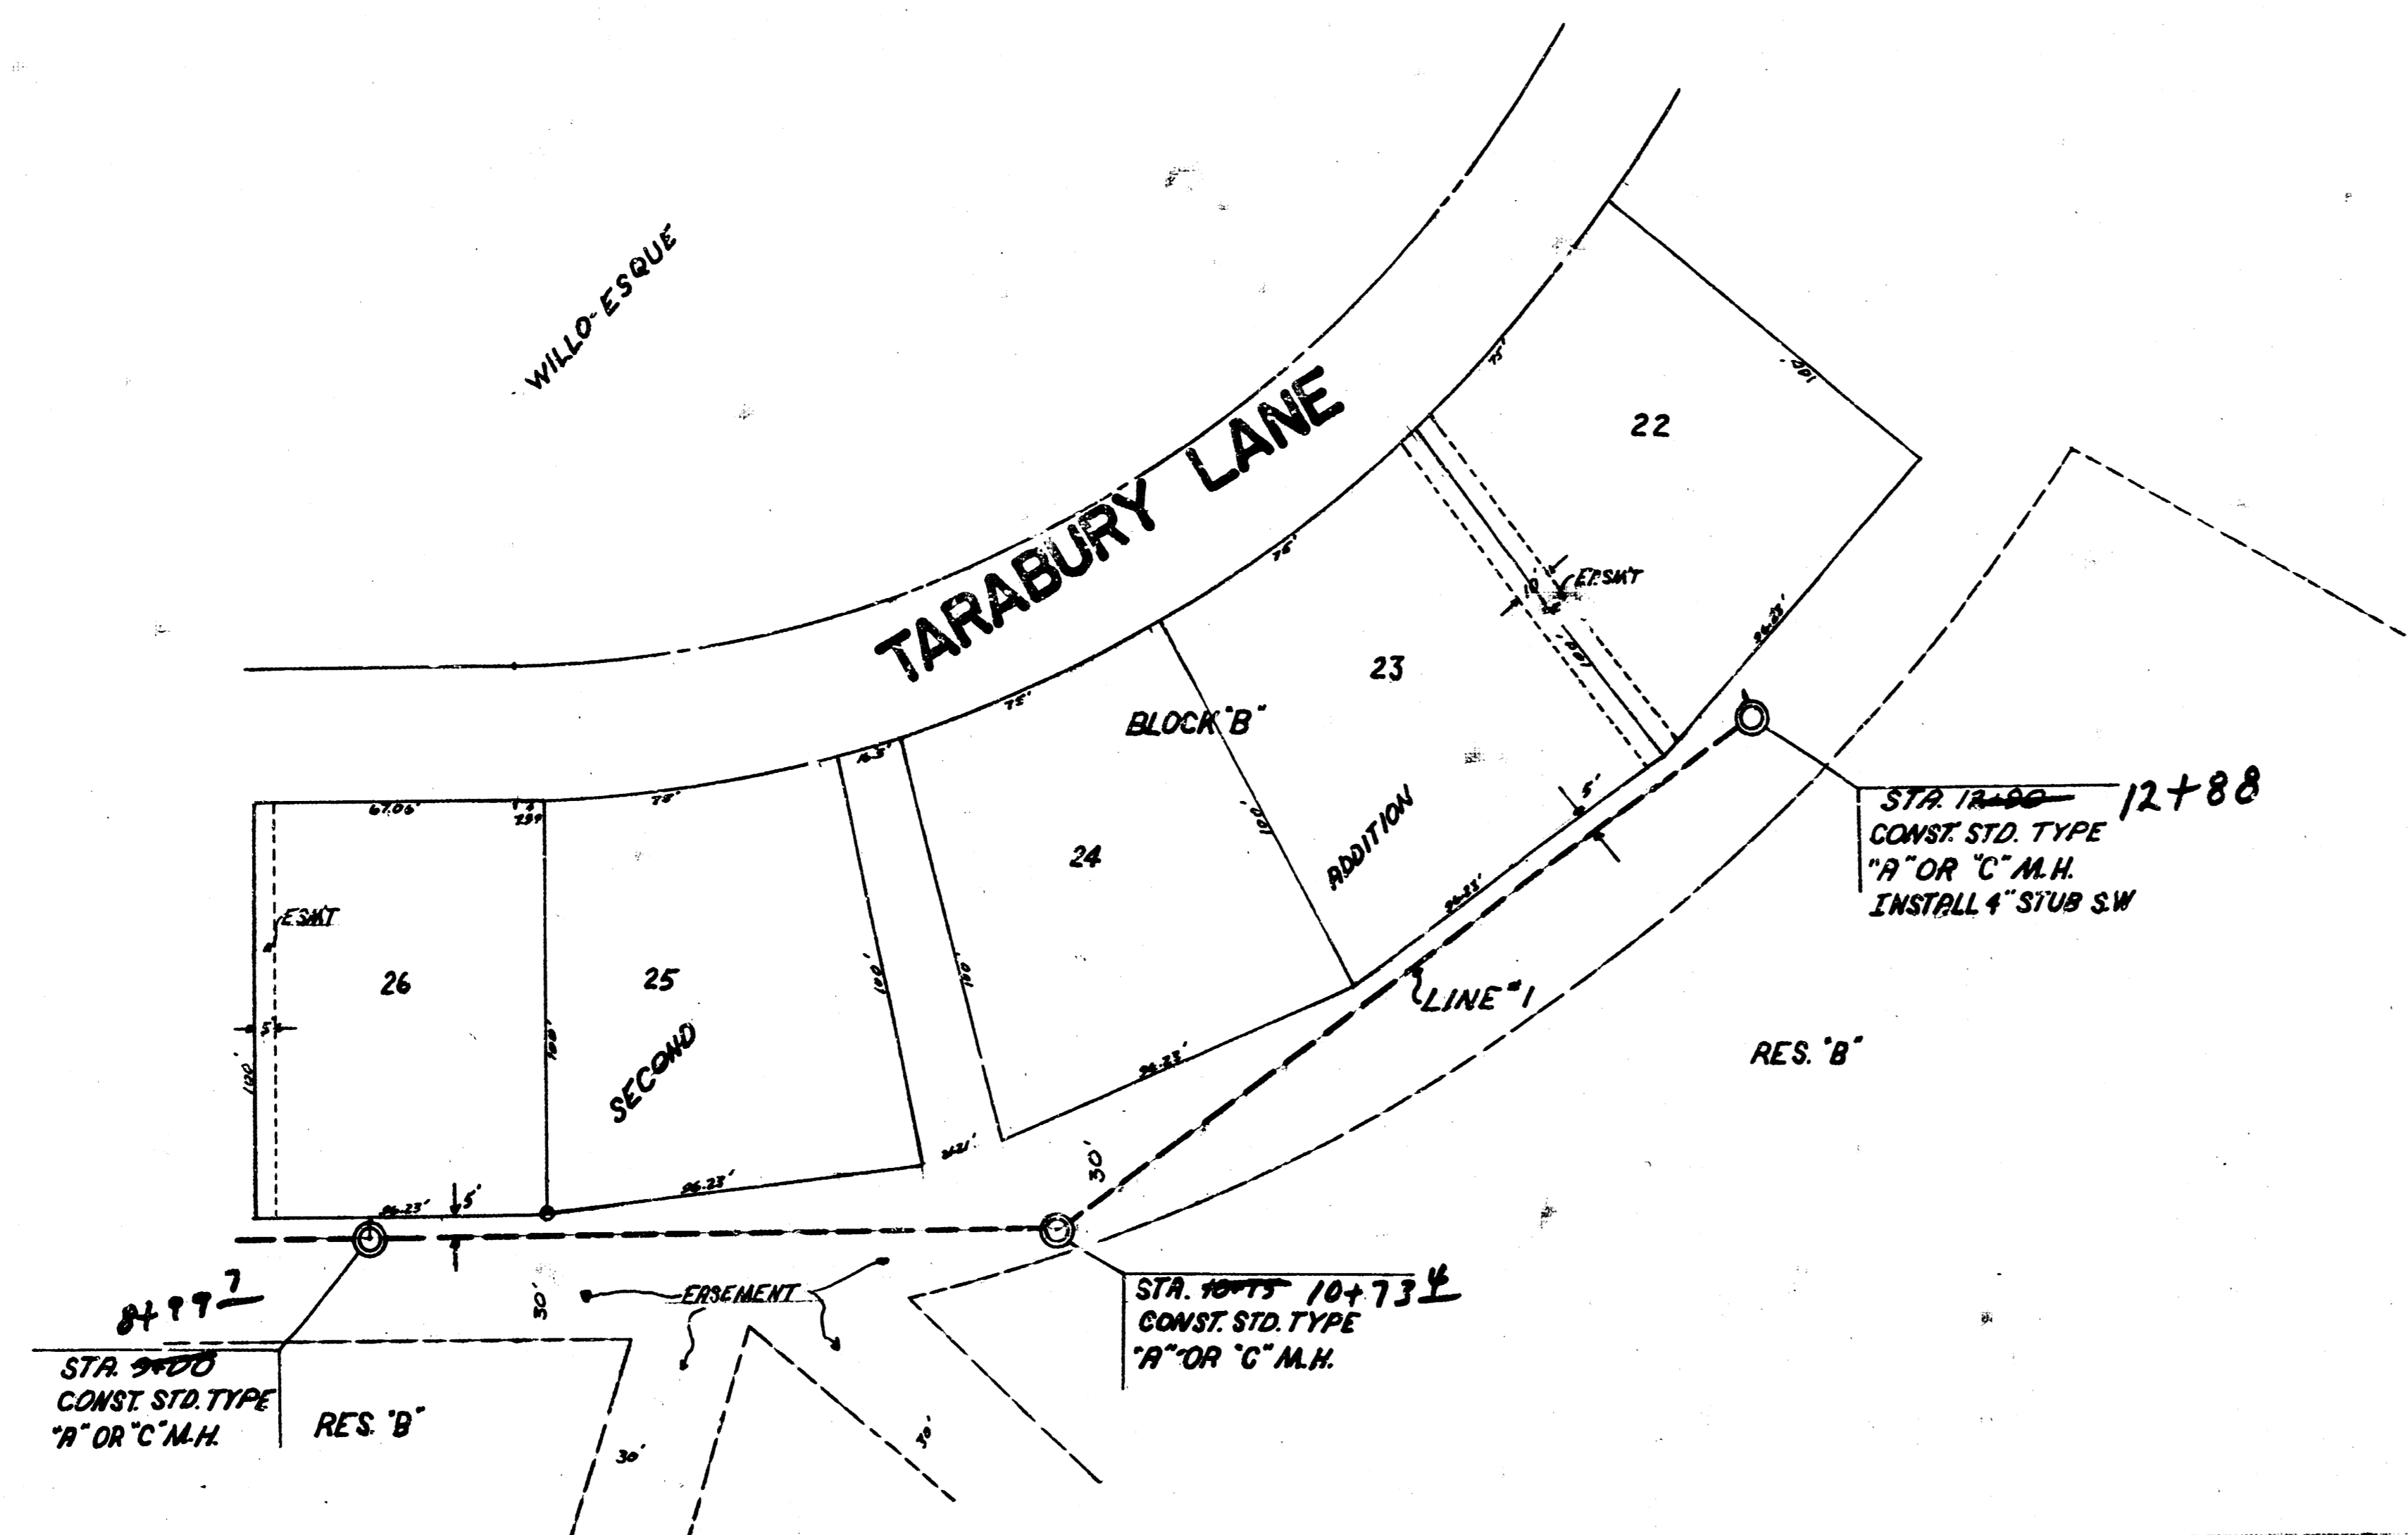



SCALES:
 PLAN: 1"=40'
 PROFILE: 1"=10'
 VERT: 1"=5'

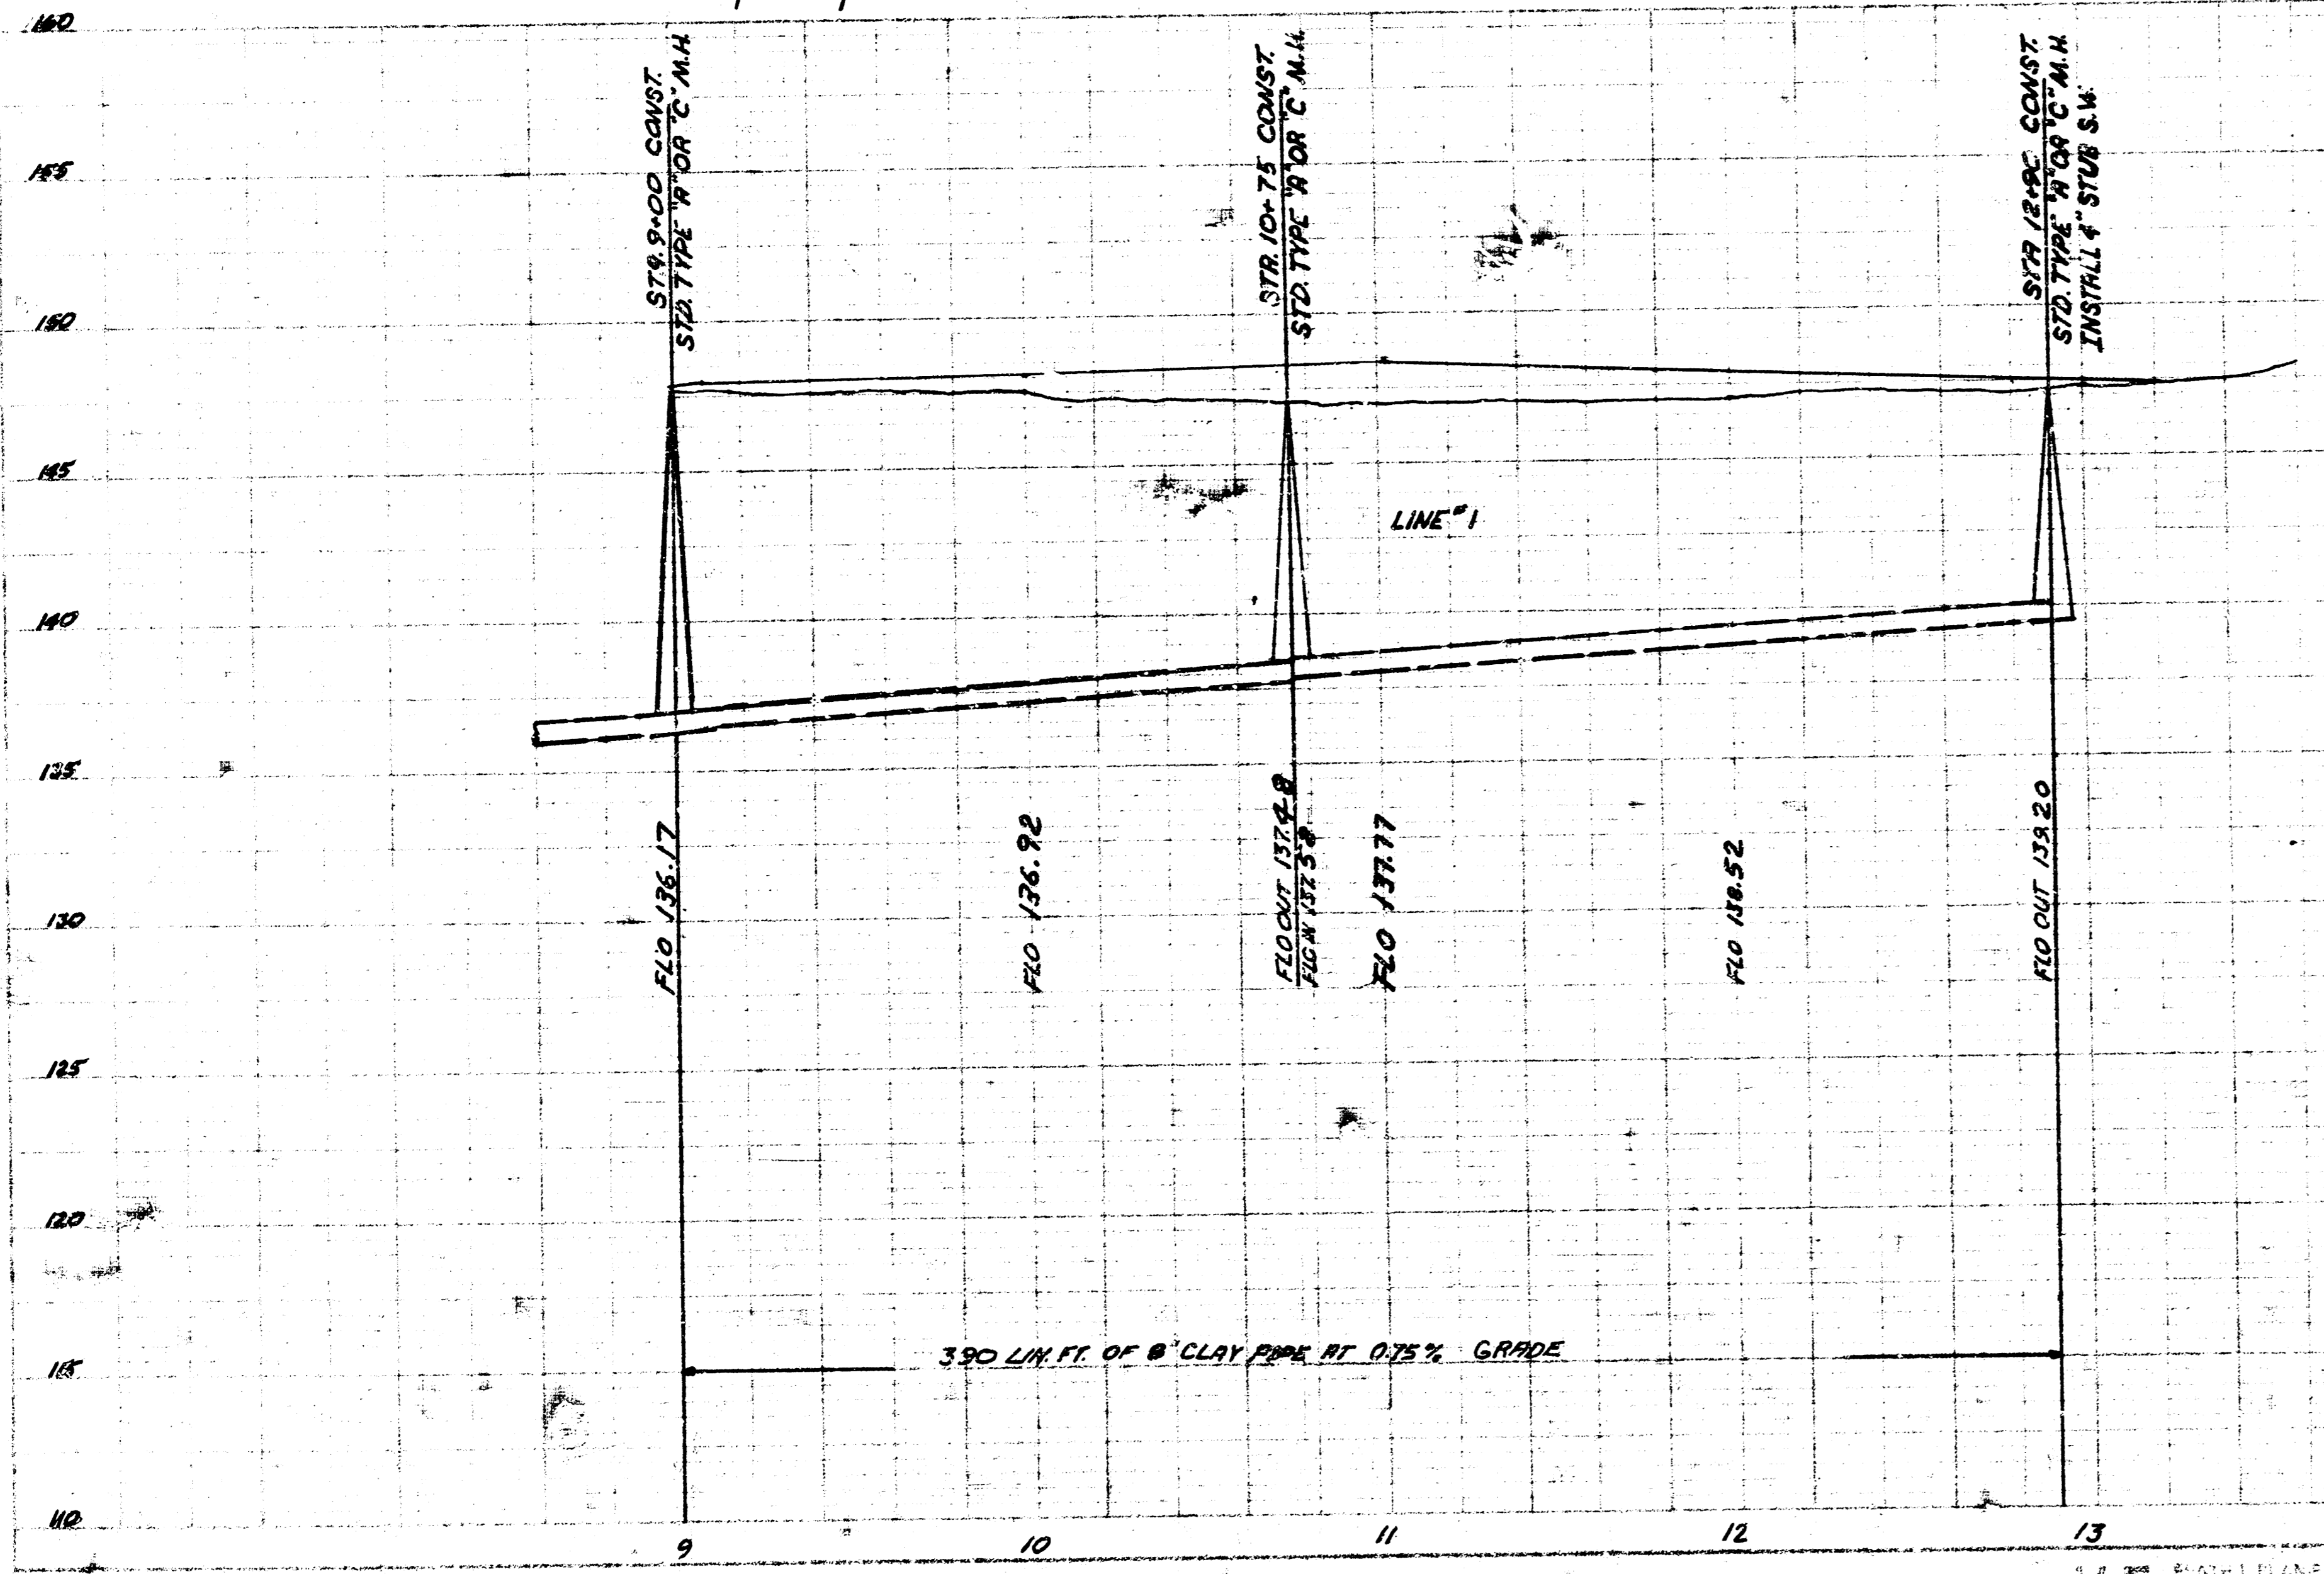


LAT. 2 MAN 6 S.W. INTERCEPTOR
 PROJ. NO. DBKL 573030
 LINE NO. 1 SHEET 2 OF 5

2/5

ENGINEER: [Signature]
 SURVEYOR: [Signature]
 DATE: [Date]

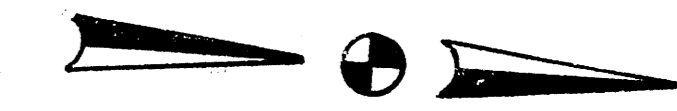
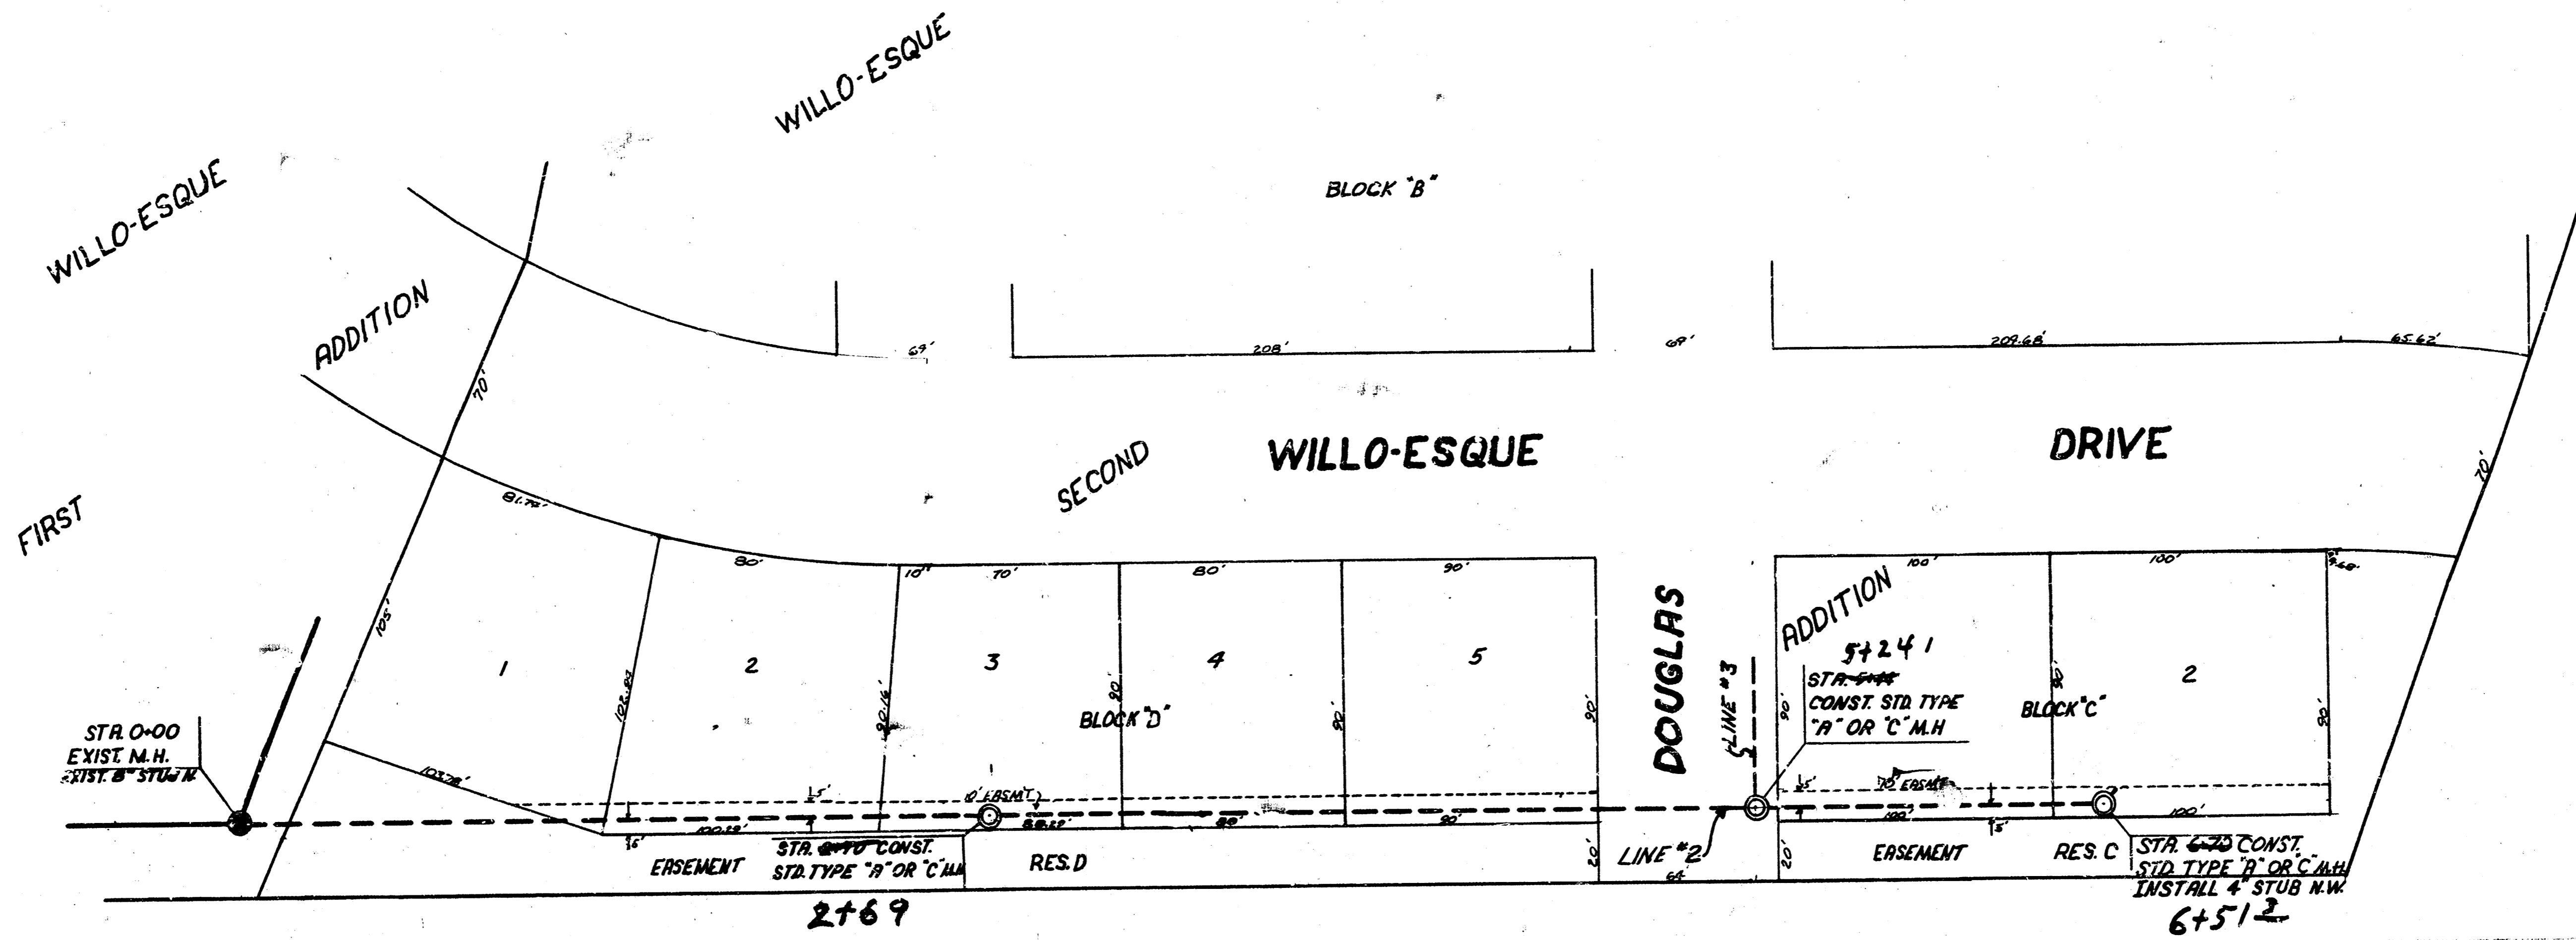


SCALE
 PLAN: 1"=40'
 PROFILE: HORIZ. 1"=40'
 VERT. 1"=5'

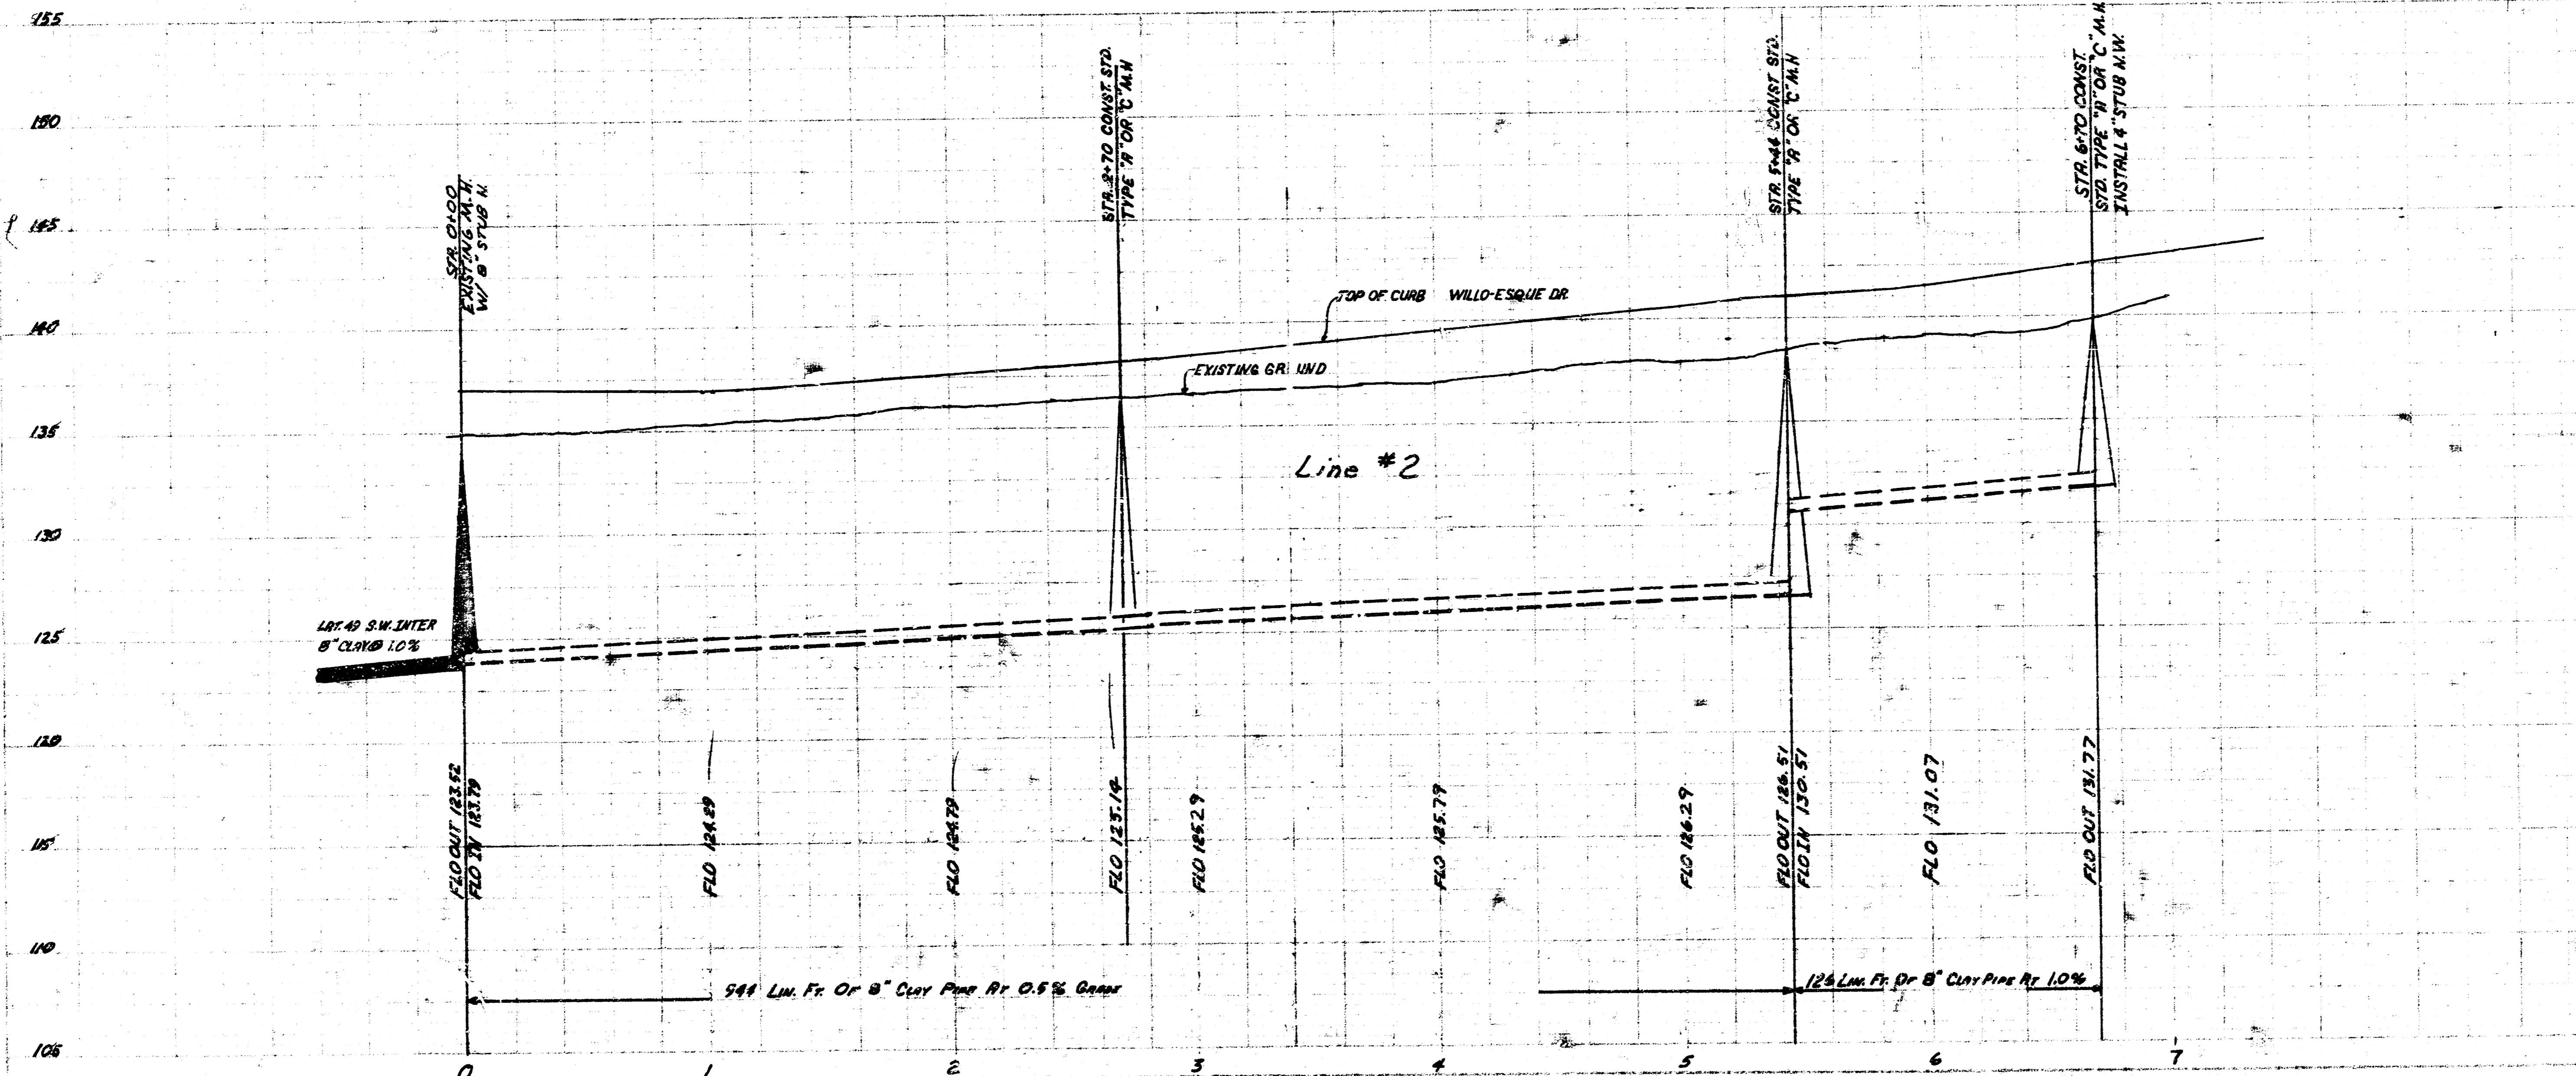


LAT. 2, MAIN 6, S. W. INTERCEPTOR
 LINE #2 PROJ. NO. DAKL573030
 SHEET 3 OF 5



3/5

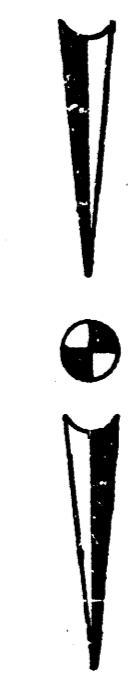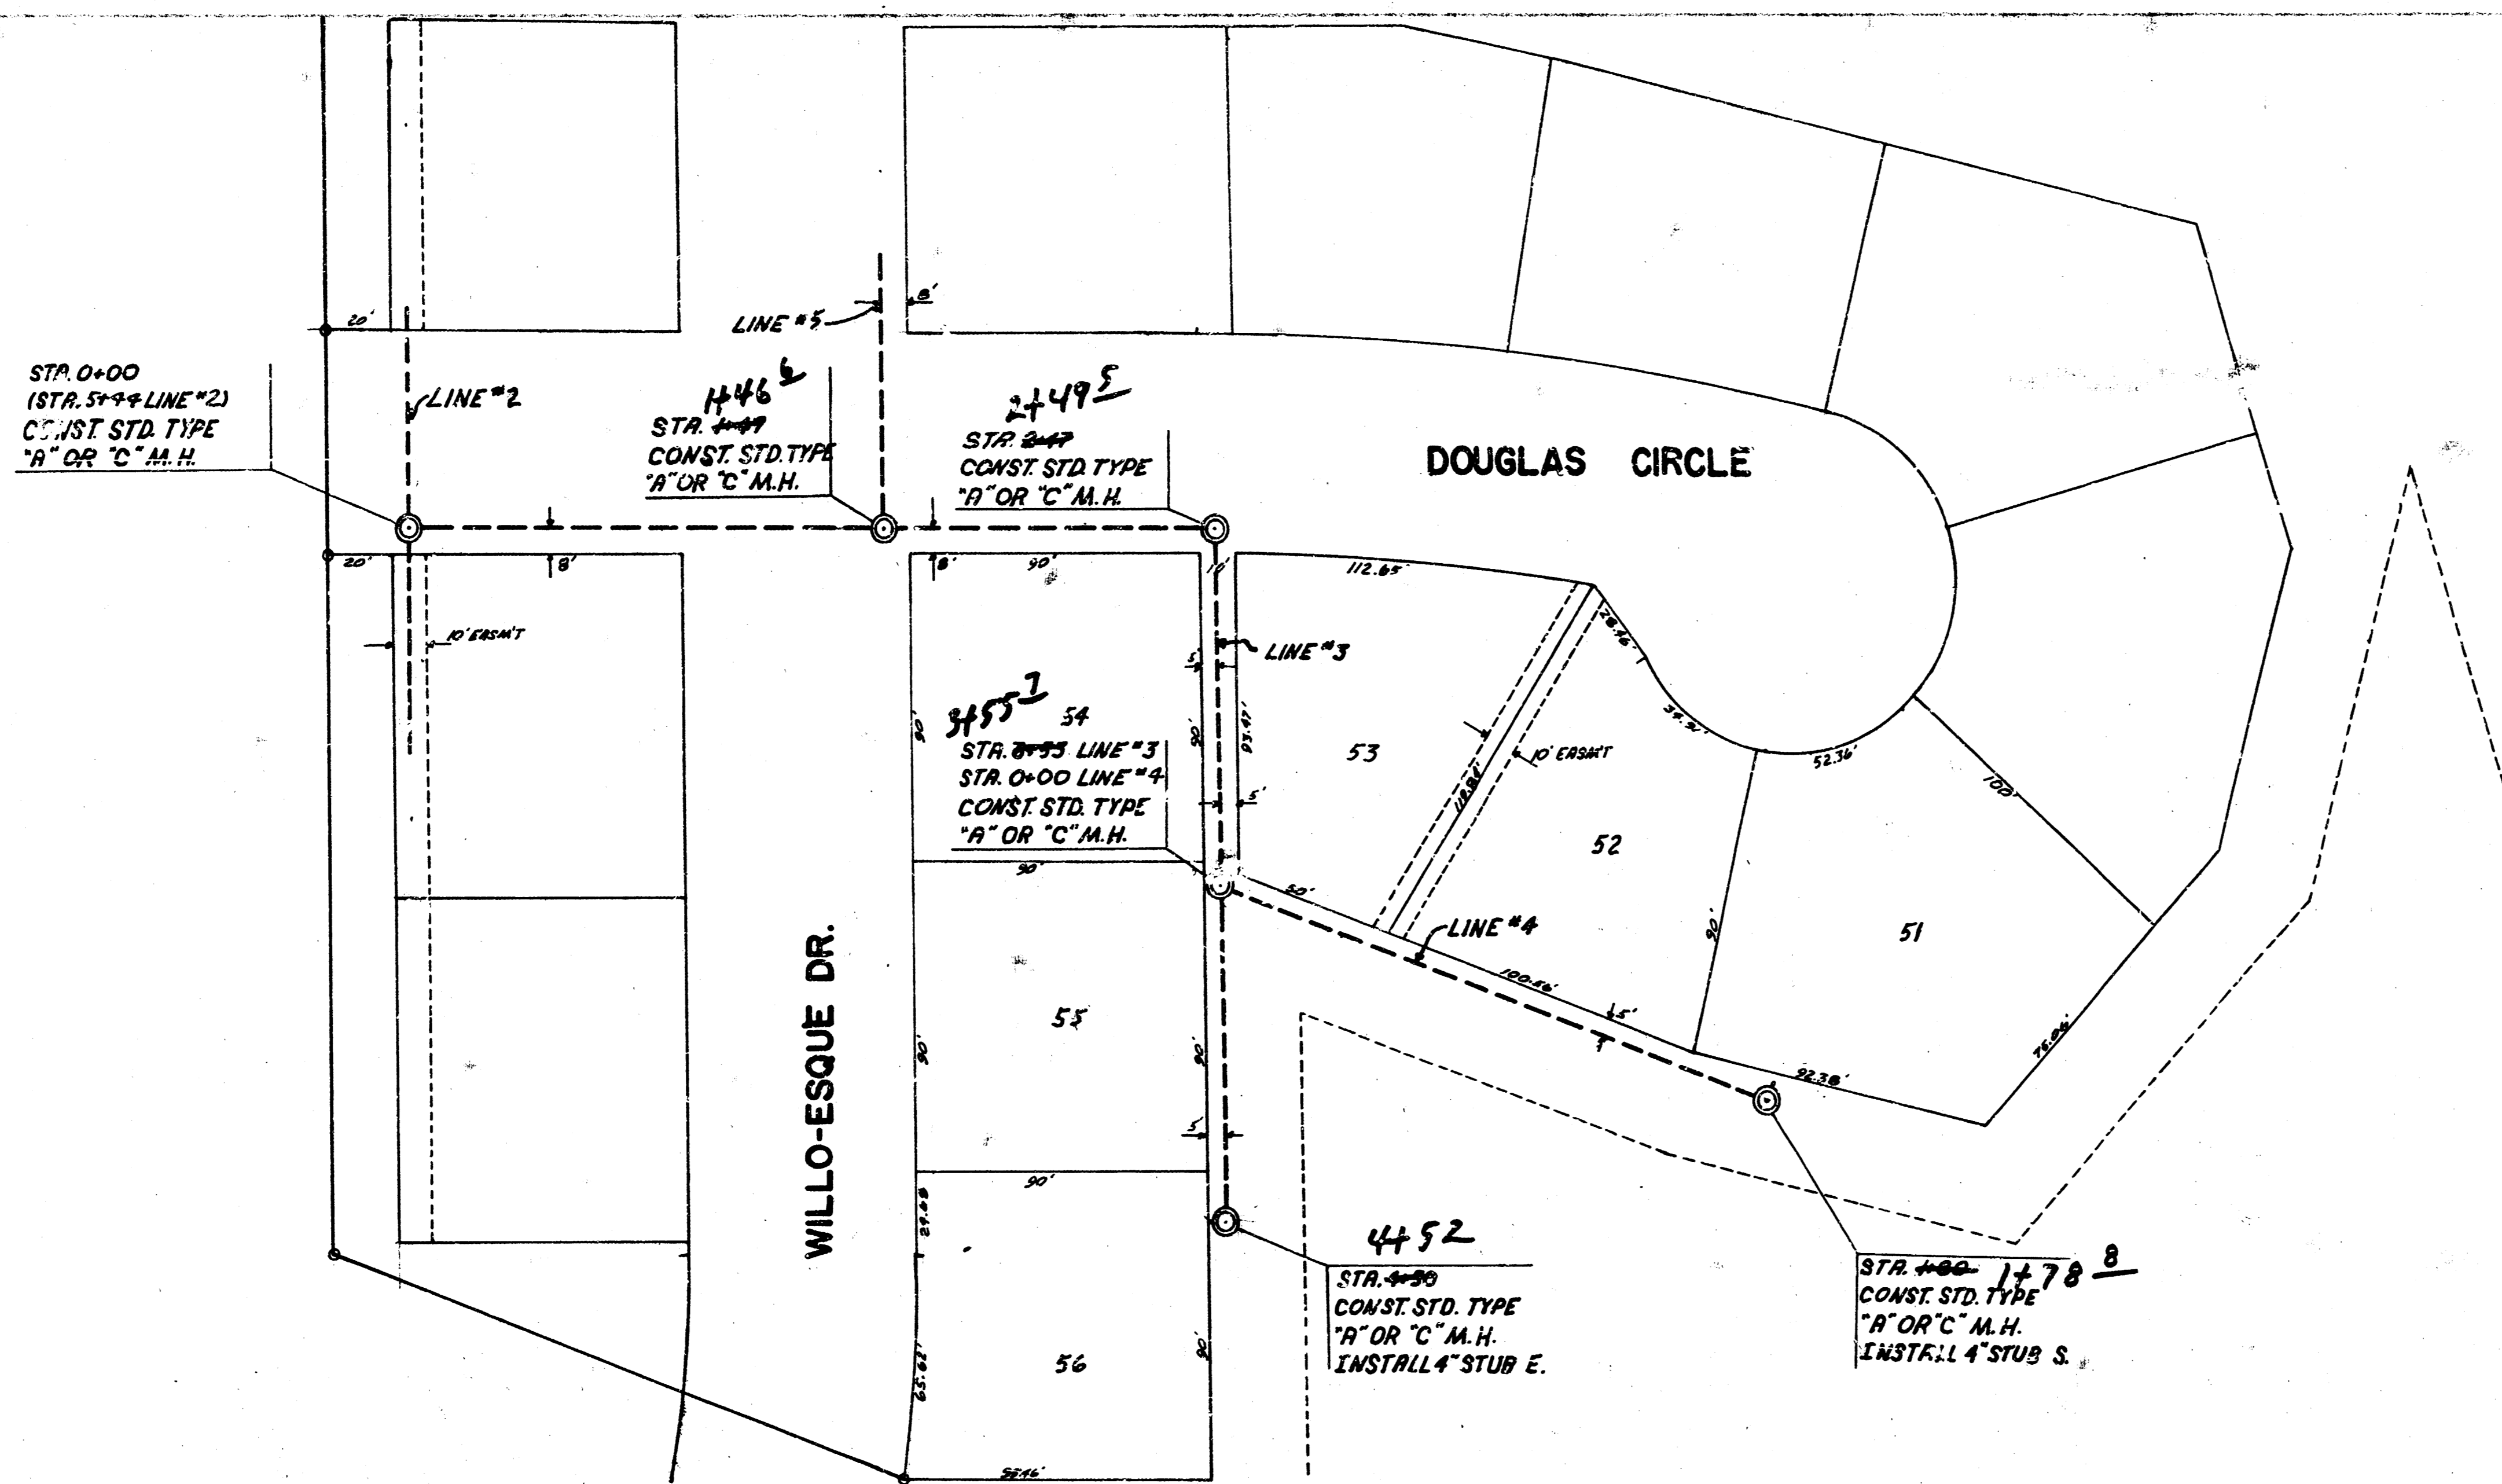


SCALE:
 PLAN: 1"=40'
 PROFILE: 1"=40'
 VERT: 1"=5'

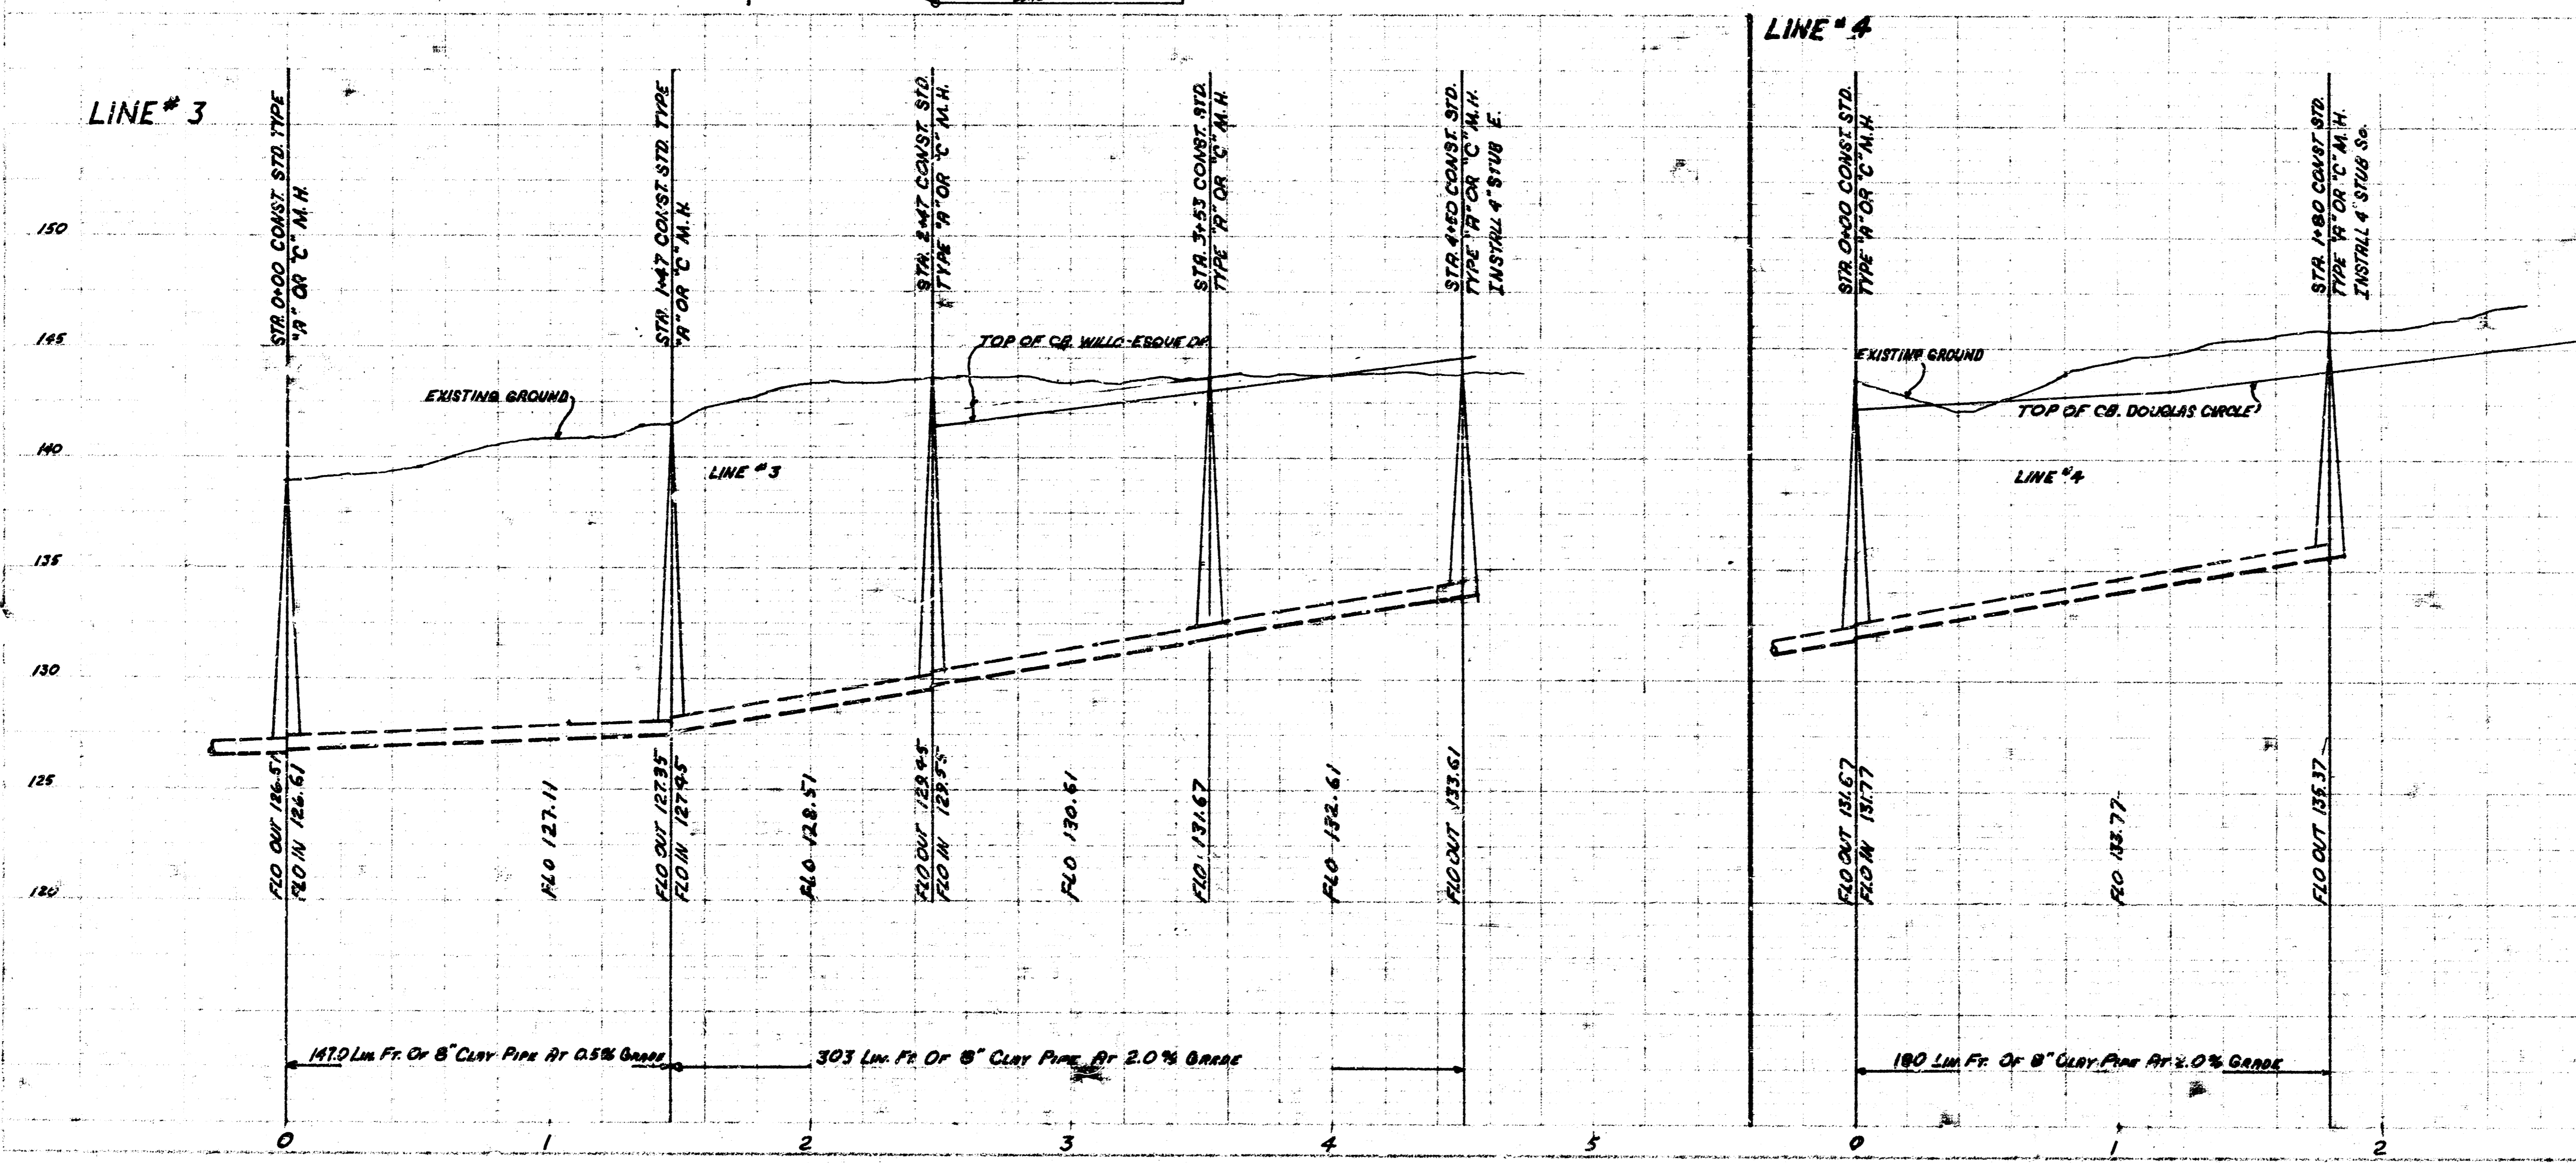

LAT. 2 MAIN 6 S.W. INTERCEPTOR
 LINES 3+4 PROJ. NO. DBKL573030
 SHEET 4 OF 5

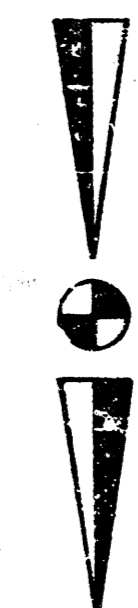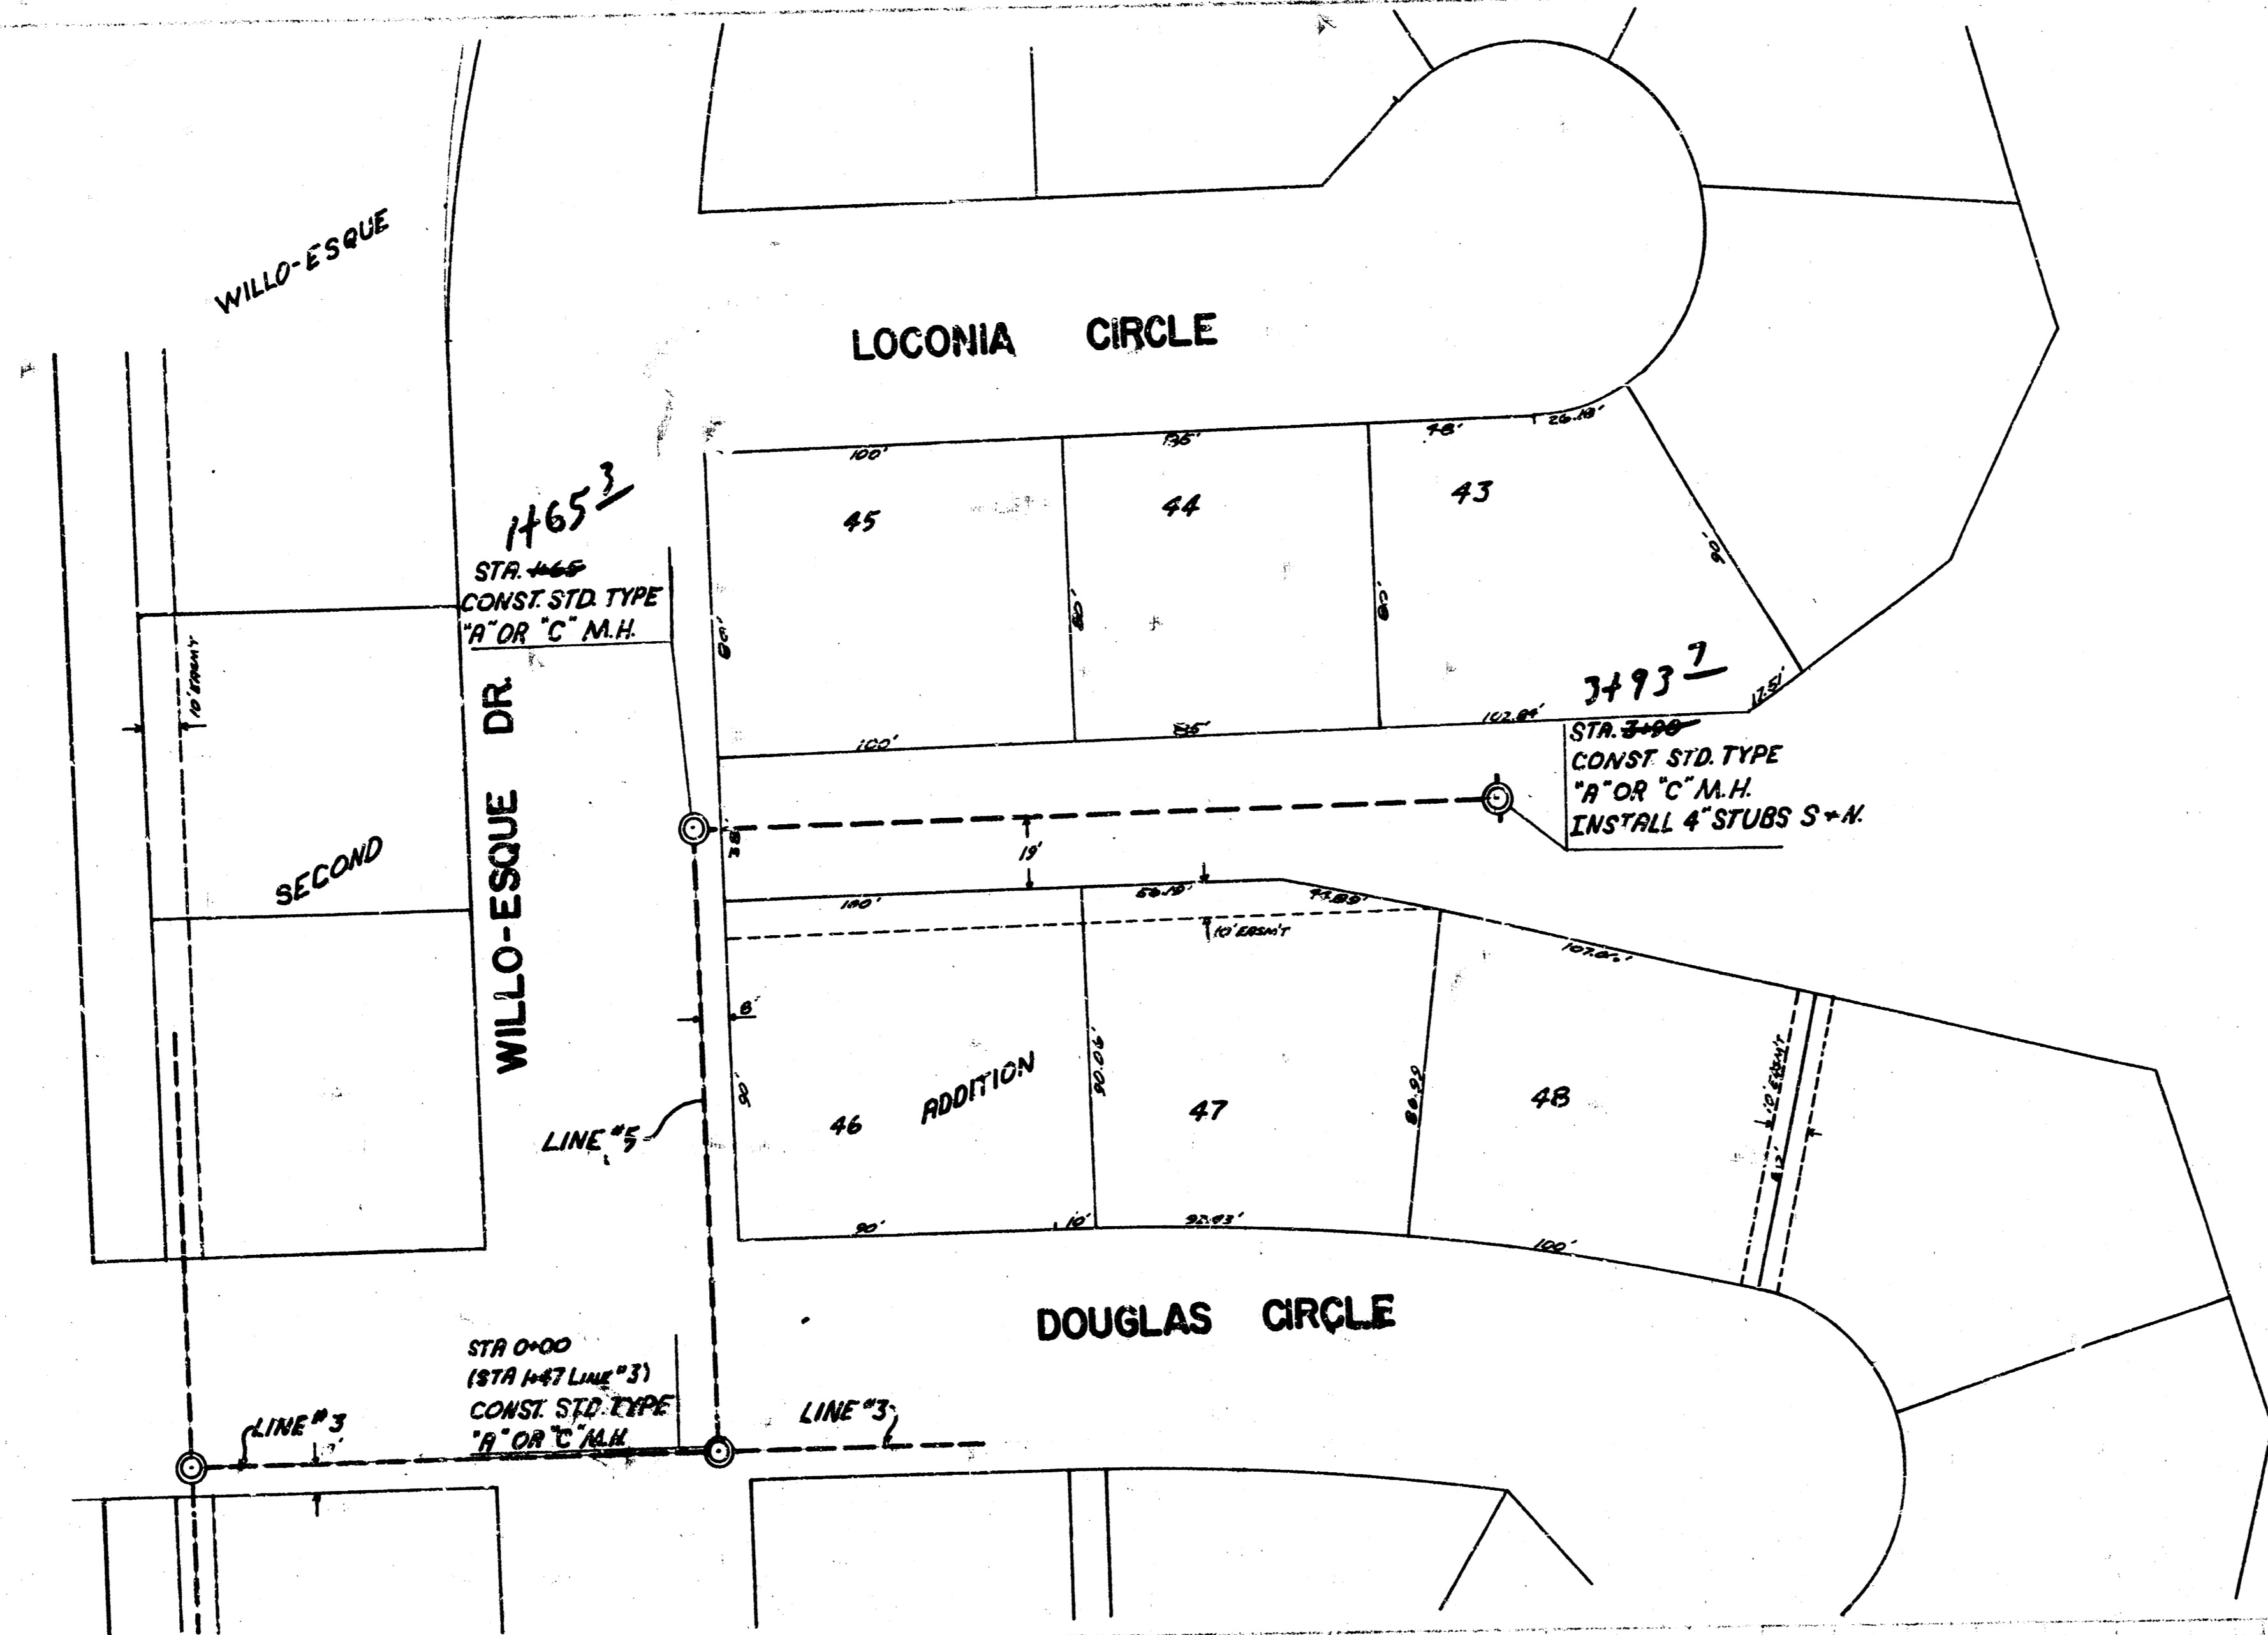

SCALE
 PLAN 1"=40'
 PROFILE: HORIZ 1"=40'
 VERT 1"=5'

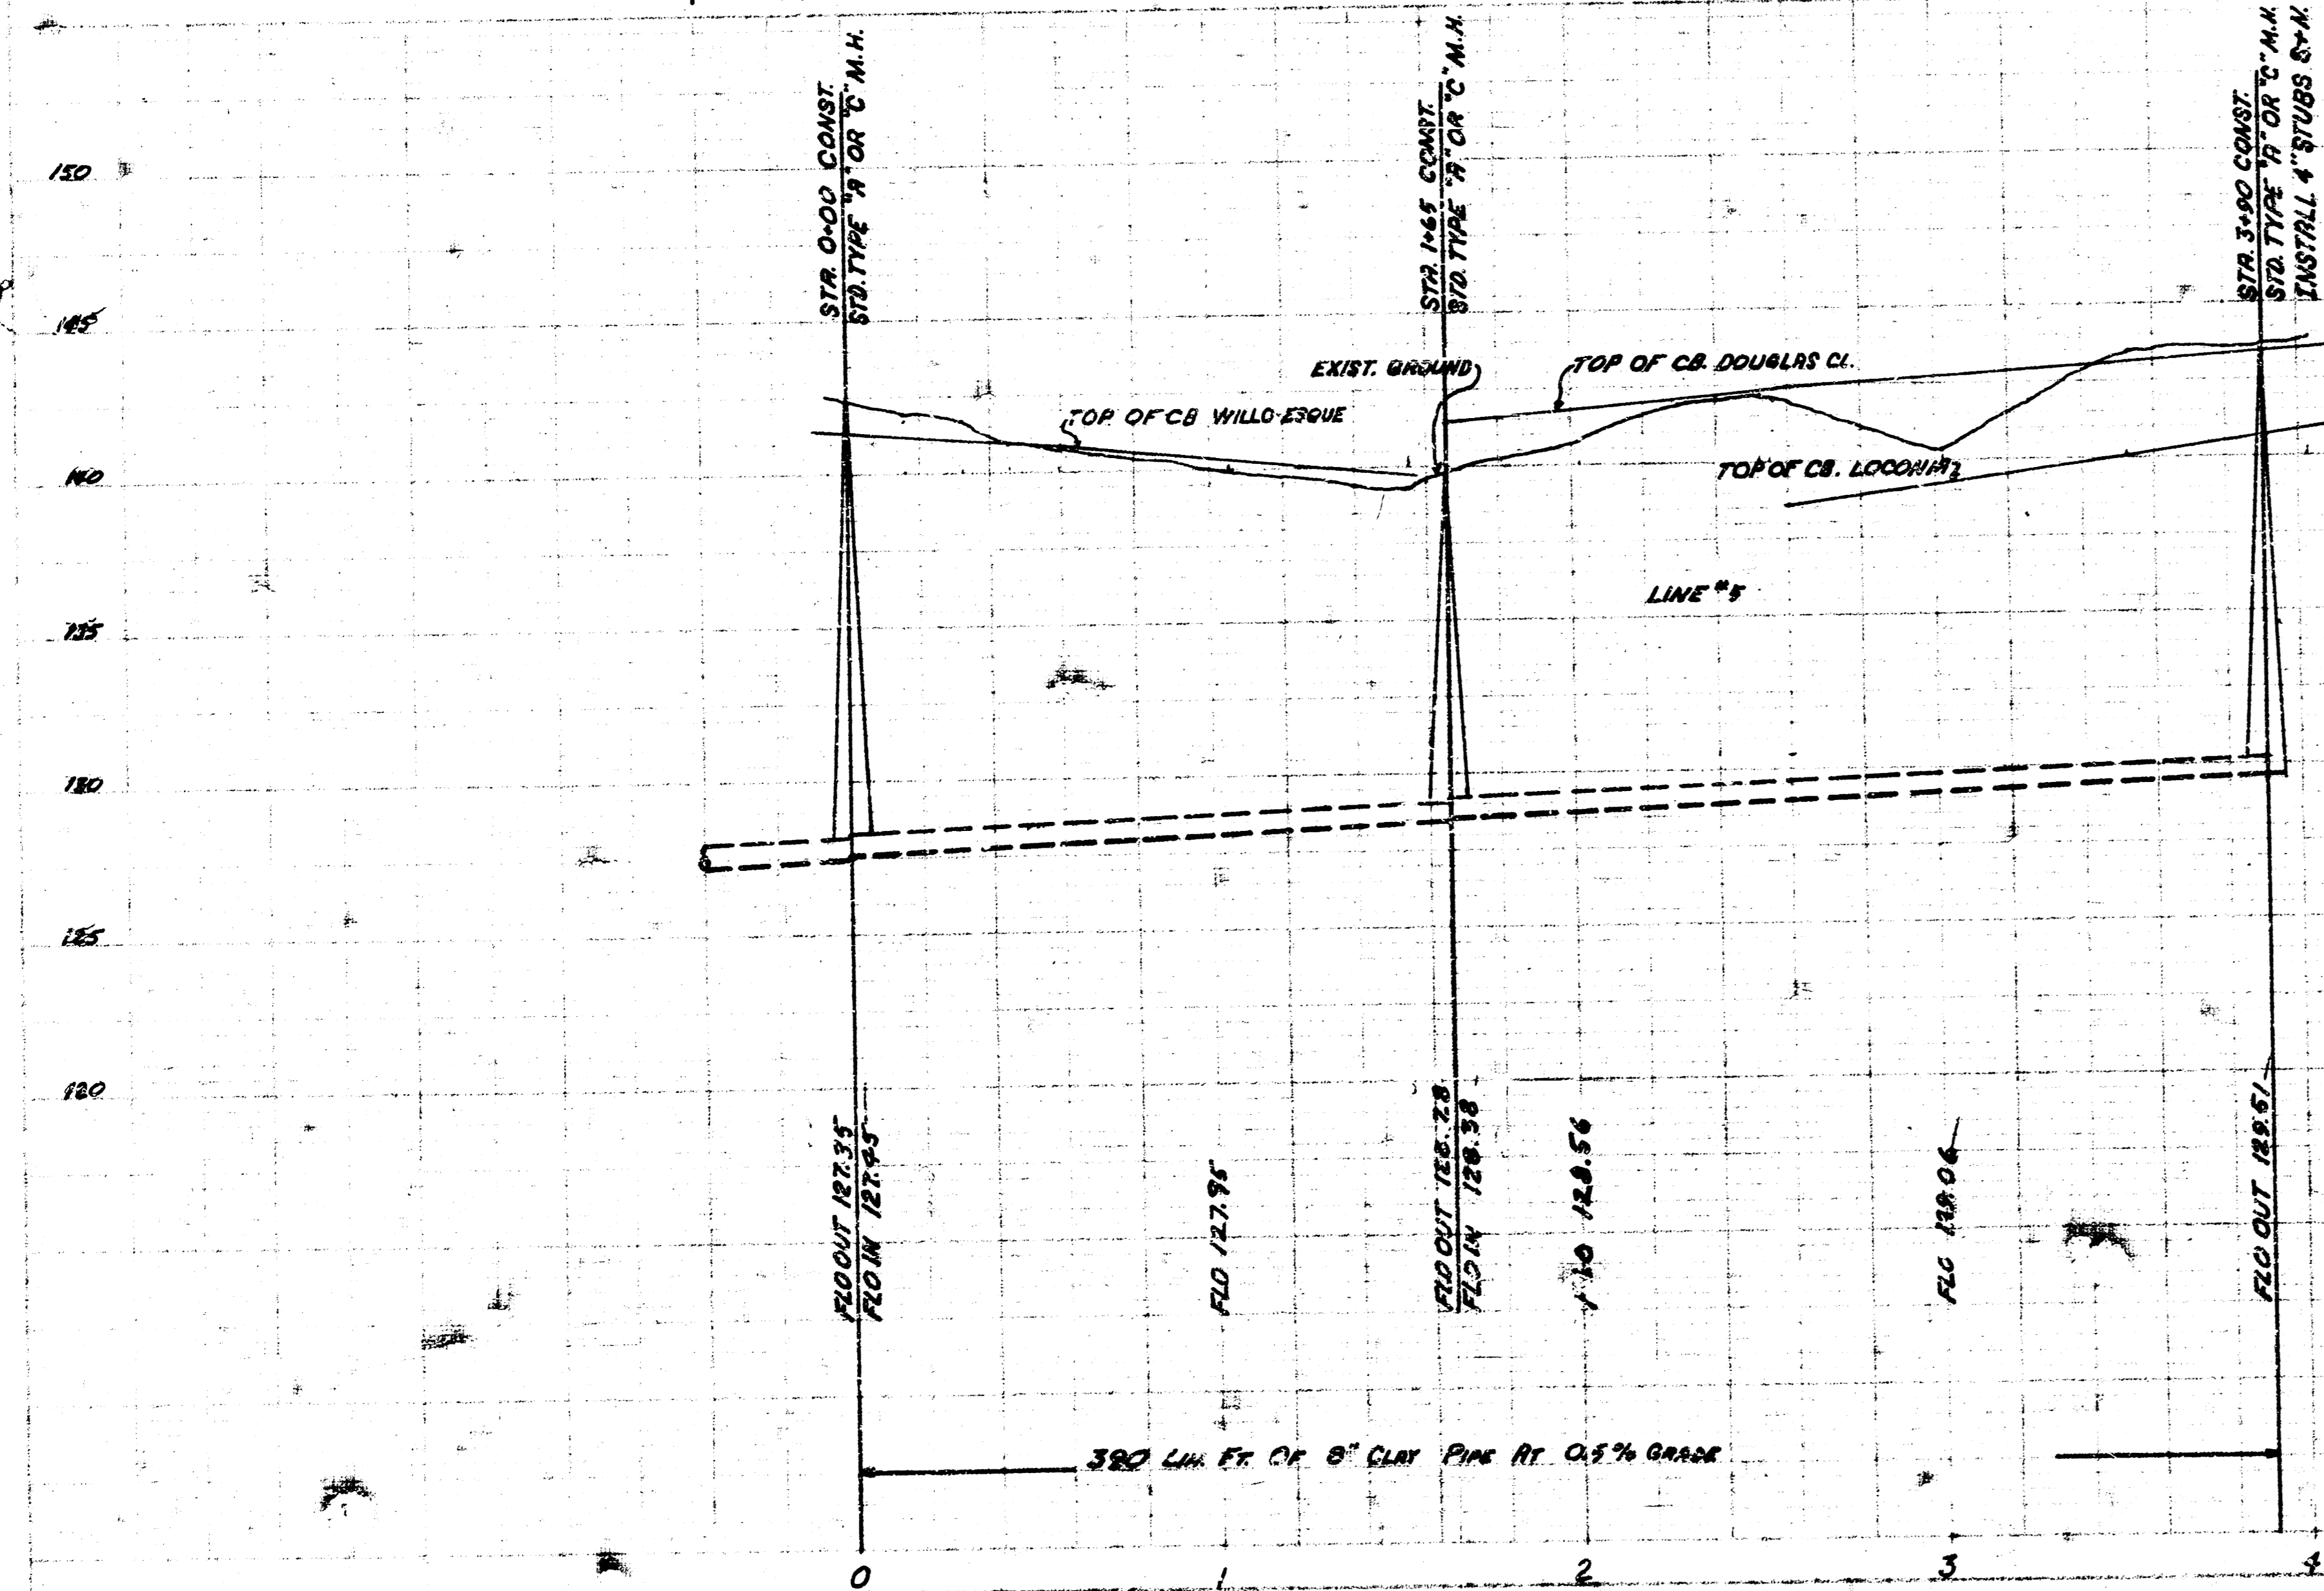

LAT. 2 MAIN 6 S.W. INTERCEPTOR
 LINE # 5
 PROJ. NO. DBKL573030
 SHEET 5 OF 5

5/5