
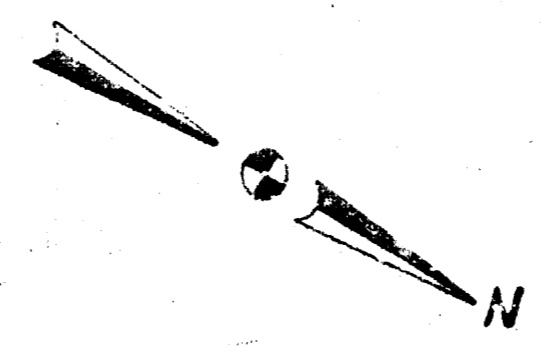


B.M. 14164 CITY STD. 54'E + 42'S OF C. RIDGE RD. + MAPLE
 B.M. 14164 'D' TOP OF AD. CURB WILLO-ESQUE DR. + E.L. TARABURY
 B.M. 13754 'D' N.E. END RET. S.E. COR WILLO-ESQUE DR. + C'YMARIE CIR


SCALE:
 PLAN: 1"=40'
 PROFILE: VERT. 1"=5'
 HORIZ. 1"=40'

As Built P.K. G-1
 LAT. 2 MAIN 6 S.W. INTERCEPTOR
 CITY OF WICHITA, KANSAS
 R.W. LINN - CITY ENGINEER
 DATE: PROJ. NO. DAKLST3030
 SHEET 1 OF 5 LINE #1

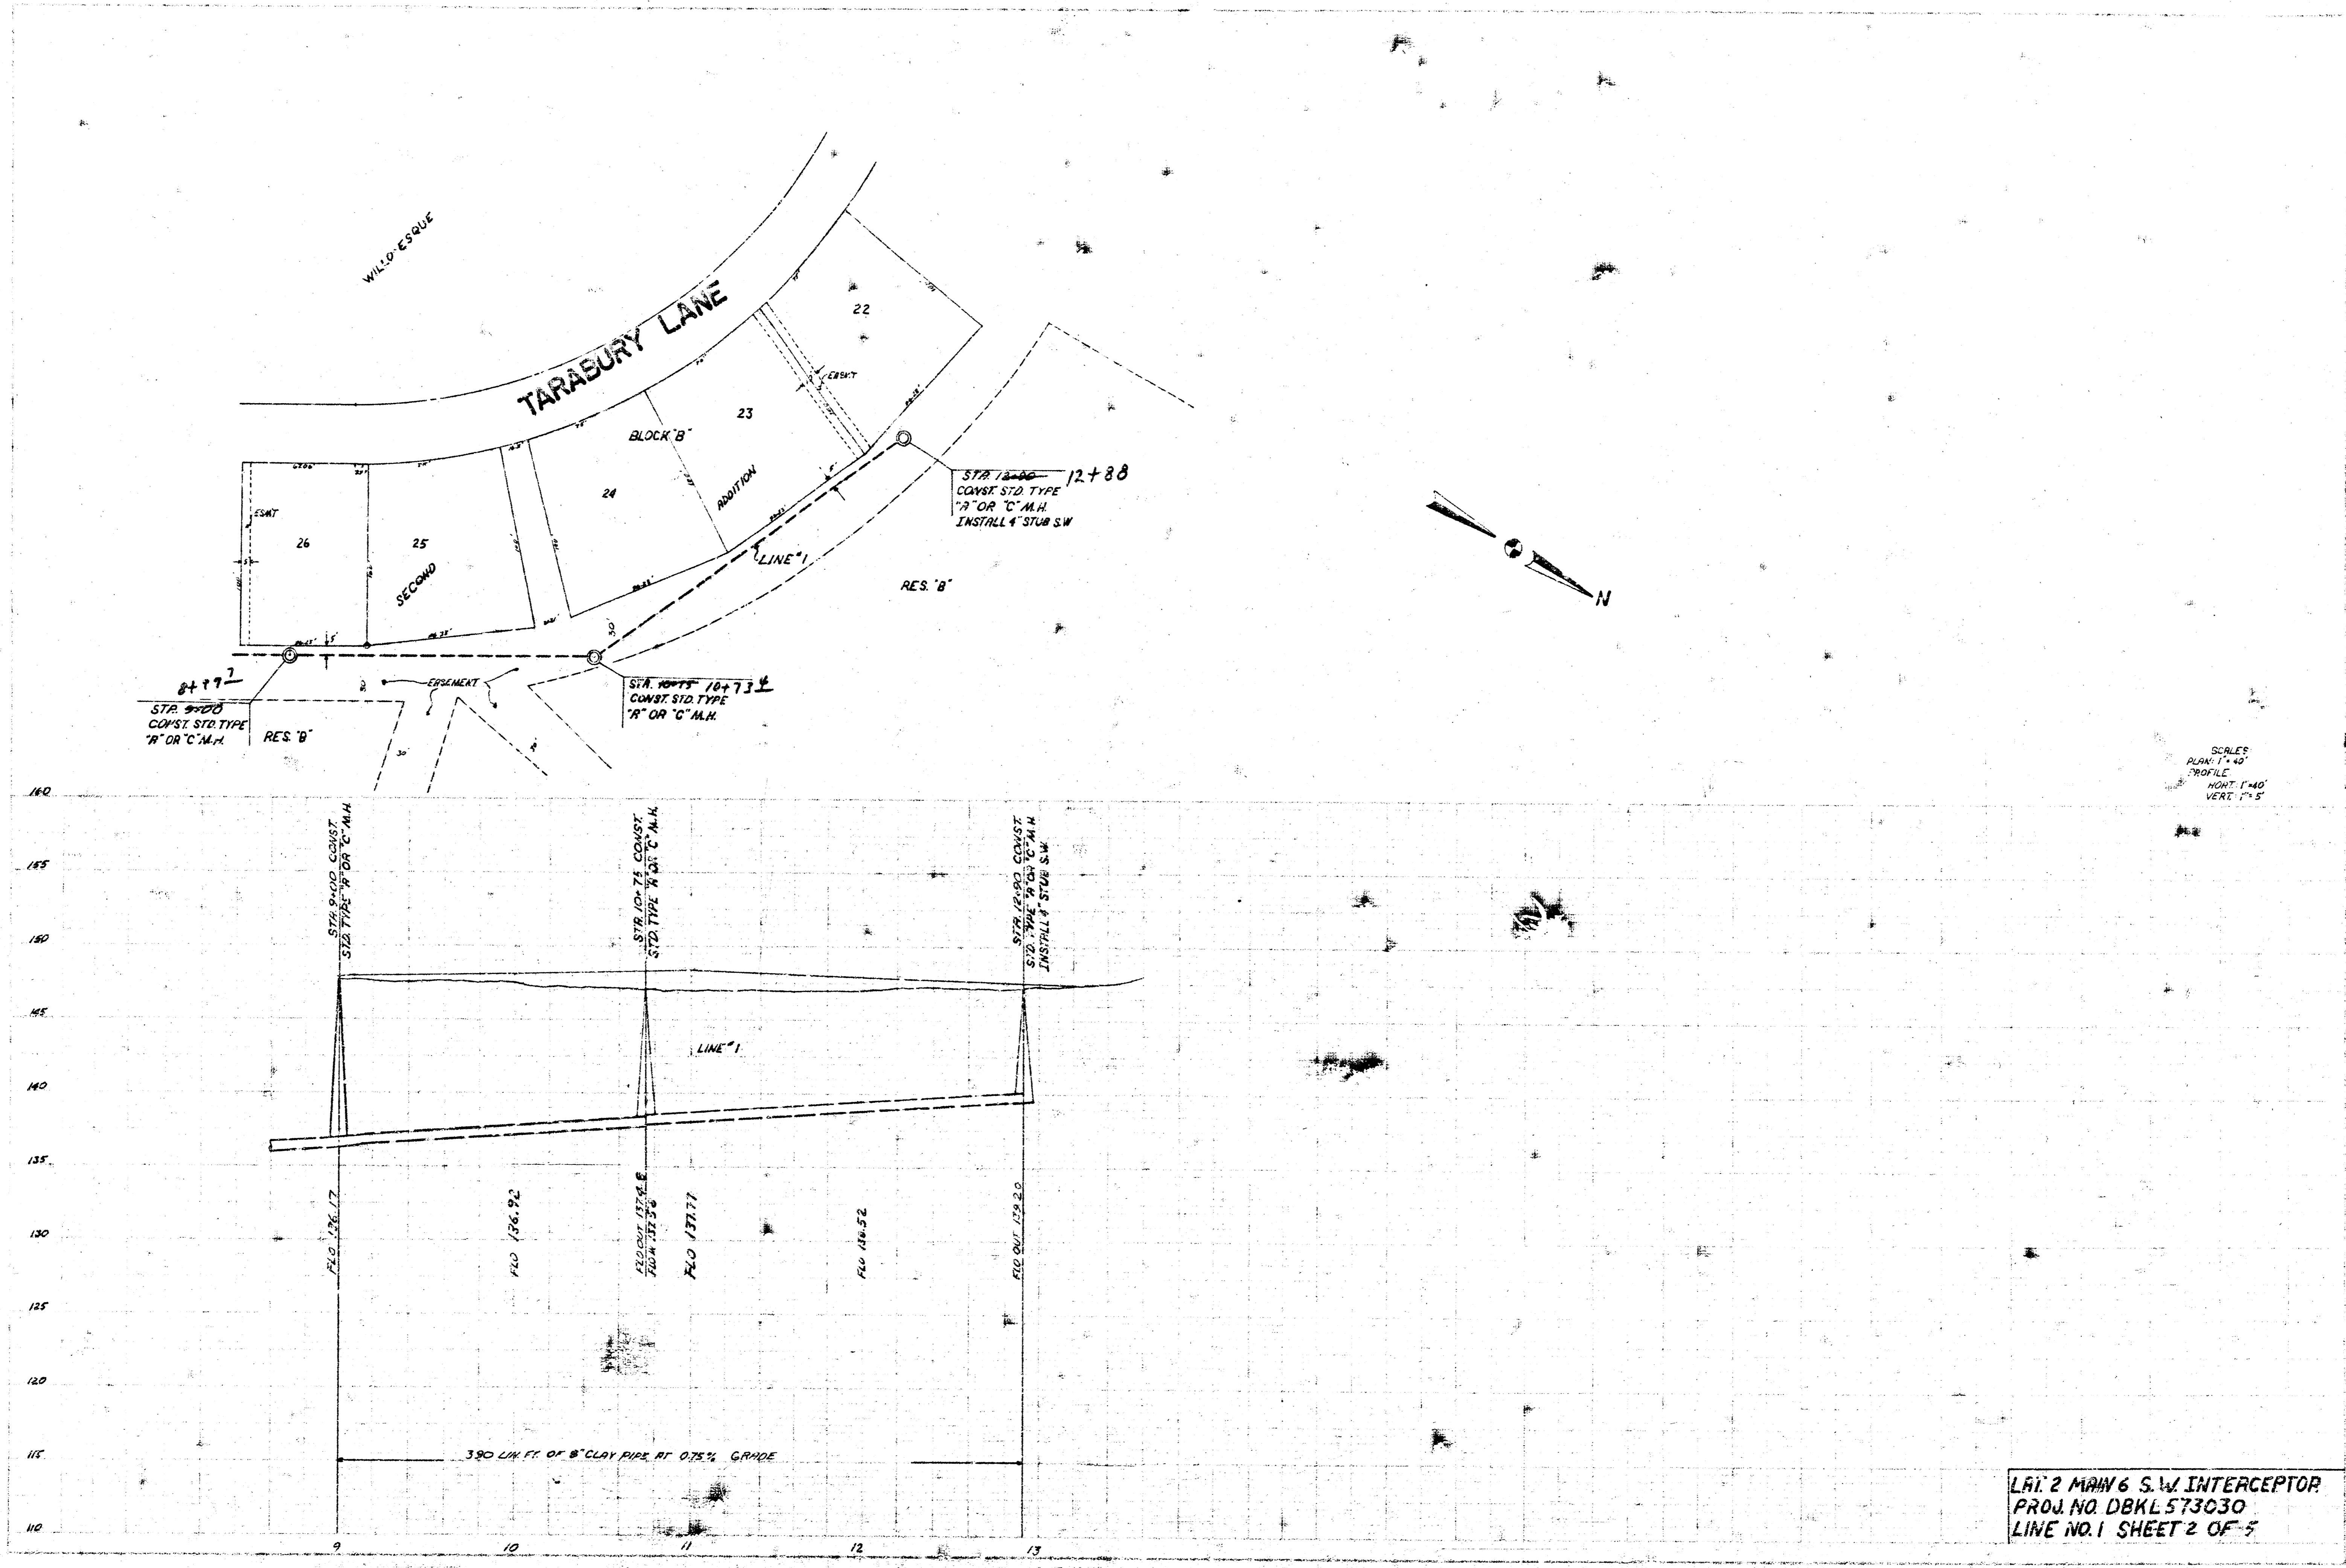


SCALES
 PLAN 1"=40'
 PROFILE
 HORIZ 1"=40'
 VERT 1"=5'


LAY. 2 MAIN 6 S.W. INTERCEPTOR
 PROJ. NO. DBKL 573030
 LINE NO. 1 SHEET 2 OF 5

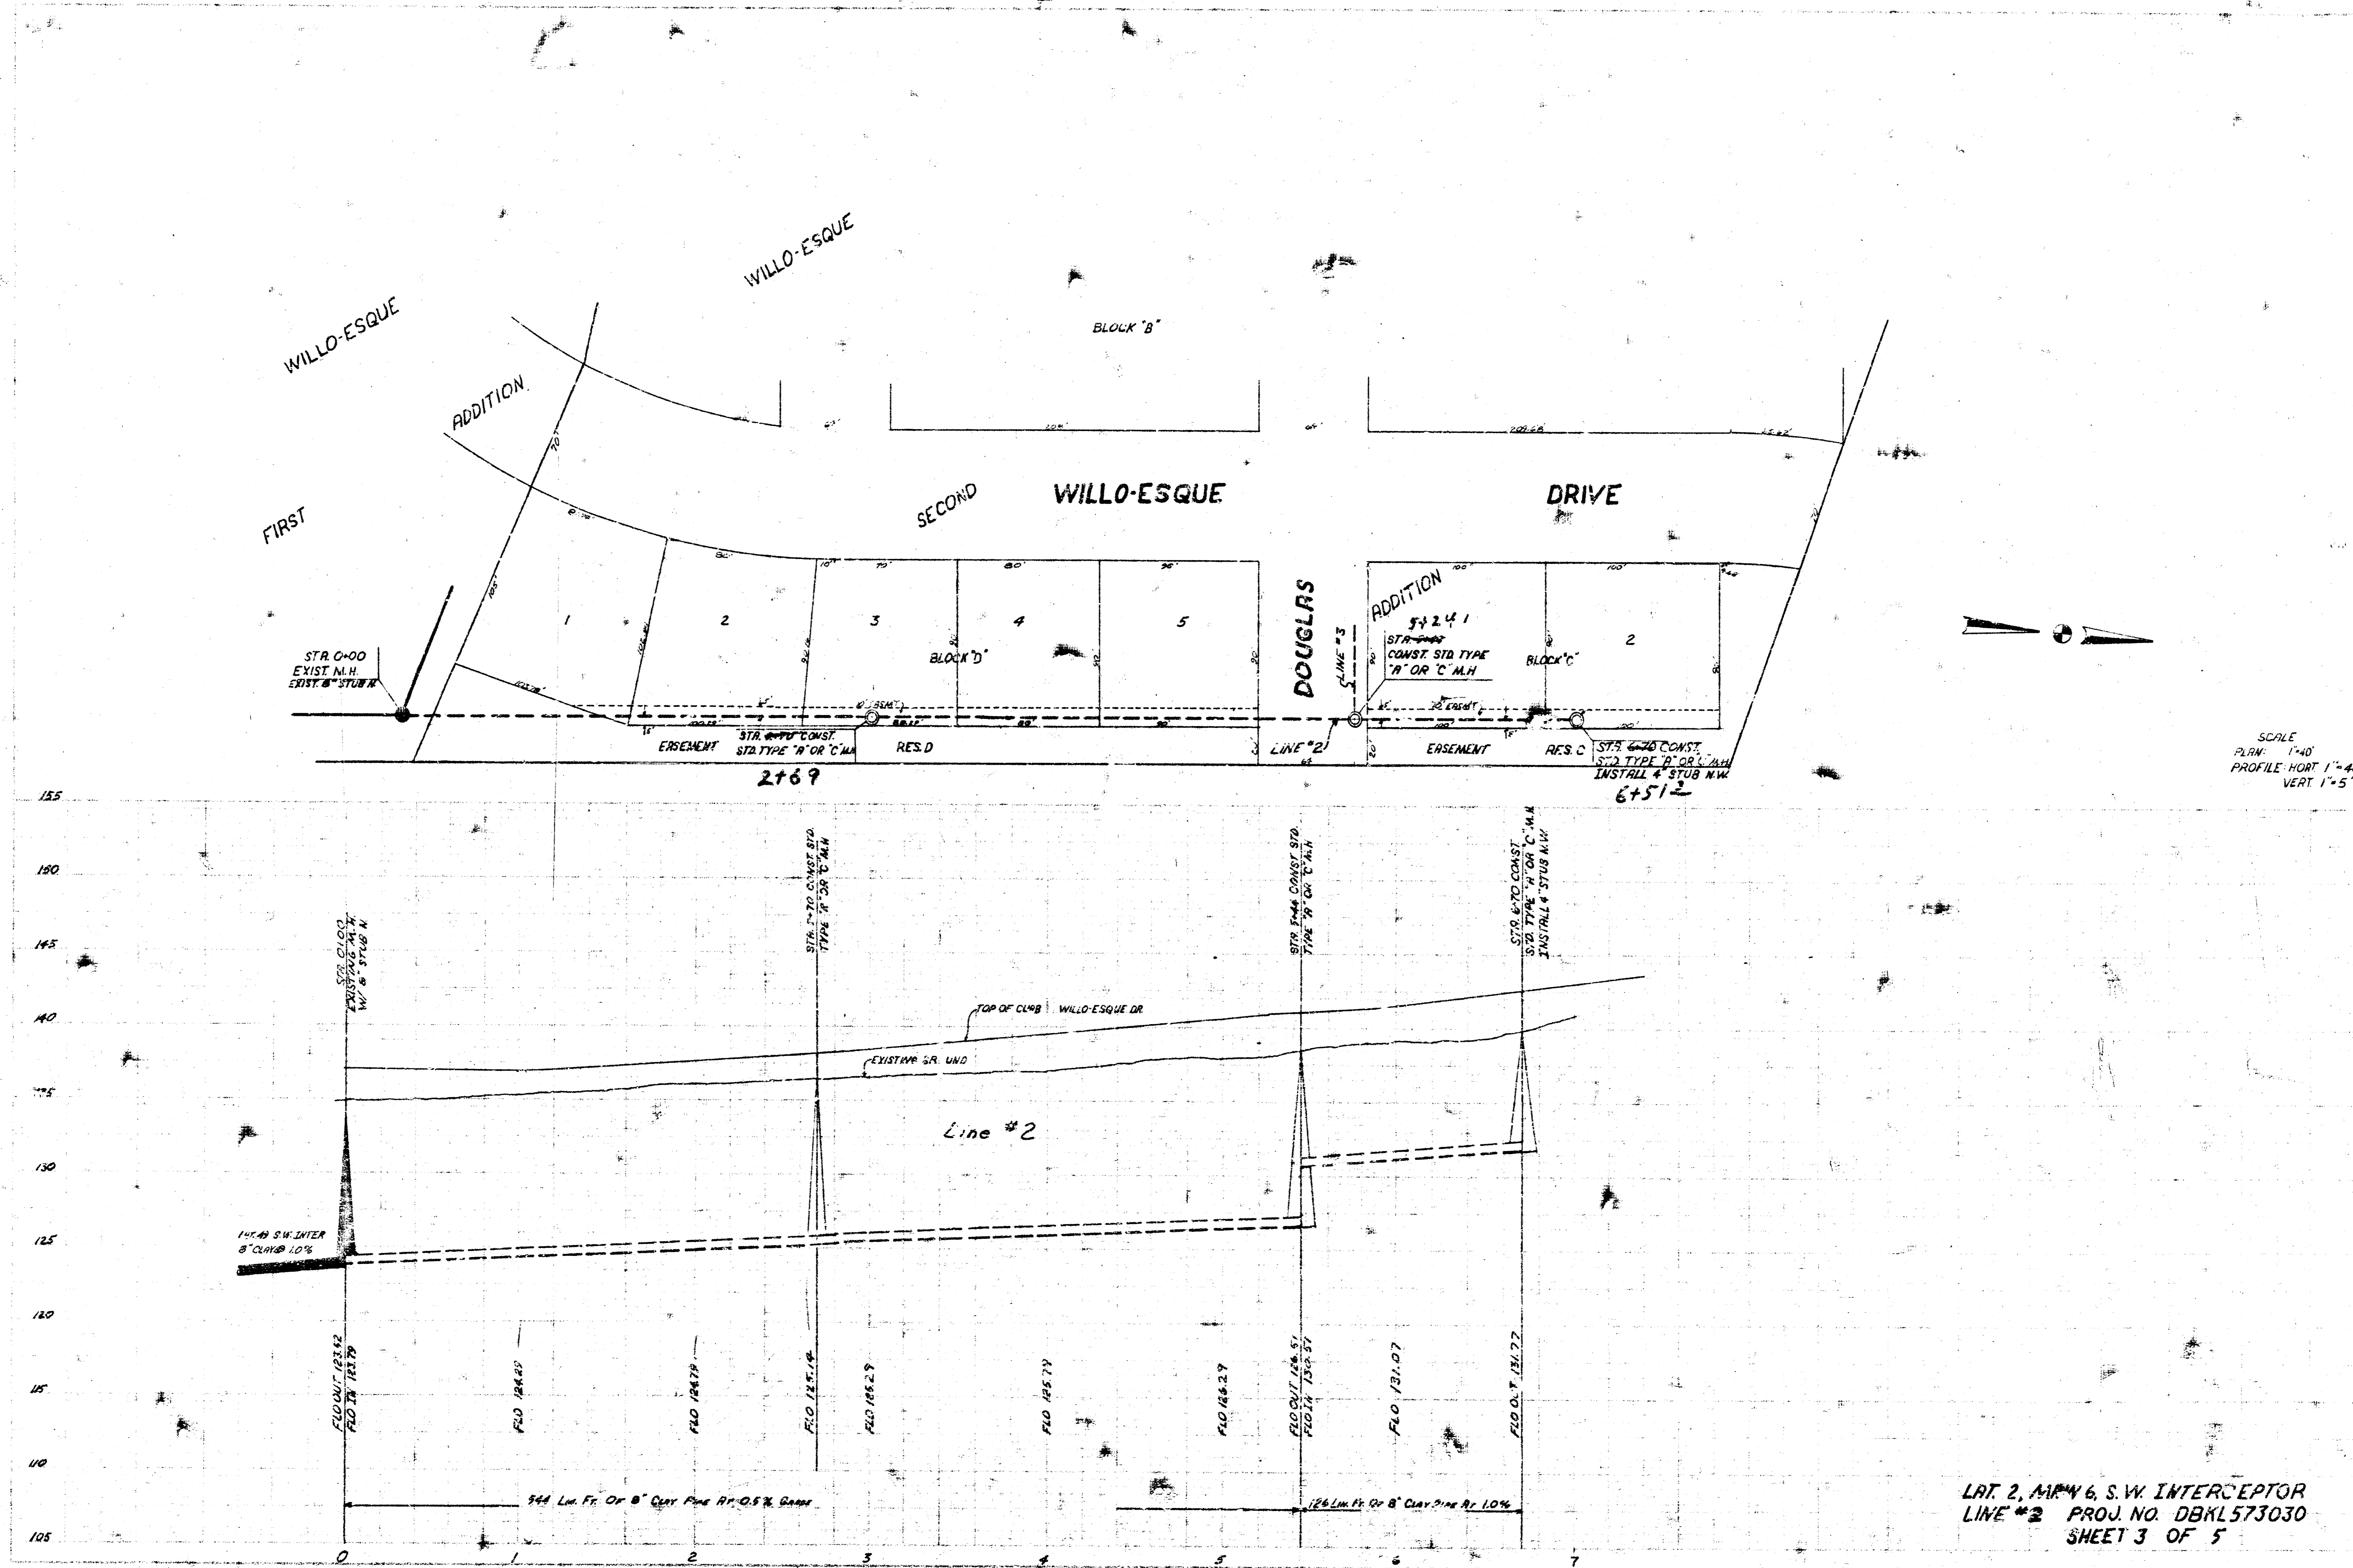



LAT 2, MAP 4, S.W. INTERCEPTOR
LINE #2
PROJ. NO. DBKL573030
SHEET 3 OF 5

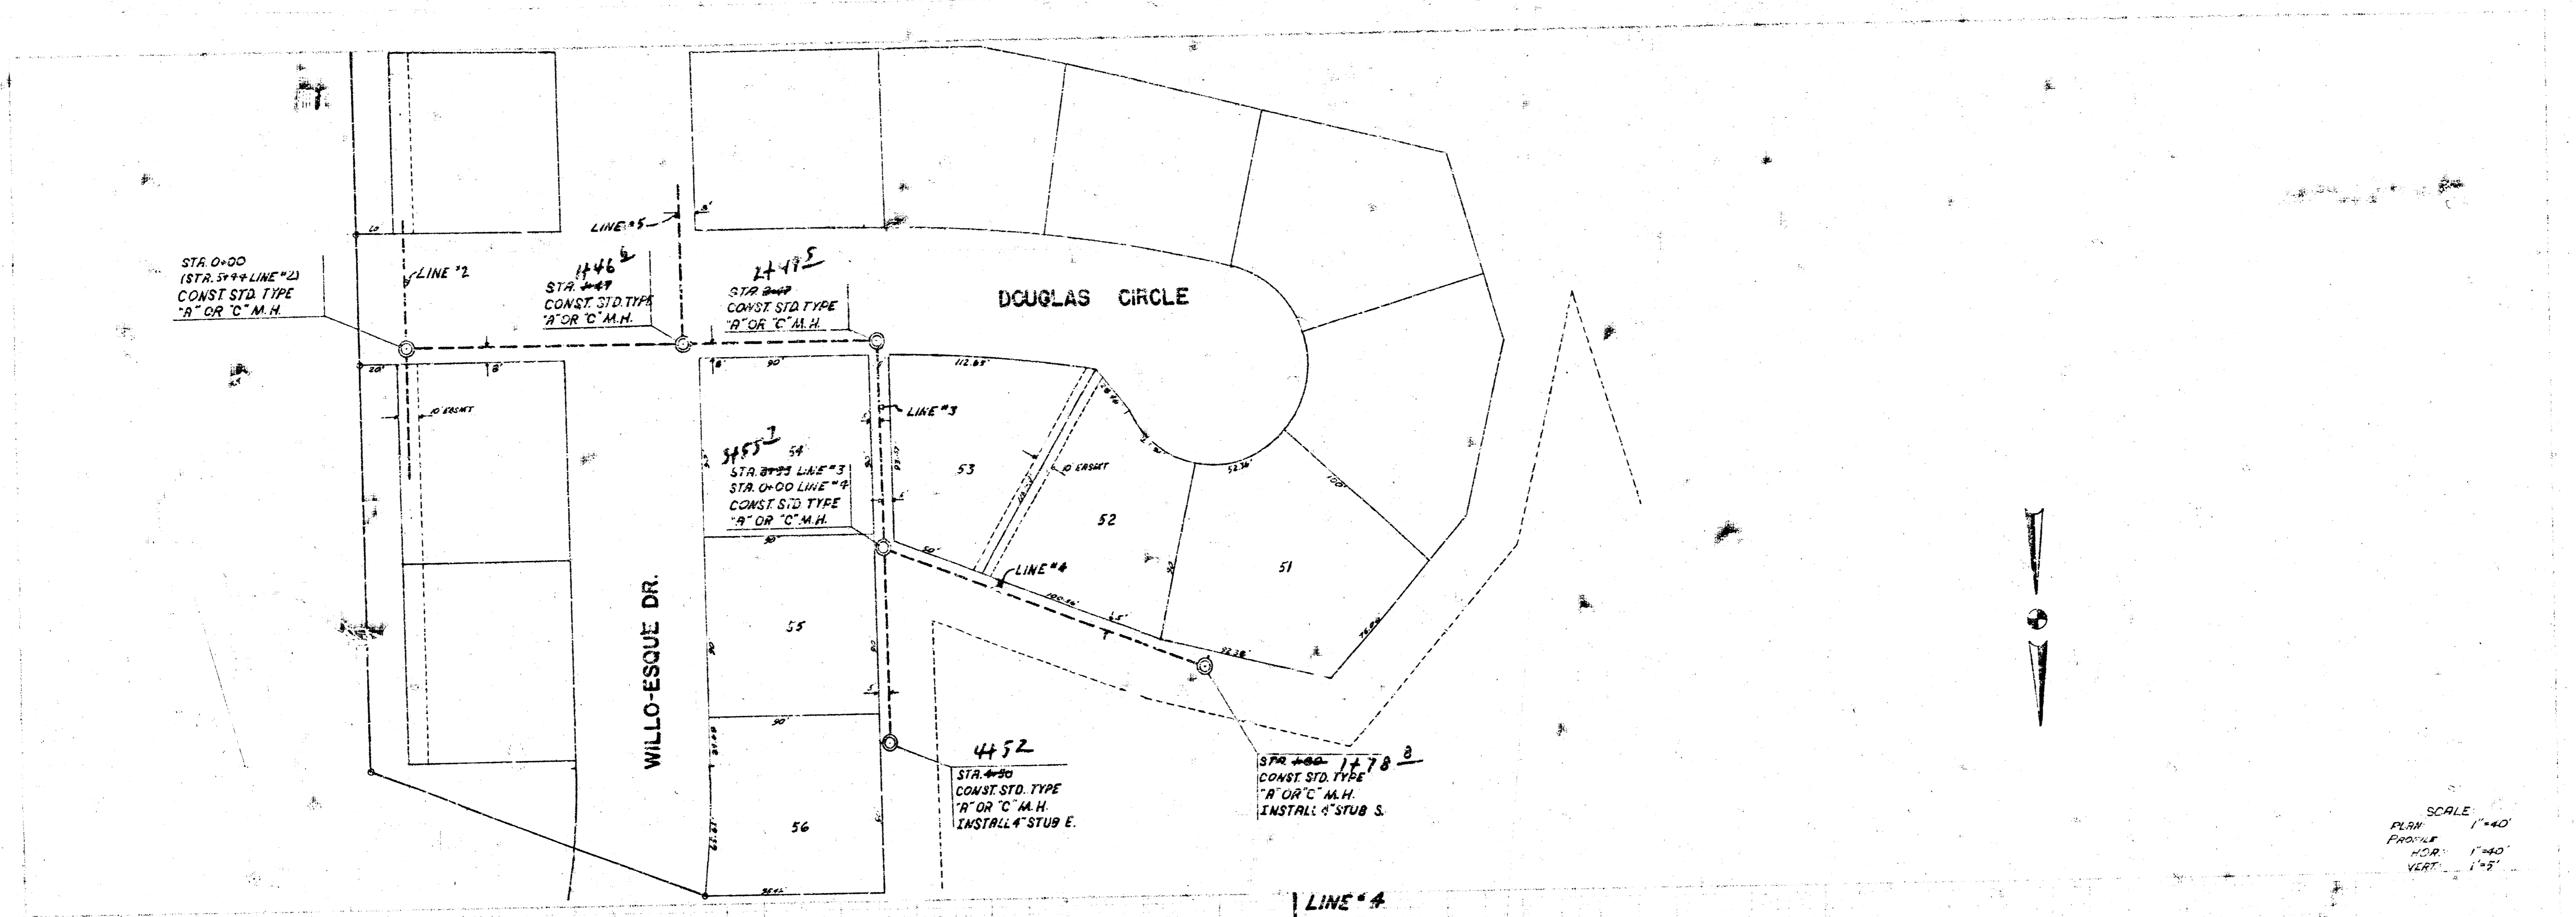


SCALE
 PLAN 1"=40'
 PROFILE 1"=40'
 VERT. 1"=5'

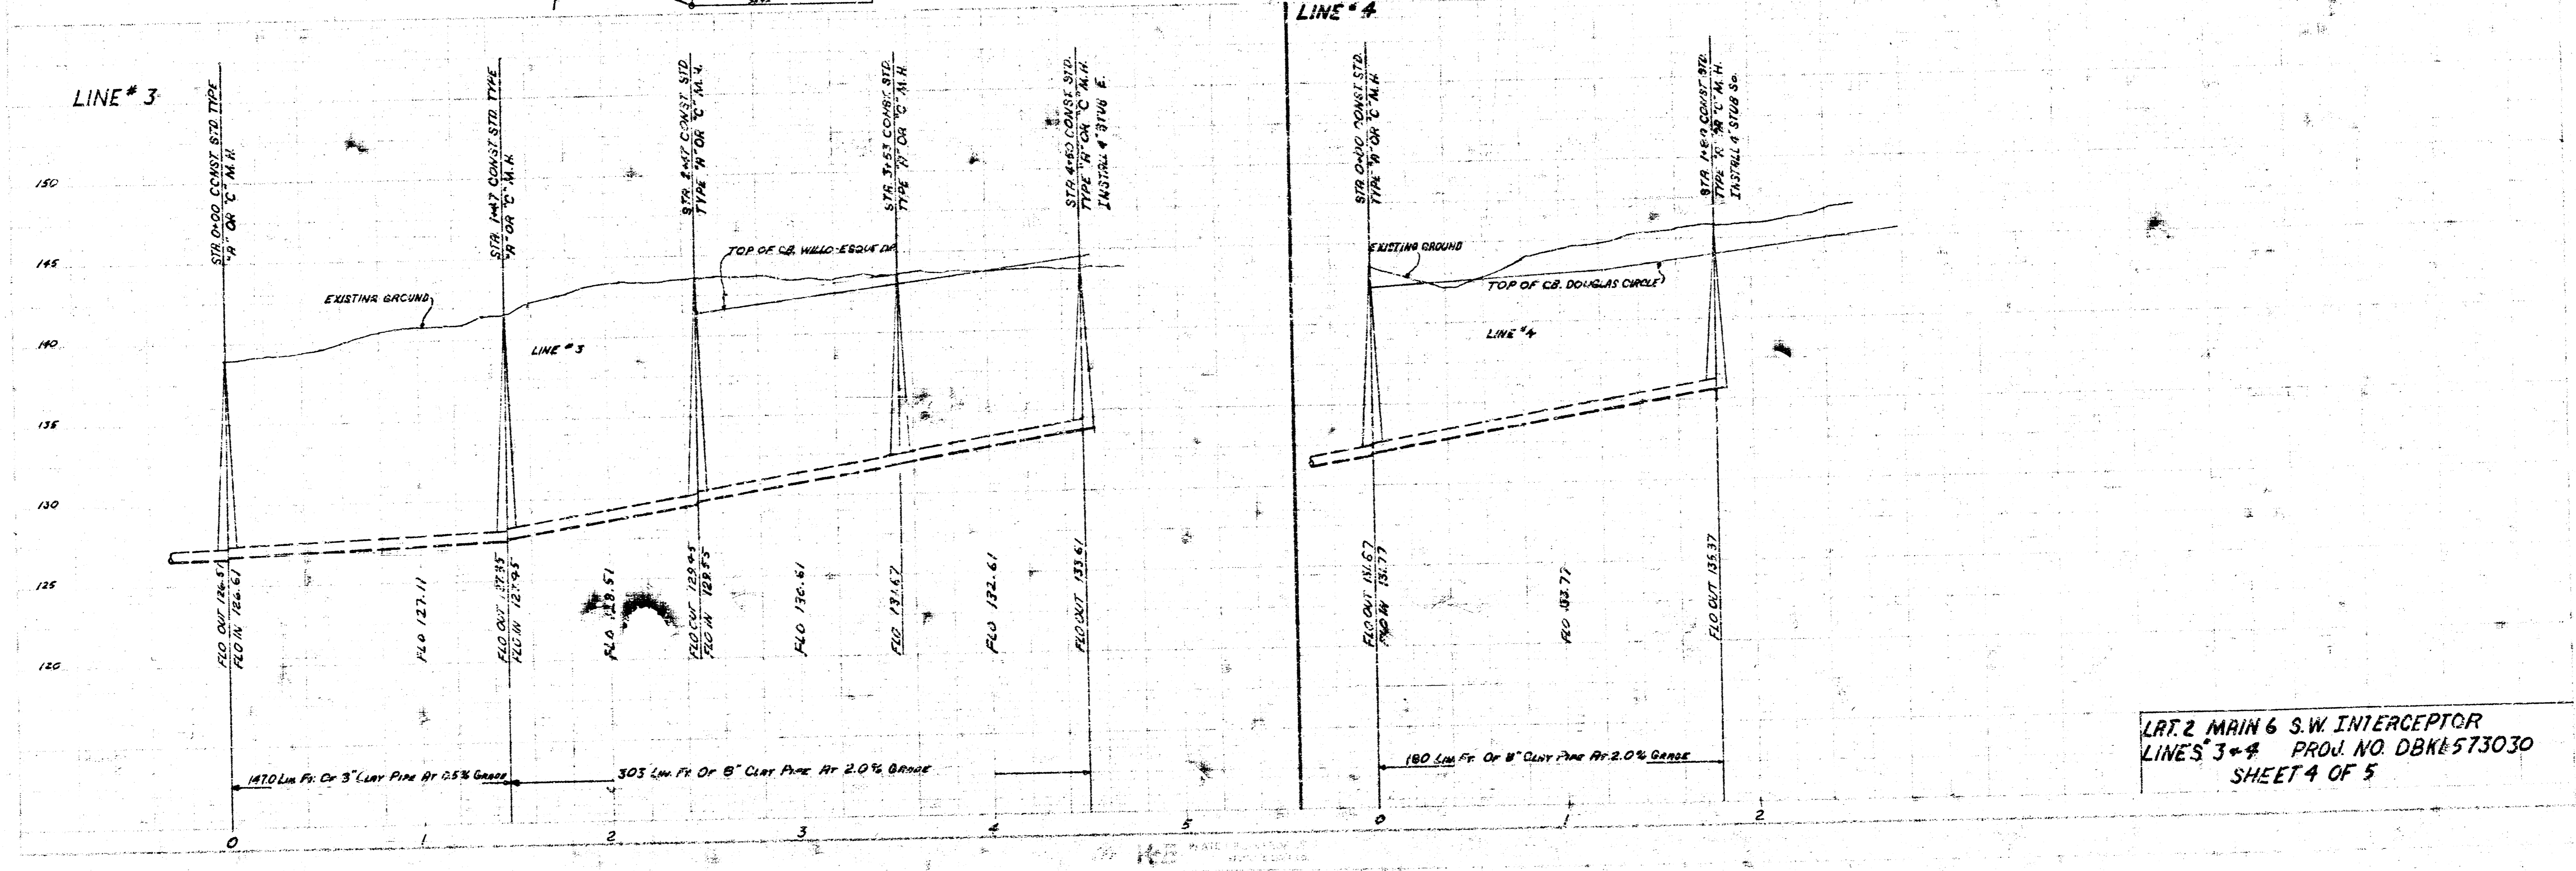

LRT 2 MAIN 6 S.W. INTERCEPTOR
 LINES 3-4 PROJ. NO. DBK 573030
 SHEET 4 OF 5

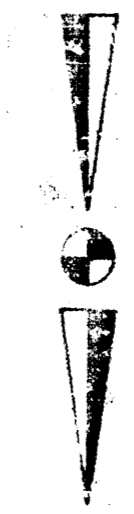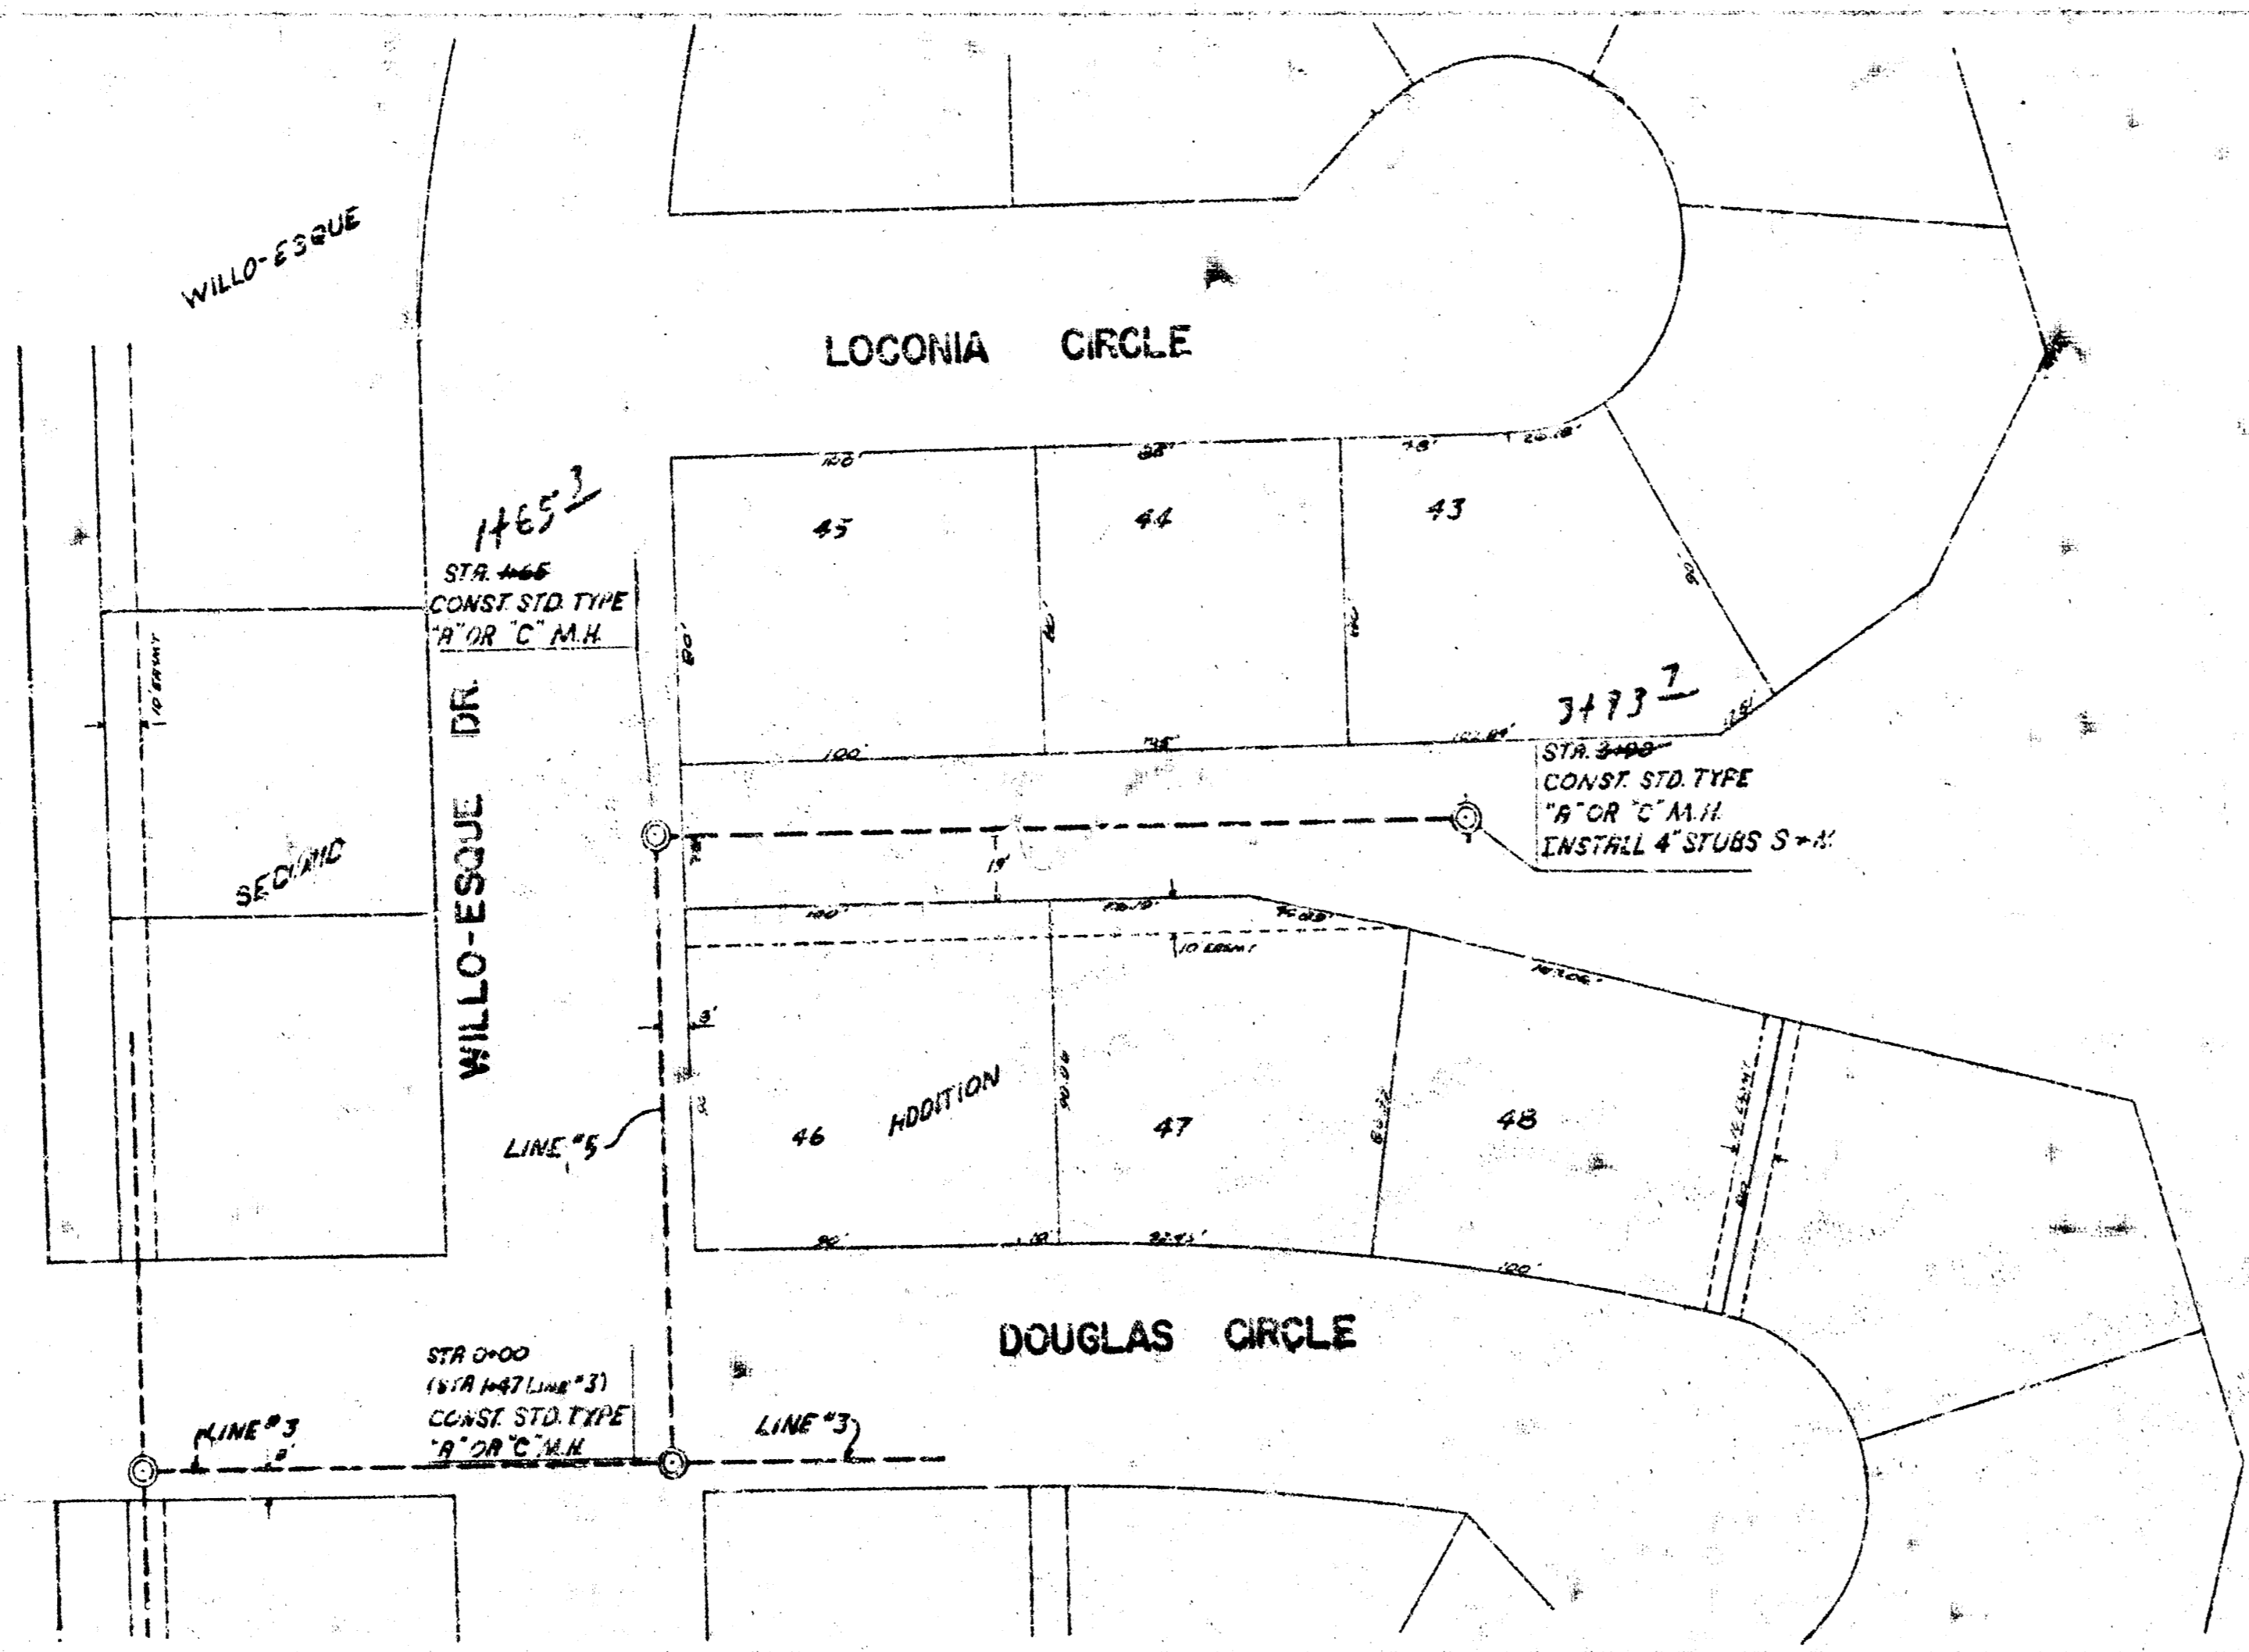

SCALE
 PLAN 1"=40'
 PROFILE 1"=40'
 VERT 1"=5'

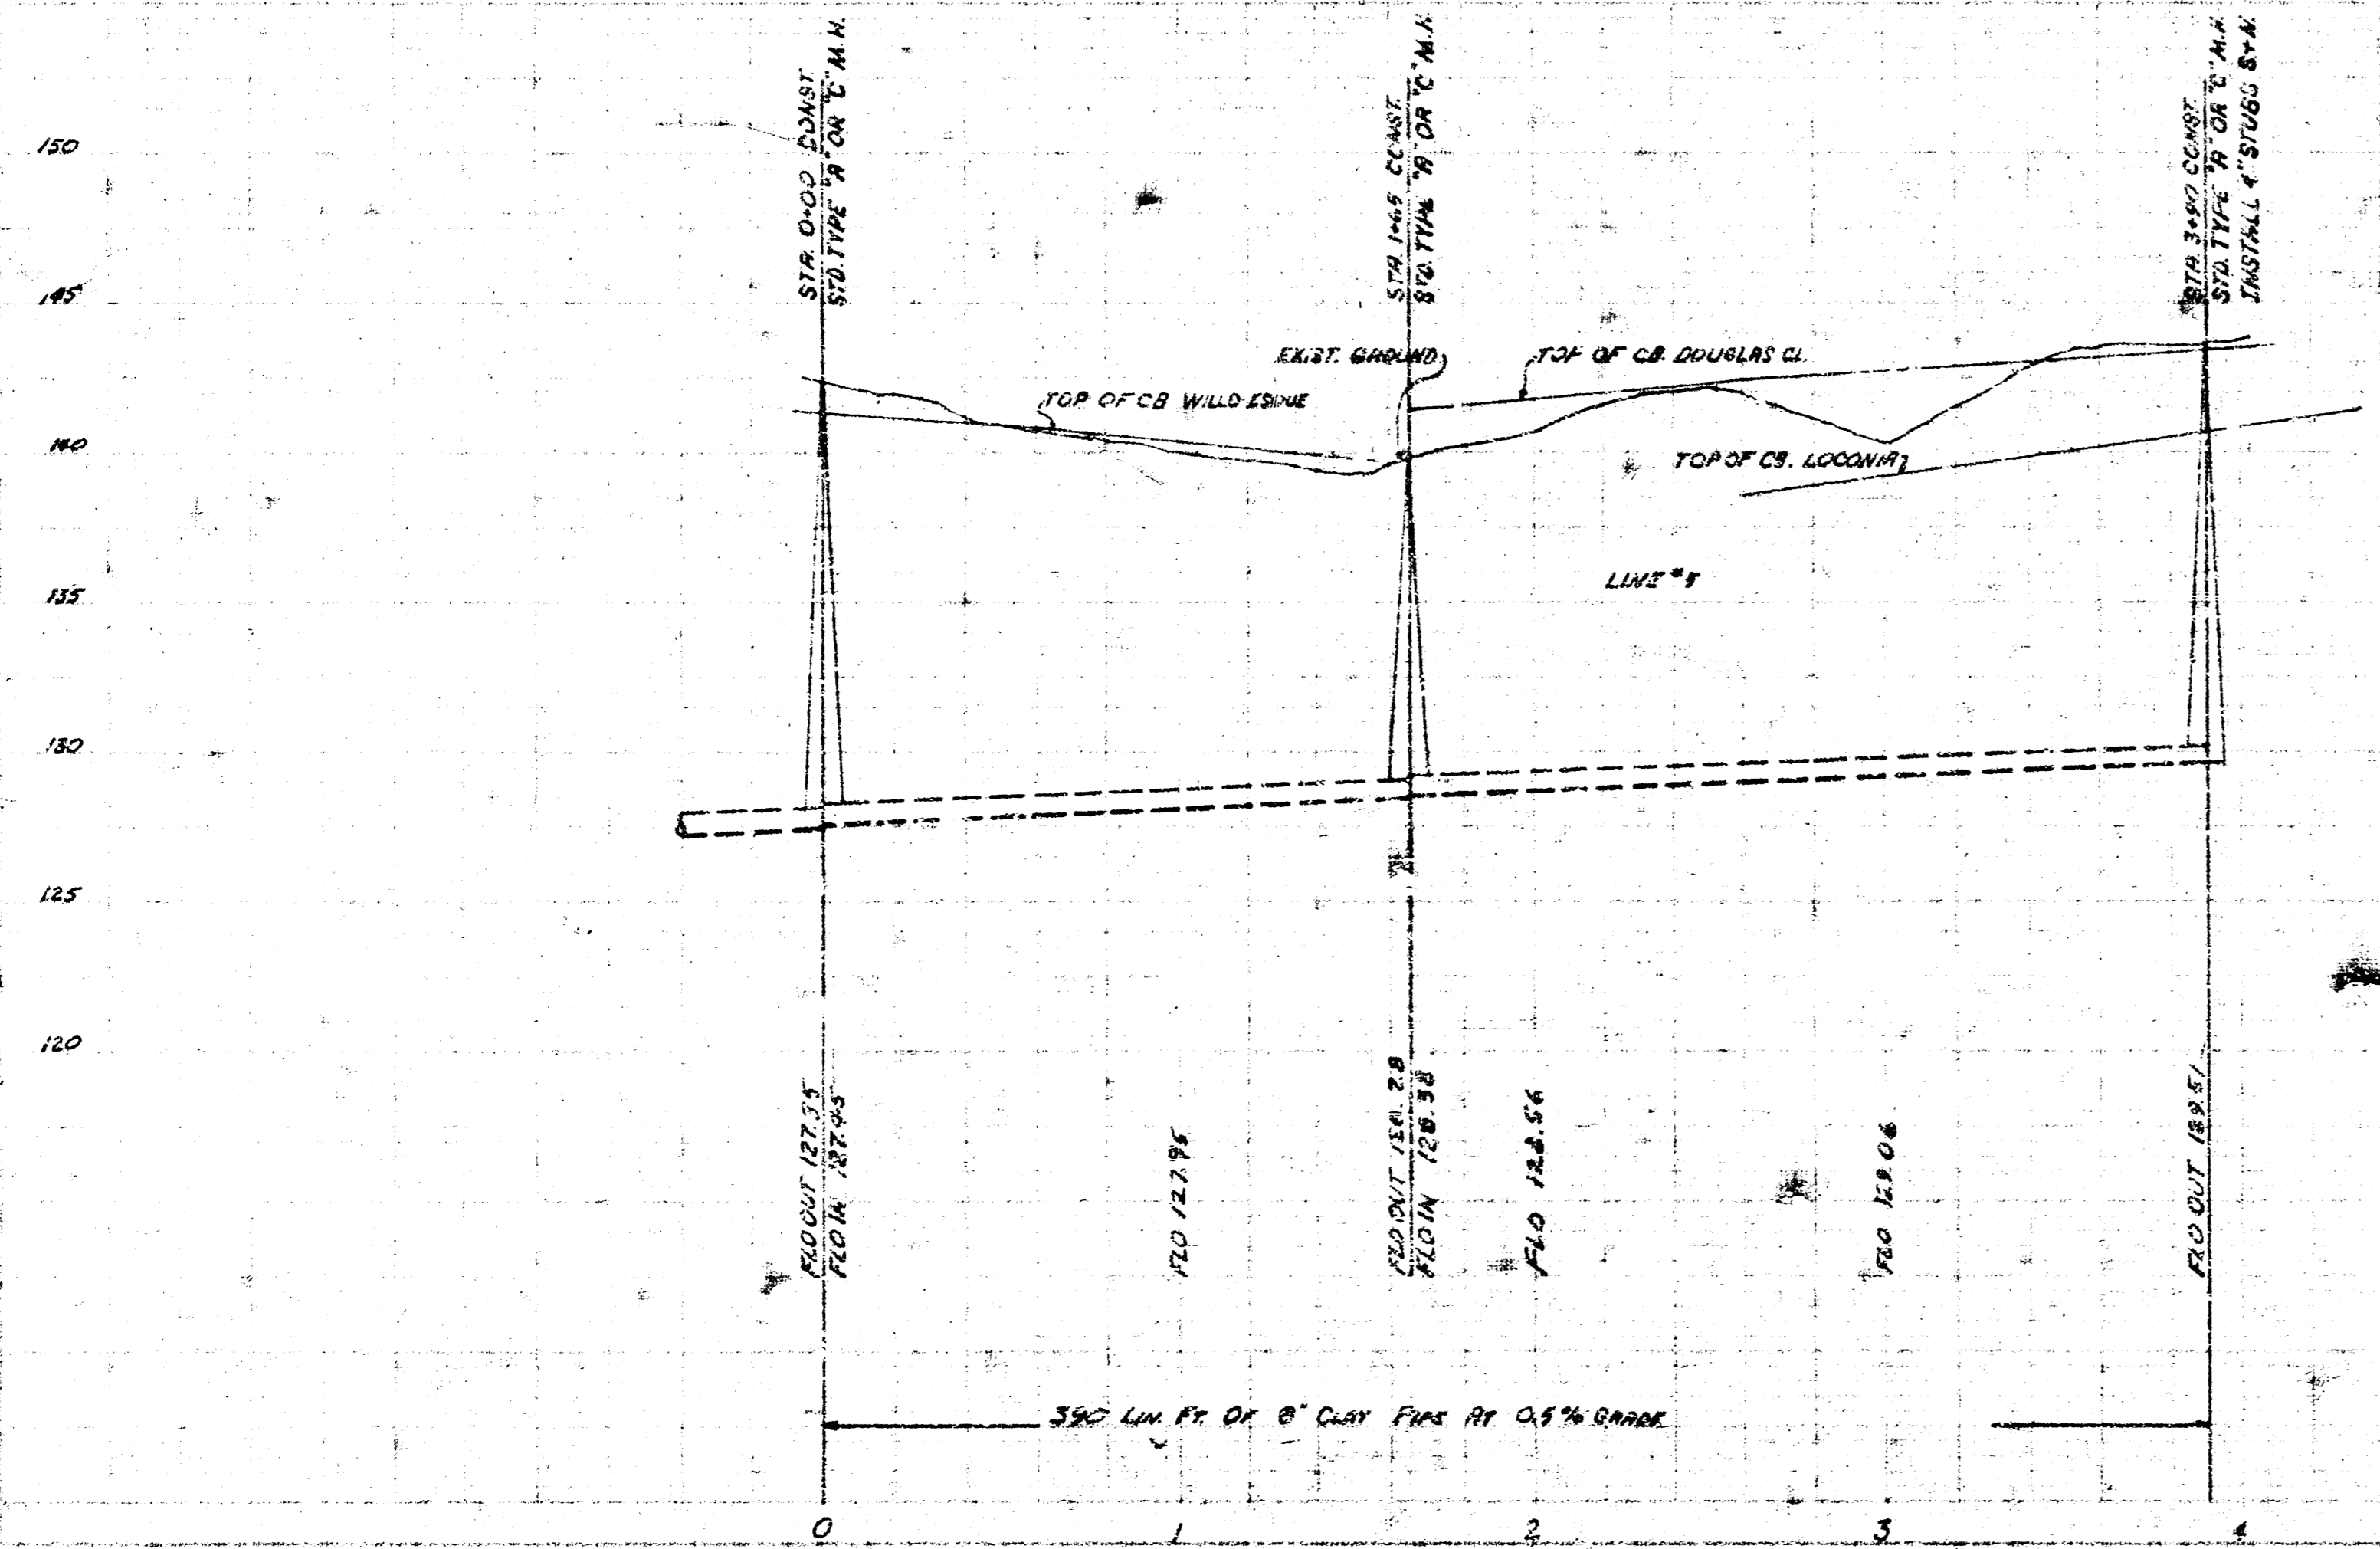

LAT. 2 MAIN & S.W. INTERCEPTOR
 LINE "5"
 PROJ. NO. DBKL573030
 SHEET 5 OF 5