



LAT 3, MAIN 6, SOUTHWEST INTERCEPTOR

CITY OF WICHITA, KANSAS

R. W. LINN — CITY ENGINEER


PROJECT NO. DBKL575048

As Built 7-12-76

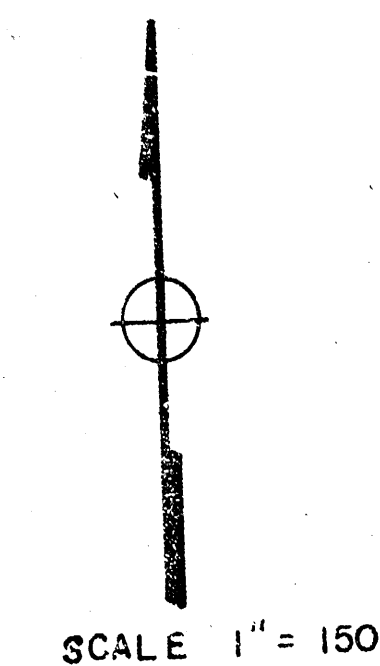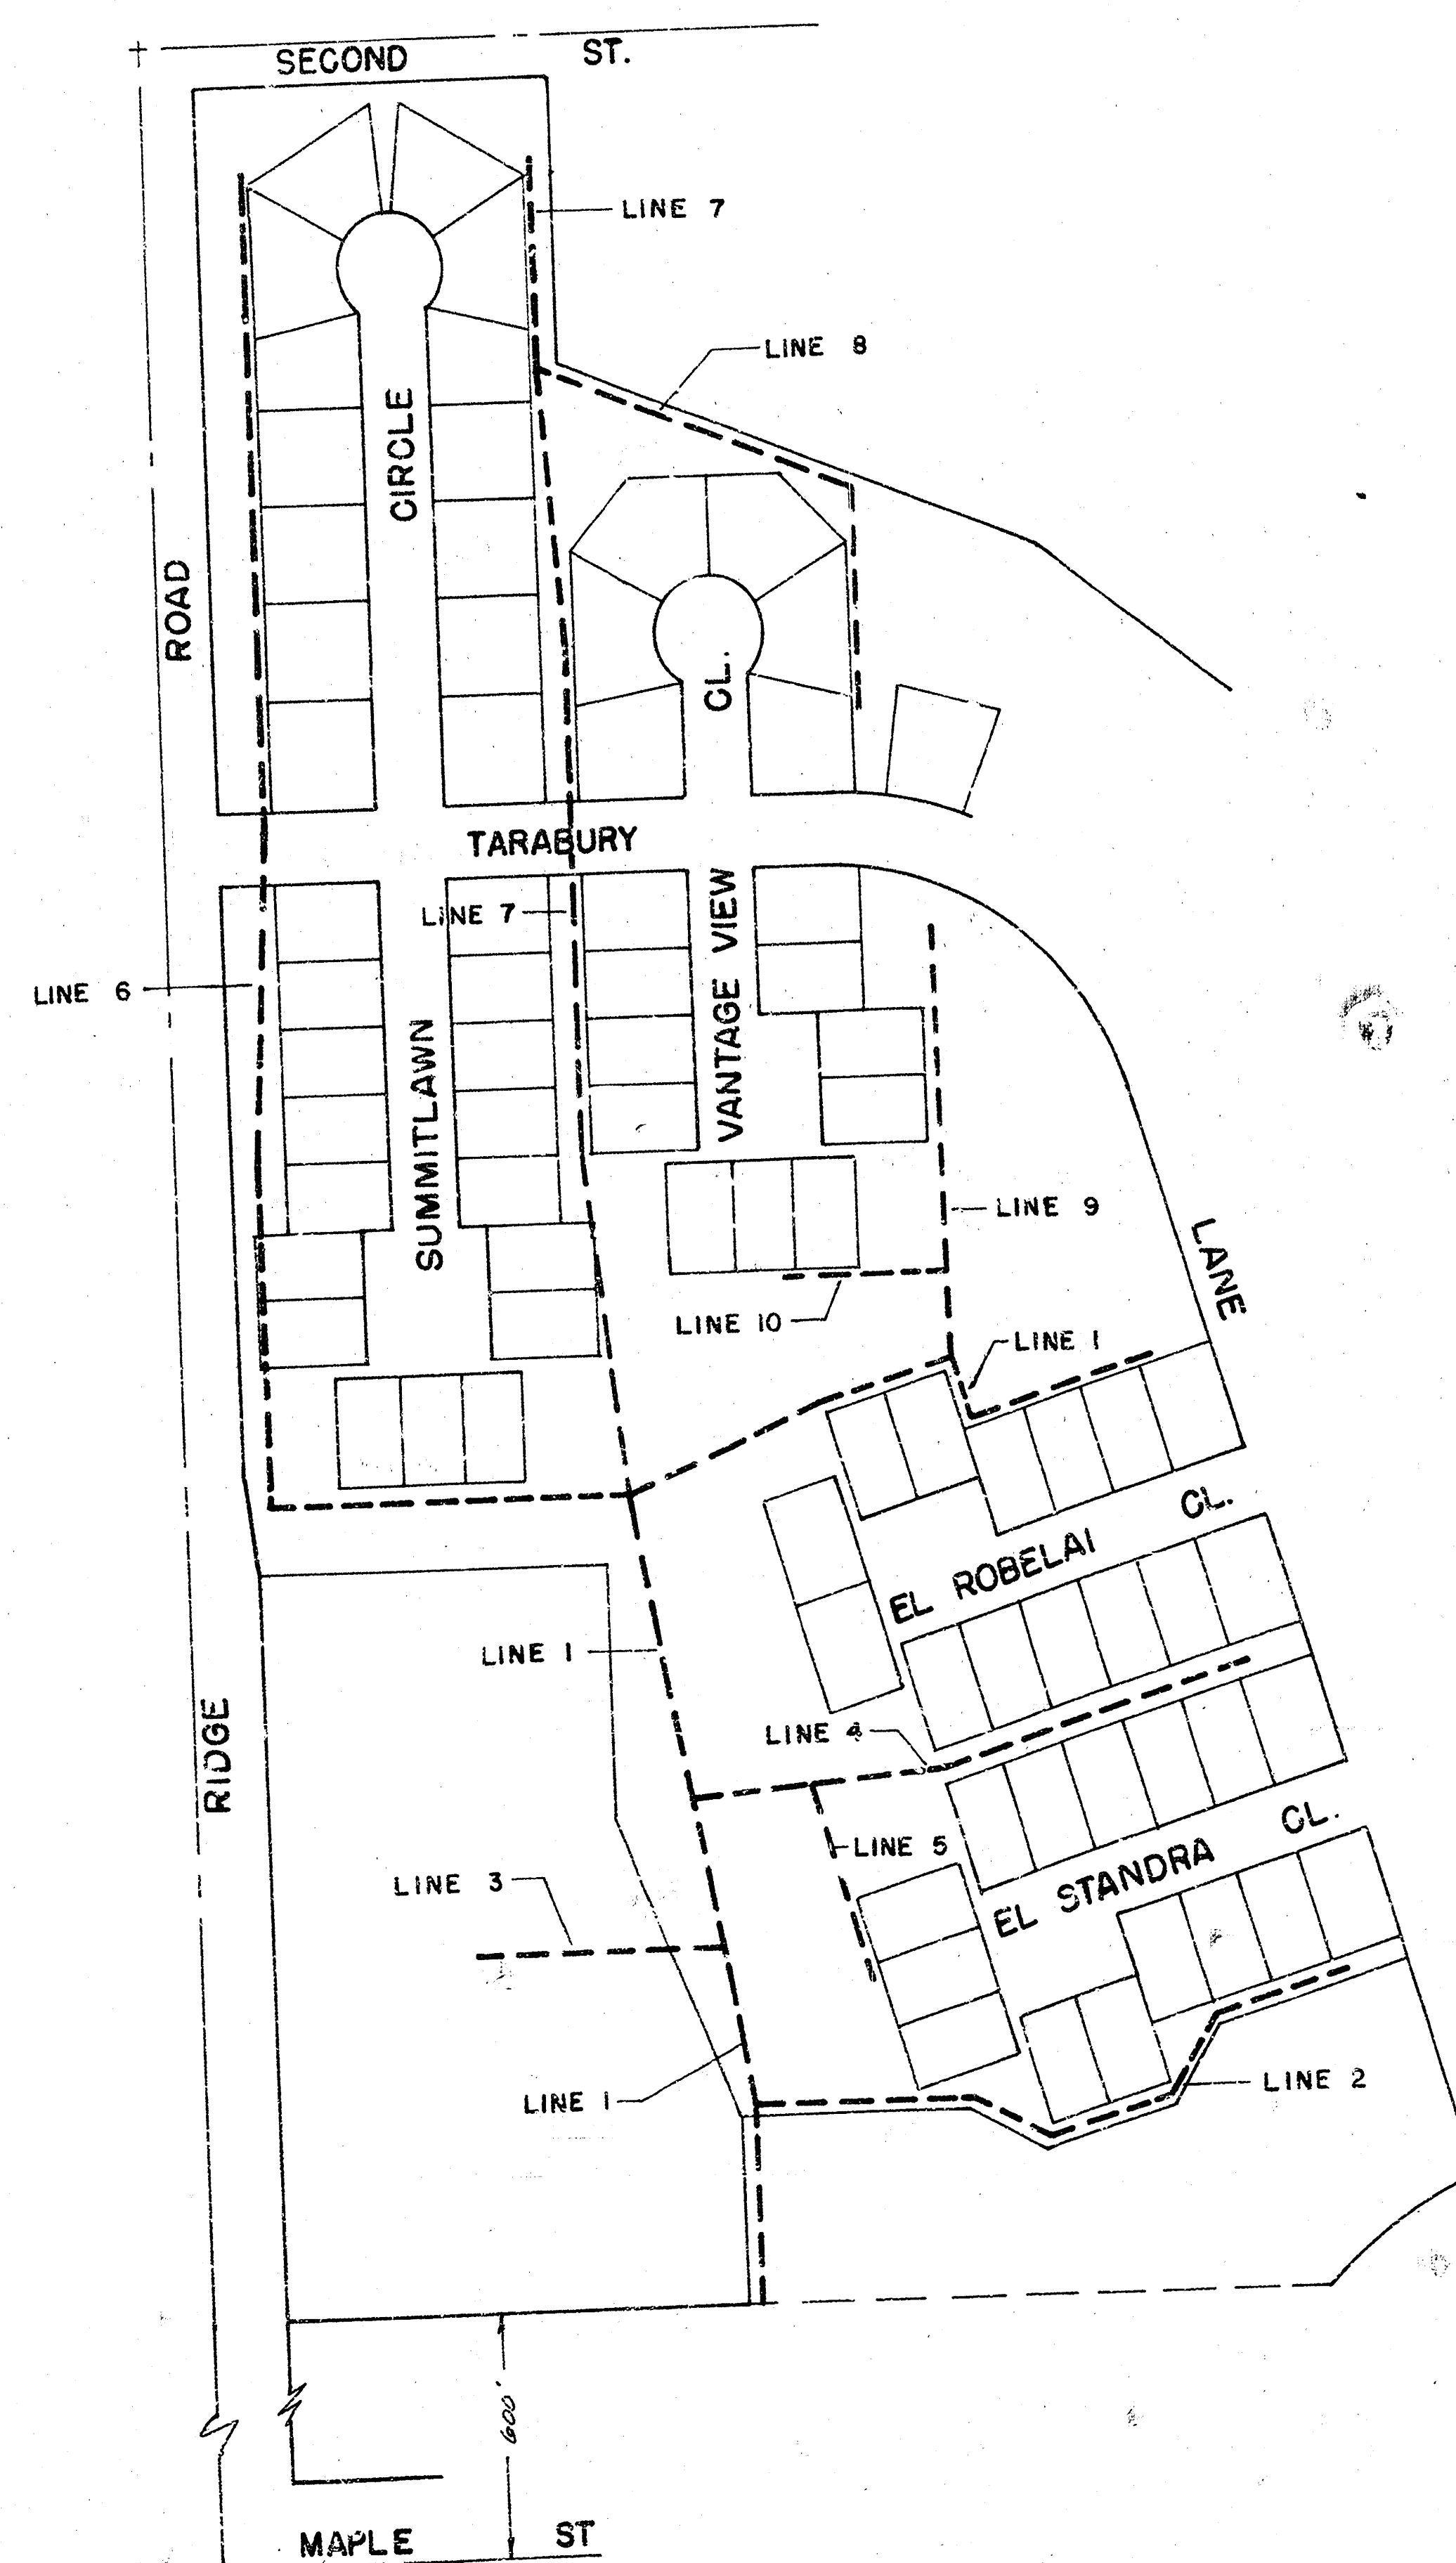






PL 259, 1/19/255
R. Linn

Scale Plan 1"=40'
Profile 1"=40' Horiz.
1"=5' Vert.

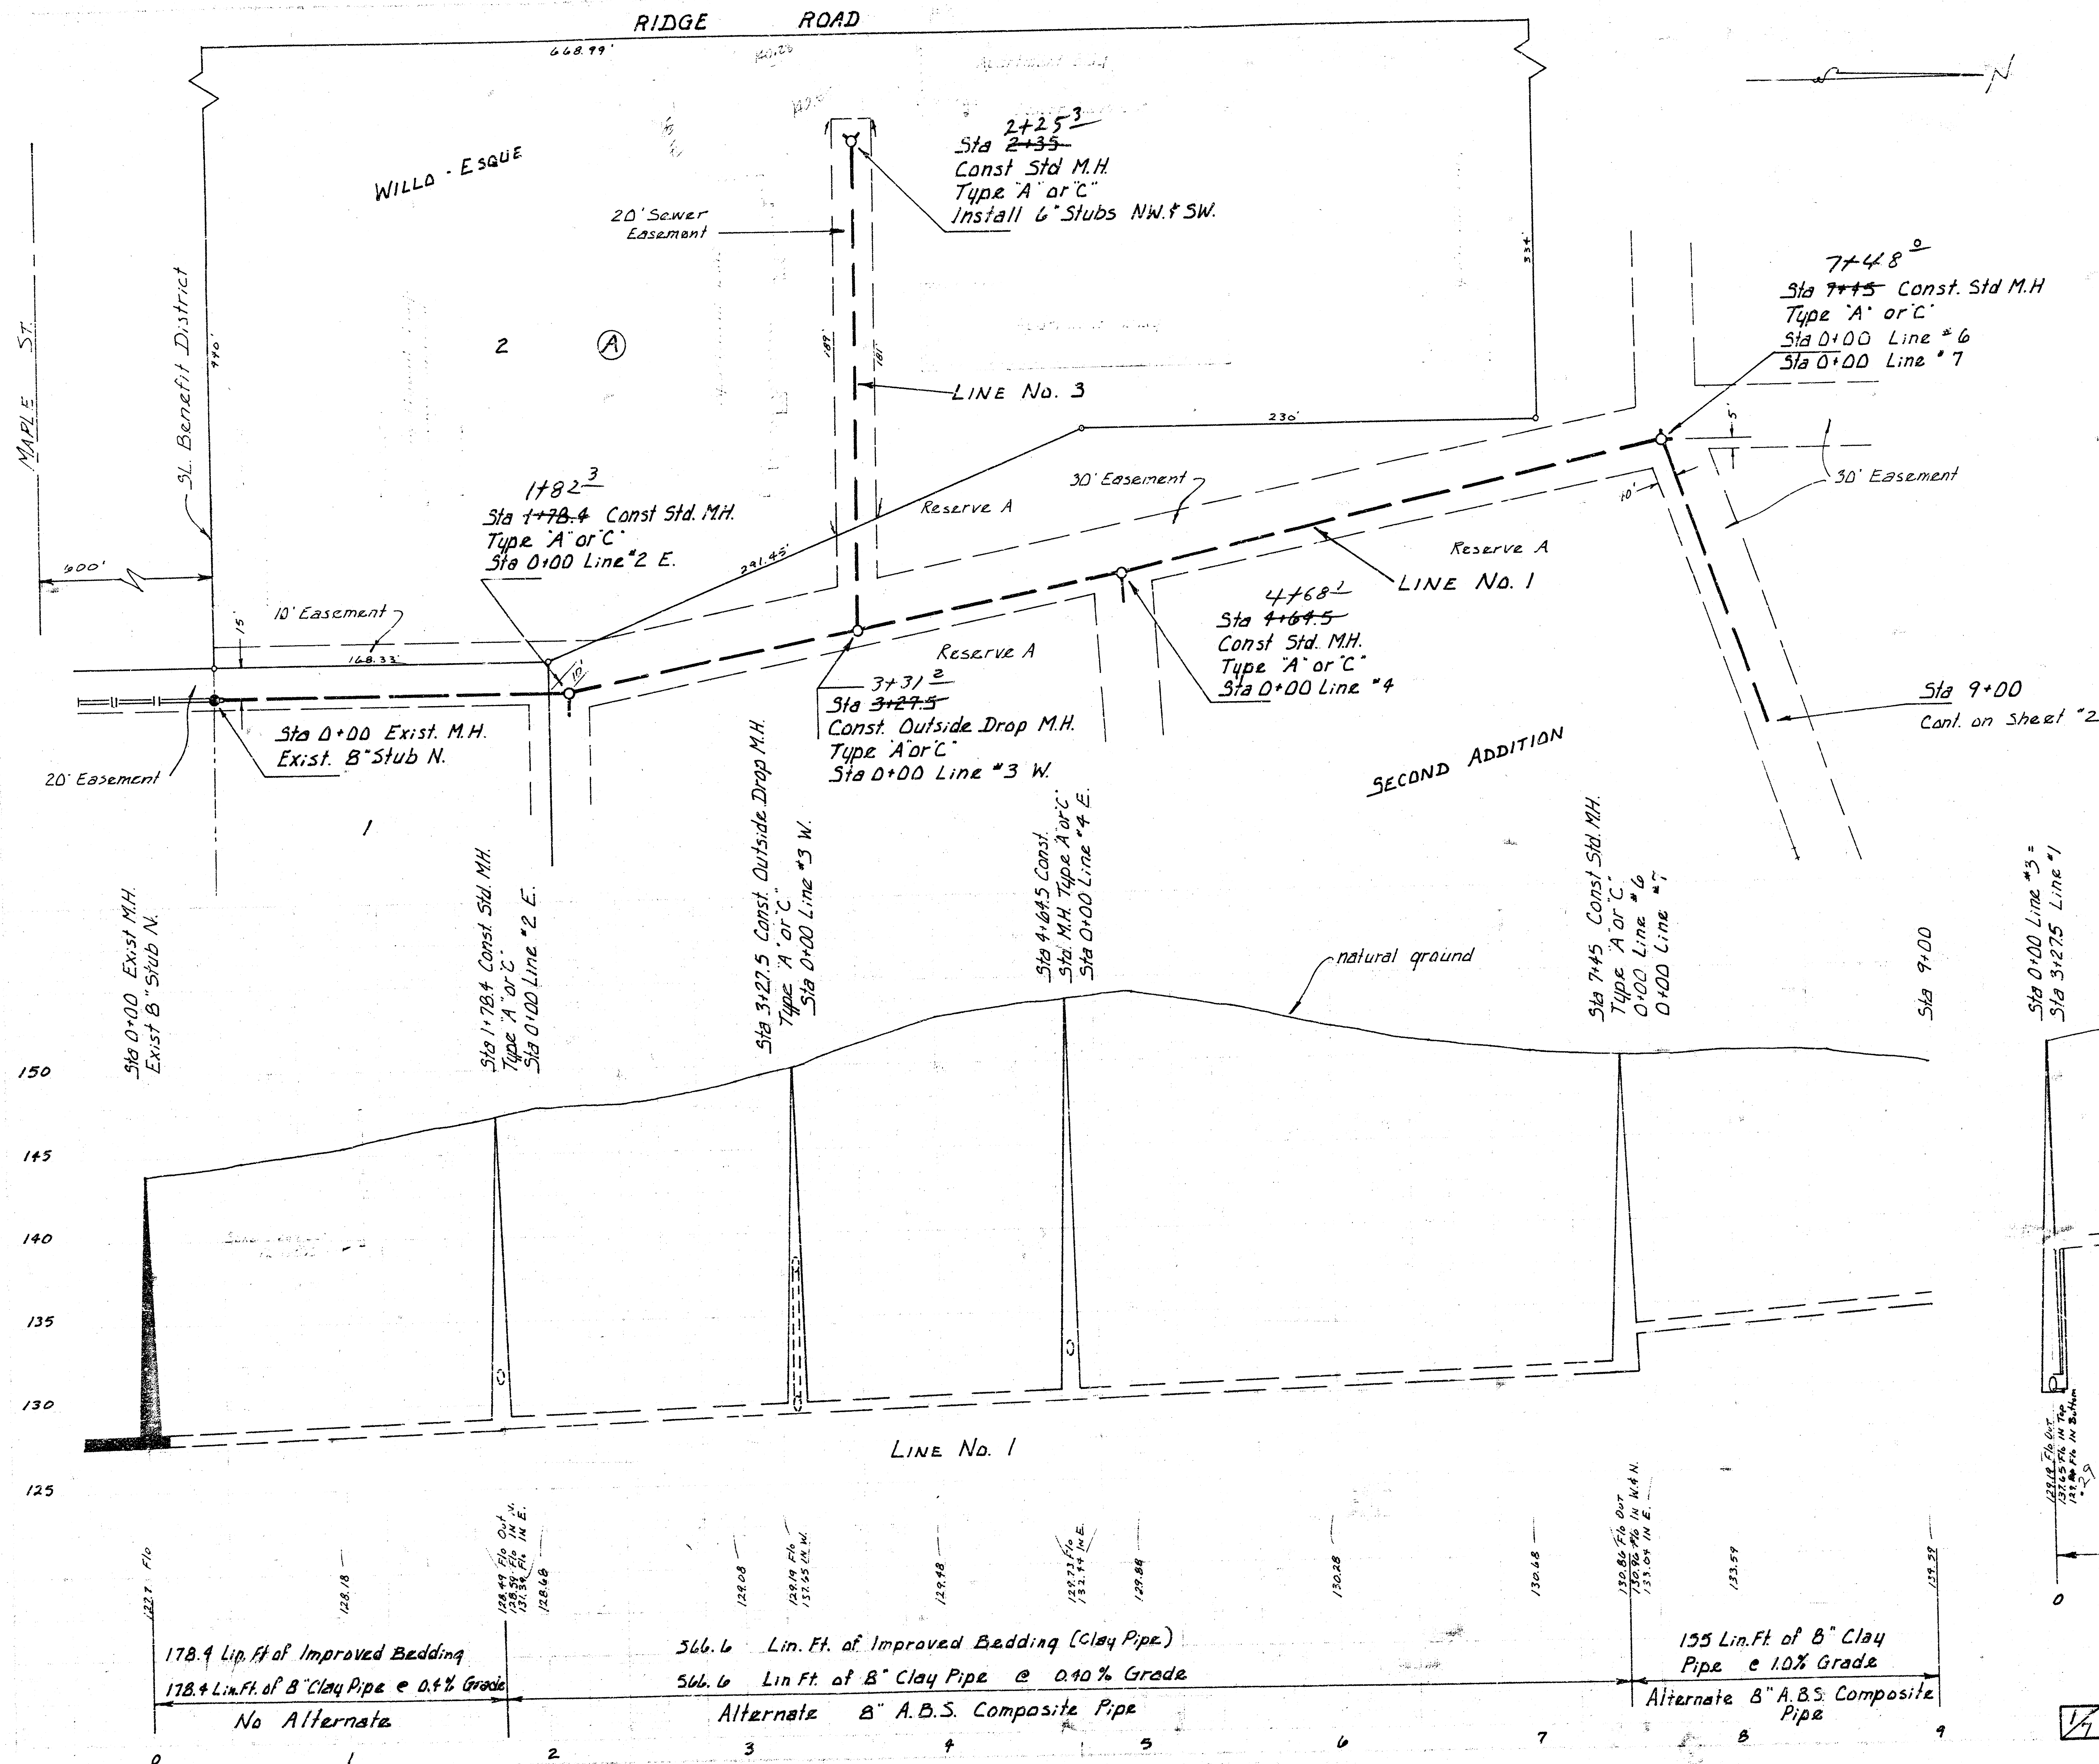

- B.M. 141.66 City Std. disc 34' E. and 42' S. of W. end of Ridge Road and Maple
- B.M. 147.62 "d" top of curb at the center of the W. end of the Island in the cul-de-sac on El Strada Cl.
- B.M. 149.99 "d" top of curb at the center of the W. end of the Island in the cul-de-sac on El Robelar Cl.




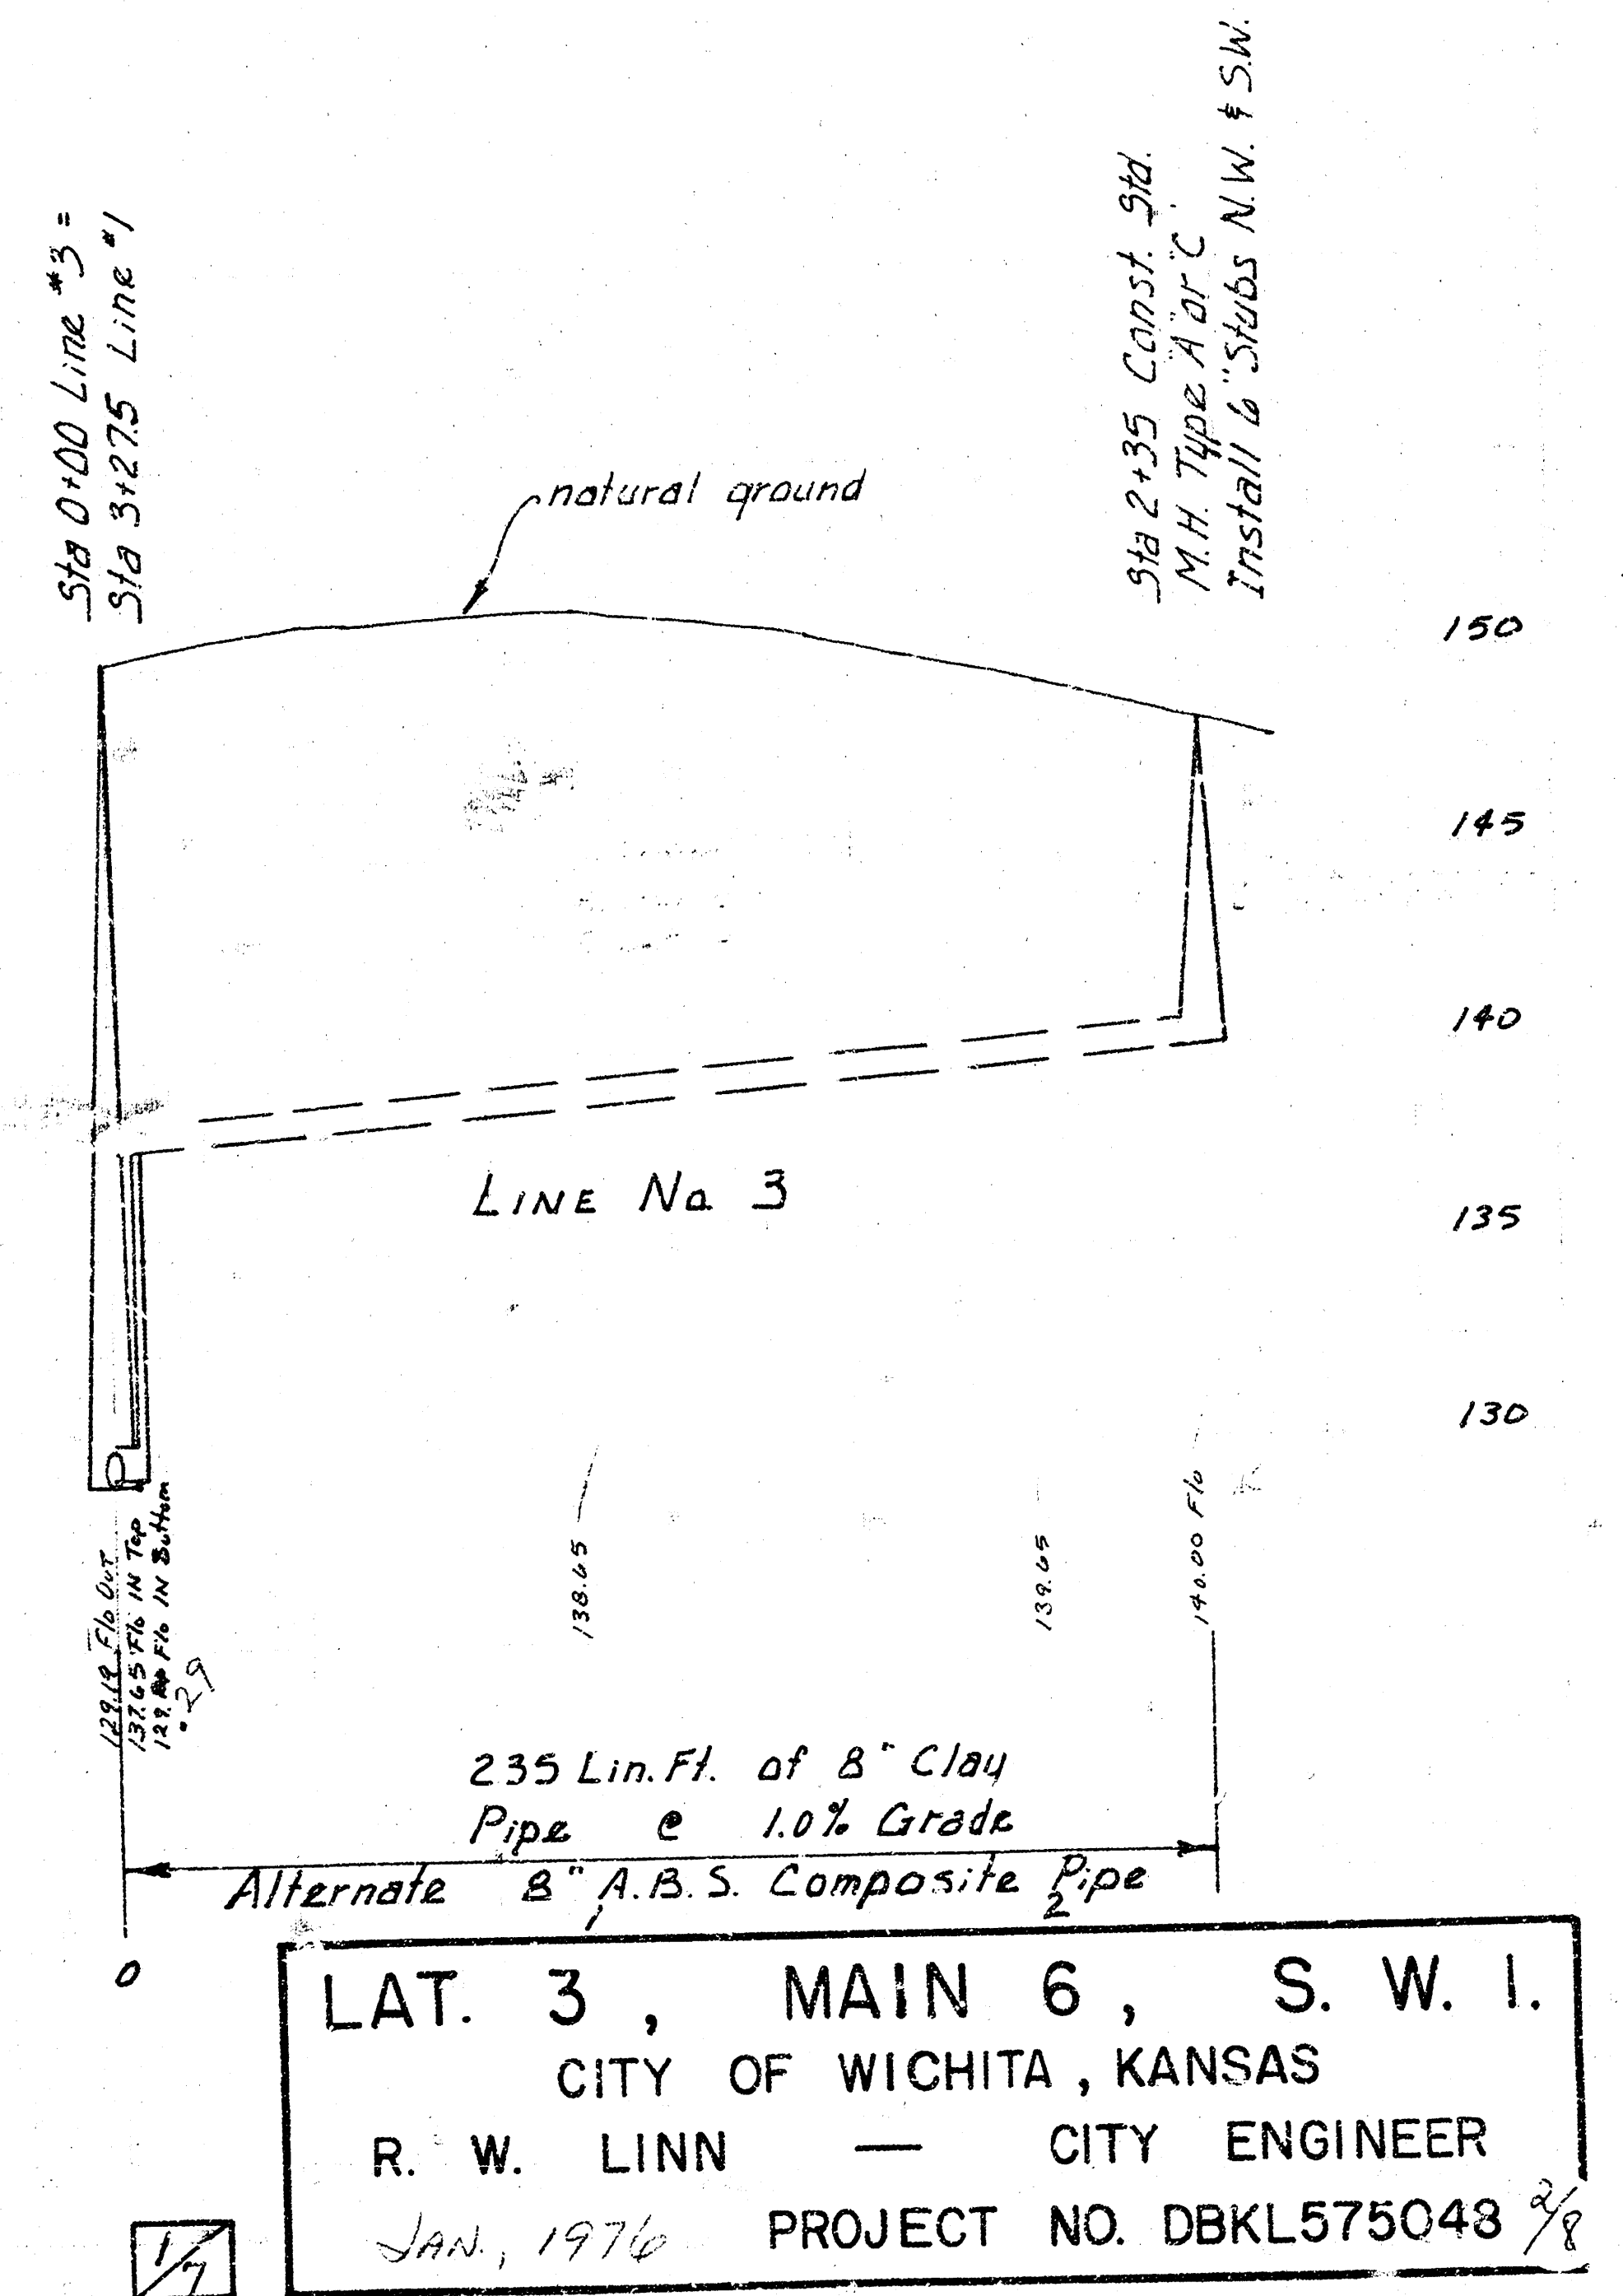


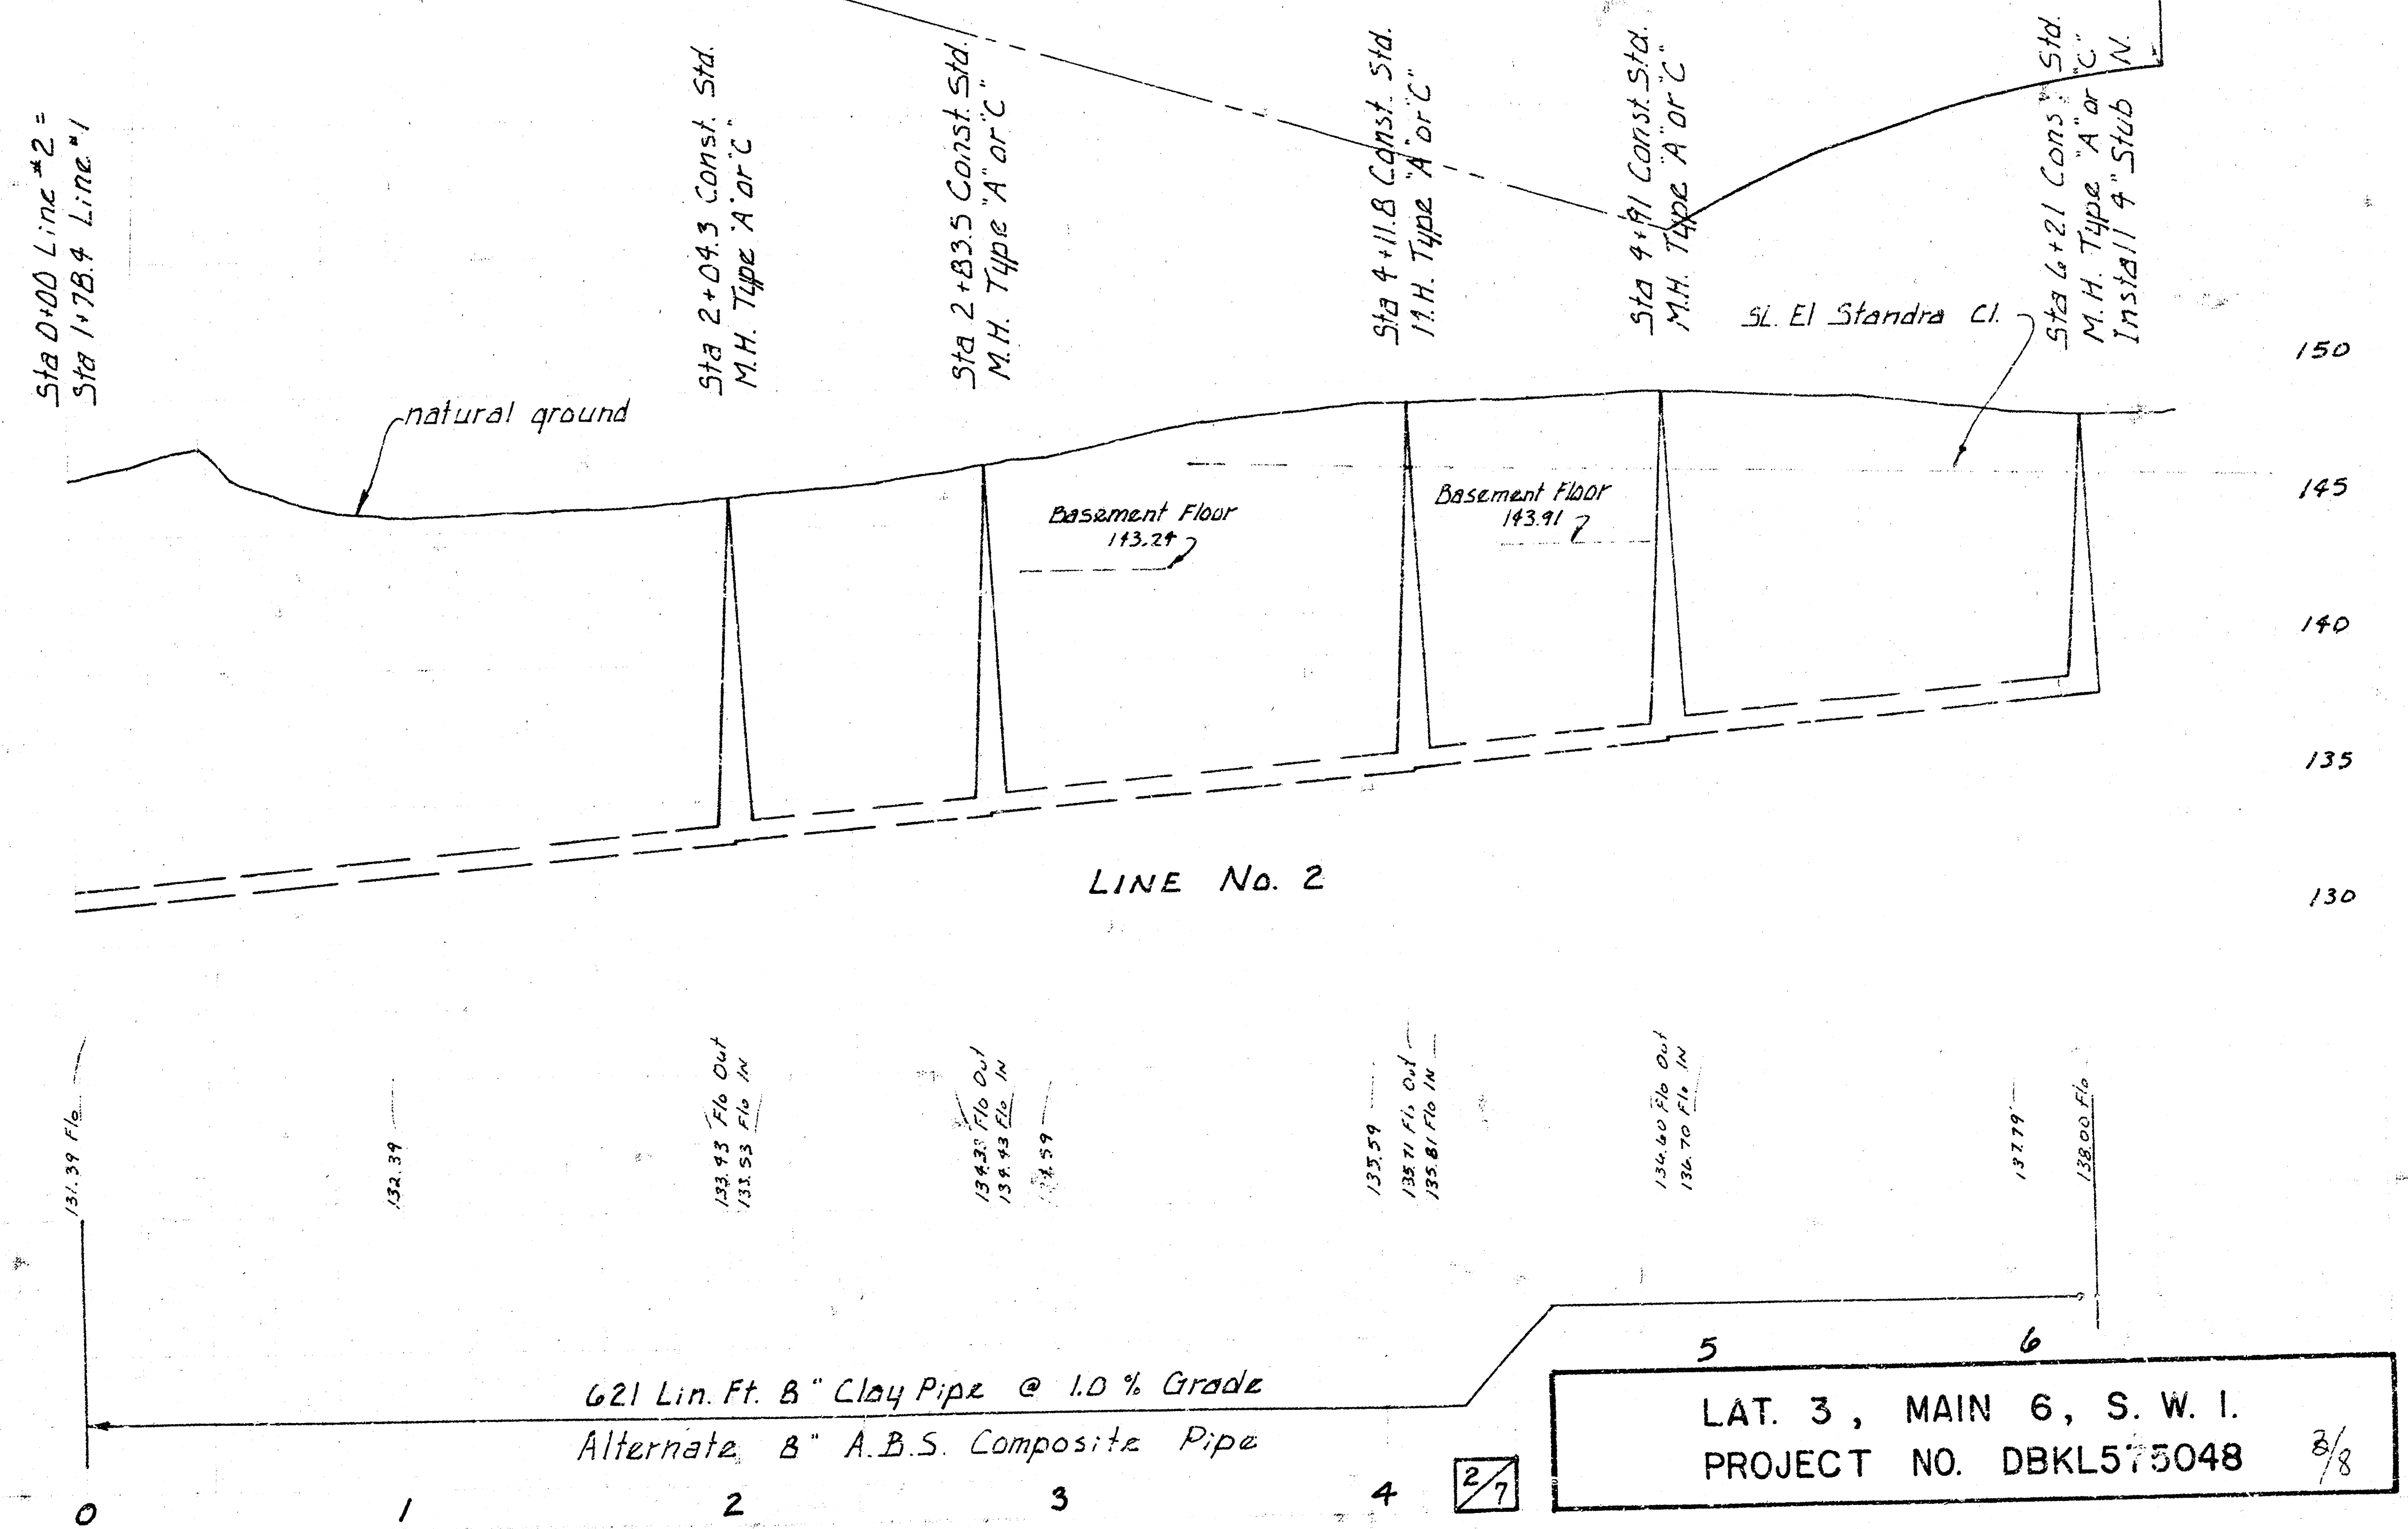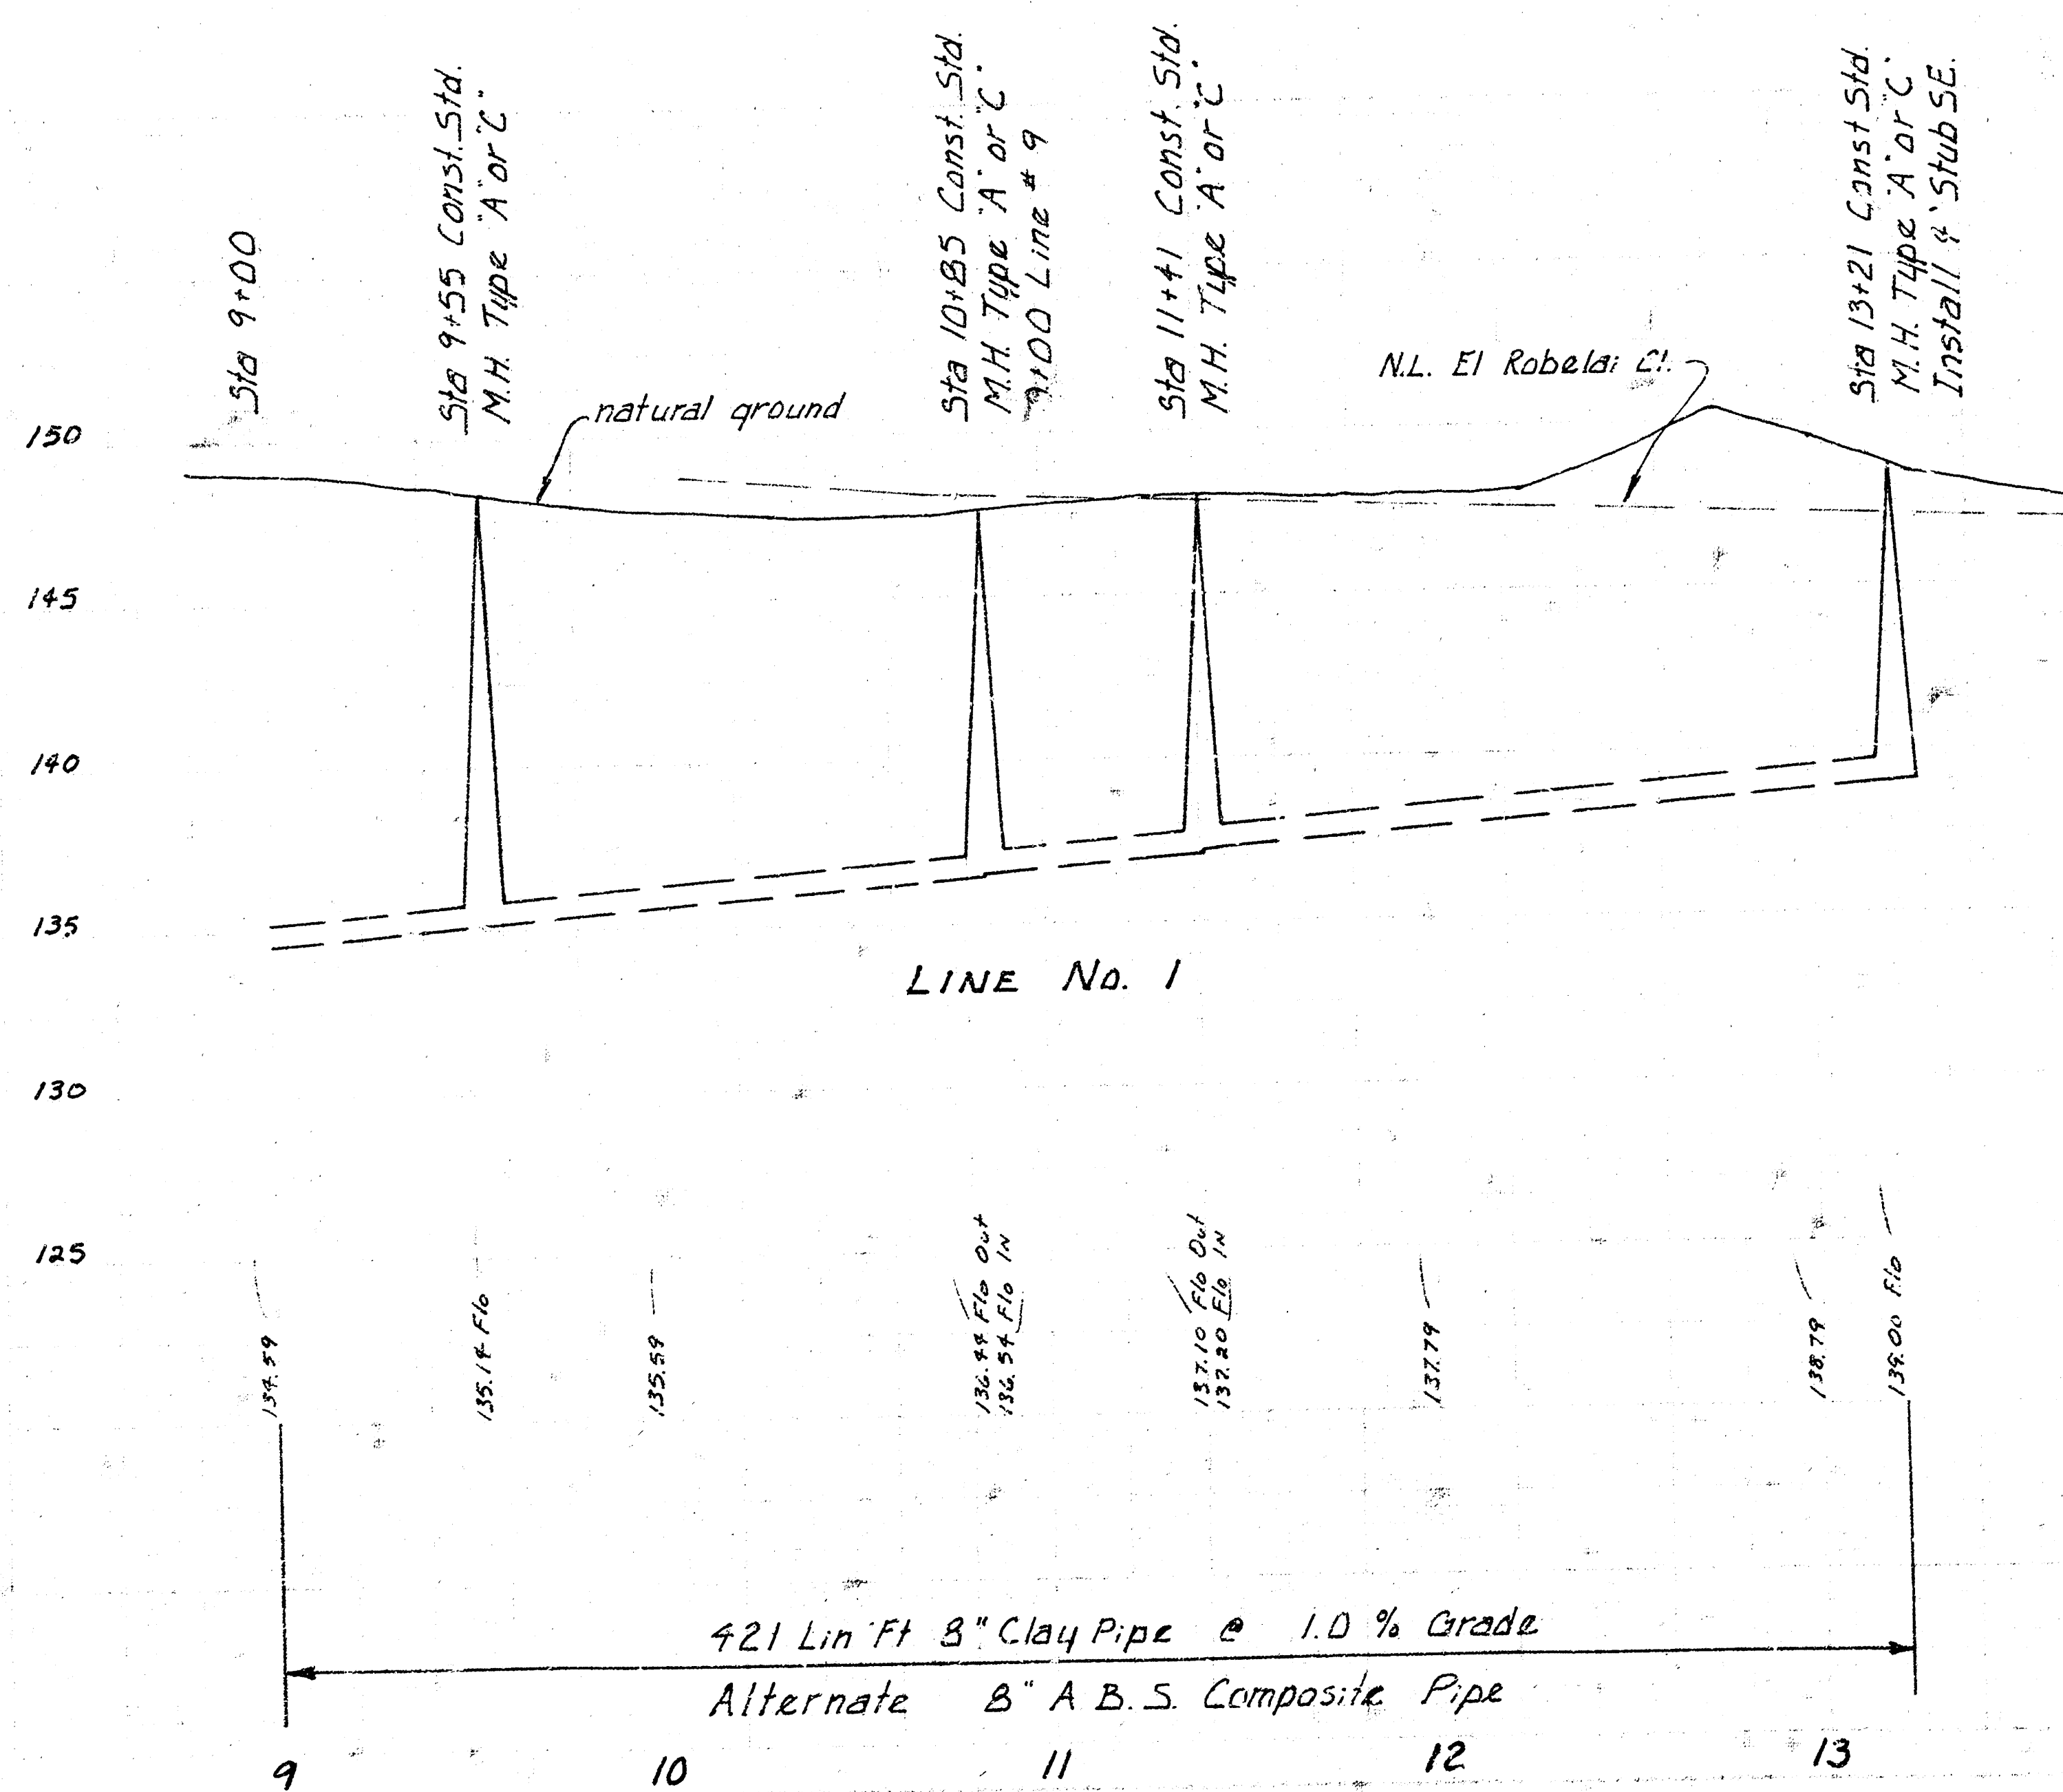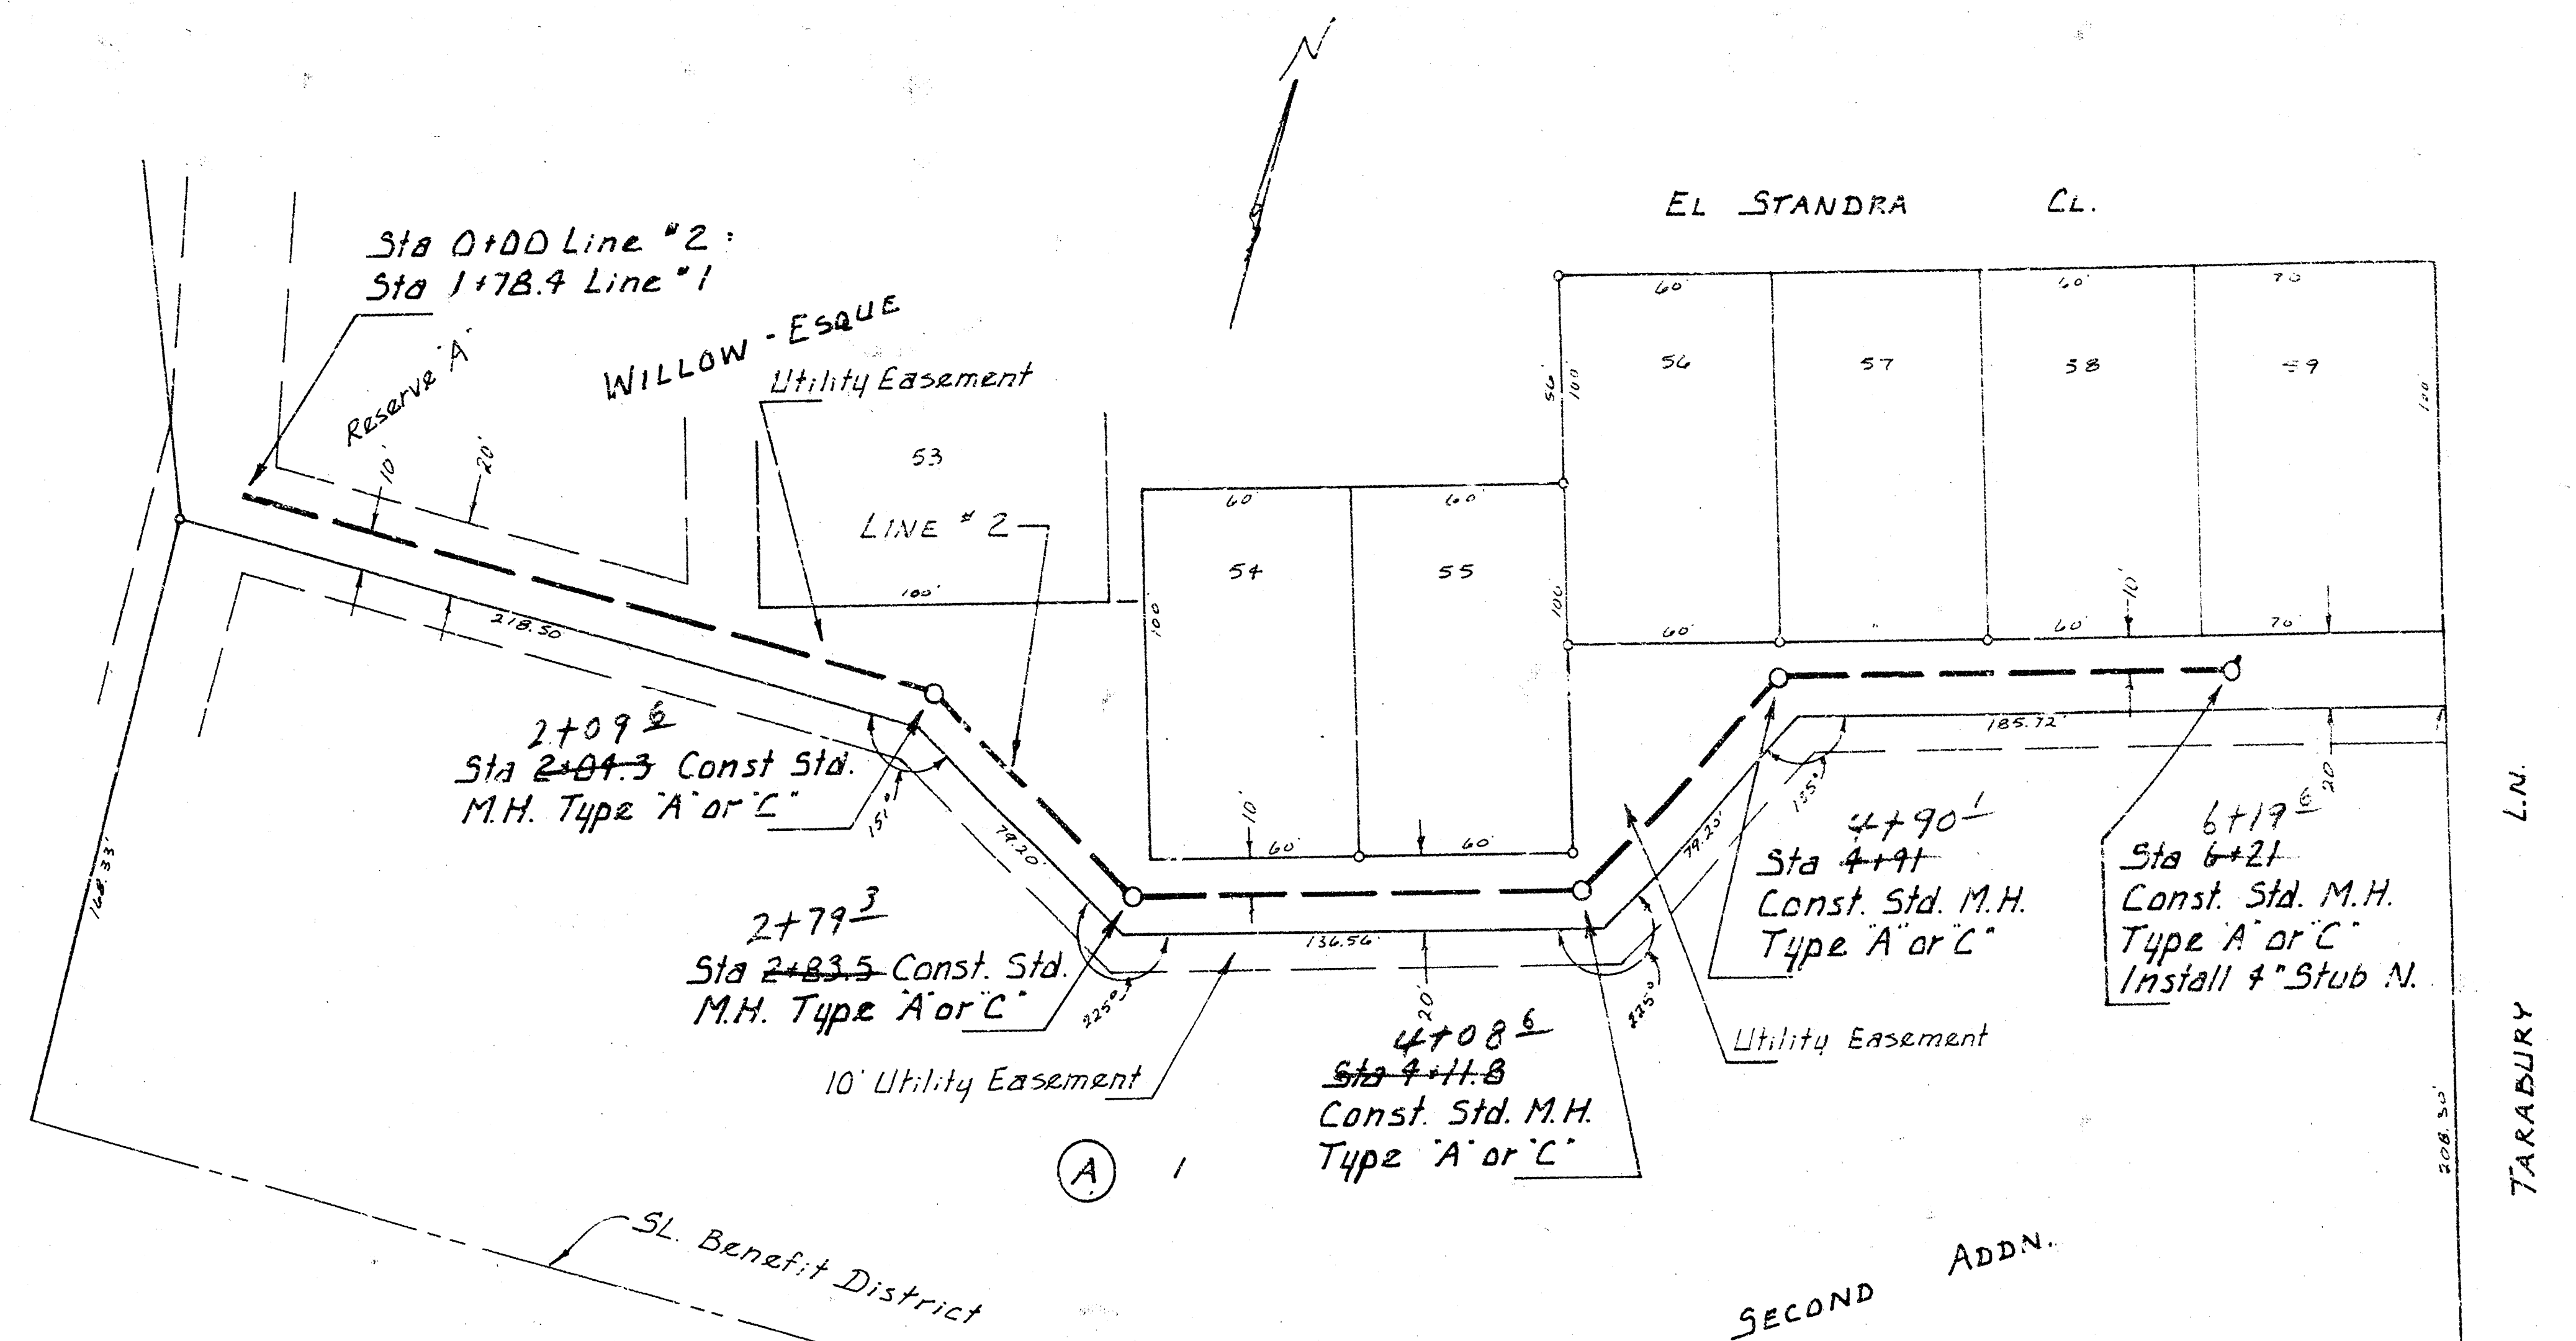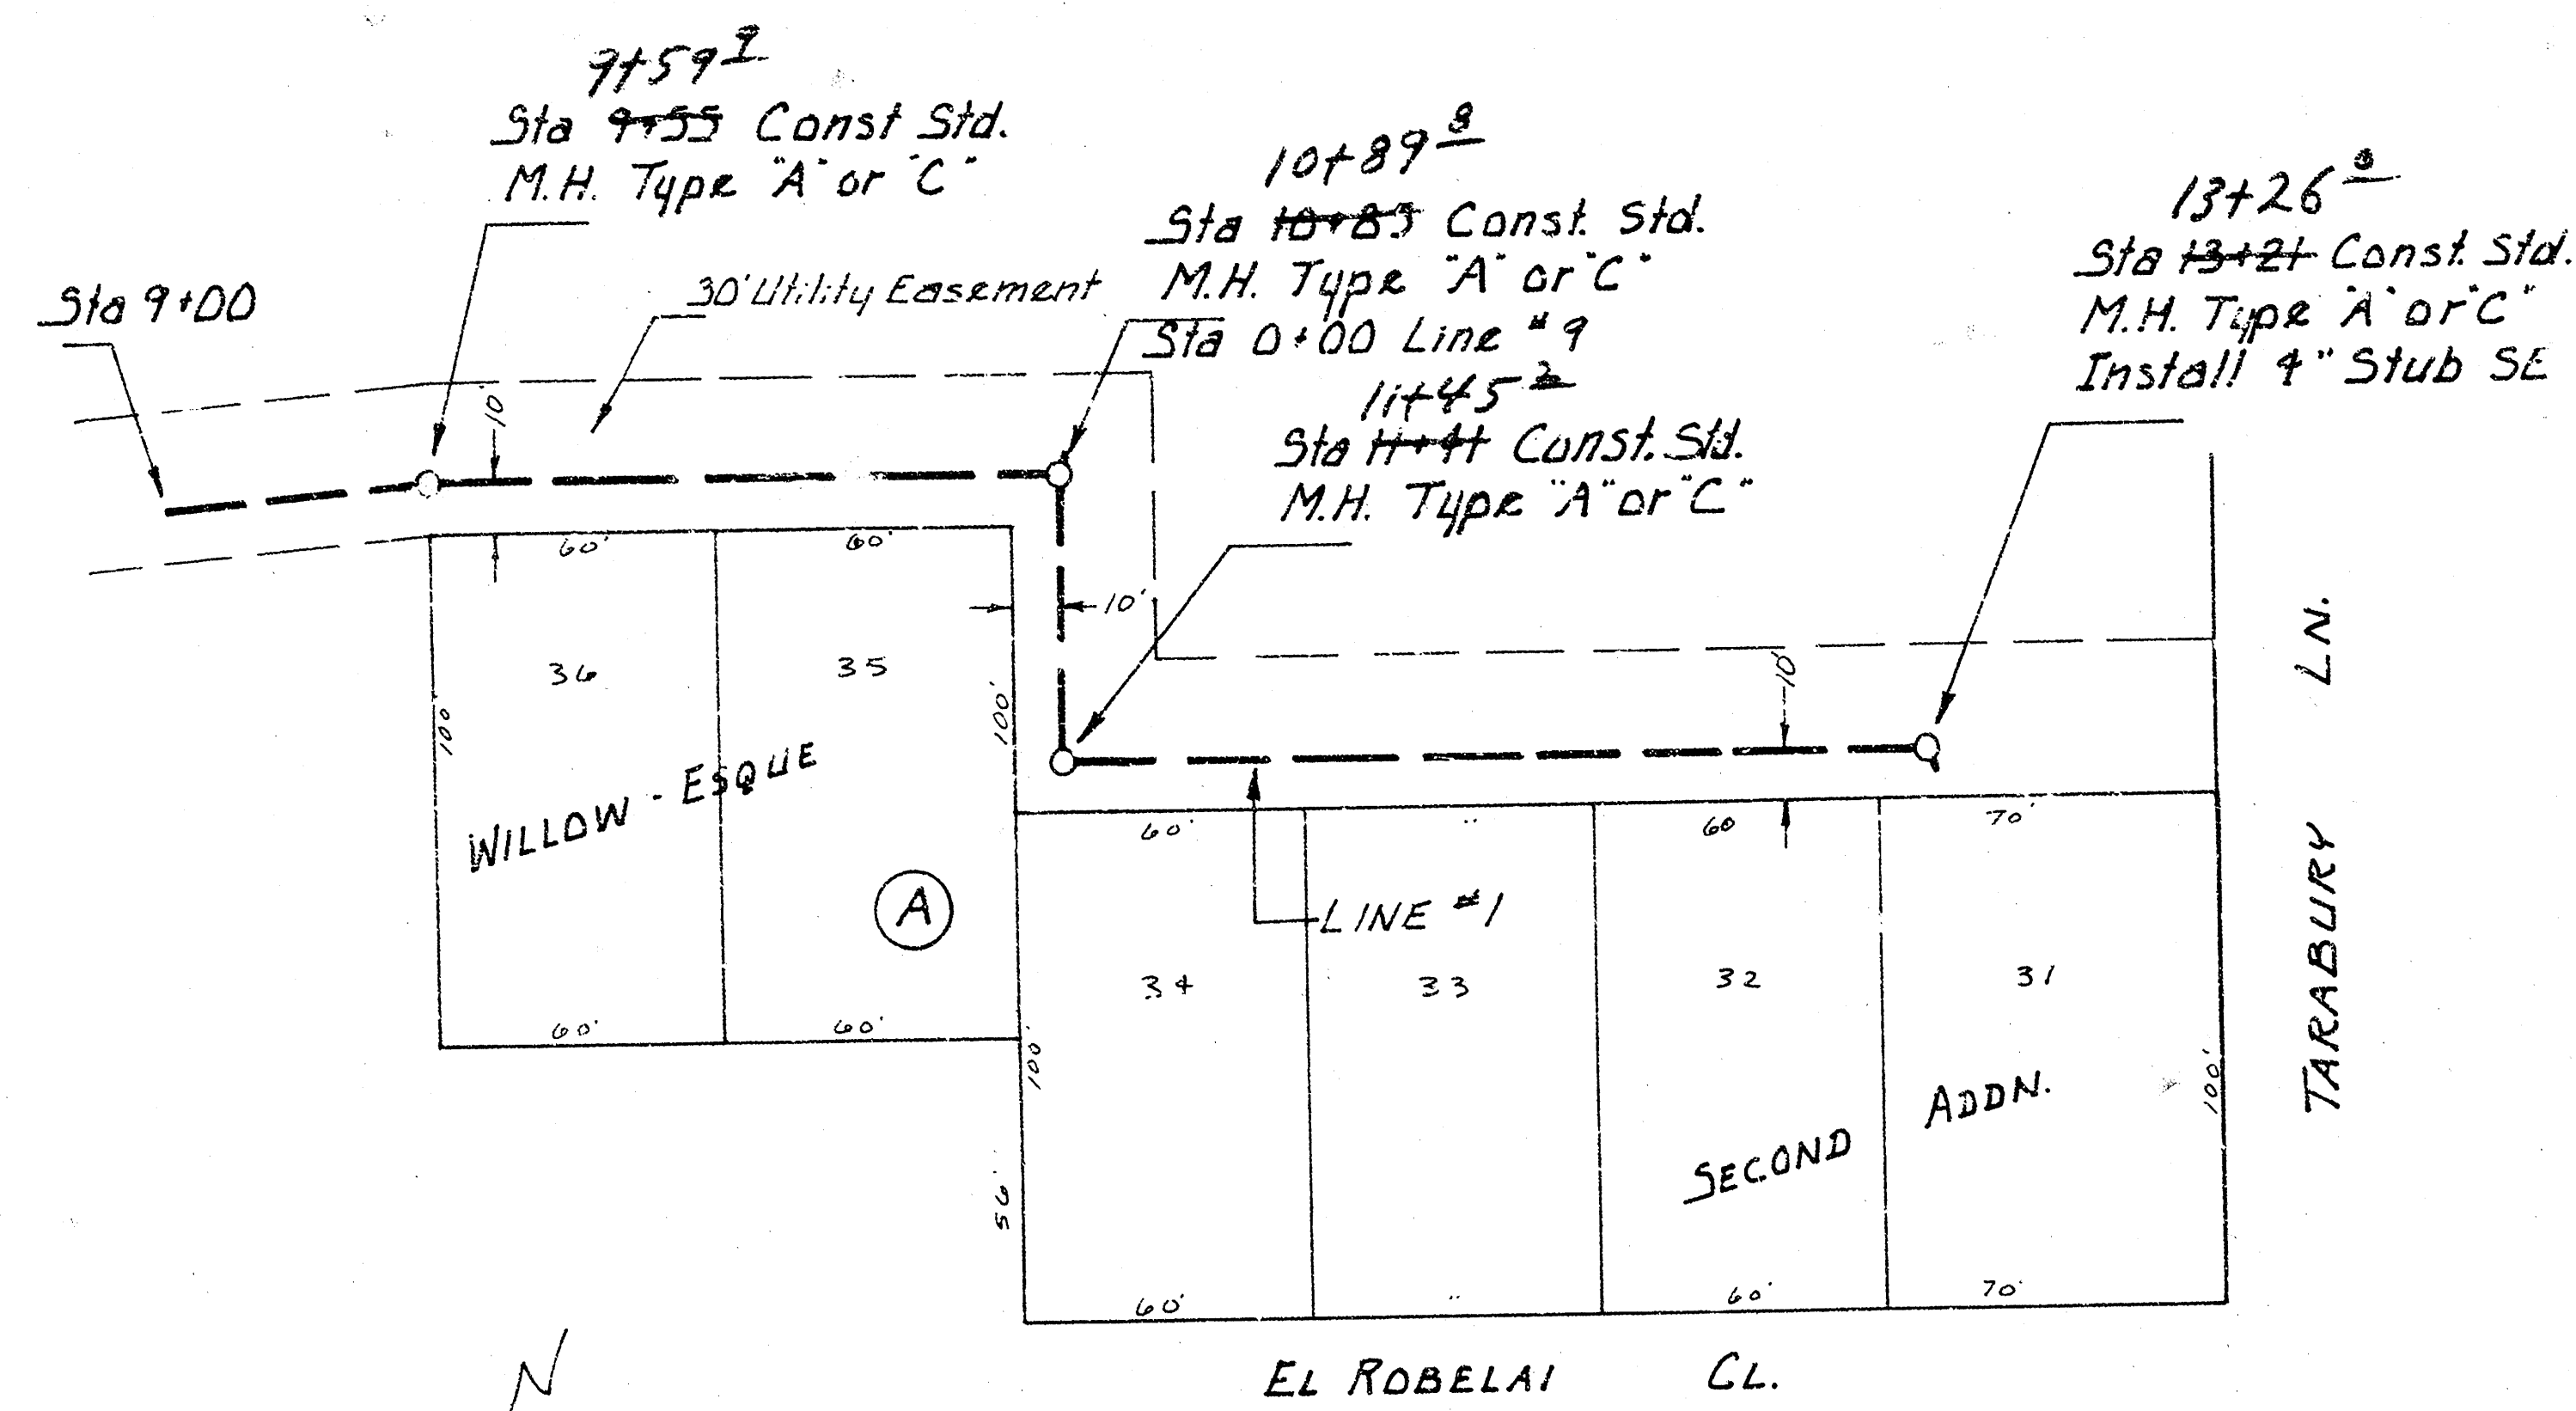






421 Lin. Ft. 8" Clay Pipe @ 1.0 % Grade
Alternate B" A.B.S. Composite Pipe

621 Lin. Ft. 8" Clay Pipe @ 1.0 % Grade
Alternate B" A.B.S. Composite Pipe




LAT. 3, MAIN 6, S. W. I.
PROJECT NO. DBKL575048

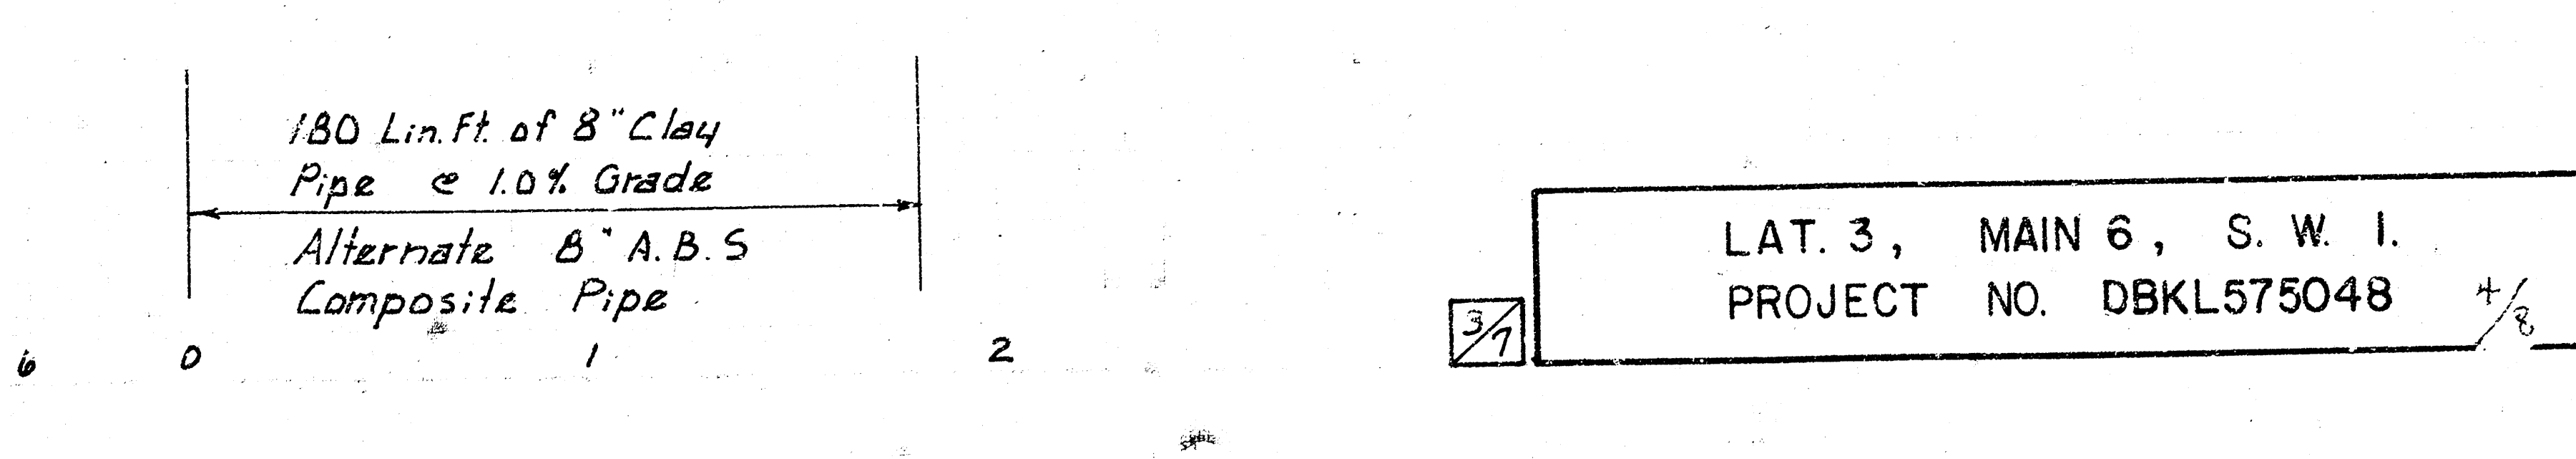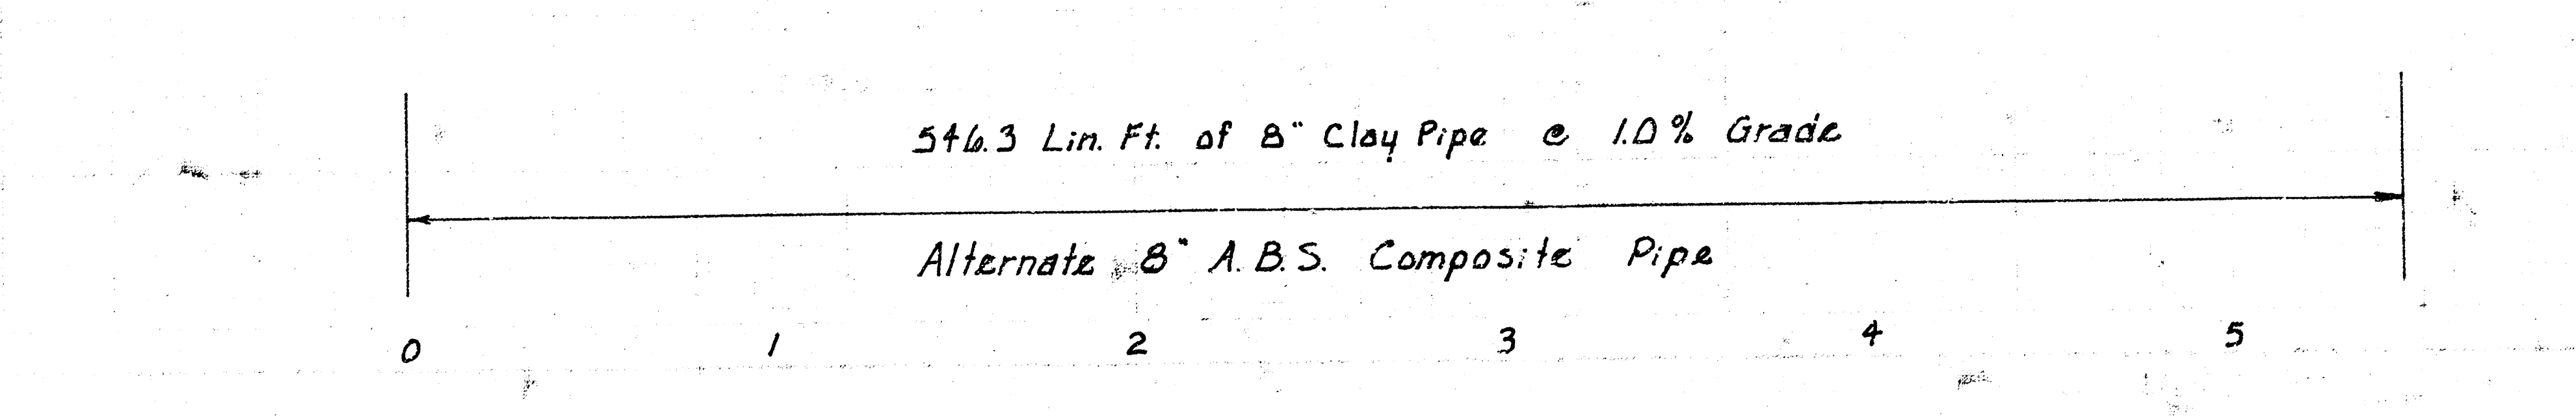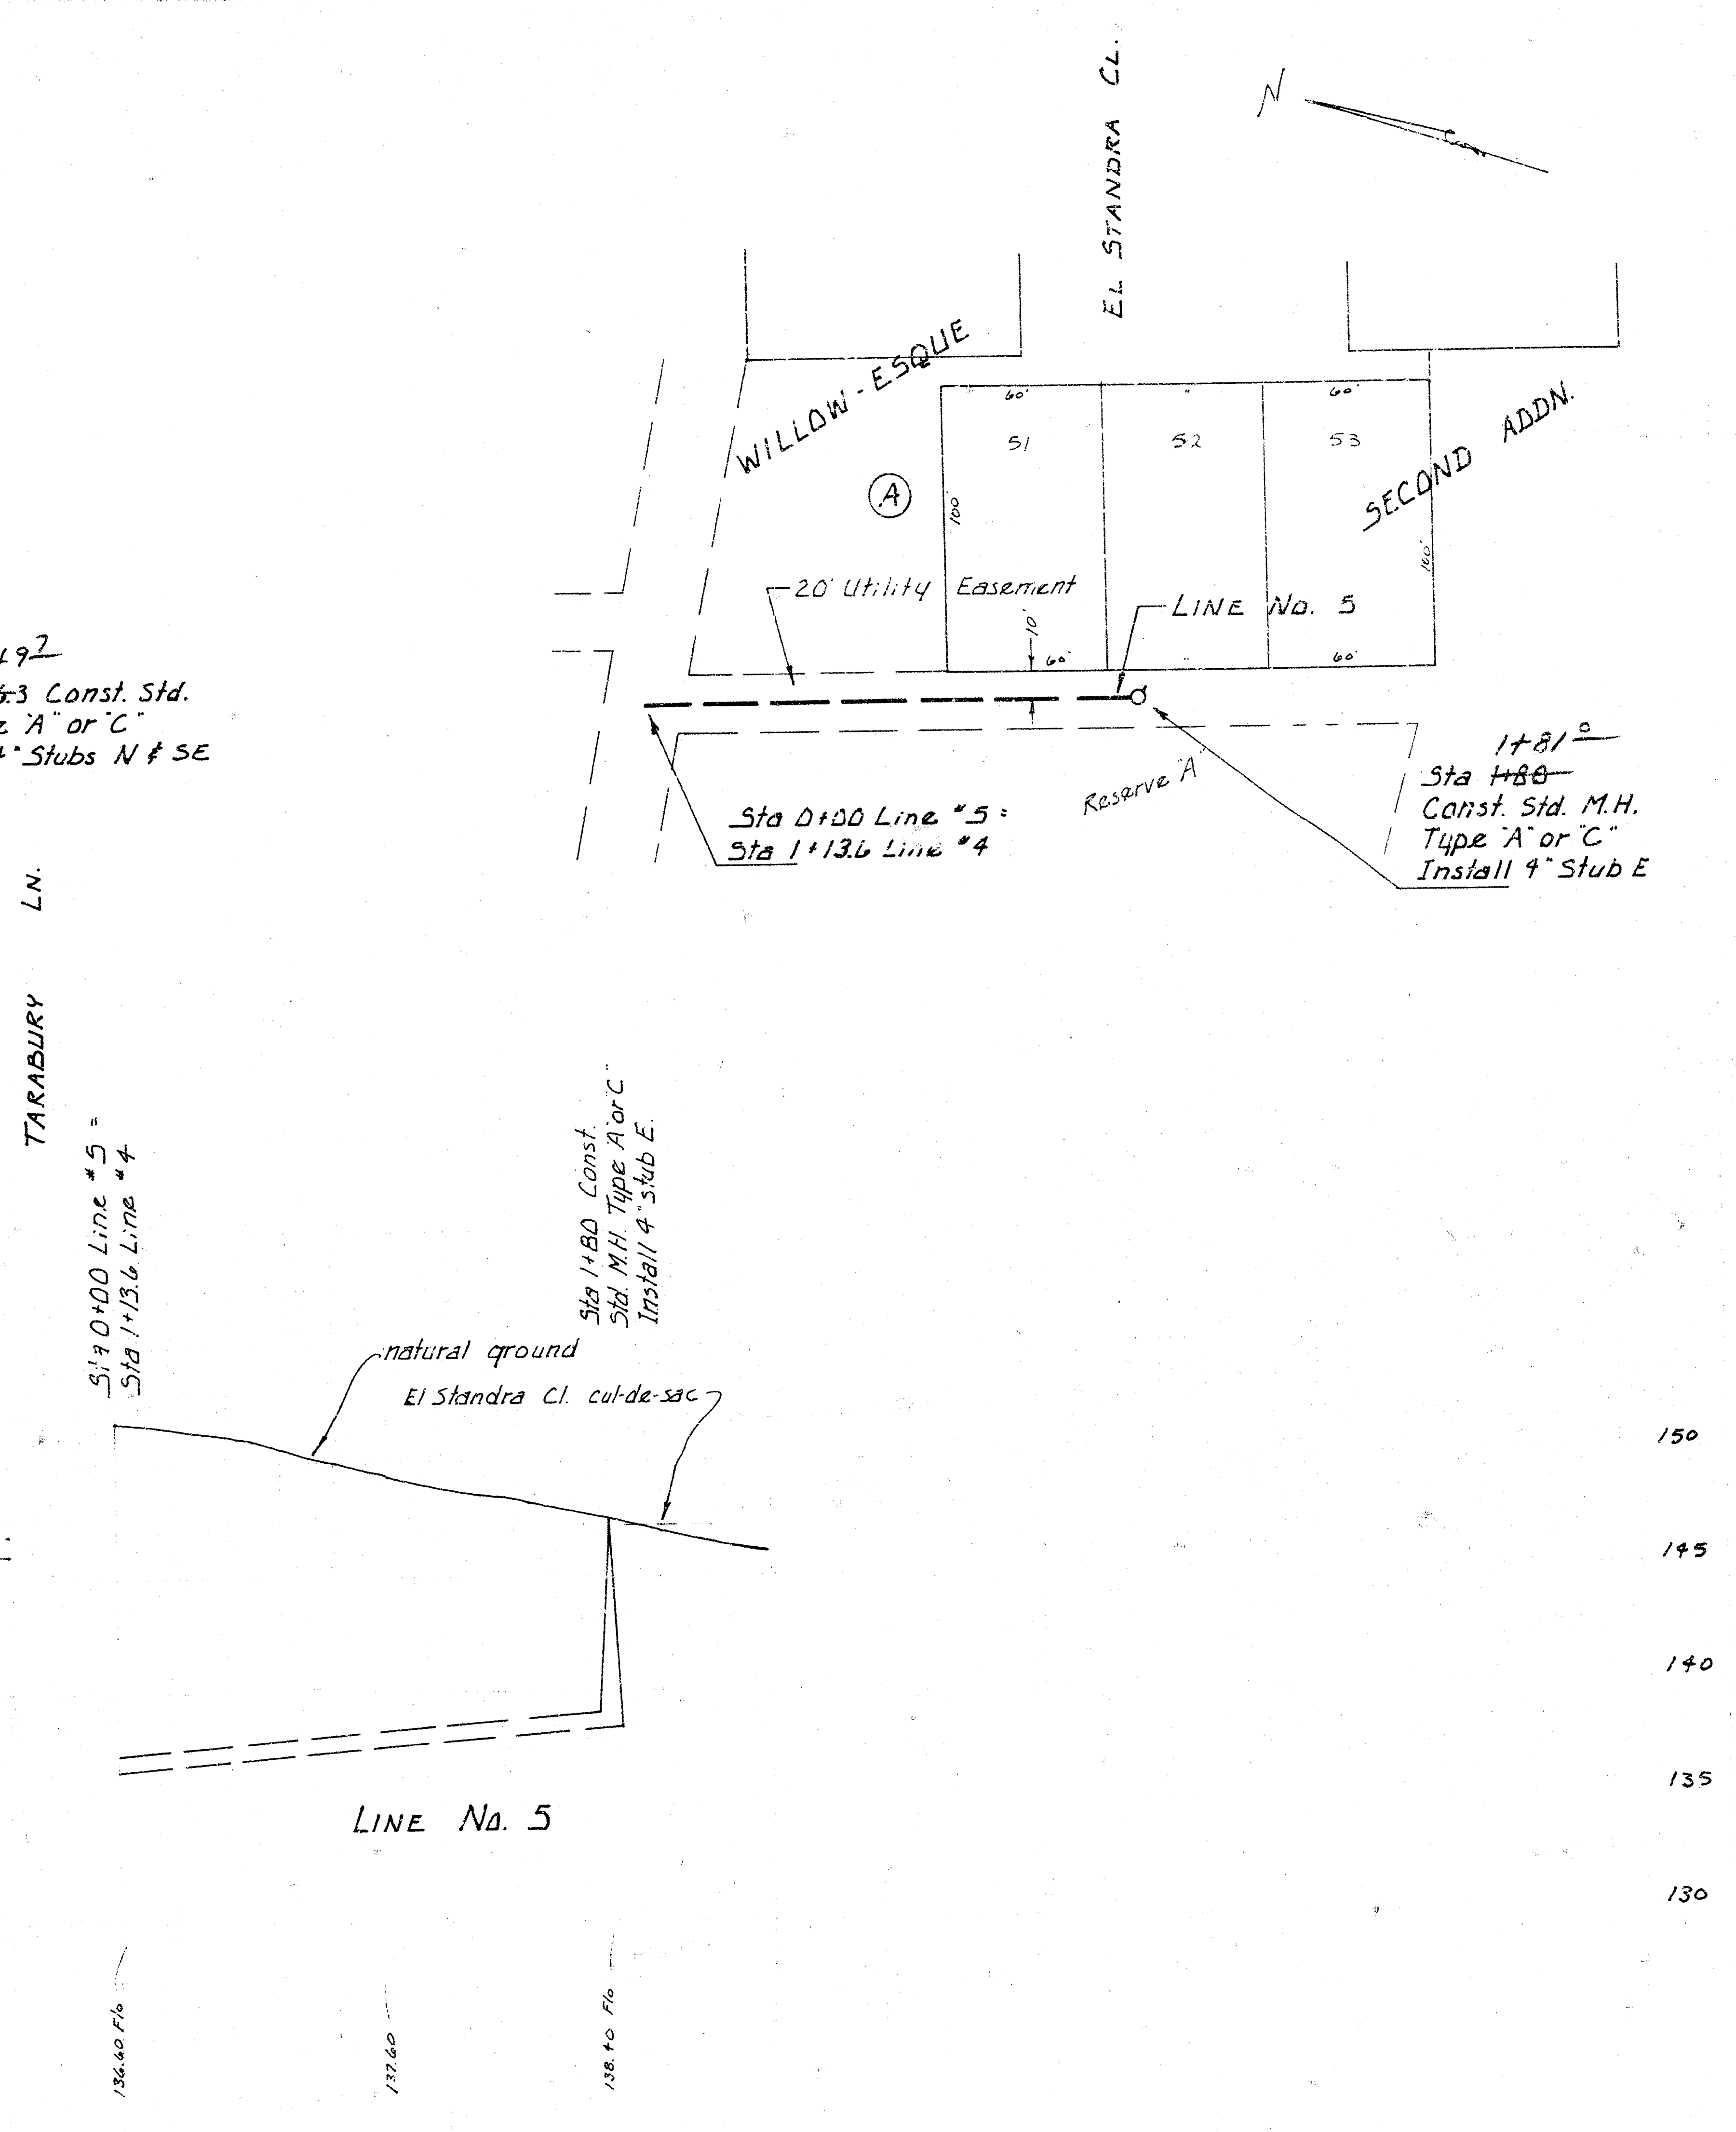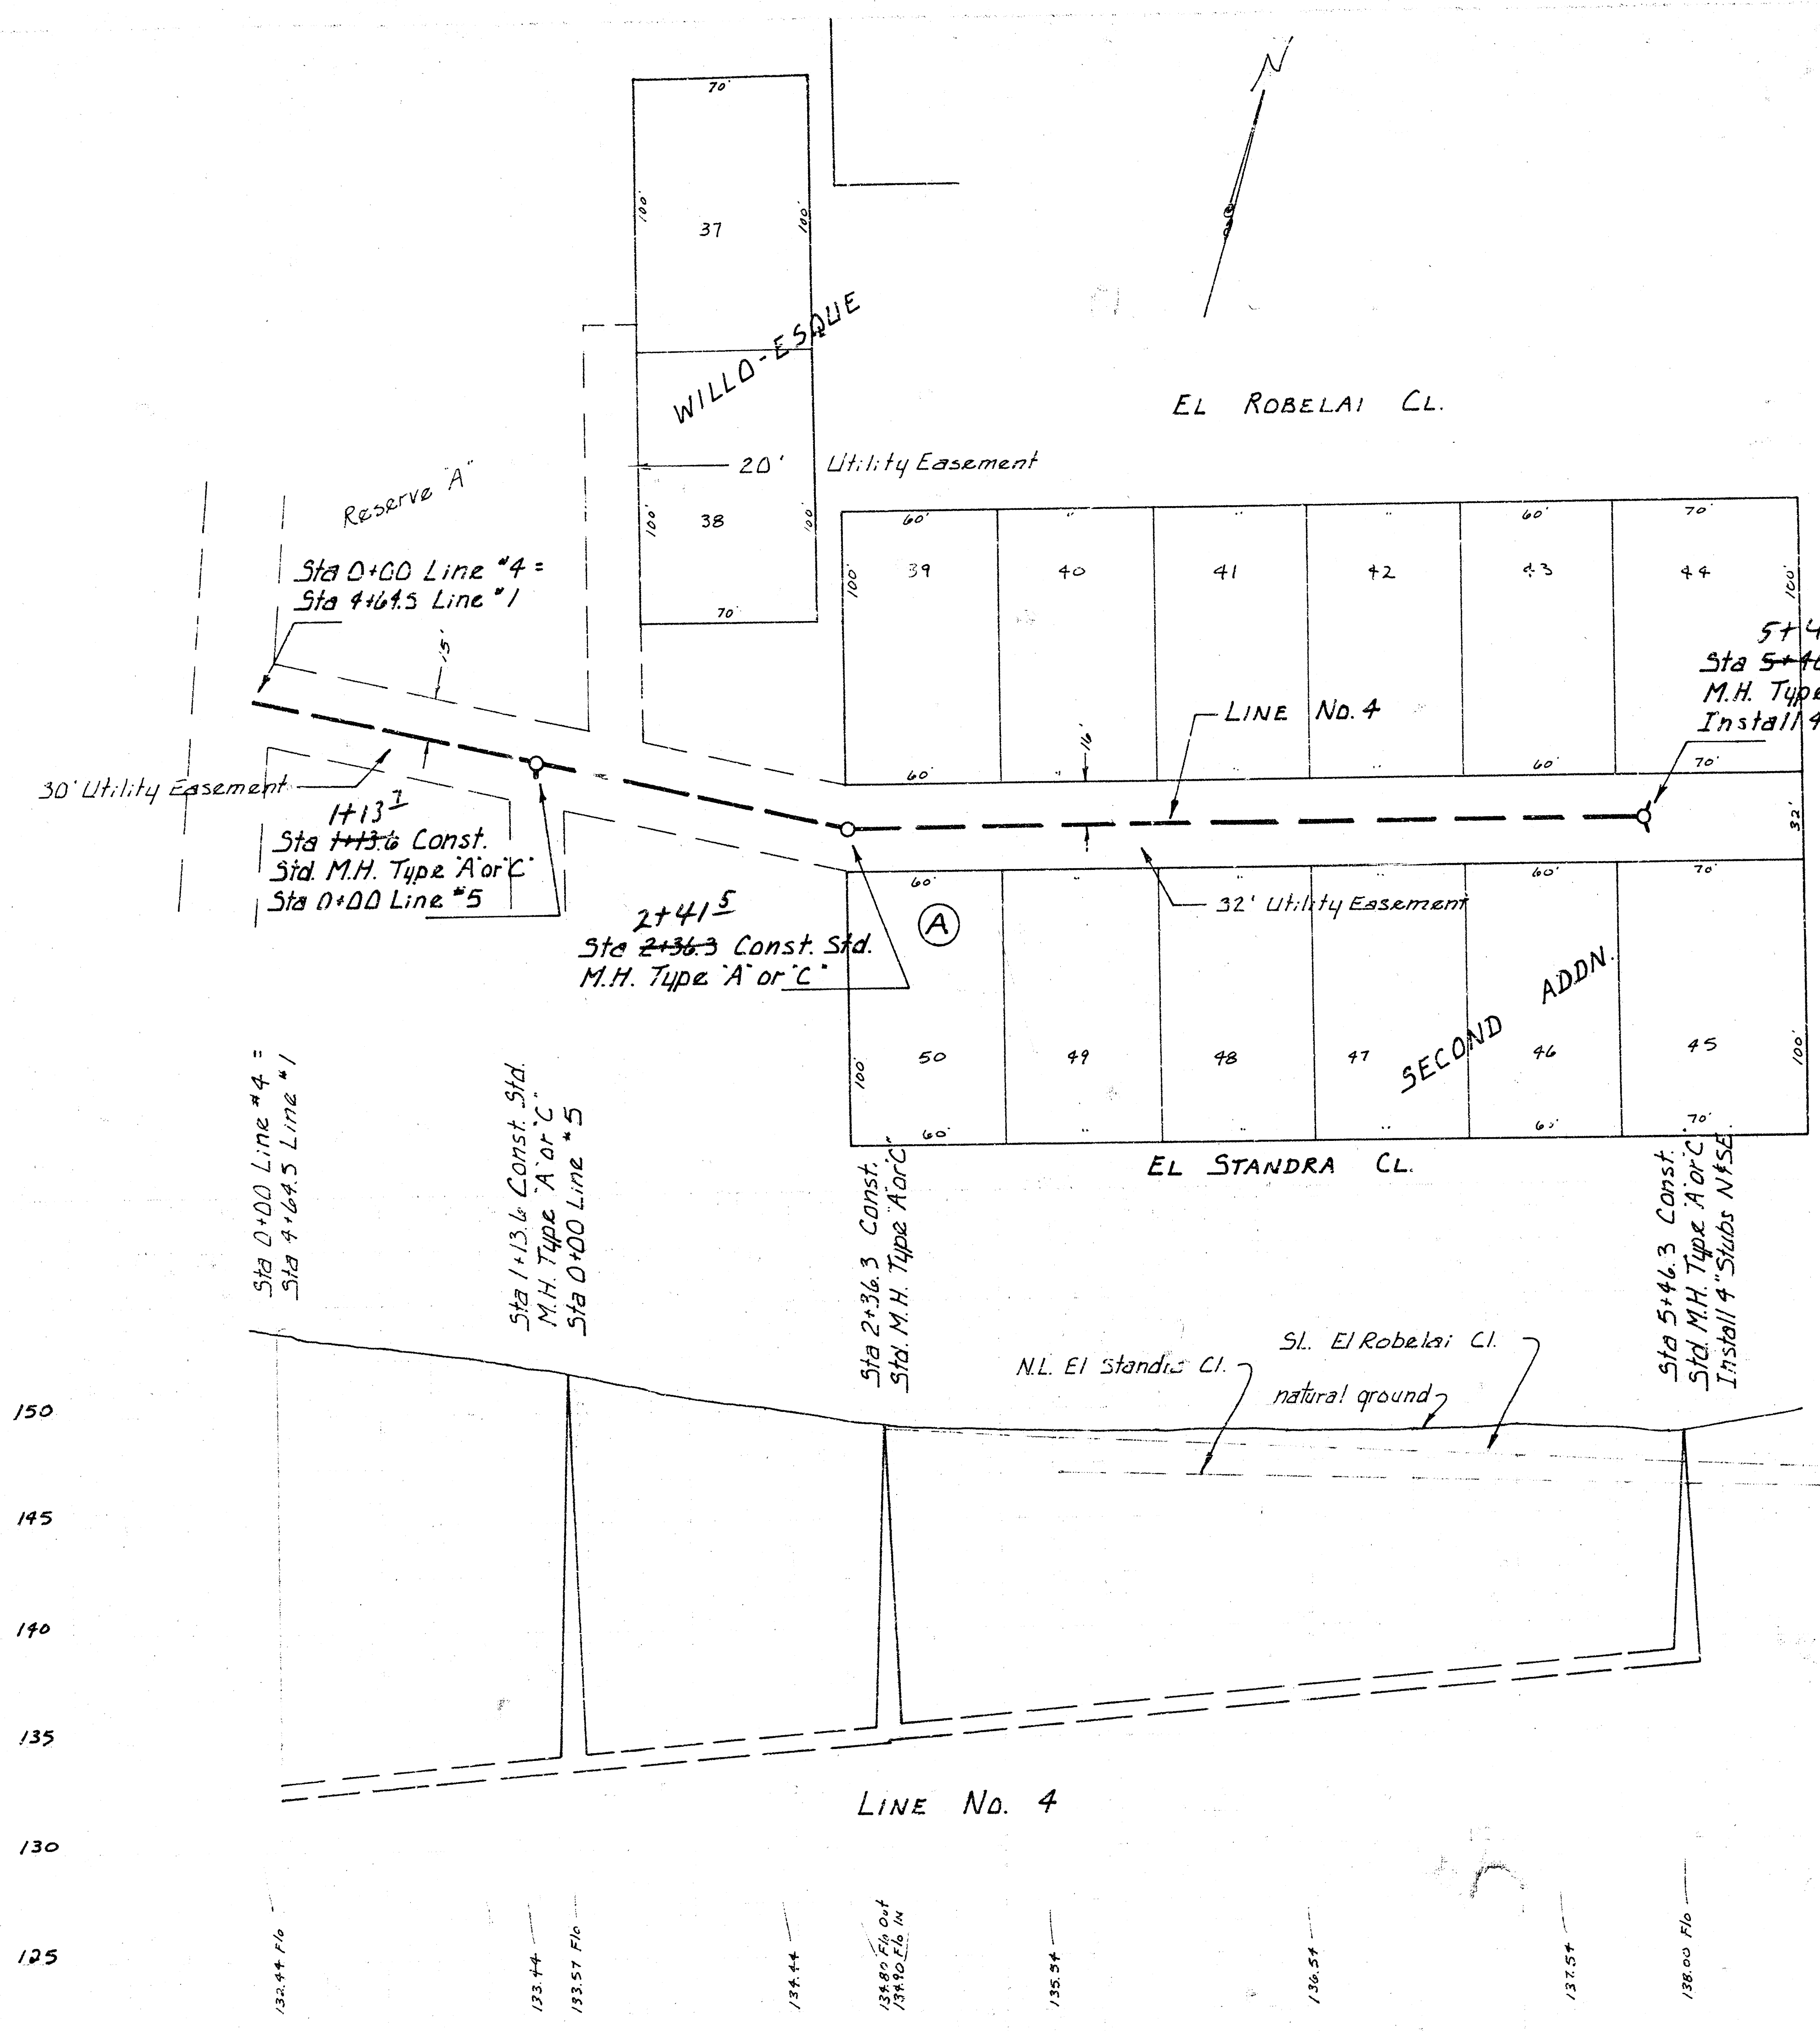


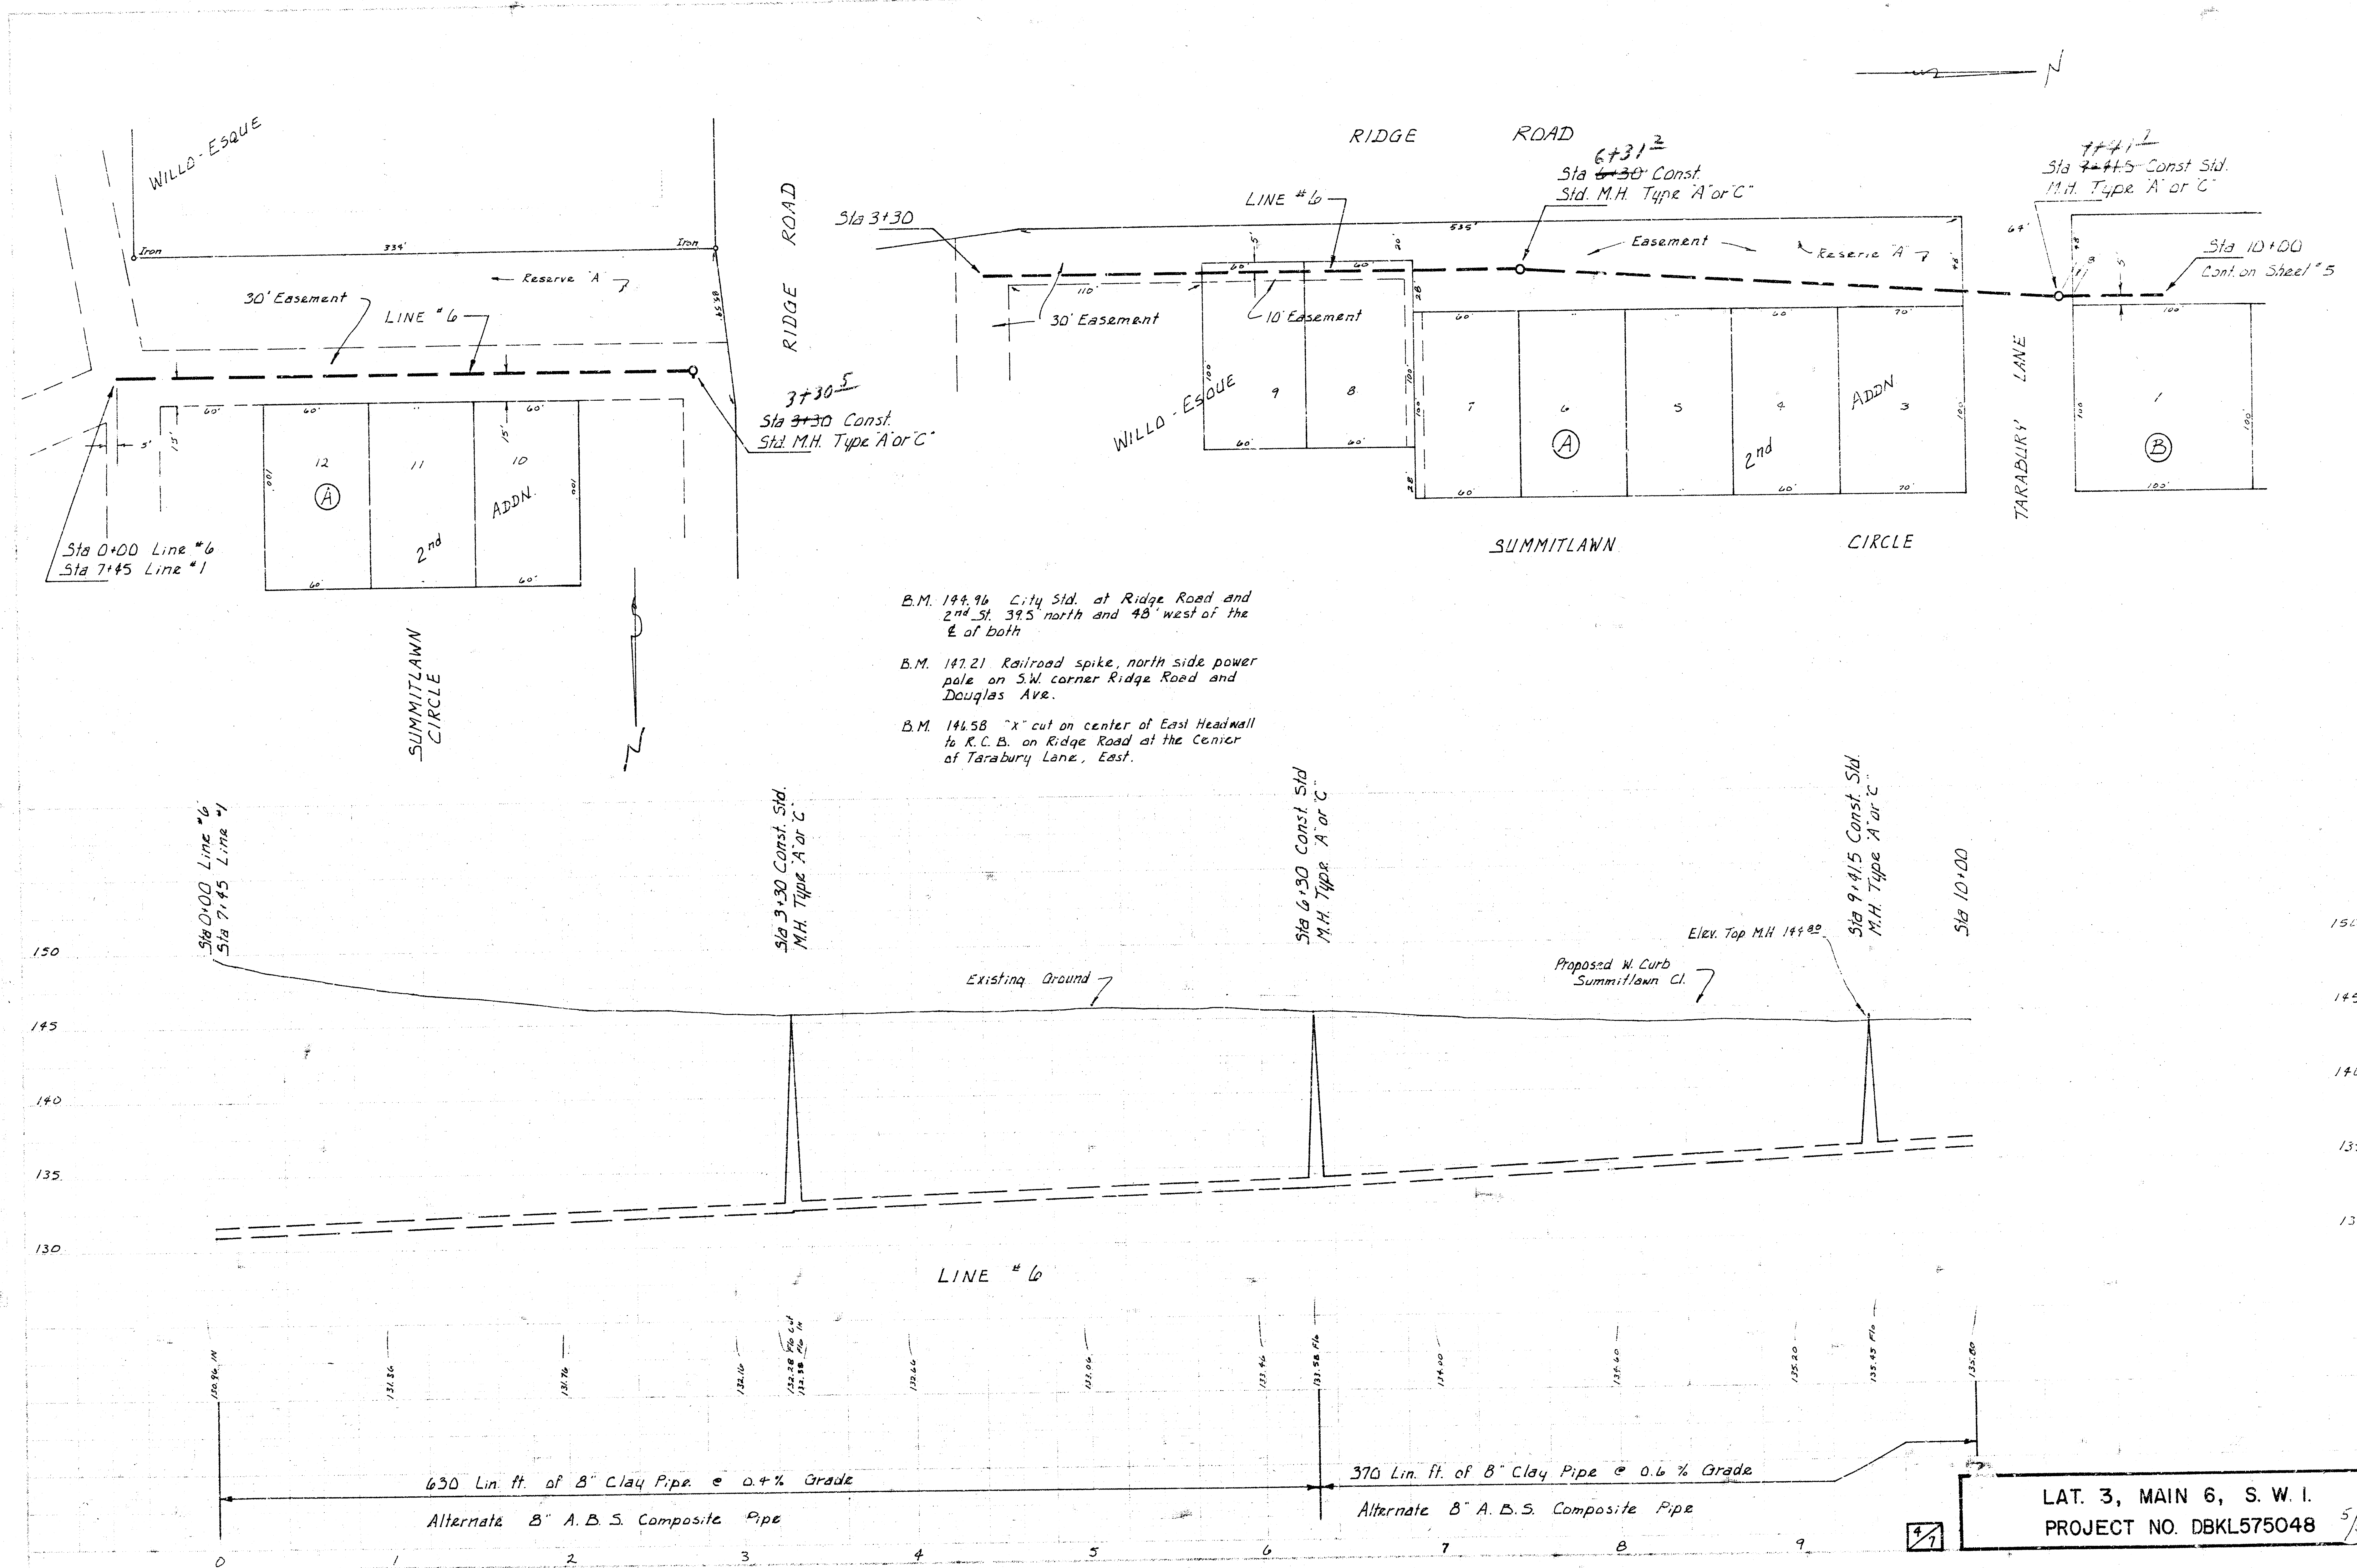

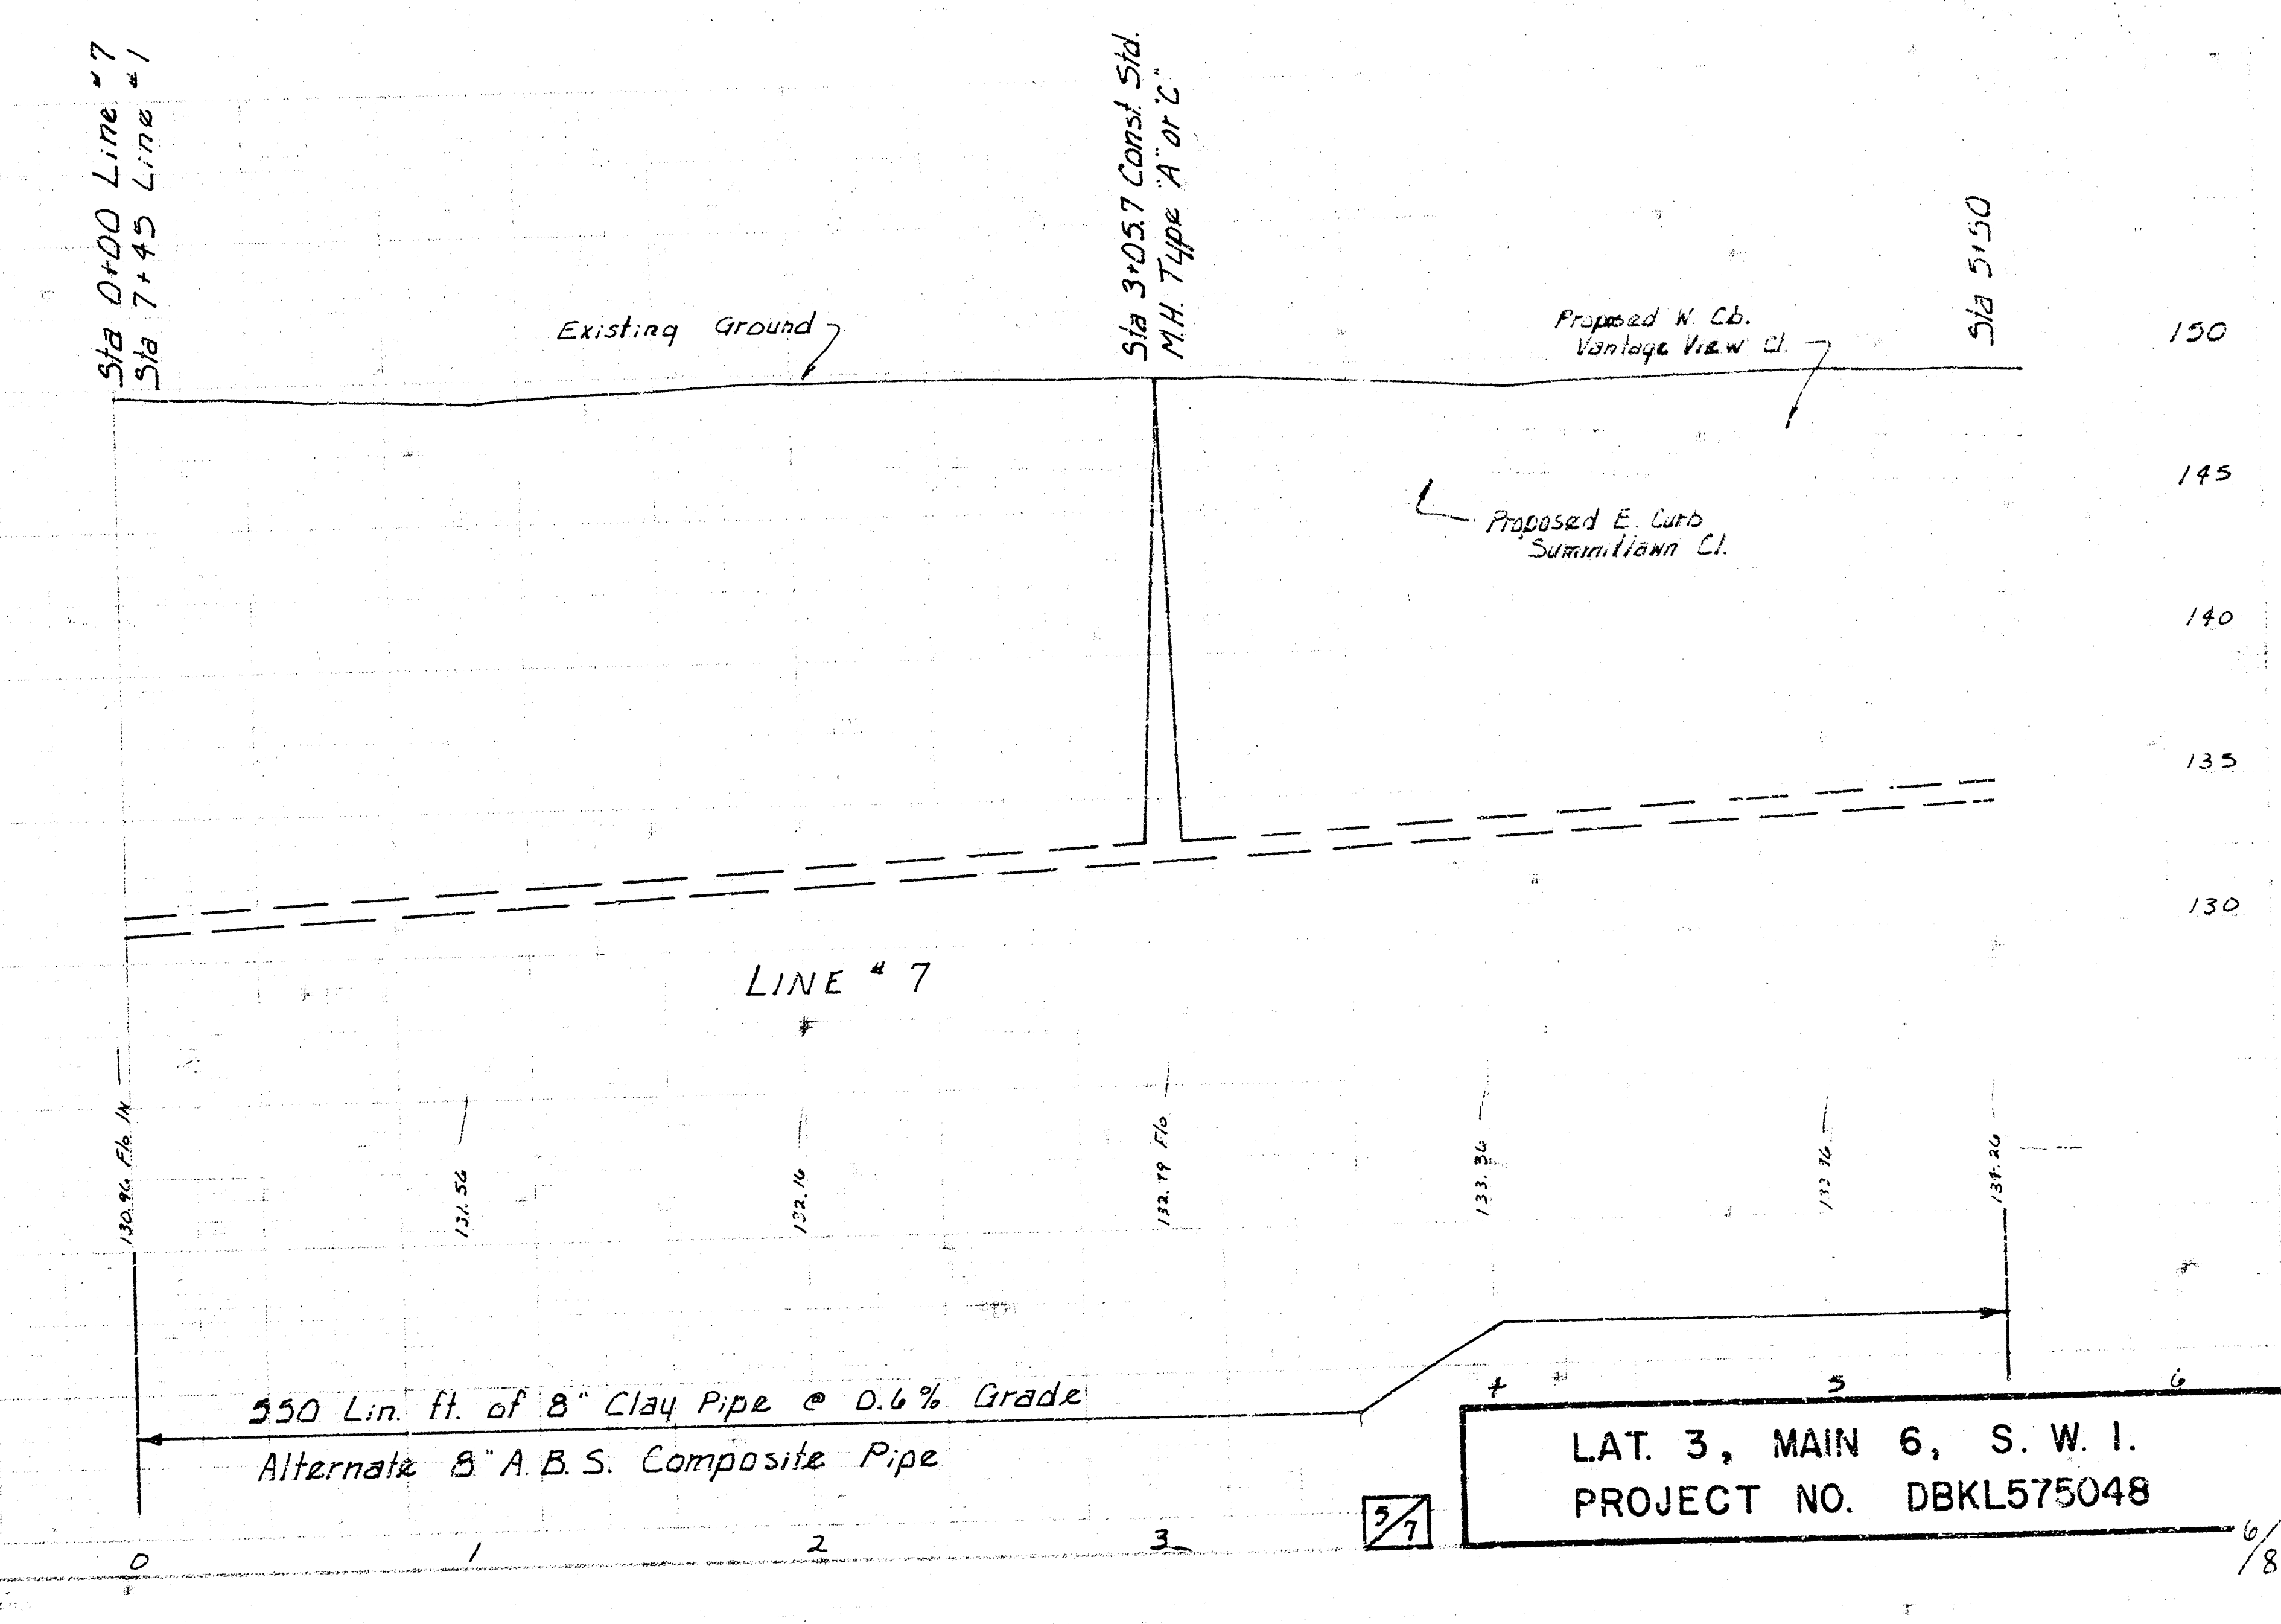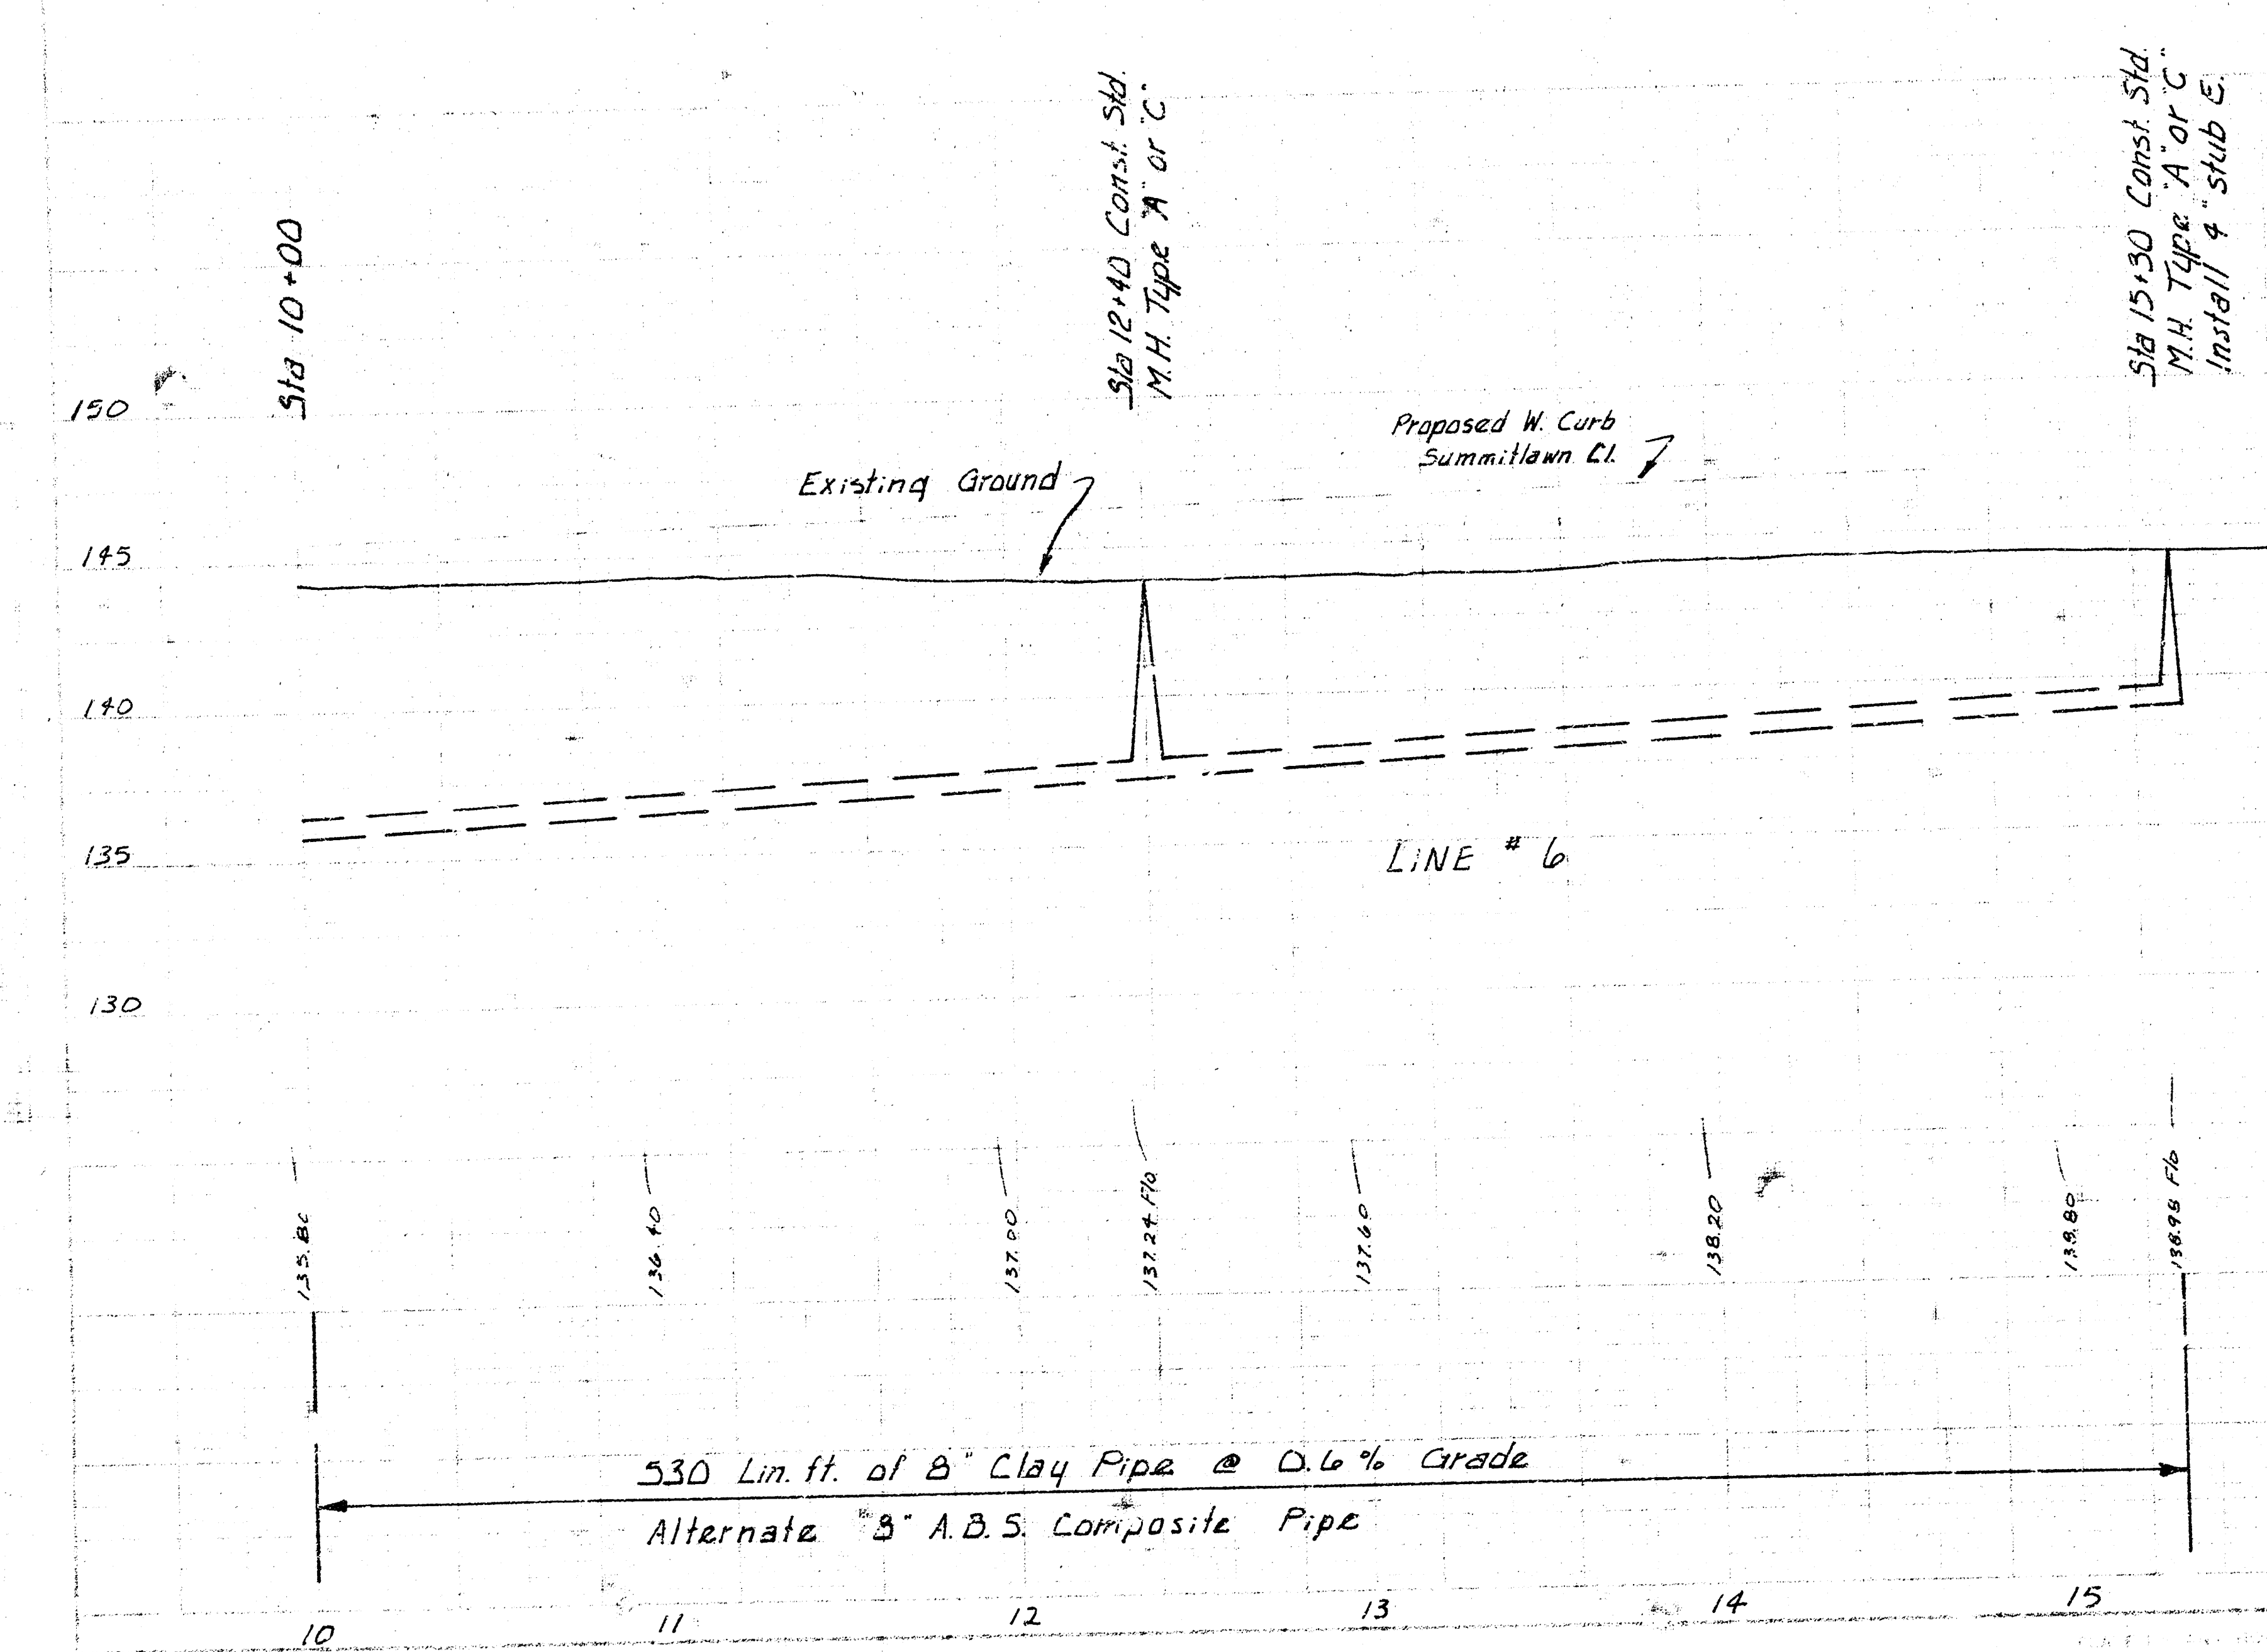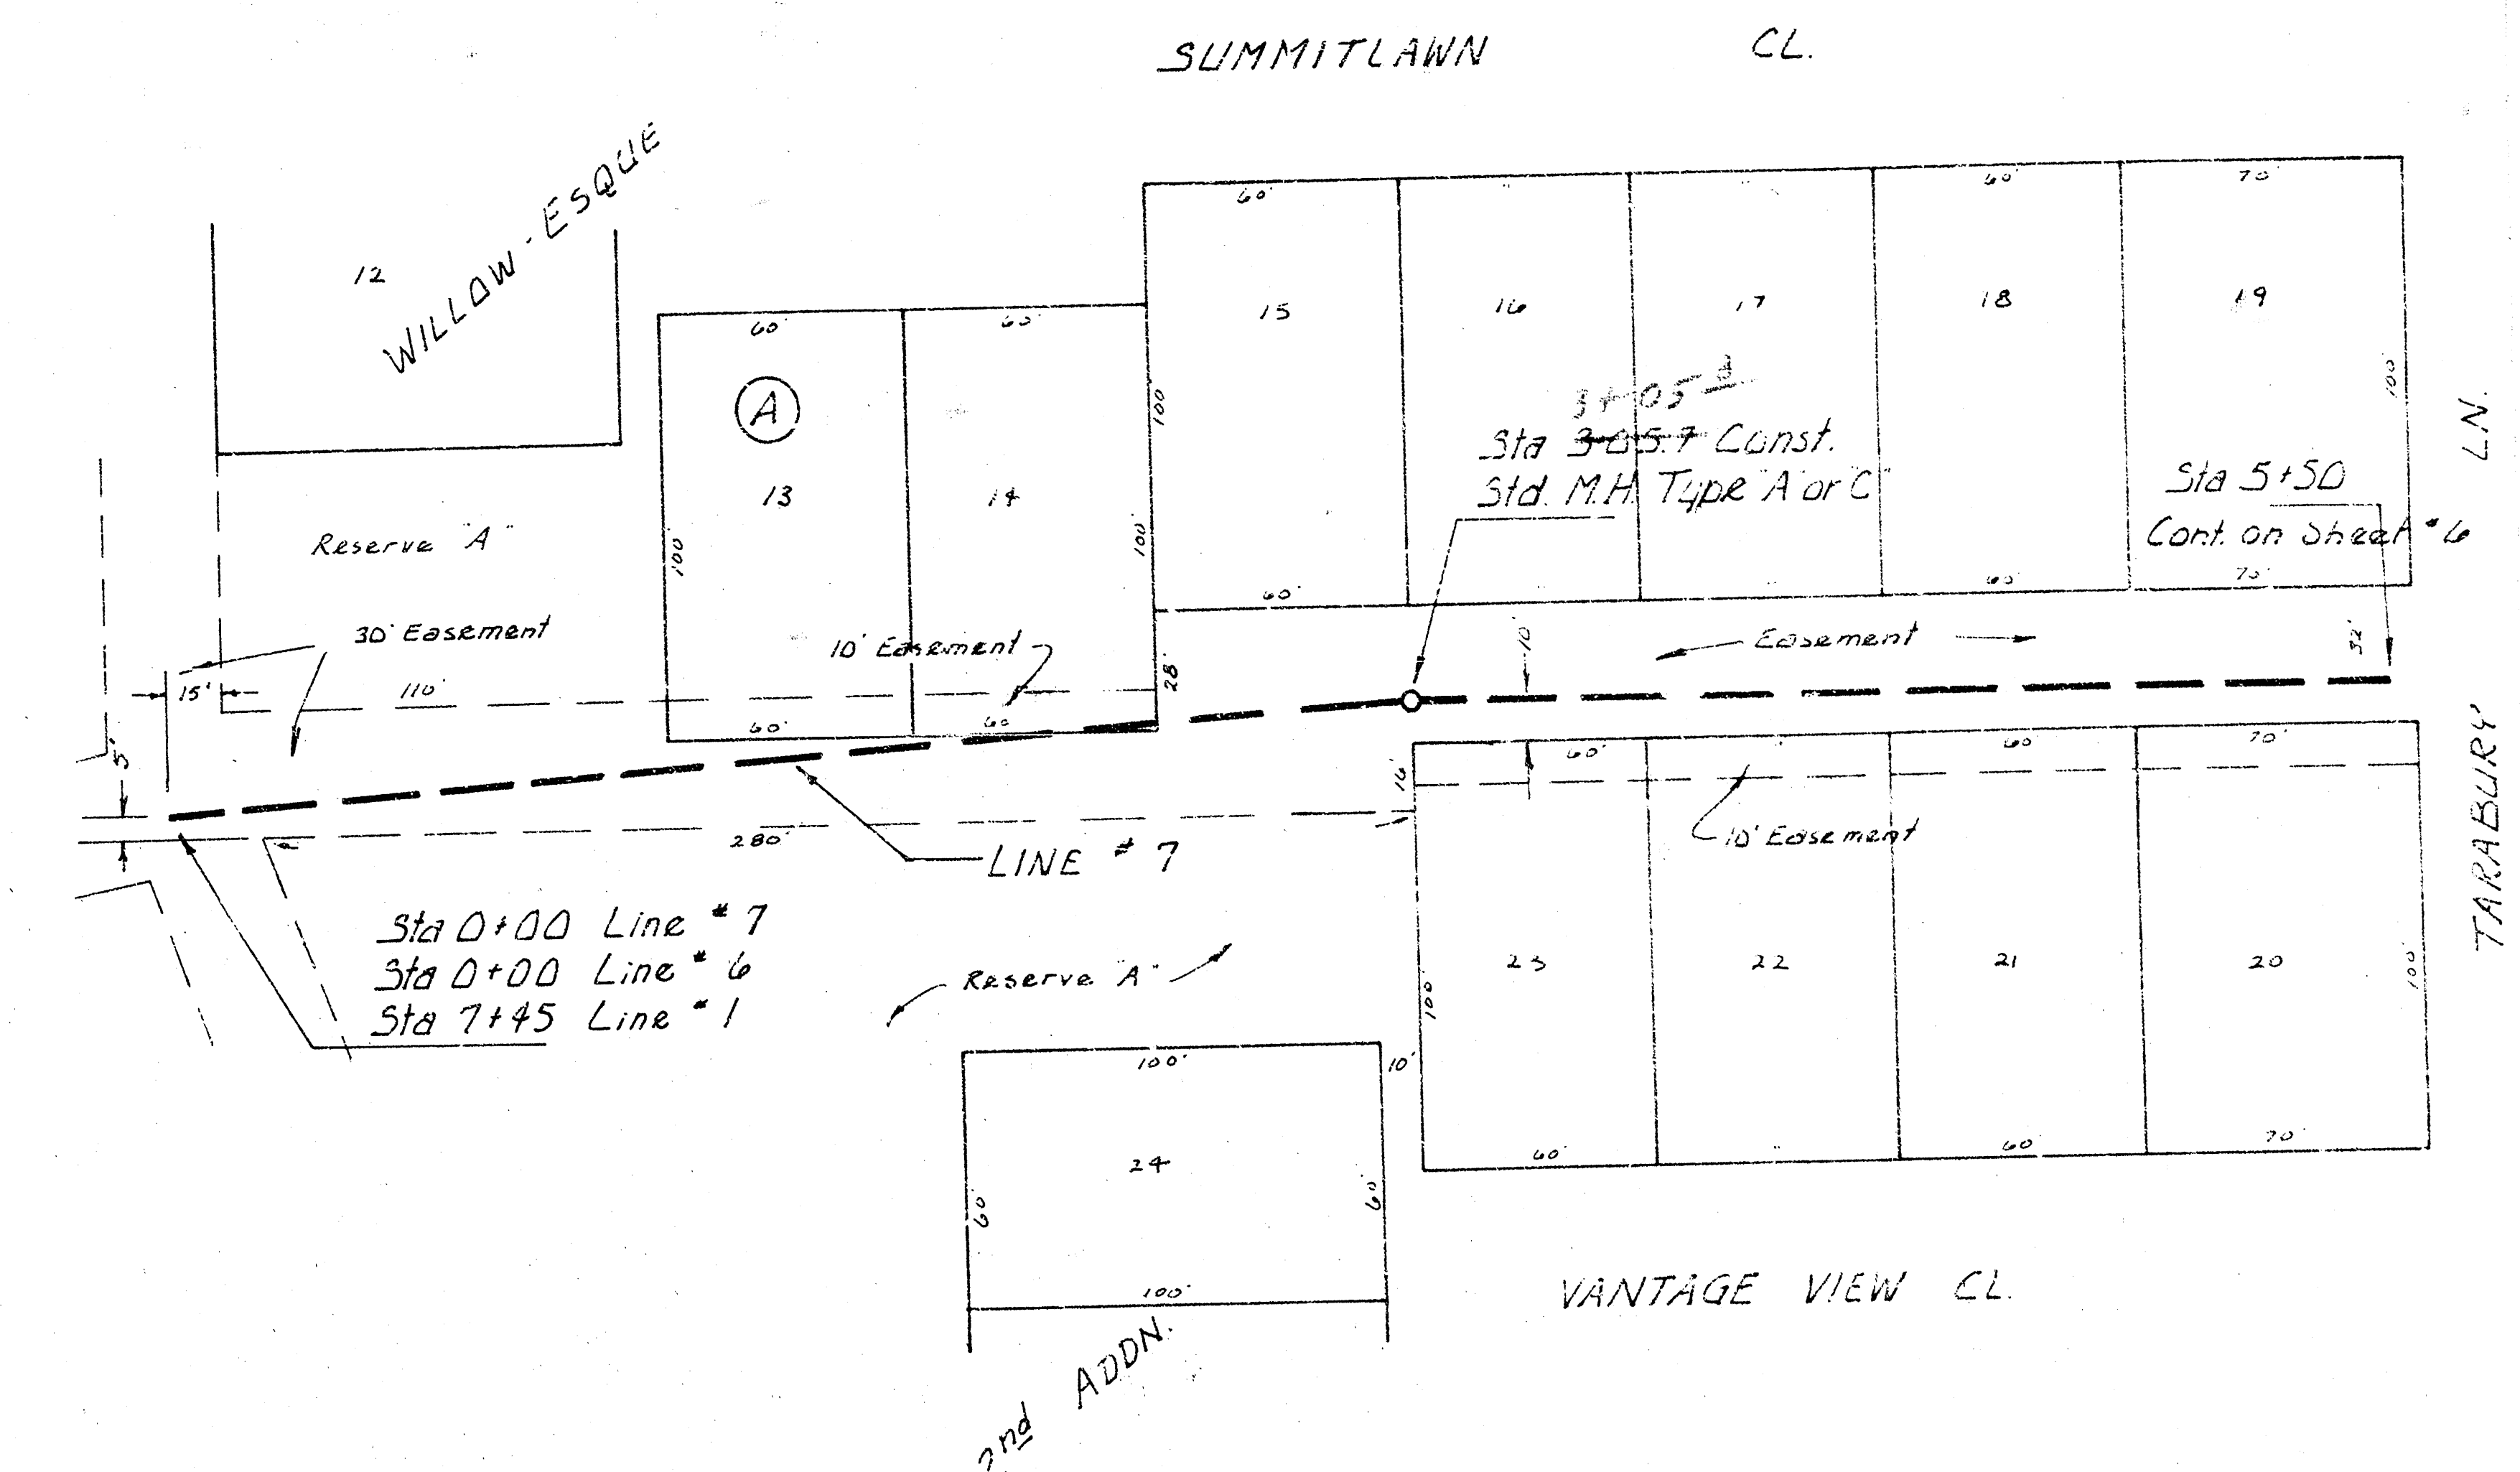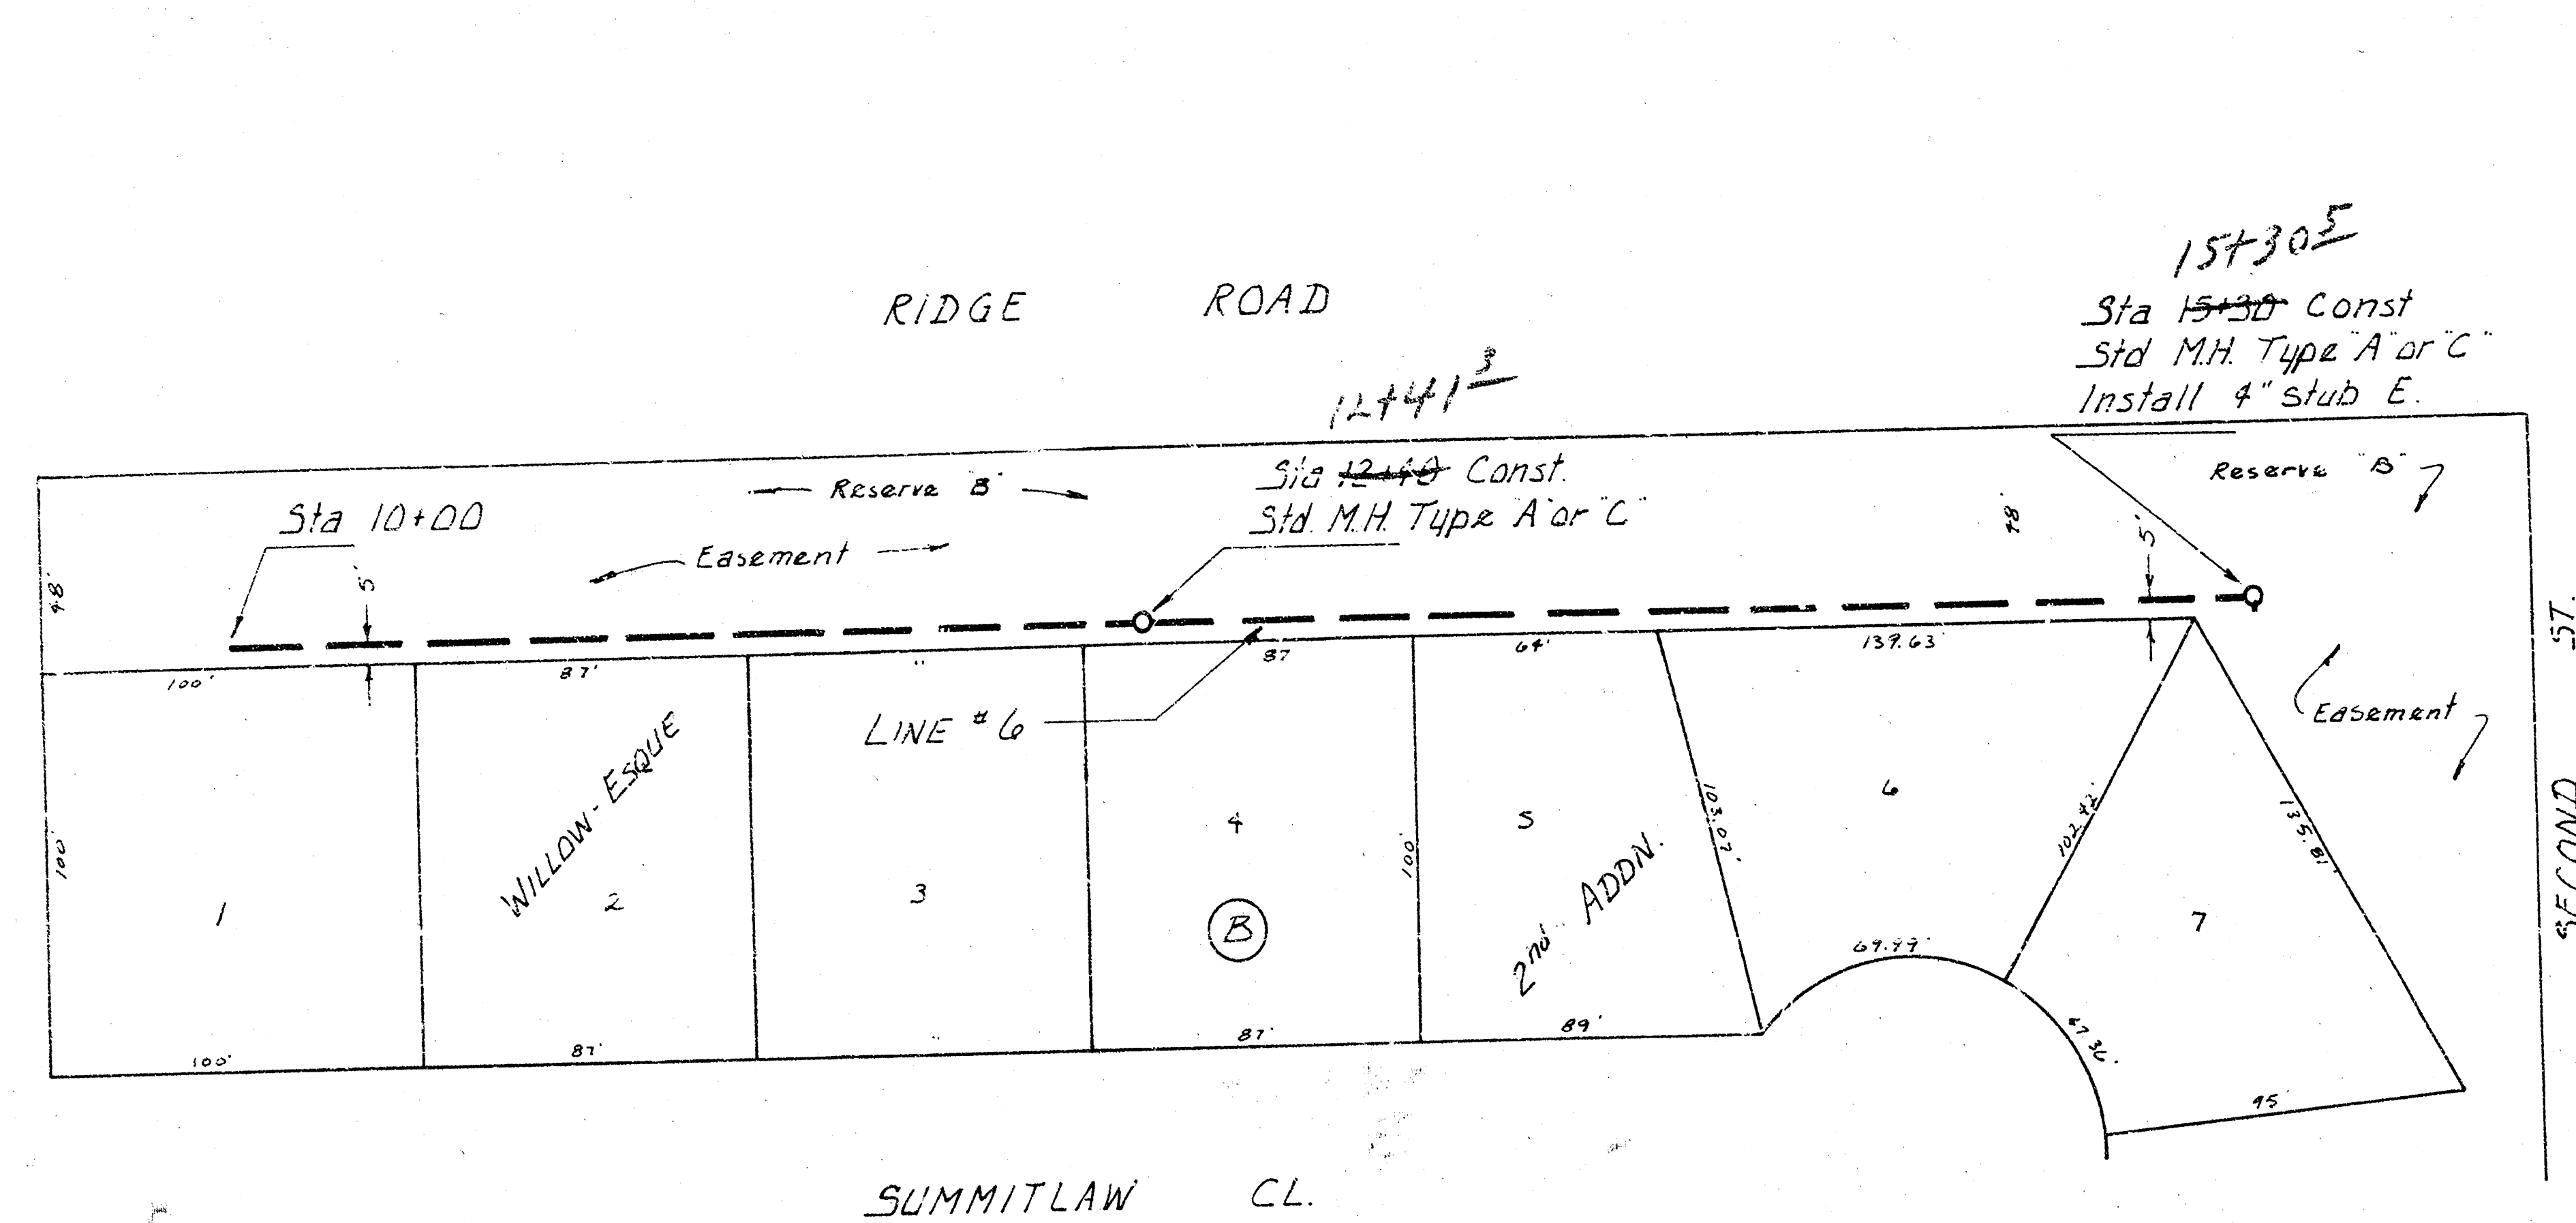

LAT. 3, MAIN 6, S. W. I.
PROJECT NO. DBKL575048

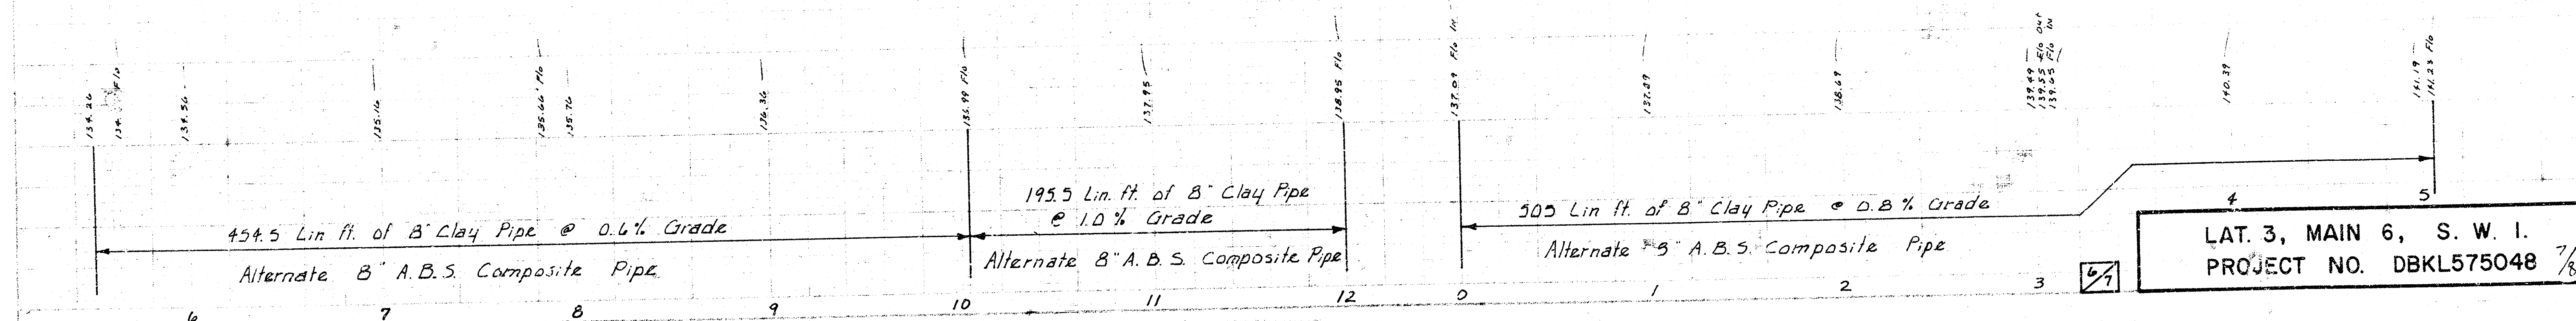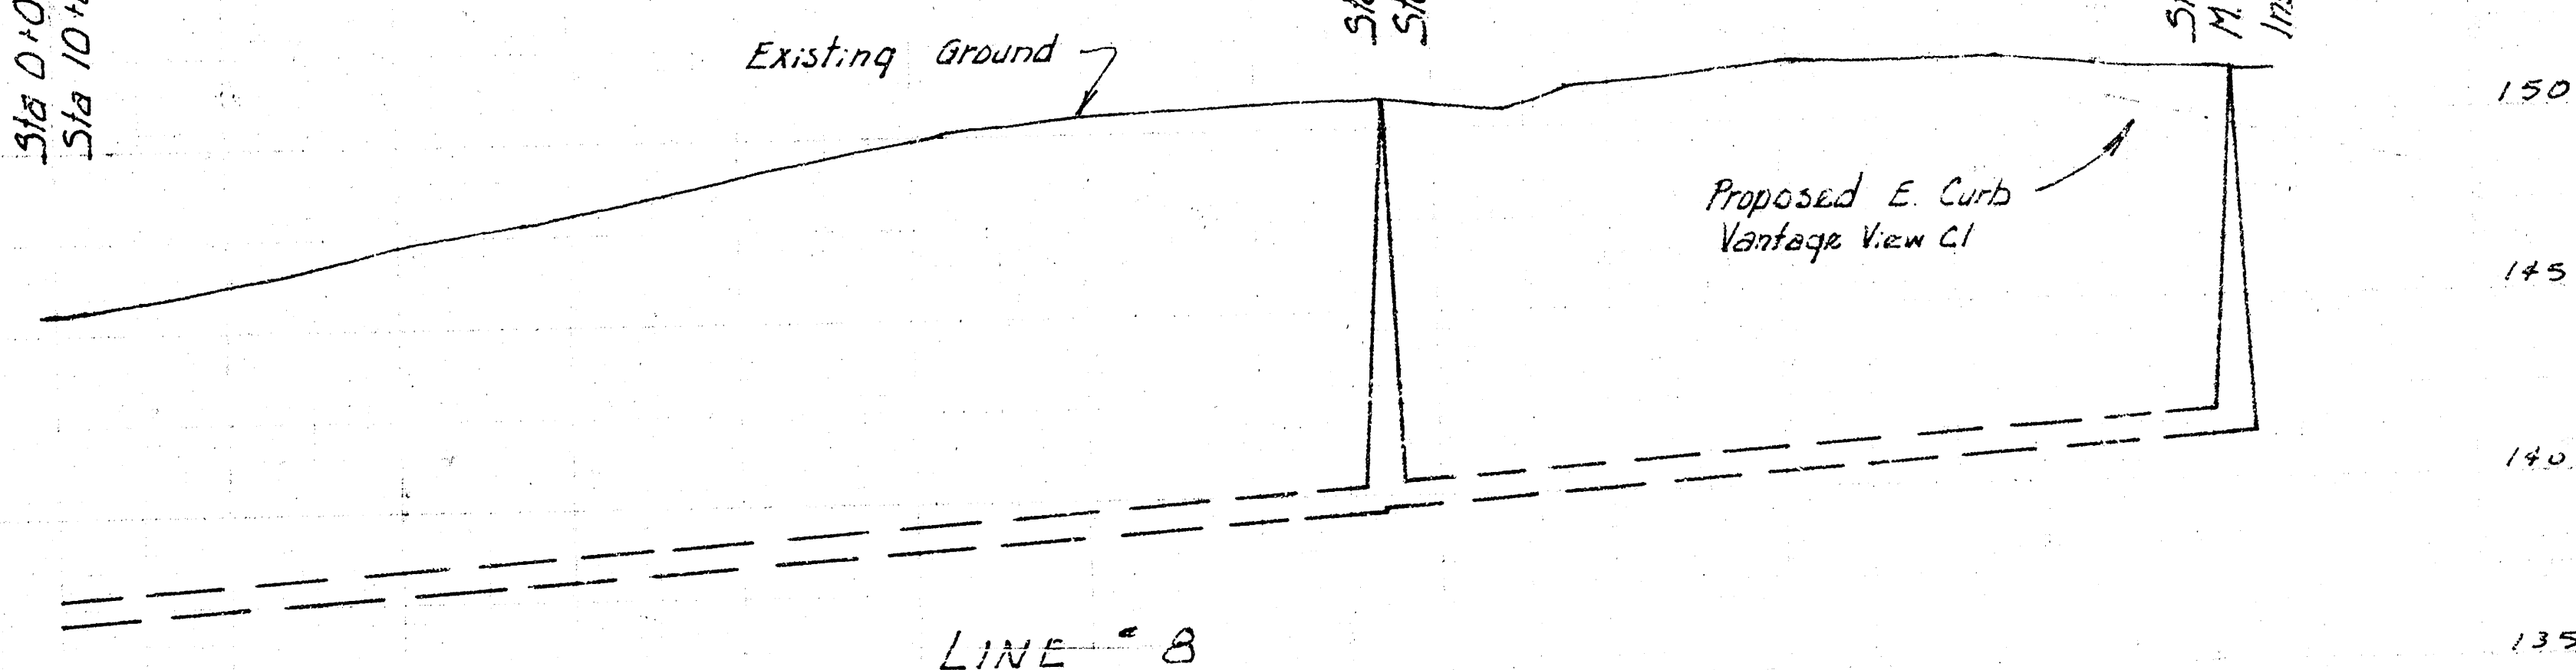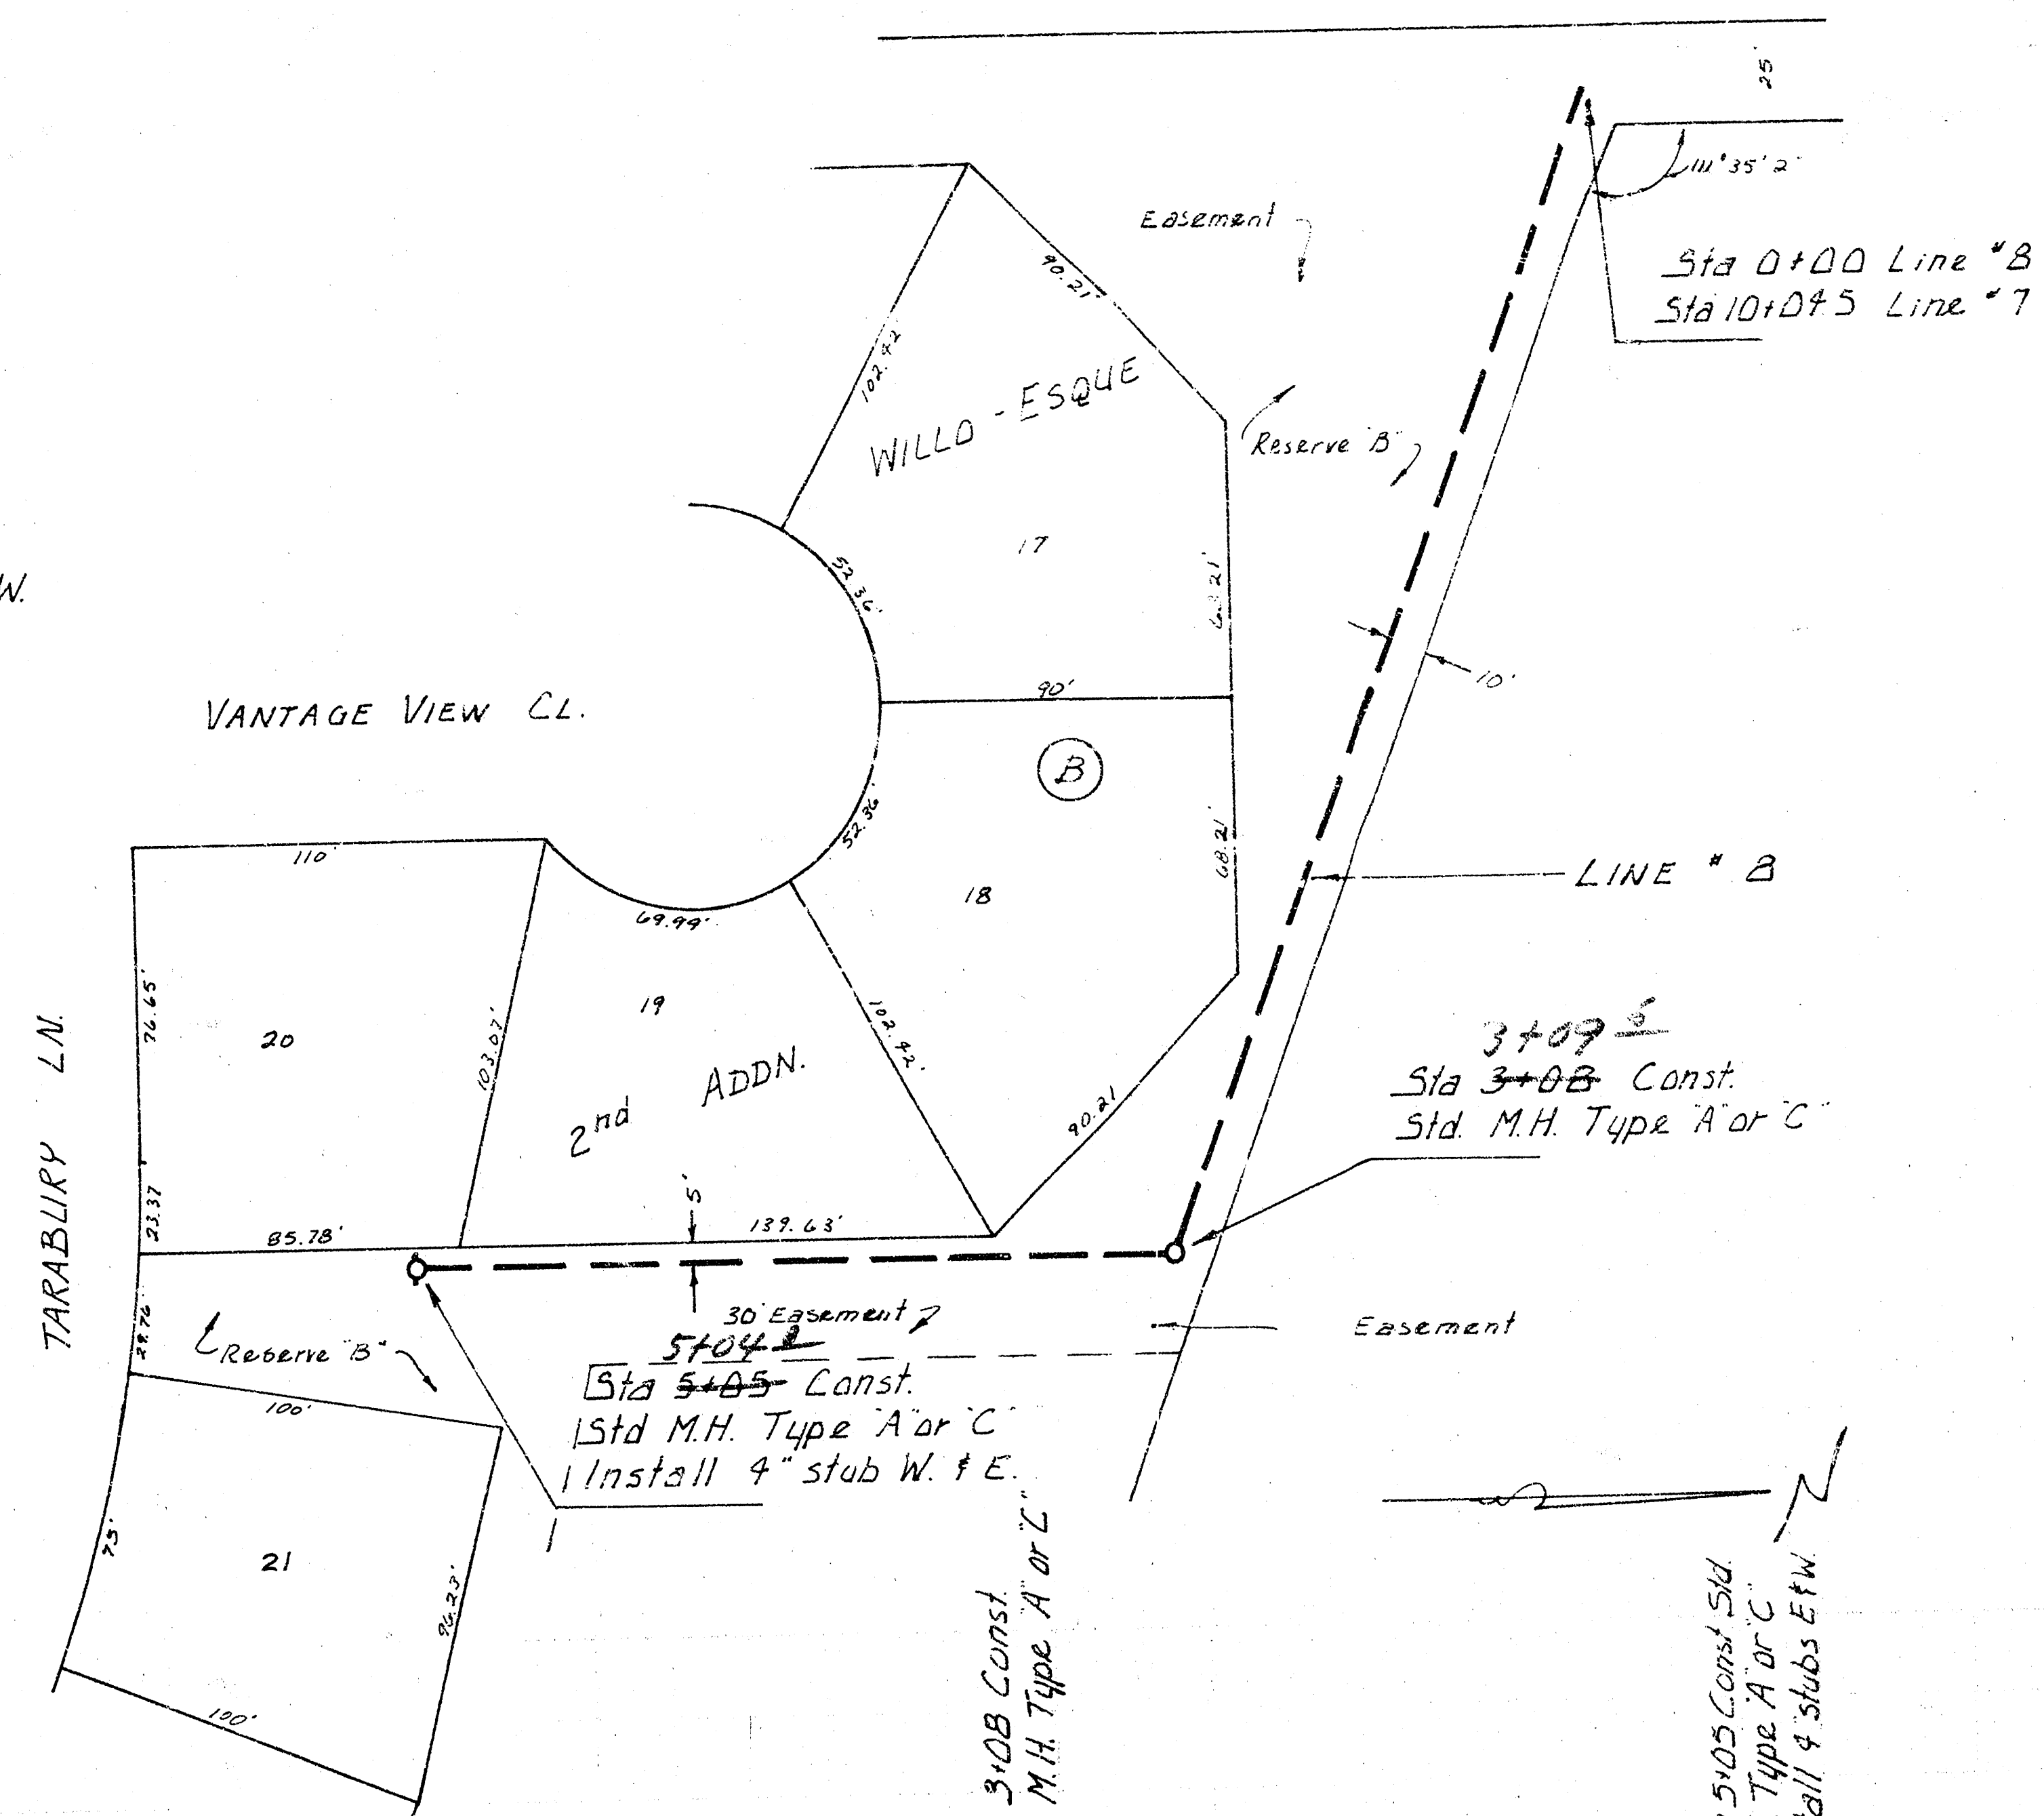

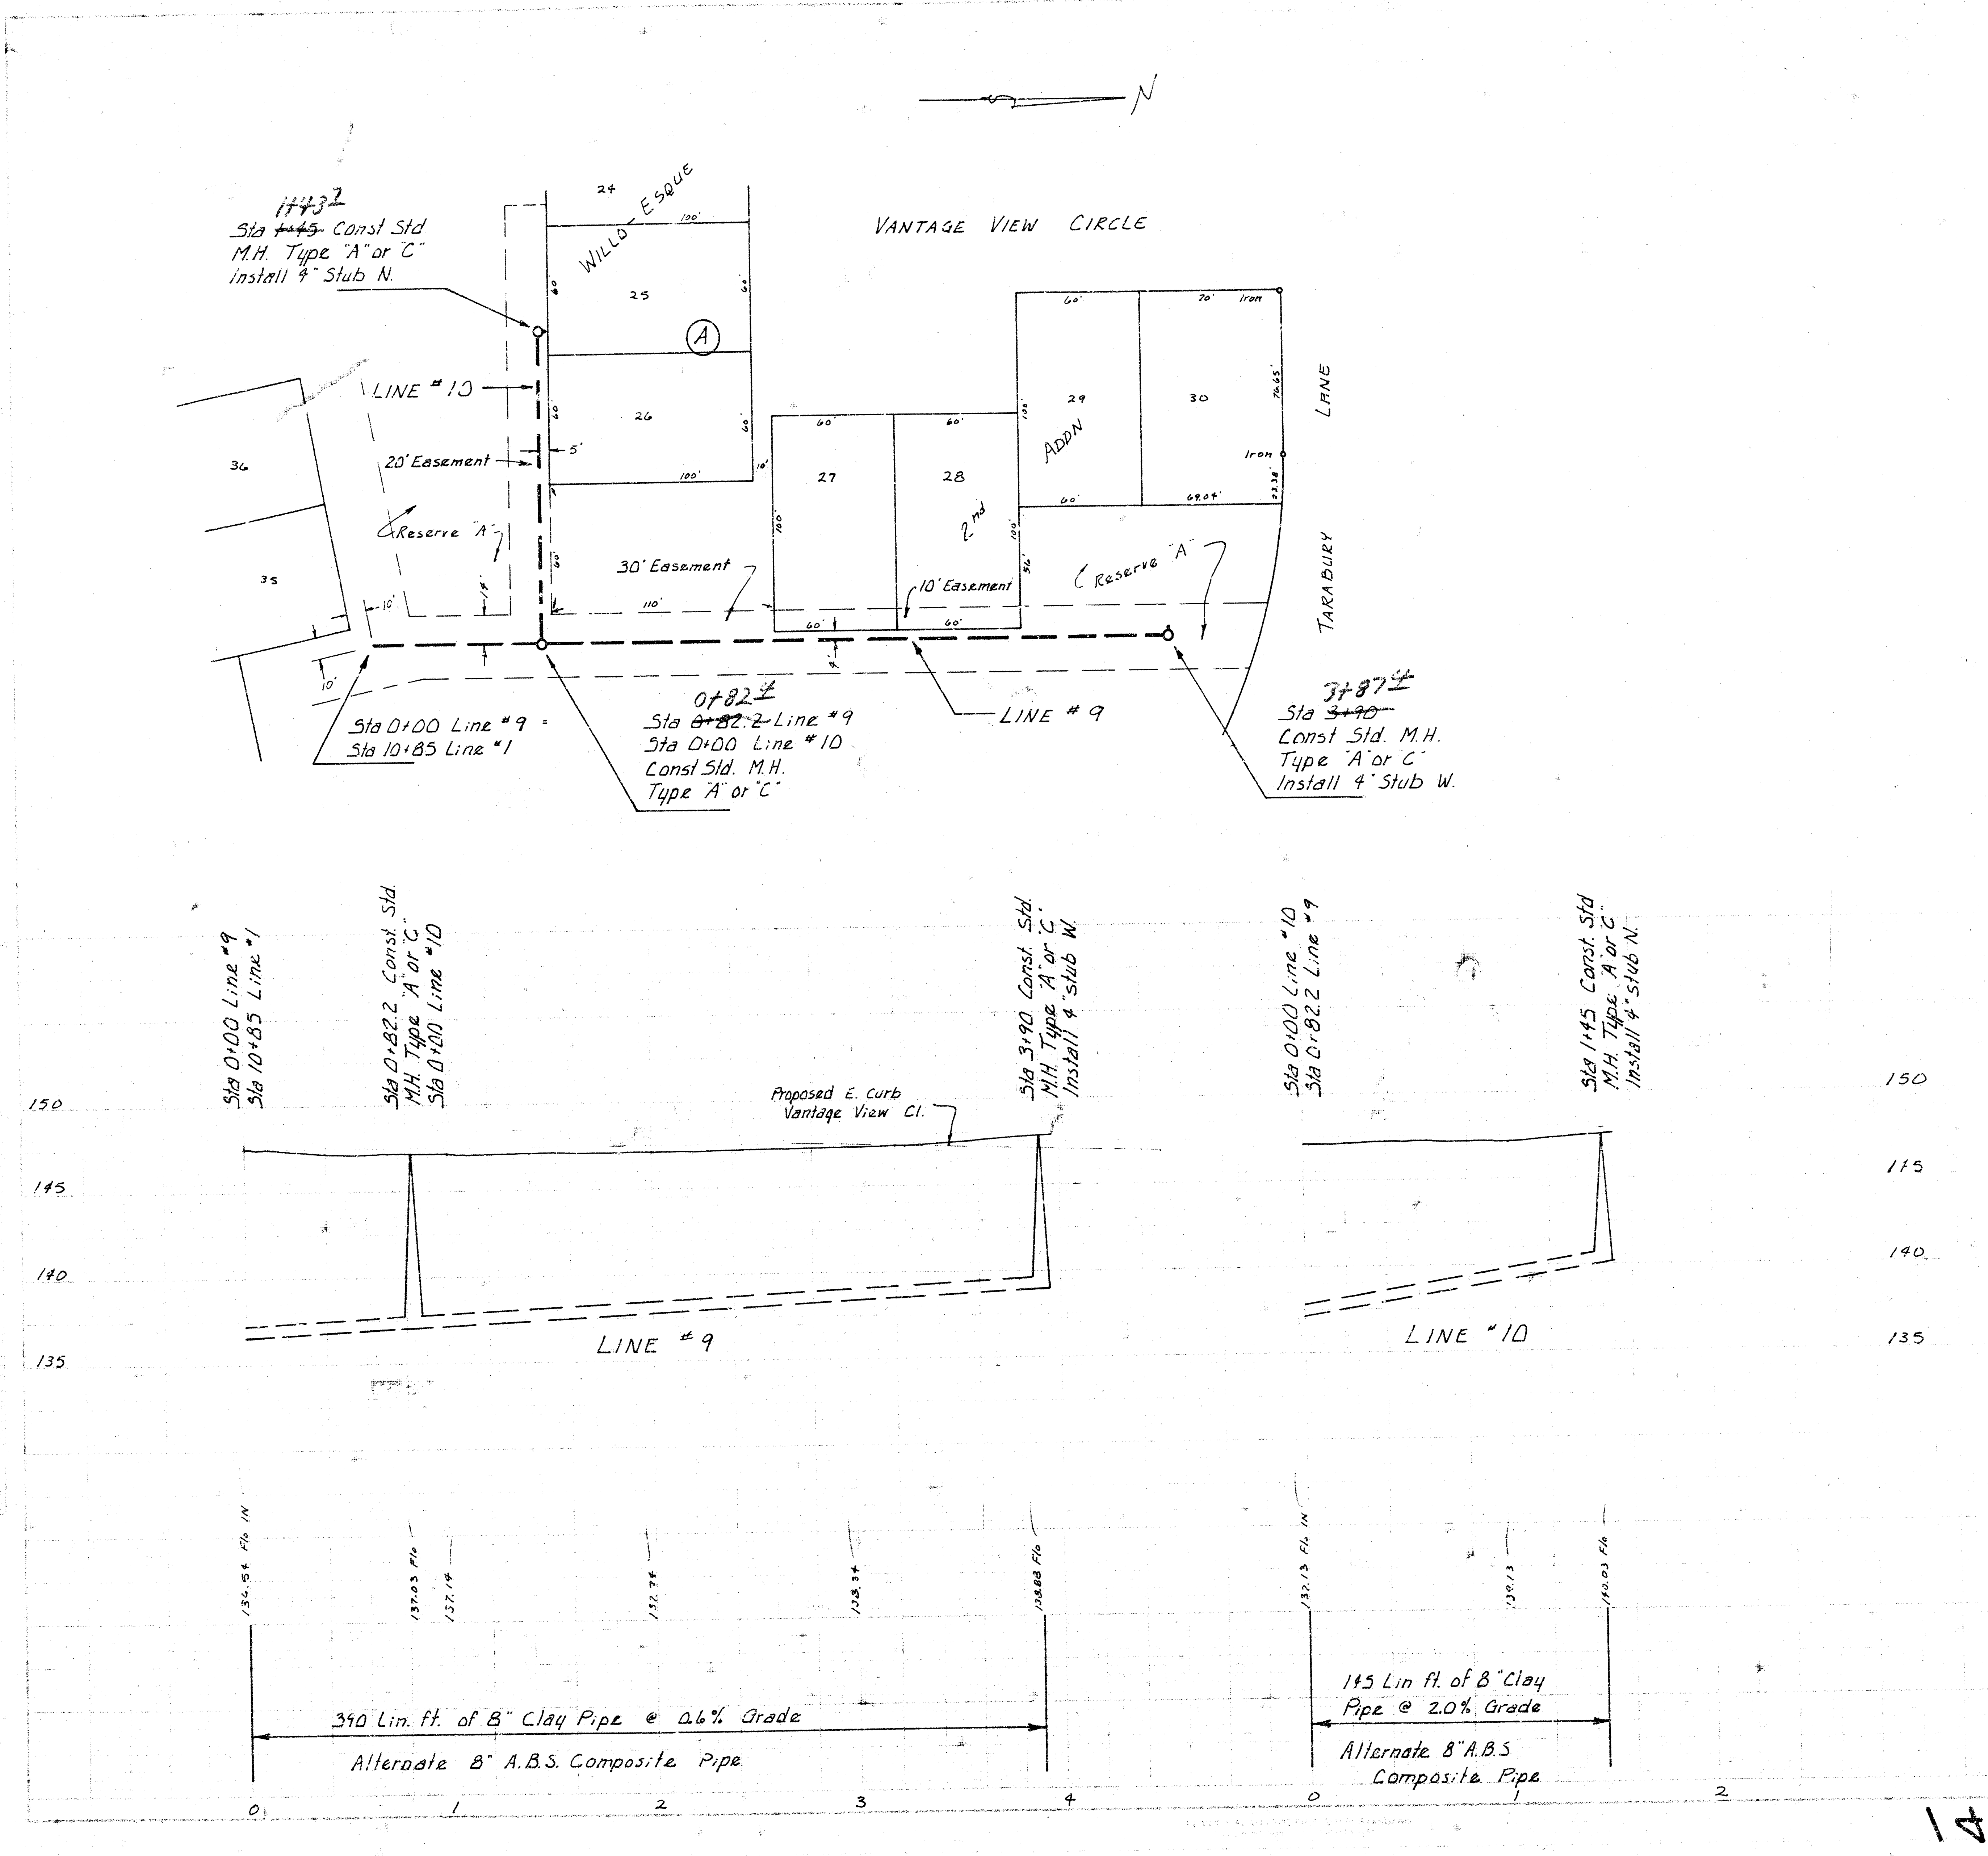

LAT. 3, MAIN 6, S.W. 1.
PROJECT NO. DBKL575048

14 8 11