

LATERAL 6, MAIN 6, SOUTHWEST INTERCEPTOR SEWER

CITY OF WICHITA, KANSAS


R. W. BRUGGEMAN: DIRECTOR OF ENGINEERING / CITY ENGINEER

PROJECT NO. 468-76-245-80892-000-000-001

INDEX

LINE 1	SHEETS 2-3
LINE 2	SHEETS 3-4
LINE 2A	SHEET 5
LINE 3	SHEET 5
LINE 4	SHEET 6

NOTE: TRENCHES SHALL NOT BE BACKFILLED ABOVE AN ELEVATION GRADE LINE ESTABLISHED AS 0.4' OF A FOOT BELOW THE TOP OF MANHOLE ELEVATIONS SHOWN ON THE PLANS.

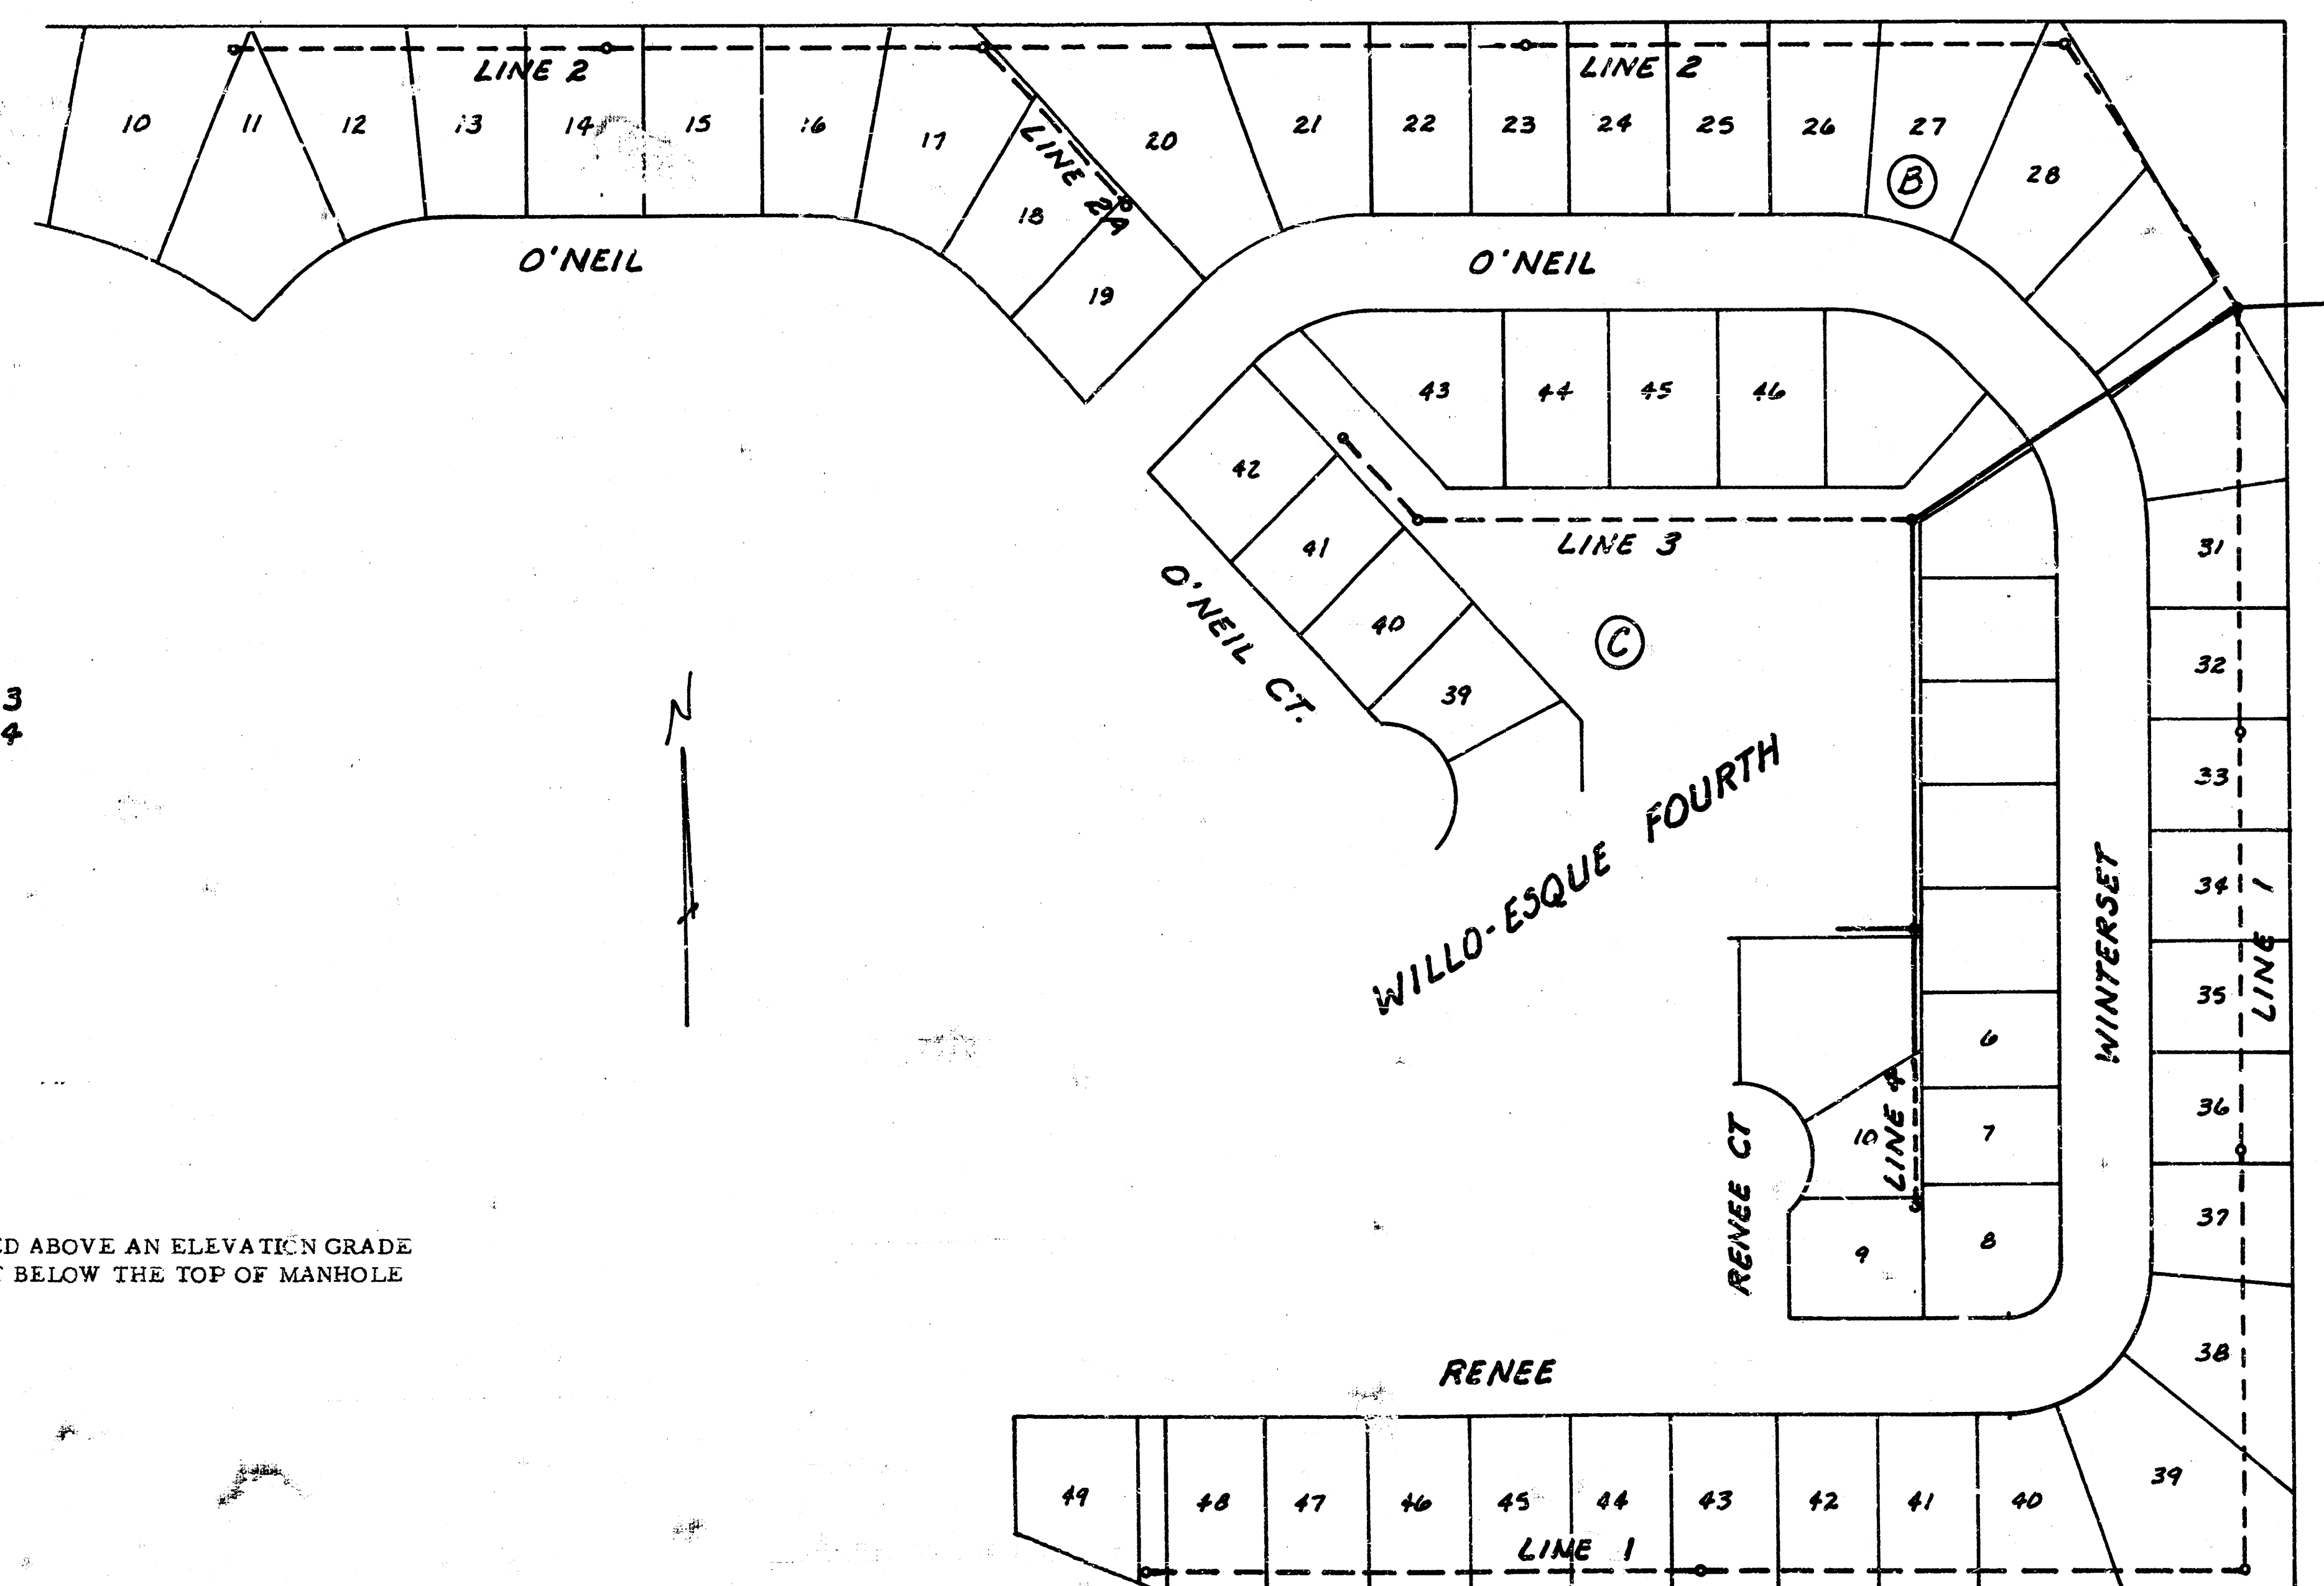


As Built
9.8.83
J.L.L.



R. BULLER

DCD-217


SCALE PLAN 1"=40' HORIZ. PROFILE 1"=5' VERT.

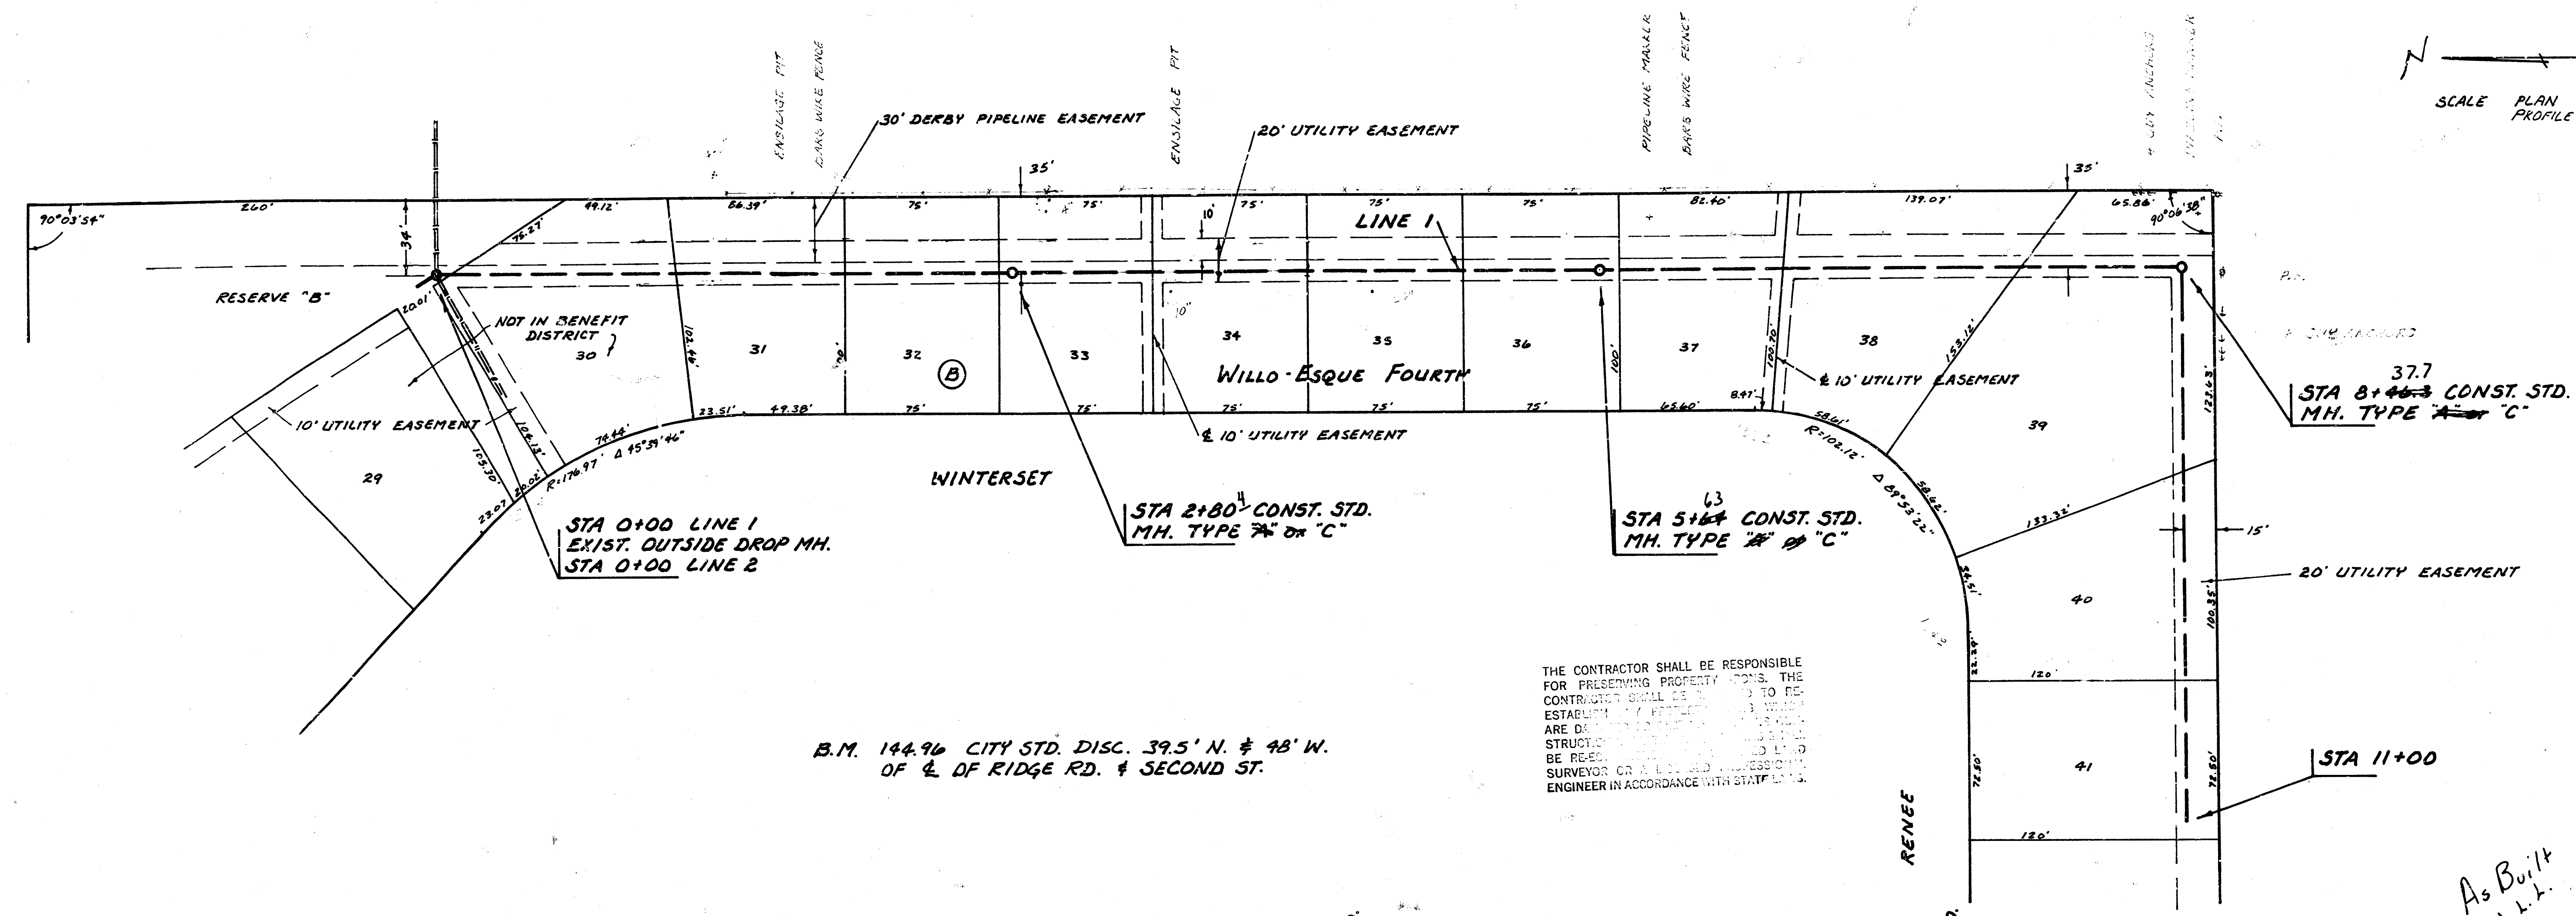


B.M. 144.96 CITY STD. DISC. 39.5' N. & 48' W. OF E. OF RIDGE RD. & SECOND ST.

THE CONTRACTOR SHALL BE RESPONSIBLE FOR PRESERVING PROPERTY LINES. THE CONTRACTOR SHALL BE RESPONSIBLE FOR ESTABLISHING PROPERTY LINES. THE CONTRACTOR SHALL BE RESPONSIBLE FOR ESTABLISHING PROPERTY LINES. THE CONTRACTOR SHALL BE RESPONSIBLE FOR ESTABLISHING PROPERTY LINES.

As Built J.L.L. 9-82

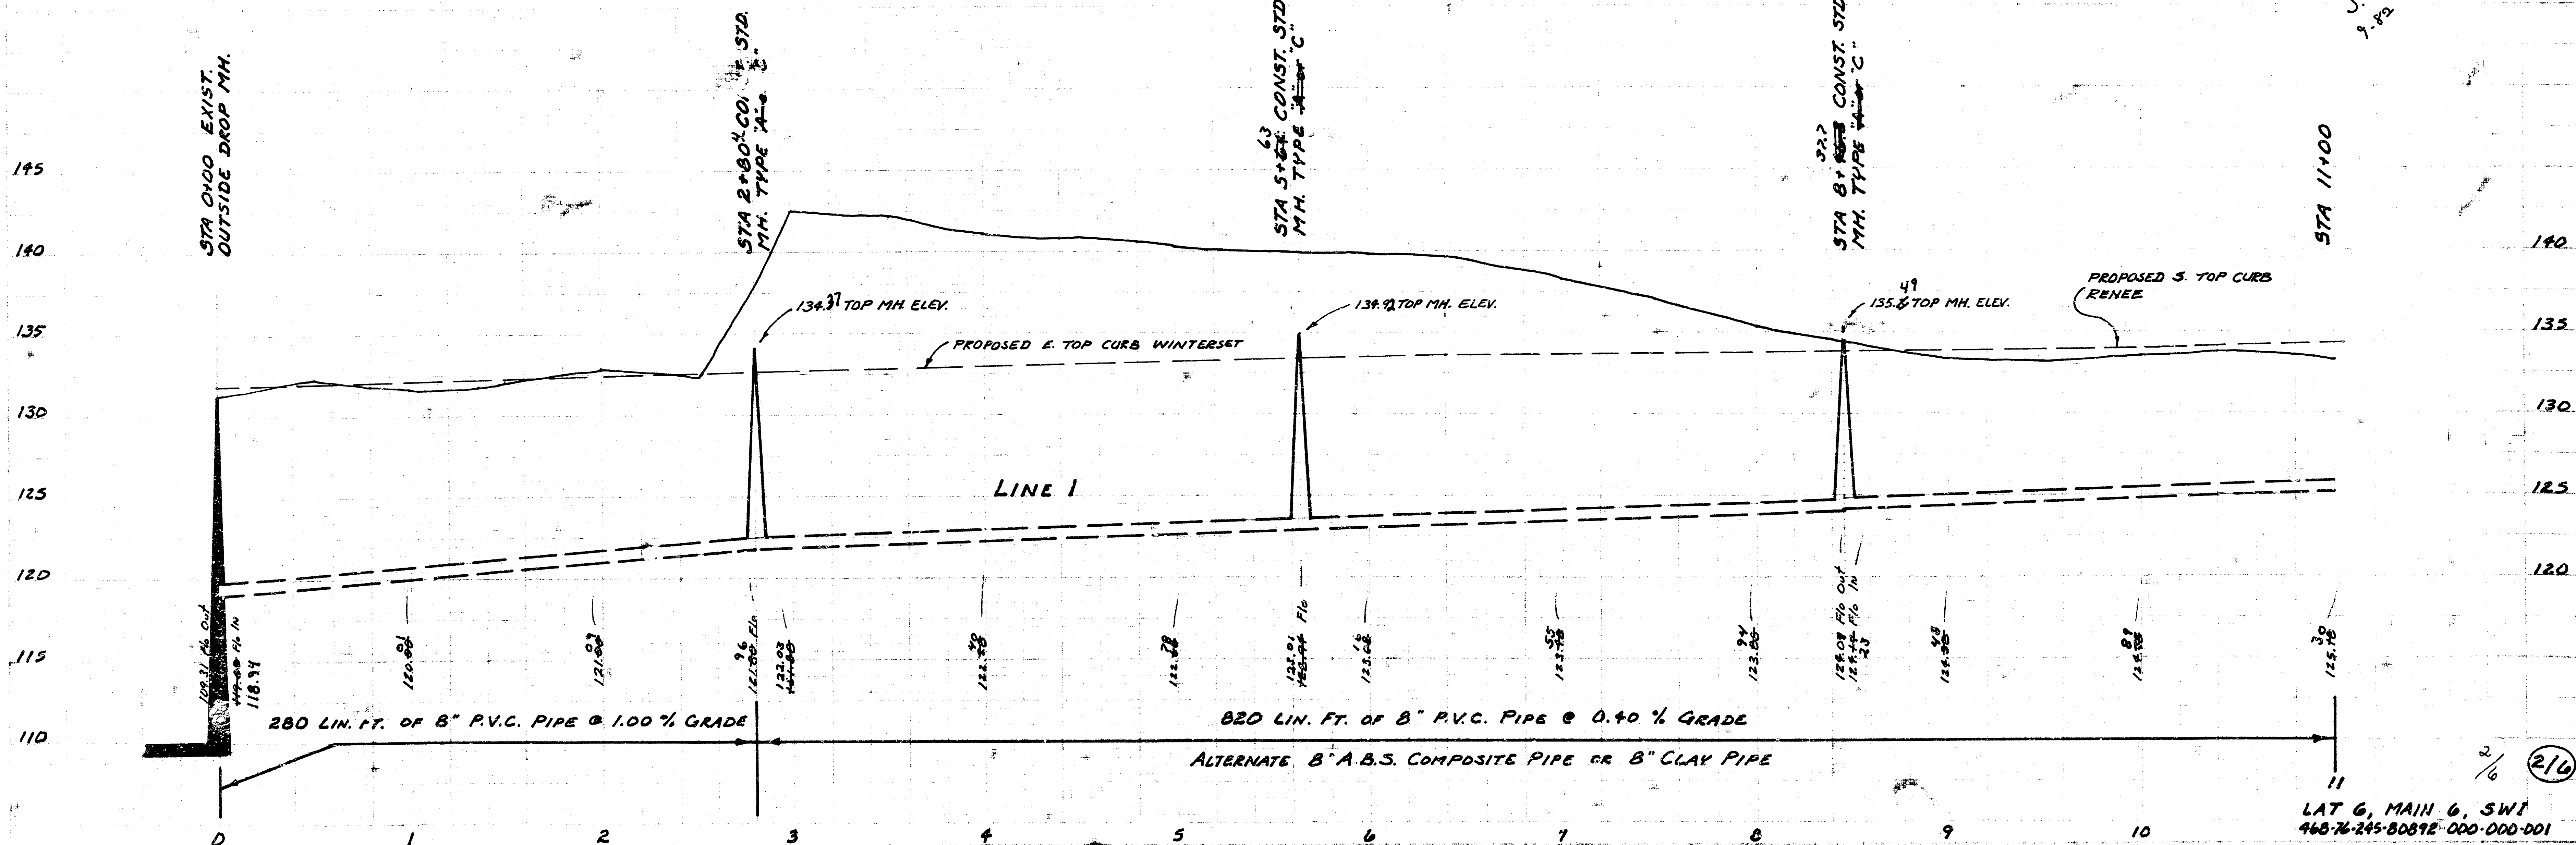


LAT 6, MAIN 6, SW1 468-76-245-80872-000-000-001


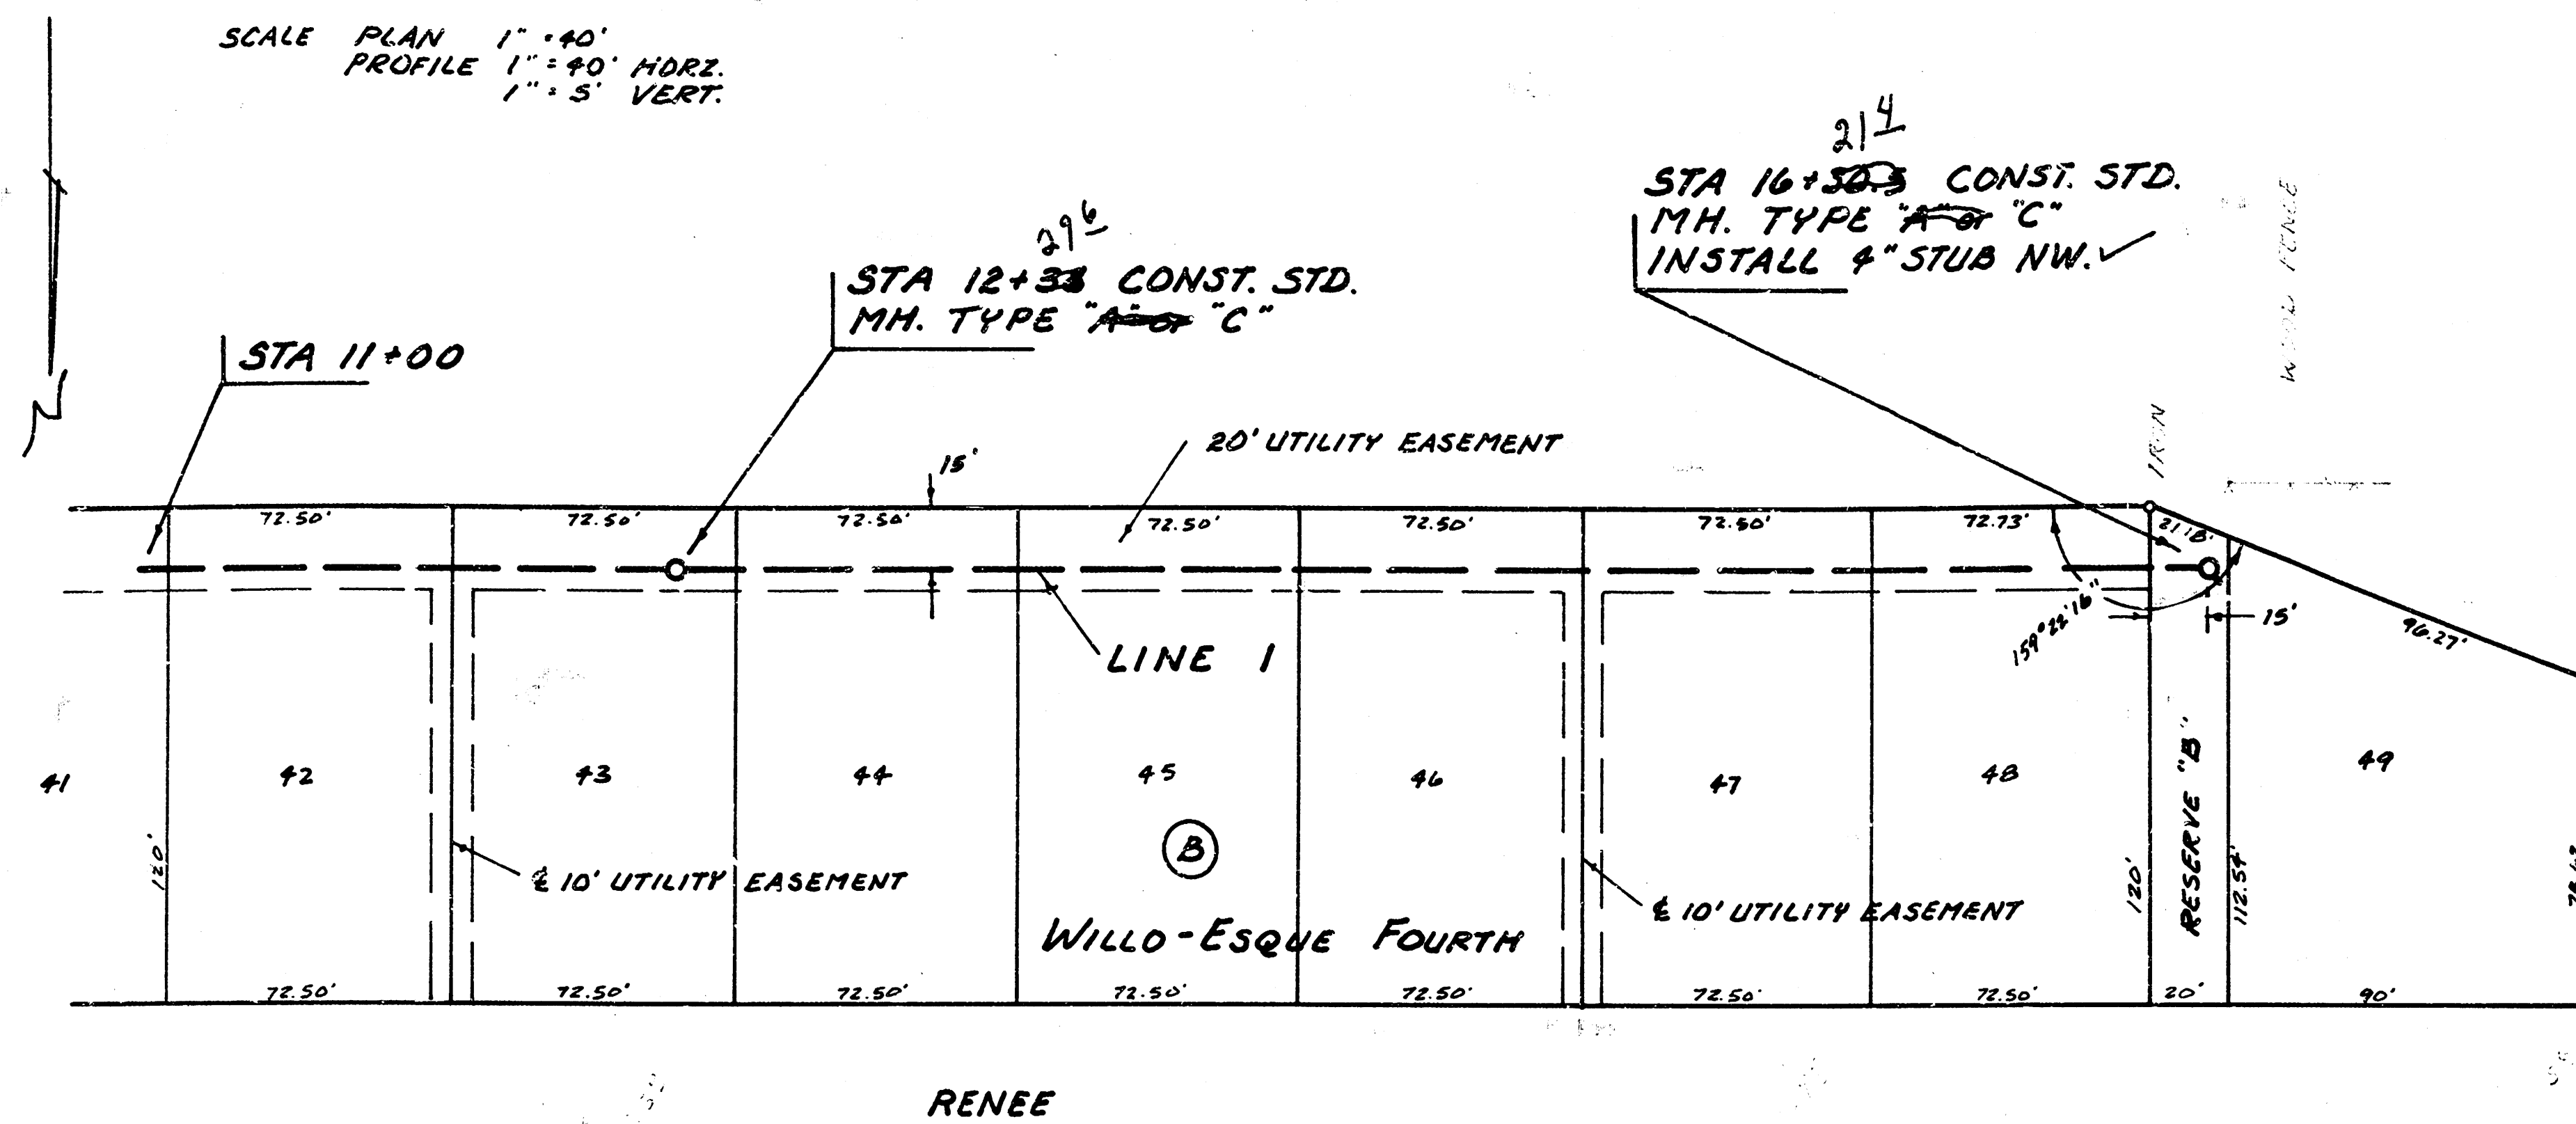


NOTE: COMPACTED FILL IN THE AREA OF MANHOLE LOCATION AT STA. 2+19.6 ON LINE NO. 2, SHALL BE CONSTRUCTED USING EXCESS TRENCH EXCAVATED MATERIAL COMPACTED TO A DENSITY OF 90% OF STANDARD DENSITY. THIS WORK SHALL BE CONSIDERED AS SUBSIDIARY TO THE OTHER PAY ITEMS.

WILLO-ESQUE DR.


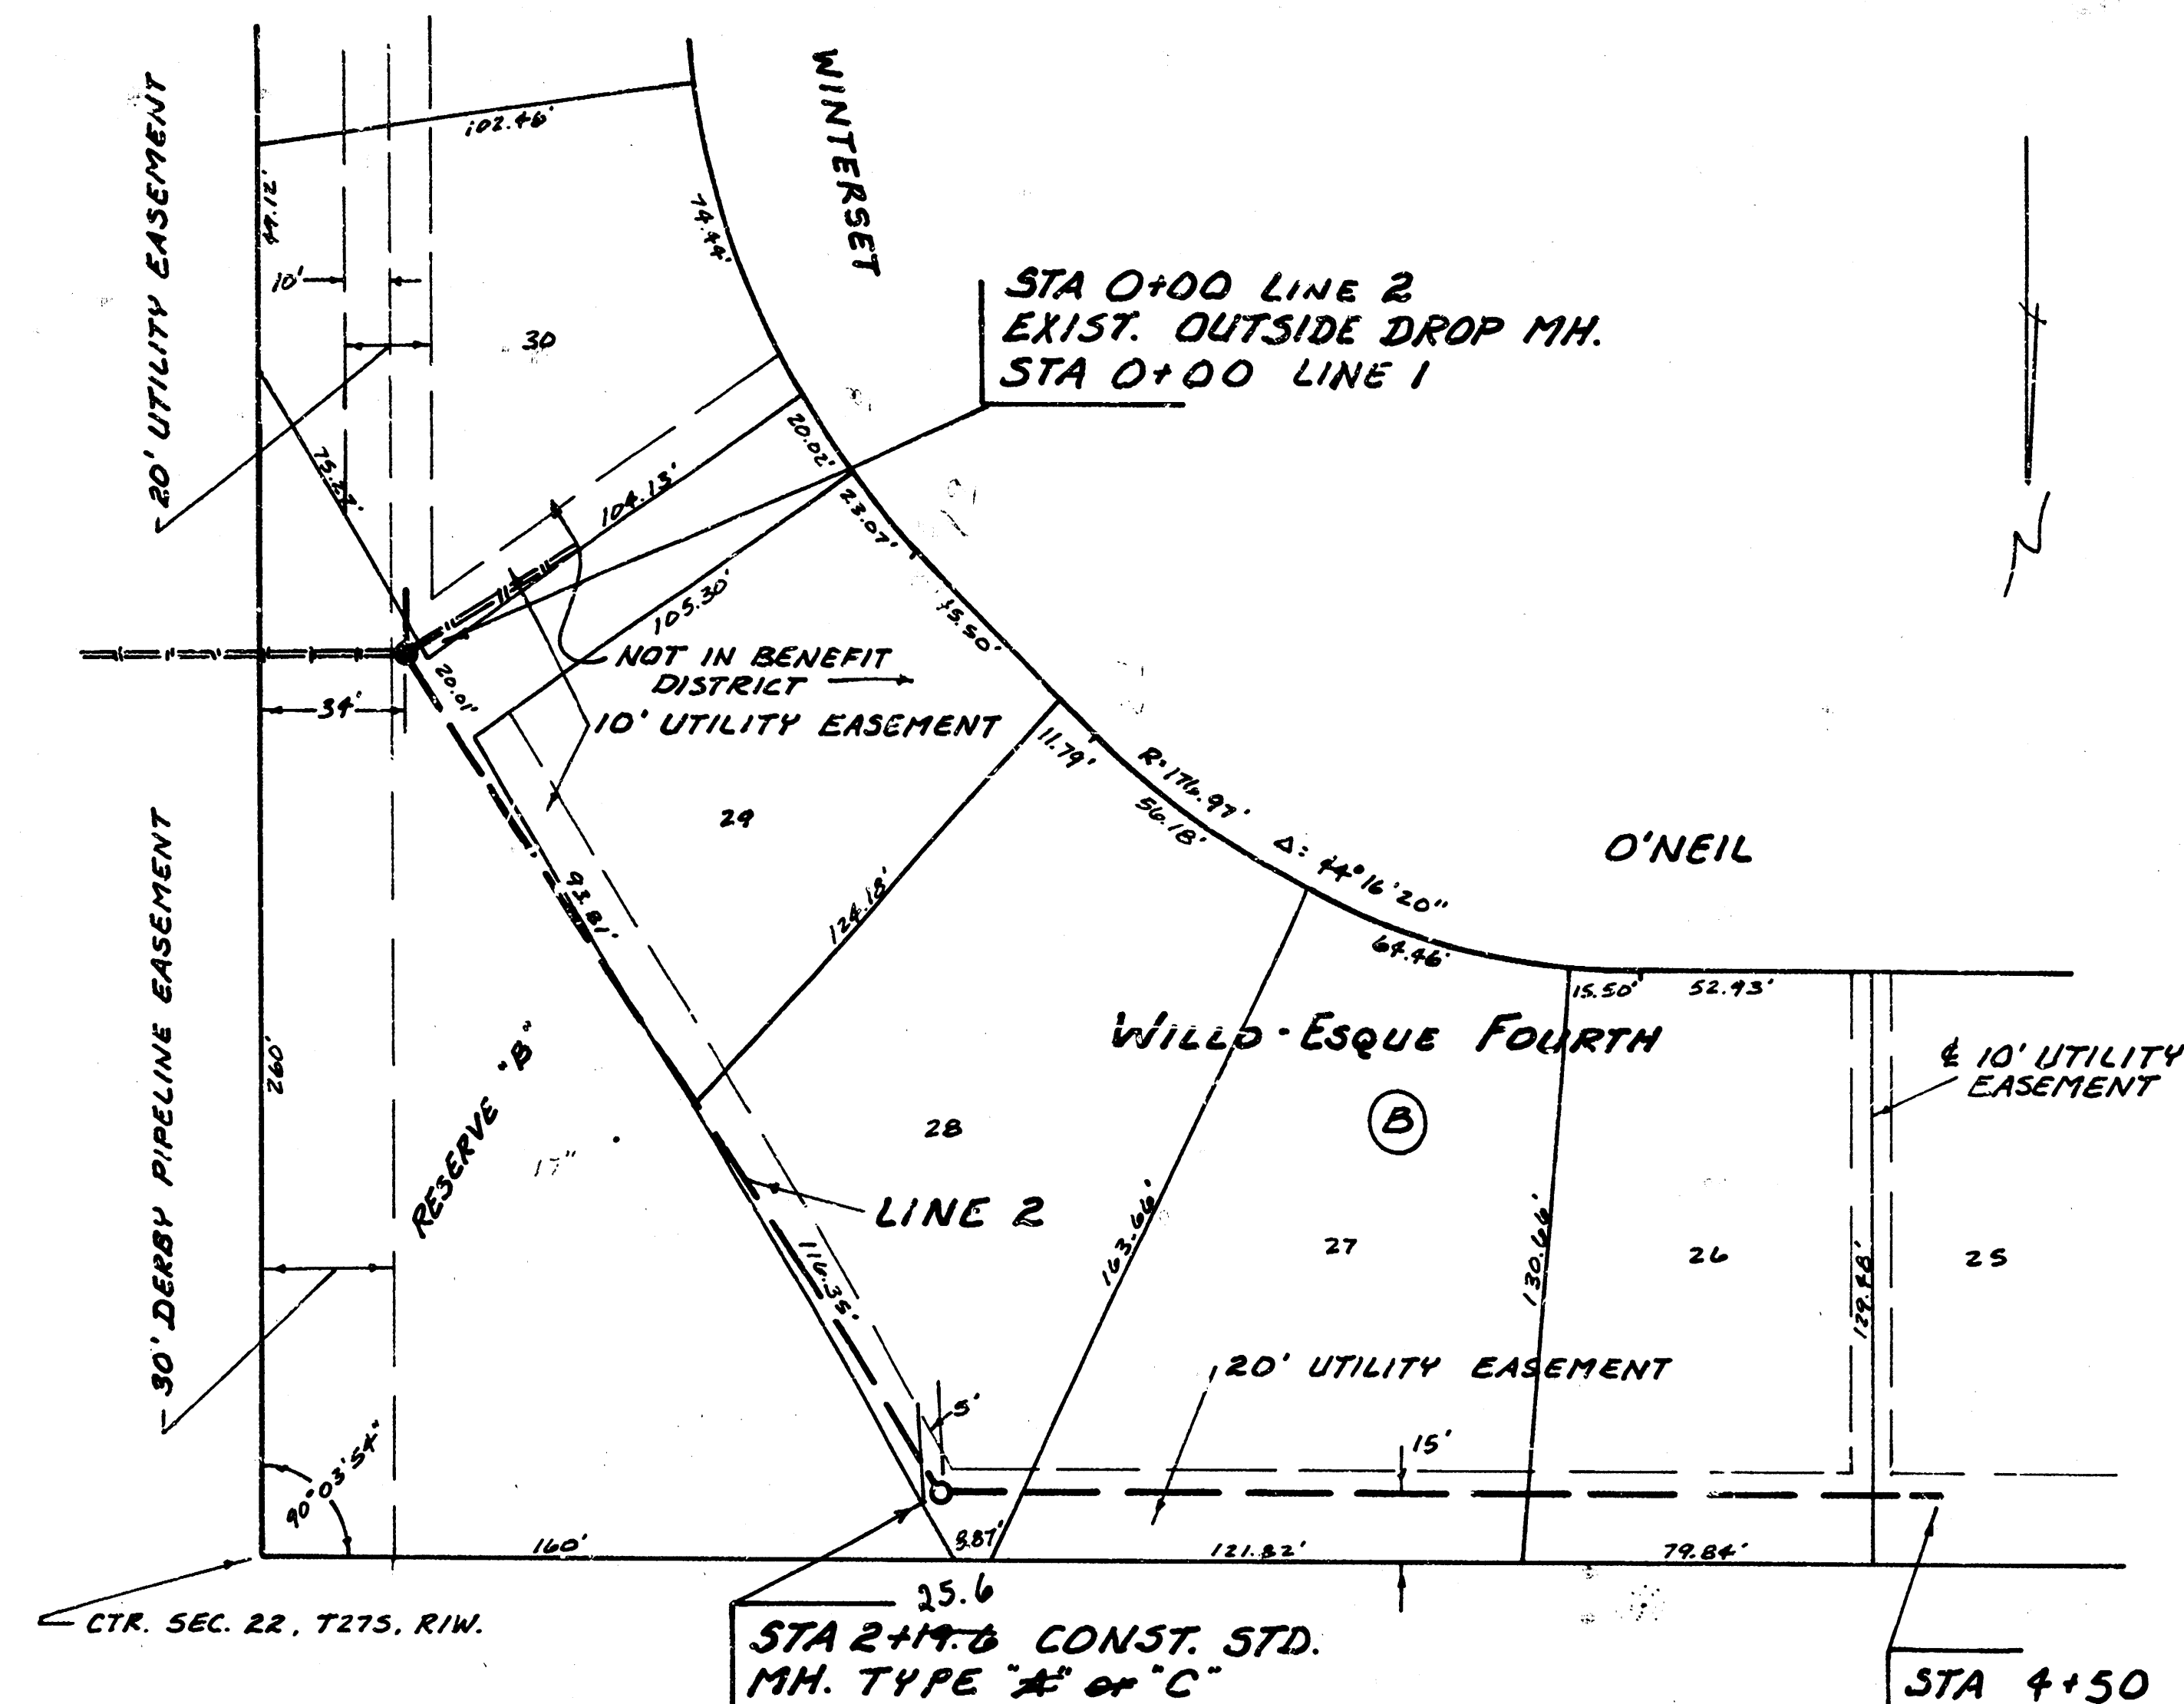


As Built
J.L.L.
9-82

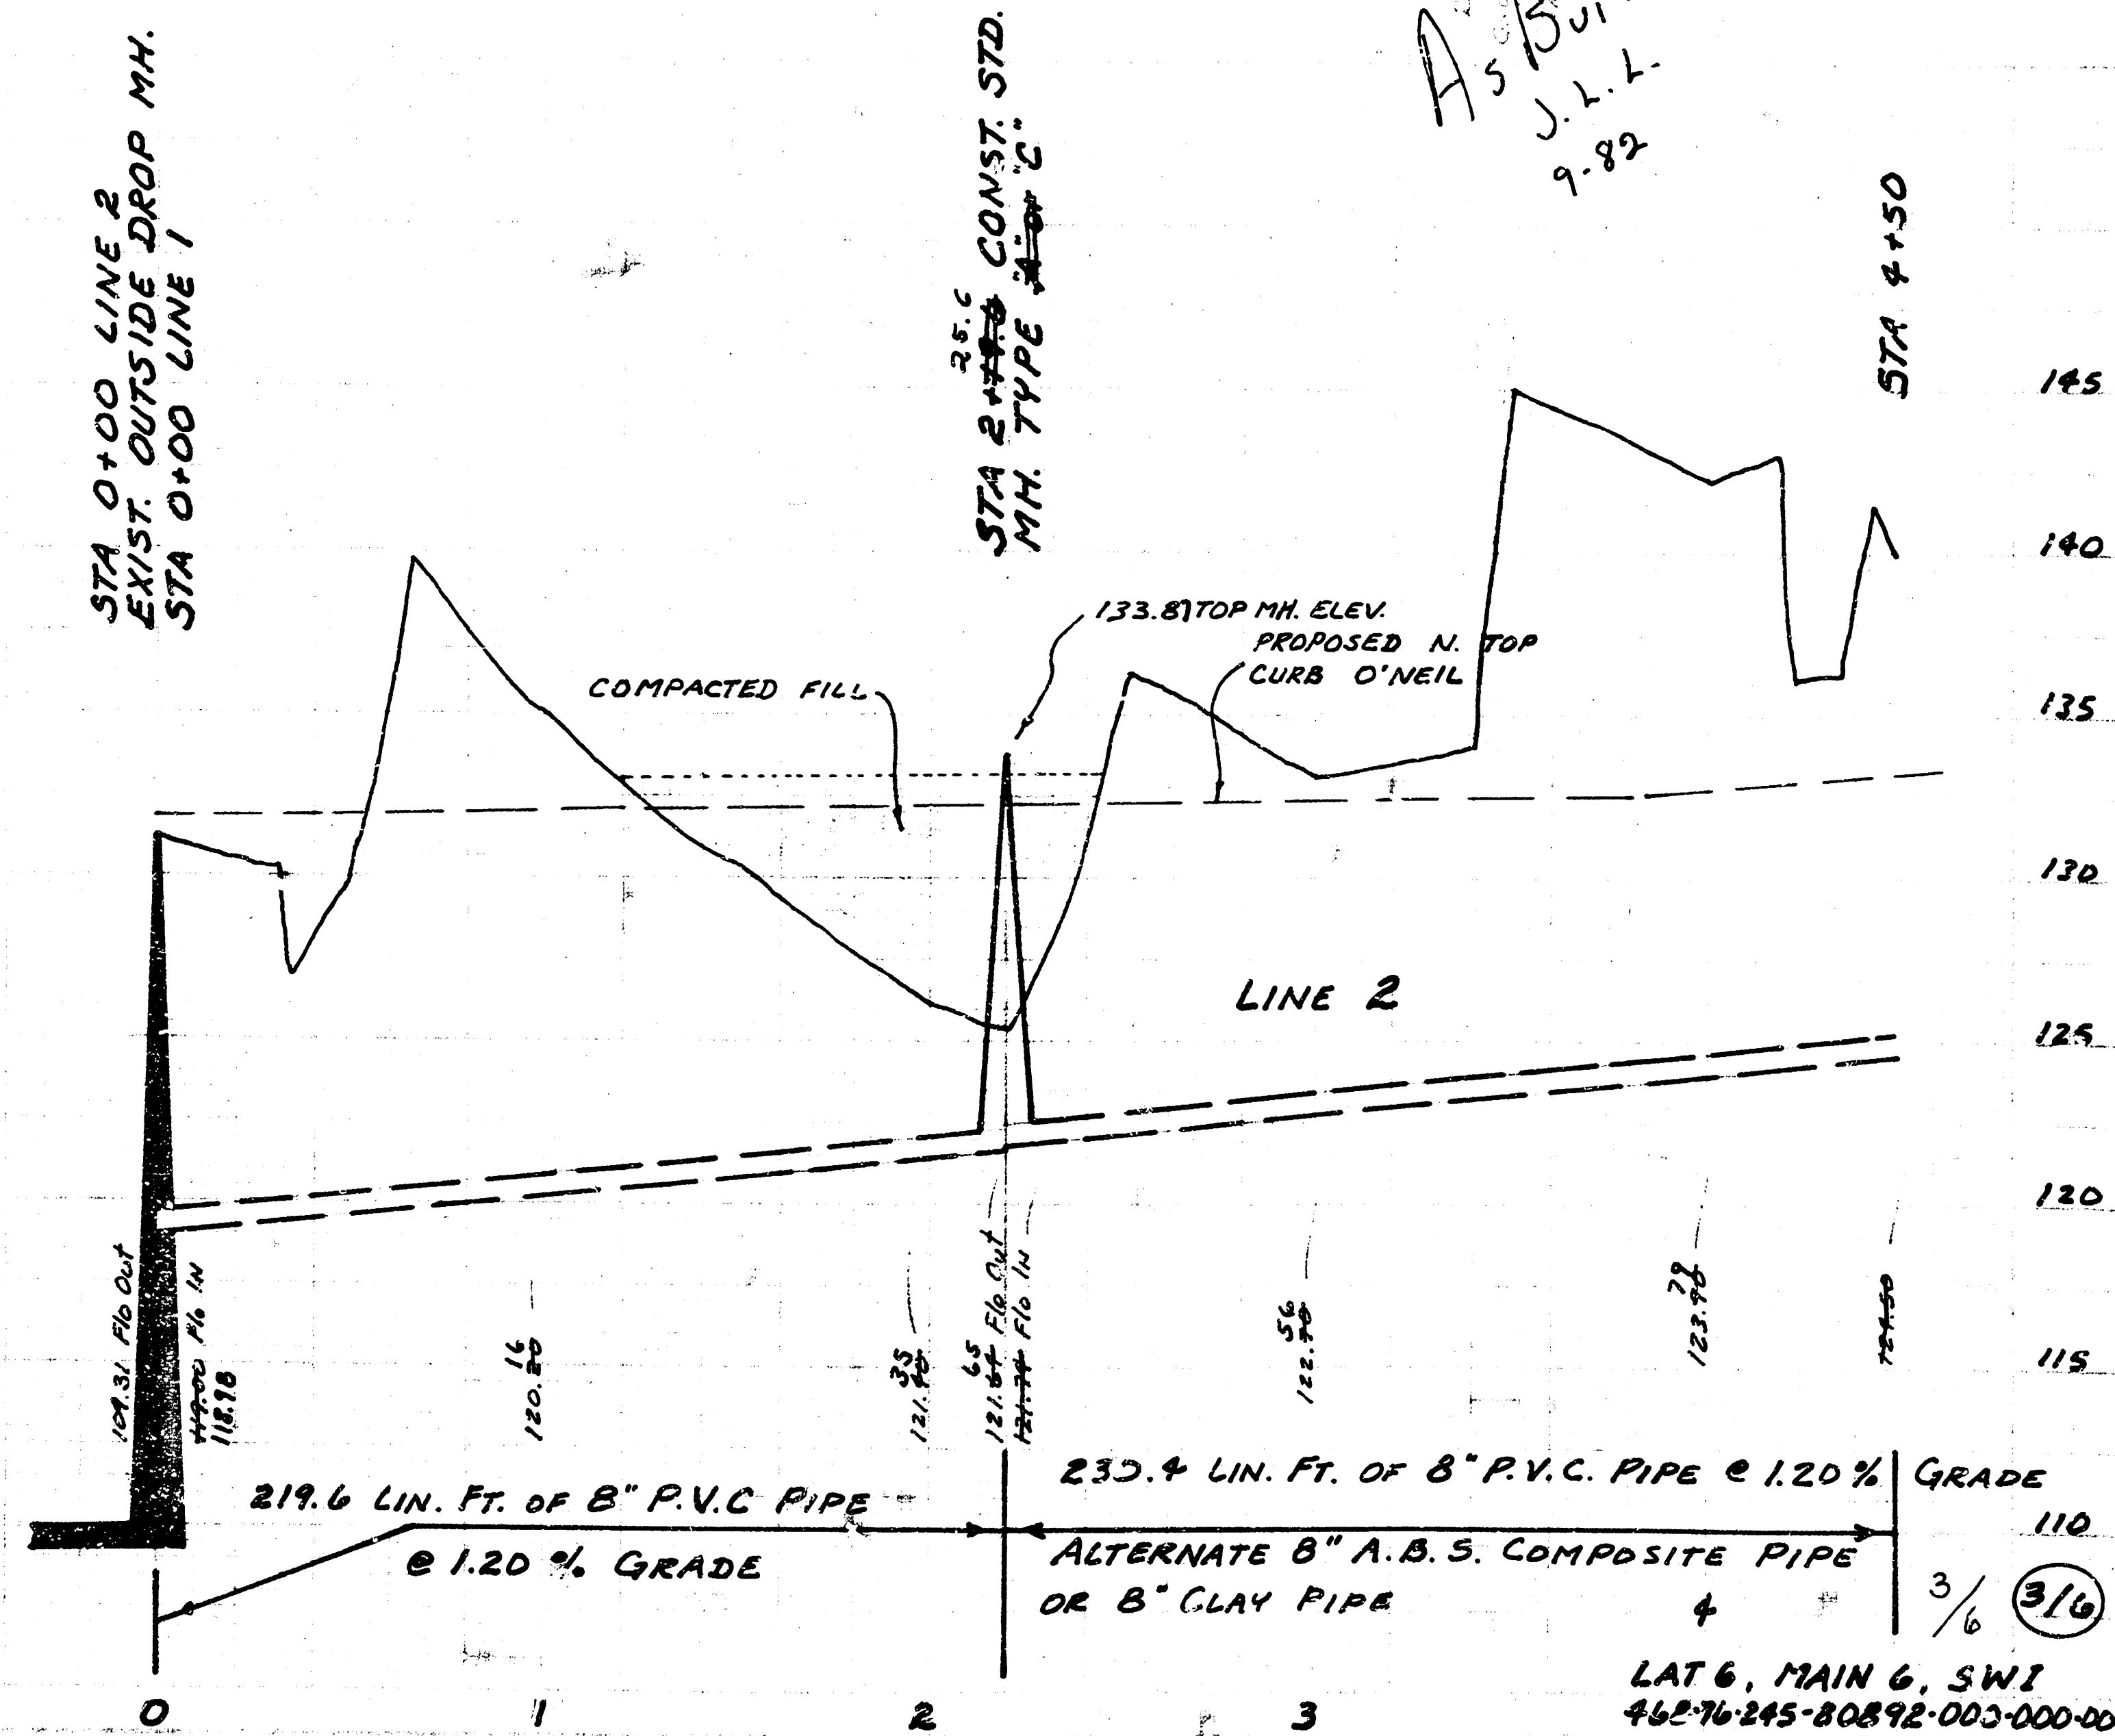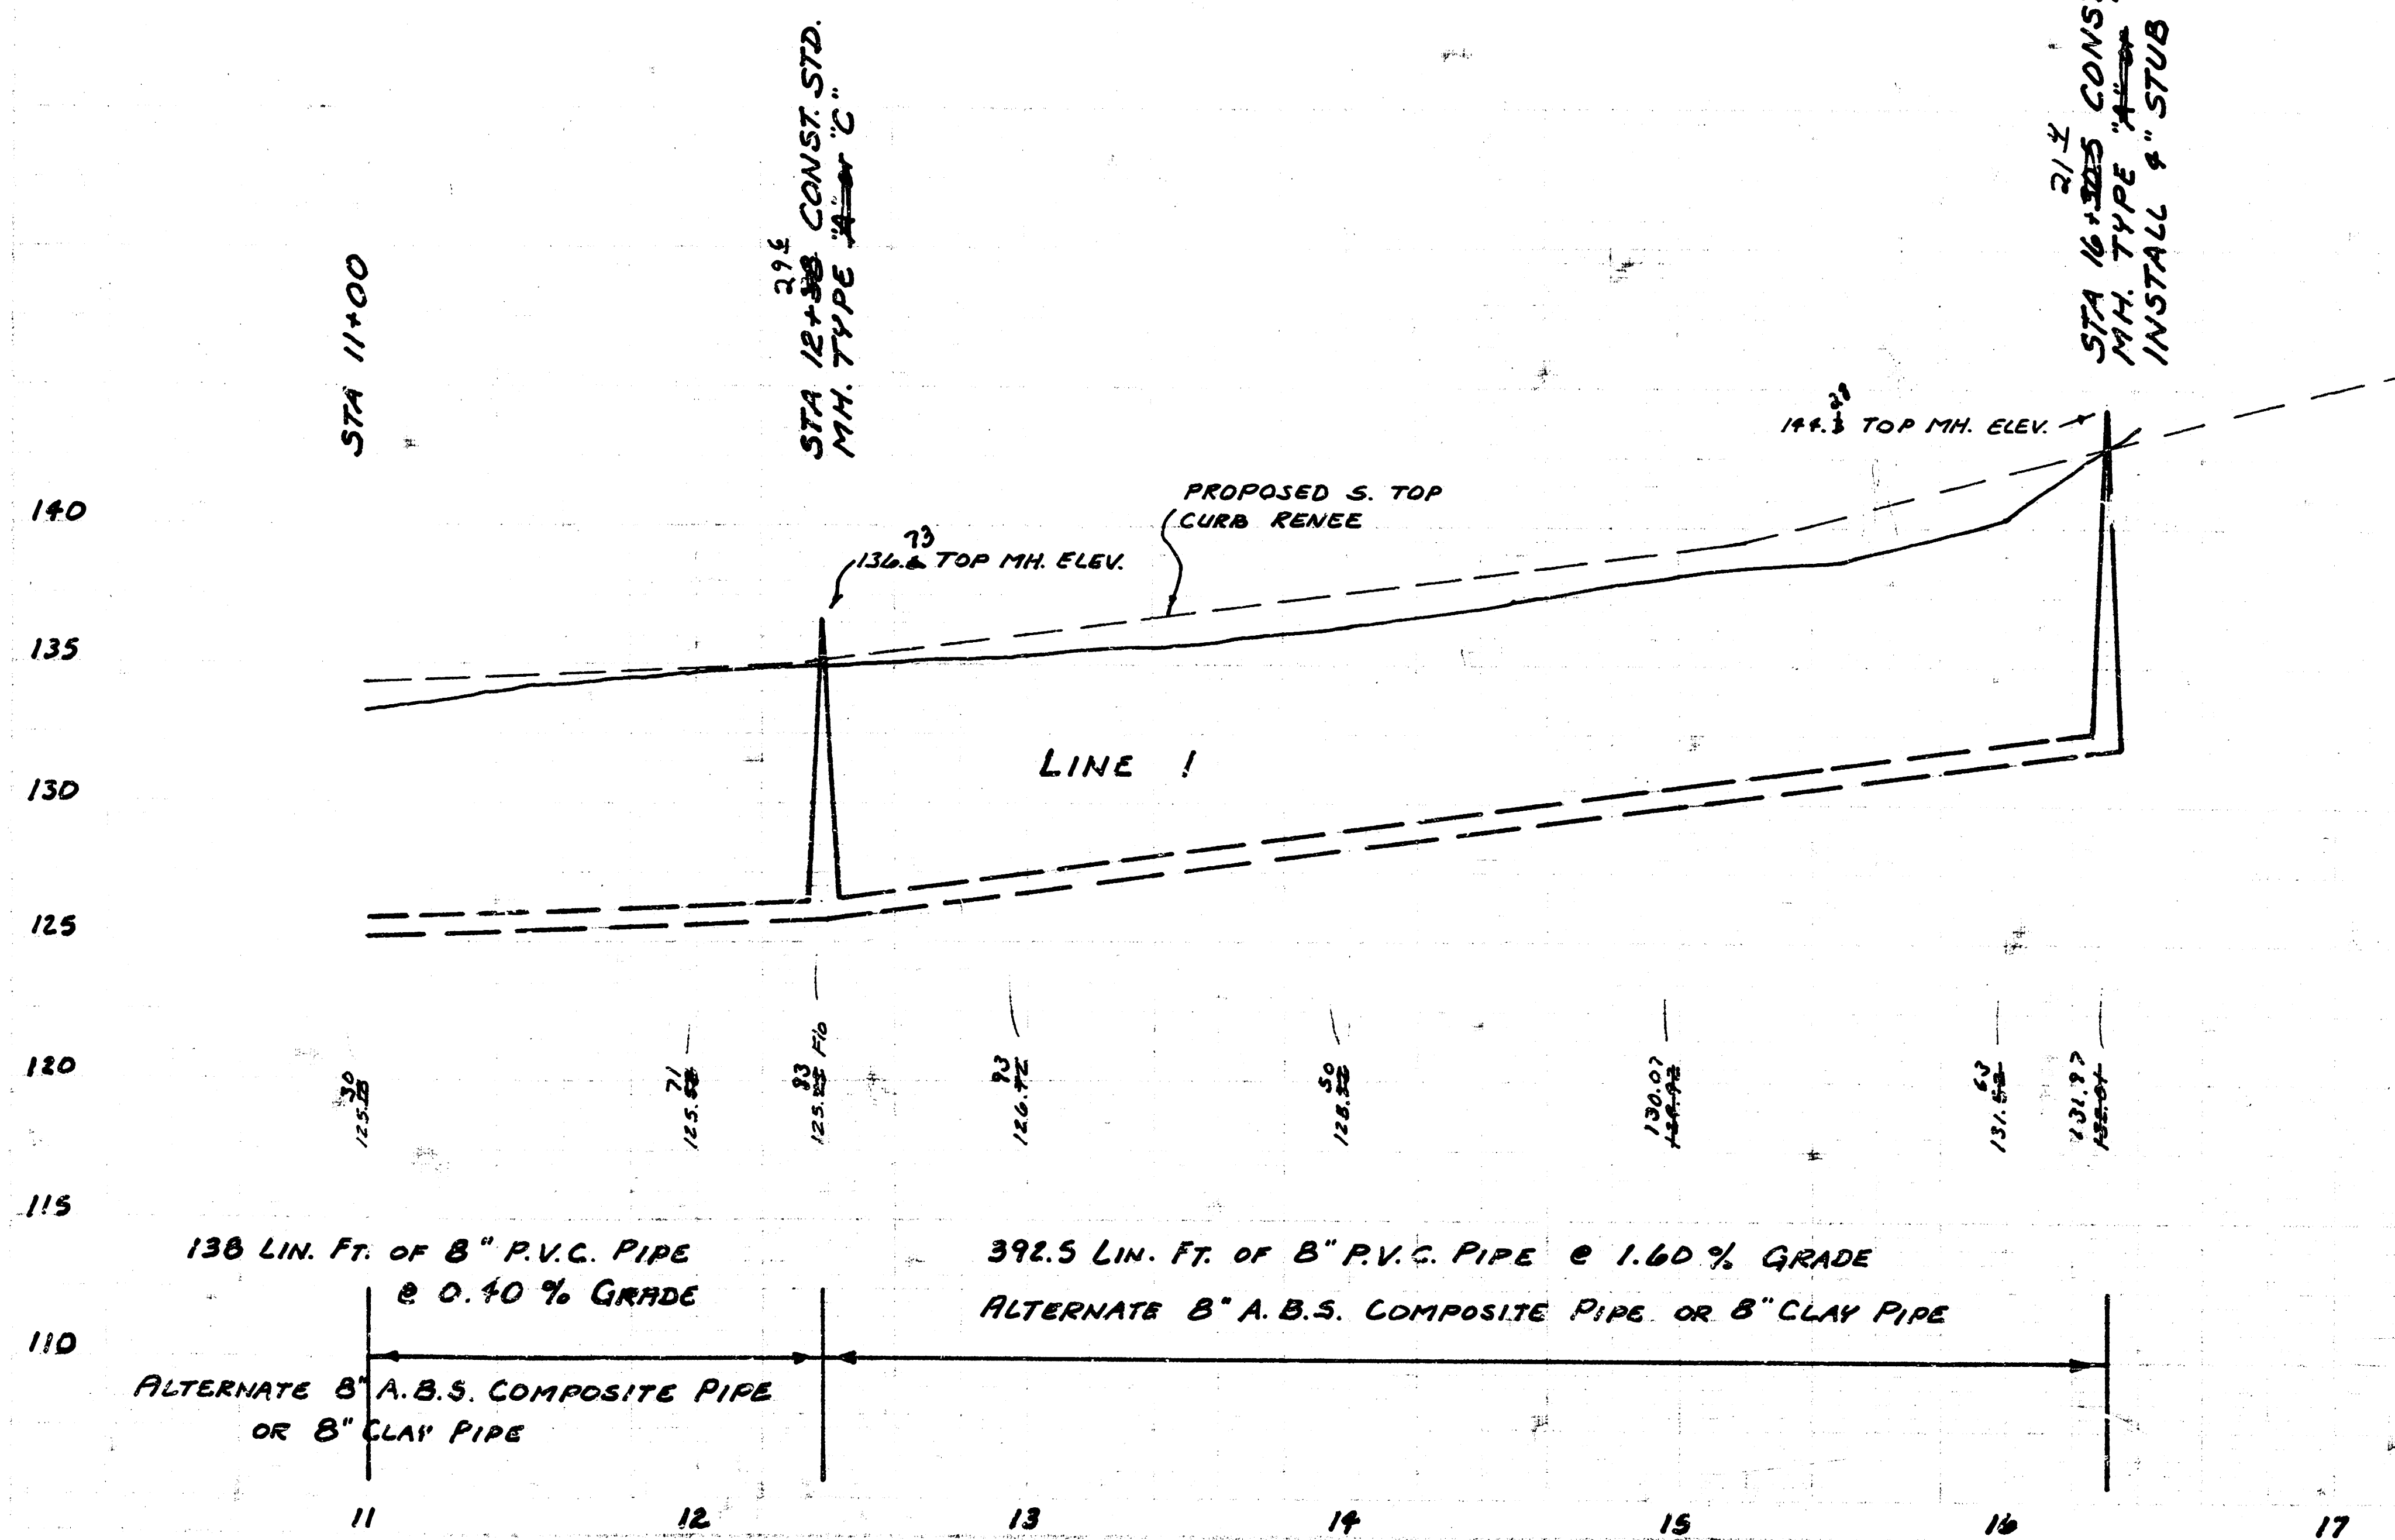


LAT 6, MAIN 6, SW1
462-76245-80892-000-000

SCALE PLAN 1" = 40'
 PROFILE 1" = 4.0' HORIZ.
 1" = 3' VERT.

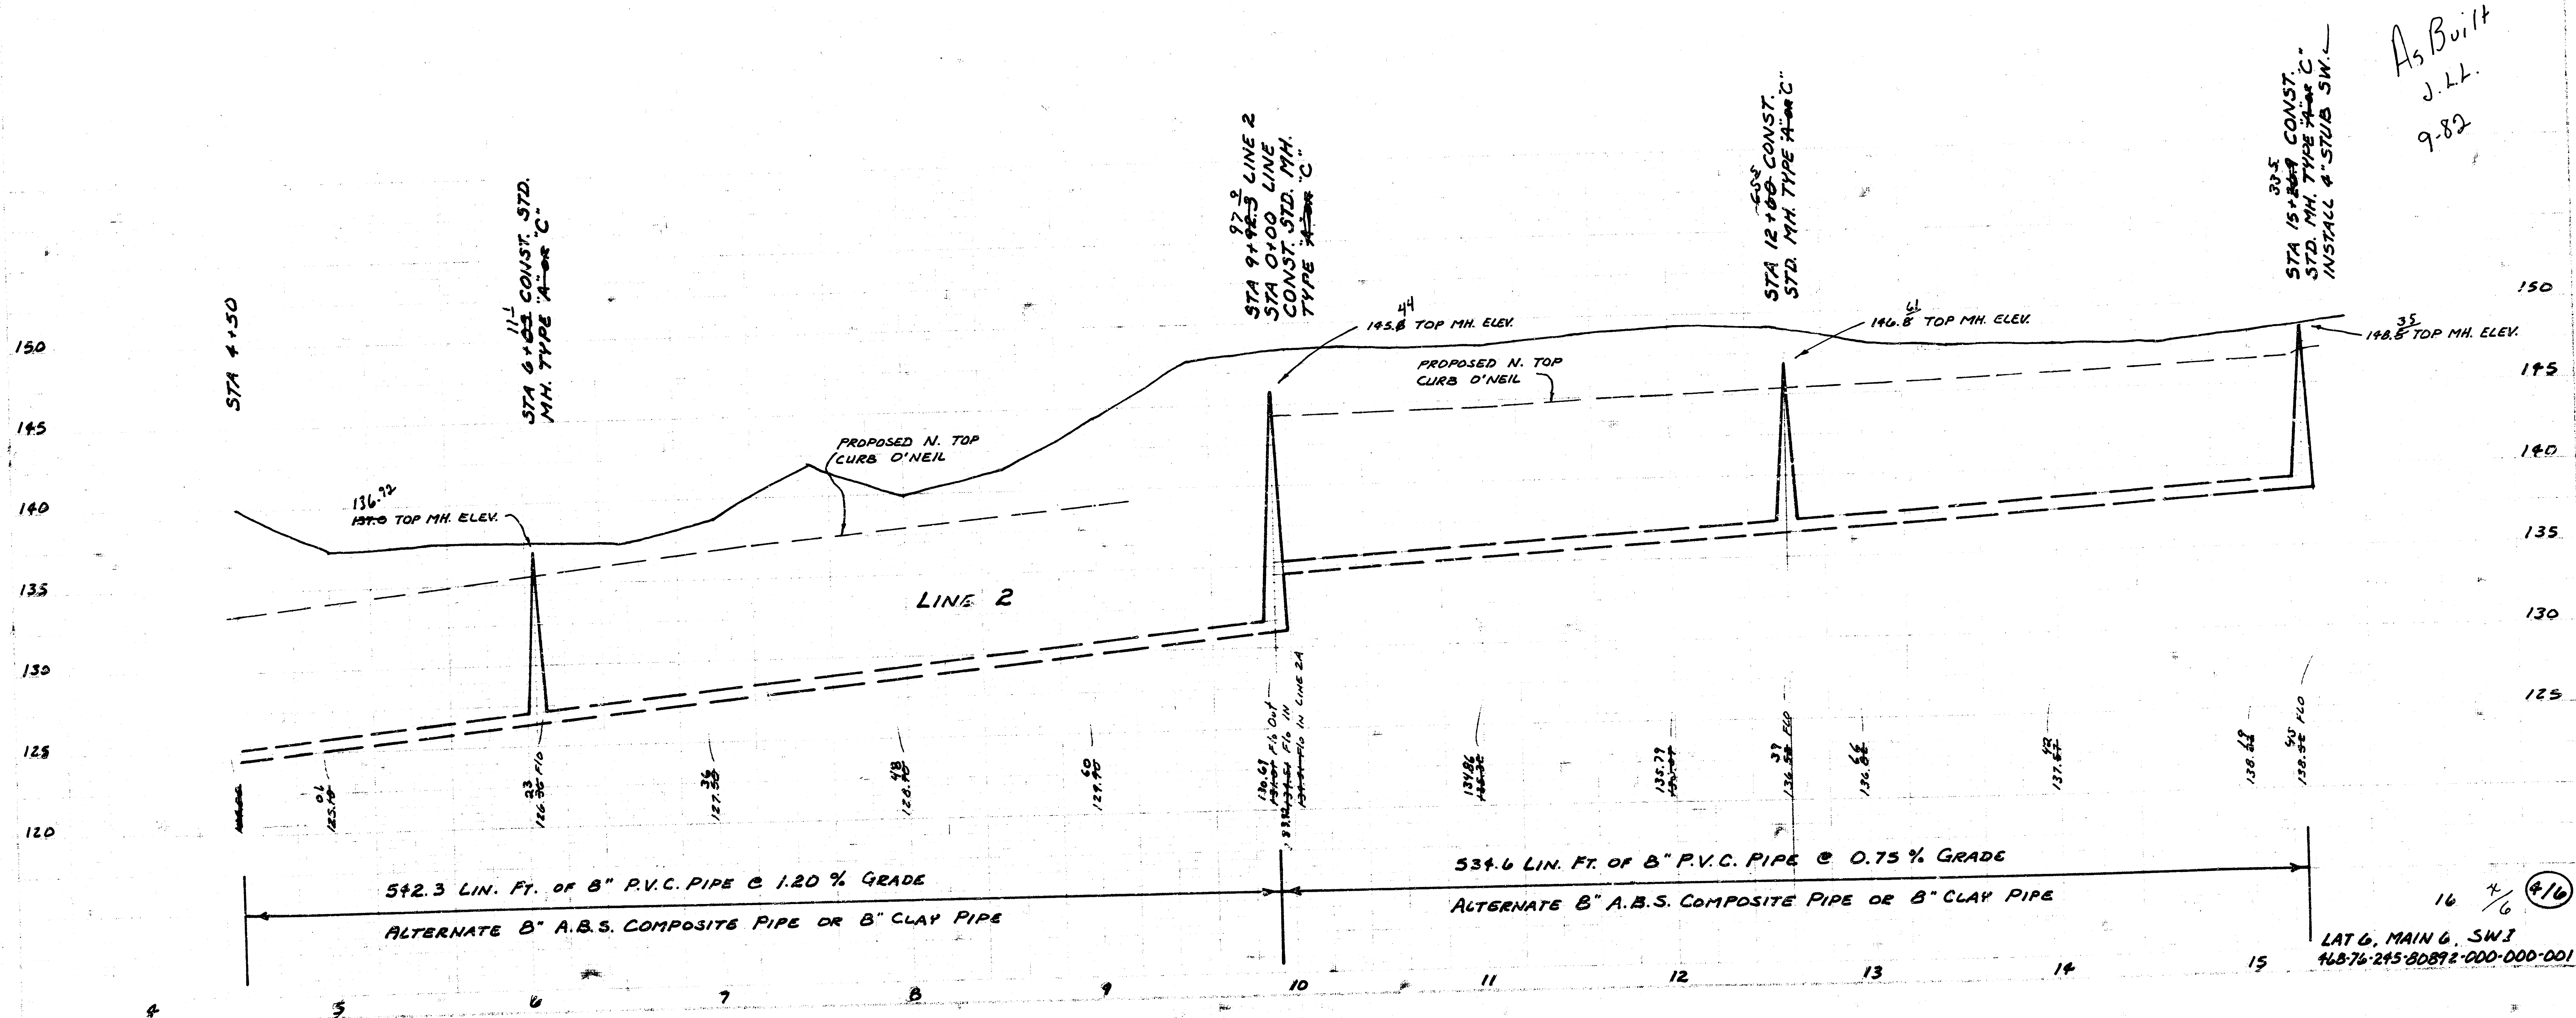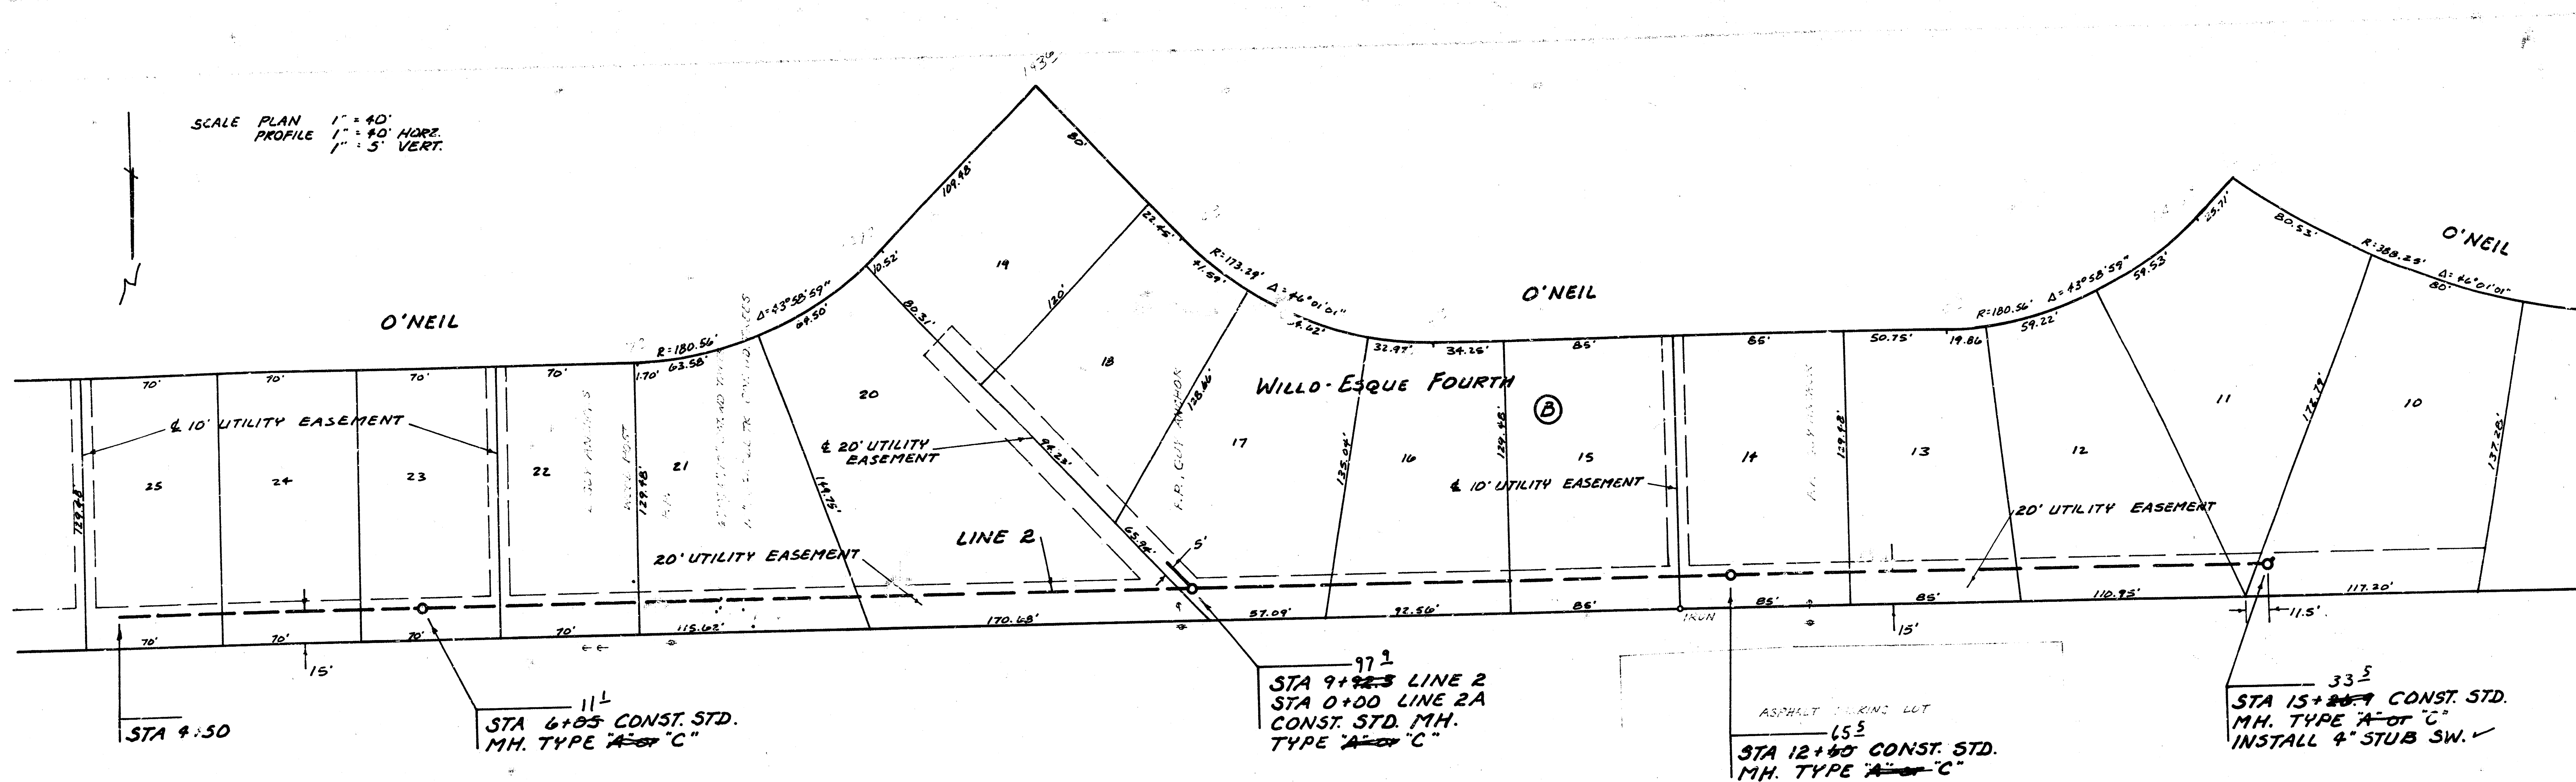


As Built
 J.L.
 9-82


LAT 6, MAIN 6, SW 3
 46876-245-80872-000-000-001

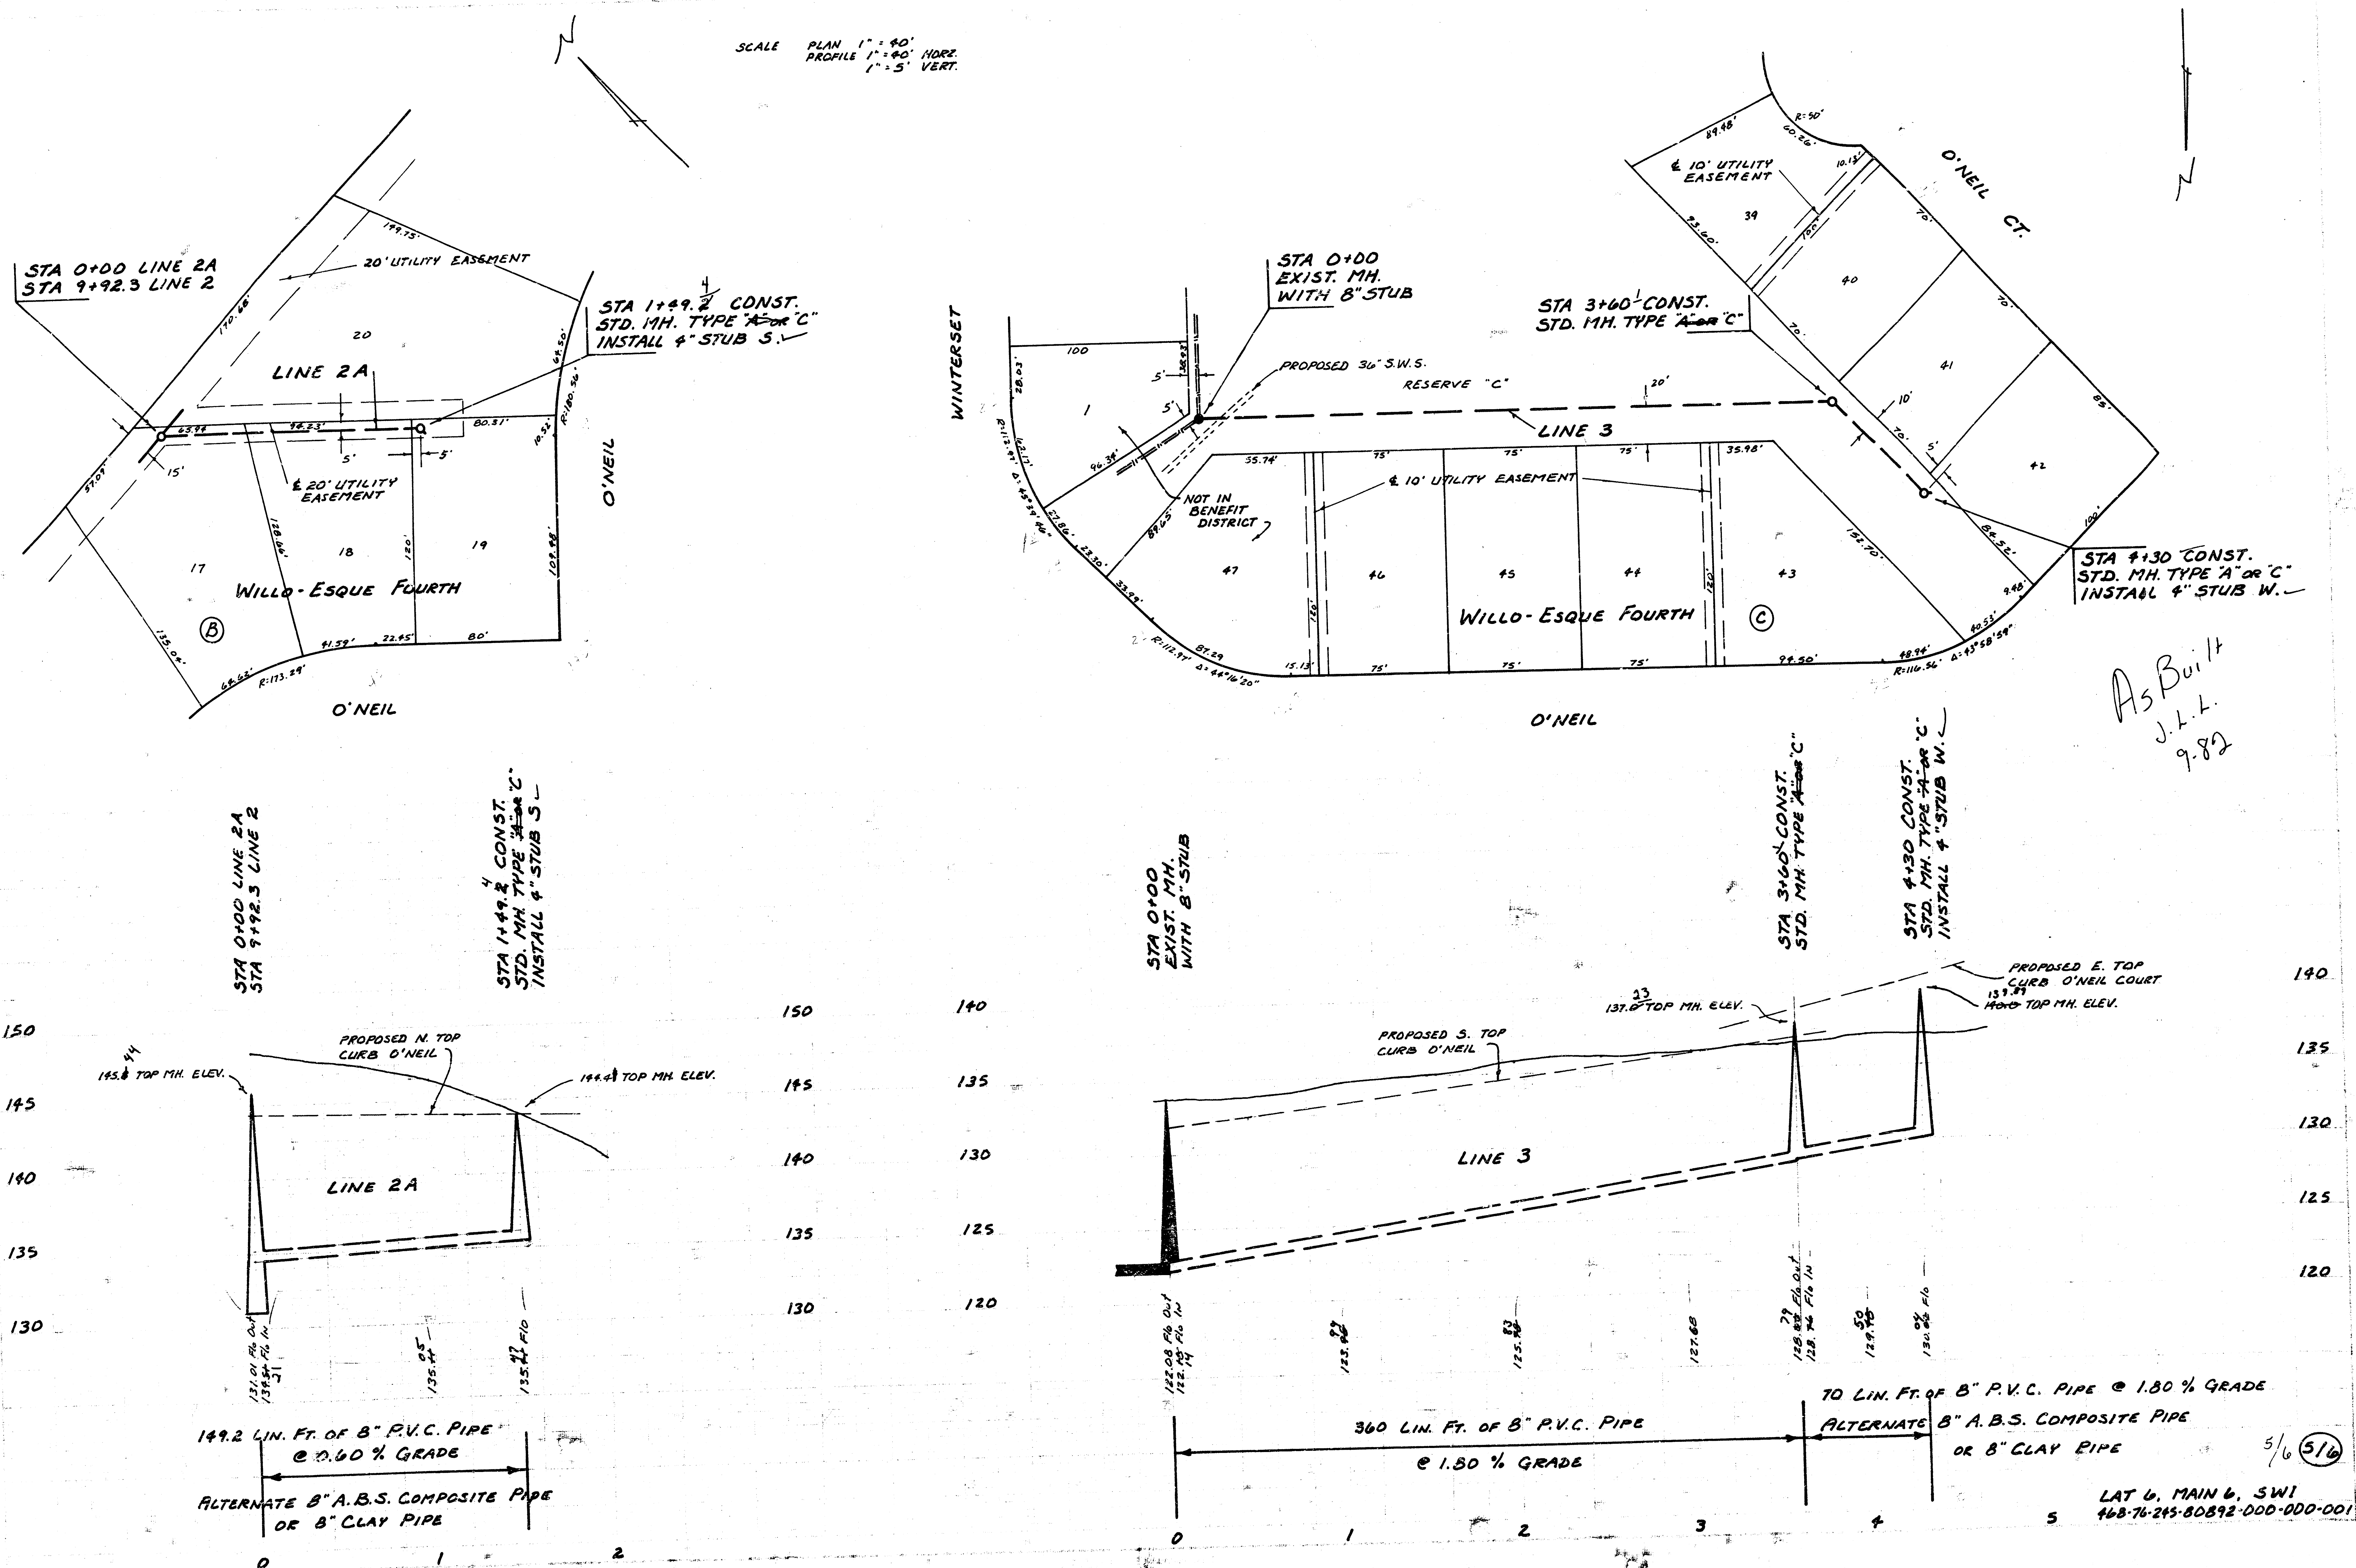

SCALE PLAN 1" = 40'
 PROFILE 1" = 40' HORIZ.
 1" = 5' VERT.

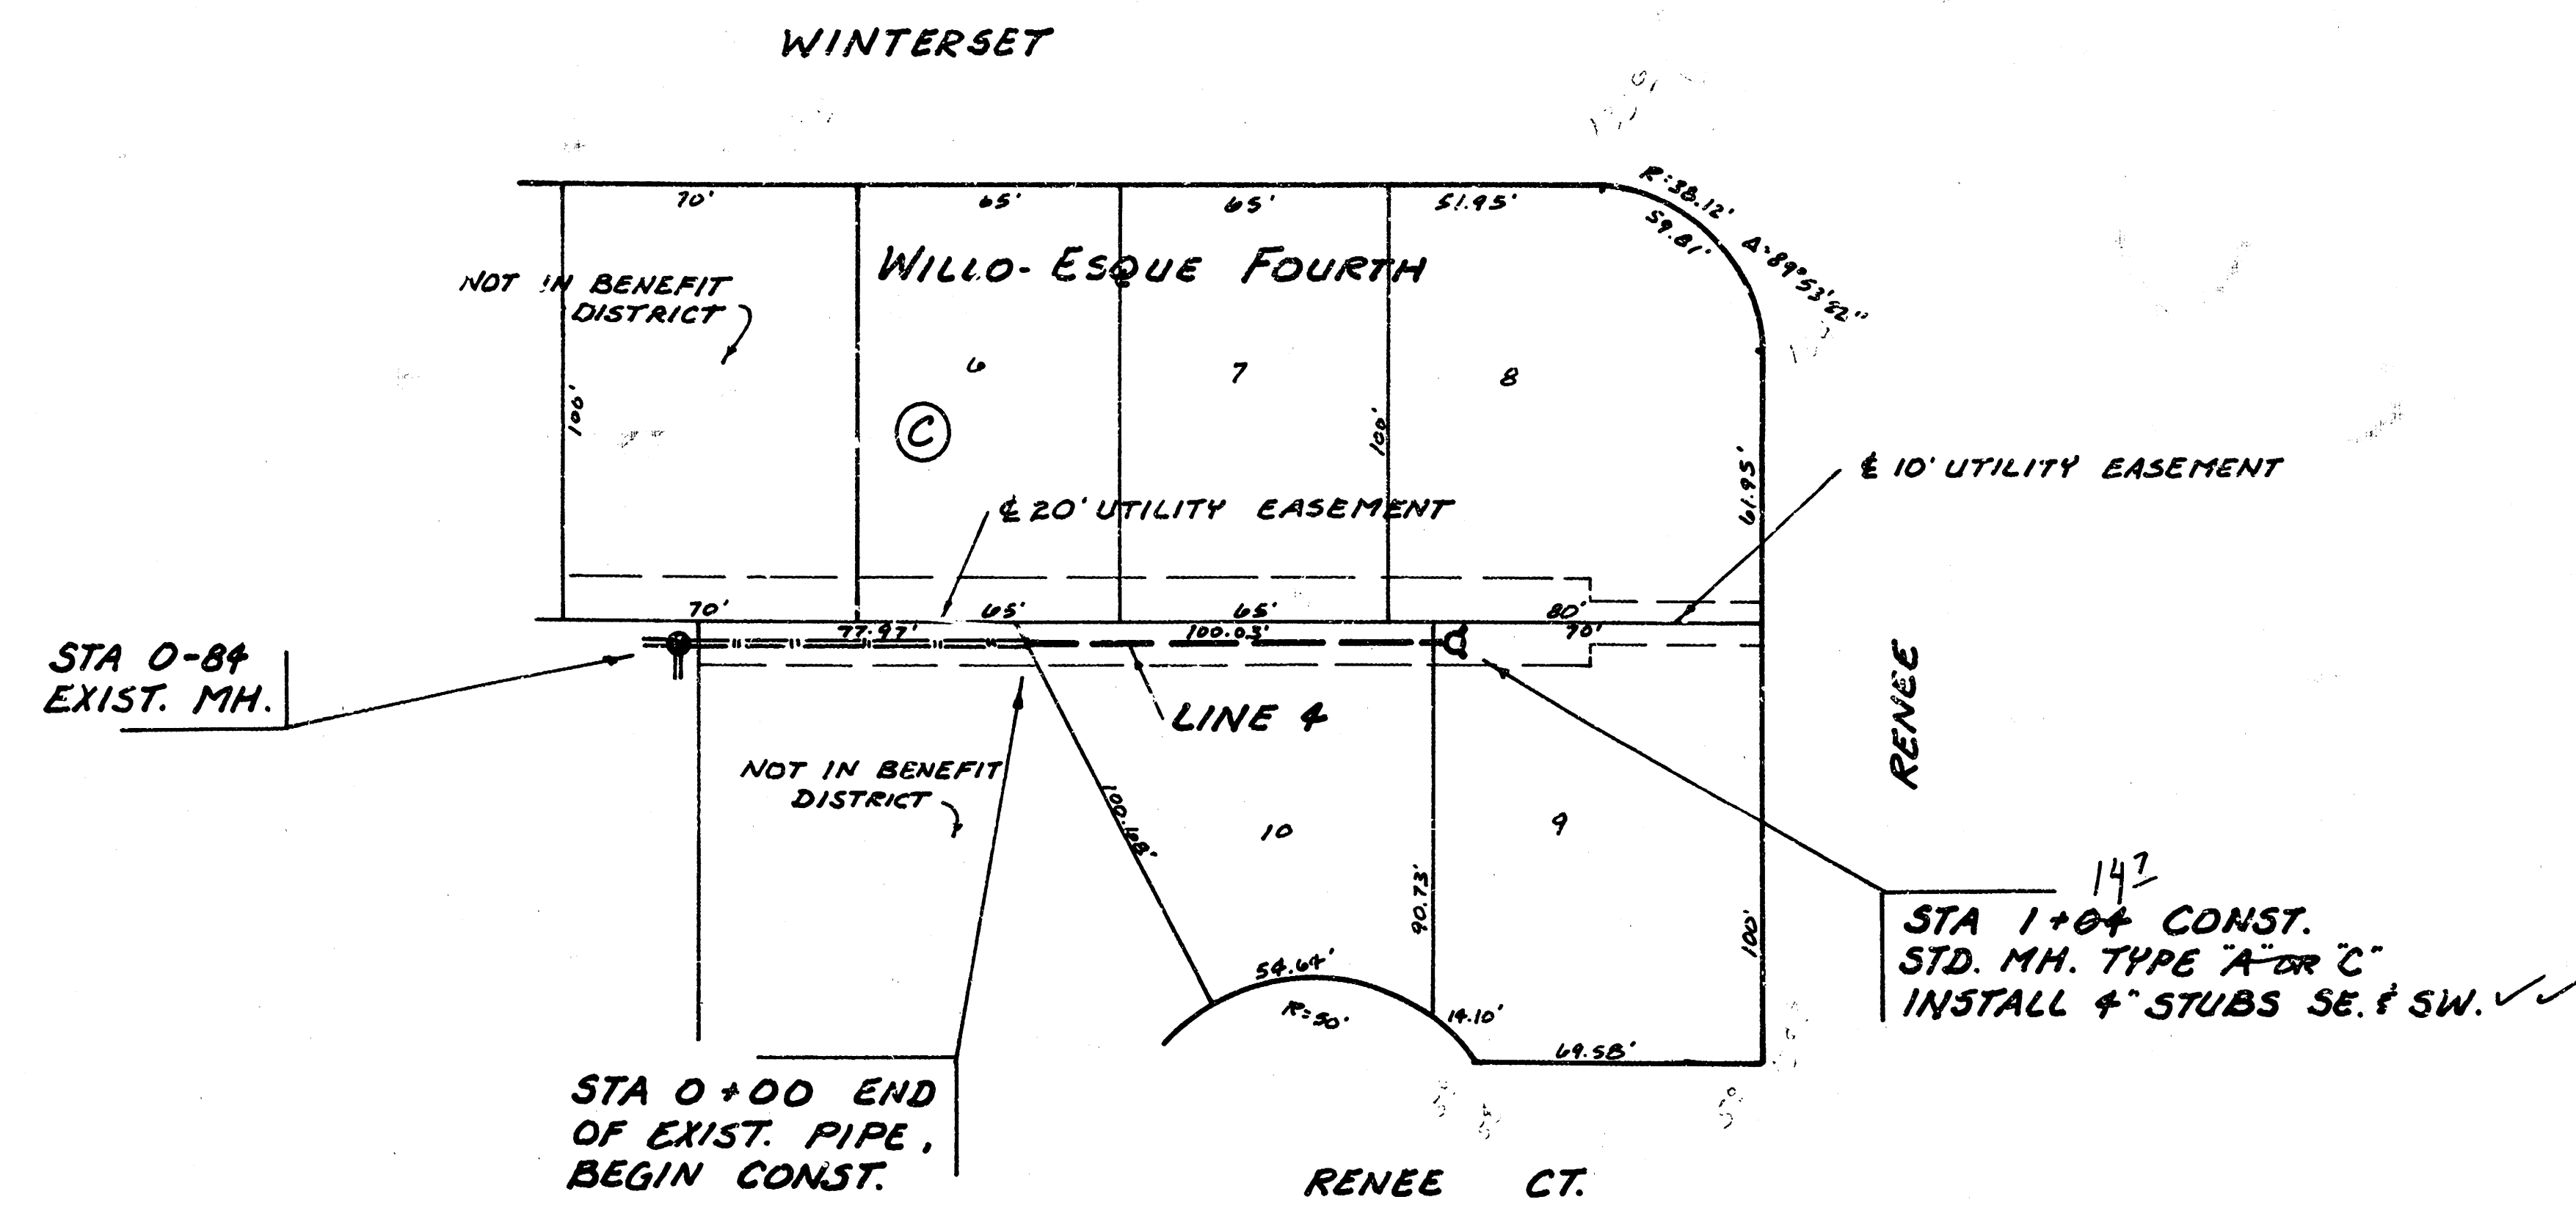

As Built
 J.L.L.
 9-82

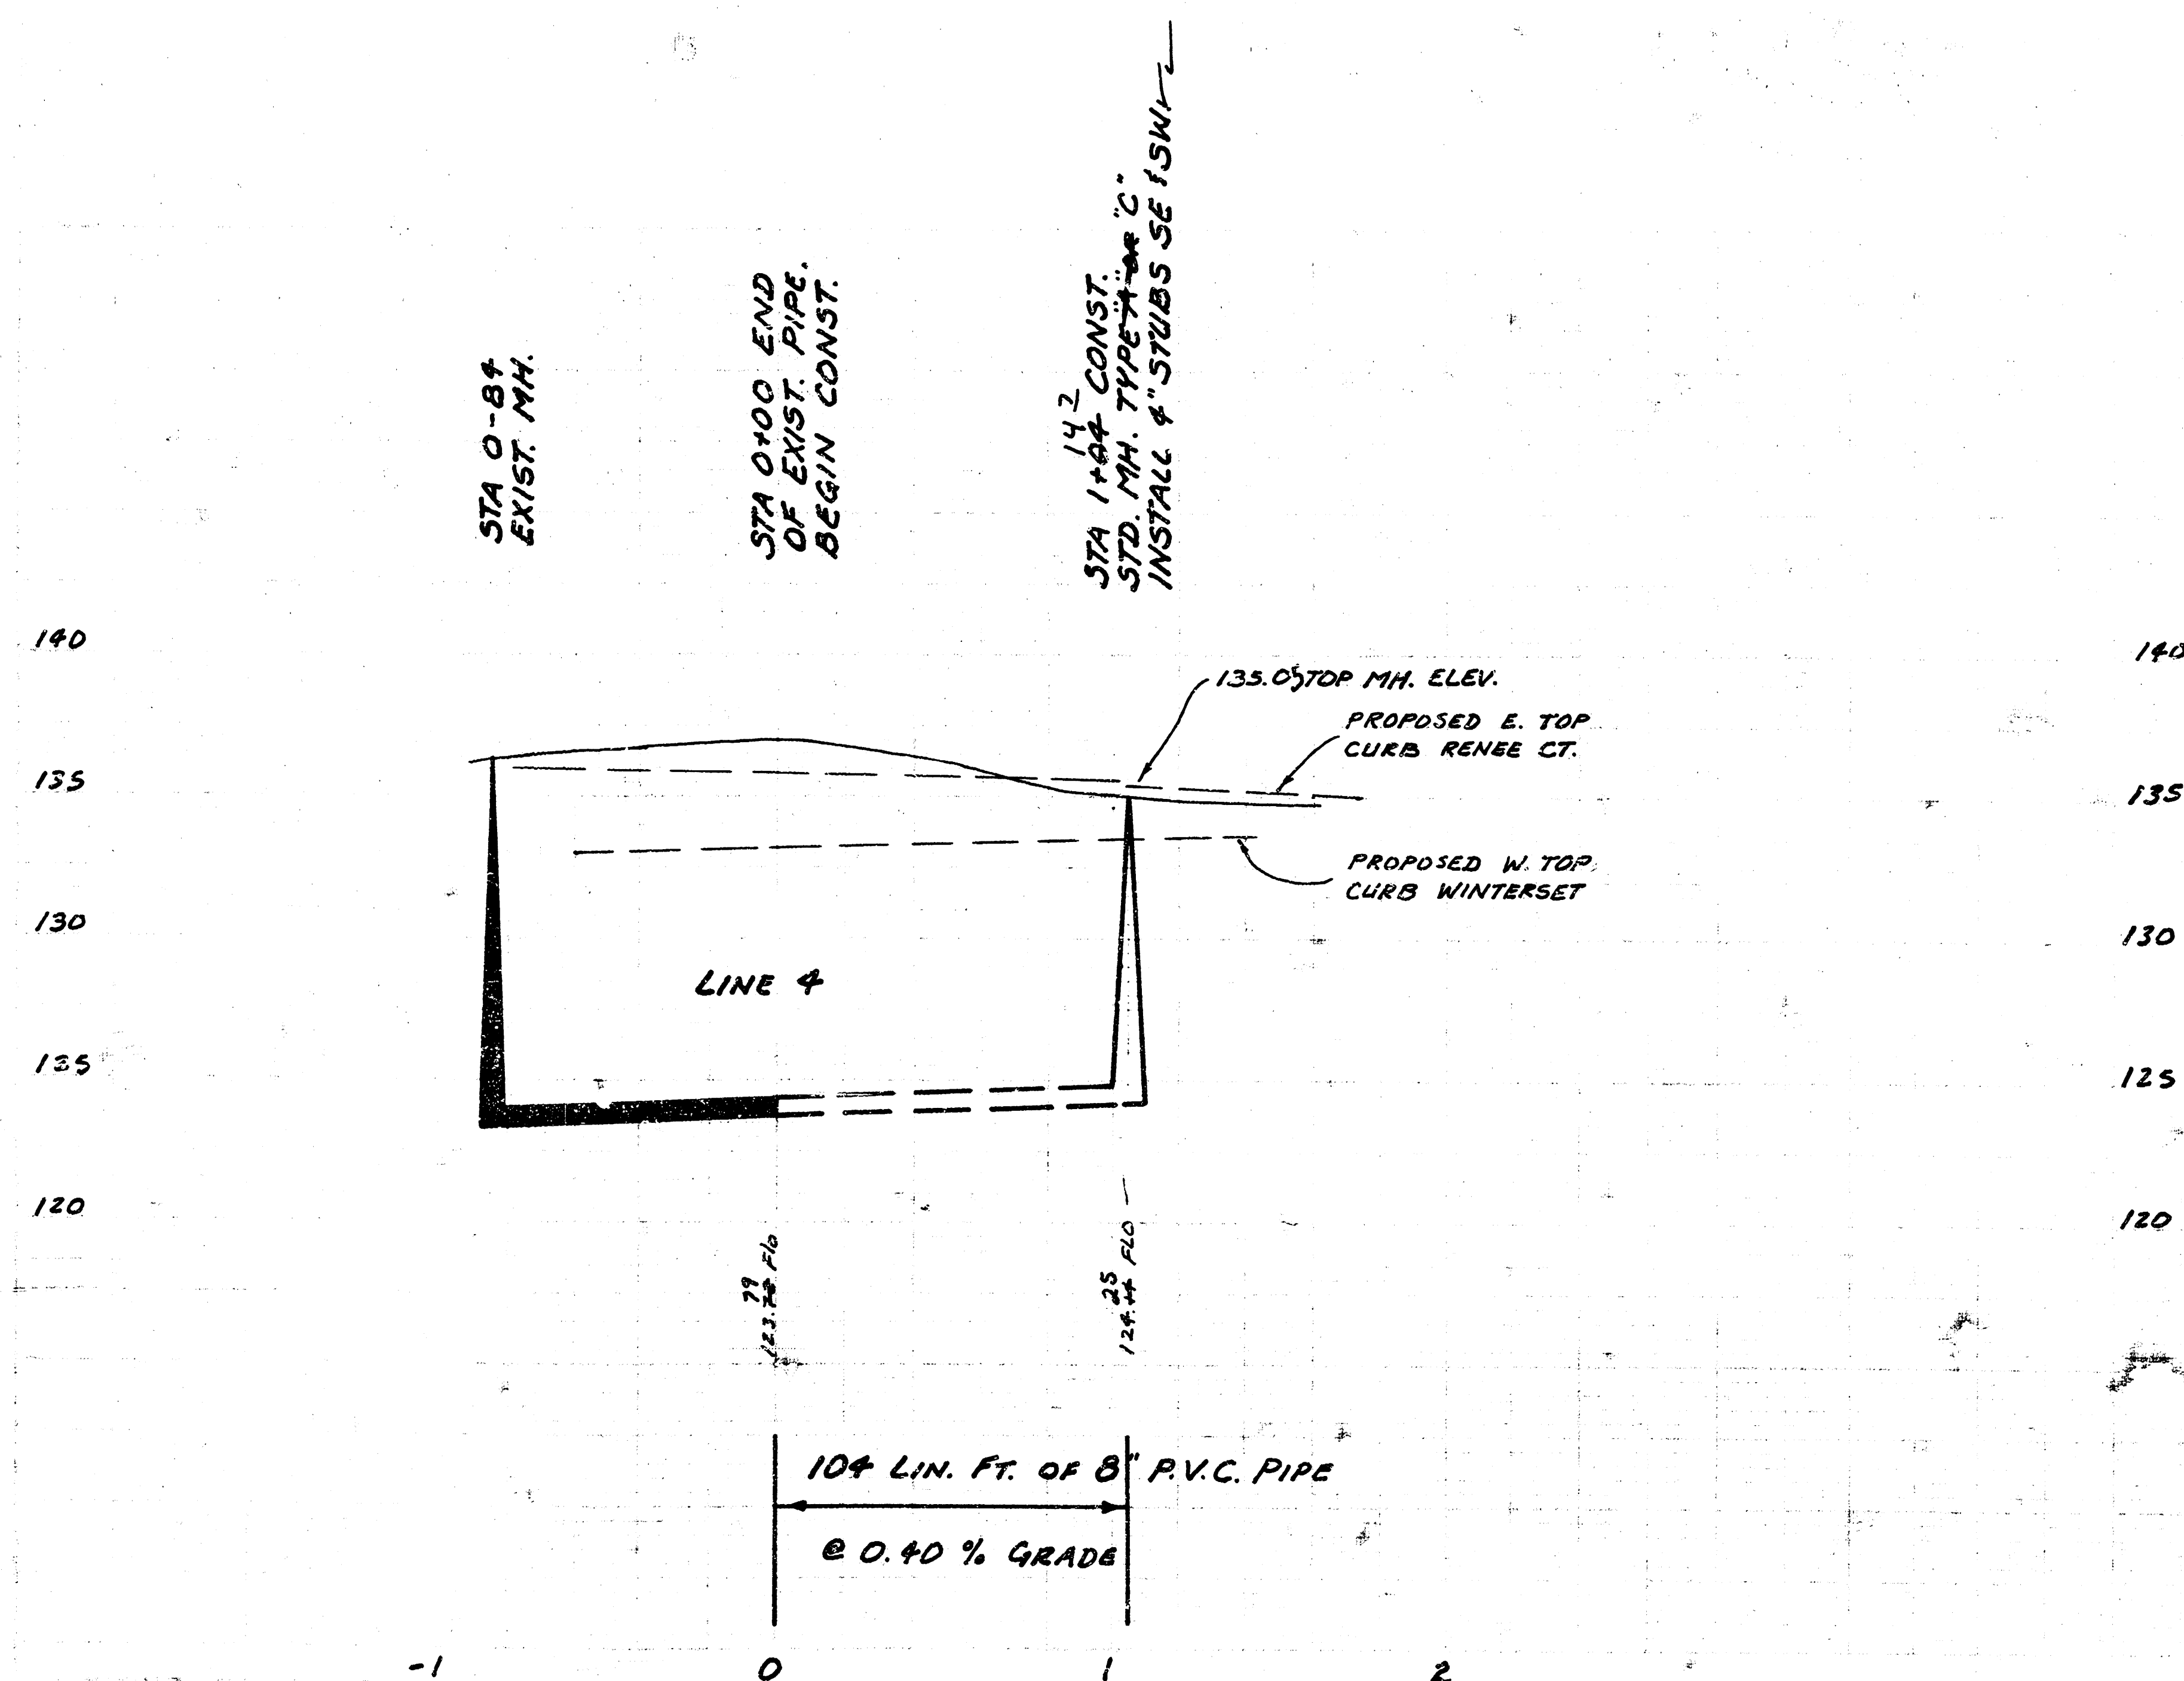

LAT 6, MAIN 6, SW1
 468-76-245-80892-000-000-001

10 2 3 2