


Scale Plan 1"=40'  
Profile 1"=40' Horiz.  
1"=5' Vert.

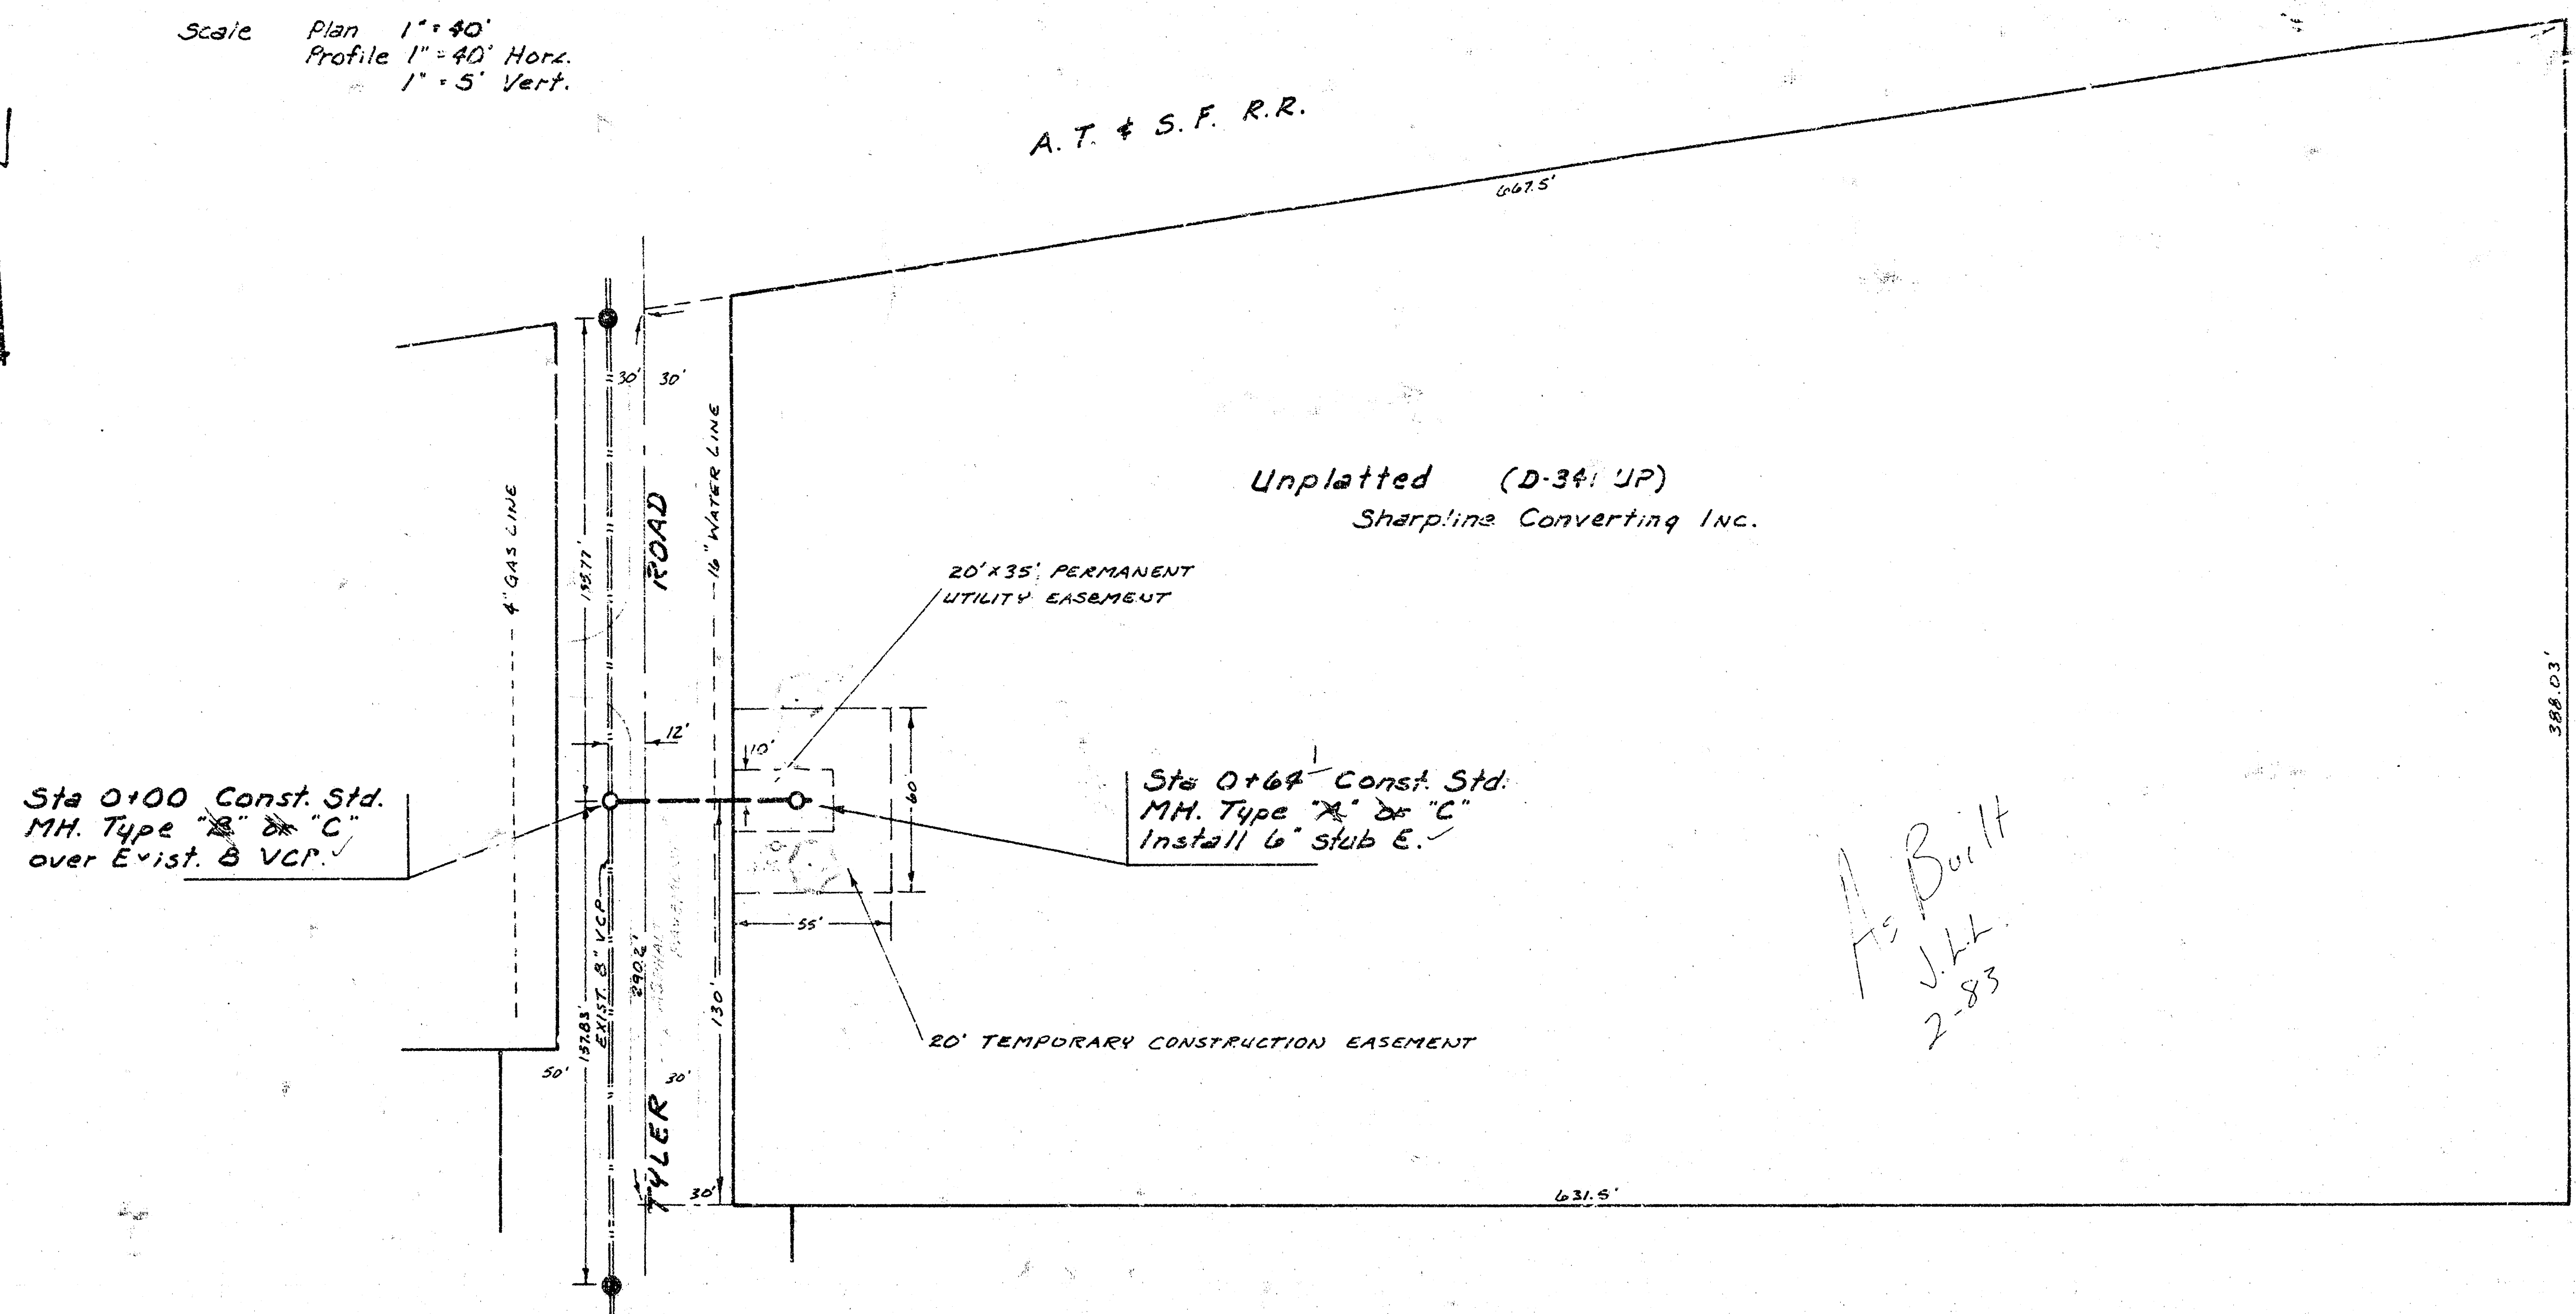


As Built  
J.L.L.  
2-83

THE CONTRACTOR SHALL BE RESPONSIBLE FOR PRESERVING PROPERTY IRONS. THE CONTRACTOR SHALL BE REQUIRED TO RE-ESTABLISH ANY PROPERTY IRONS WHICH ARE DAMAGED OR DESTROYED BY HIS CONSTRUCTION OPERATIONS. SUCH IRONS SHALL BE RE-ESTABLISHED BY A LICENSED LAND SURVEYOR OR A LICENSED PROFESSIONAL ENGINEER IN ACCORDANCE WITH STATE LAWS.

TBM: Top of the SW 3" x 4" Steel Guard Post of Guard Posts around a Gas Regulator in the NW Quad of the Intersection of Harry St. and Tyler Road. Elev. 143.78

TBM: "M" in Mueller on the Top Flange of Fire Hydrant in the SE Quad of the Intersection of Kellogg (HWY #4) and Tyler Road. Elev. 142.85

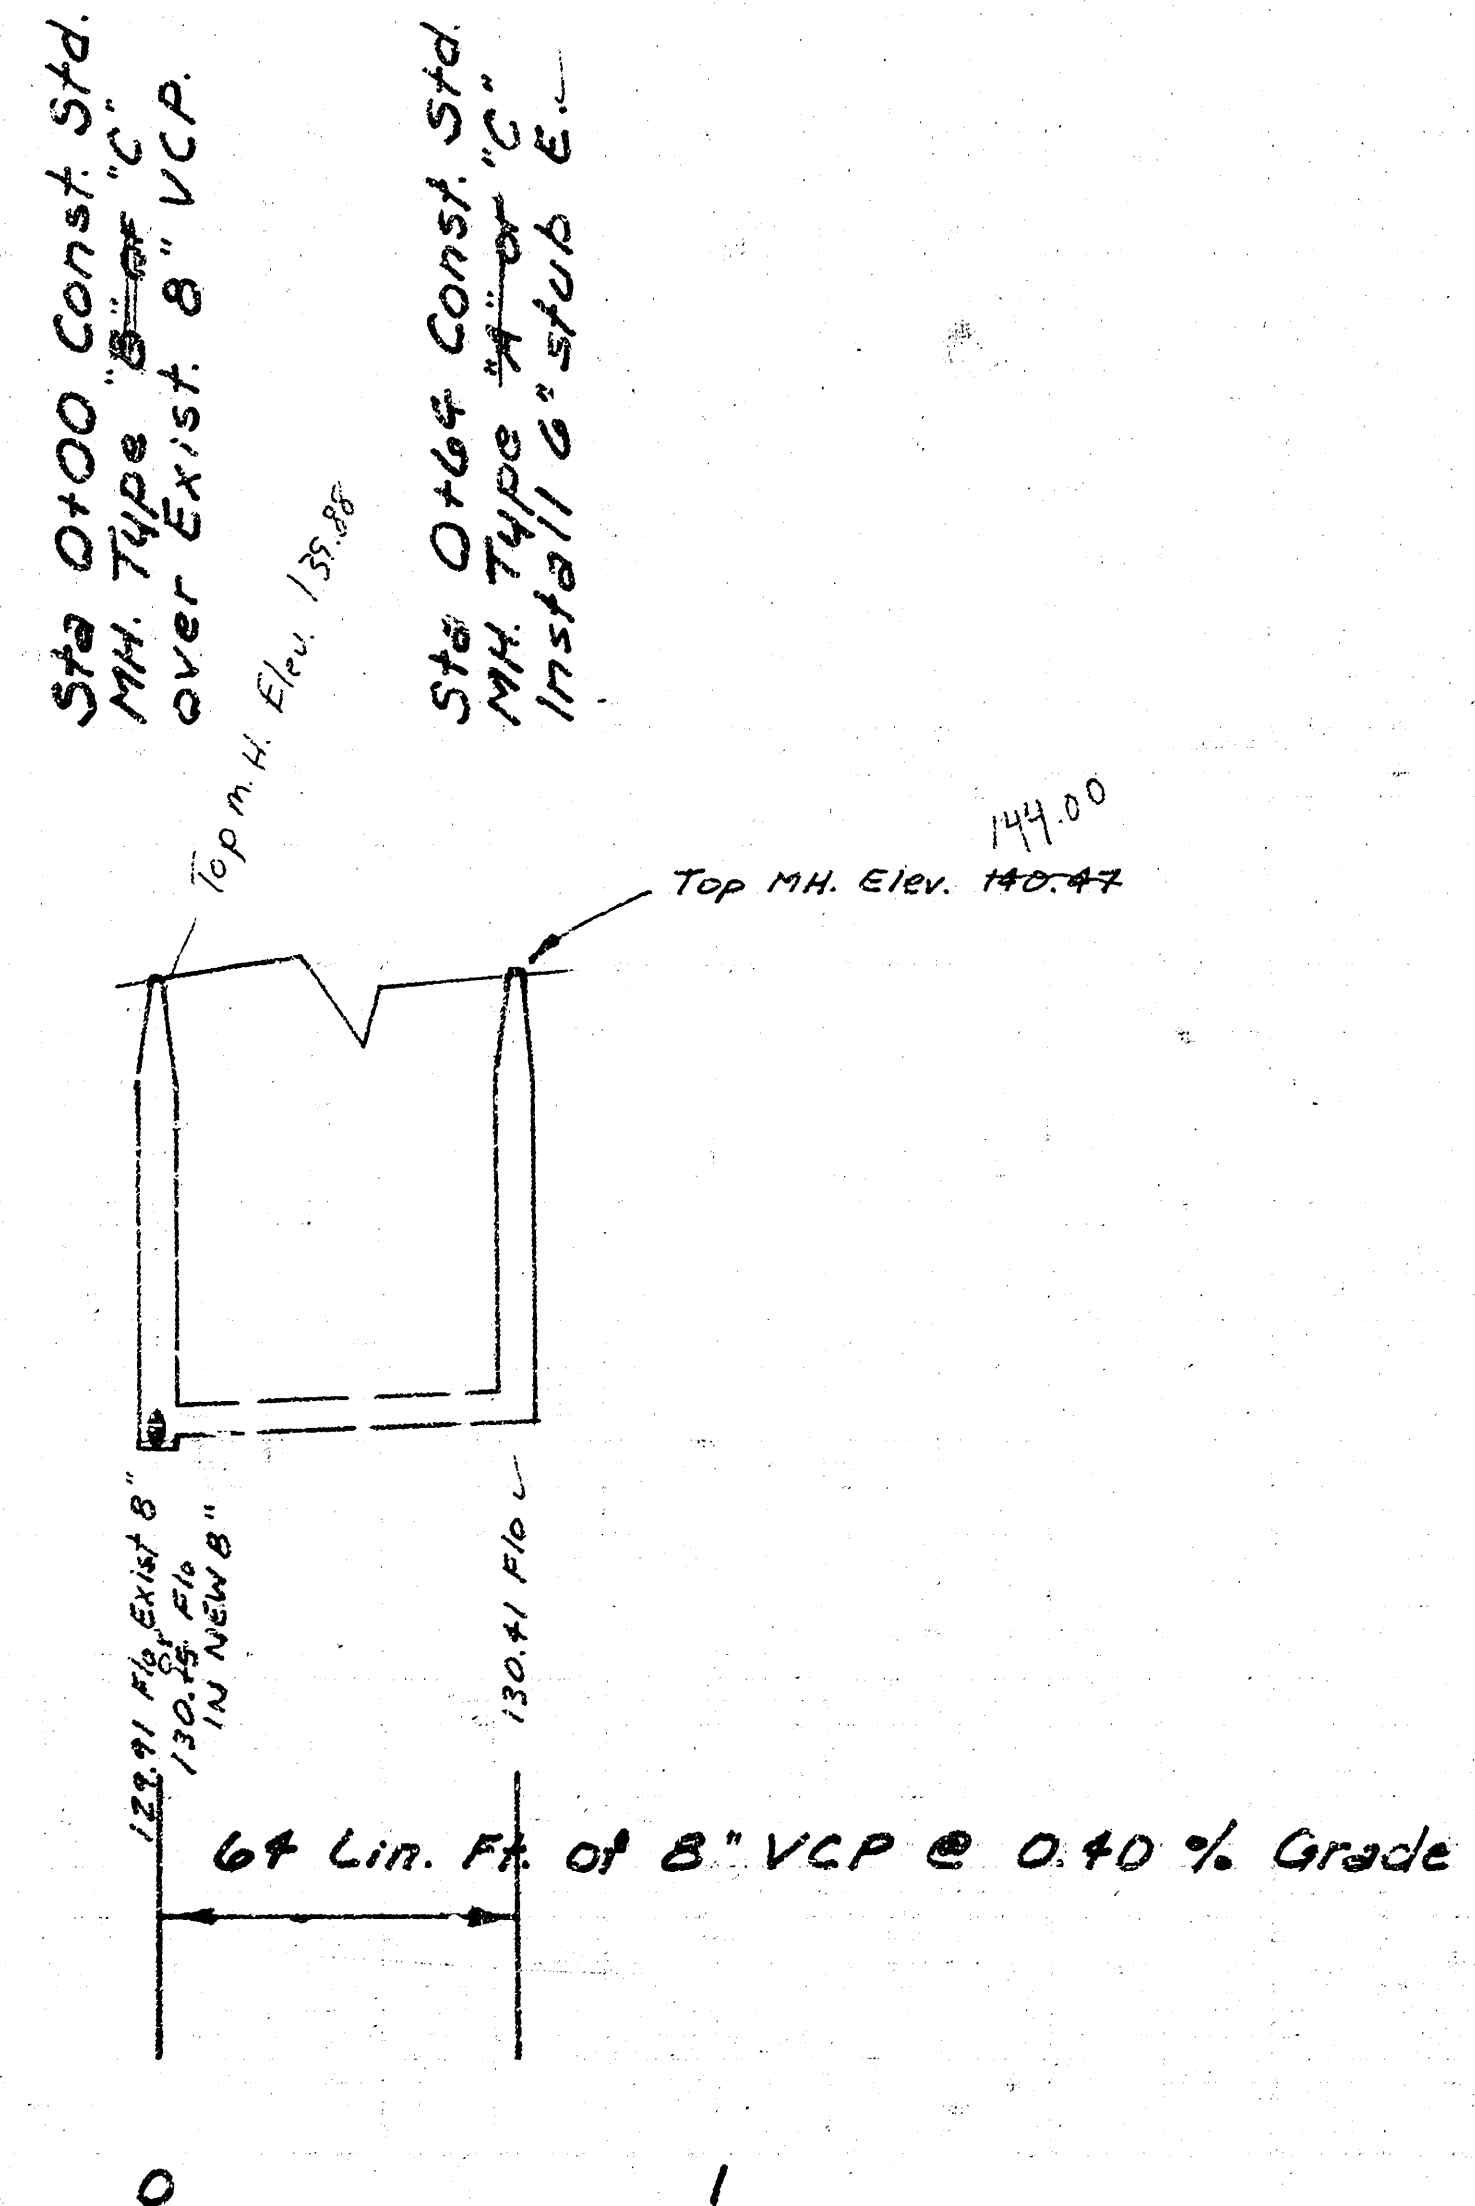

|                                      |             |      |          |
|--------------------------------------|-------------|------|----------|
| PROJECT DESCRIPTION                  |             |      |          |
| LAT 2, MAIN 3, SOUTHWEST INTERCEPTOR |             |      |          |
| PROJECT NUMBER                       |             |      |          |
| 468-76-245-81237-000-000-001         |             |      |          |
| BOOK NO.                             | APPROVED BY | DATE | REVISION |
| DRAWN BY 100/M/S                     |             |      |          |
| CITY OF WICHITA                      |             |      |          |
| DEPARTMENT OF ENGINEERING            |             |      |          |
| DIRECTOR OF ENG./CITY ENGINEER       |             |      | SCALE    |
| R. W. BRUGGEMAN                      |             |      |          |