


BM 143<sup>06</sup> "a" Ch. Hdwl. S. End R.C.P.  
S. Side MAPLE, 1/2 mile W. of M112 Rd.




*D. B. Burt*  
7/8/88  
888

Phase I  
Lat. 1, Main 9, Southwest Interceptor  
Proj. No. 468-76-295-80639-000-000-001

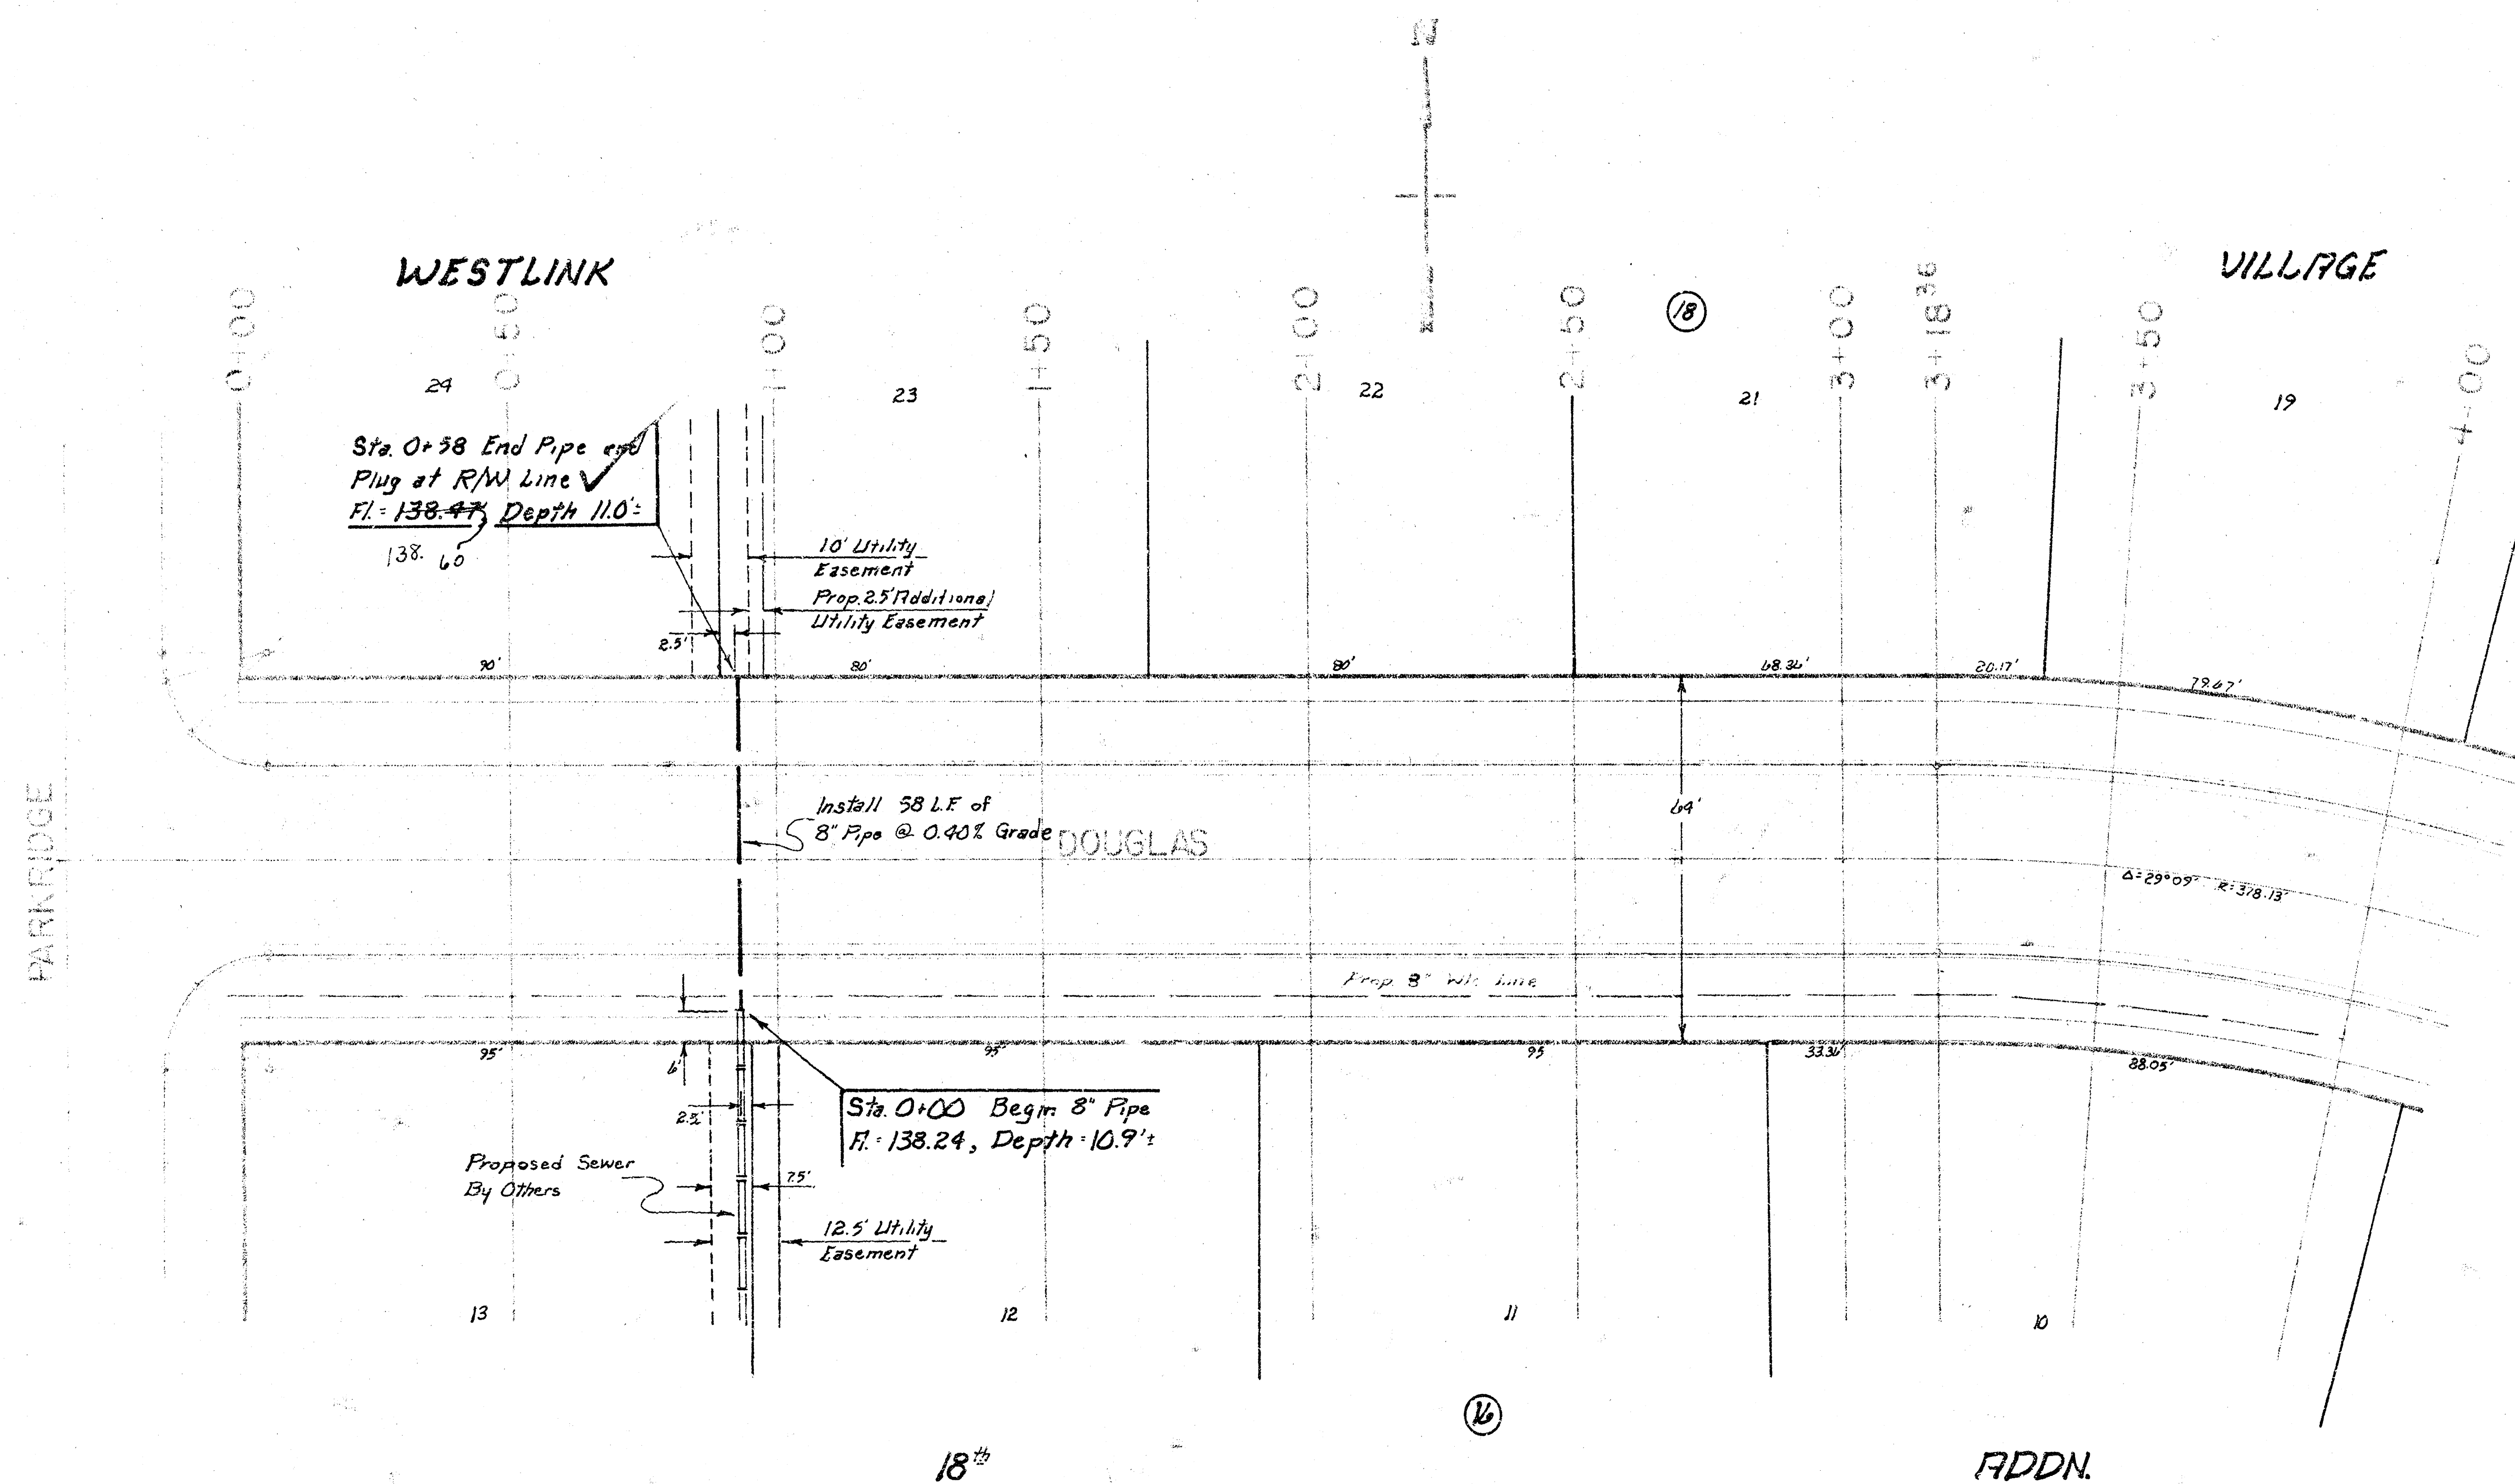


B.M. 1434 6" Ctr. Hdw. S. End R.C.P.  
S. Side MAPLE, 1/2 mile W of M712 Rd.

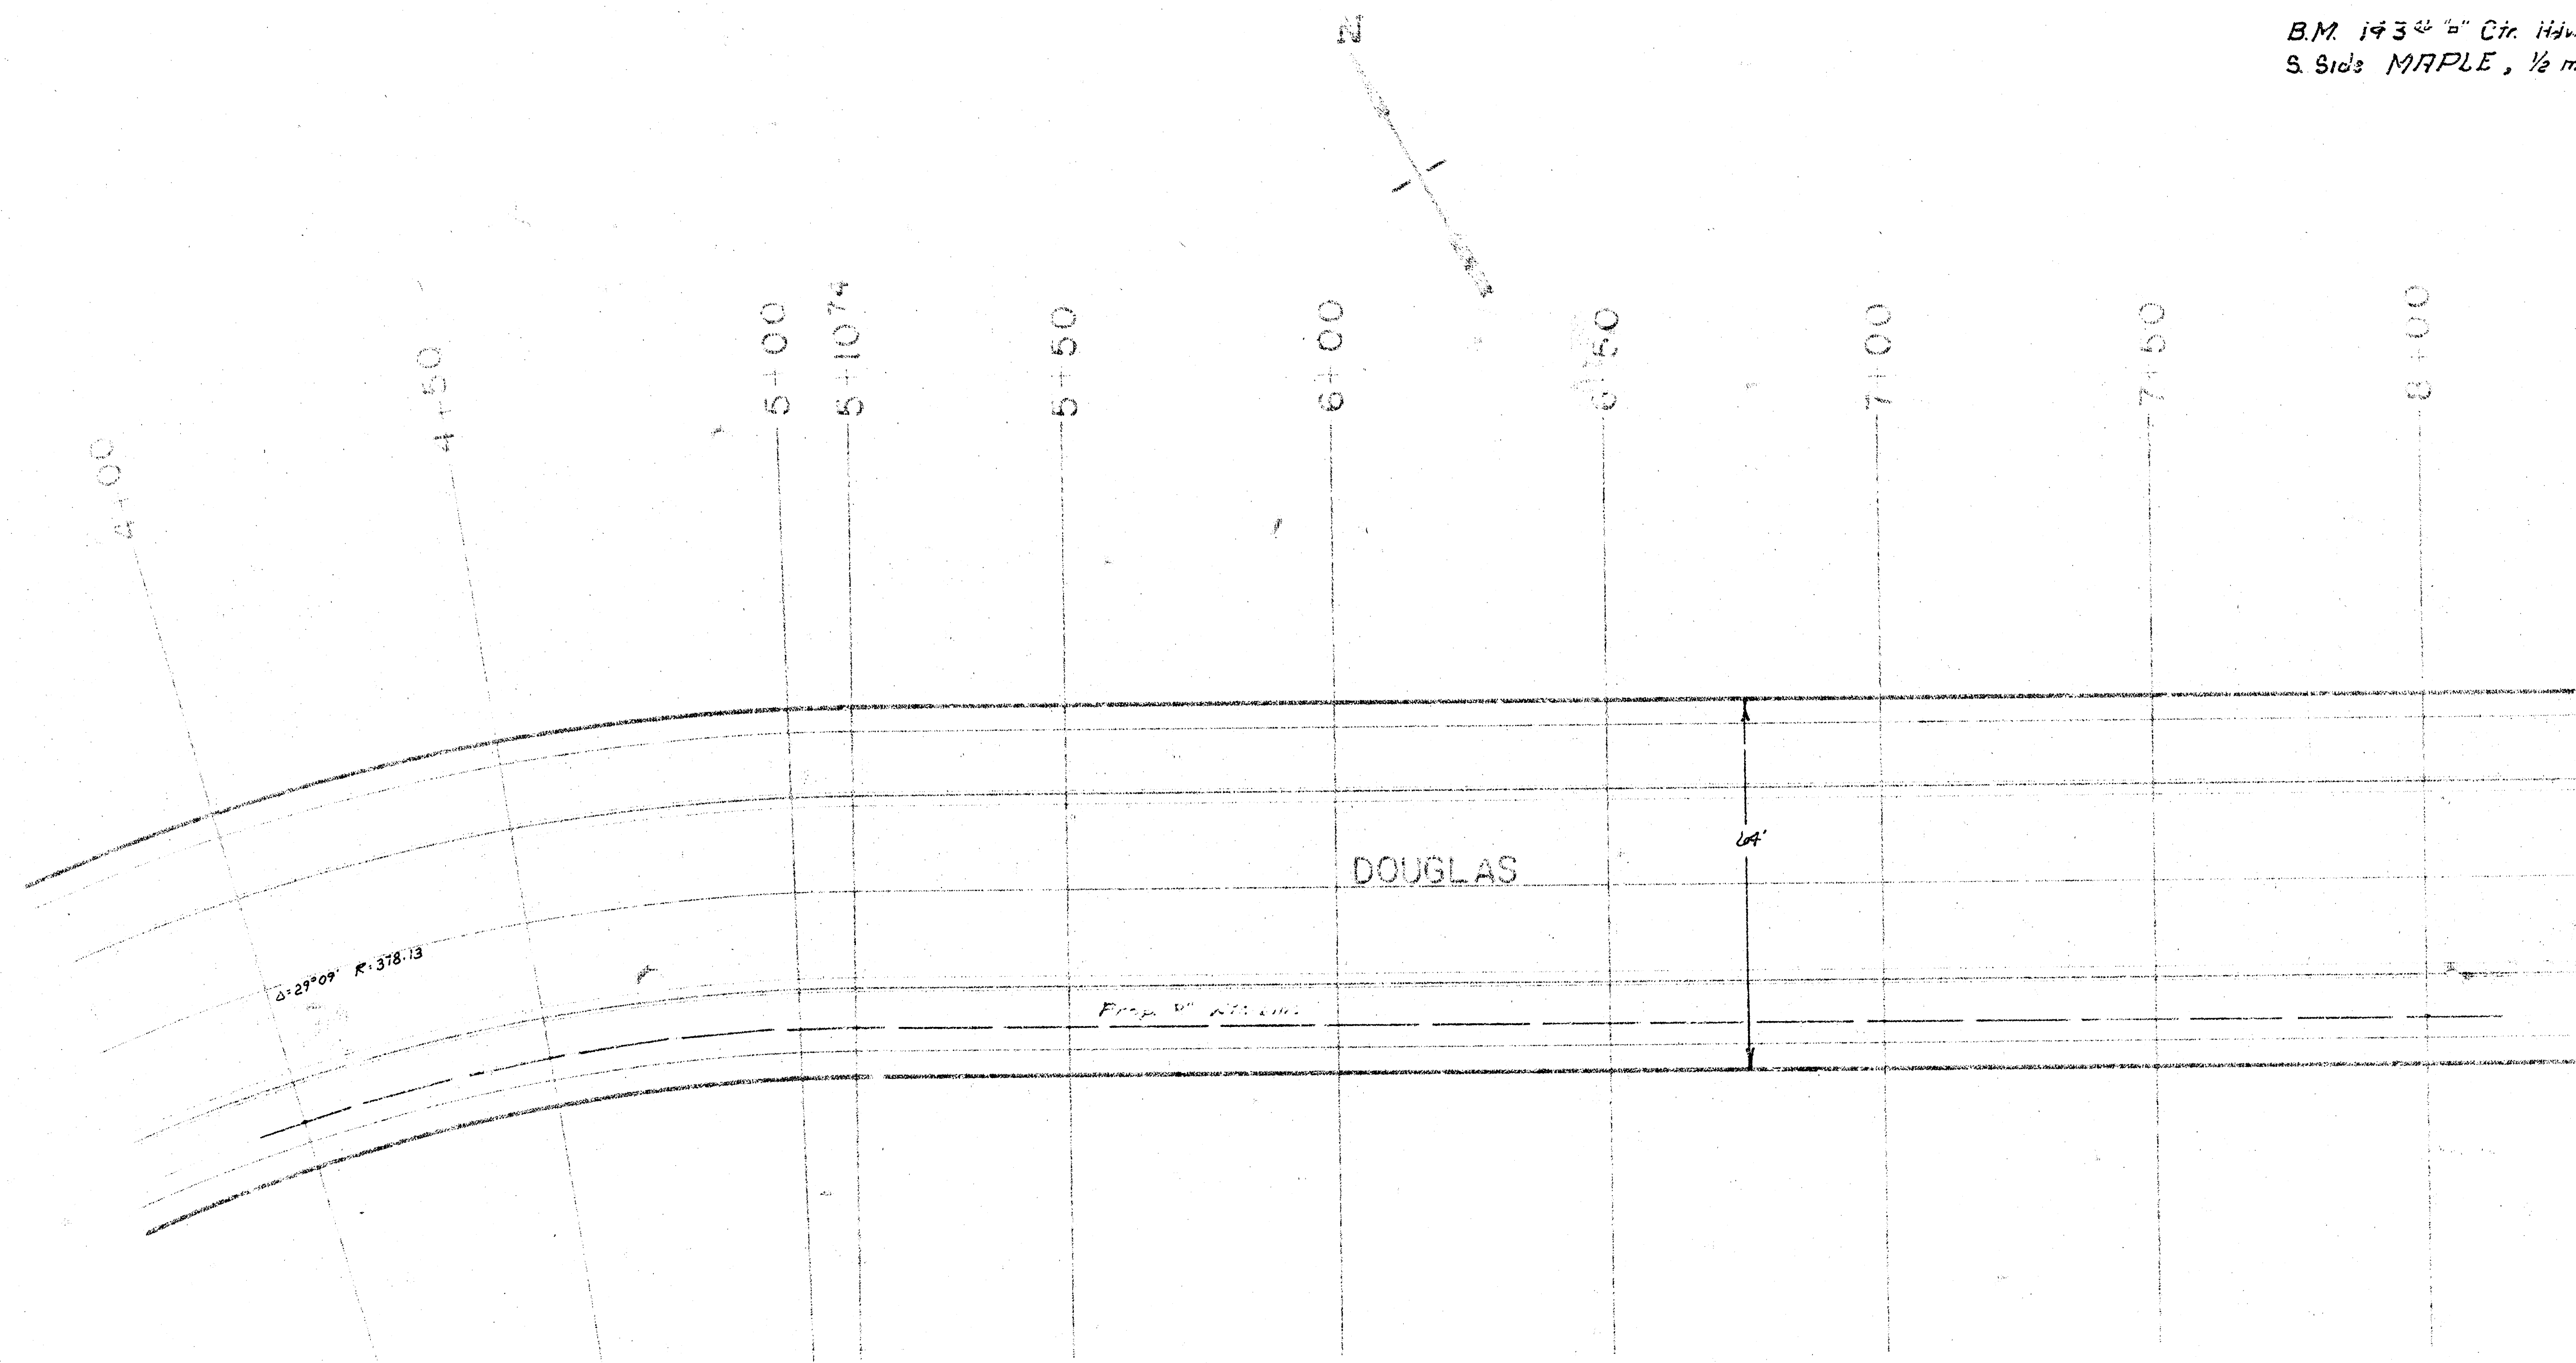

Phase I  
Lat. 1, Main 9, Southwest Interceptor  
Proj. No. 403-76-245-80034-000-000-001



B.M. 143.00 "a" Ctr. Hdwl. S. End R.C.P.  
S. Side MIDDLE, 1/2 mile W. of M712 Rd.

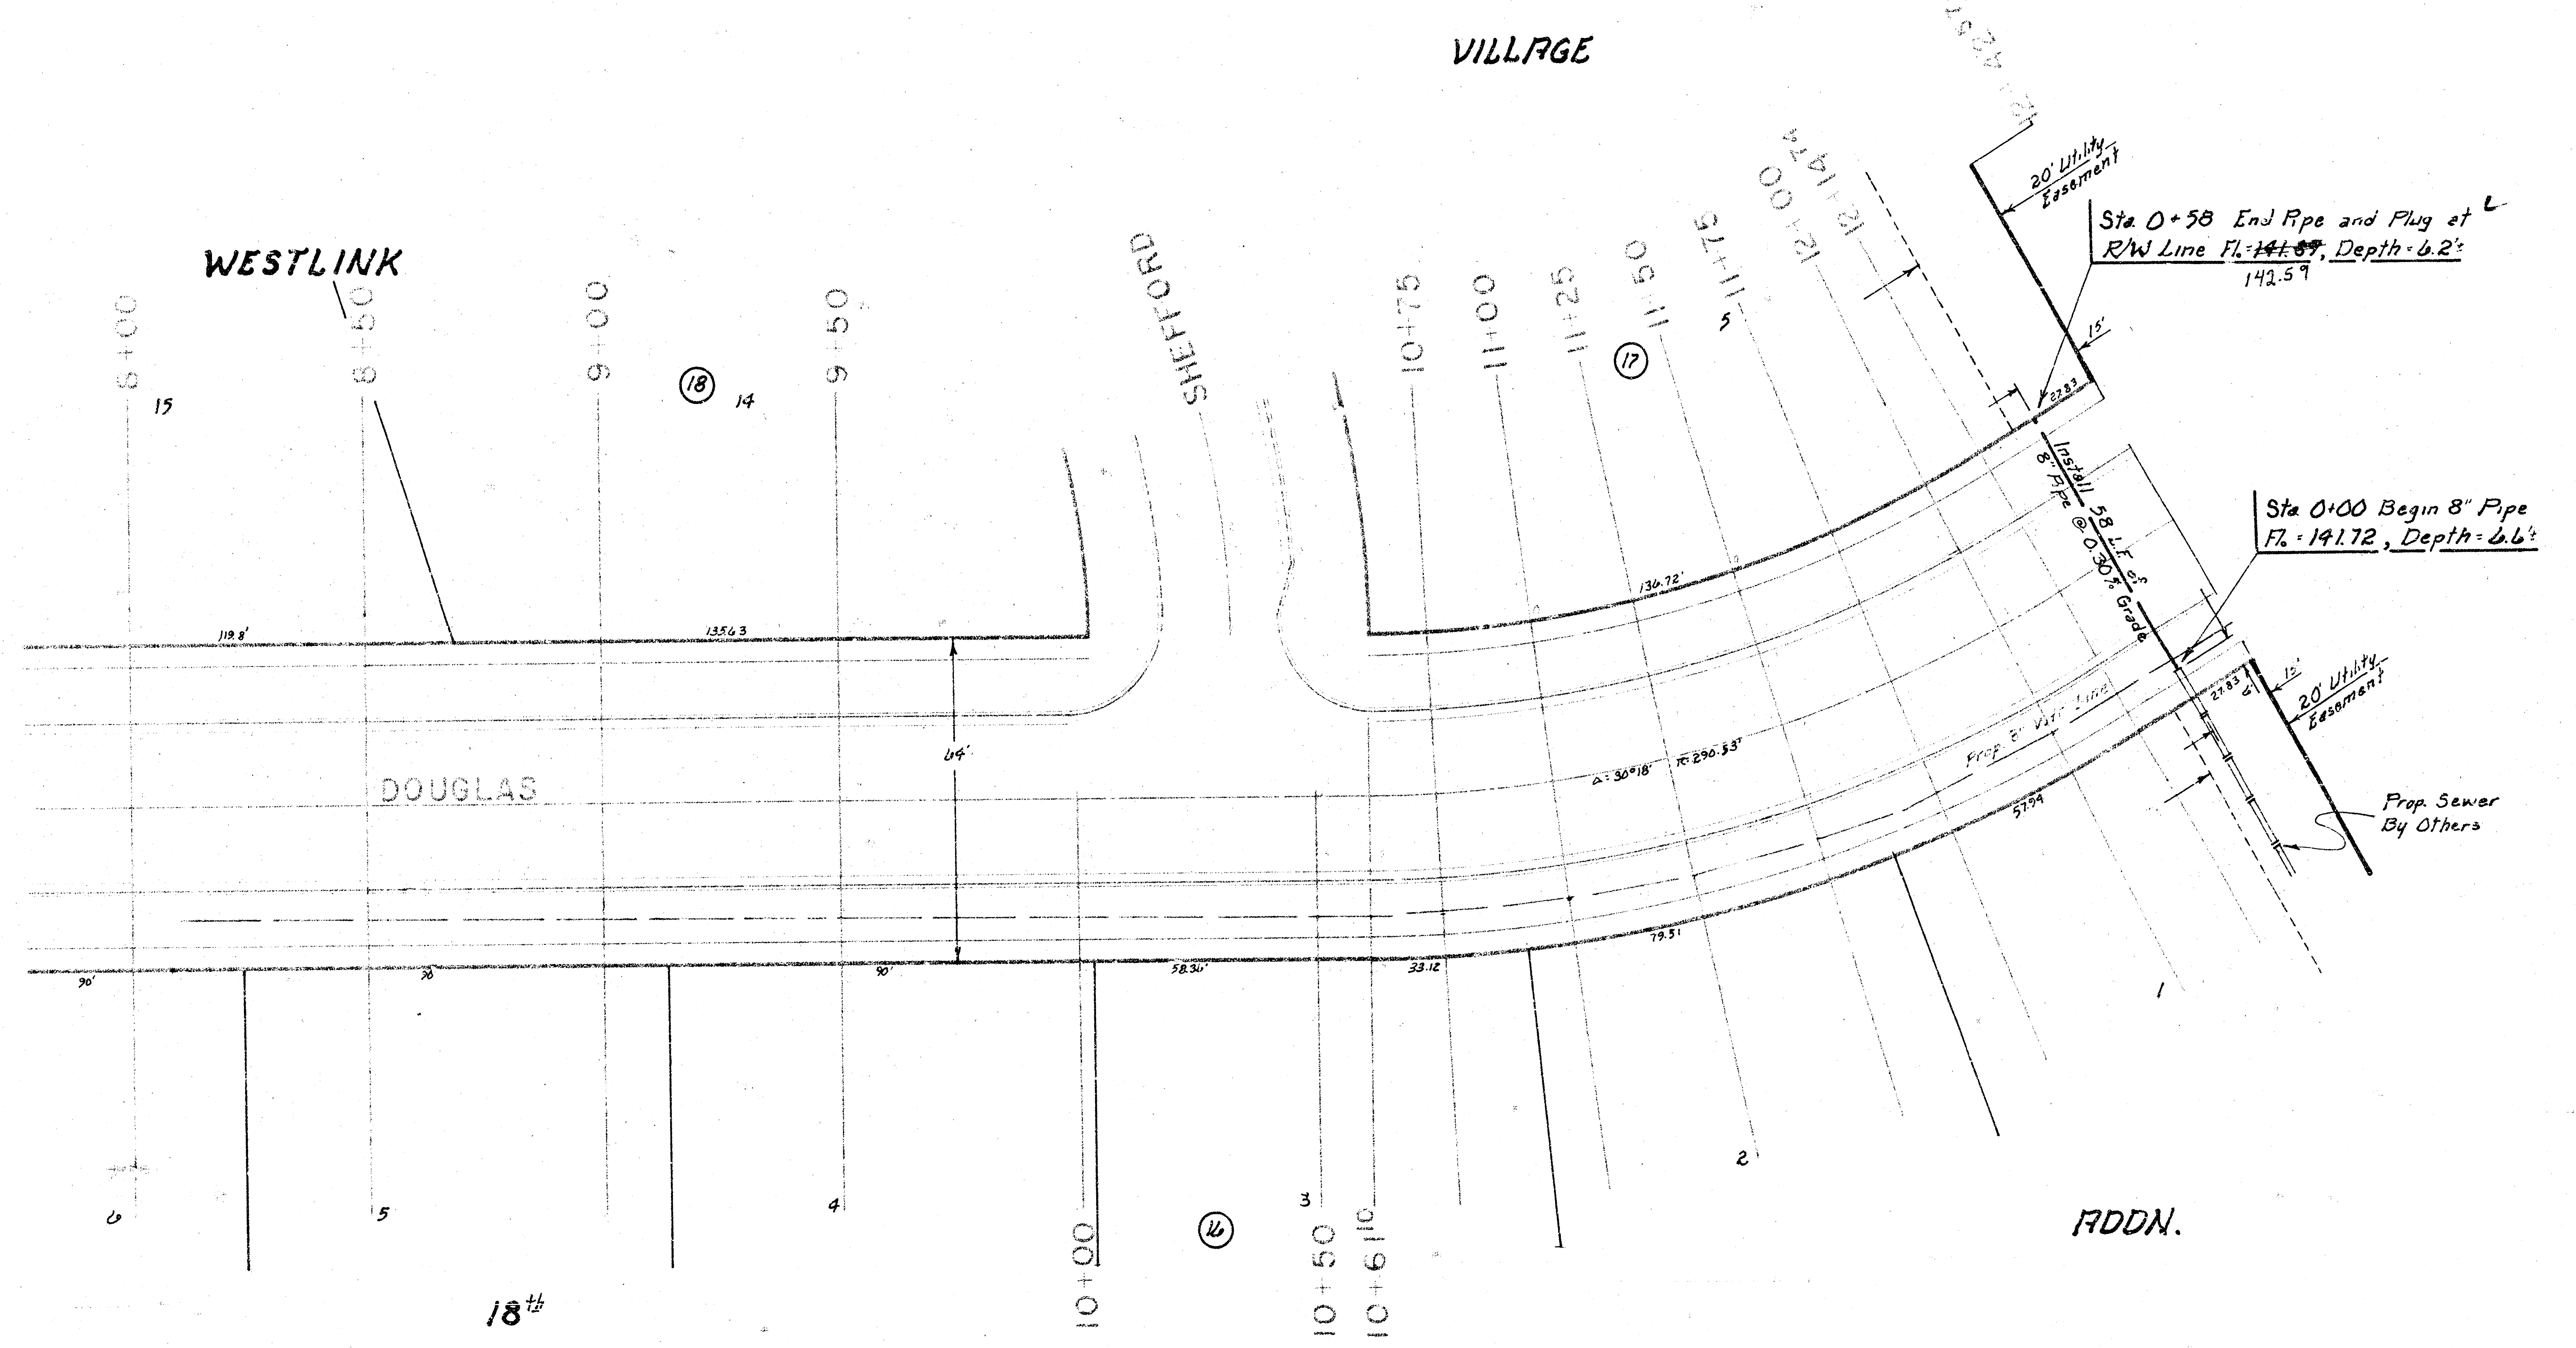


Phase I  
Lot 1, Main 7, Southwest Interceptor  
Proj. No. 468-76-295-80639-000 000-001







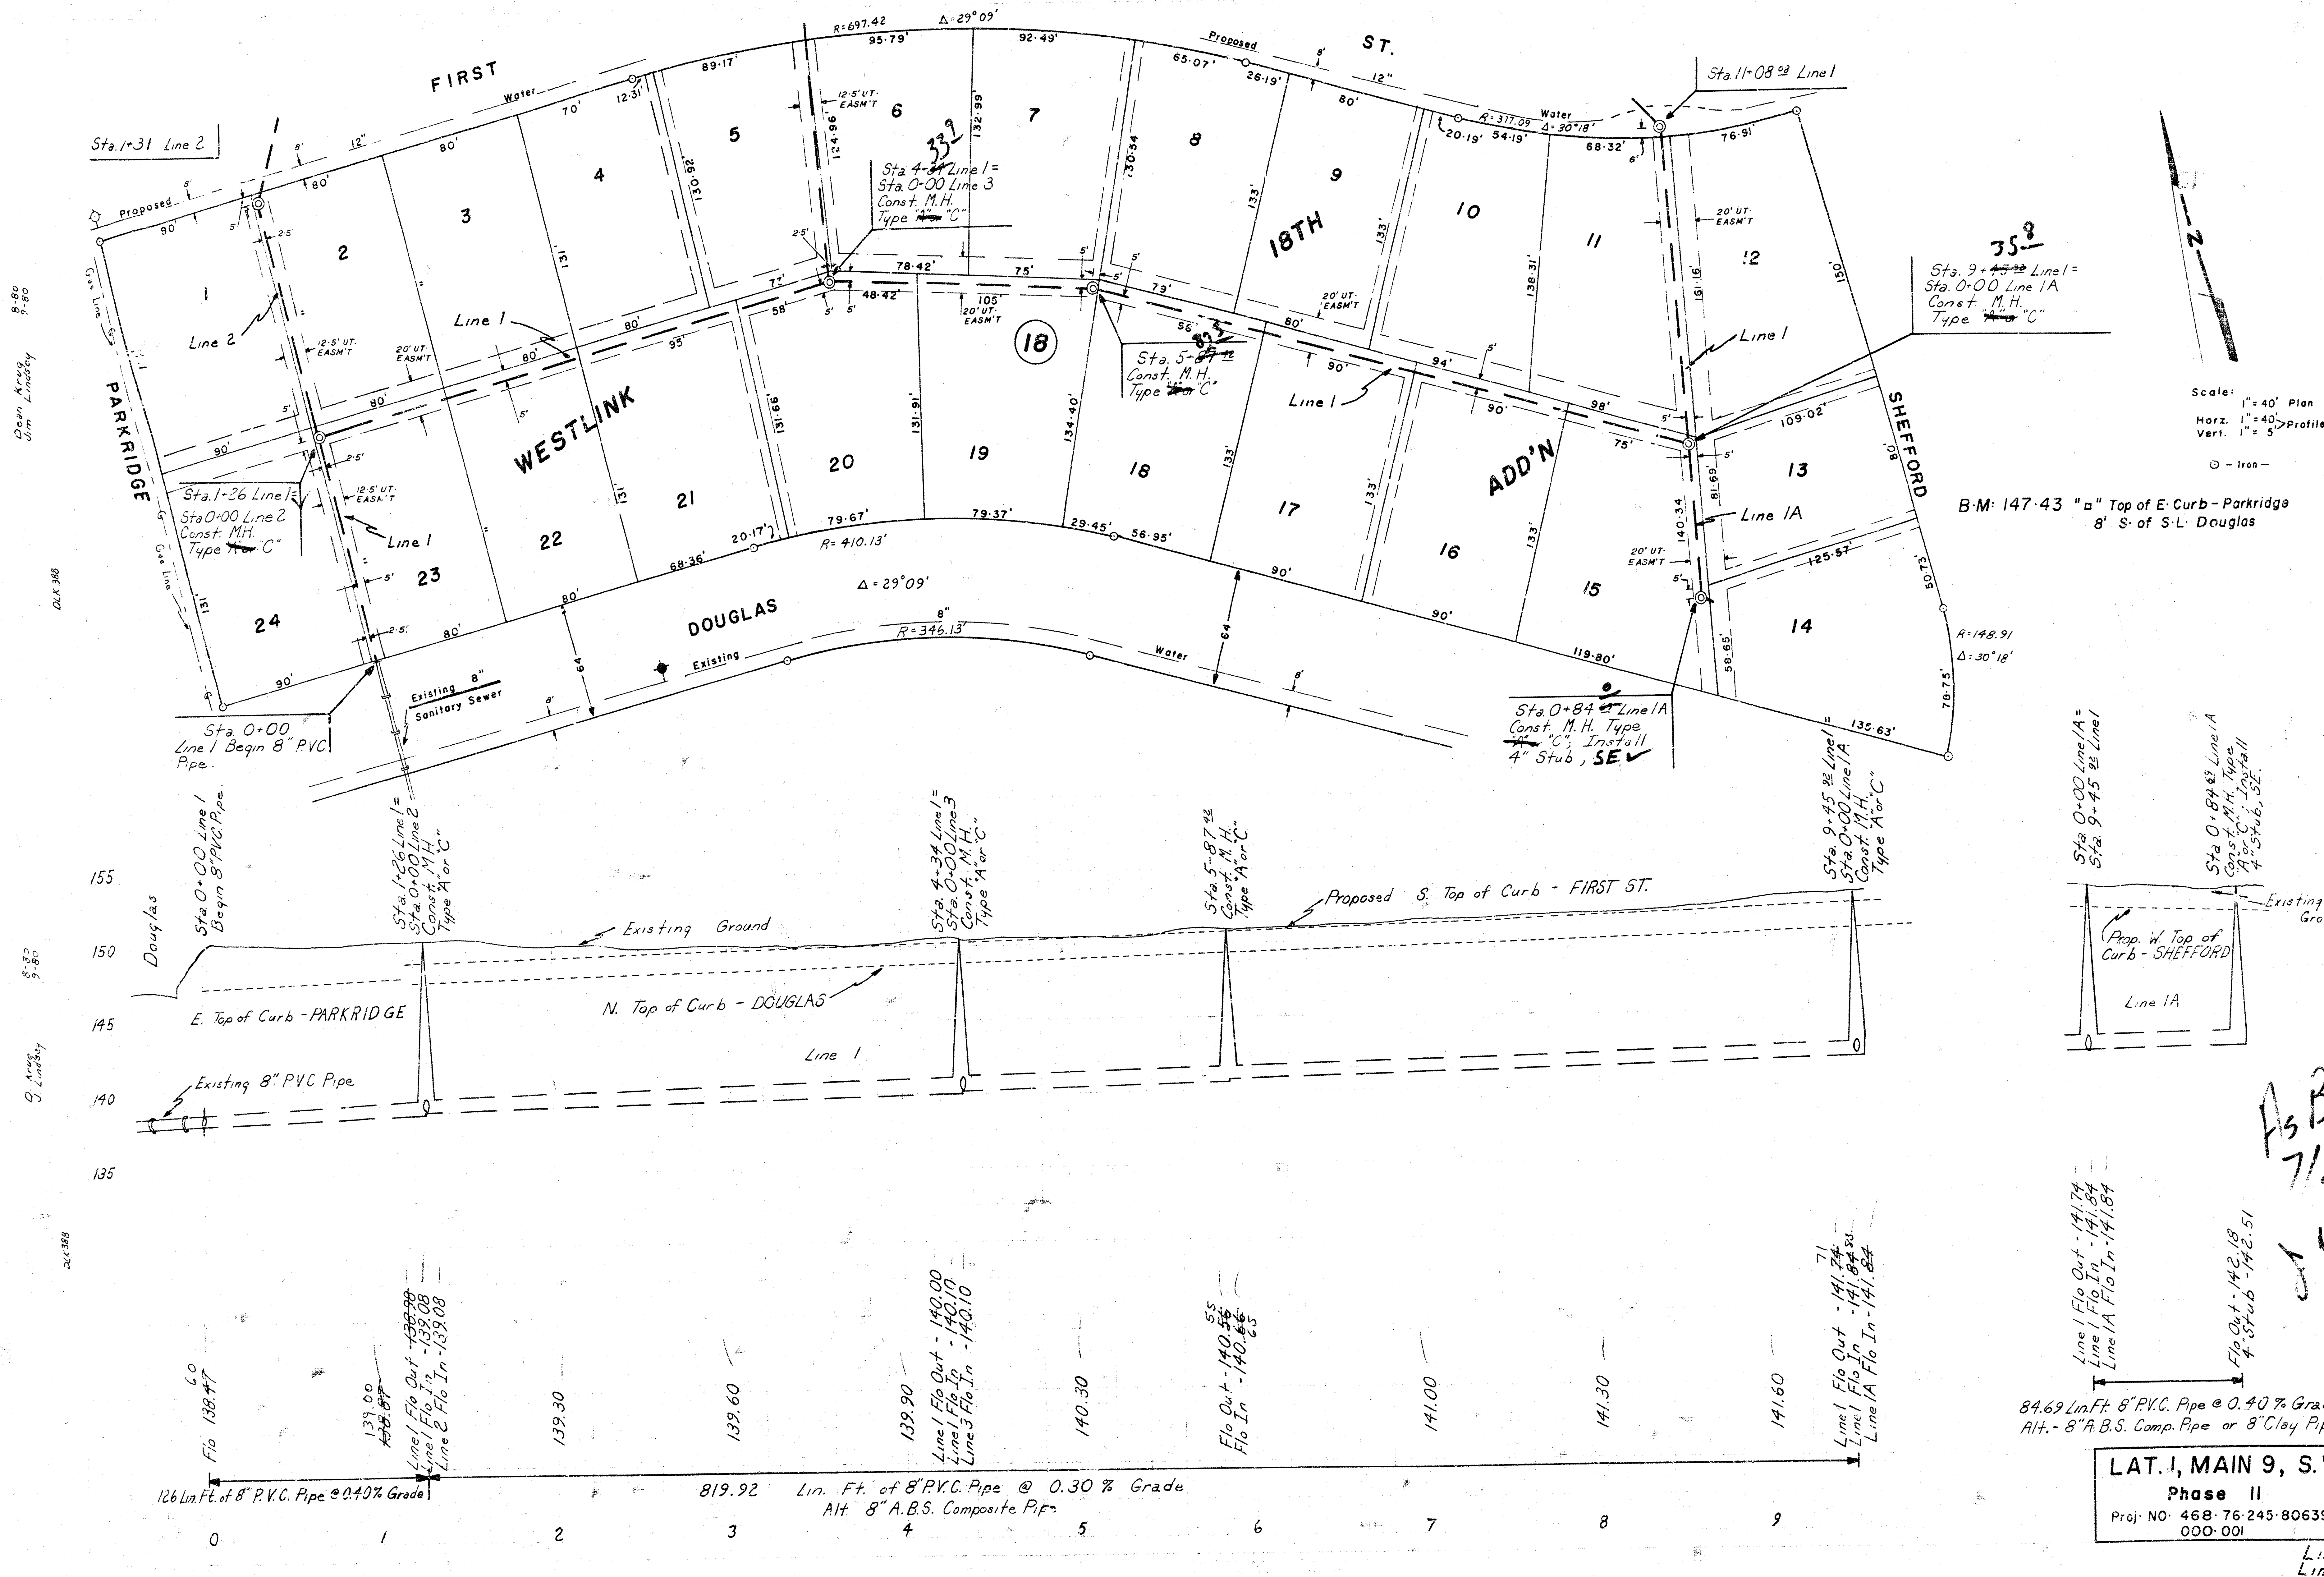

358





As Built  
7/91  
JSS

84.69 Lin. Ft. 8" P.V.C. Pipe @ 0.40% Grade  
Alt. - 8" A.B.S. Comp. Pipe or 8" Clay Pipe

LAT. I, MAIN 9, S.W. I.  
Phase II  
Proj. NO. 468-76-245-80639-000-000-001

Line 1  
Line 1A



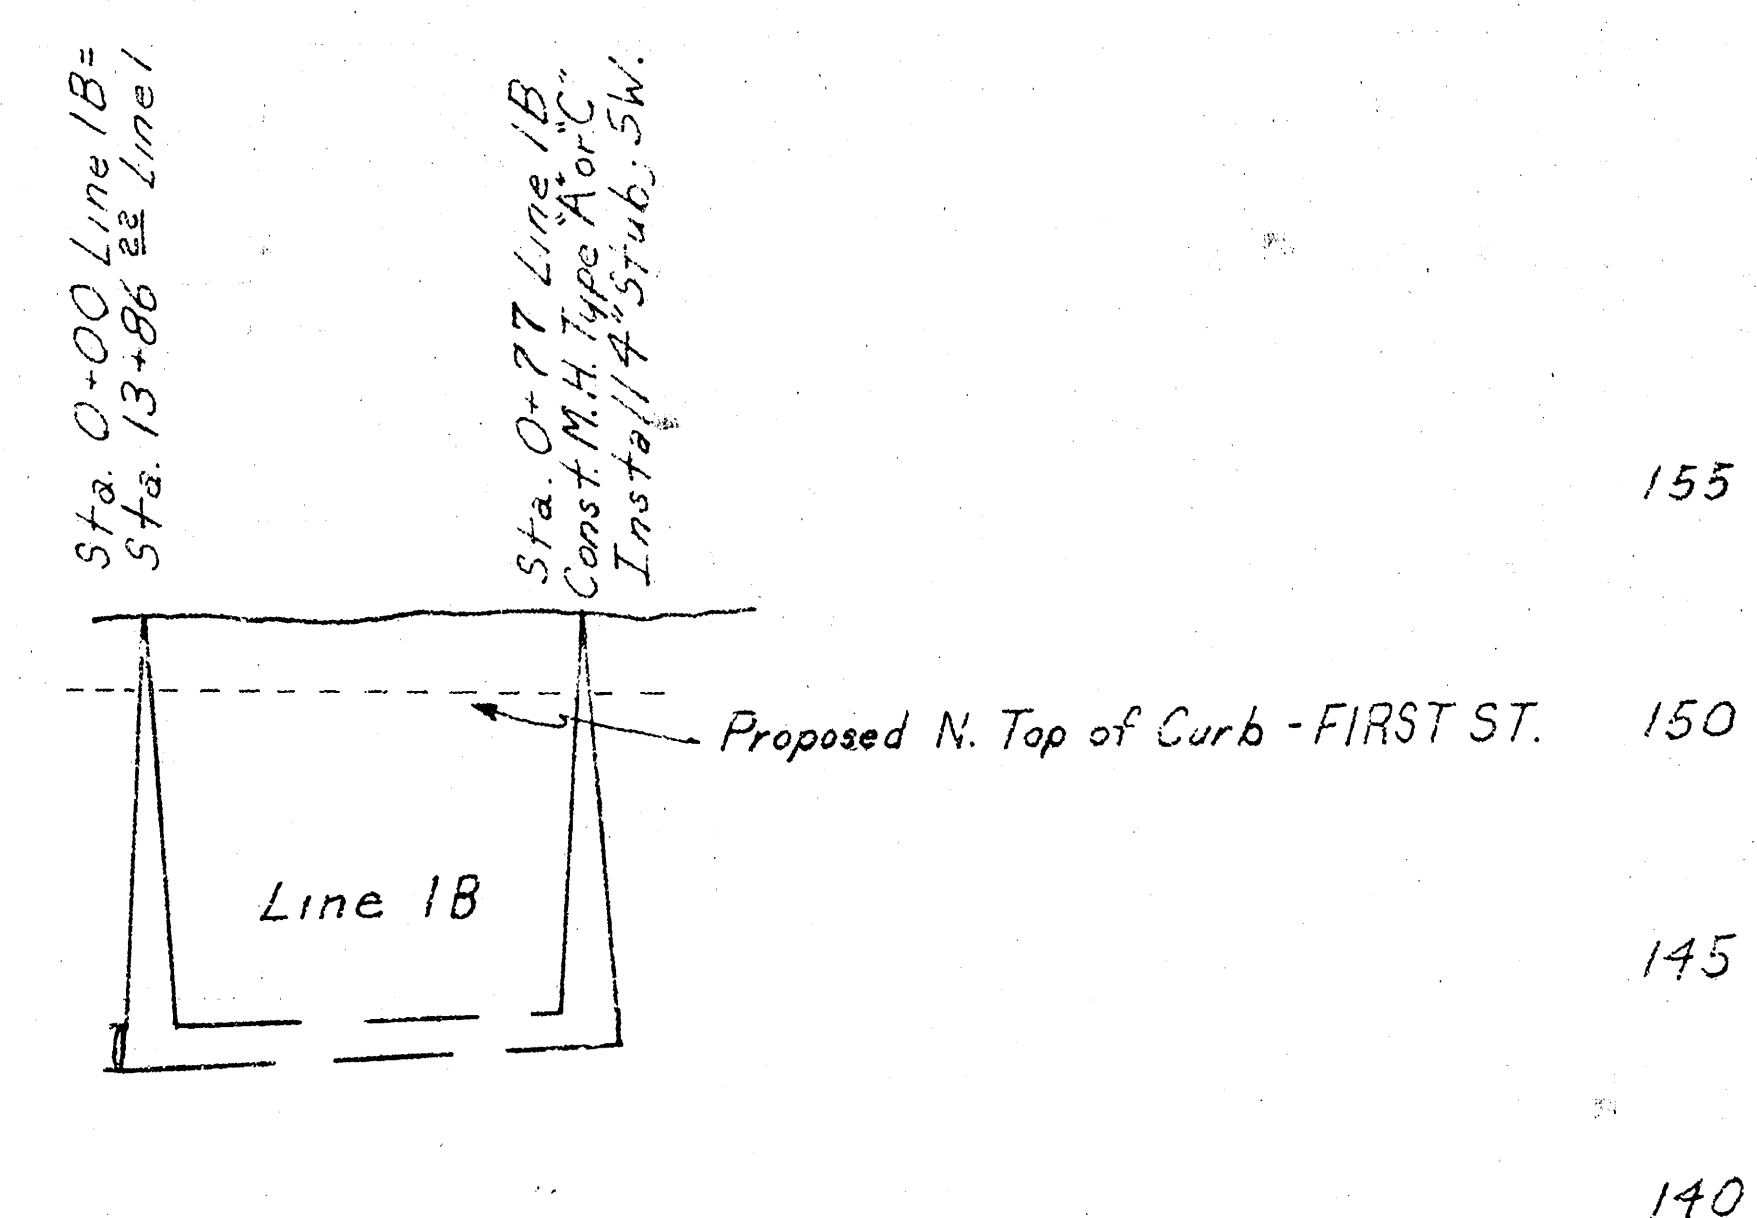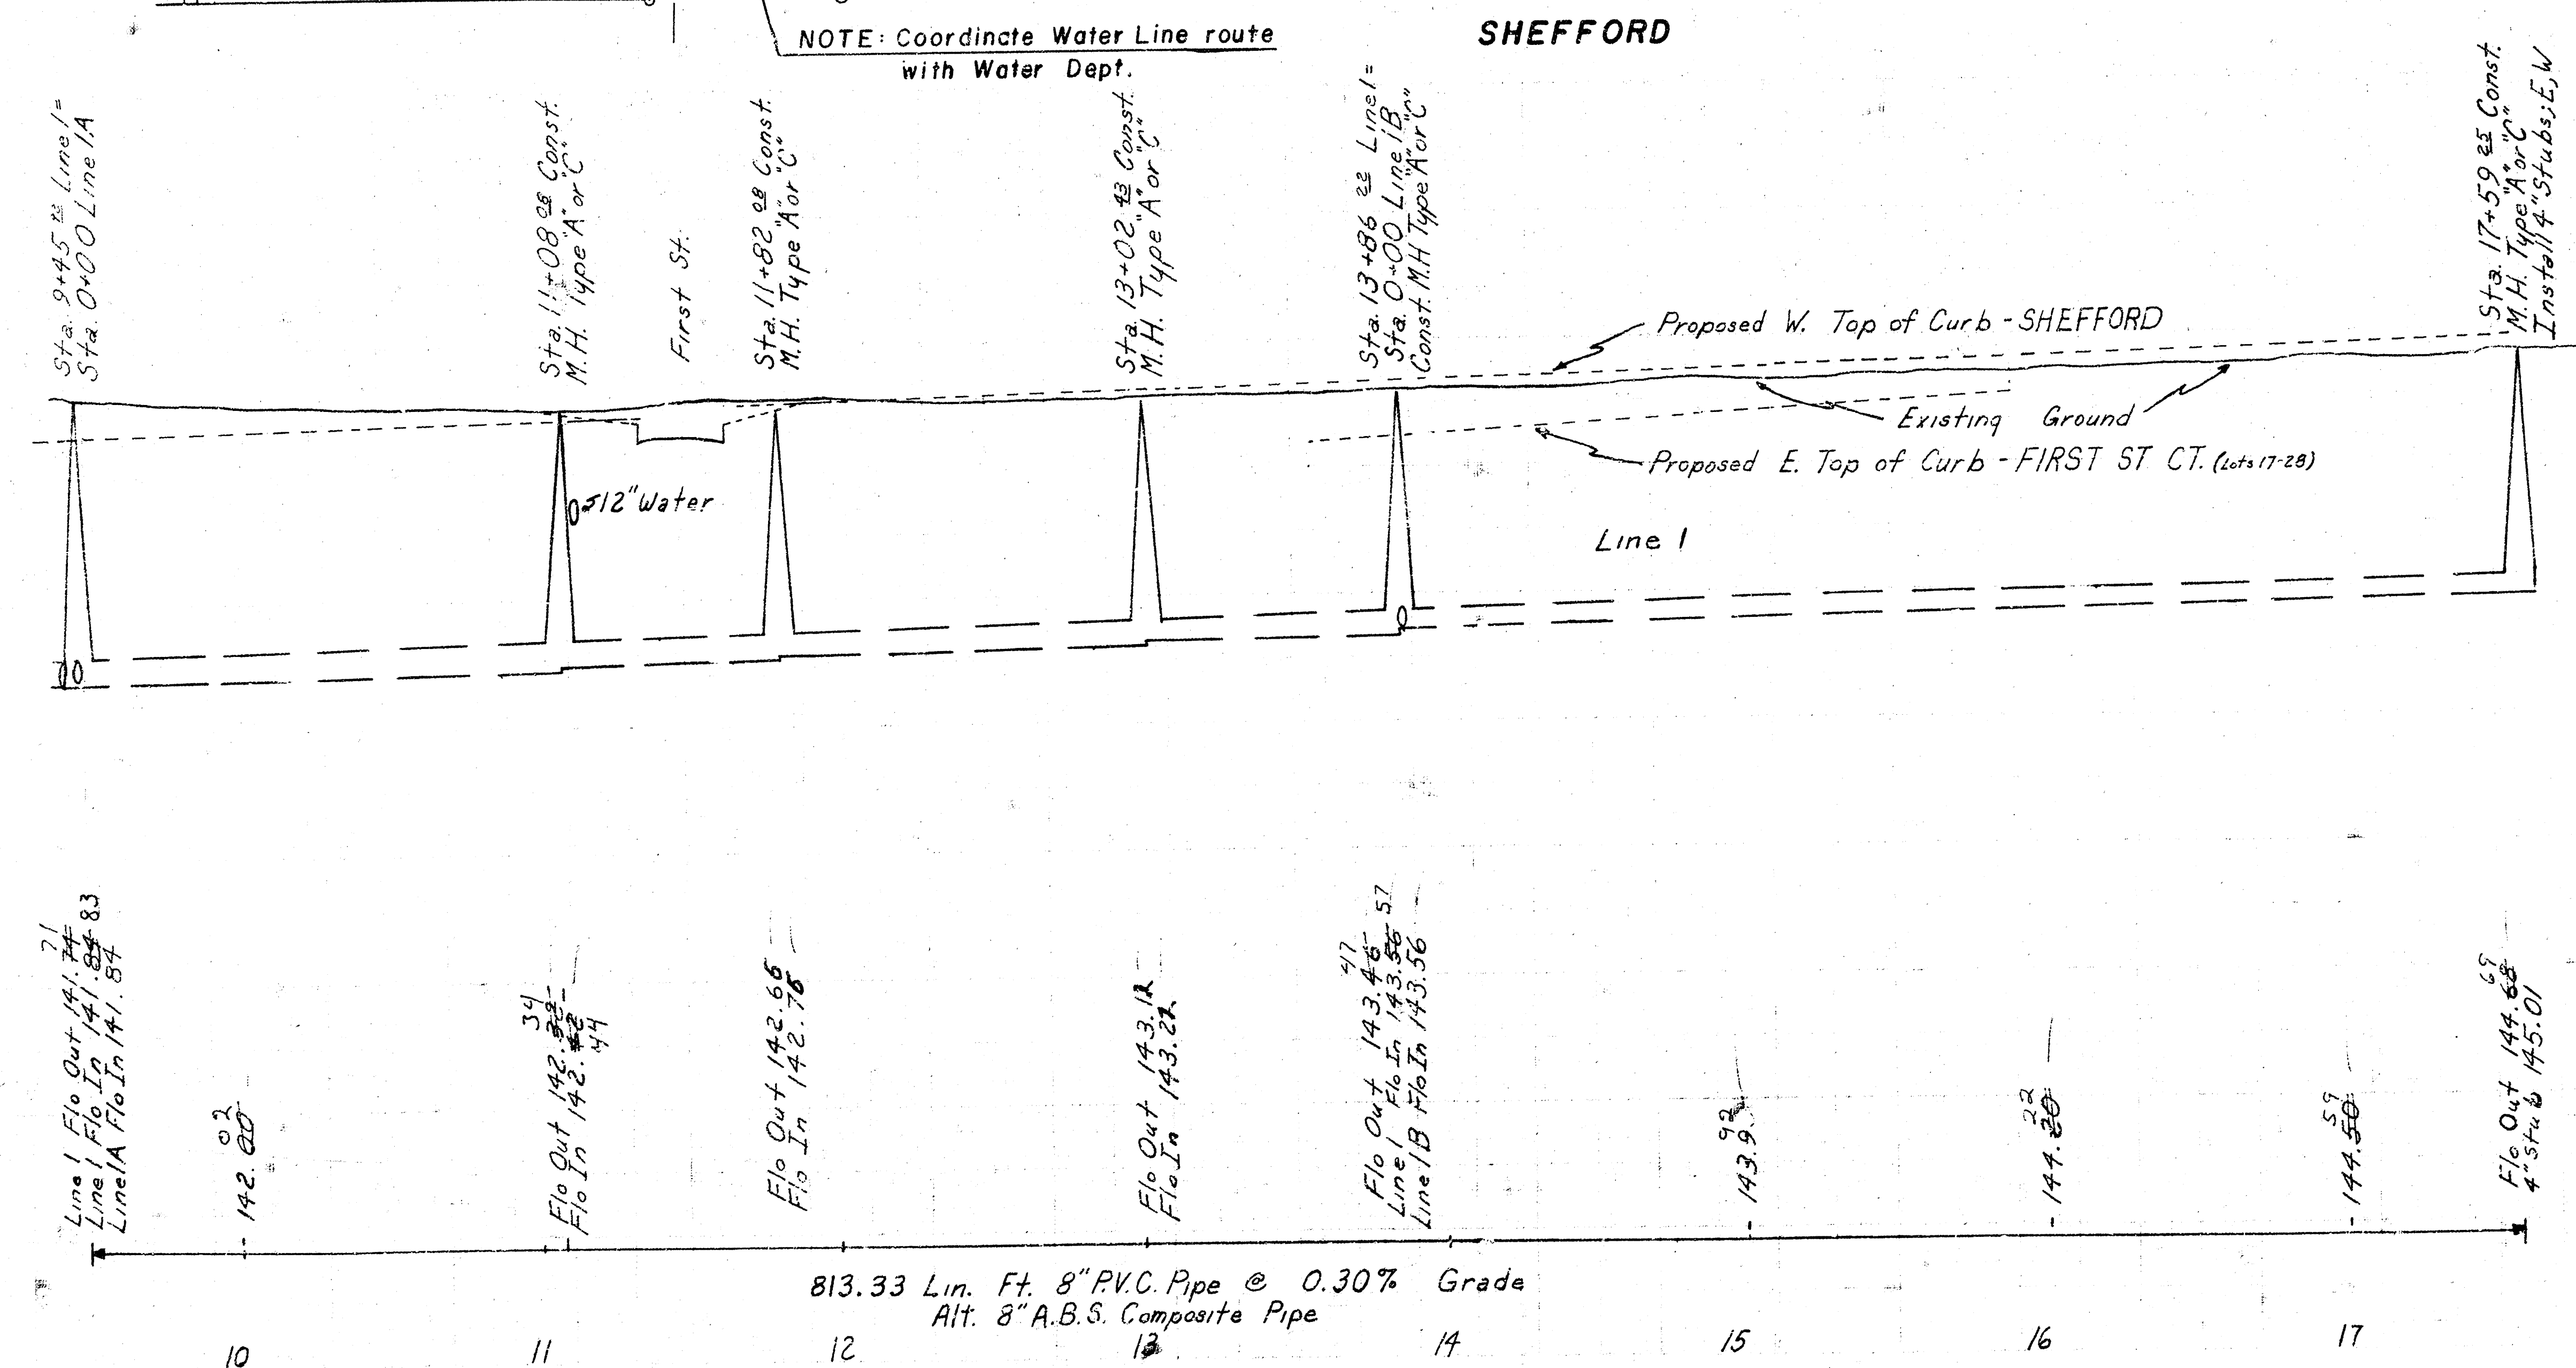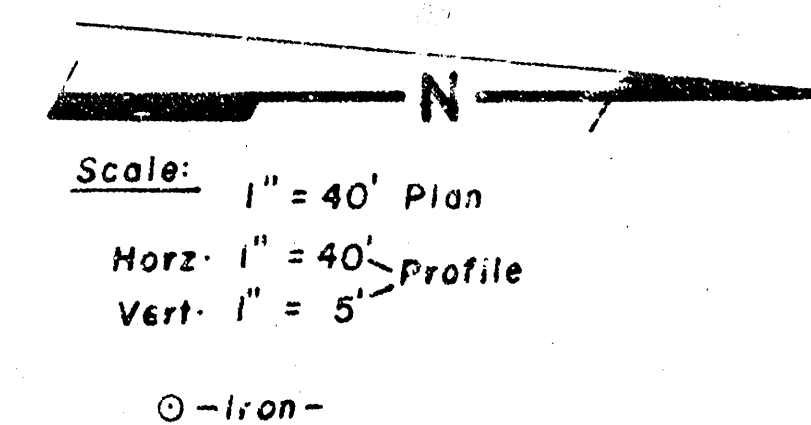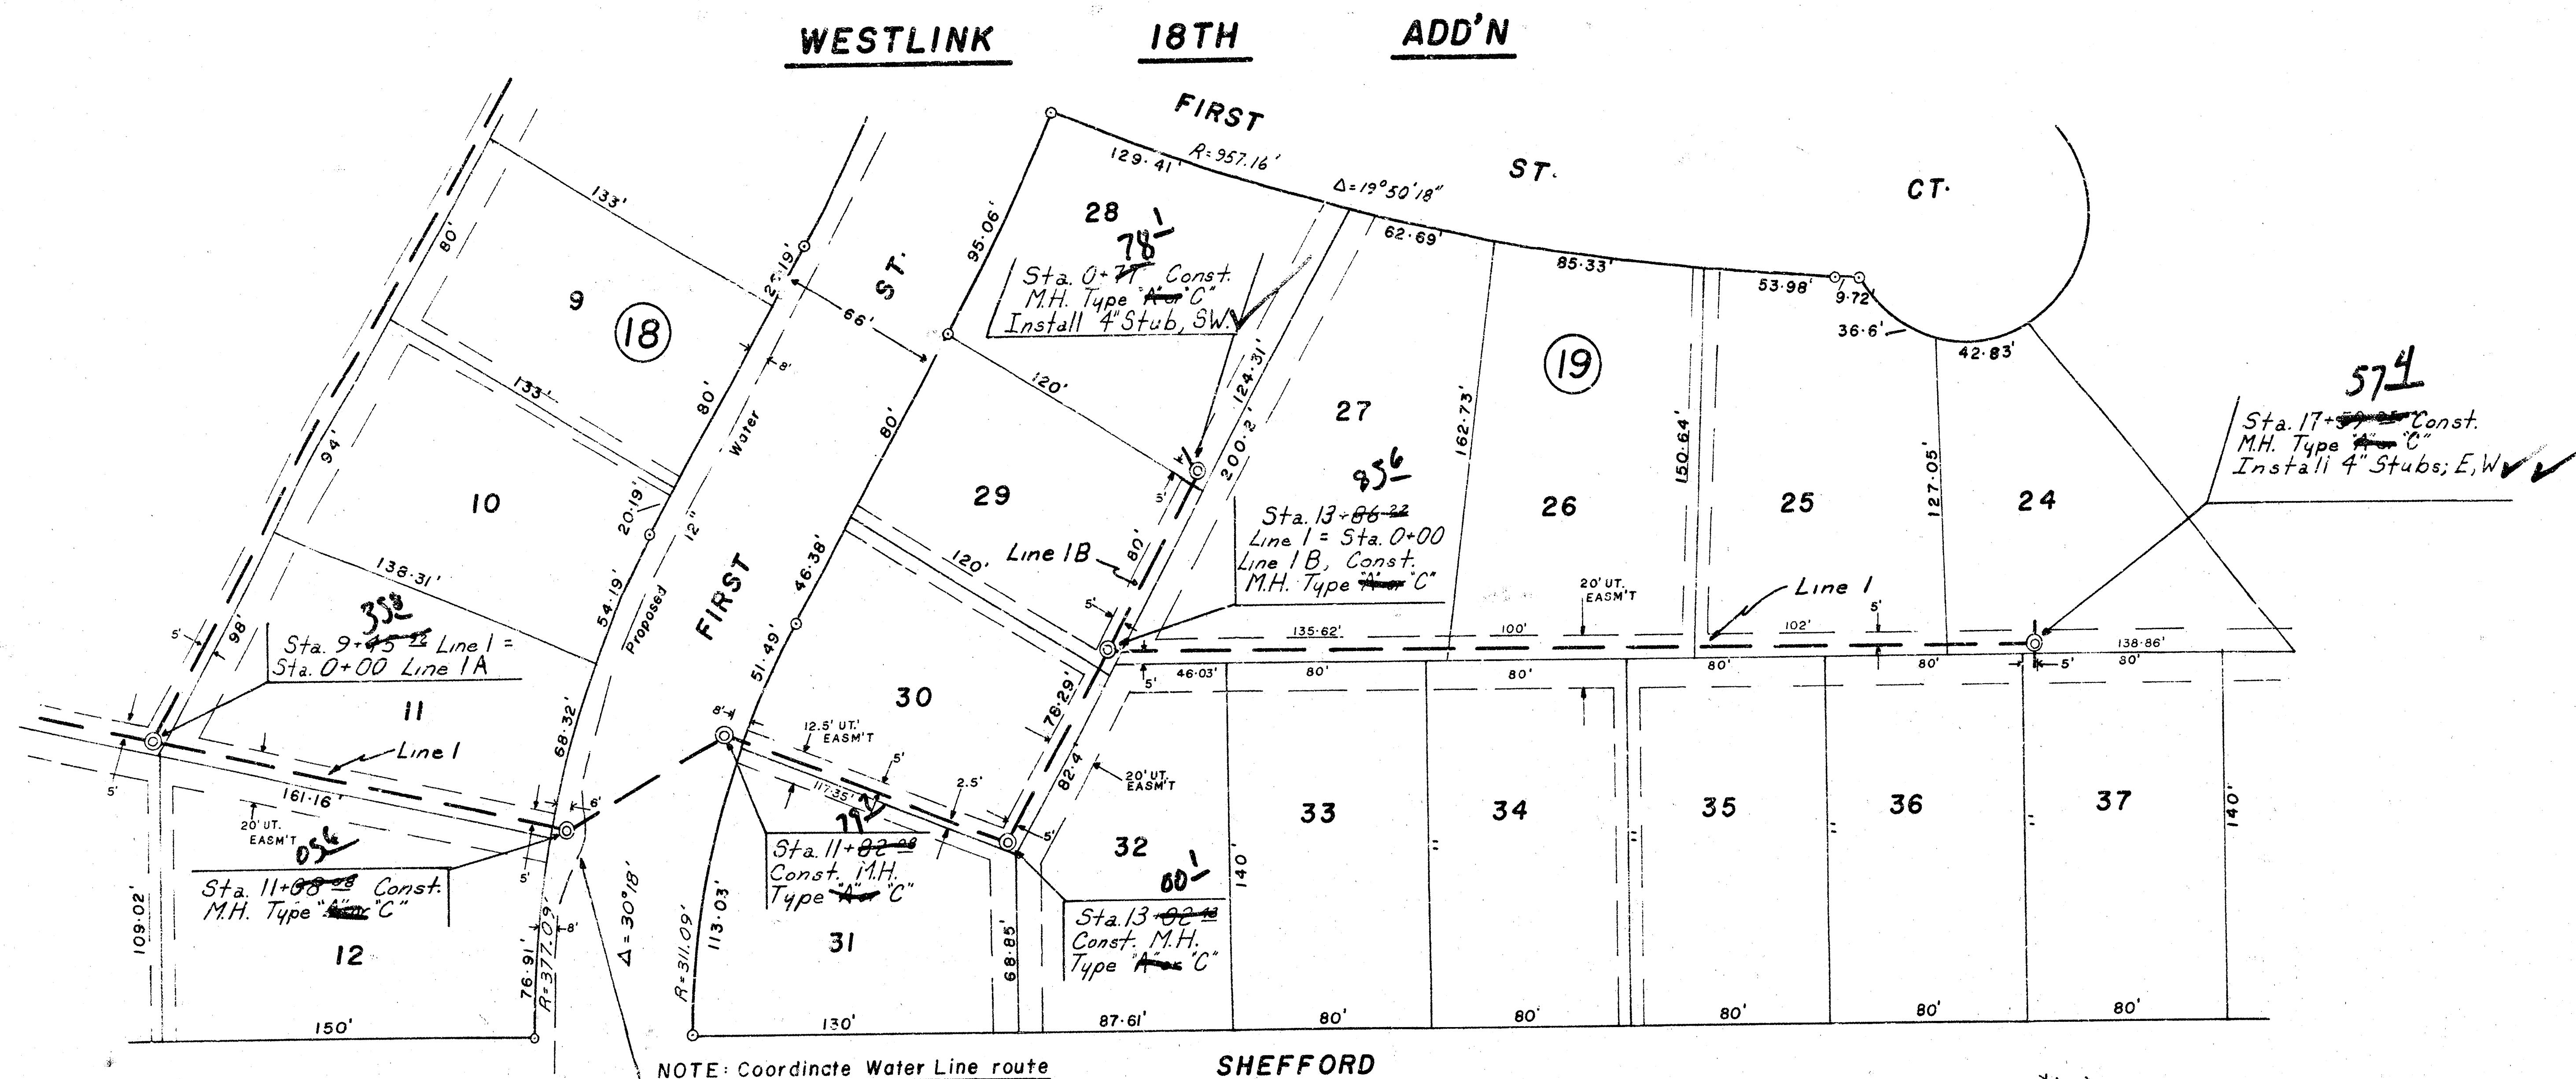

As Built  
 7/8/1  
 ggg

77 Lin. Ft. of 8" PVC Pipe @ 0.40% Grade  
 Alt. 8" A.B.S. Composite Pipe or 8" Clay Pipe








**LAT. 1, MAIN 9, S. W. 1.**  
**Phase II**  
 Proj. NO. 468-76-245-80639-000  
 000-001

Line 1  
 Line 1B



LINE 2


LINE 3

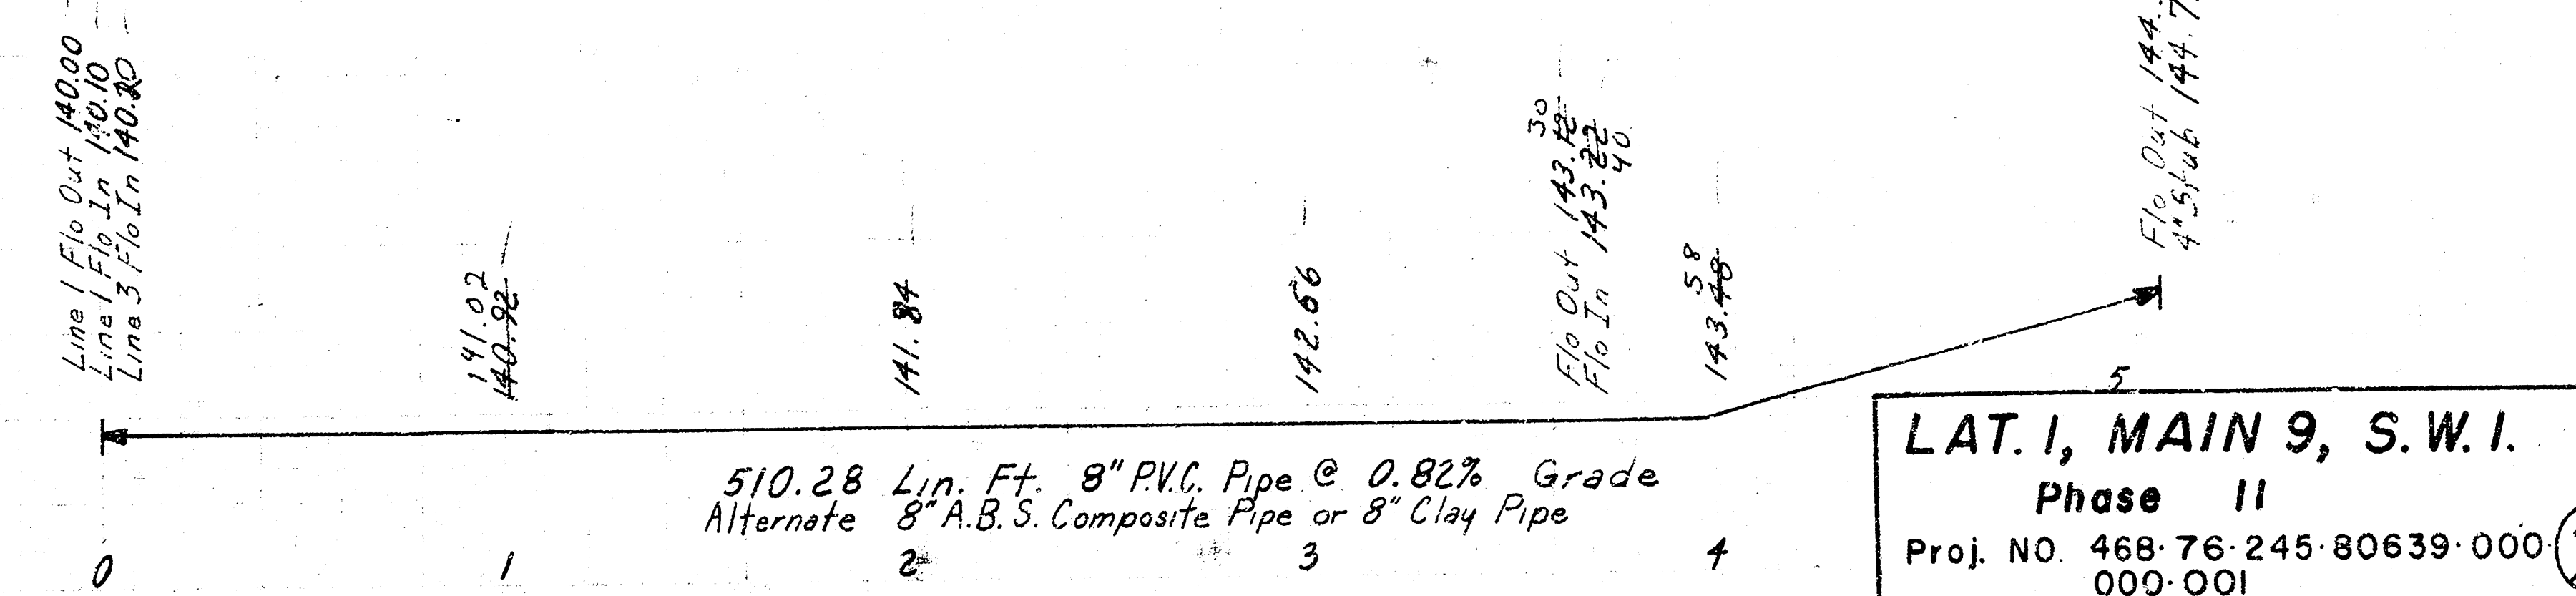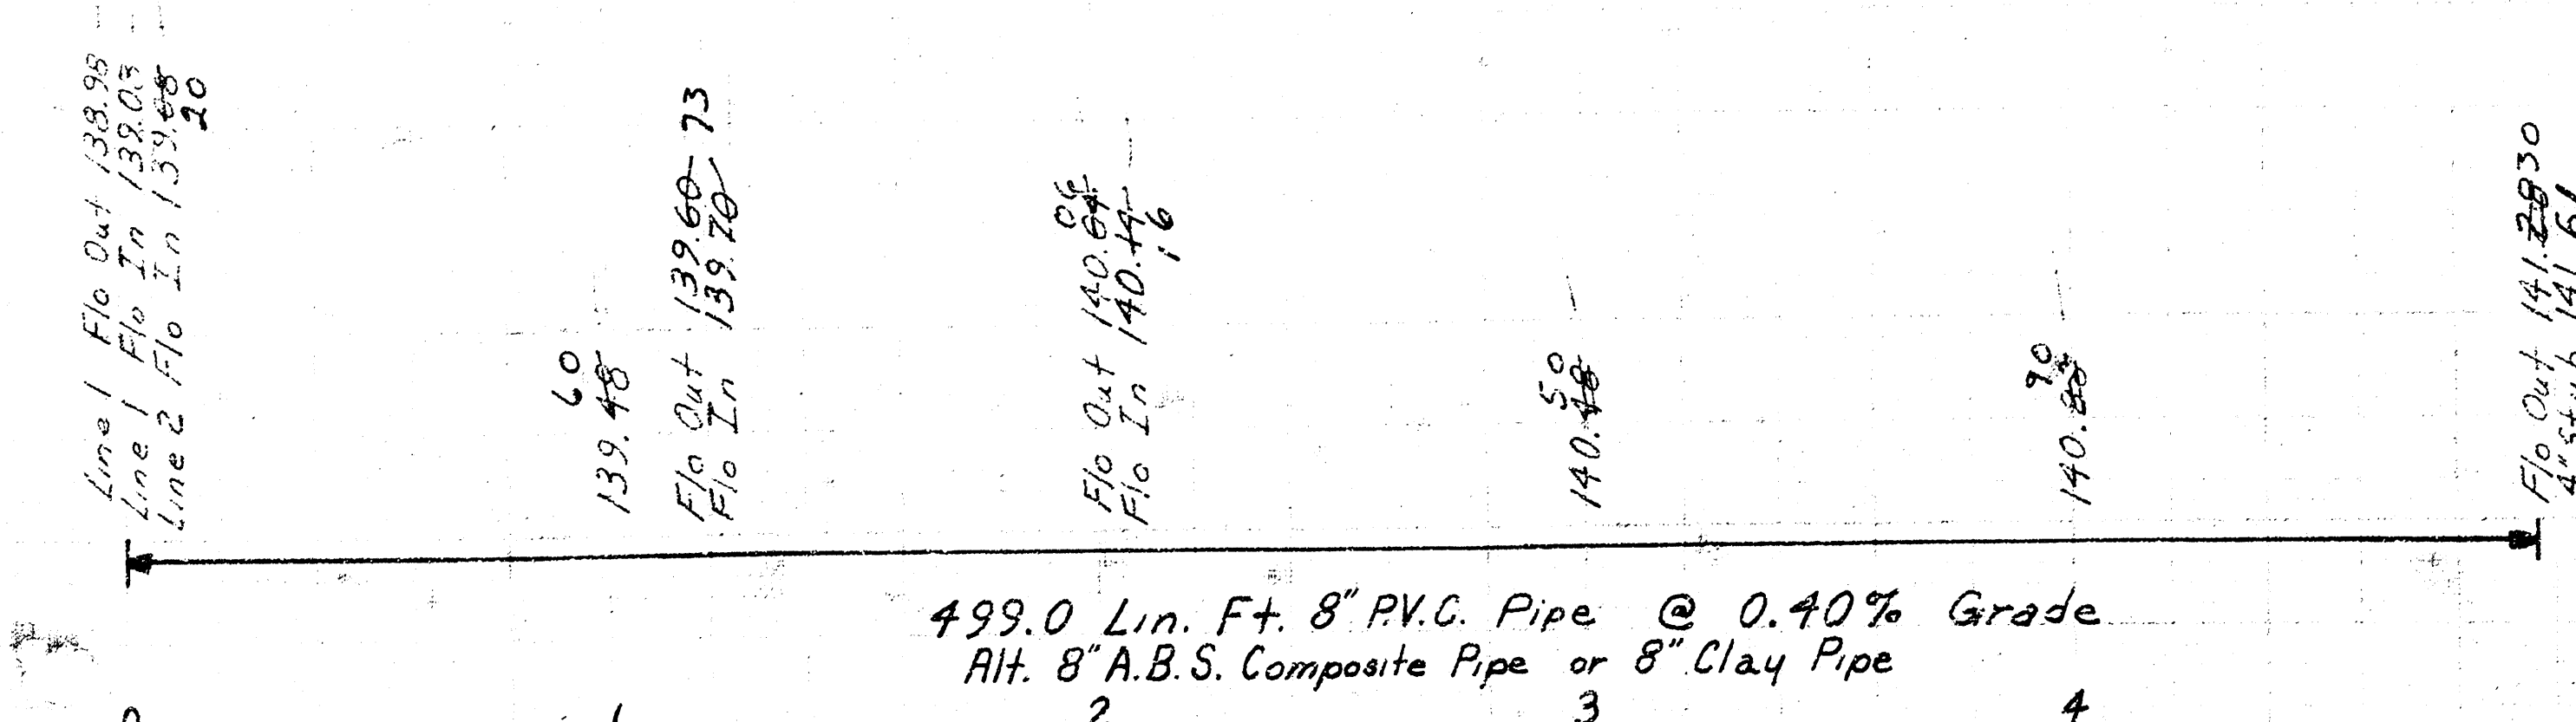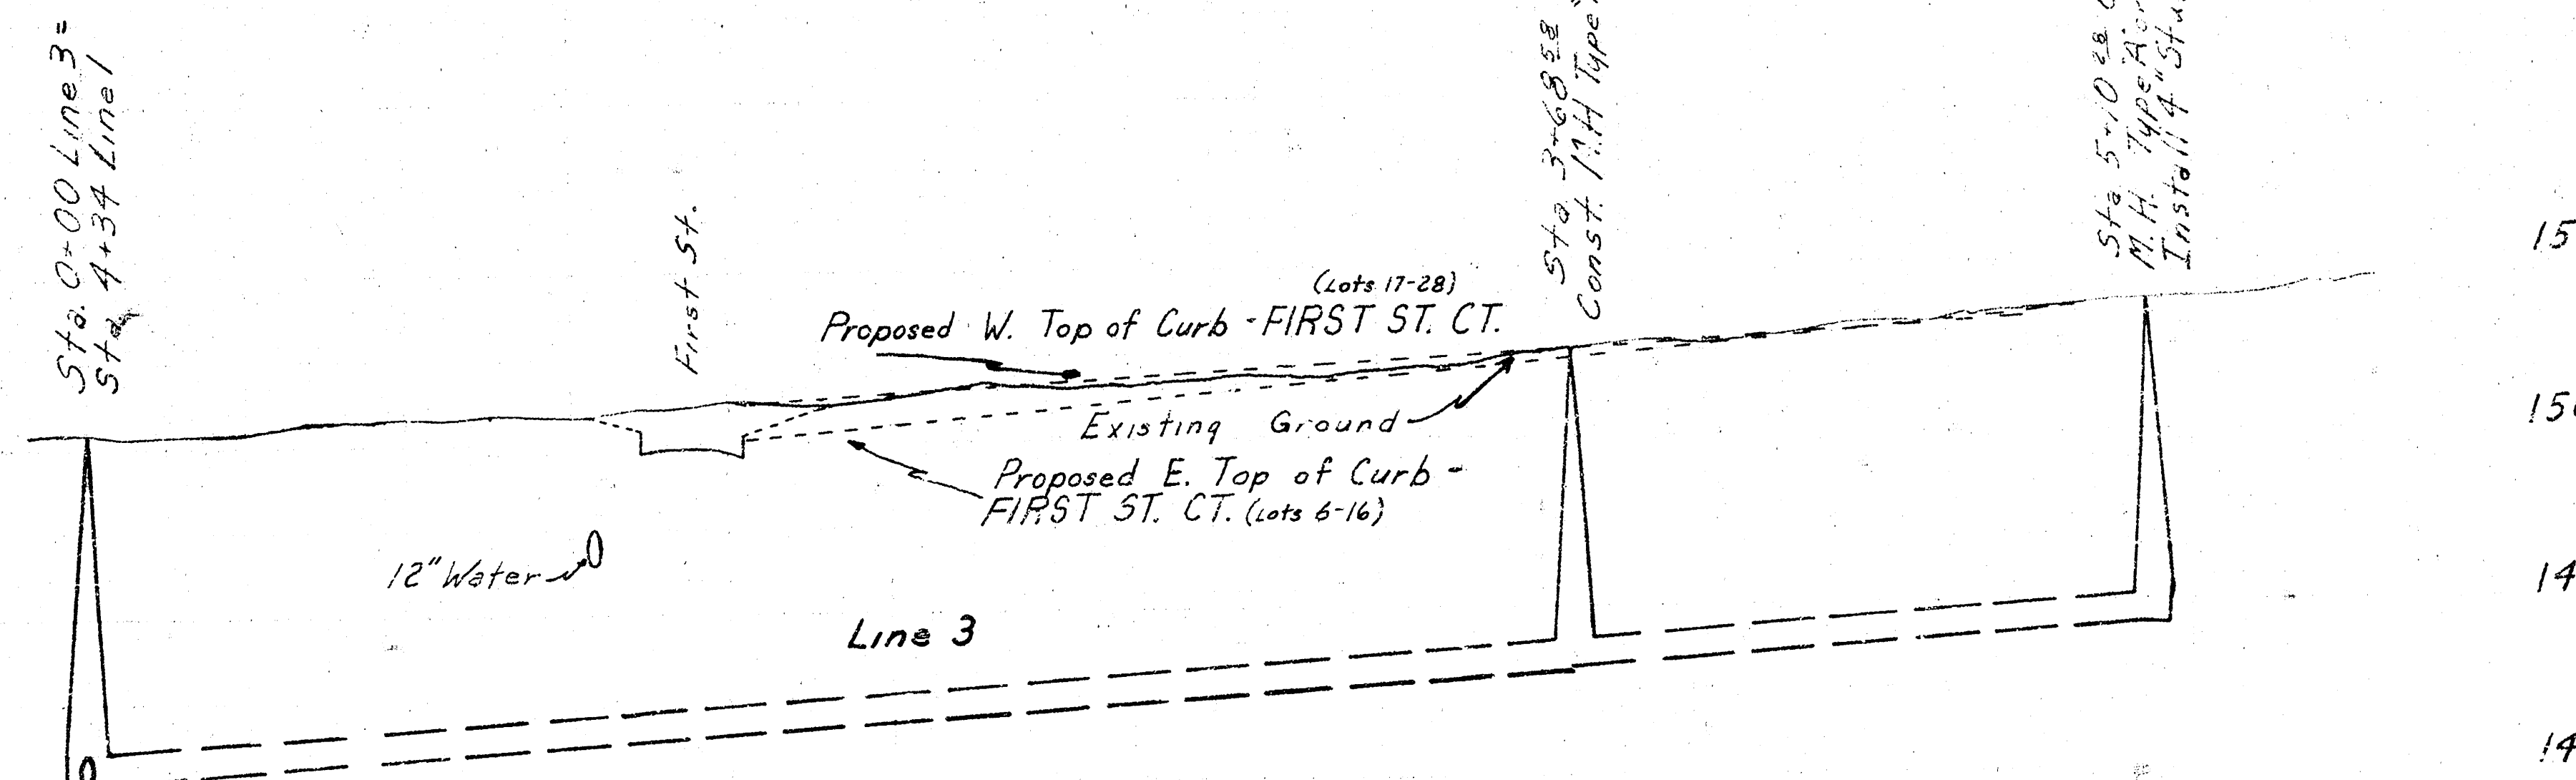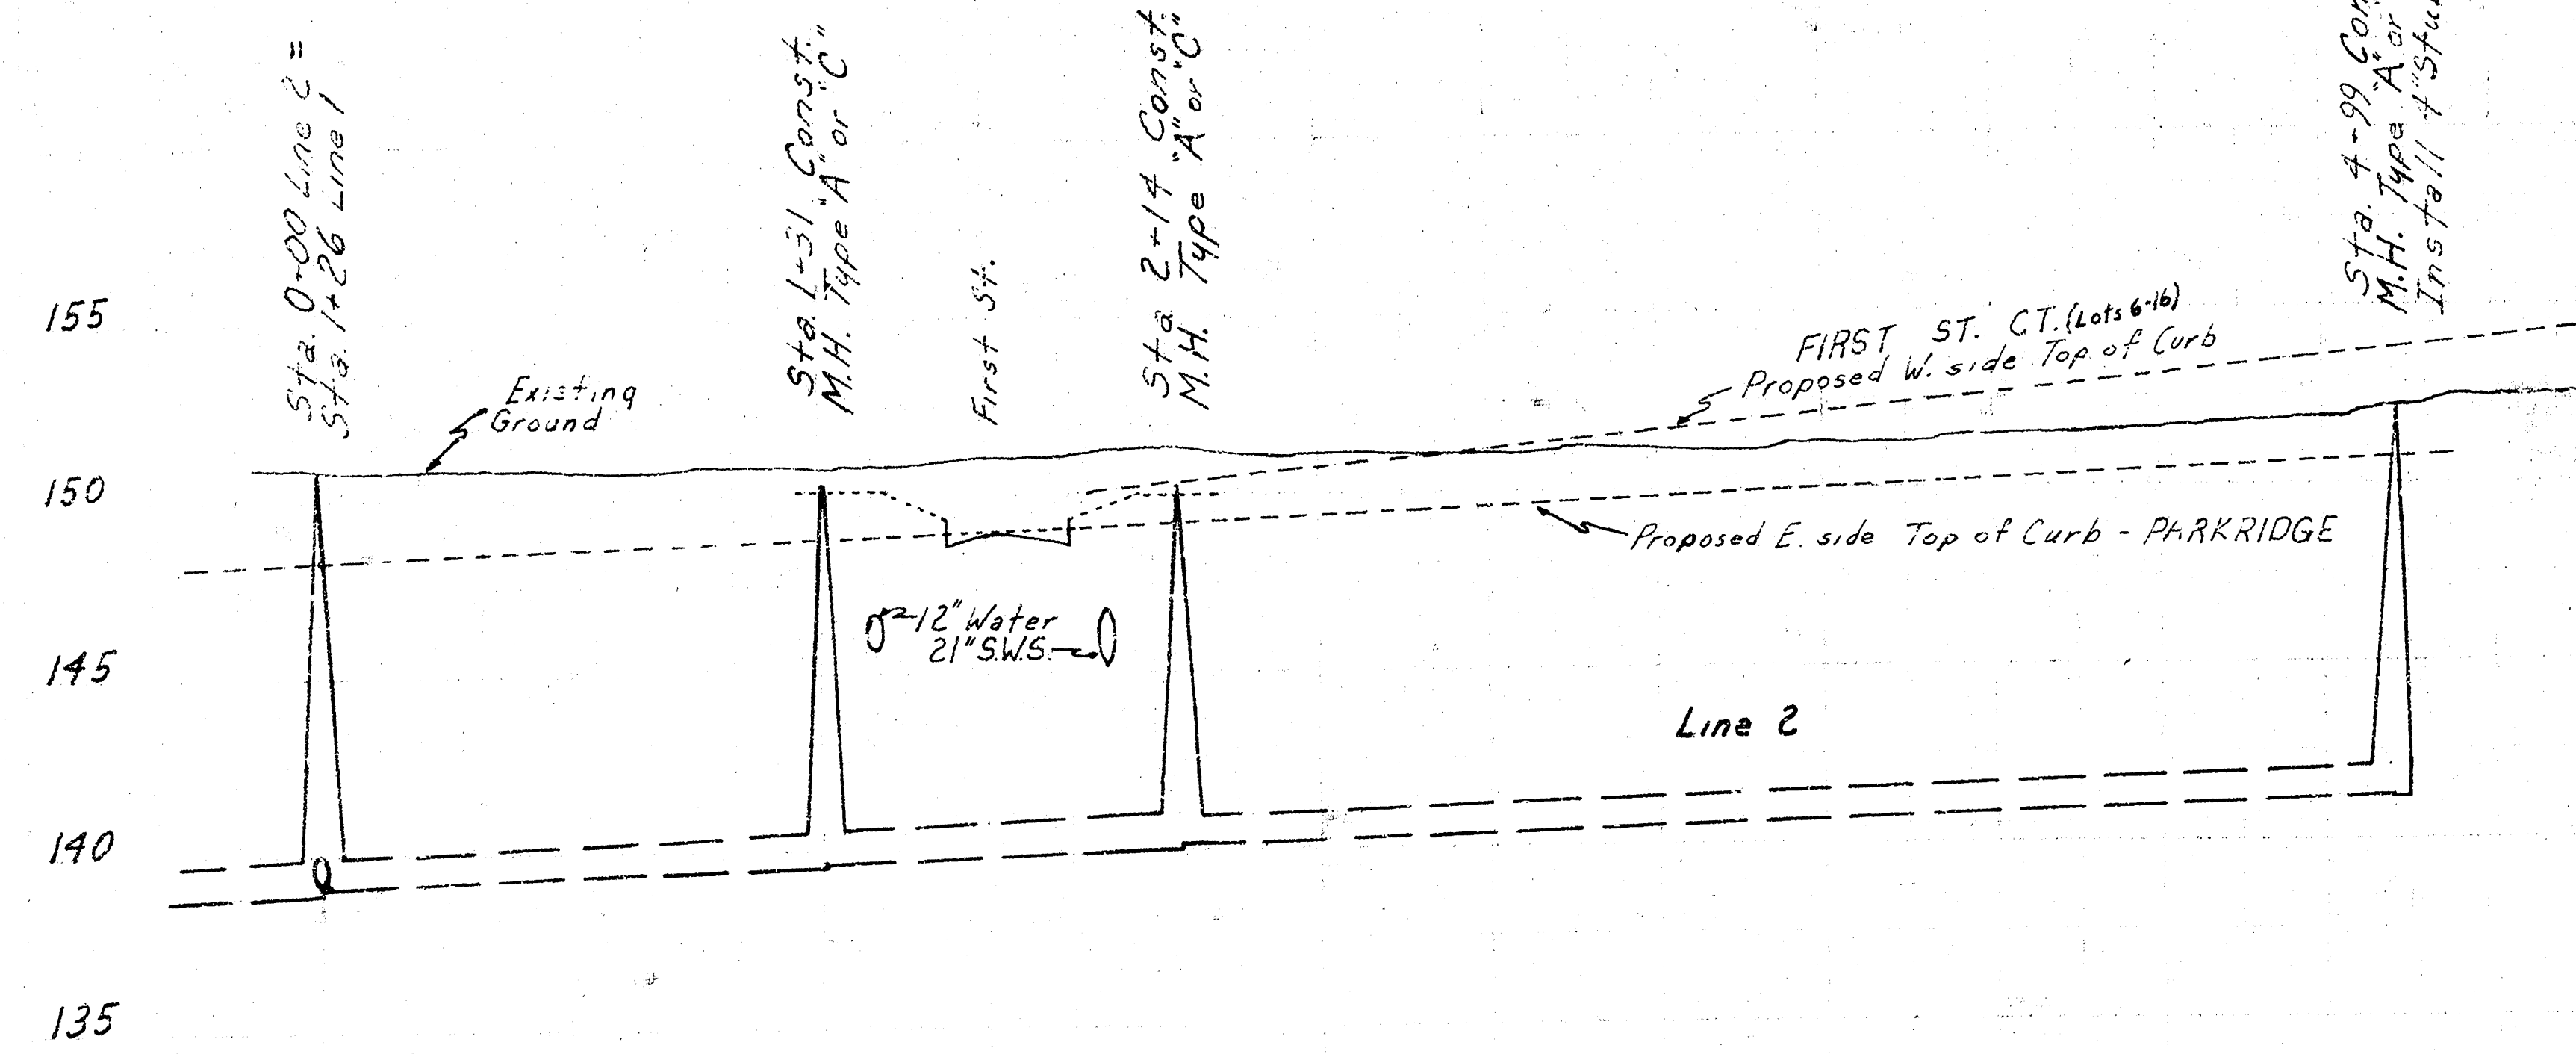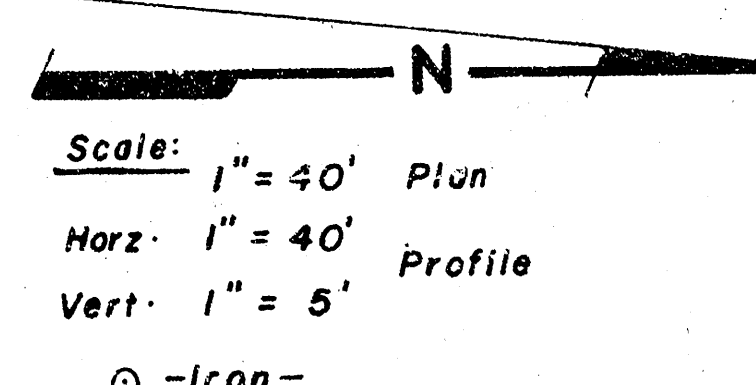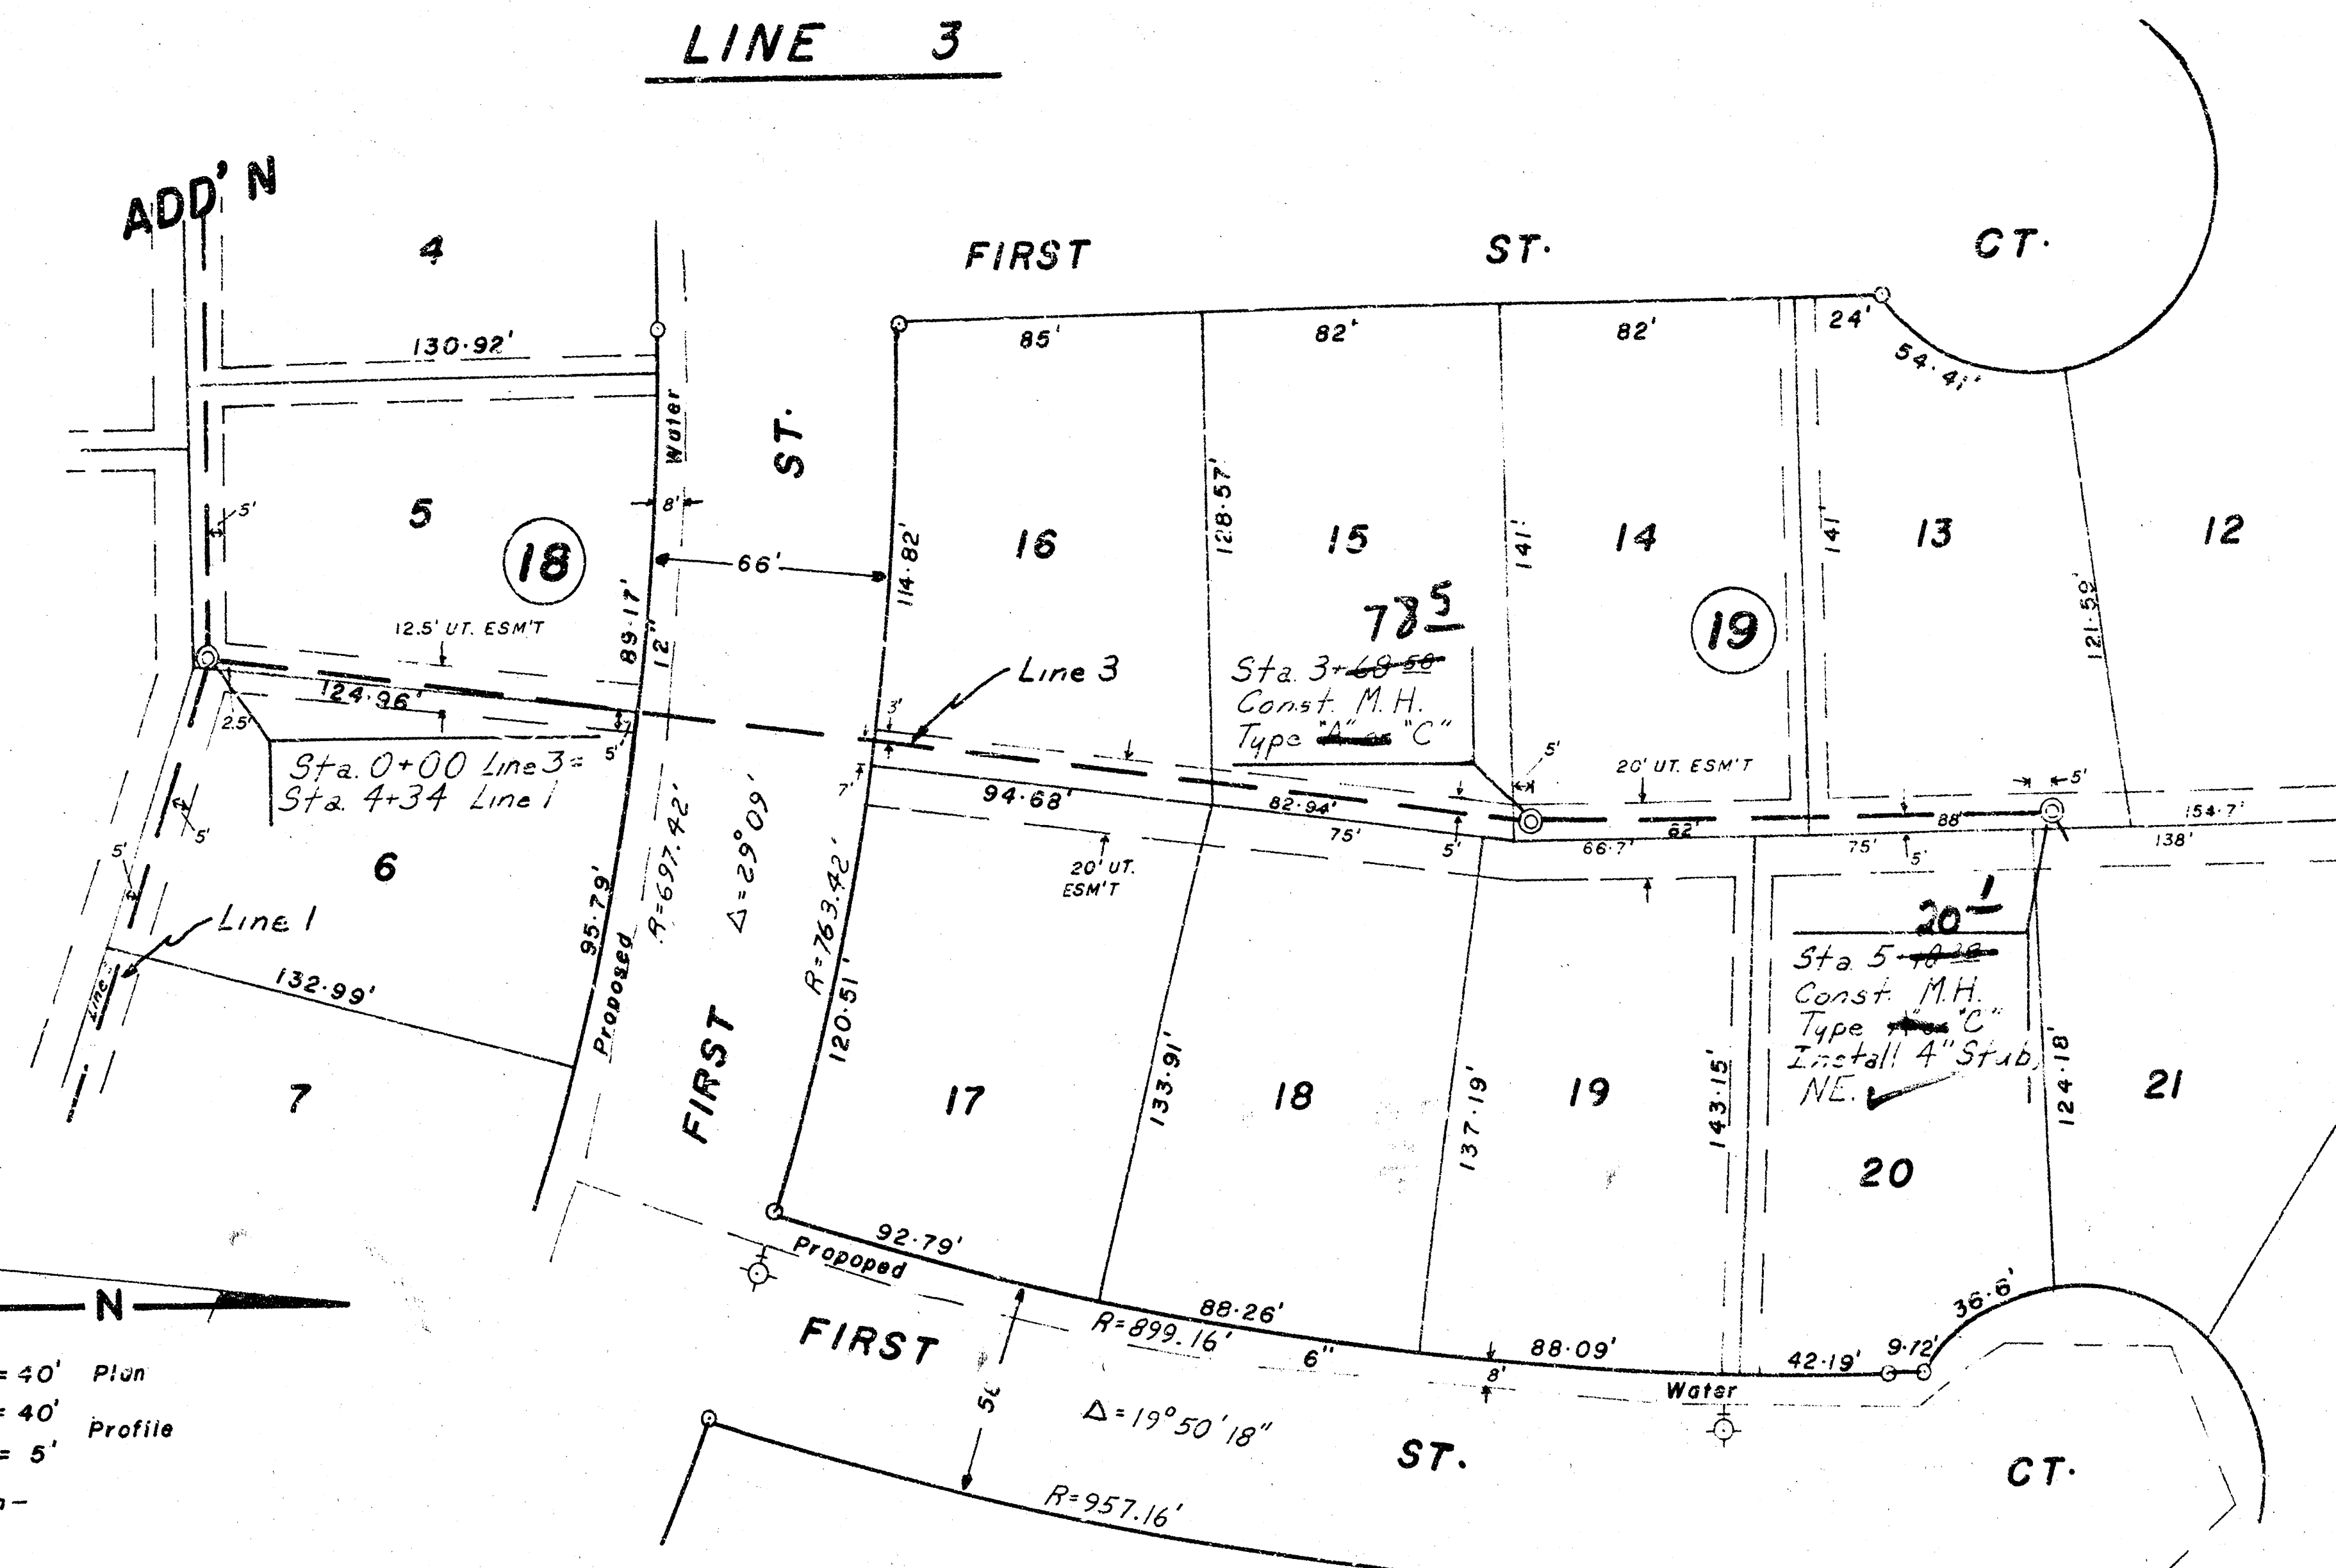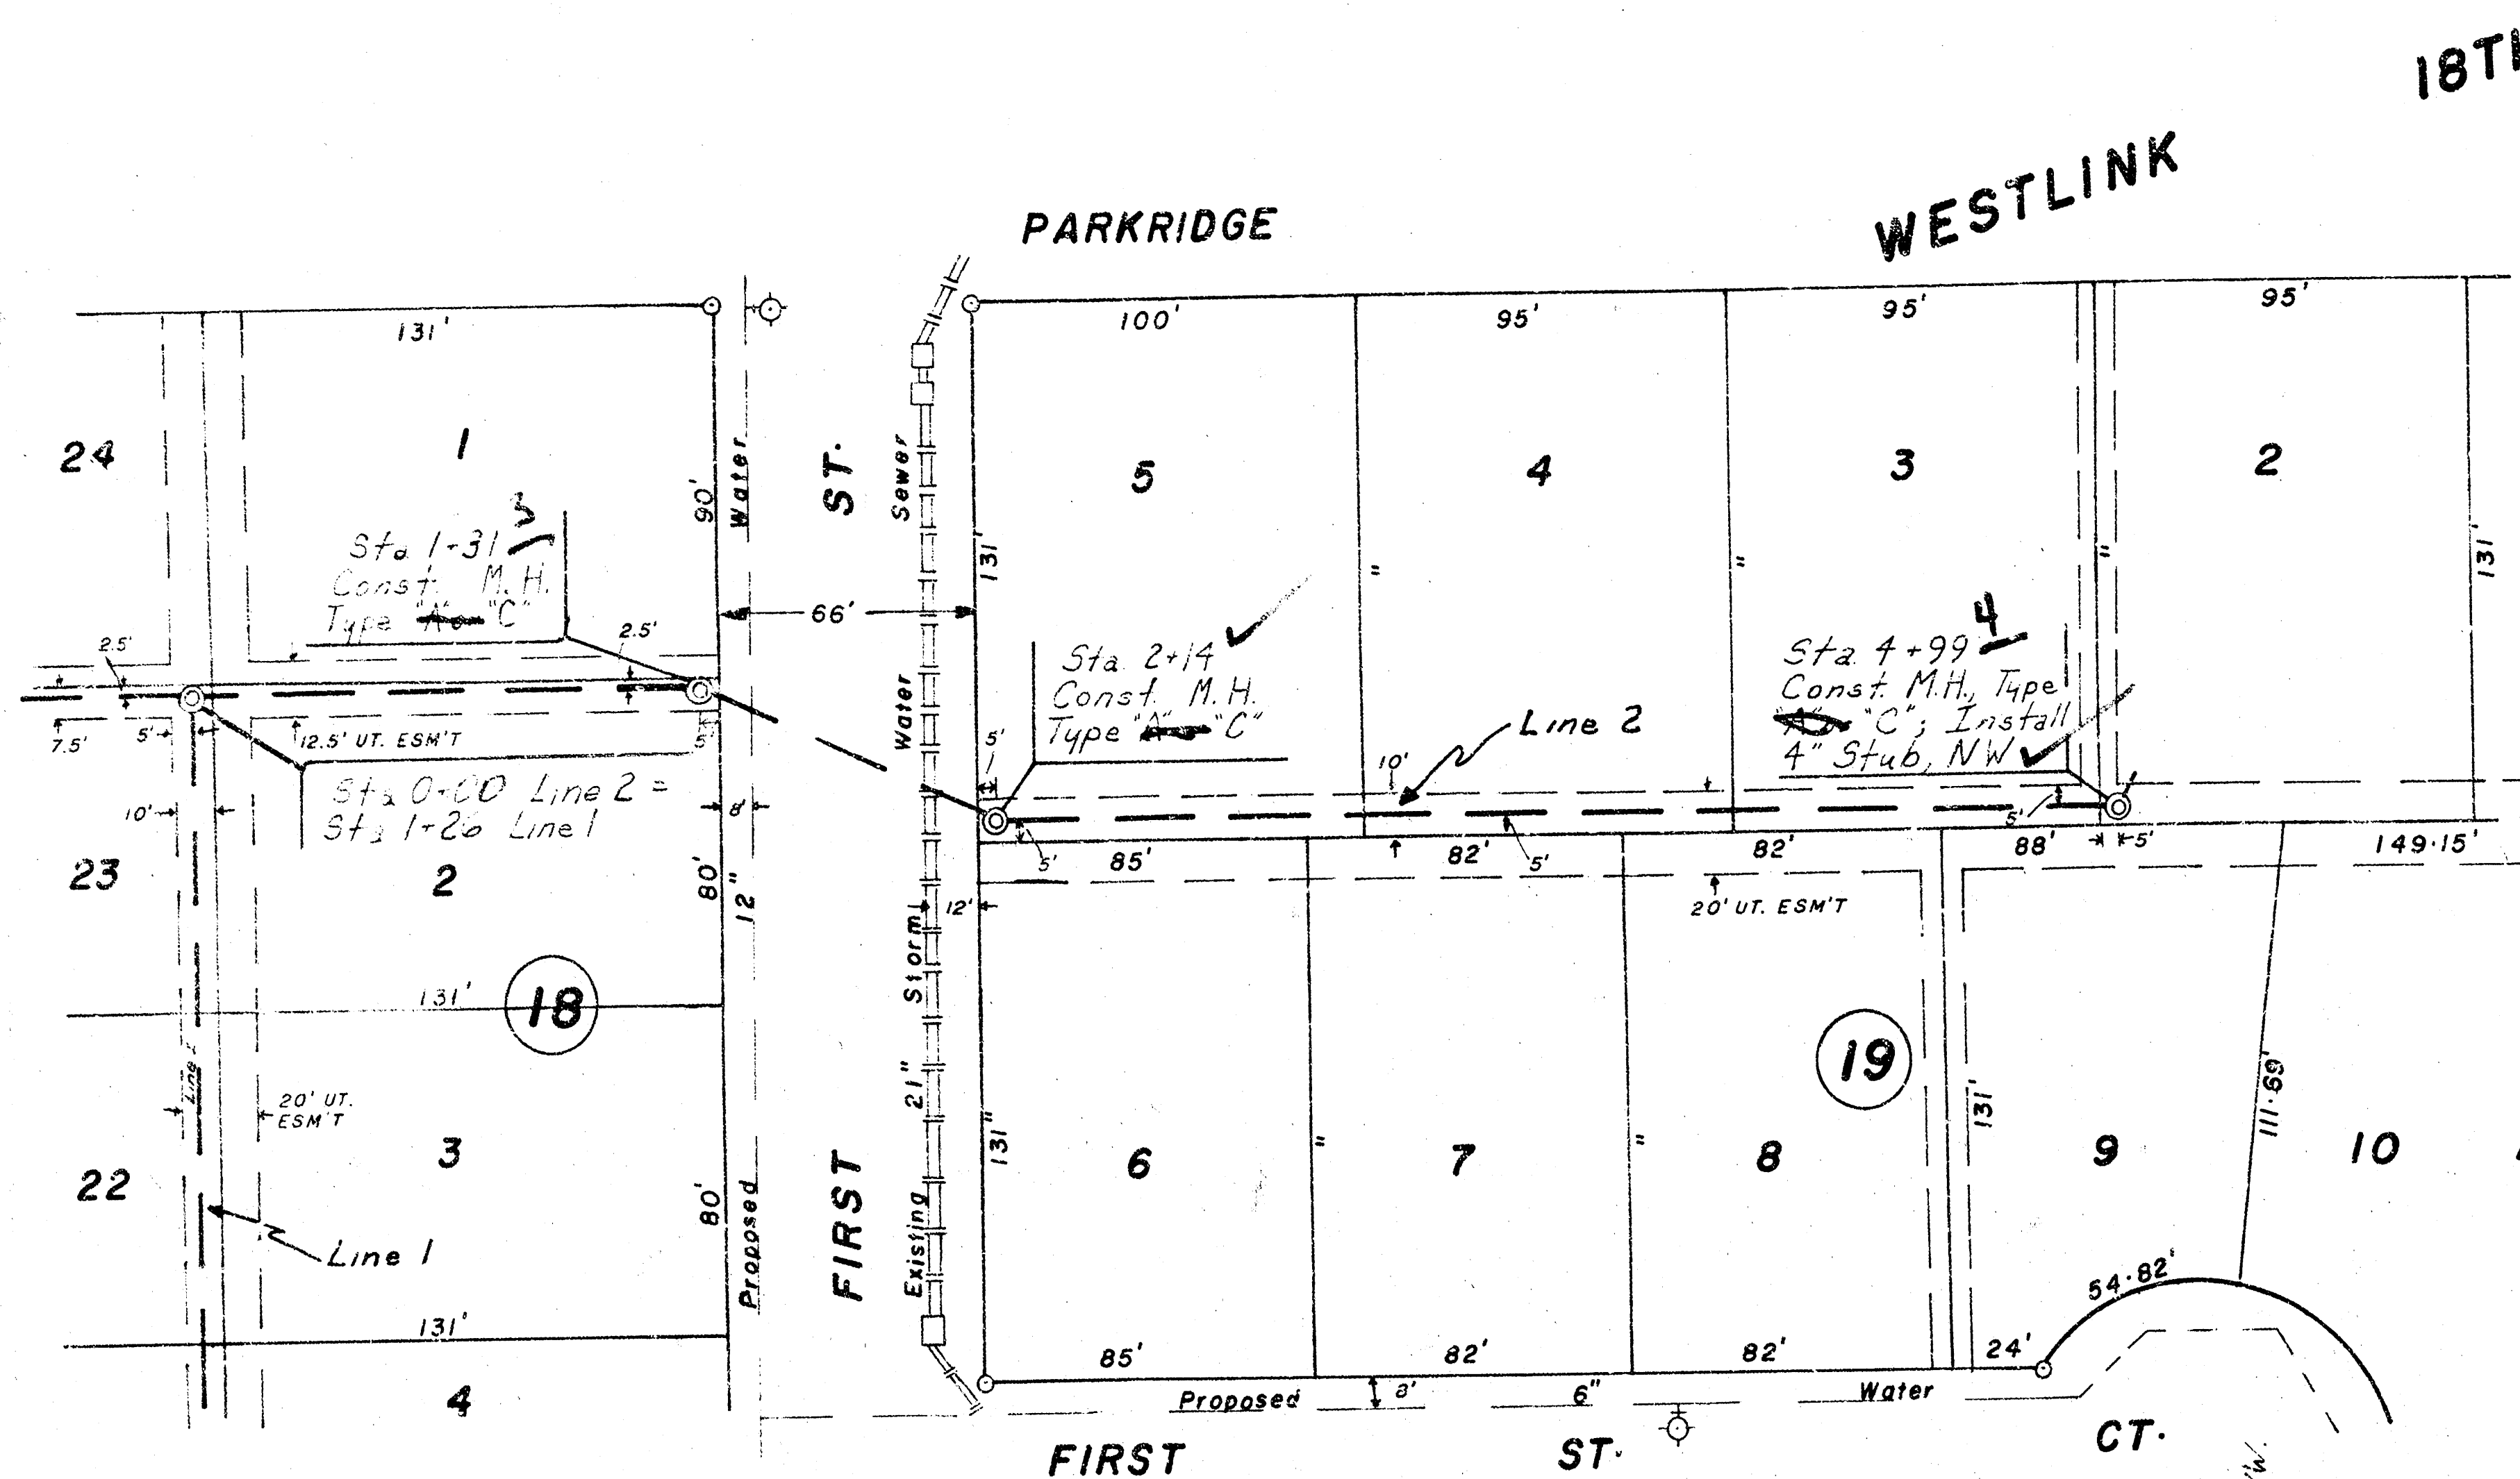

LAT. 1, MAIN 9, S.W. 1.  
 Phase II  
 Proj. NO. 468-76-245-80639-000  
 000-001

FILMED FROM THE BEST AVAILABLE COPY.....



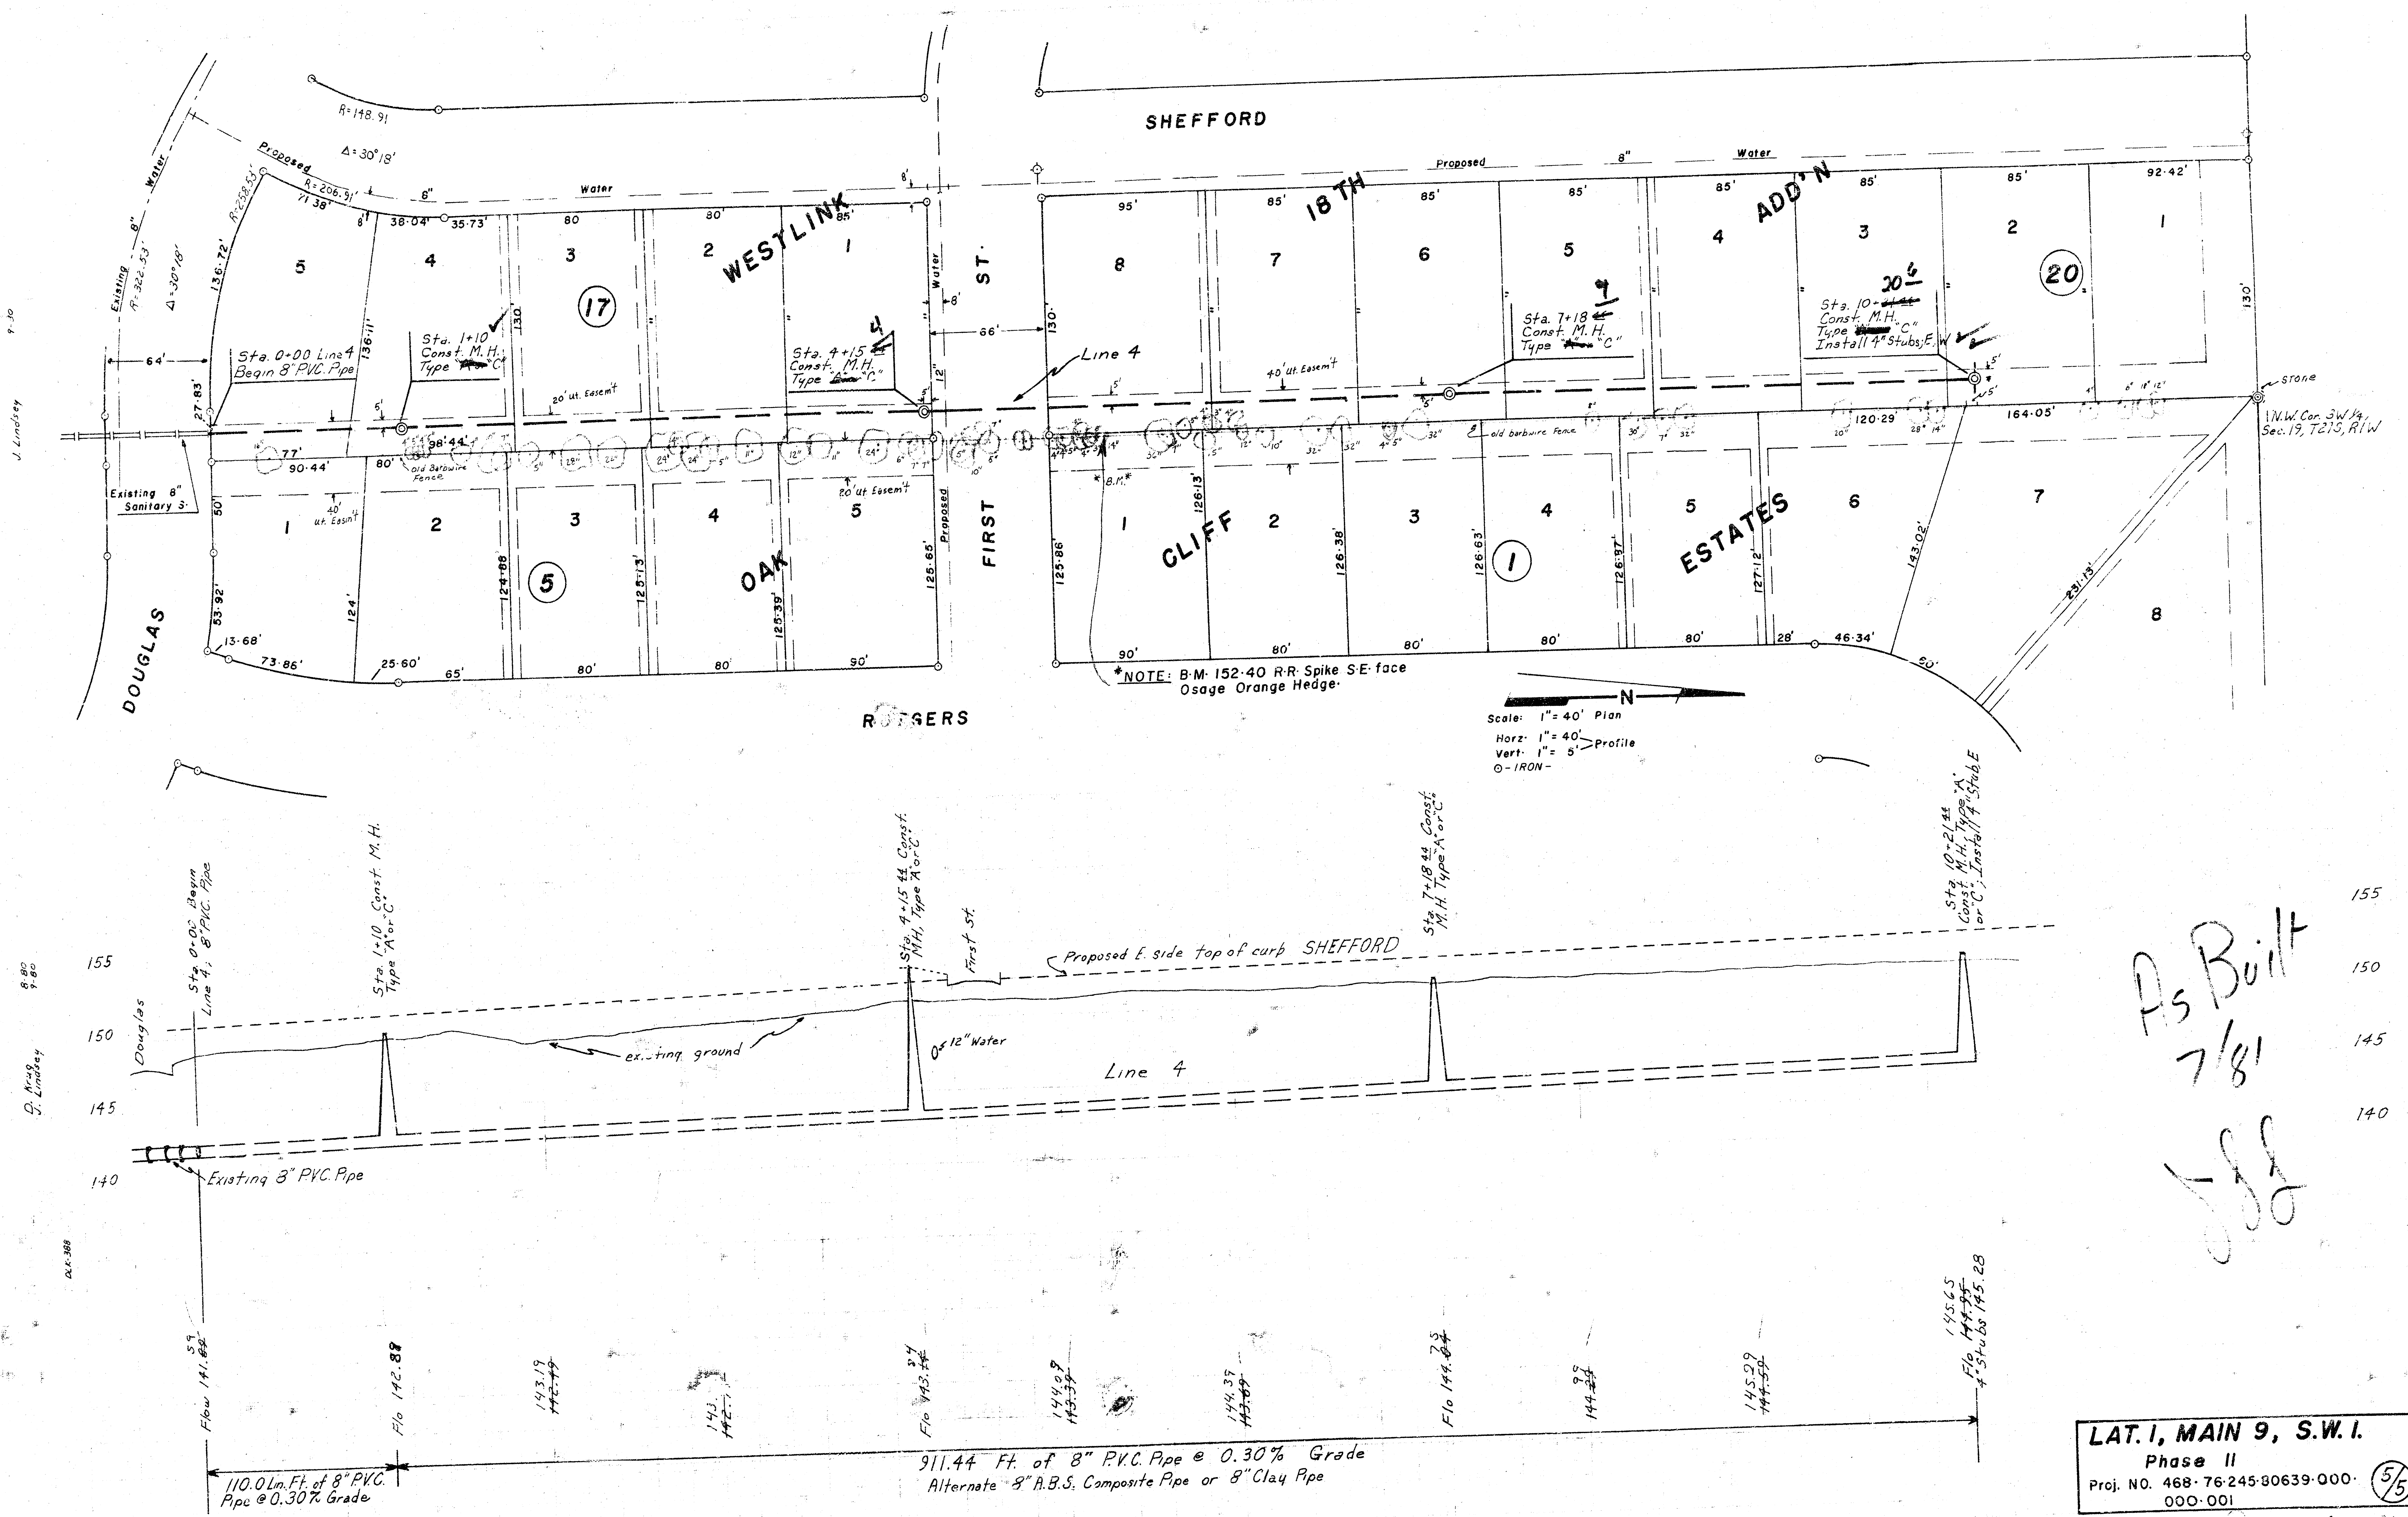

As Built  
 7/8/1  
 JSS