


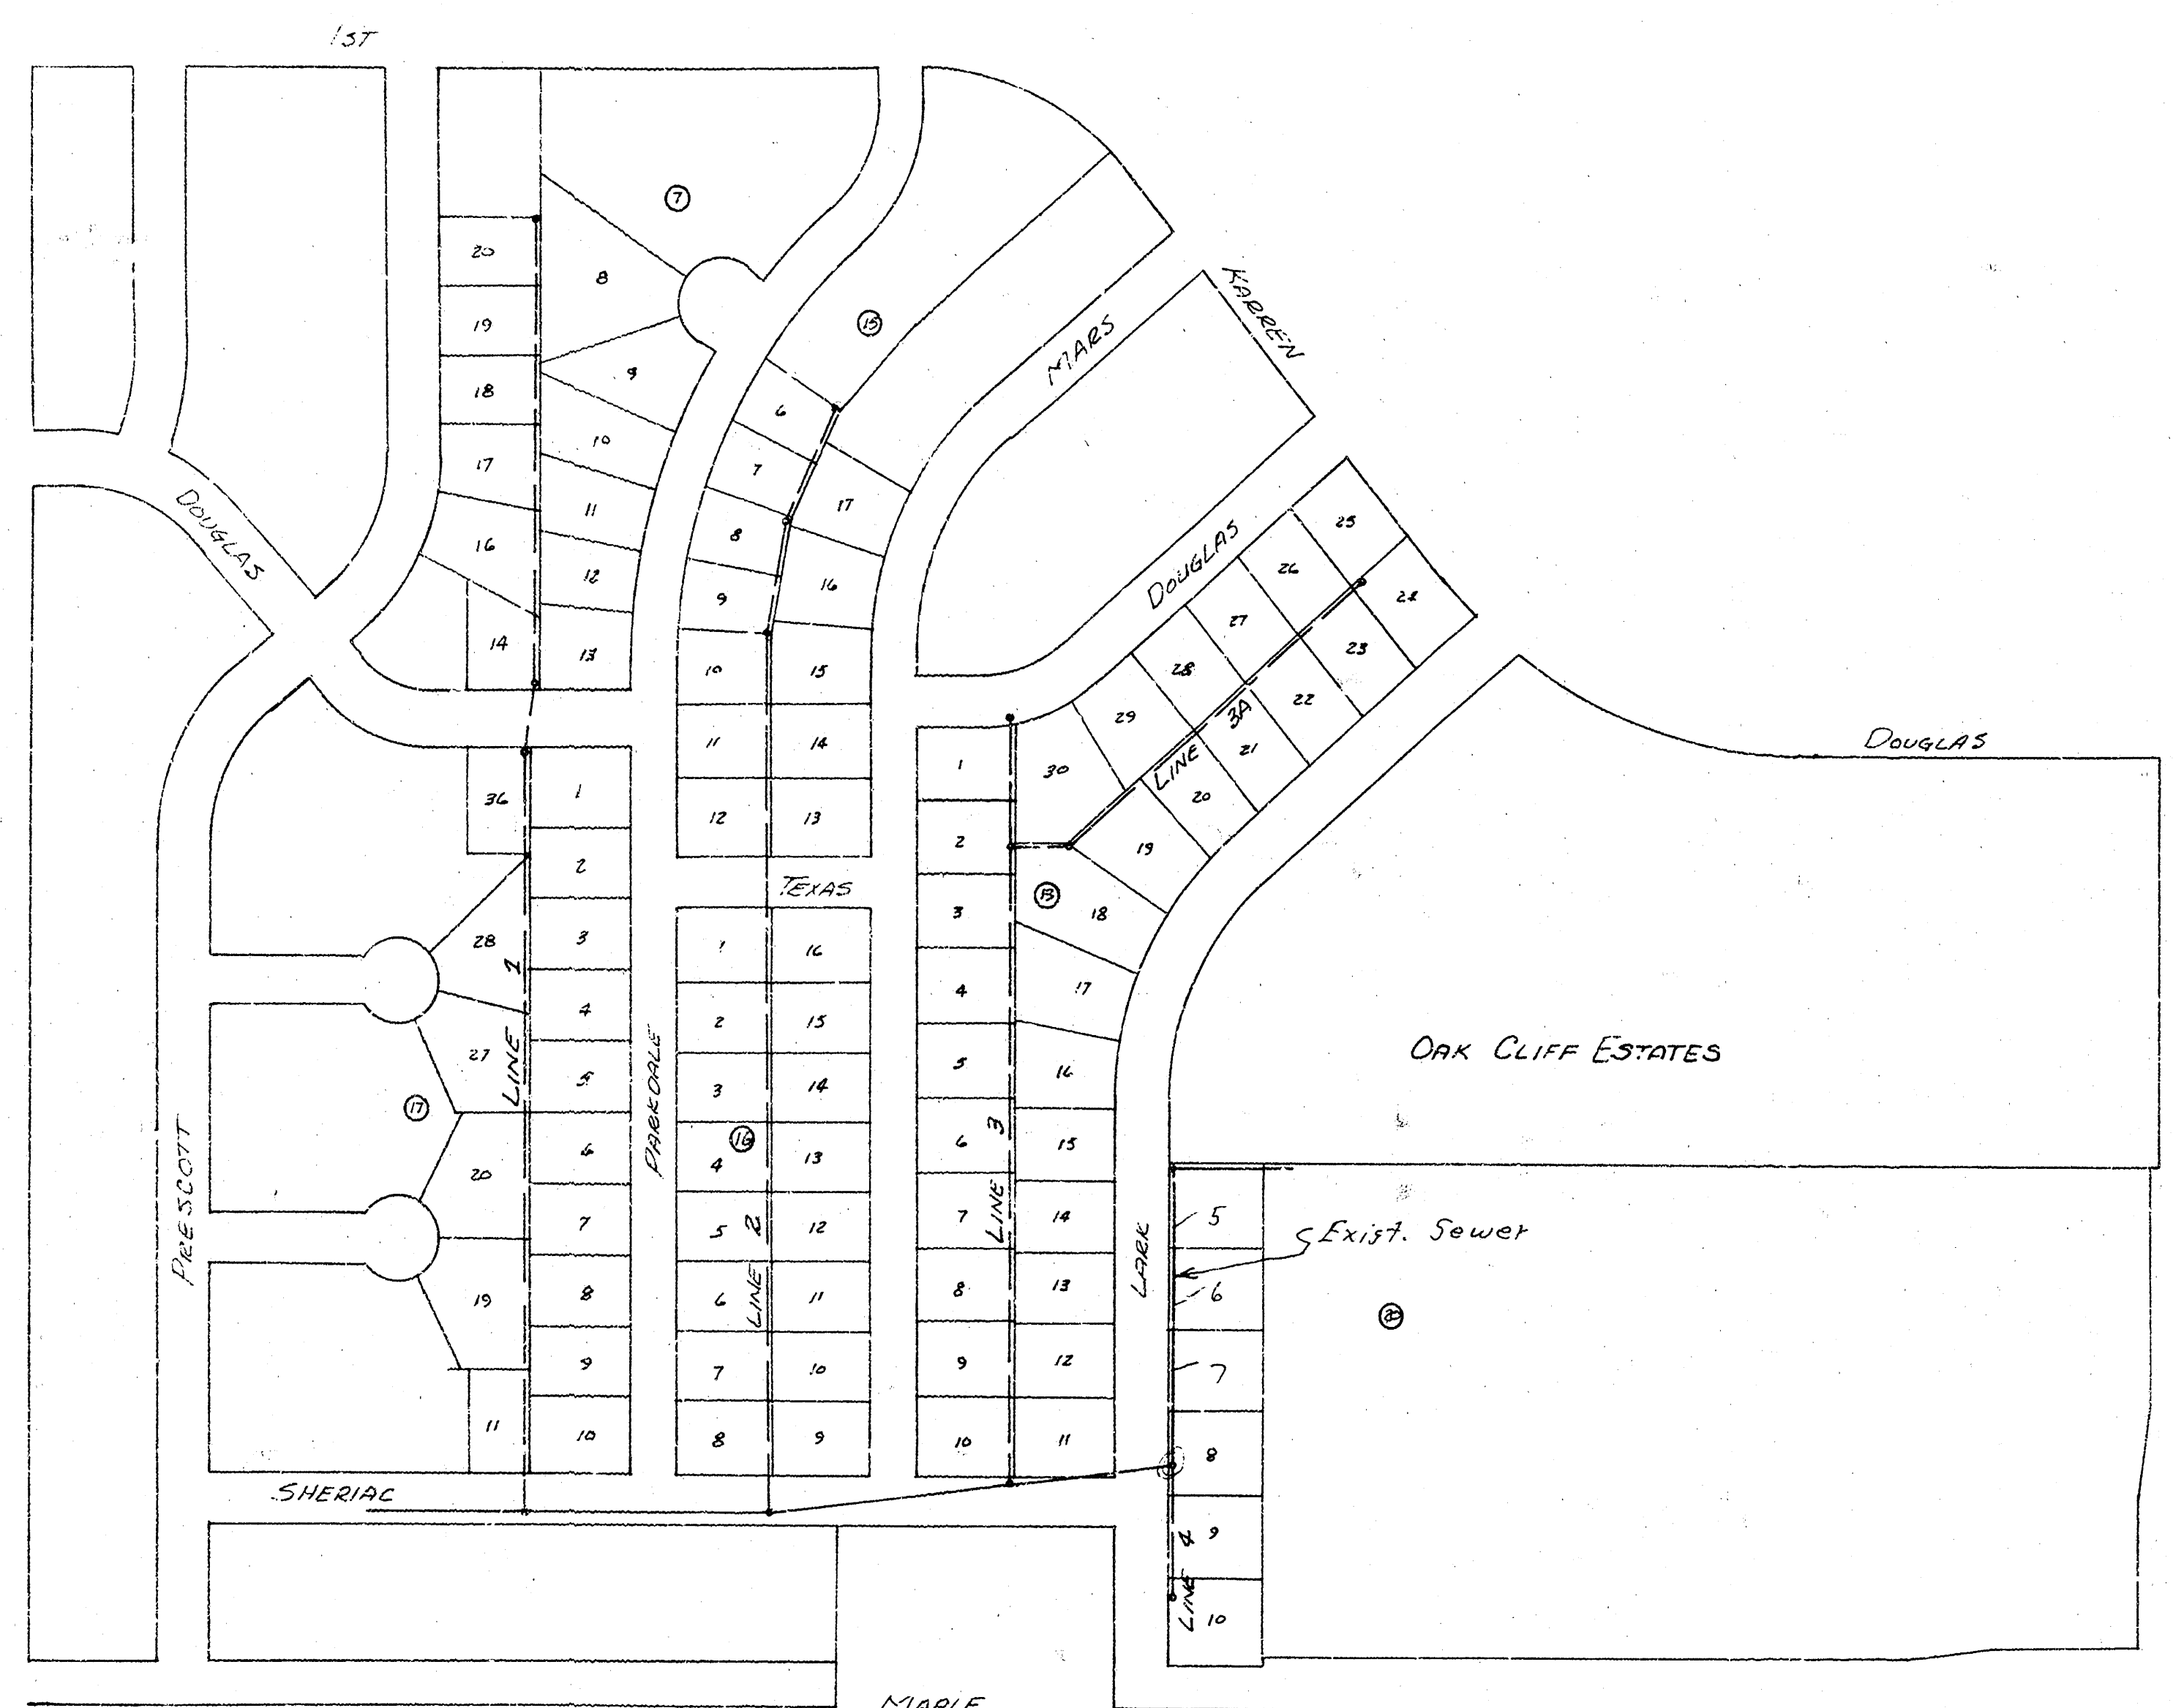

# LAT 5 , MAIN 9 , SW. INTERCEPTOR

CITY OF WICHITA

RAY BRUGGEMAN - CITY ENGINEER

PROJ. NO. 468-76-245-80988-000-000-001



LINE 1 SHEET 243  
 LINE 2 SHEET 445  
 LINE 3 SHEET 6  
 LINE 3A SHEET 7  
 LINE 4 SHEET 8

NOTE: RISERS SHALL BE INSTALLED ON THE EXISTING SEWER ALONG THE EAST SIDE OF LARK TO FACILITATE FUTURE HOUSE SEWER CONNECTIONS ON LOTS 5, 6 AND 7, IN BLOCK 20 AS A PART OF PROJECT.


OK

NOTE: PLAN INDICATES CLAY PIPE TO BE USED ON THIS PROJECT BUT A.B.S. COMPOSITE PIPE OR P.V.C. PIPE CAN BE USED AS AN ALTERNATE. TYPE "C" MANHOLES CAN ALSO BE USED AS AN ALTERNATE TO THE TYPE "A" MANHOLES SHOWN ON THE PLANS.


As Built  
 7/8/1

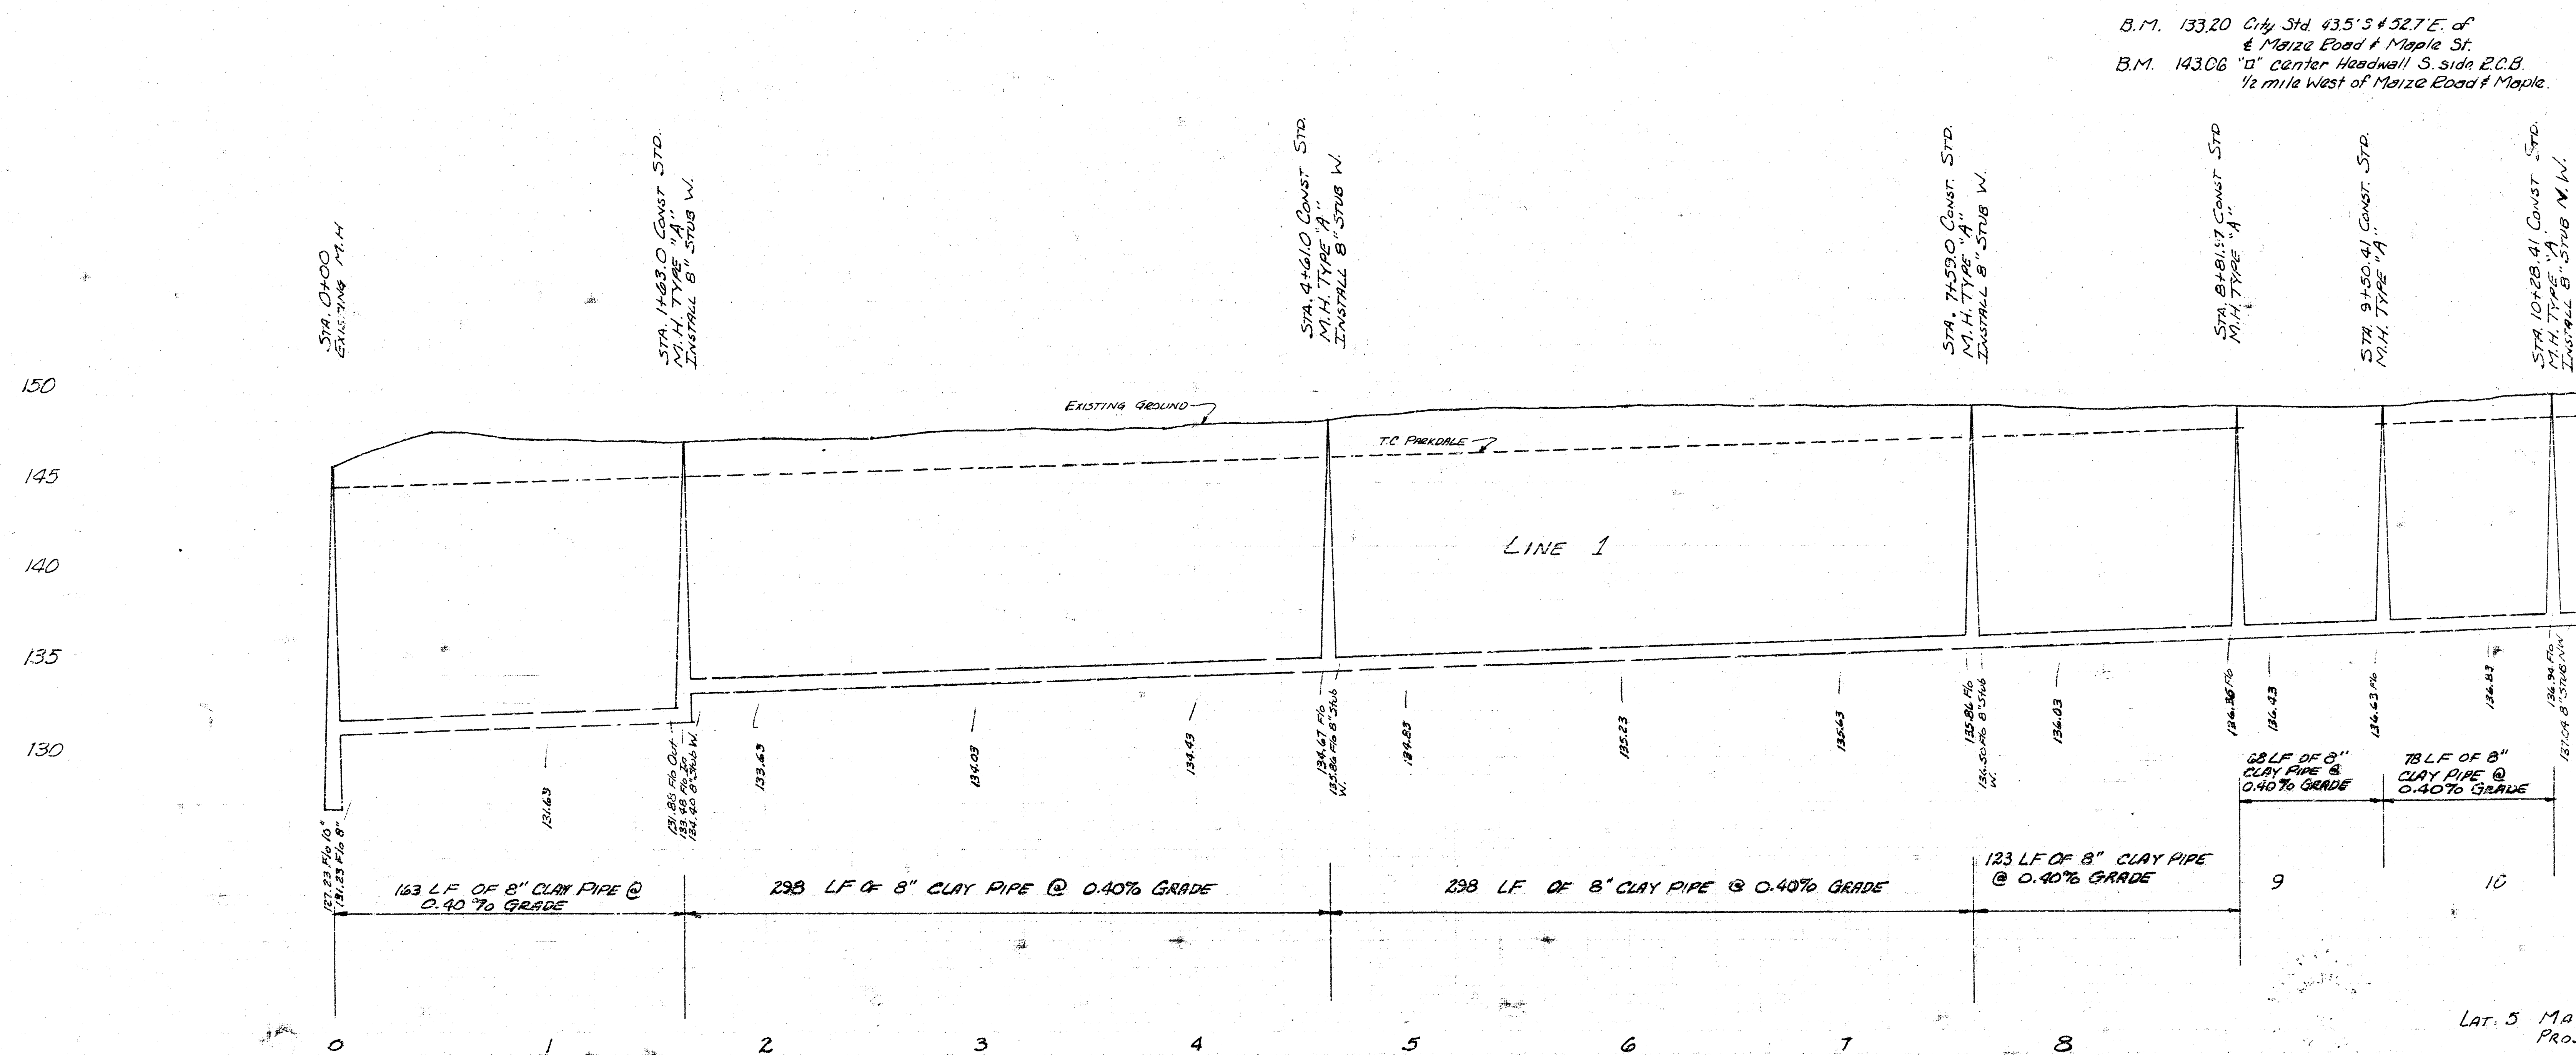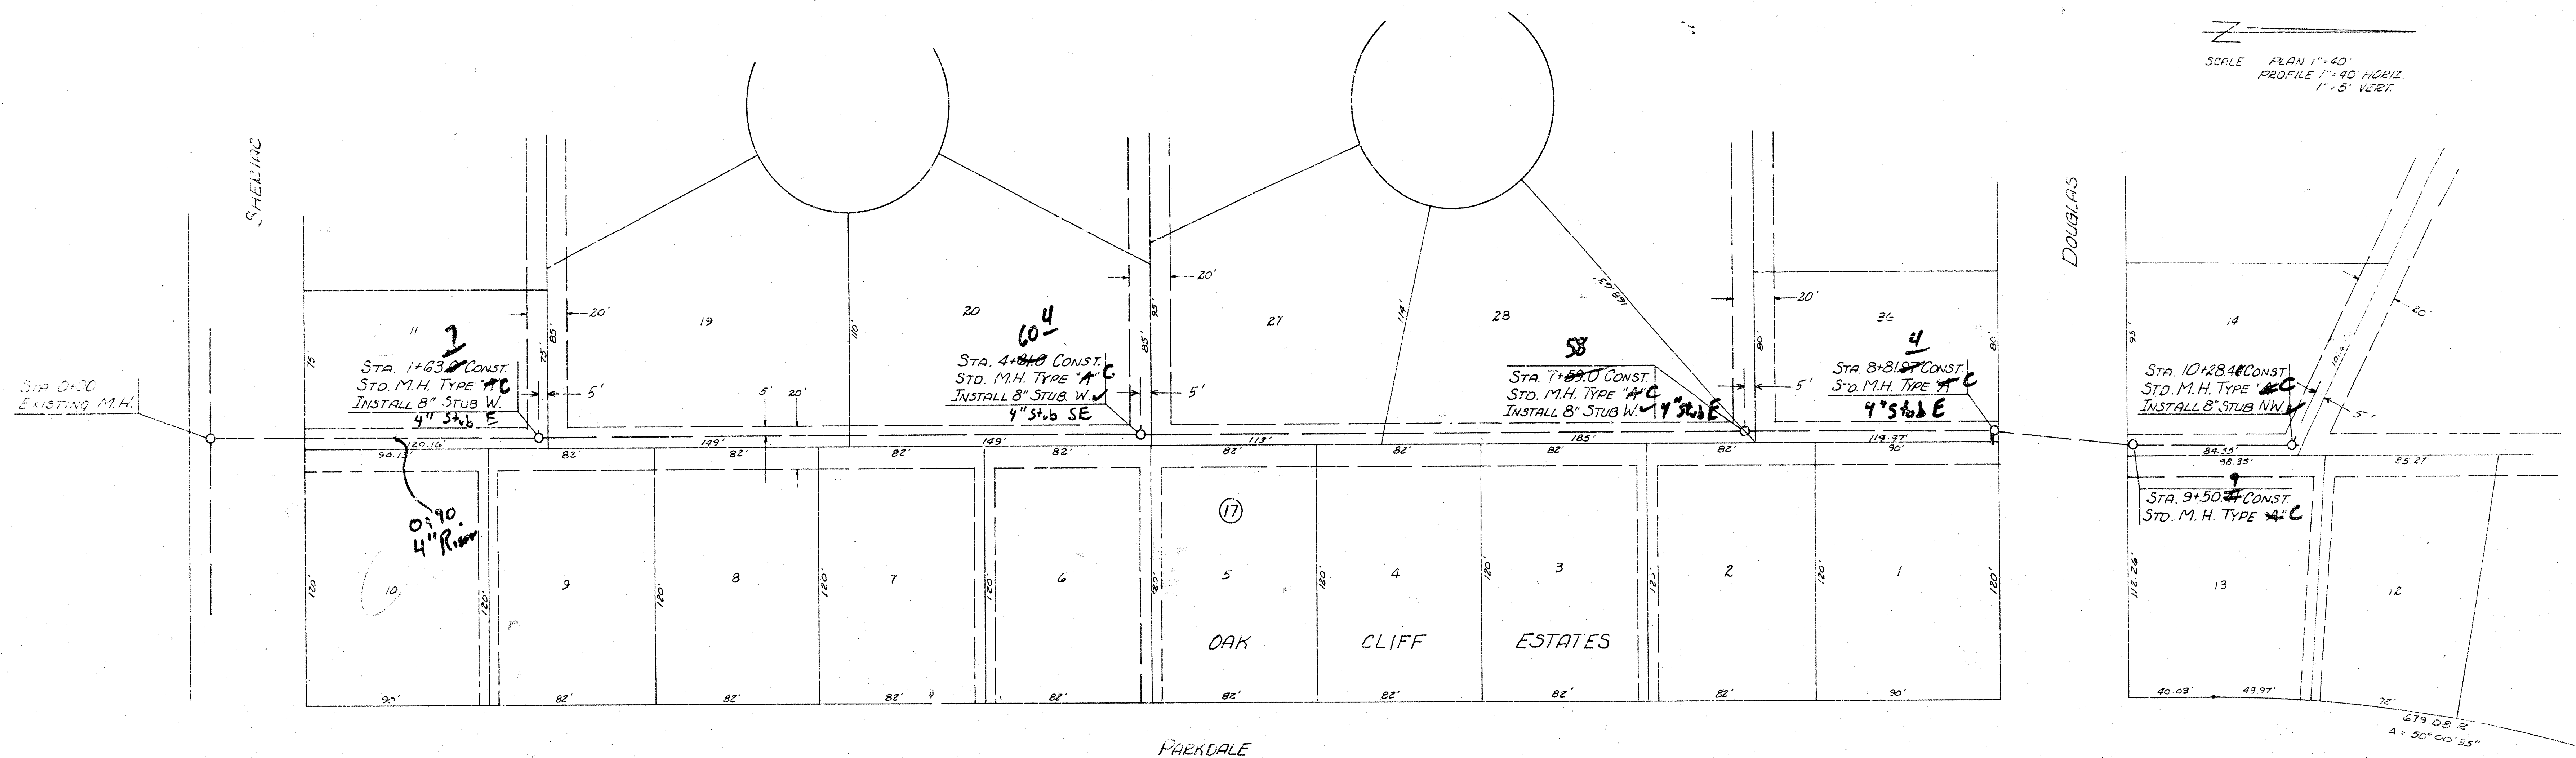

As Built  
7/8/15


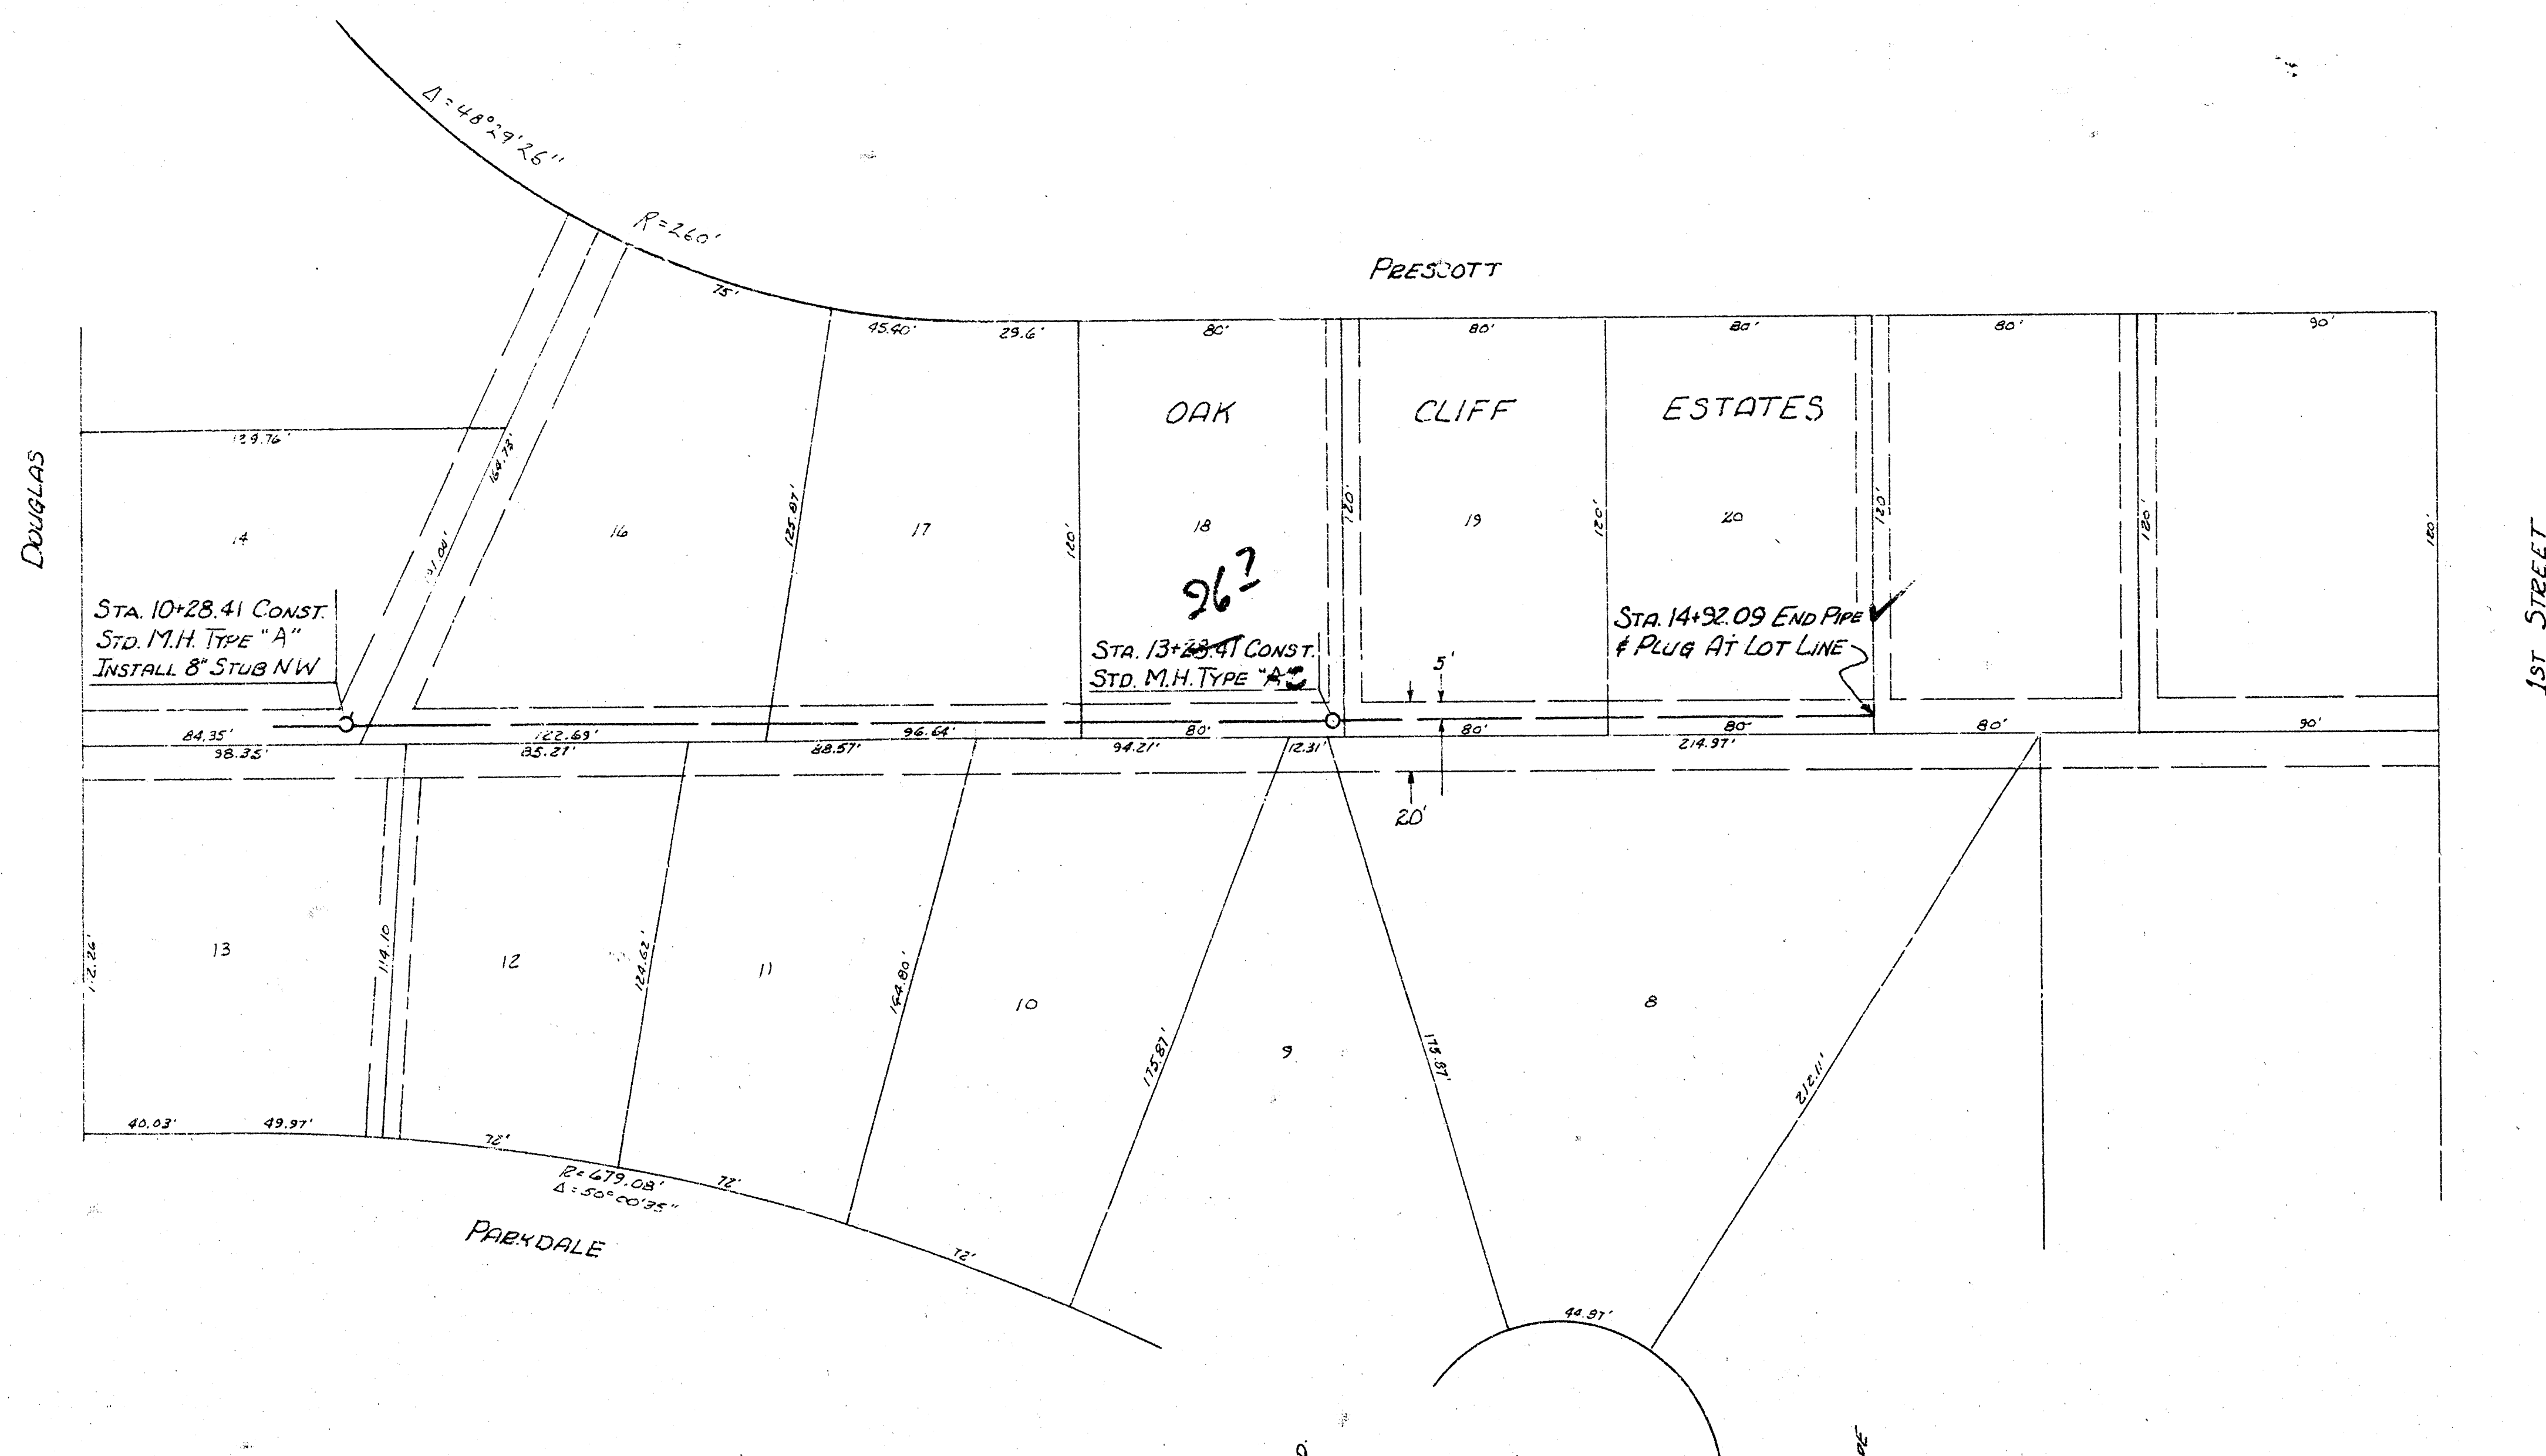


SCALE: PLAN 1"=40'  
 PROFILE 1"=40' HORIZ.  
 1"=5' VERT.

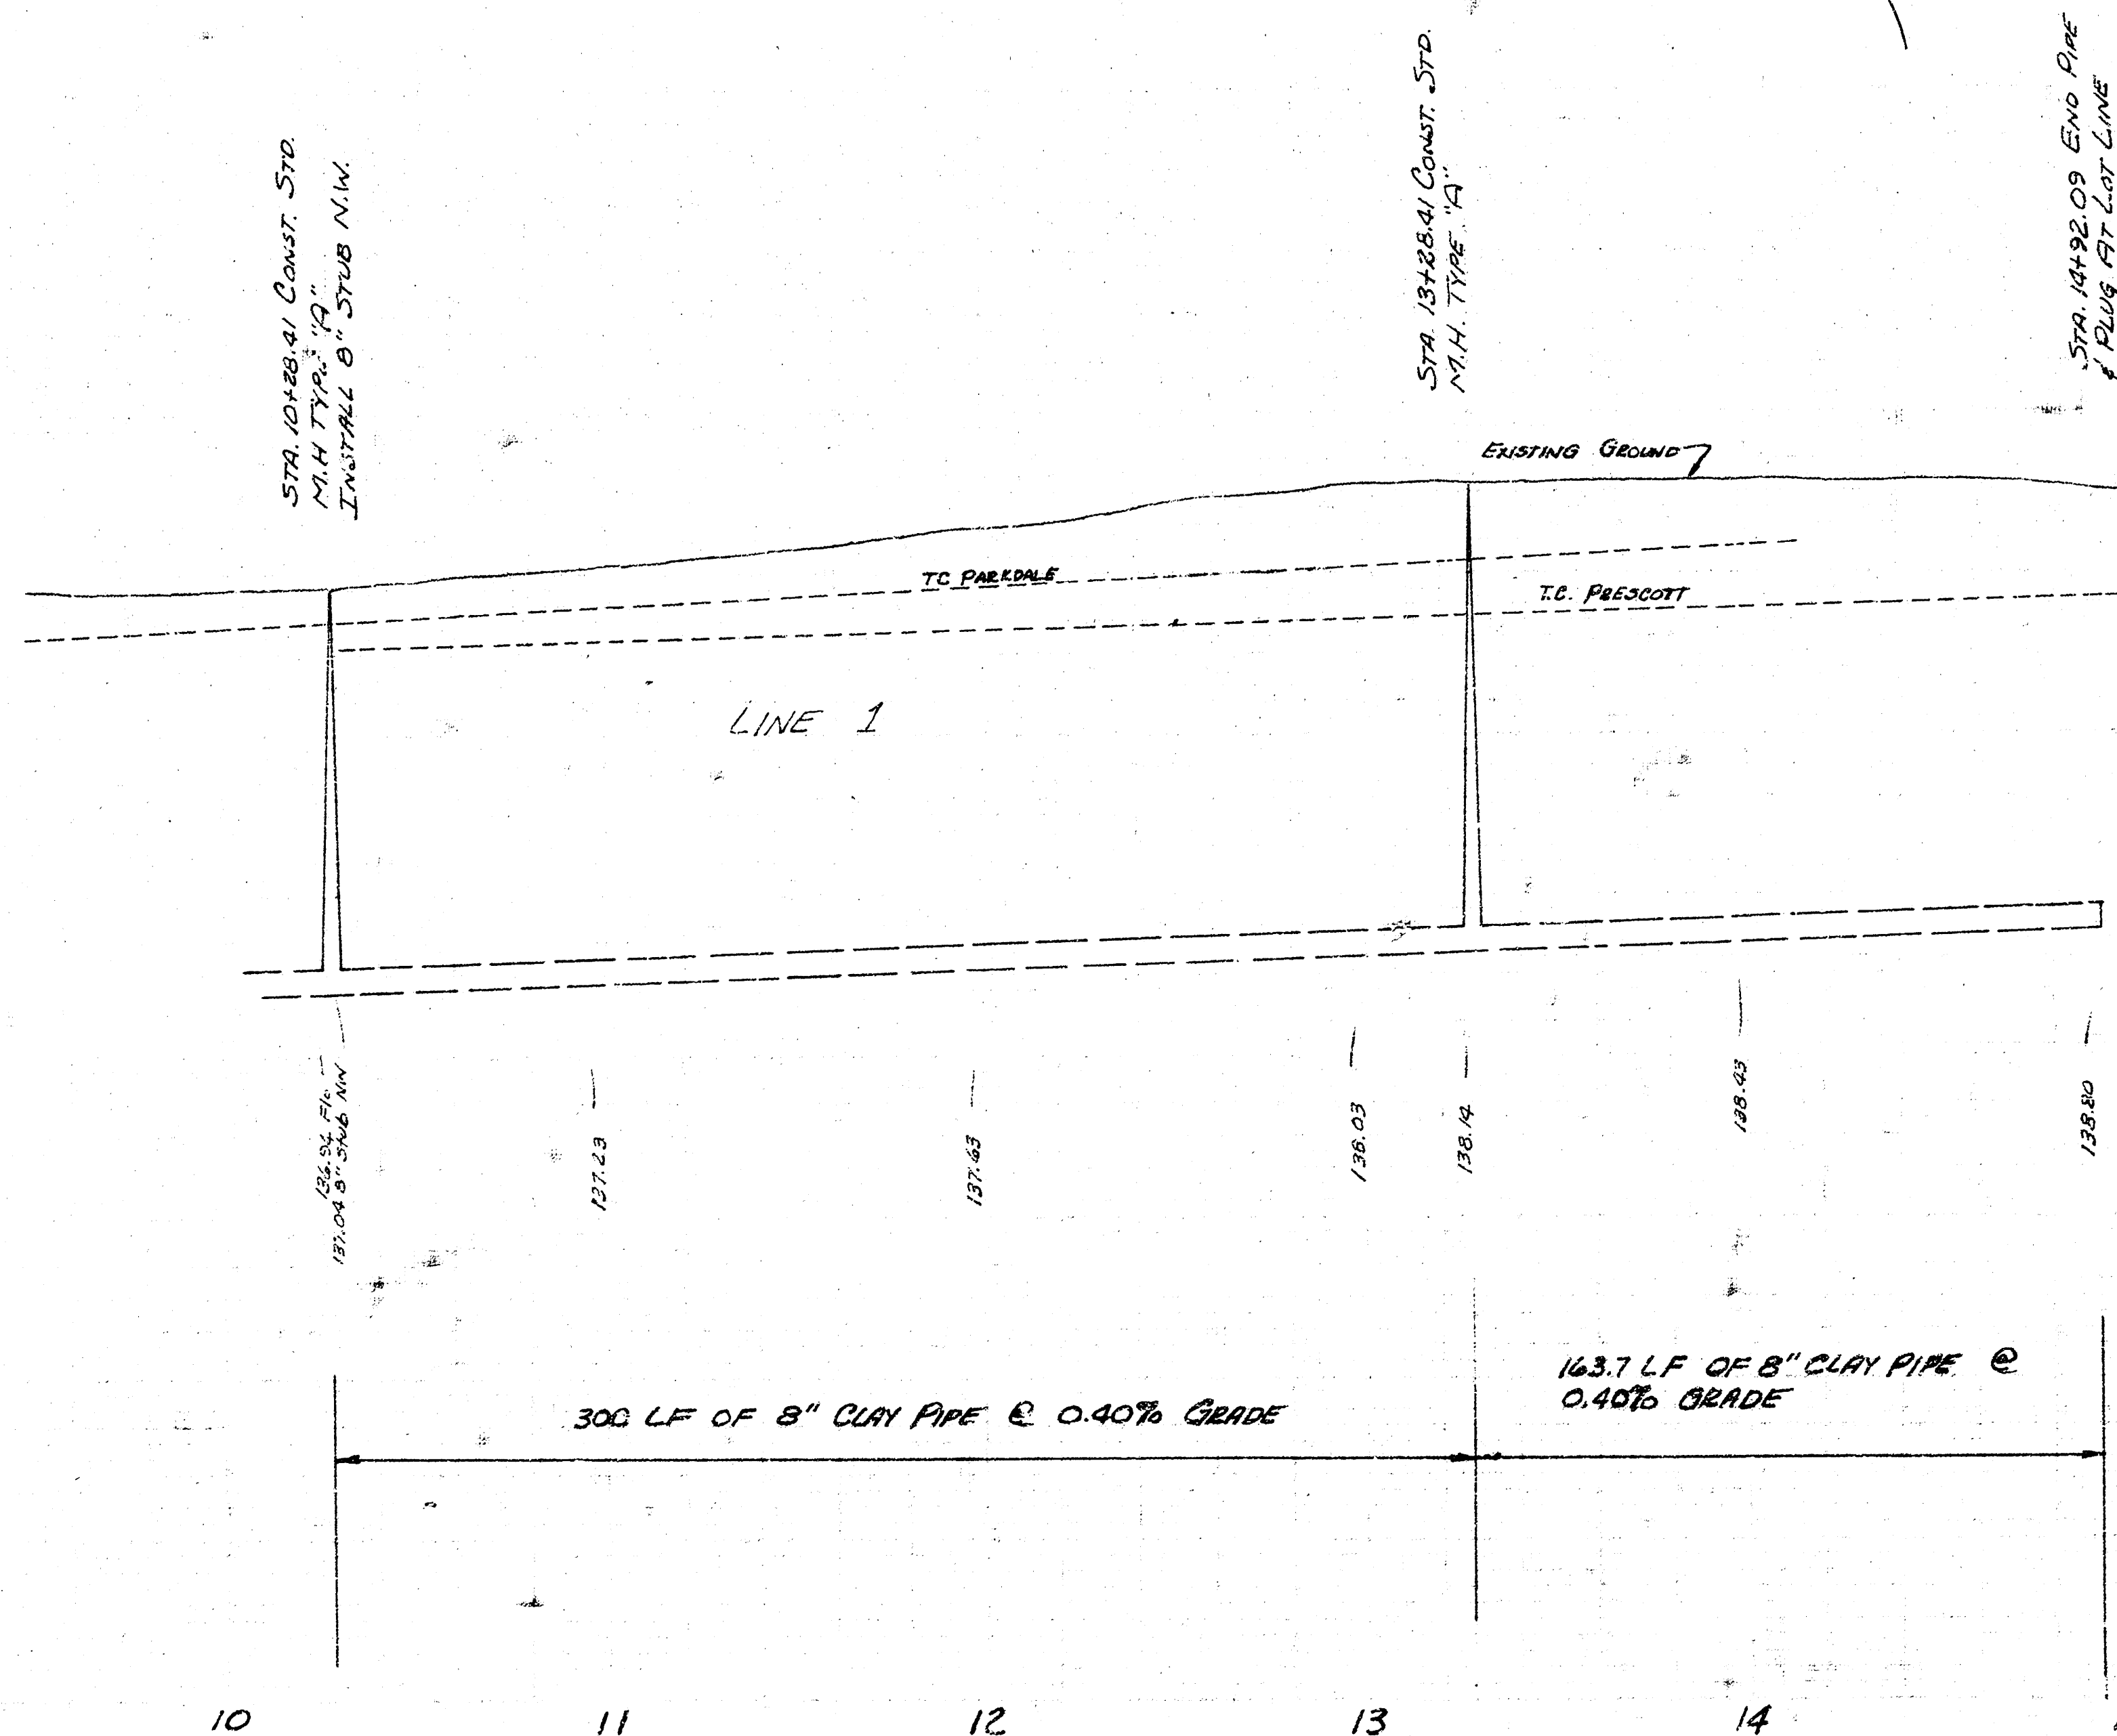

LAT 5 MAIN 9, SOUTHWEST INTERCEPTOR  
 PROJ. NO. 468-76-245-80988-000-000-001


SCALE PLAN 1"=40'  
 PROFILE 1"=40' HORIZ.  
 1"=5' VERT.

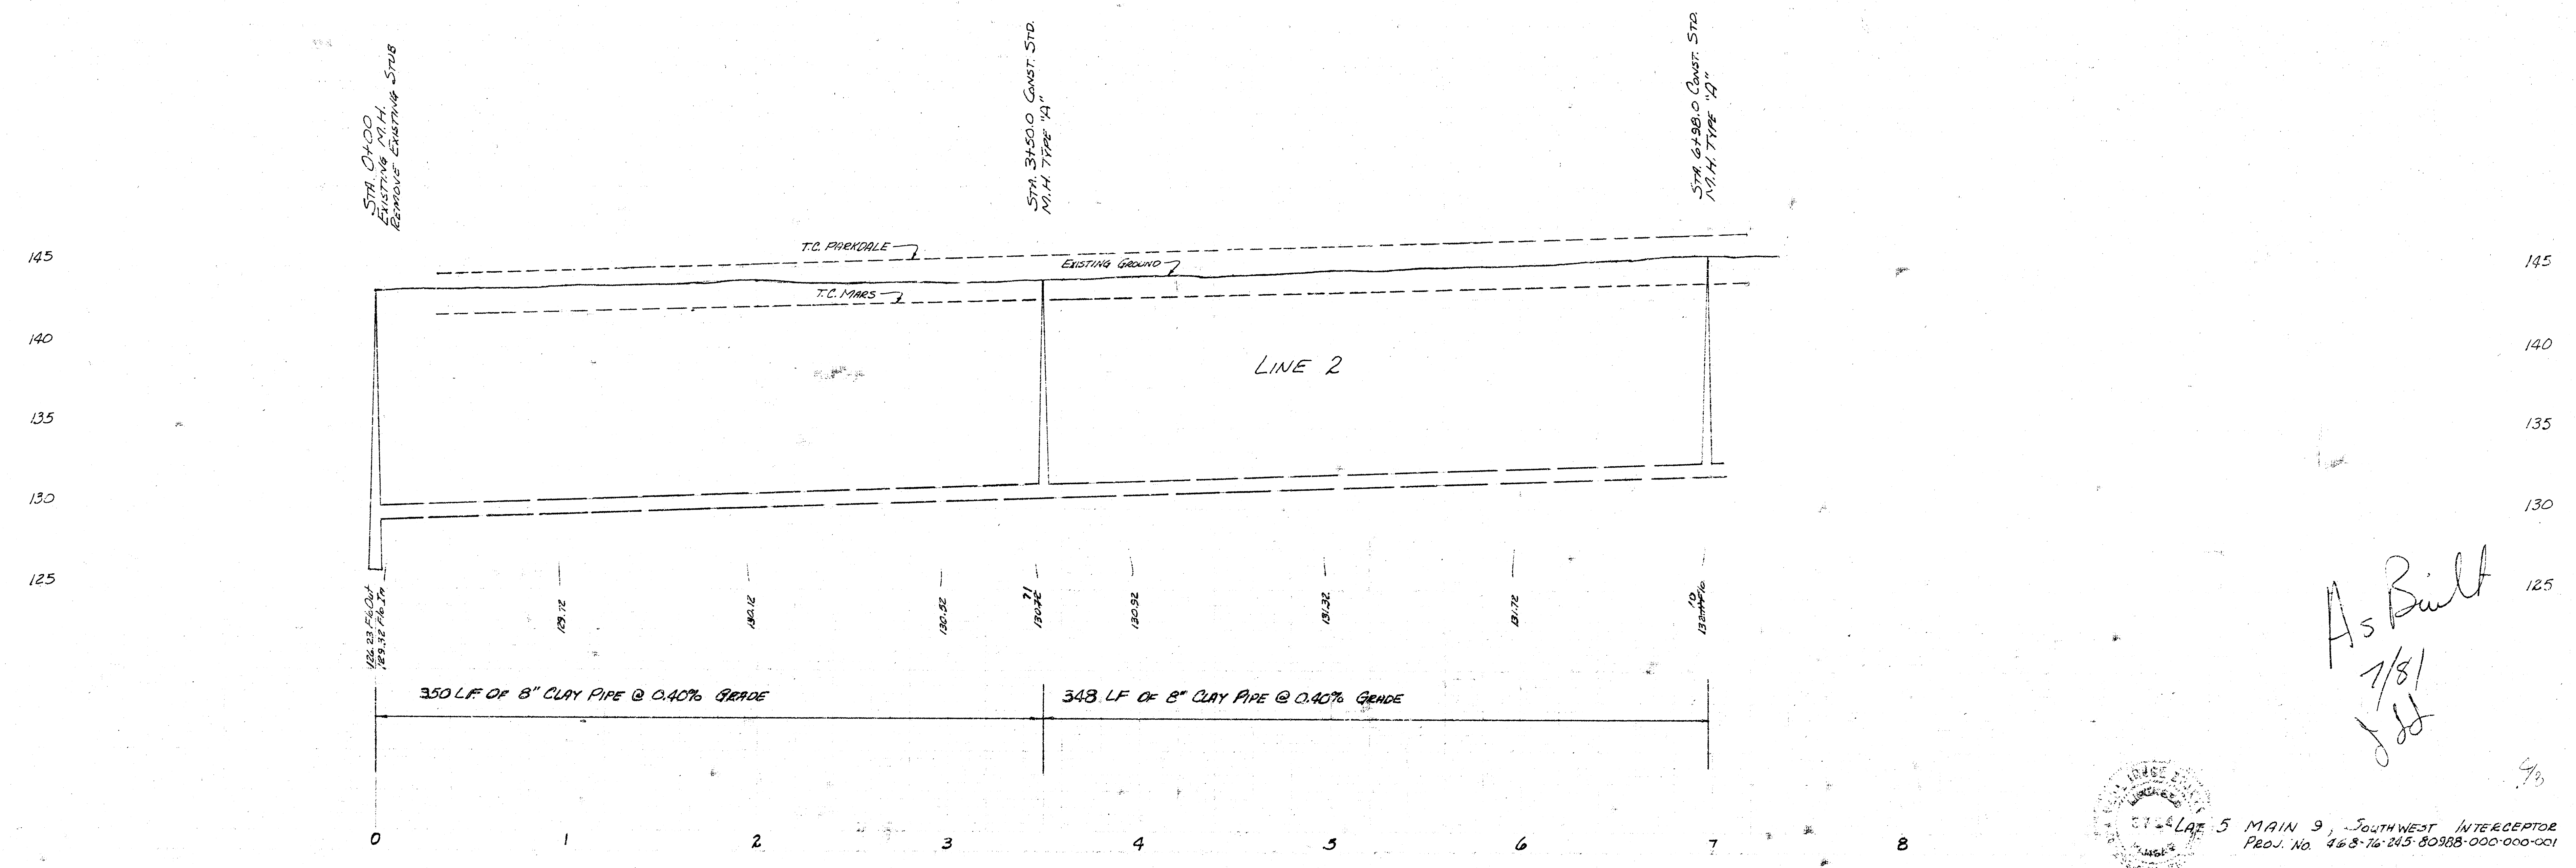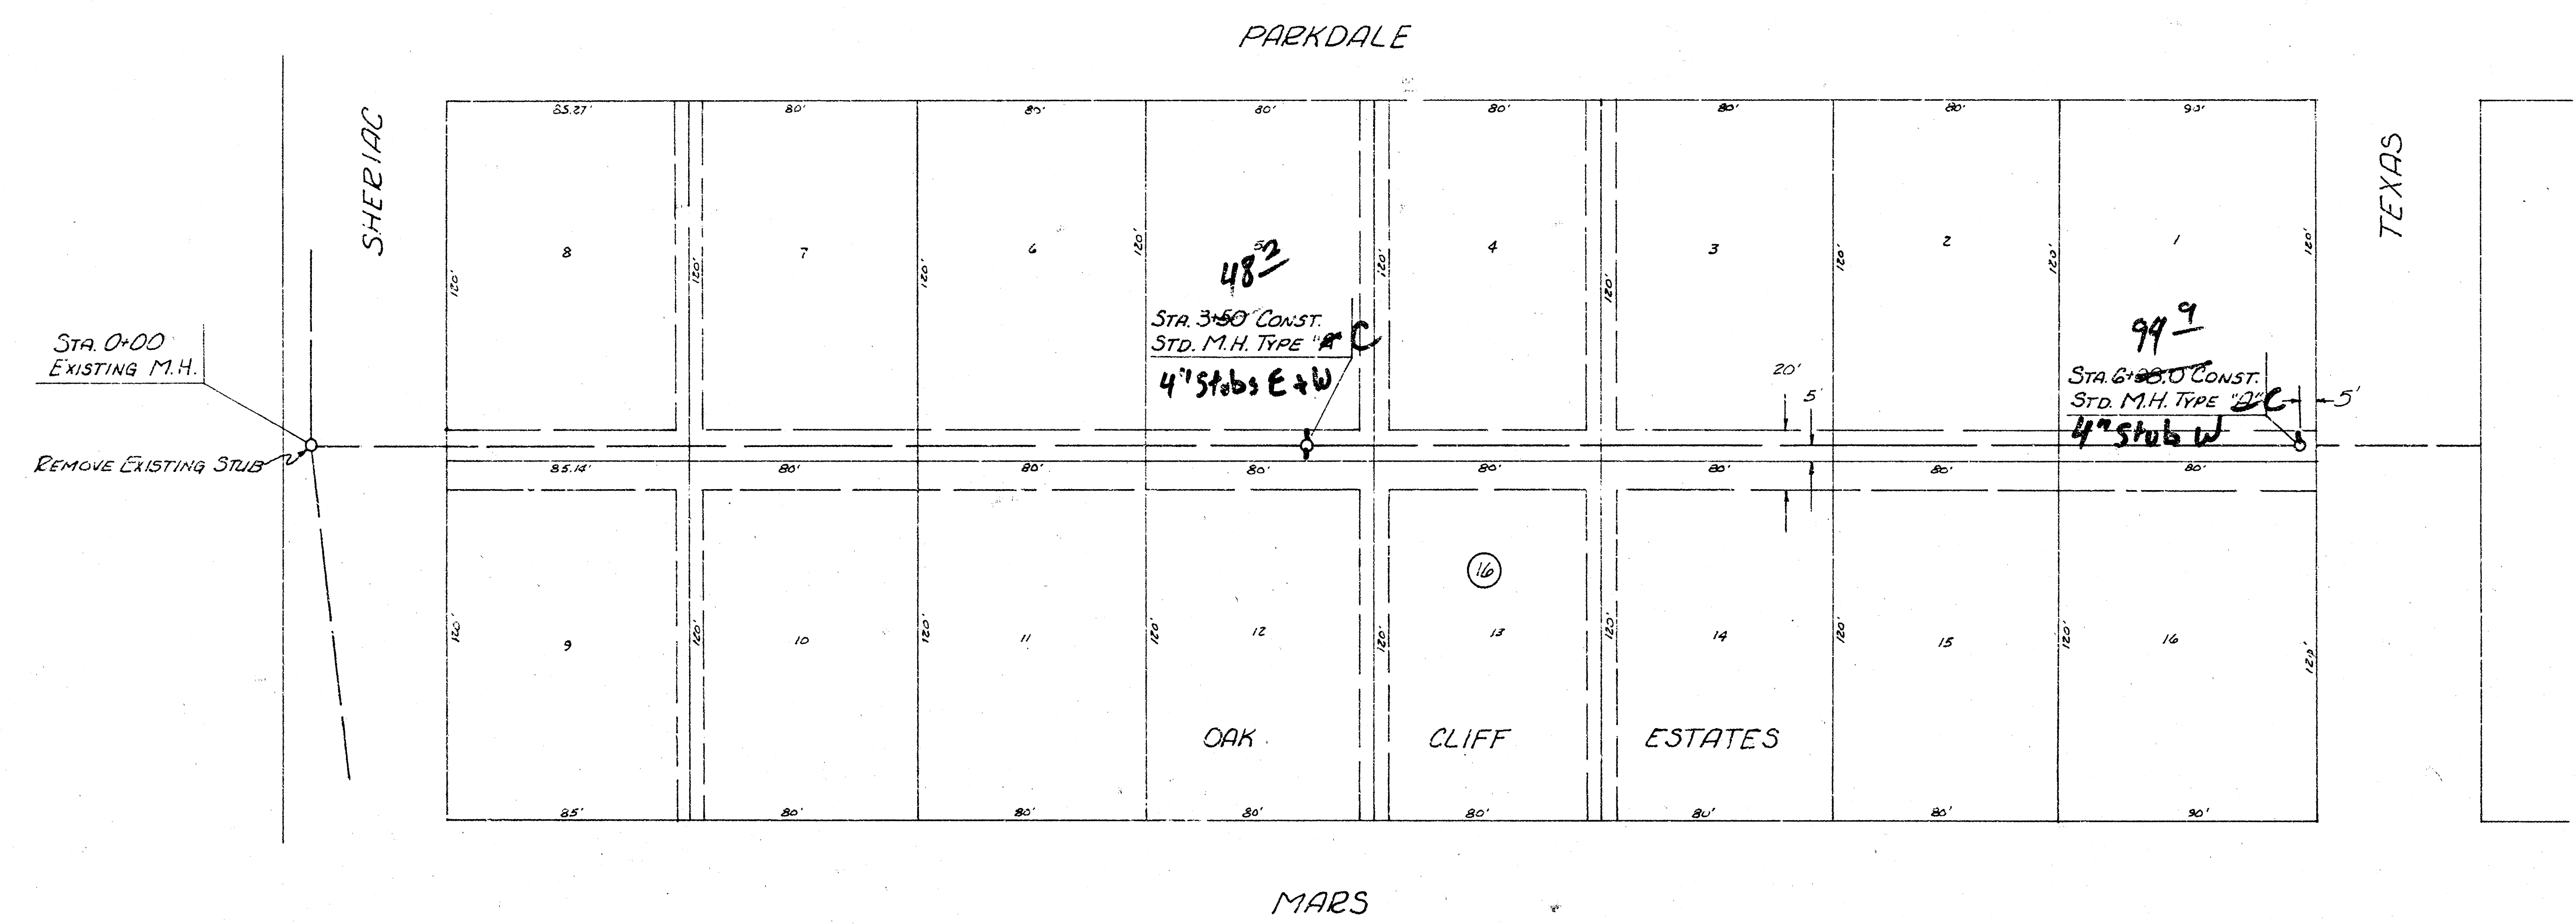


As Built  
 7/8/1  
 JST



LA 5 MAIN 9, SOUTHWEST INTERCEPTOR  
 PROJ. NO. 468-76-245-80988-000-000-001


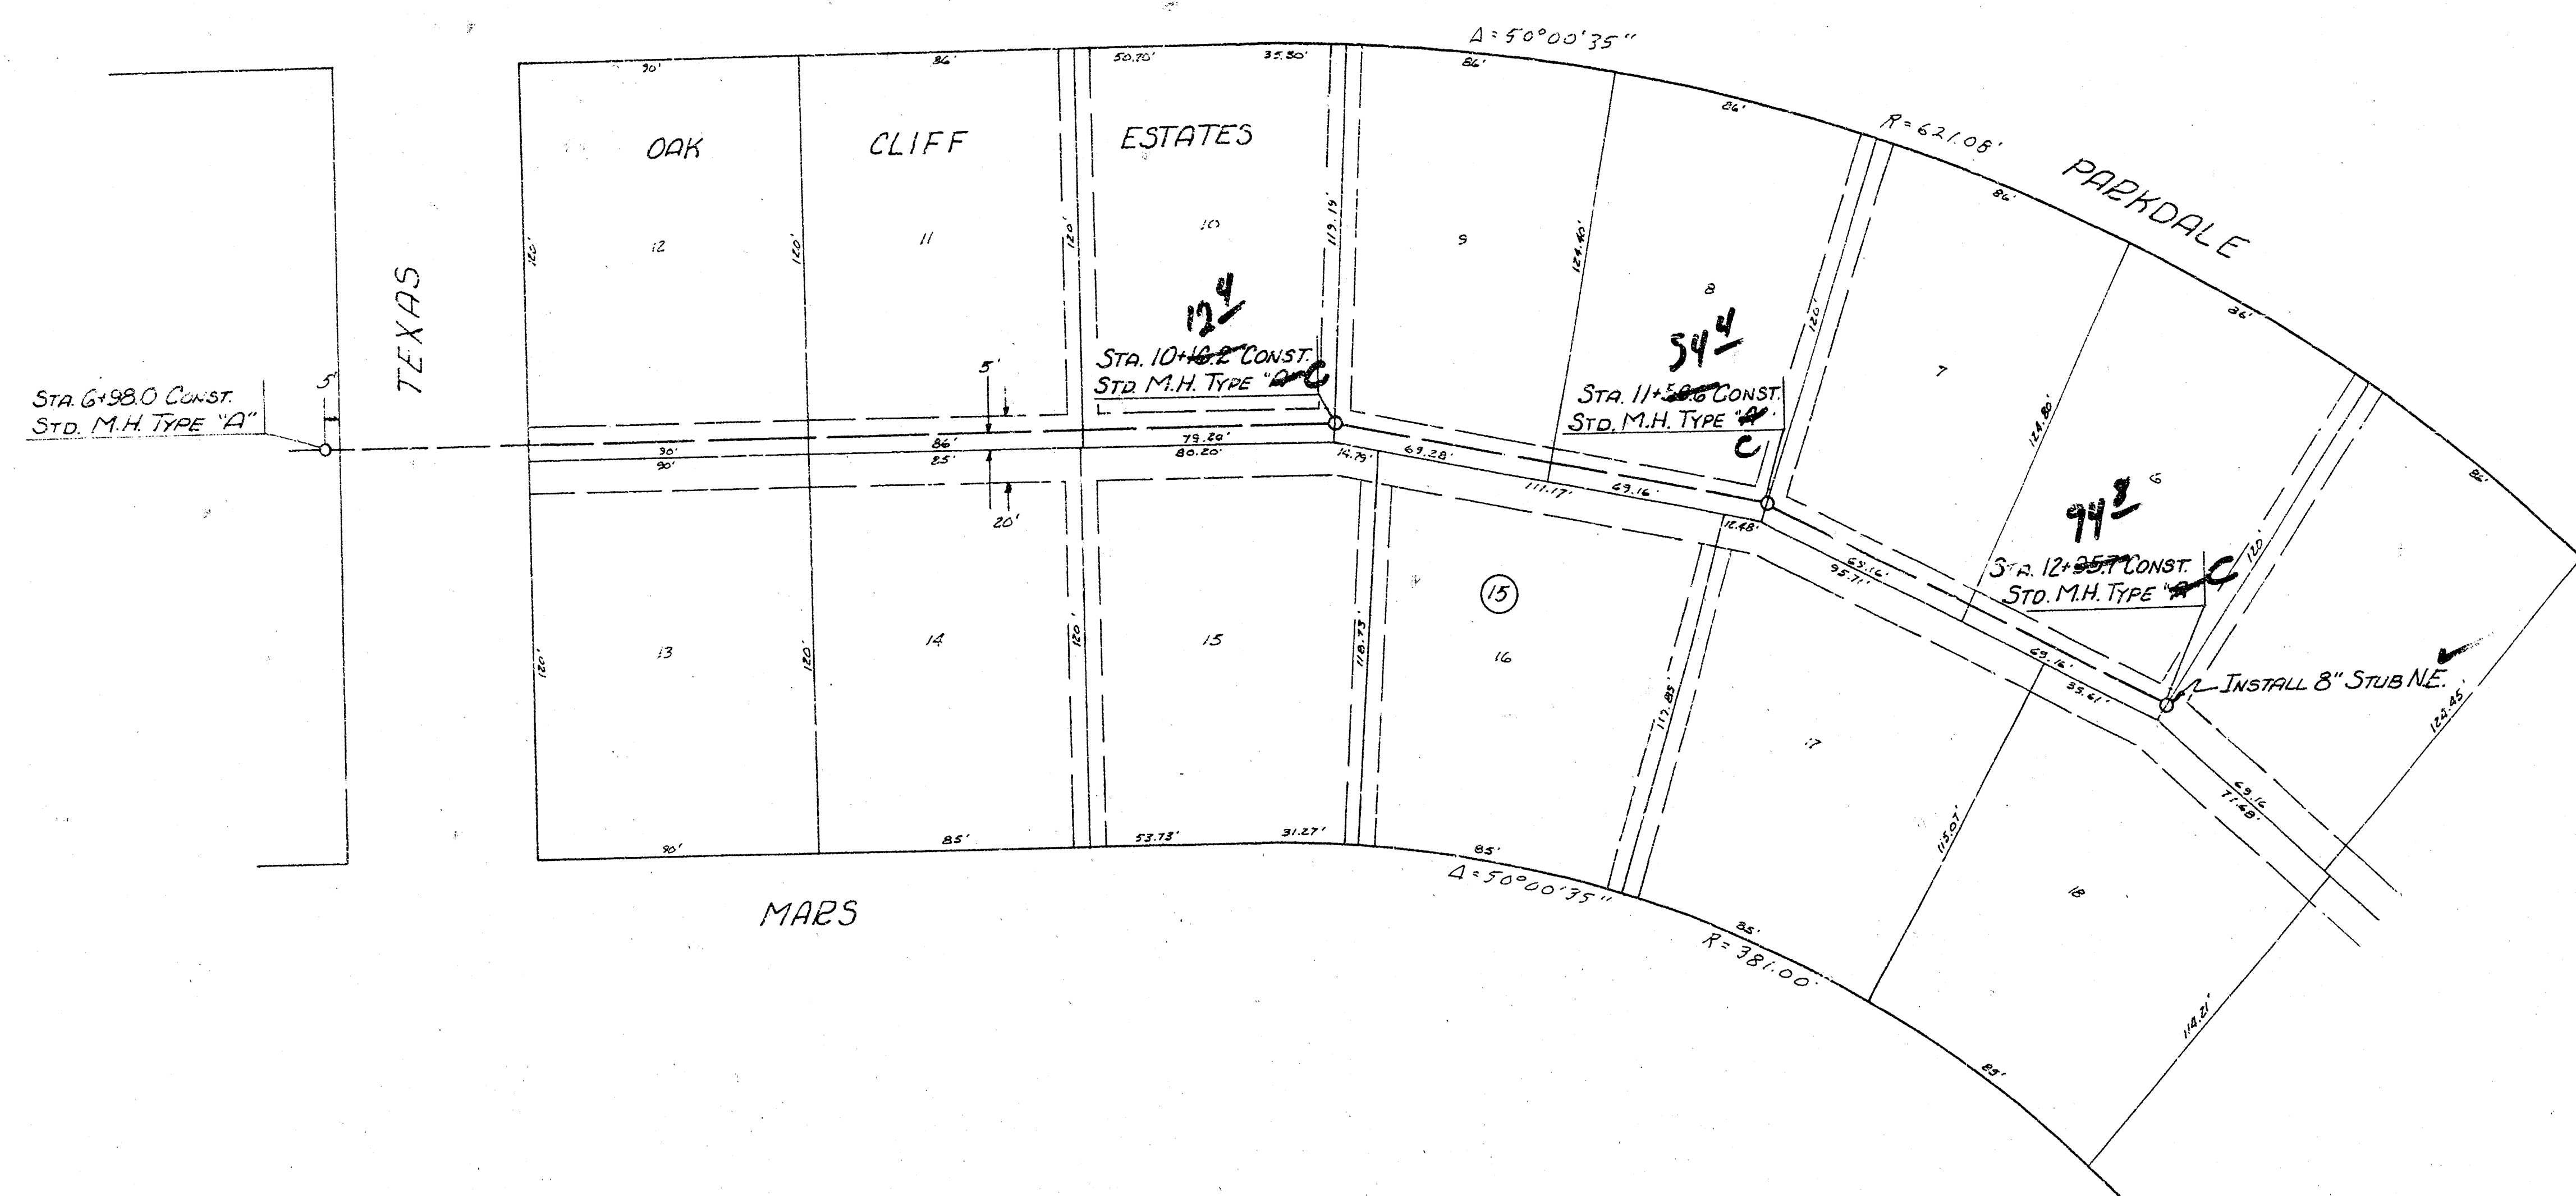


SCALE PLAN 1"=40'  
 PROFILE 1"=40' HORIZ.  
 1"=5' VERT.

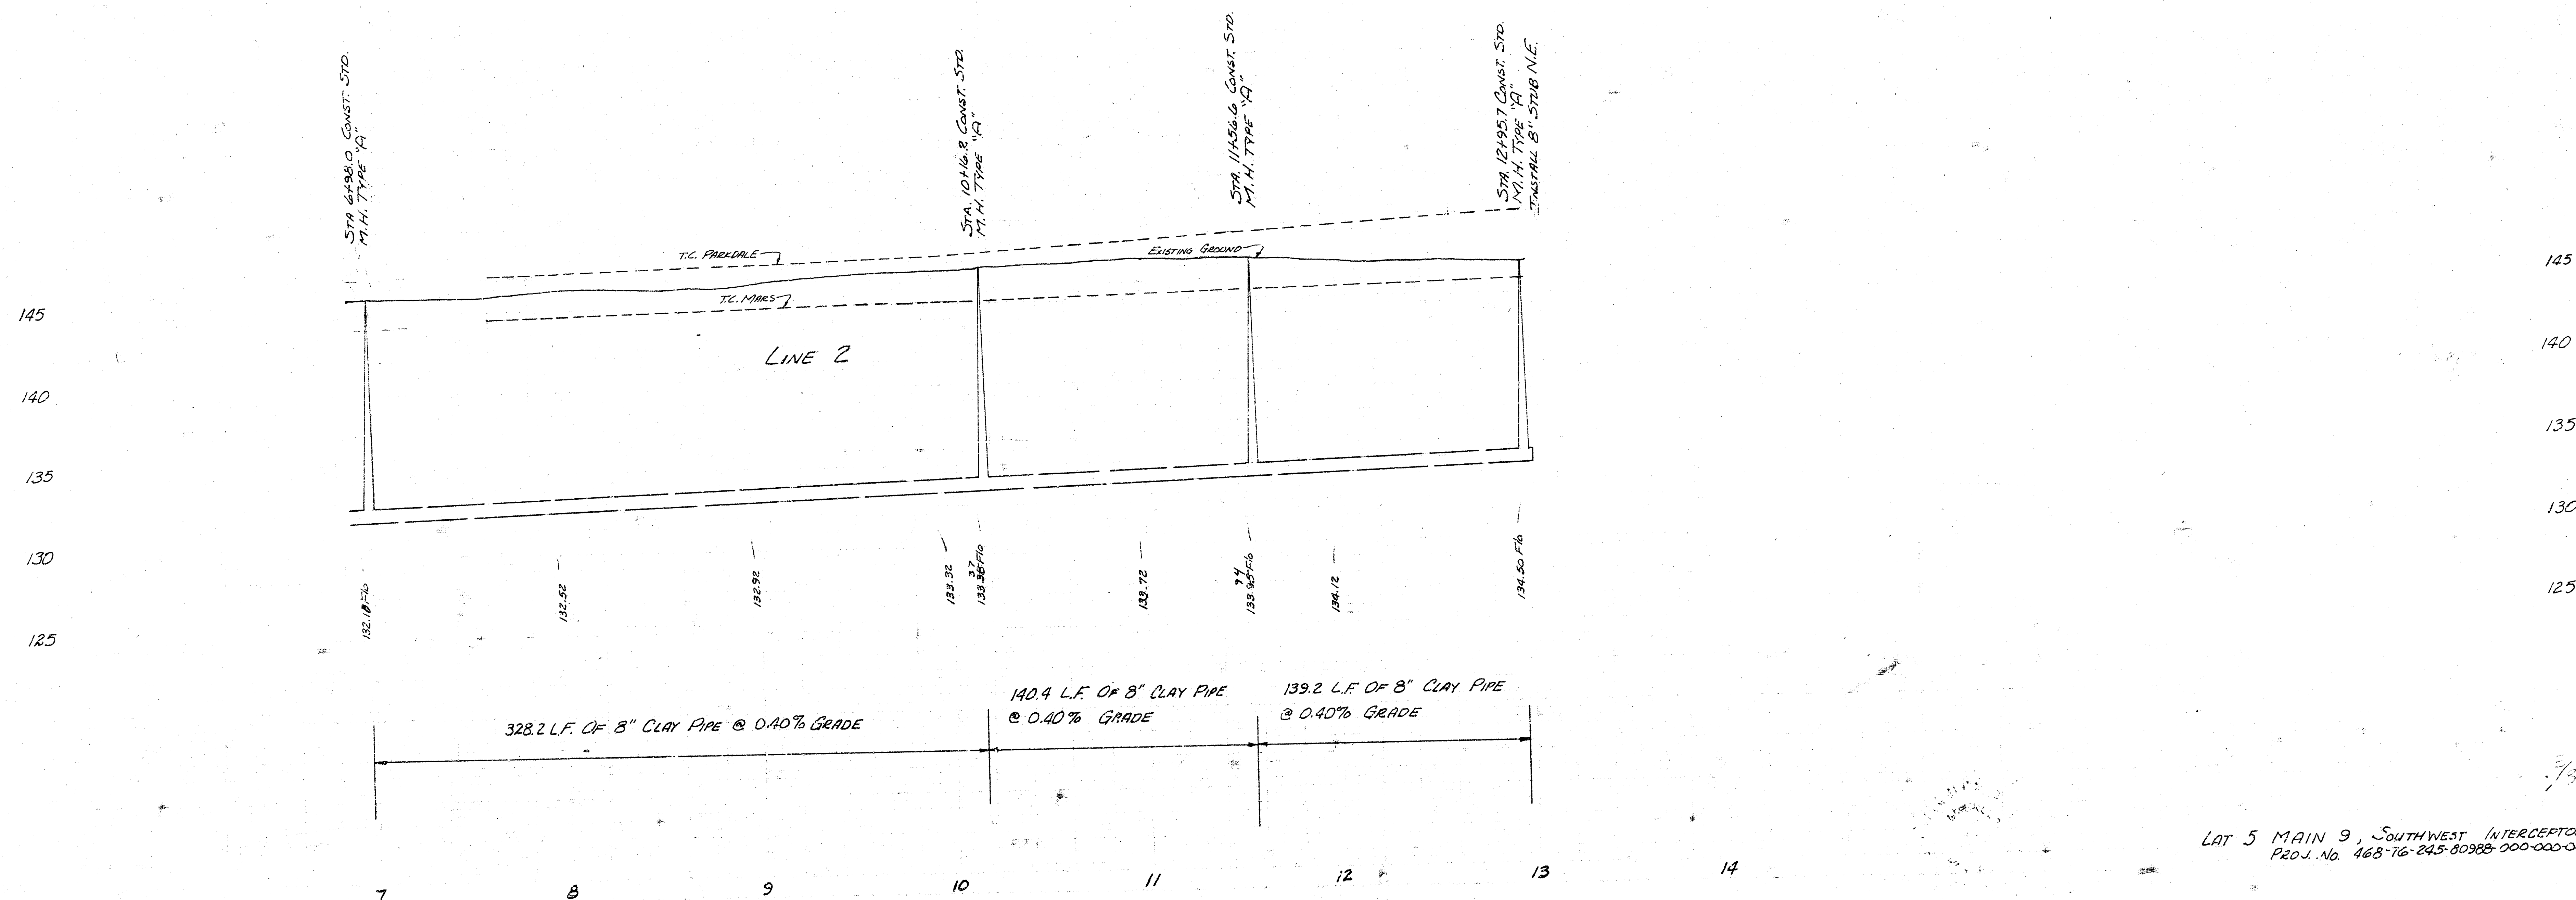

LAT 5 MAIN 9, SOUTHWEST INTERCEPTOR  
 PROJ. No. 468-76-245-80988-000-000-001


SCALE PLAN 1" = 40'  
 PROFILE 1" = 40' HORIZ  
 1" = 5' VERT.

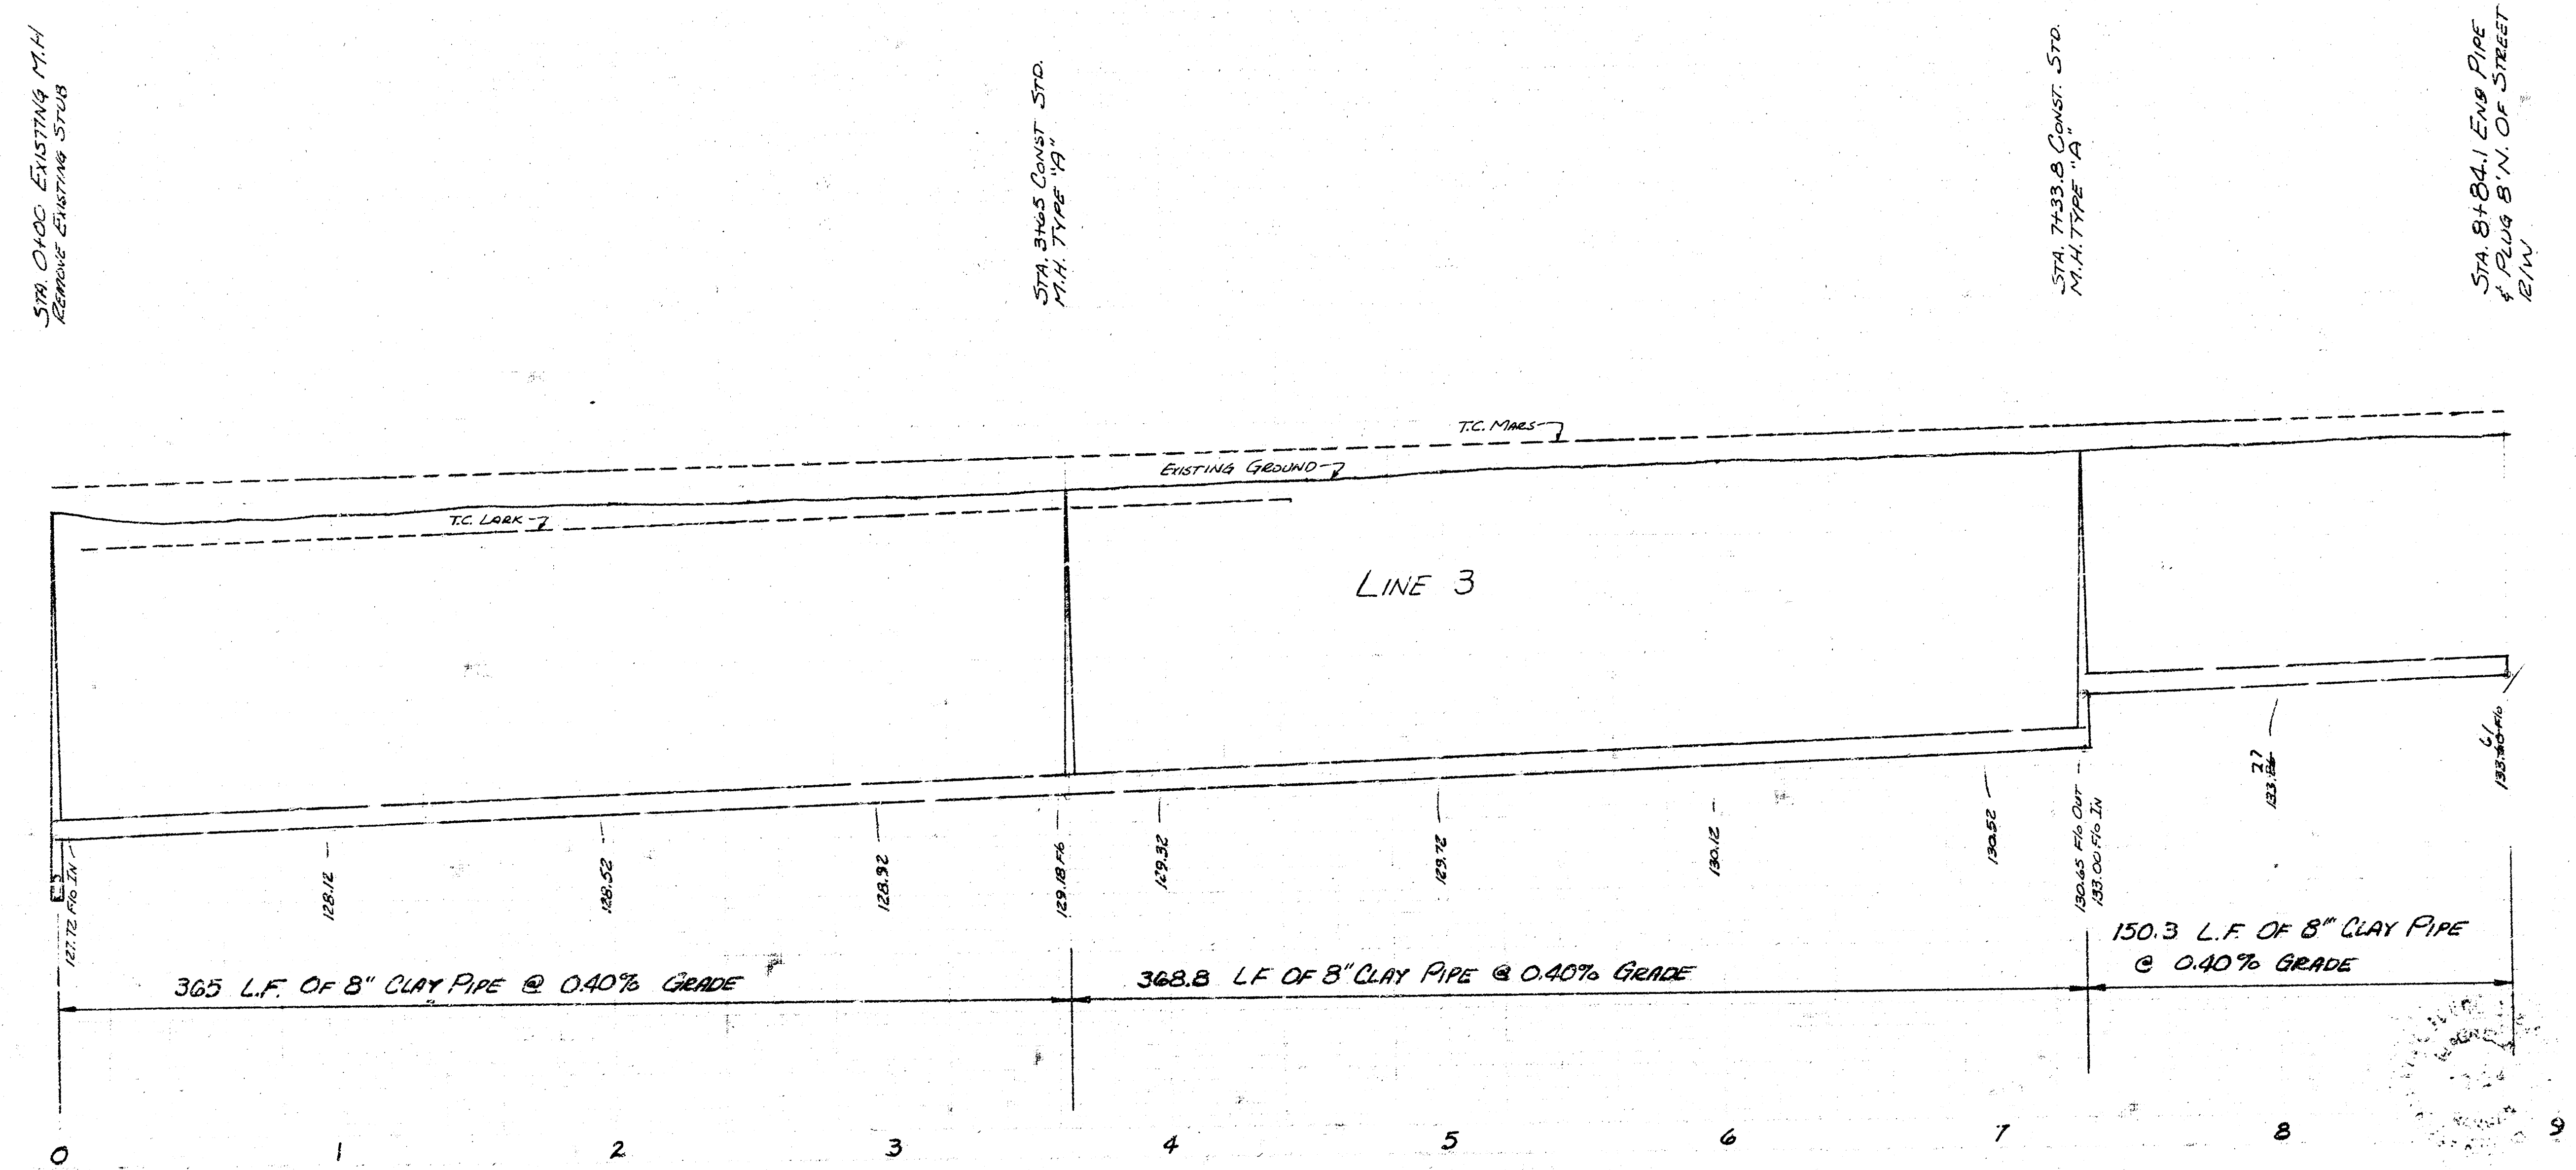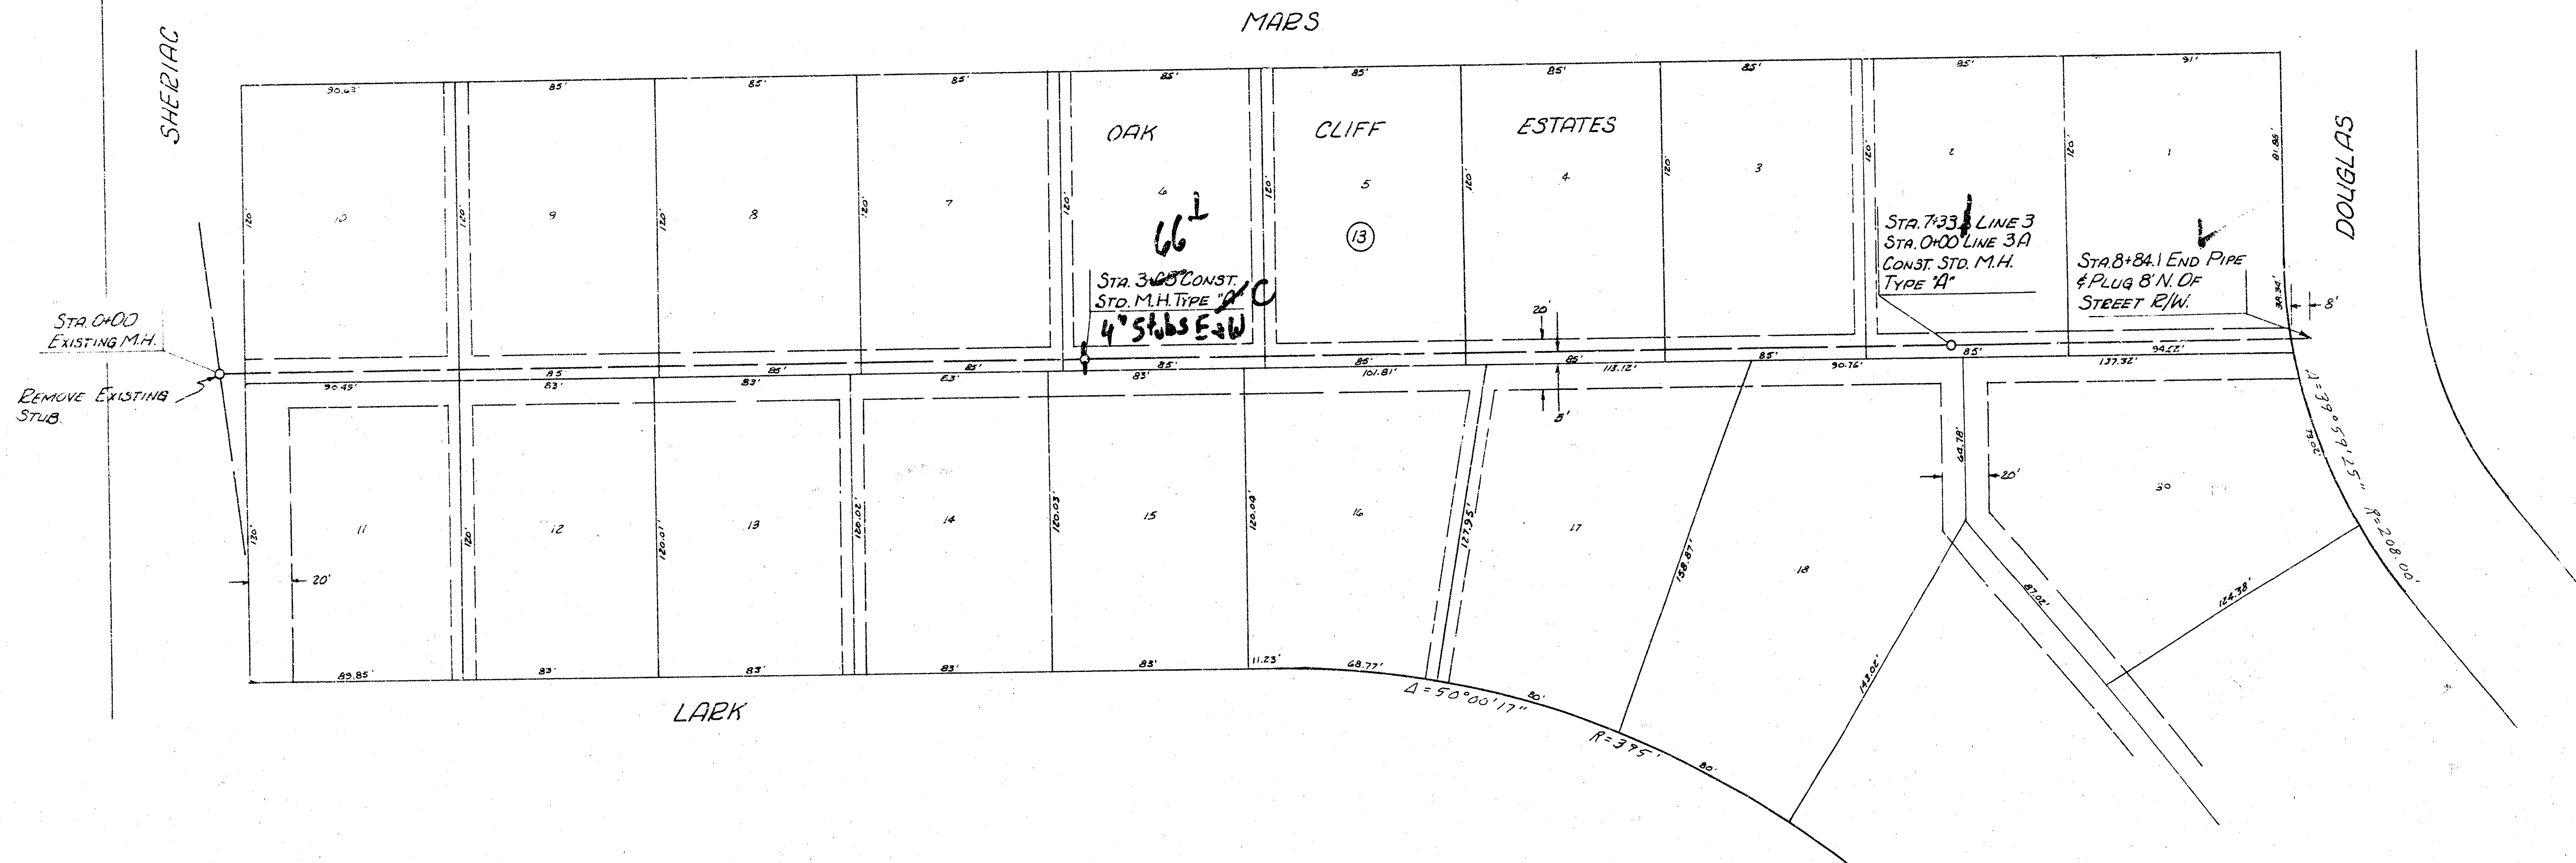

As Built  
 7/8/1

LAT 5 MAIN 9, SOUTHWEST INTERCEPTOR  
 PROJ. NO. 468-76-245-80988-000-000-001


FILMED FROM THE BEST

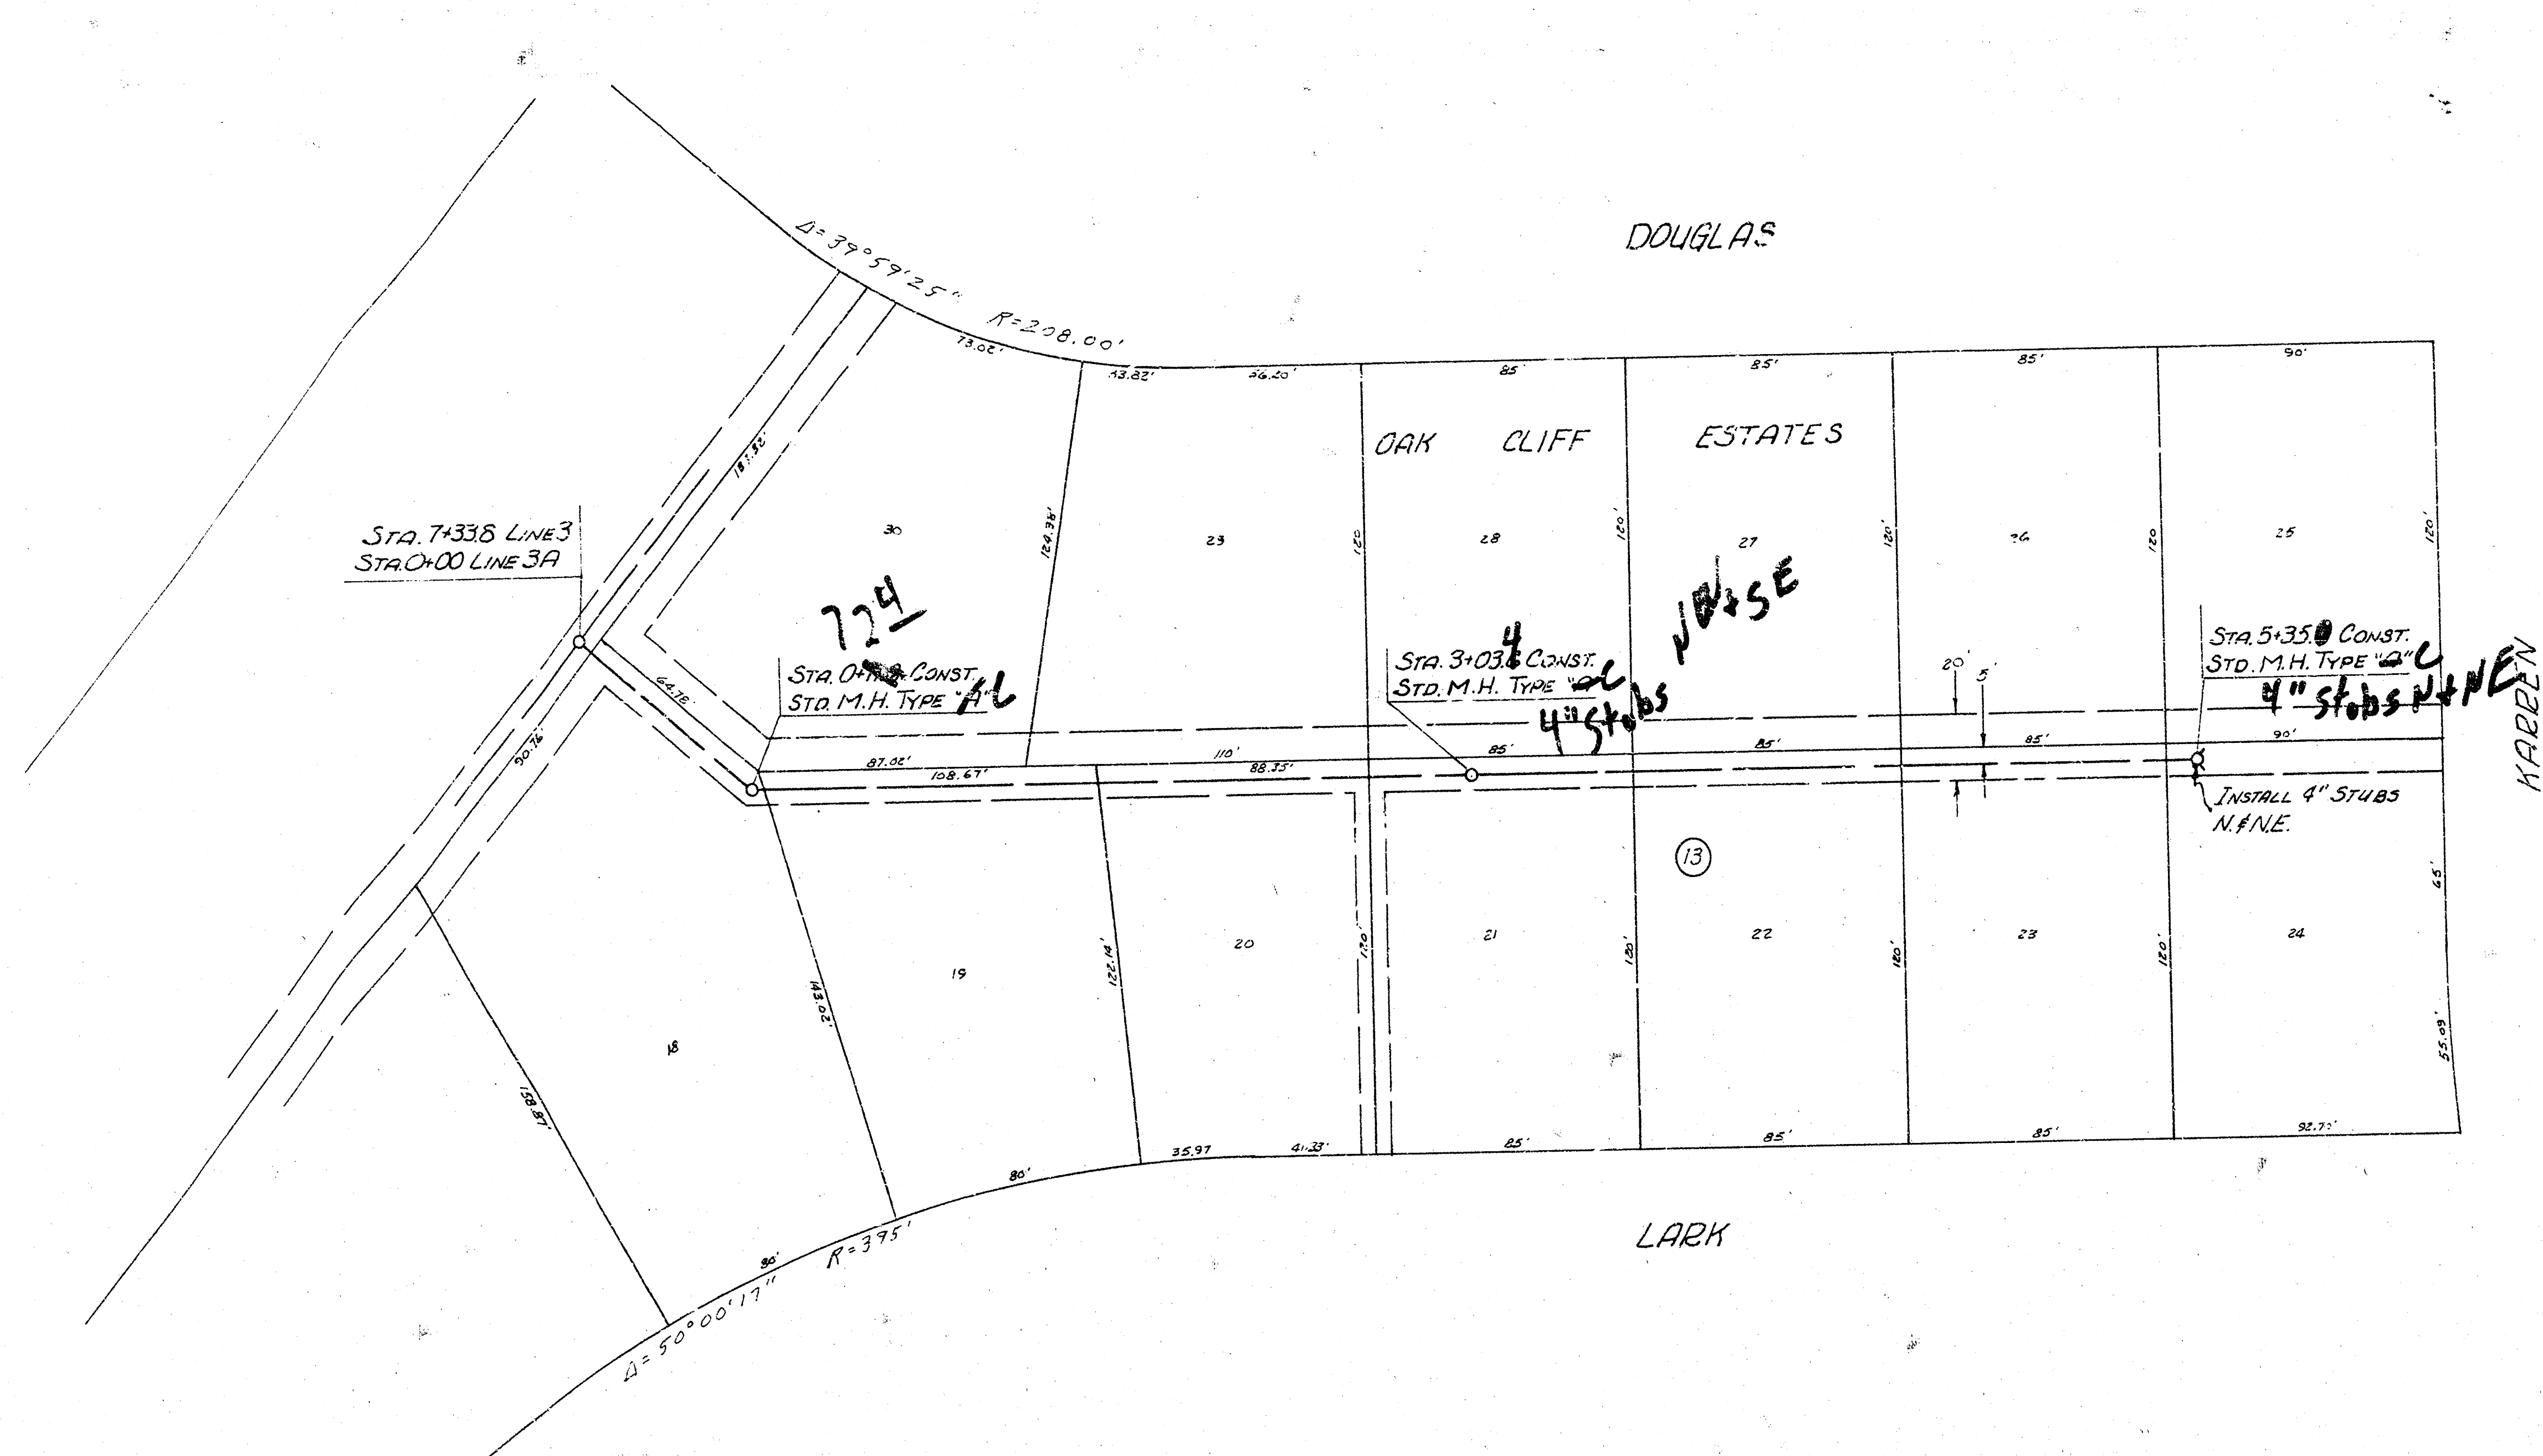


SCALE PLAN 1"=40'  
 PROFILE 1"=40' VERT.  
 1"=5' VERT.

150  
 145  
 140  
 135  
 130

150  
 145  
 140  
 135  
 130

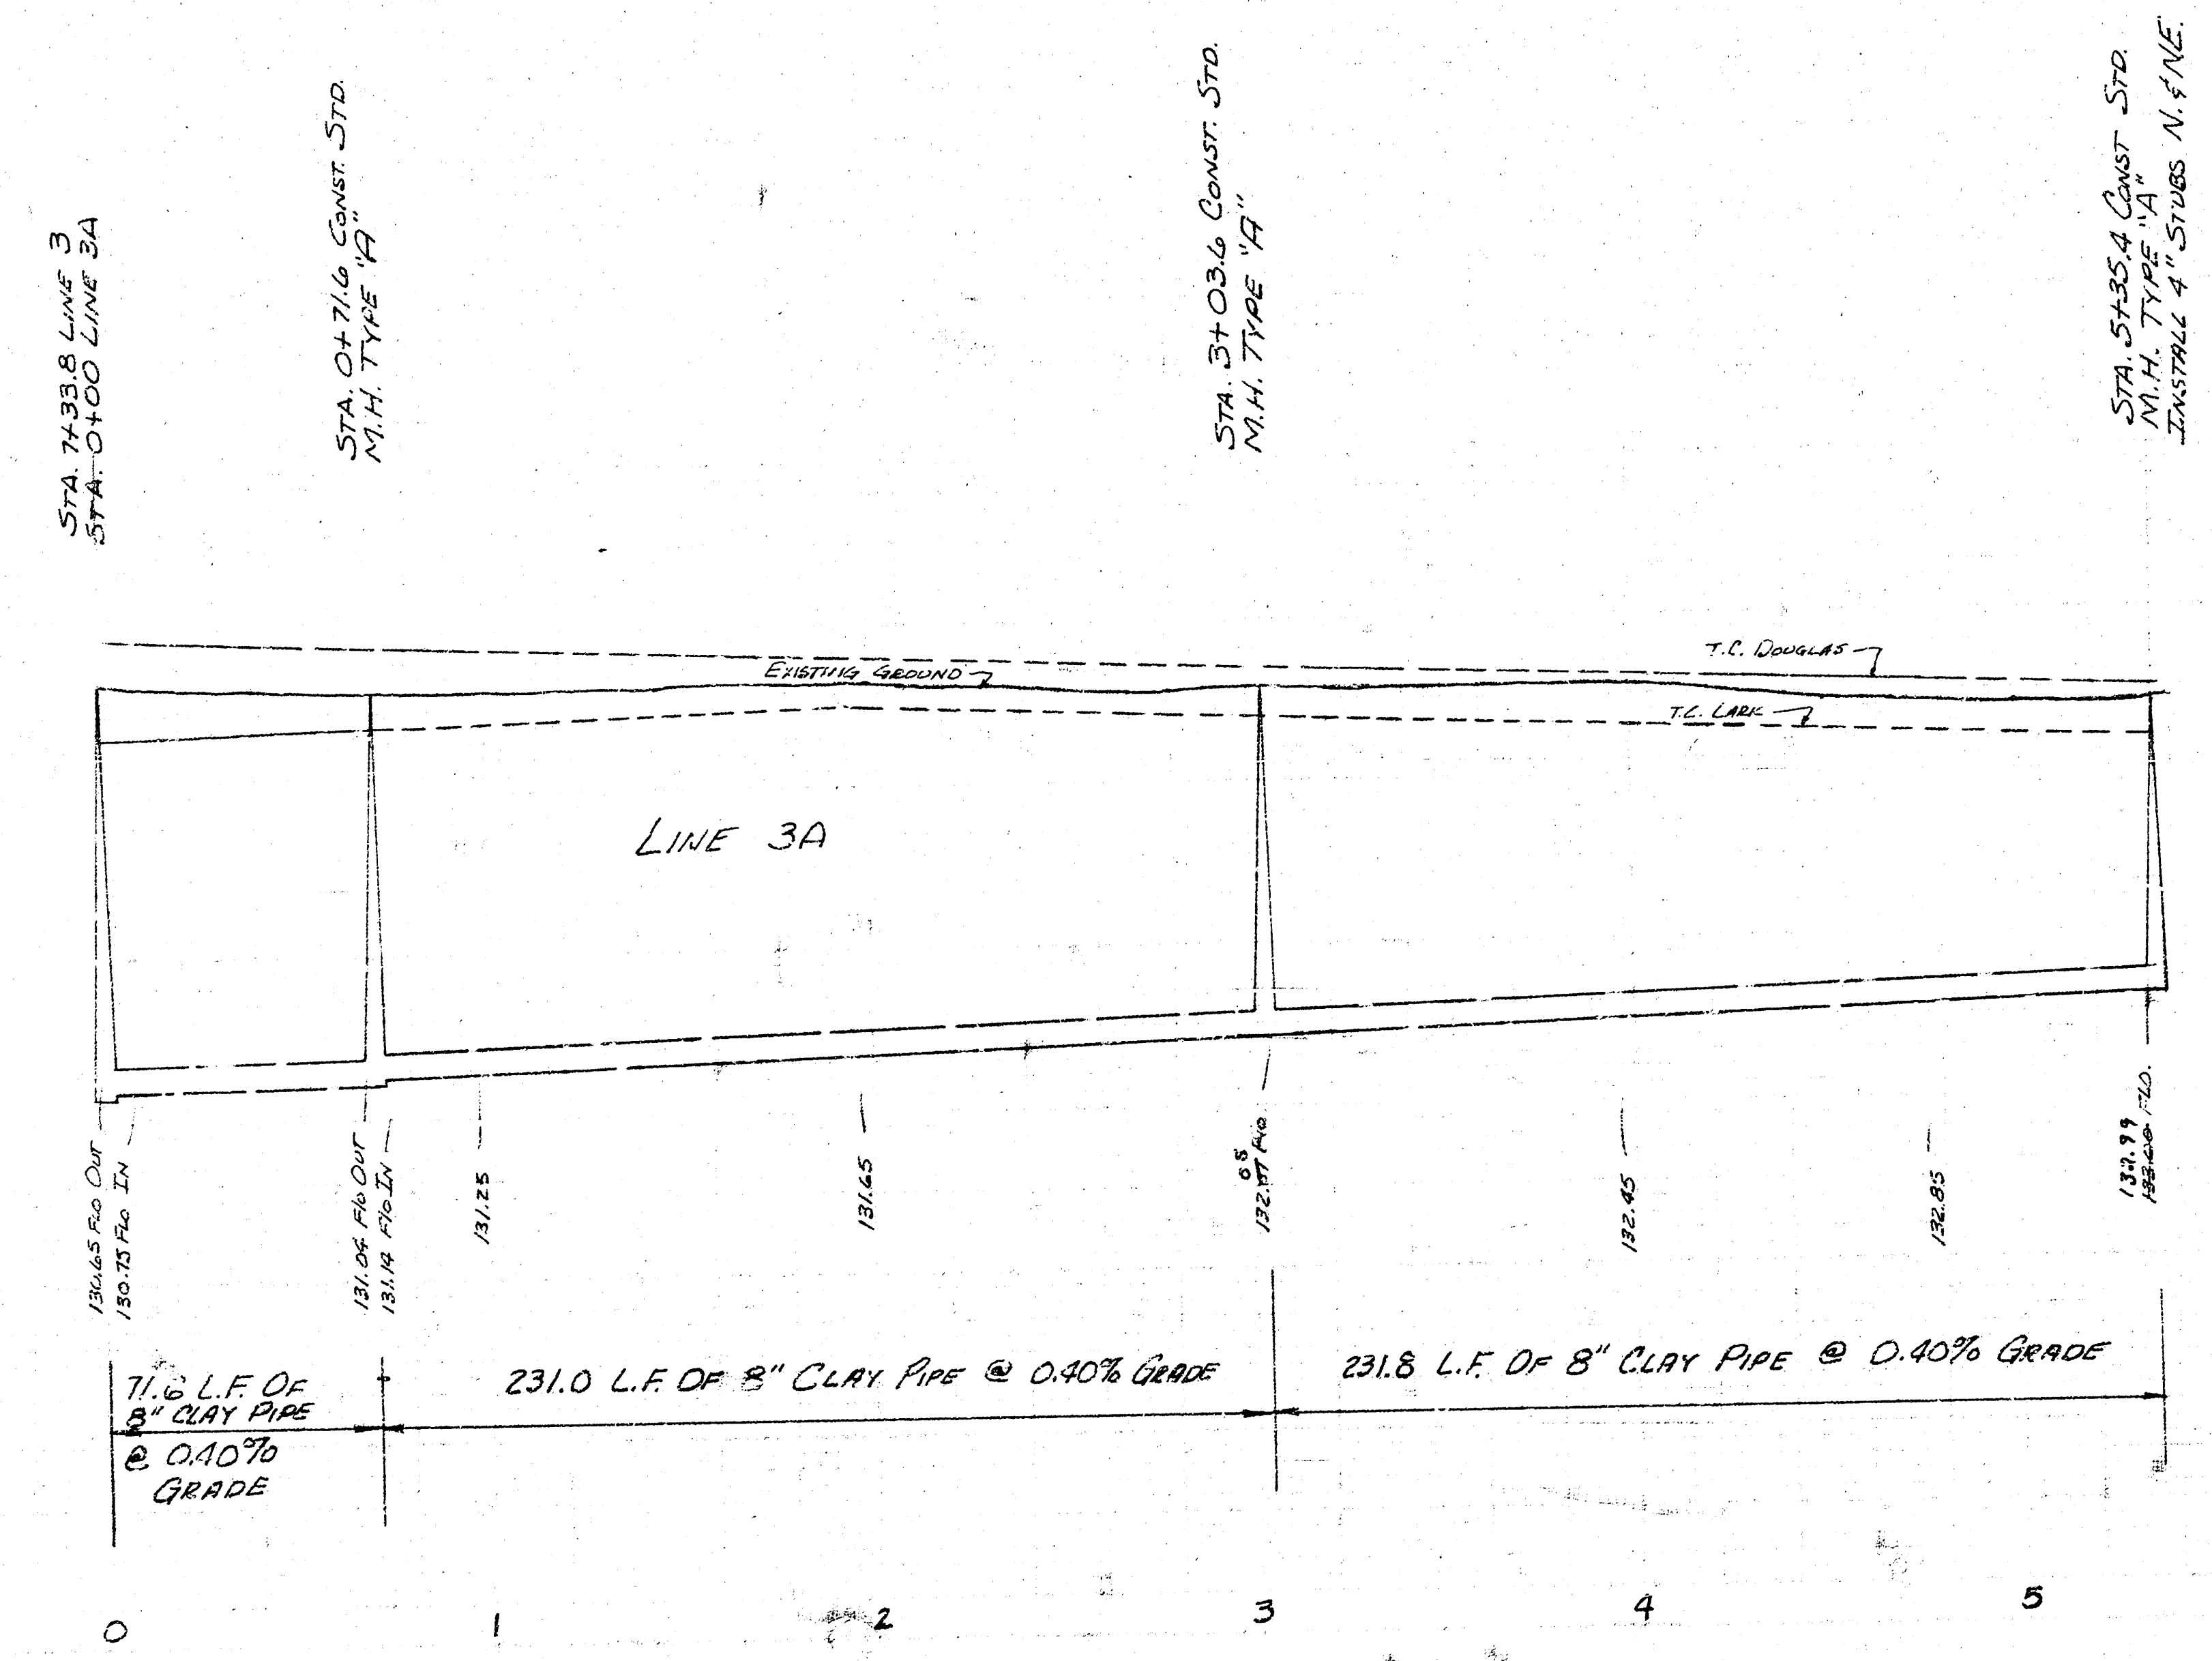


LAT 5 MAIN 9, SOUTHWEST INTERCEPTOR  
 PROJ. NO. 468-76-245-80988-000-000-001

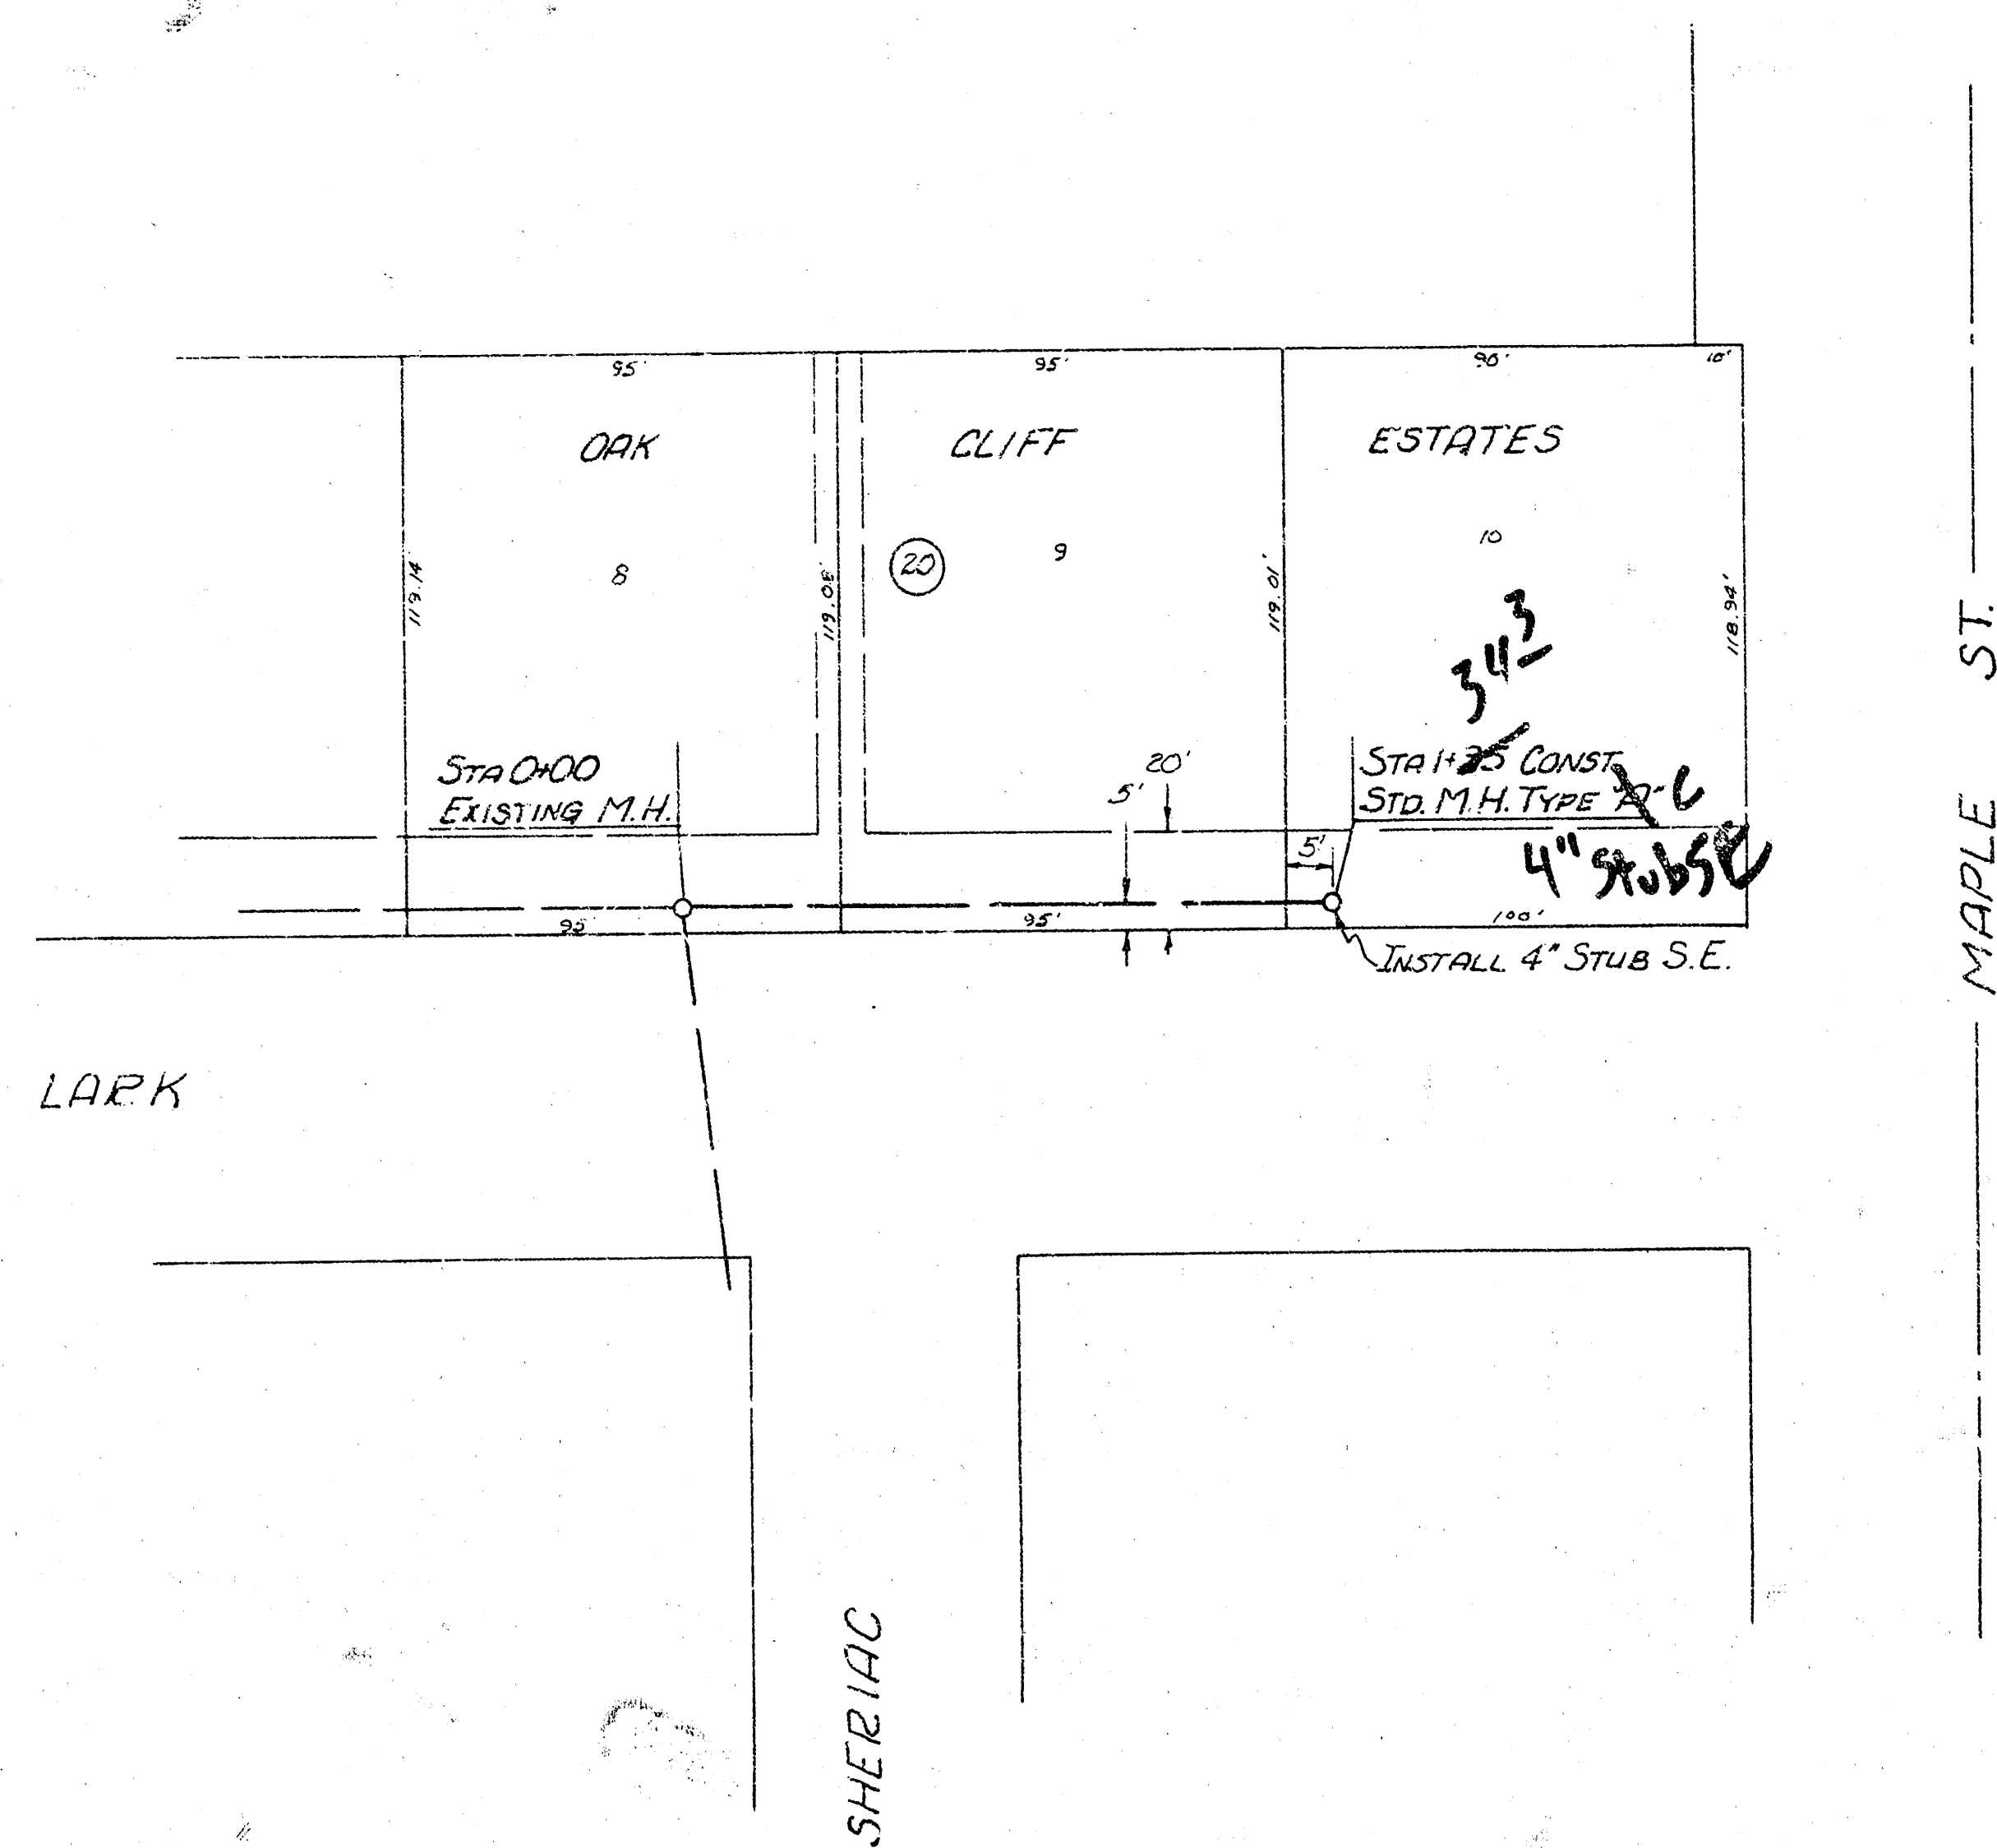

SCALE PLAN 1"=40'  
PROFILE 1"=40' HORIZ  
1"=5' VERT.

B.M. 133.20 City Std. 43.5' S + 52.7' E. of  
+ Mariza Road + Maple St.  
B.M. 143.06 "d" center Handwall S. side P.C.B.  
1/2 mile West of Mariza Road + Maple.

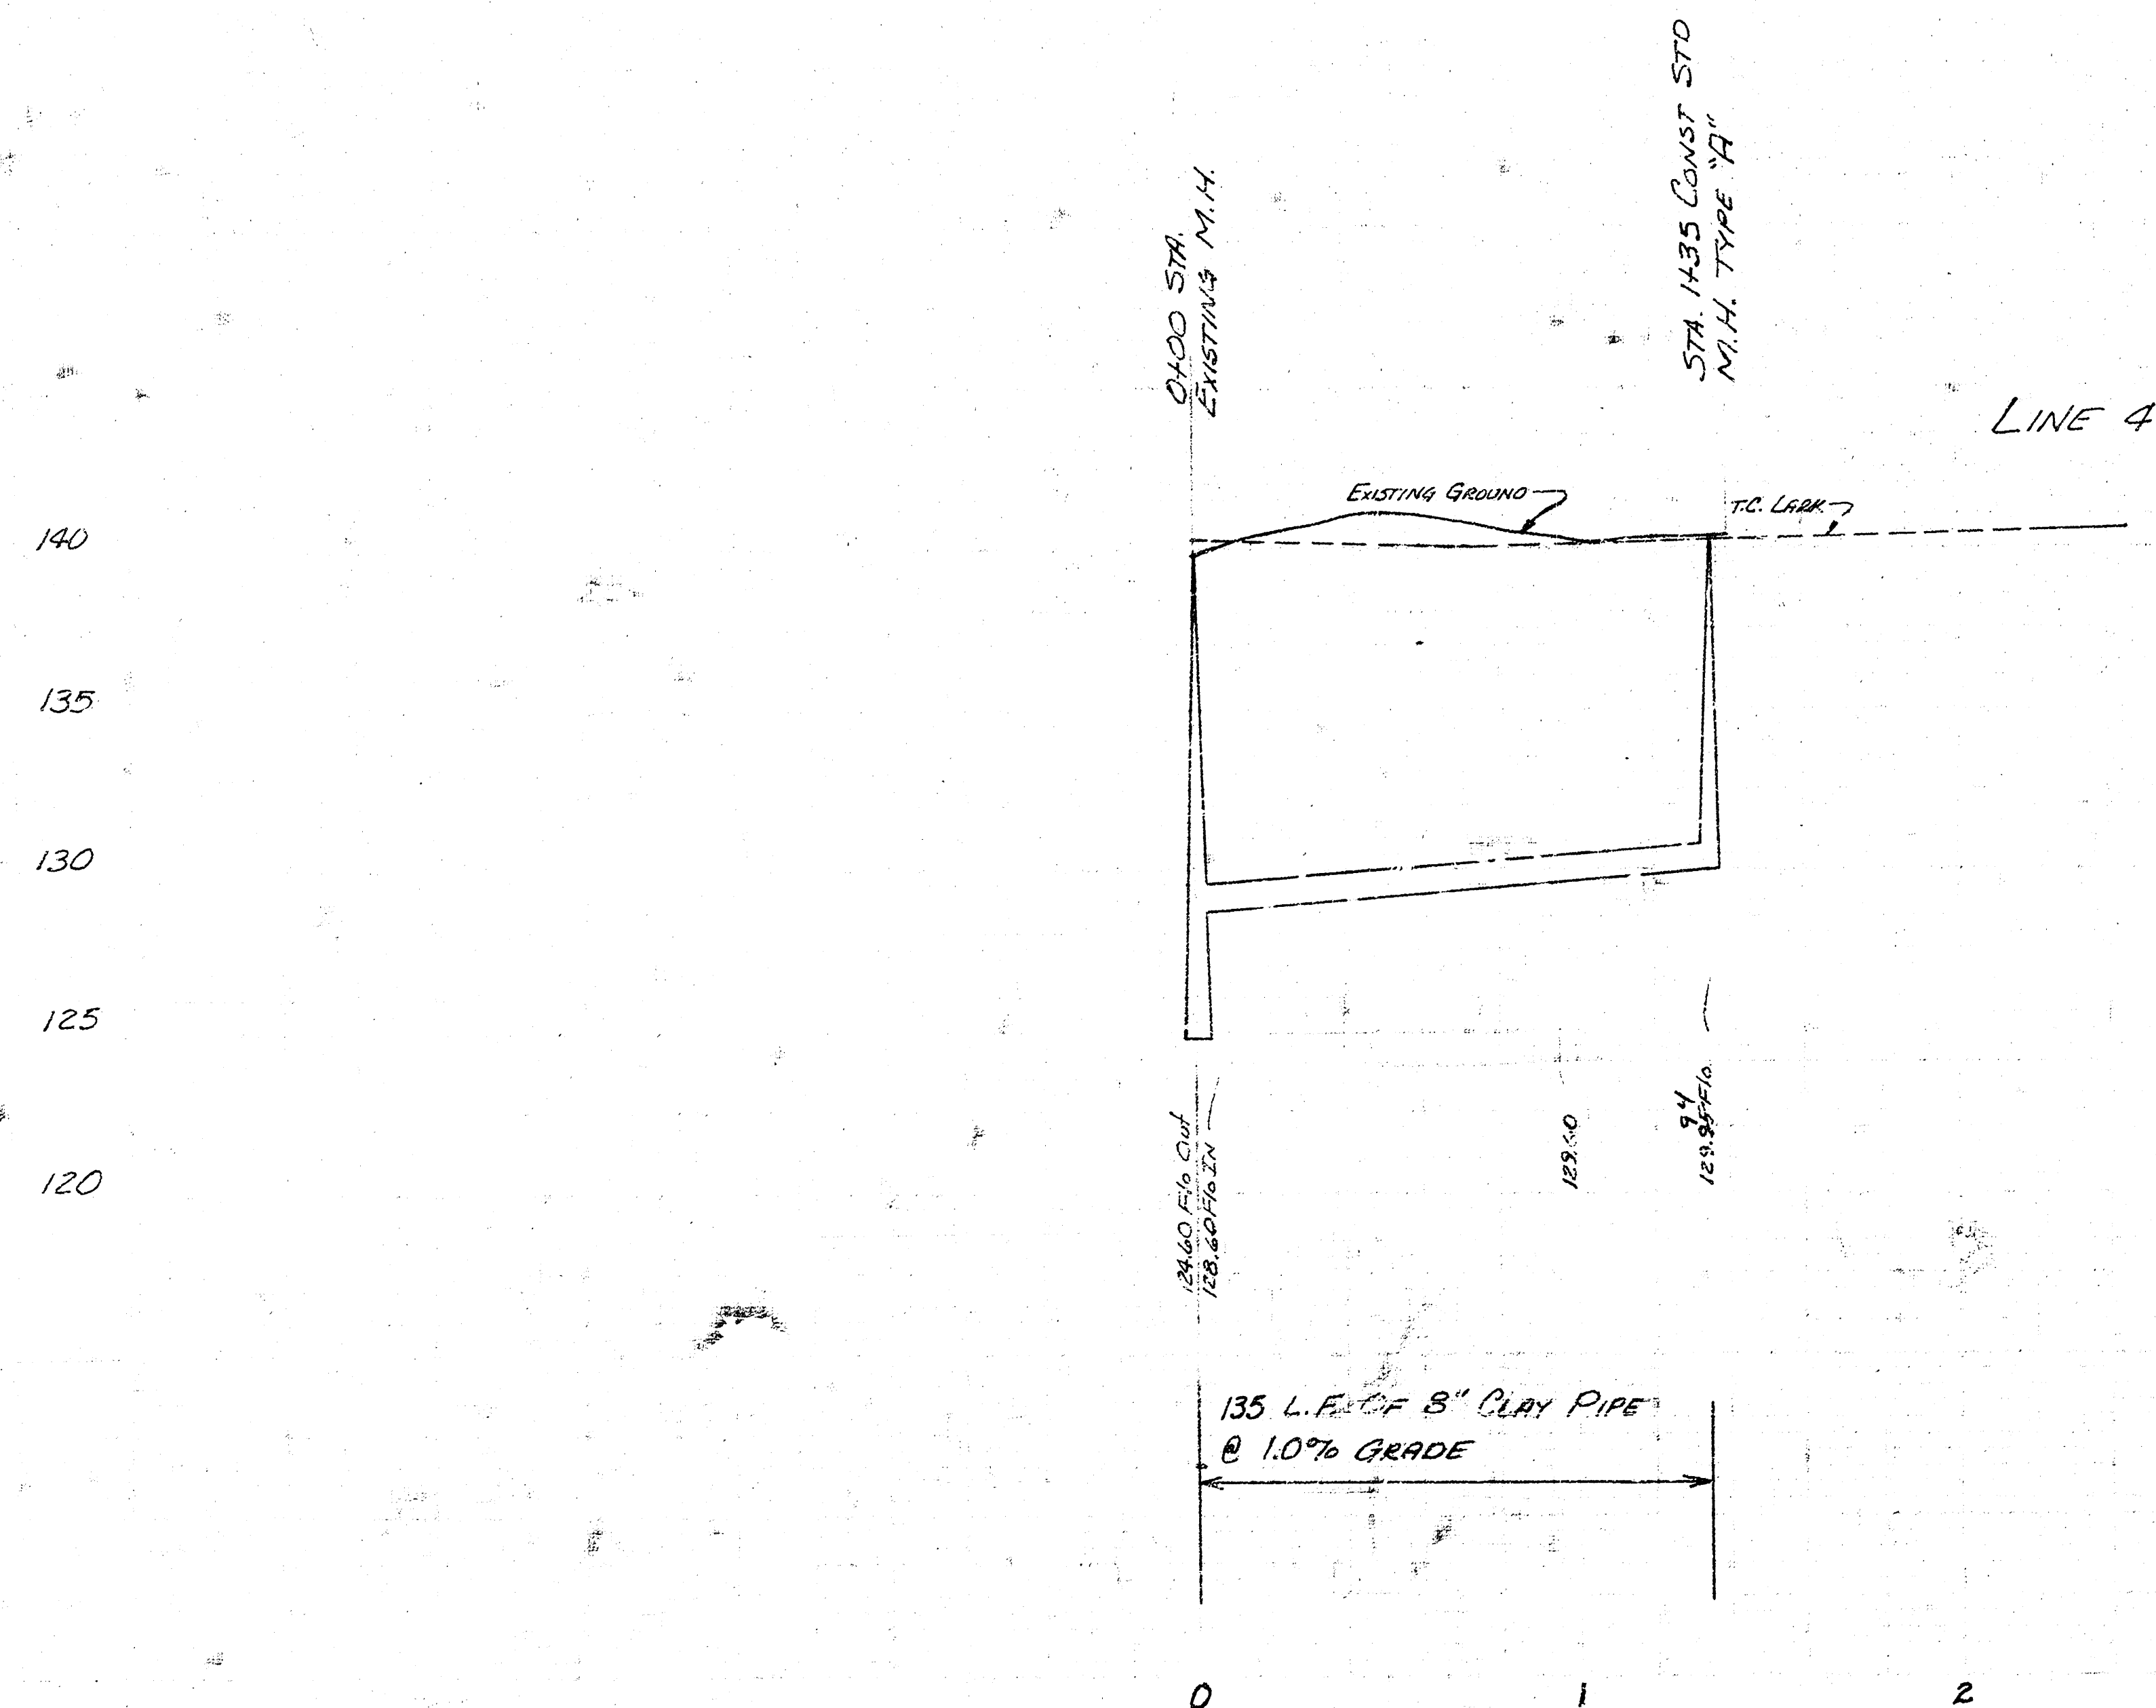

As Built  
7/8/81  
JLL

LAT 5 MAIN 9, SOUTHWEST INTERCEPTOR  
PROJ. No. 468-76-245-80968-000-000-001

FILMED FROM THE BEST